




1 CURB RAMP DETAIL
Scale: 1"=5'

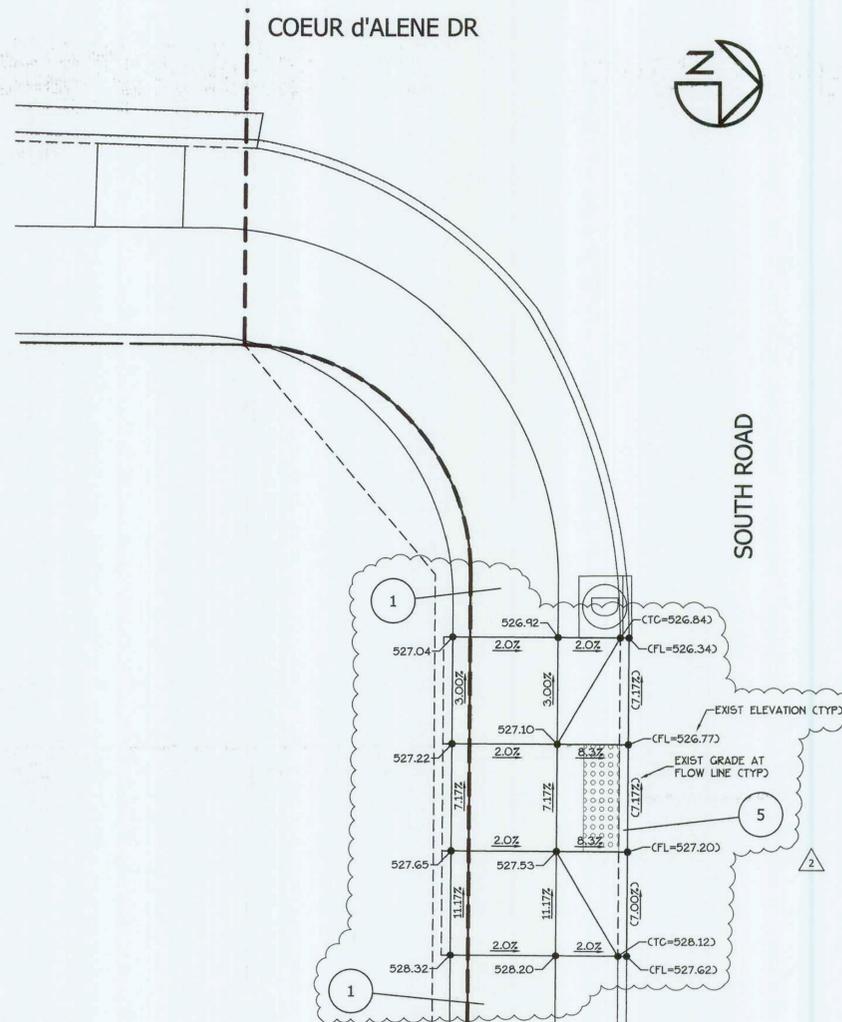


2 CURB RAMP DETAIL
Scale: 1"=5'

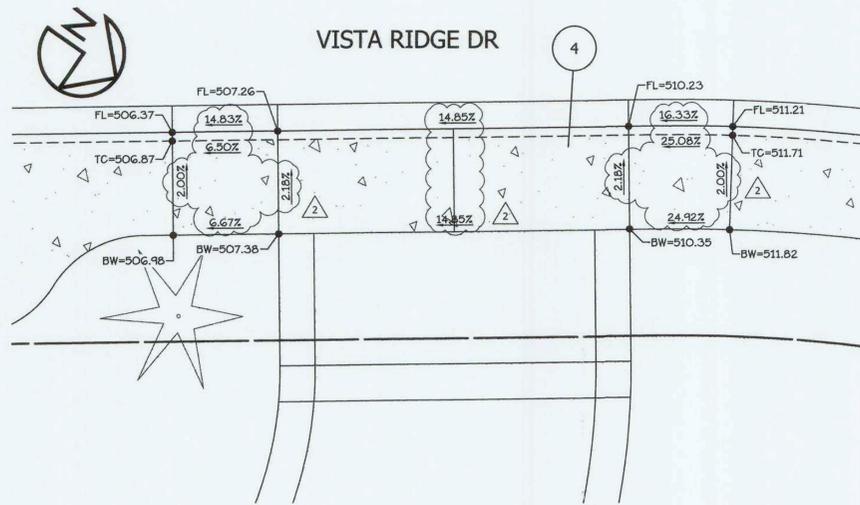

3 SIDEWALK RAMP AT LOT 30 DRIVEWAY DETAIL
Scale: 1"=5'

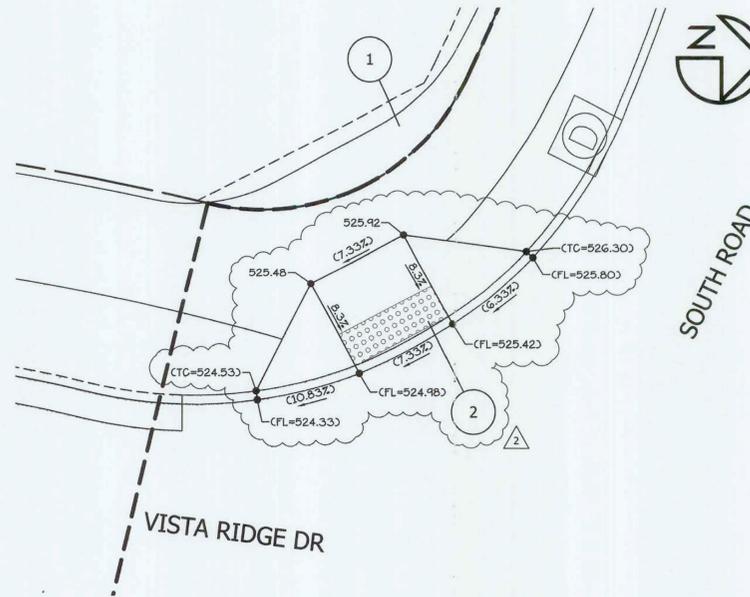

4 CURB RAMP DETAIL
Scale: 1"=5'

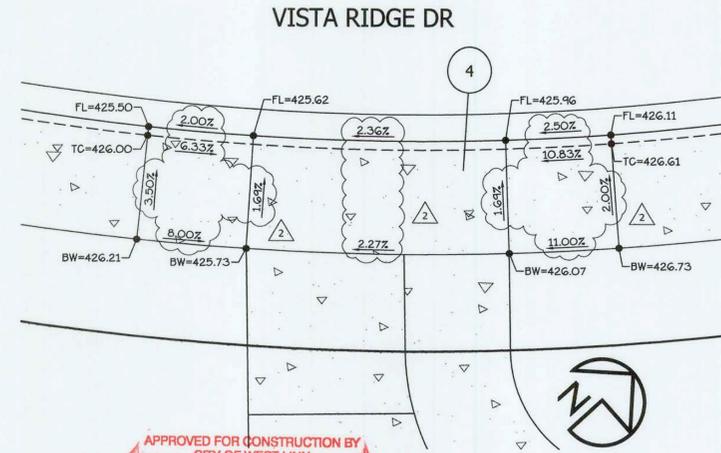

5 APPROVED FOR CONSTRUCTION BY CITY OF WEST LINN. This approval is only for general performance and shall not be construed as relieving the Design Engineer of full responsibility for accuracy and completeness of the drawings. This plan review approval does not prevent the City from requiring further code corrections. DATE: 9-6-11 BY: E.M.C.V. ENGINEERING DATE: 9-6-11 BY: J.Z. PLANNING
SIDEWALK RAMP AT DETENTION POND DRIVEWAY
Scale: 1"=5'



- NOTES:
1. CONSTRUCT SIDEWALK PER WL-508. SIDEWALK CONSTRUCTION TO BE COMPLETED IN CONJUNCTION WITH HOME. (EXCEPT AS NOTED ON C1.4.)
 2. CONSTRUCT CURB RAMP PER WL-507A.
 3. (NOT USED)
 4. CONSTRUCT DRIVEWAY PER WL-503B.
 5. CONSTRUCT PARALLEL CURB RAMP PER WL-506B.

DESIGN GROUP
901 N. Brutscher, Ste. 202
Newberg, Oregon 97132
Phone: 503-537-9347
www.thesaunderscompany.net

THE SAUNDERS COMPANY

REGISTERED PROFESSIONAL ENGINEER
OREGON
SEPT. 14, 1988
CHARLES EDWARD GREGORY
RENEWS: JUNE 30, 20 12

J.T. SMITH companies

Teresa's Vineyard
Public Improvements
Sub-07-02/NDW-07-02/VAR-07-01
West Linn, Oregon

REV	DATE	SUMMARY
1	8/5/11	Client/Agency Comments
2	8/30/11	Agency Comments

Project #: 9130 Drawn: CL

CURB & DRIVEWAY RAMP DETAIL PLANS

Date: April 15, 2011

C3.10