
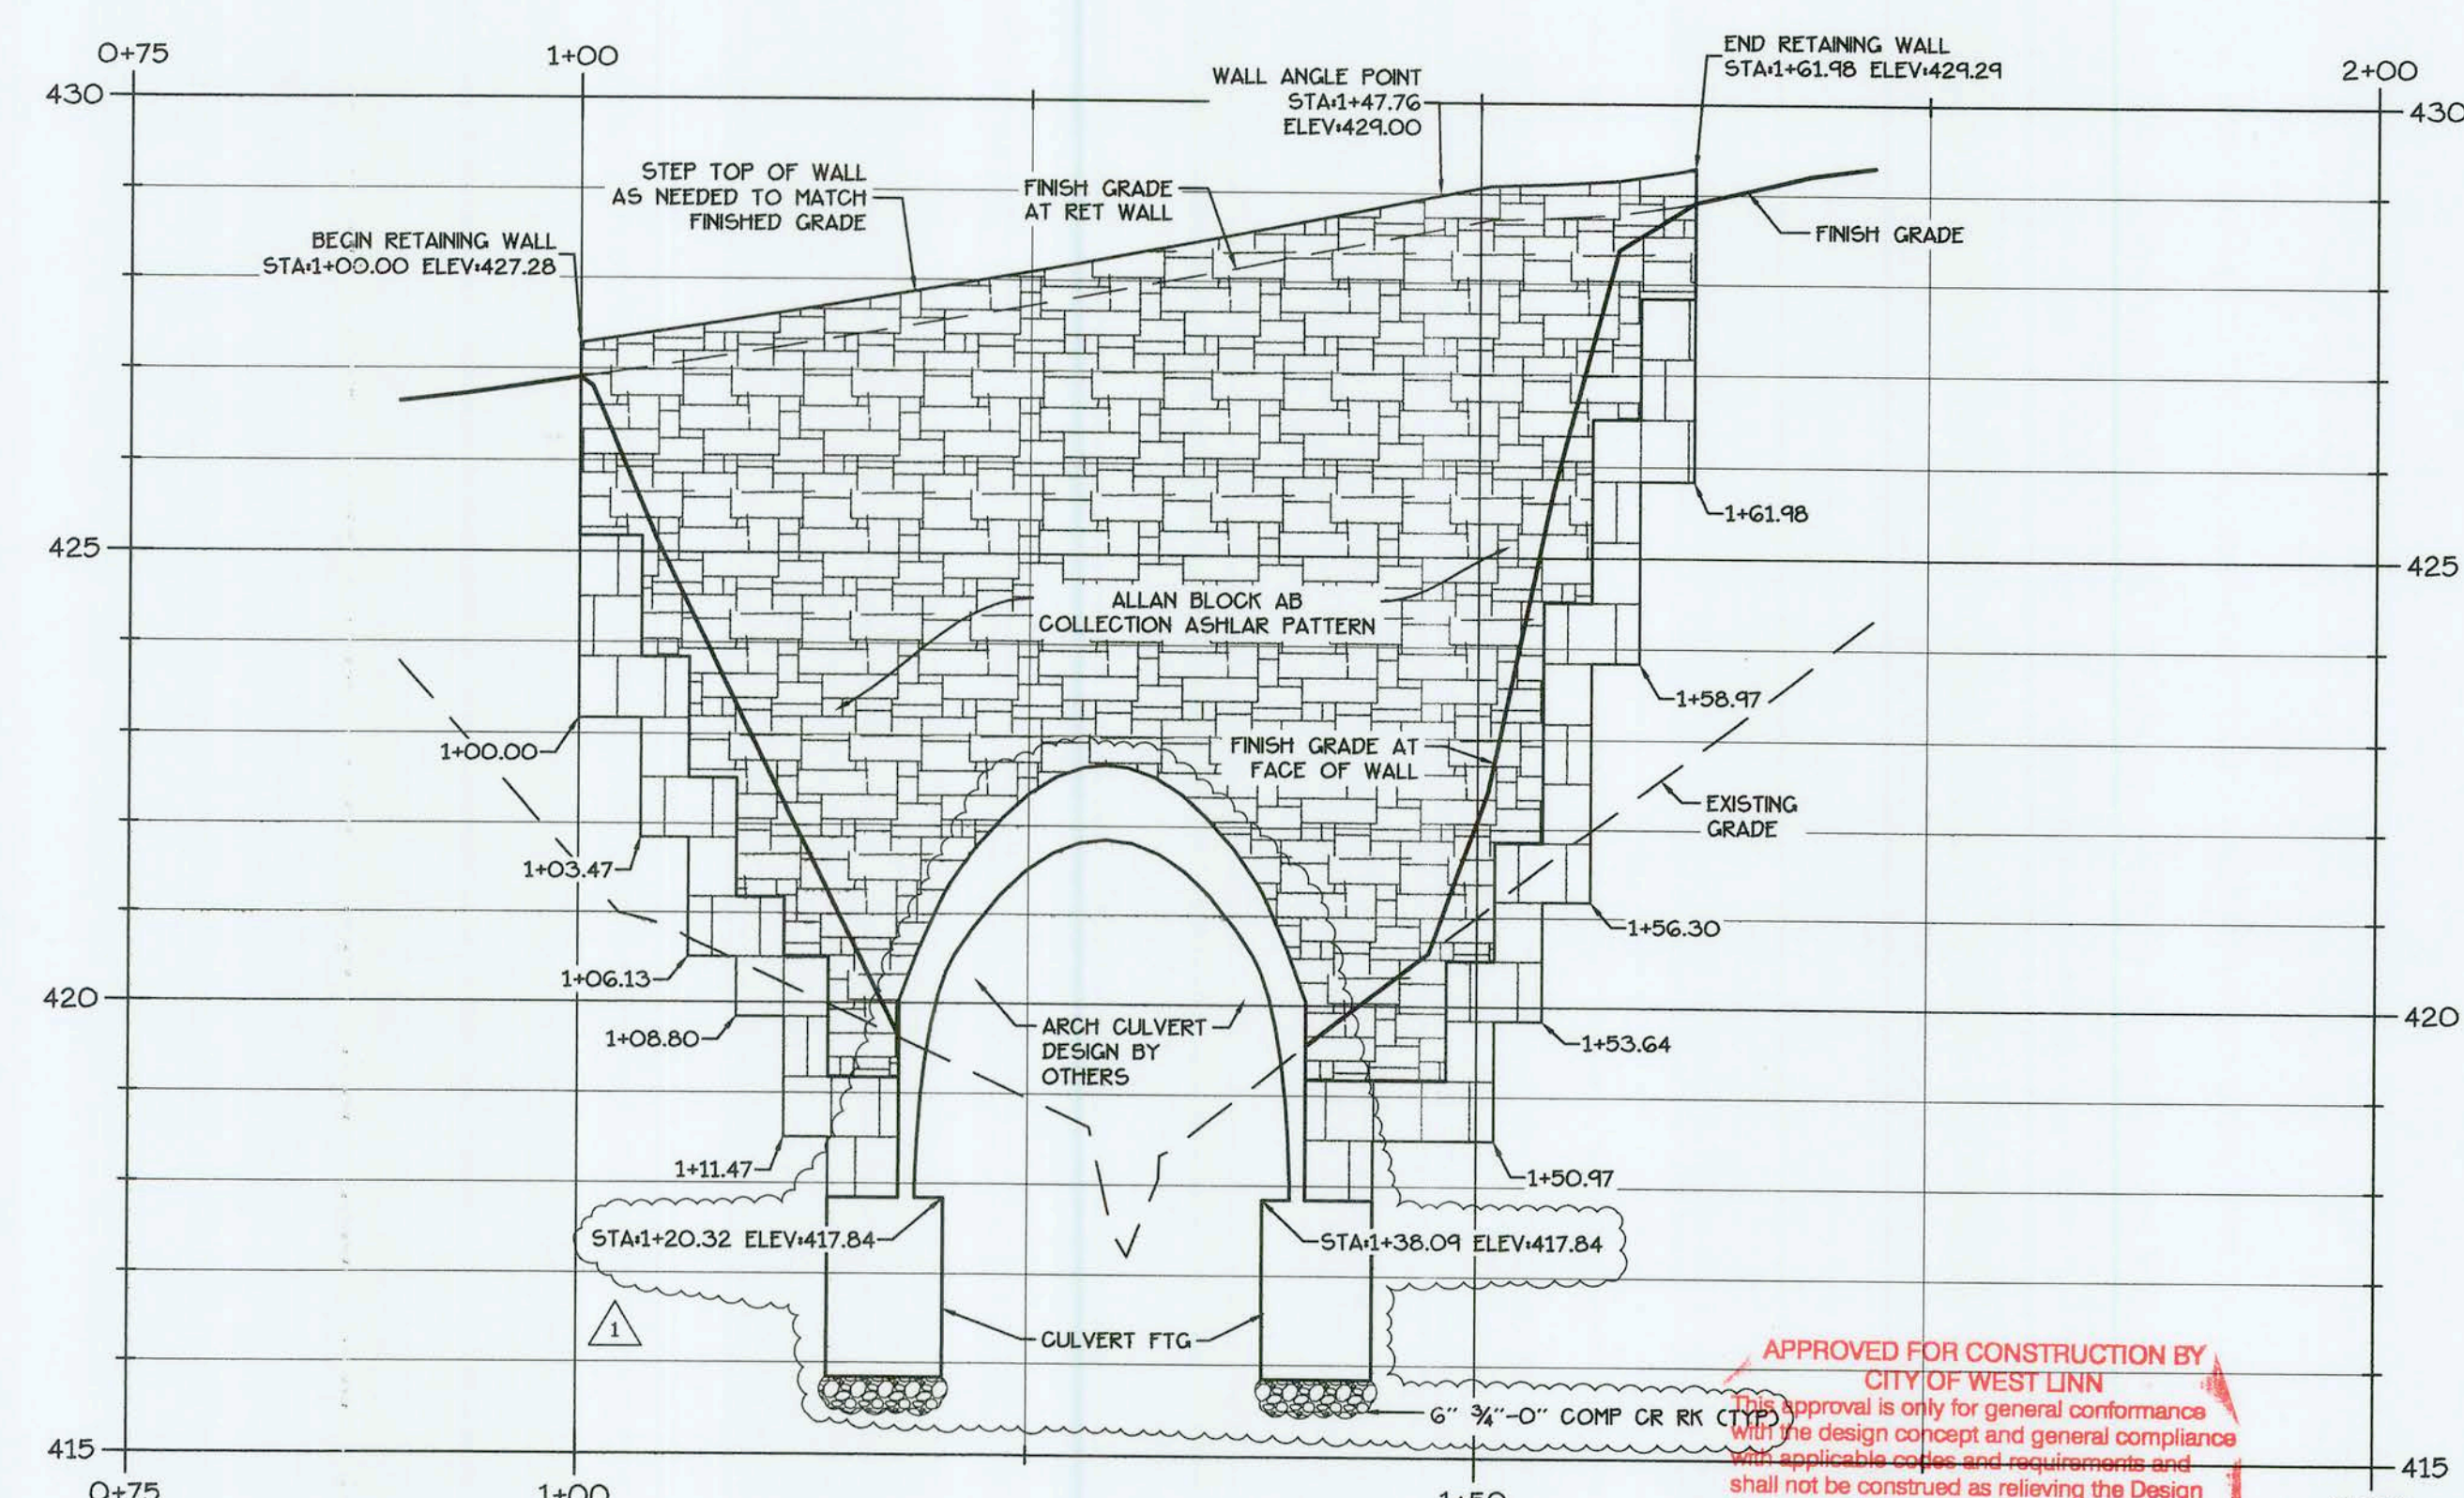
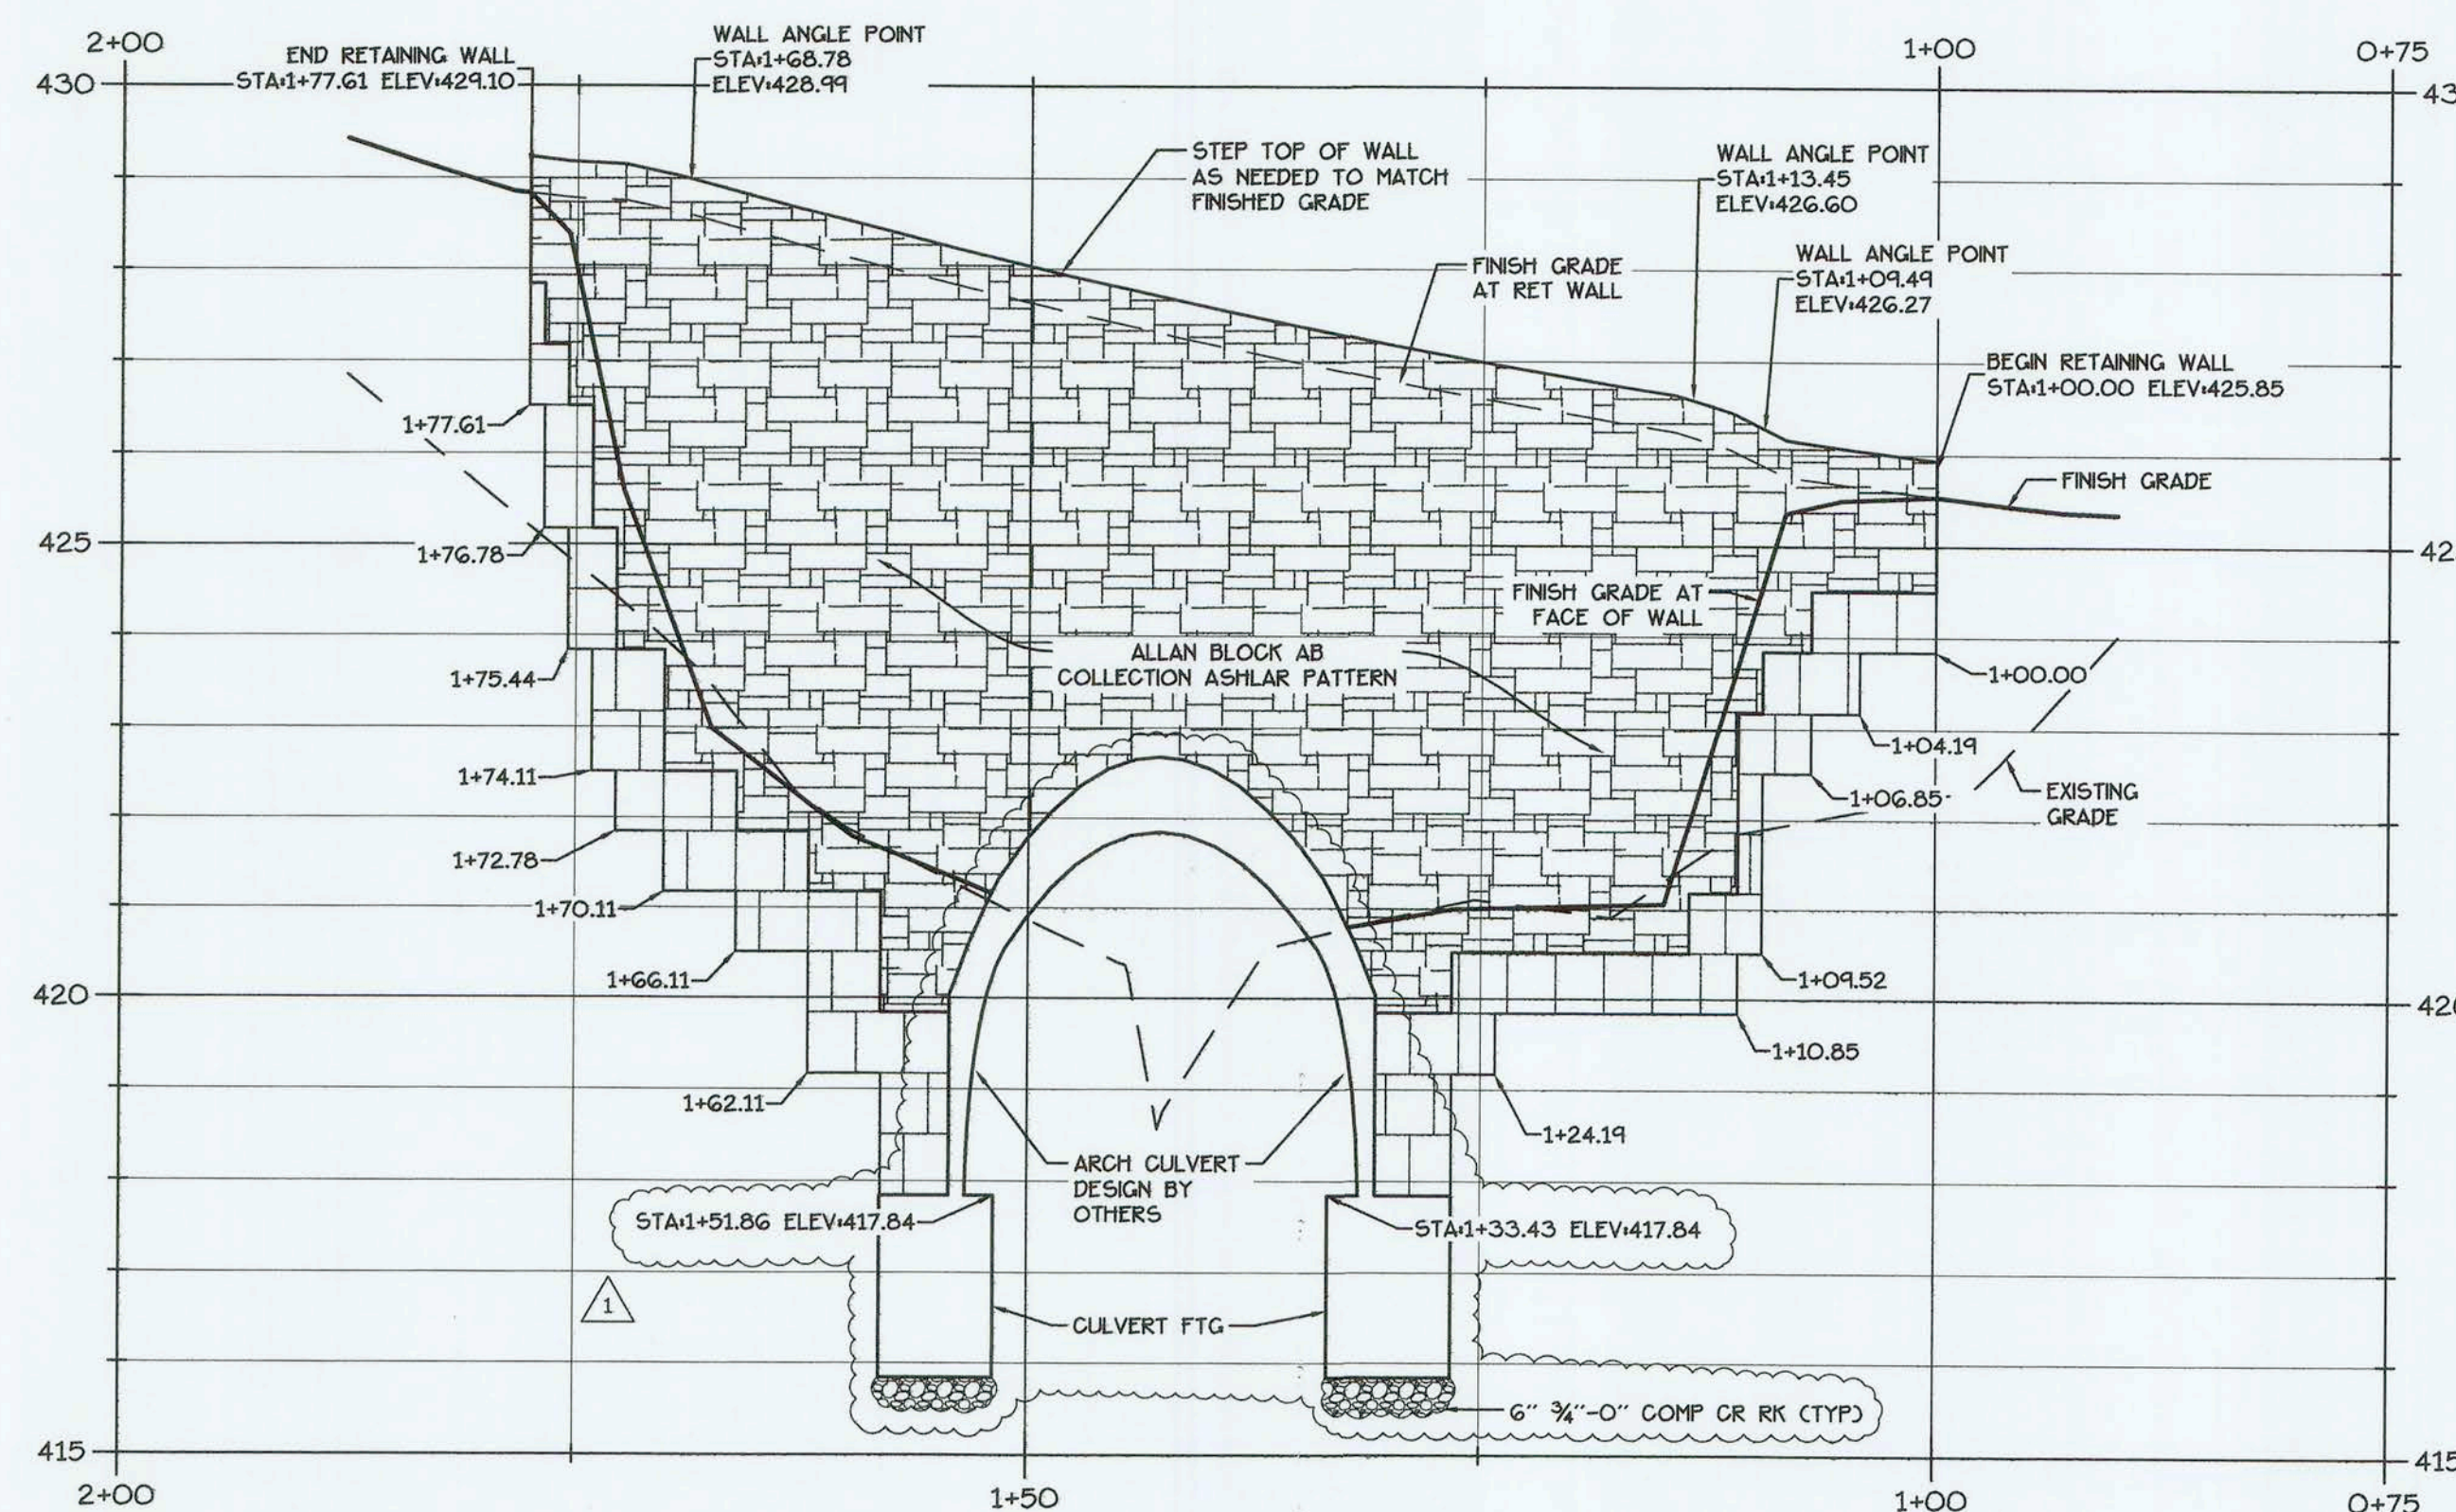


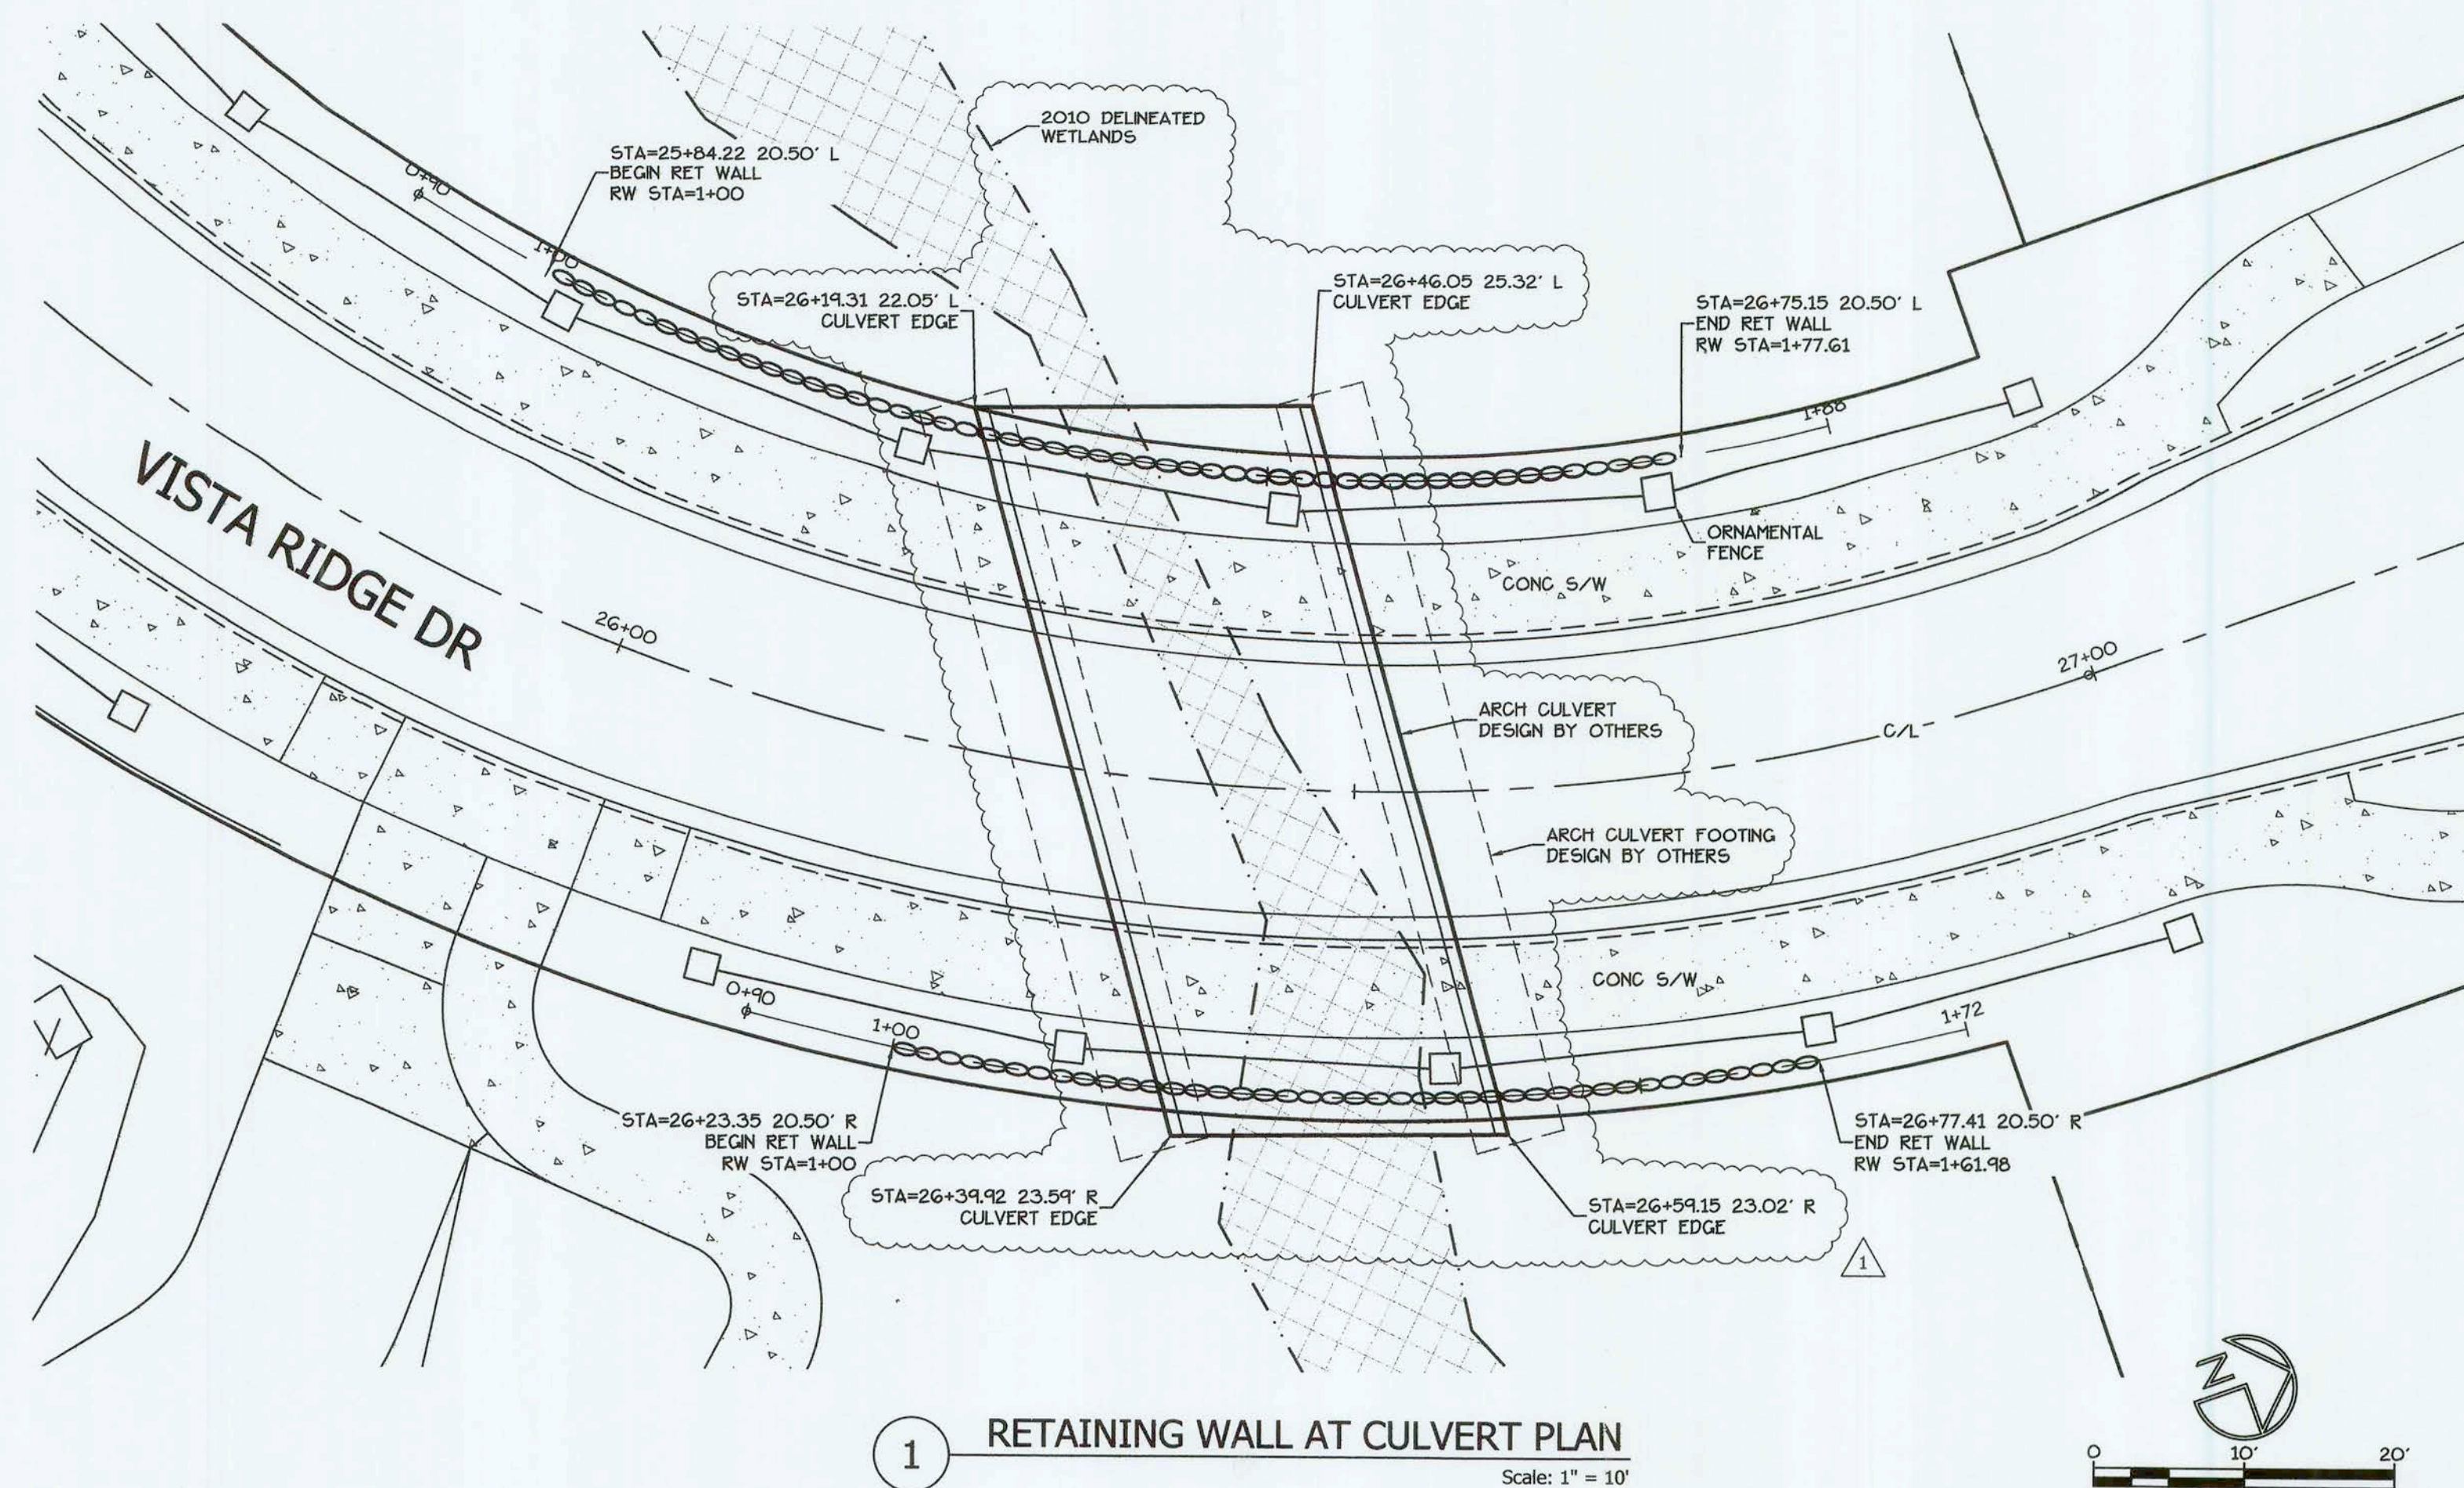

- NOTES:
1. BLOCK WALL FOOTING STEPS 7 7/8" AS SHOWN HEREON. MAINTAIN BURY DEPTH AS REQUIRED BY THE GEOTECHNICAL ENGINEER.
 2. SEE GEOTECHNICAL ENGINEERING REPORT BY GEOPACIFIC DATED 4/14/2011 FOR STRUCTURAL DESIGN OF RETAINING WALL.
 3. SEE SHEETS C3.2 - C3.4 FOR DETAILED GRADING AND EROSION CONTROL.

APPROVED FOR CONSTRUCTION BY
CITY OF WEST LINN
This approval is only for general conformance with the design concept and general compliance with applicable codes and requirements and shall not be construed as relieving the Design Engineer of full responsibility for accuracy and completeness of the drawings. This plan review approval does not prevent the City from requiring further code corrections.
DATE: 9-6-11 BY: *[Signature]* ENGINEERING
DATE: 7-6-11 BY: *[Signature]* PLANNING

DESIGN GROUP
901 N. Brutscher, Ste. 202
Newberg, Oregon 97132
Phone: 503-537-9347
www.thesaunderscompany.net

REGISTERED PROFESSIONAL
ENGINEER
60644PE
OREGON
SEPT. 14, 1988
CHARLES EDWARD GREGG
RENEWS: JUNE 30, 2012

J.T. SMITH
companies
jt

Teresa's Vineyard
Public Improvements
Sub-07-02/NDW-07-02/VAR-07-01
West Linn, Oregon

REV	DATE	SUMMARY
1	8/5/11	Client/Agency Comments

Project #: 9130 Drawn: CL

**ARCH CULVERT
RETAINING WALL
PLAN & PROFILE**
Date: April 15, 2011

C3.6