



**DESIGN GROUP**  
 901 N. Brutscher, Ste. 202  
 Newberg, Oregon 97132  
 Phone: 503-537-9347  
 www.thesaunderscompany.net

REGISTERED PROFESSIONAL  
 ENGINEER  
 50844PE  
 OREGON  
 SEPT. 14, 1998  
 CHARLES EDWARD GREGORY  
 RENEWS: JUNE 30, 2013

J.T. SMITH  
 companies



**Teresa's Vineyard**  
 Public Improvements  
 Sub-07-02/NDW-07-02/VAR-07-01  
 West Linn, Oregon



REV	DATE	SUMMARY
1	8/5/11	Client/Agency Comments
2	8/30/11	Agency Comments
3	9/27/11	Per City Requirements

Project #: 9130 Drawn: CL

**SALAMO ROAD  
 & RE-ROUTED  
 STORM DRAINAGE  
 PLAN & PROFILE**

Date: April 15, 2011

**C4.7**

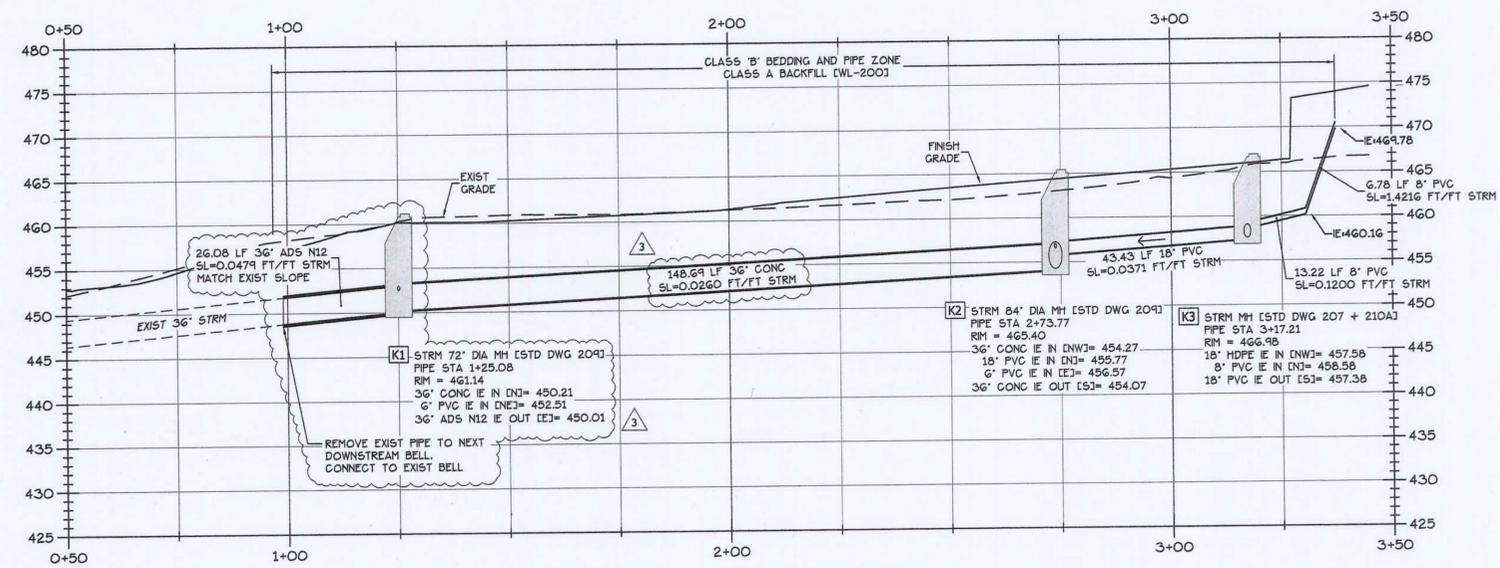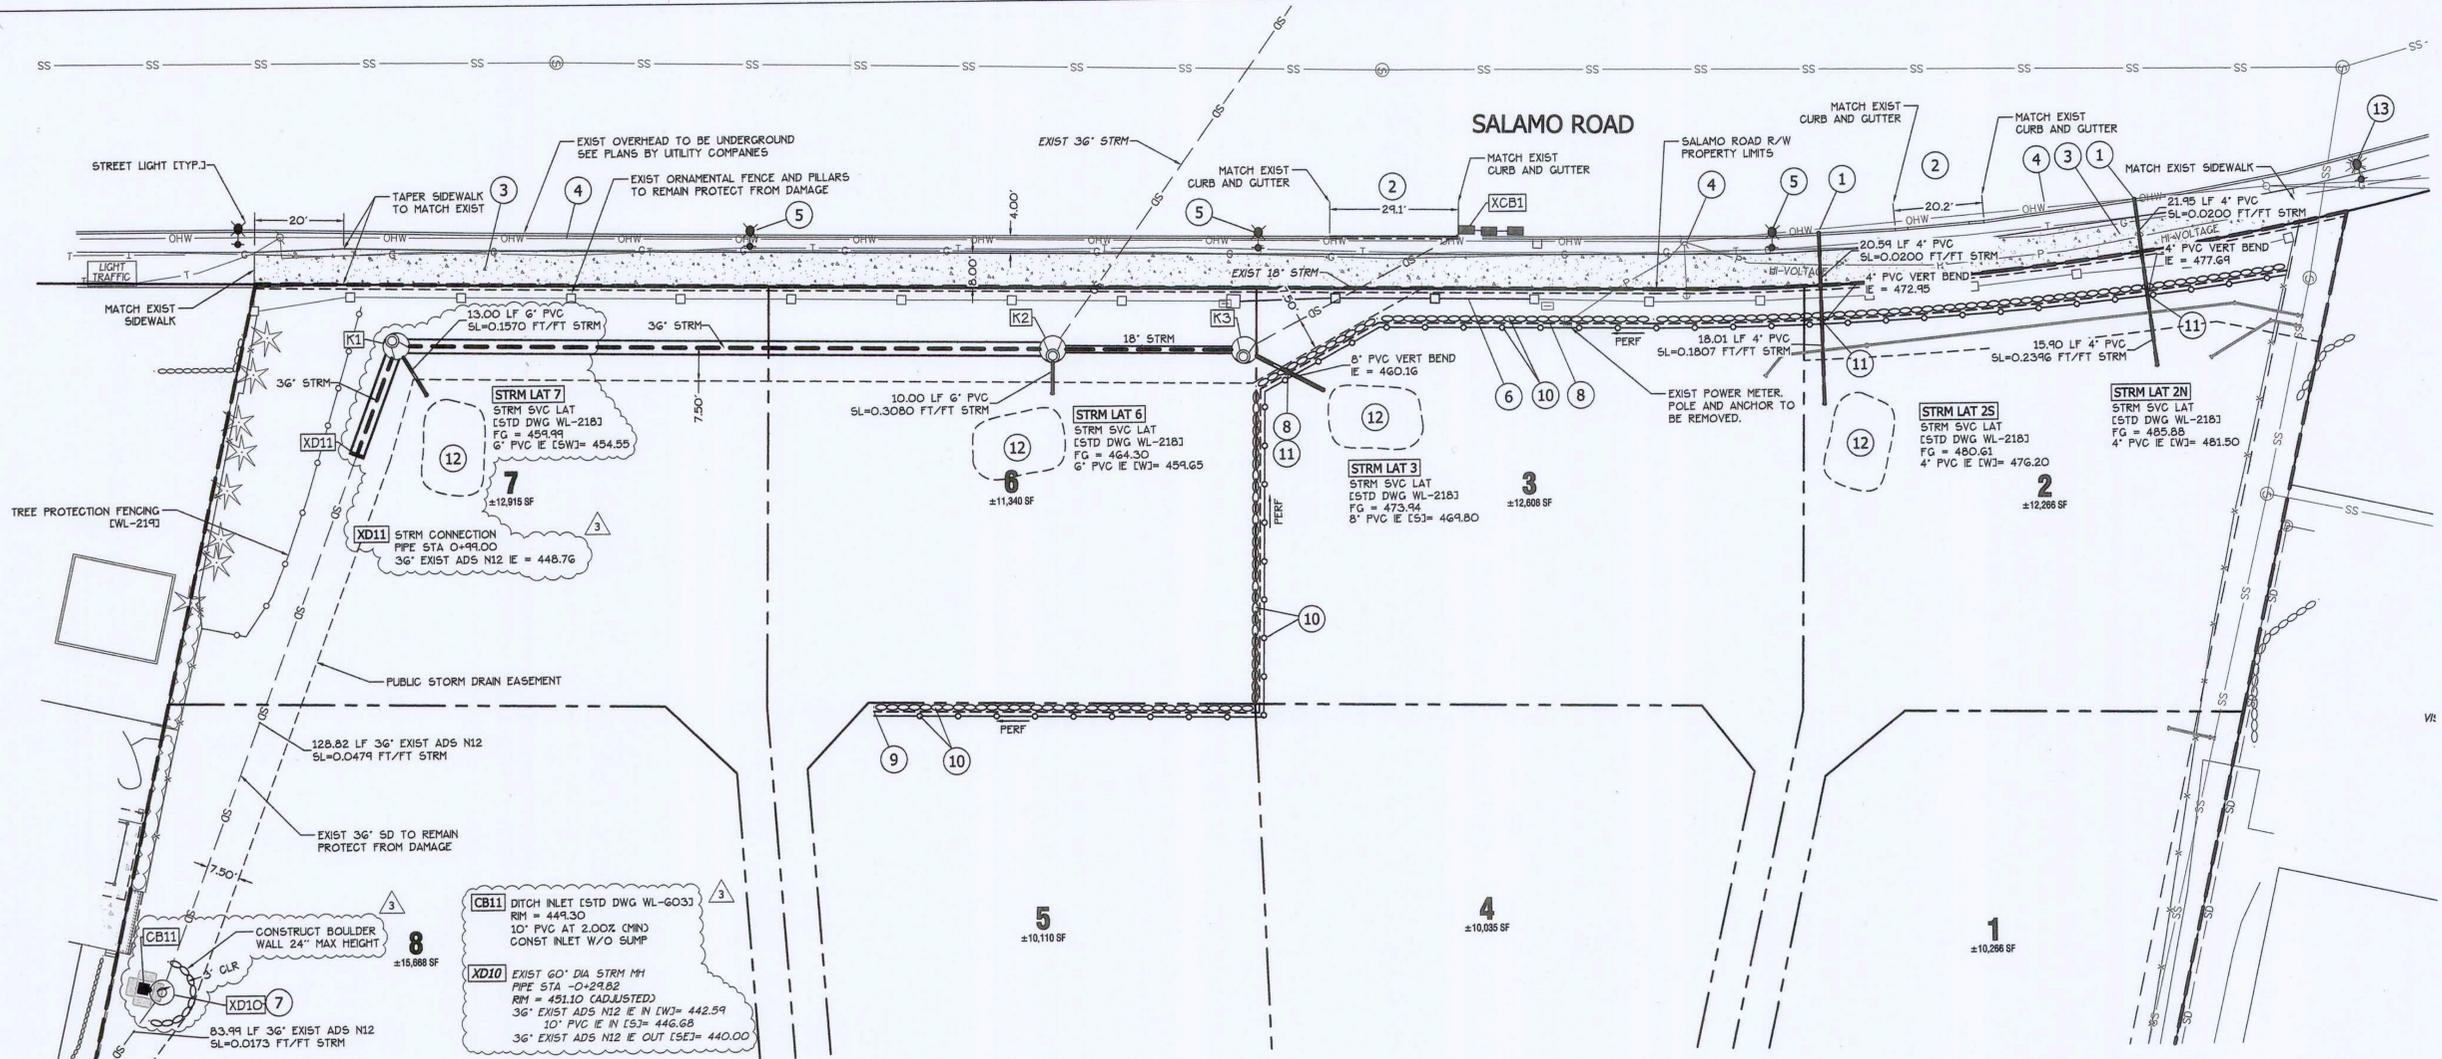

**STORM DRAINAGE RE-ROUTE PROFILE**  
 STA 0+50 - 3+50  
 Horiz: 1"=20' Vert: 1"=10'

- CONSTRUCTION NOTES:**
- SAWCUT EXIST CURB AT CURB FACE. CONSTRUCT NEW WEEP HOLE PER WL-501. INSTALL 4"x3" FERRO-ADAPTOR AT BACK OF CURB. NO STREET CUT SHALL BE ALLOWED IN SALAMO ROAD. CONSTRUCT NEW CURB SHALL BE SET UP FROM BEHIND THE PAVEMENT. MIN. 3' CURB CUT WIDTH.
  - CONSTRUCT NEW CURB AND GUTTER PER WL-501 + WL-505.
  - CONSTRUCT 6' SIDEWALK PER WL-508.
  - EXIST OVERHEAD TO BE UNDERGROUNDED SEE FRANCHISE UTILITY PLANS.
  - INSTALL STREET LIGHT. SEE STREET LIGHTING PLAN.
  - CONSTRUCT NEW ORNAMENTAL FENCING AND BRICK PILLARS. SEE DETAILS 4 AND 5/C.G.S.
  - ADJUST EXIST MANHOLE RIM TO GRADE. INSTALL TAMPER-PROOF LID PER WL-214.
  - CONNECT RETAINING WALL PERF PIPE TO STORM DRAIN.
  - DAYLIGHT RETAINING WALL PERF PIPE SEE SHEET C3.5.
  - CONSTRUCT RETAINING WALL AND FENCE. SEE SHEET C3.5.
  - INSTALL 5' MIN. DIP SLEEVE UNDER RETAINING WALL BLOCKS.
  - FUTURE RAIN GARDEN.
  - REMOVE EXISTING STREET LIGHT AND REPLACE WITH NEW LIGHT. SEE STREET LIGHTING PLAN.
  - REPLACE ANY DAMAGED CURB FACE AS DIRECTED BY CITY ENGINEER. MIN. 3' WIDE REMOVAL SECTIONS.

**APPROVED FOR CONSTRUCTION BY  
 CITY OF WEST LINN**  
 This approval is only for general conformance with the design concept and general compliance with applicable codes and requirements and shall not be construed as relieving the Design Engineer of full responsibility for accuracy and completeness of the drawings. This plan review approval does not prevent the City from requiring further code corrections in the field.  
 DATE: 9/29/11 BY: *Khri Qle*

