




DESIGN GROUP
 901 N. Brutscher, Ste. 202
 Newberg, Oregon 97132
 Phone: 503-537-9347
 www.thesaunderscompany.net



J.T. SMITH
 companies

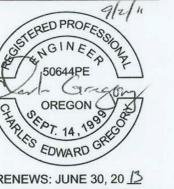

Teresa's Vineyard
 Public Improvements
 Sub-07-02/NDW-07-02/VAR-07-01
 West Linn, Oregon




REV	DATE	SUMMARY
1	8/5/11	Client/Agency Comments
2	8/30/11	Agency Comments

Project #: 9130 Drawn: CL

**COEUR D'ALENE DR
 SANITARY SEWER
 & WATER
 PLAN & PROFILE**

Date: April 15, 2011

C5.1

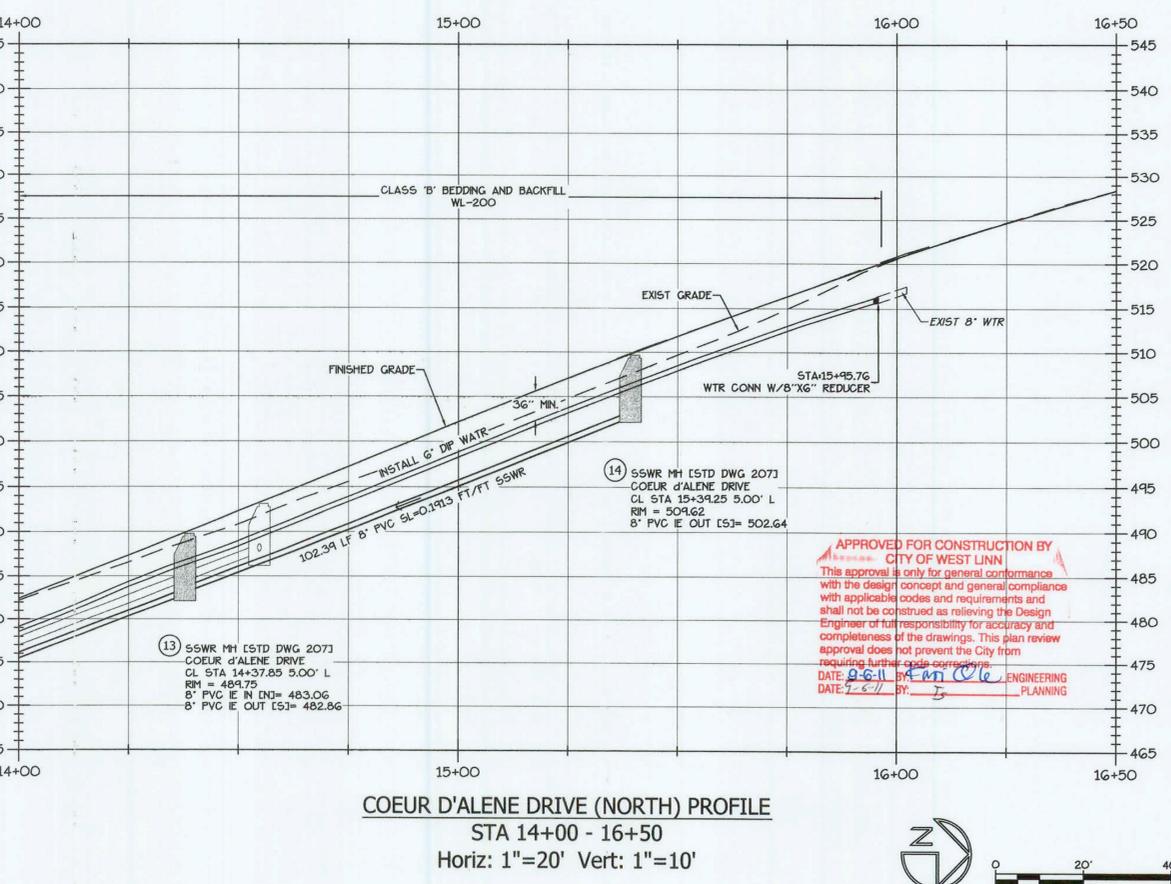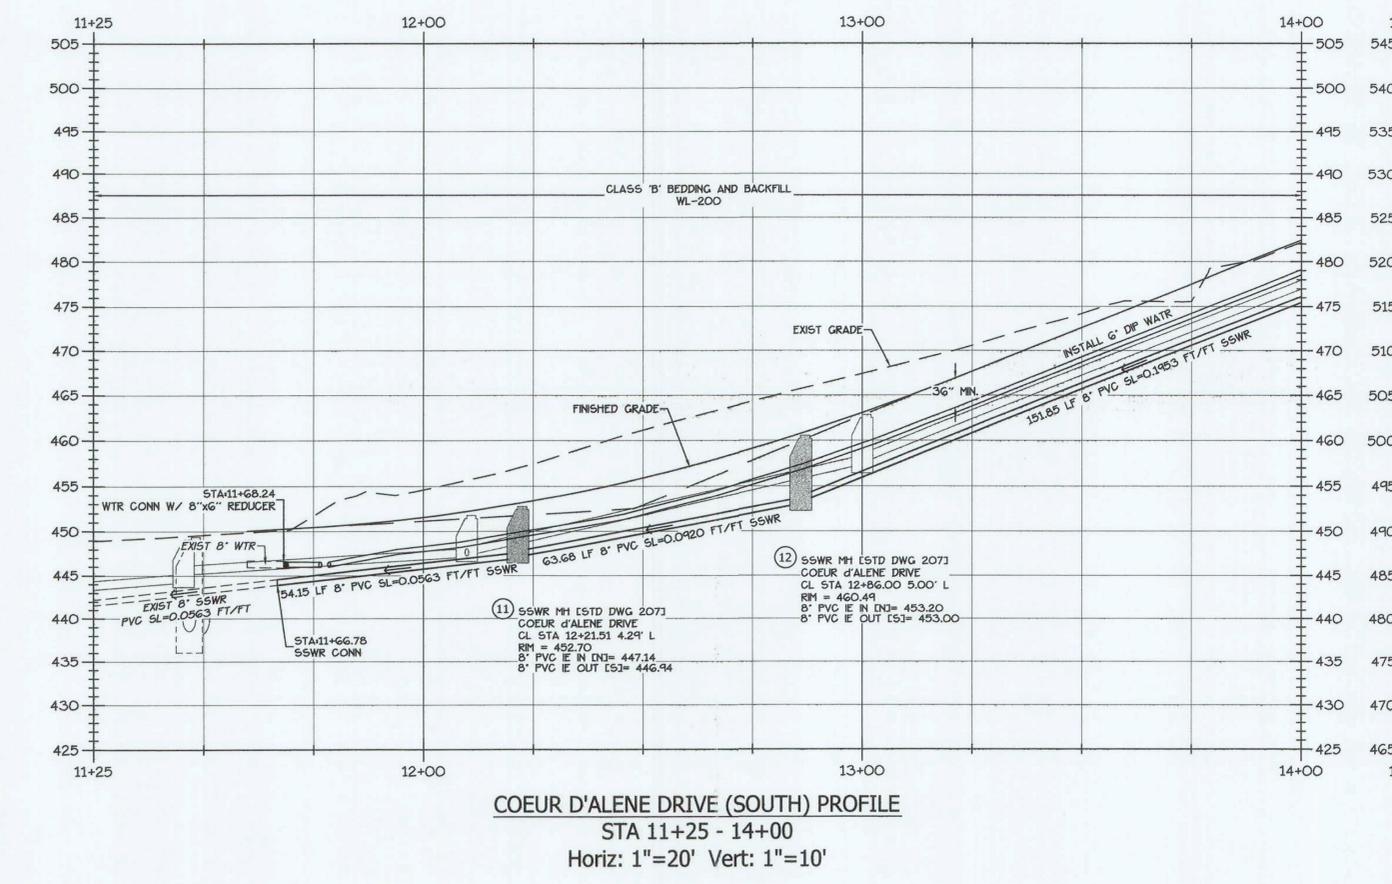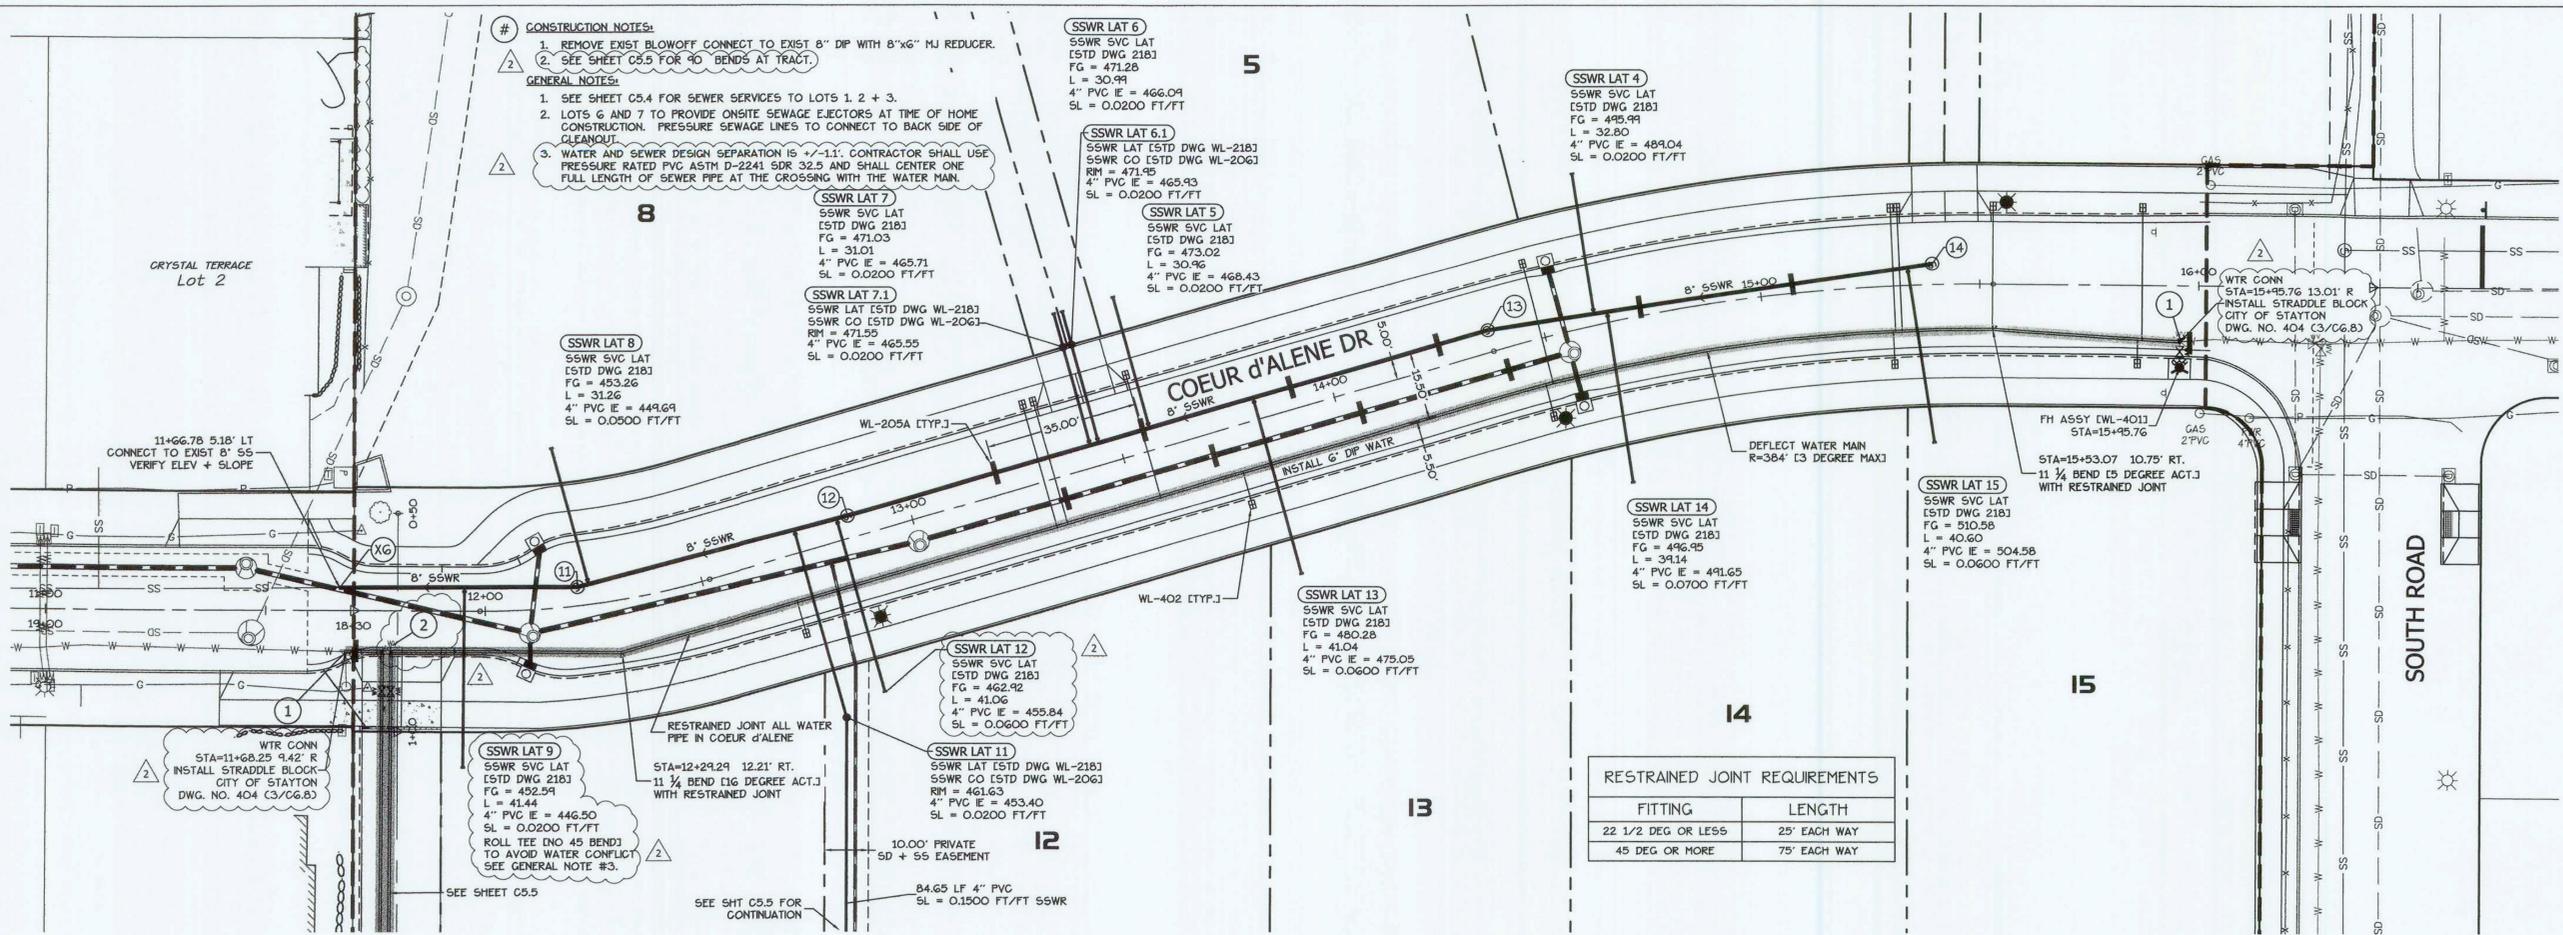

APPROVED FOR CONSTRUCTION BY
 CITY OF WEST LINN
 This approval is only for general conformance with the design concept and general compliance with applicable codes and requirements and shall not be construed as relieving the Design Engineer of full responsibility for accuracy and completeness of the drawings. This plan review approval does not prevent the City from requiring further design corrections.
 DATE: 8-6-11 BY: [Signature] ENGINEERING
 DATE: 9-6-11 BY: [Signature] PLANNING

