




**DESIGN GROUP**  
 901 N. Brutscher, Ste. 202  
 Newberg, Oregon 97132  
 Phone: 503-537-9347  
 www.thesaunderscompany.net



RENEWS: JUNE 30, 2013

**J.T. SMITH**  
 companies

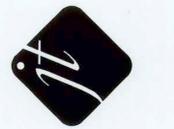

**Teresa's Vineyard**  
 Public Improvements  
 Sub-07-02/NDW-07-02/NAR-07-01  
 West Linn, Oregon




REV	DATE	SUMMARY
1	8/5/11	Client/Agency Comments
2	8/30/11	Agency Comments

Project #: 9130 Drawn: CL

**VISTA RIDGE DR (N)  
 SANITARY SEWER  
 & WATER  
 PLAN & PROFILE**

Date: April 15, 2011

**C5.3**

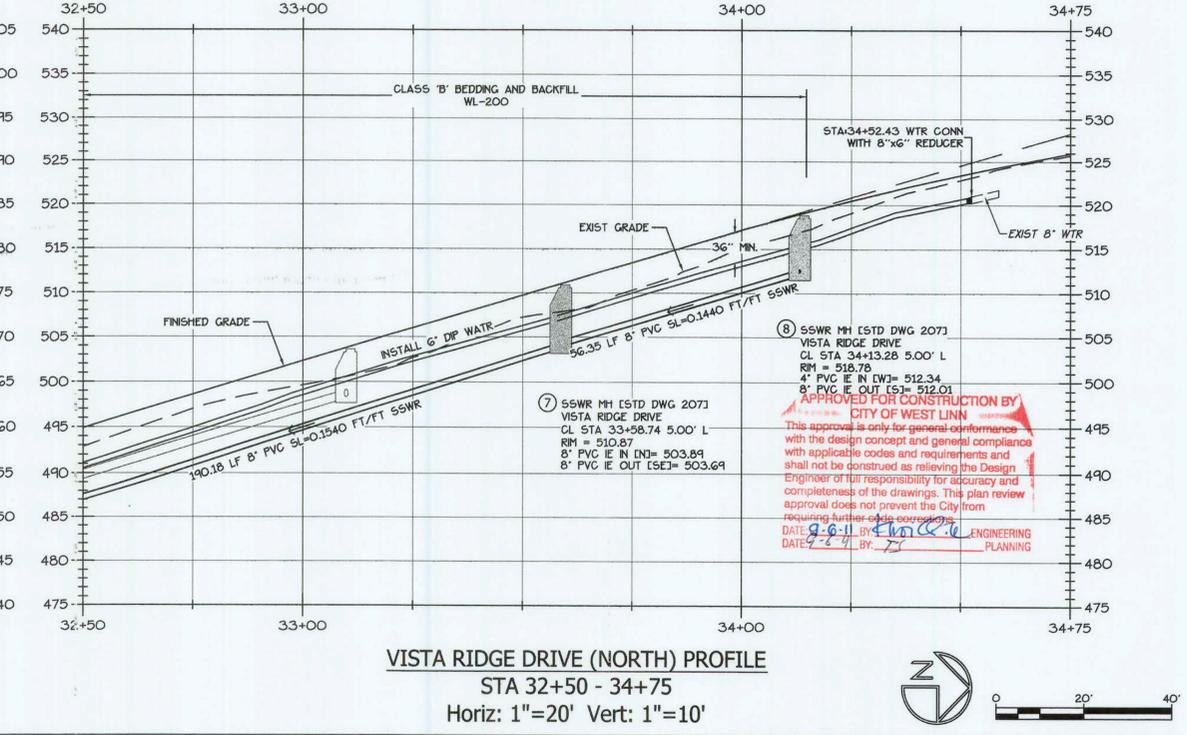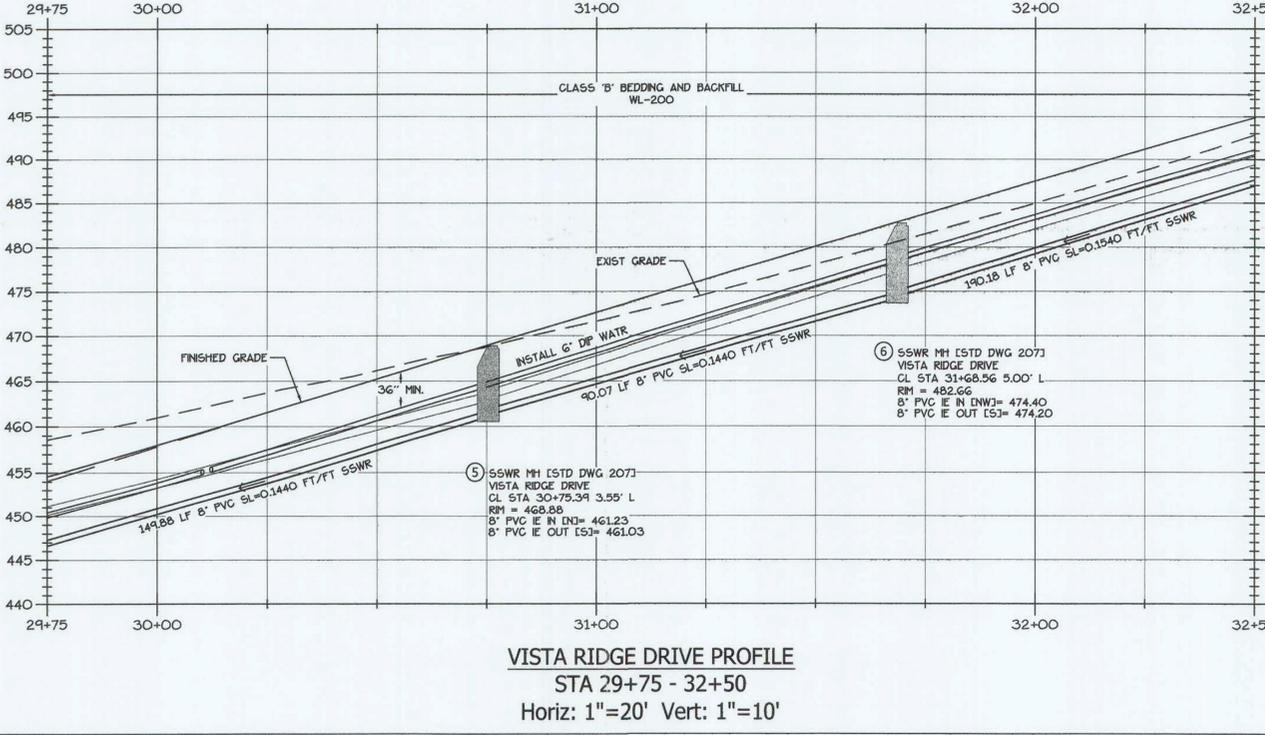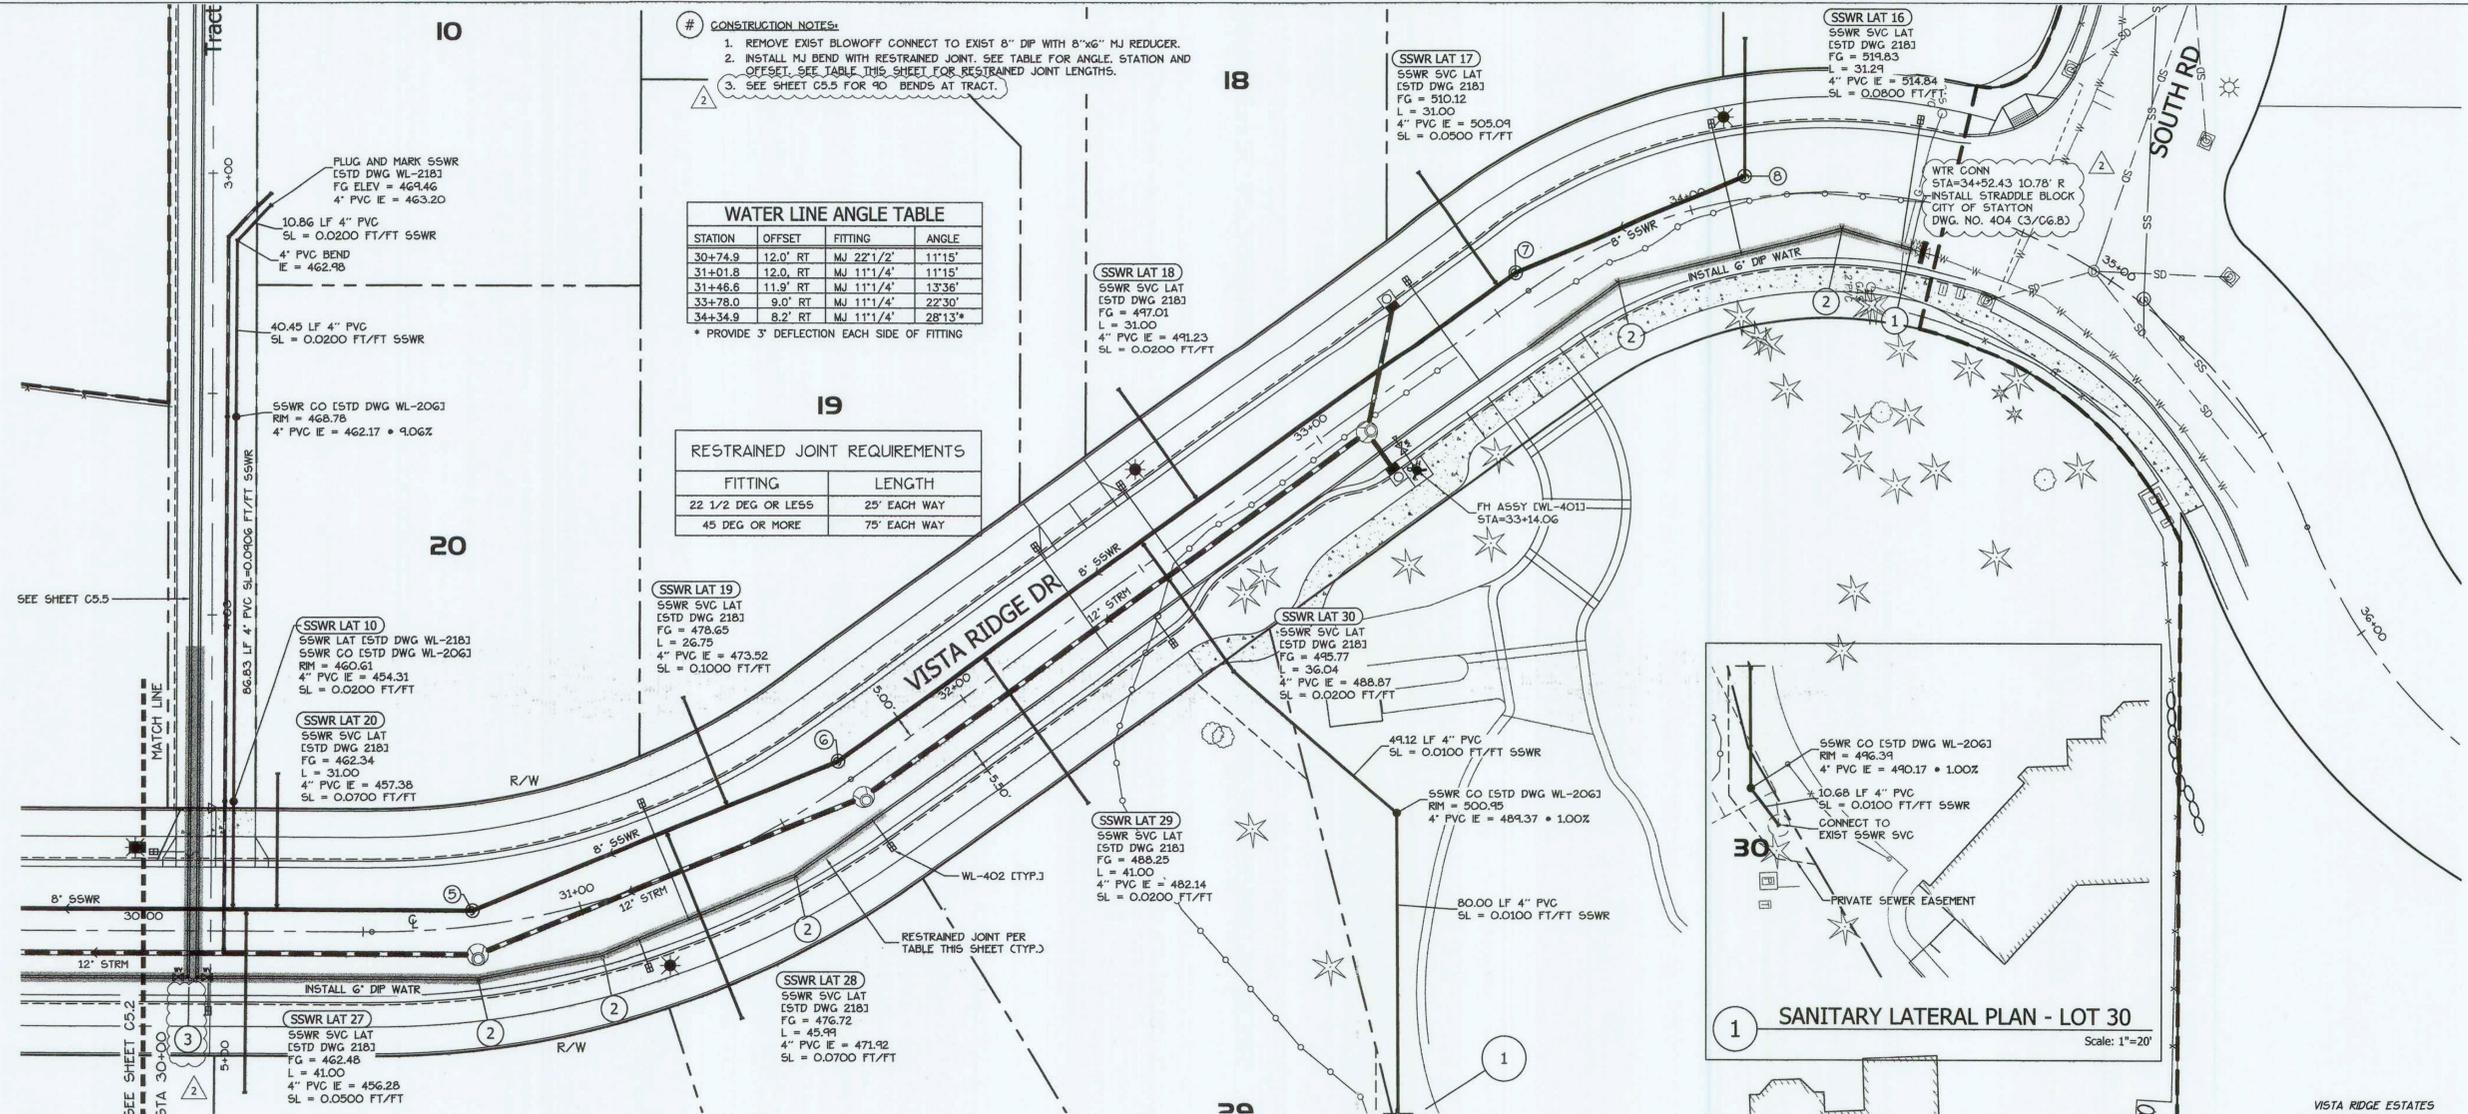

\\SERVER1\land\Projects\9130\ENGINEERING\Construction Documents\Drawings\Permit Submittal\9130-SSWR-WATR-PROFILES.dwg, 9/1/2011 4:16:01 PM, The Saunders Company