




1 SANITARY CONNECTION & EXTENSION PLAN  
Scale: 1"=20'

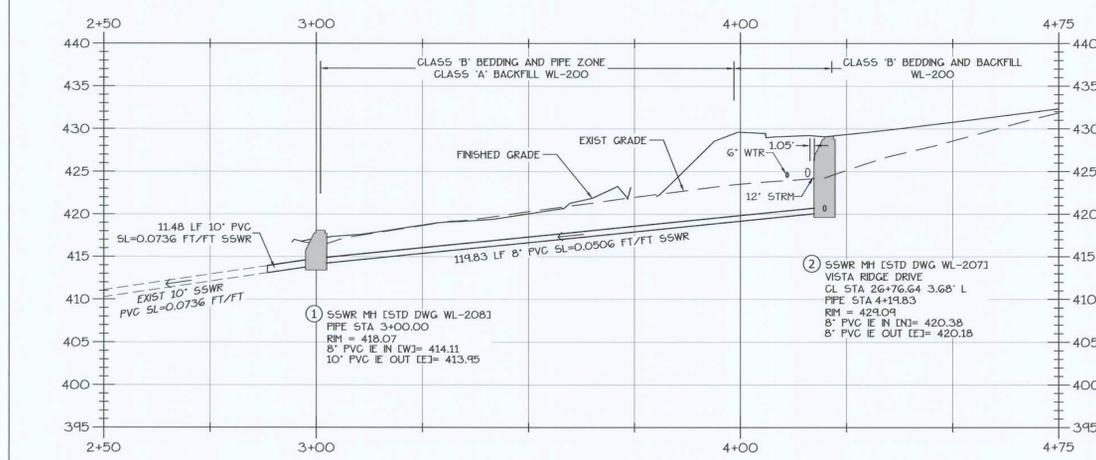

SANITARY SEWER CONNECTION PROFILE  
STA 2+50 - 4+75  
Horiz: 1"=20' Vert: 1"=10'

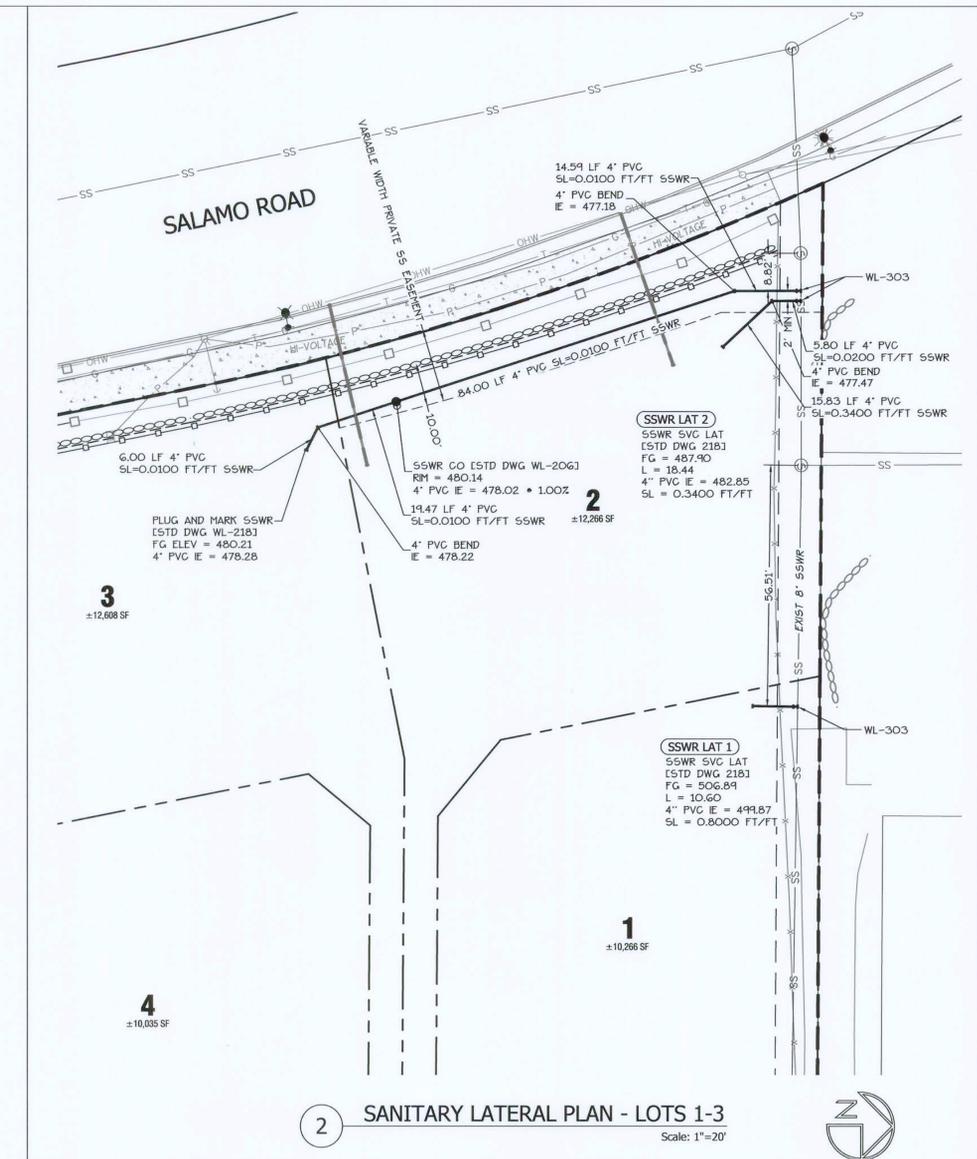

2 SANITARY LATERAL PLAN - LOTS 1-3  
Scale: 1"=20'

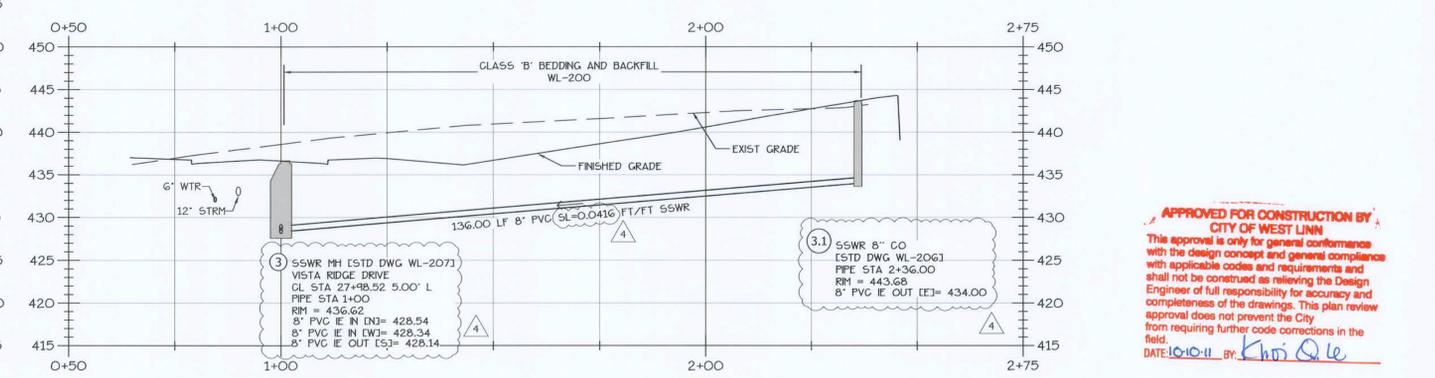

SANITARY SEWER EXTENSION PROFILE  
STA 0+50 - 2+75  
Horiz: 1"=20' Vert: 1"=10'

**APPROVED FOR CONSTRUCTION BY:**  
CITY OF WEST LINN  
This approval is only for general conformance with the design concept and general compliance with applicable codes and requirements and shall not be construed as relieving the Design Engineer of full responsibility for accuracy and completeness of the drawings. This plan review approval does not prevent the City from requiring further code corrections in the field.  
DATE: 10-01-11 BY: *Chris O'Leary*

**DESIGN GROUP**  
901 N. Brutscher, Ste. 202  
Newberg, Oregon 97132  
Phone: 503-537-9347  
www.thesaunderscompany.net

REGISTERED PROFESSIONAL ENGINEER  
50844PE  
OREGON  
SEPT. 14, 1999  
CHARLES EDWARD GREGORY  
RENEWS: JUNE 30, 20\_\_

J.T. SMITH  
companies  
it

**Teresa's Vineyard**  
Public Improvements  
Sub-07-02/NDW-07-02/VAR-07-01  
West Linn, Oregon

REV	DATE	SUMMARY
1	8/5/11	Client/Agency Comments
2	8/30/11	Agency Comments
4	10/10/11	Draw revision per Client

Project #: 9130 Drawn: CL

SANITARY SEWER  
EXTENSION &  
CONNECTION  
PLAN & PROFILE

Date: April 15, 2011

C5.4