



**DESIGN GROUP**  
 901 N. Brutscher, Ste. 202  
 Newberg, Oregon 97132  
 Phone: 503-537-9347  
 www.thesaunderscompany.net



RENEWS: JUNE 30, 2013

**J.T. SMITH**  
 companies



**Teresa's Vineyard**  
 Public Improvements  
 Sub-07-02/NDW-07-02/VAR-07-01  
 West Linn, Oregon

REV	DATE	SUMMARY
1	8/5/11	Client/Agency Comments
2	8/30/11	Agency Comments


Project #: 9130 Drawn: CL

**TRACT 4**  
**WATER LINE &**  
**ACCESS ROAD**  
**PLAN & PROFILE**

Date: April 15, 2011




**C5.5**

- # CONSTRUCTION NOTES:
1. INSTALL 6" FLXFLG 90 DEGREE BEND WITH RESTRAINED JOINT  
 6" FLXFLG G.V. EWL-411J  
 SEE RESTRAINED JOINT TABLE THIS SHEET. SEE DETAIL 2/C5.5.
  2. REMOVE EXISTING LANDSCAPING AND RETAINING WALLS. RE-LANDSCAPE TO OWNER'S SATISFACTION.
  3. INSTALL 18 LF OF TRENCH DRAIN AT BACK OF WALK.

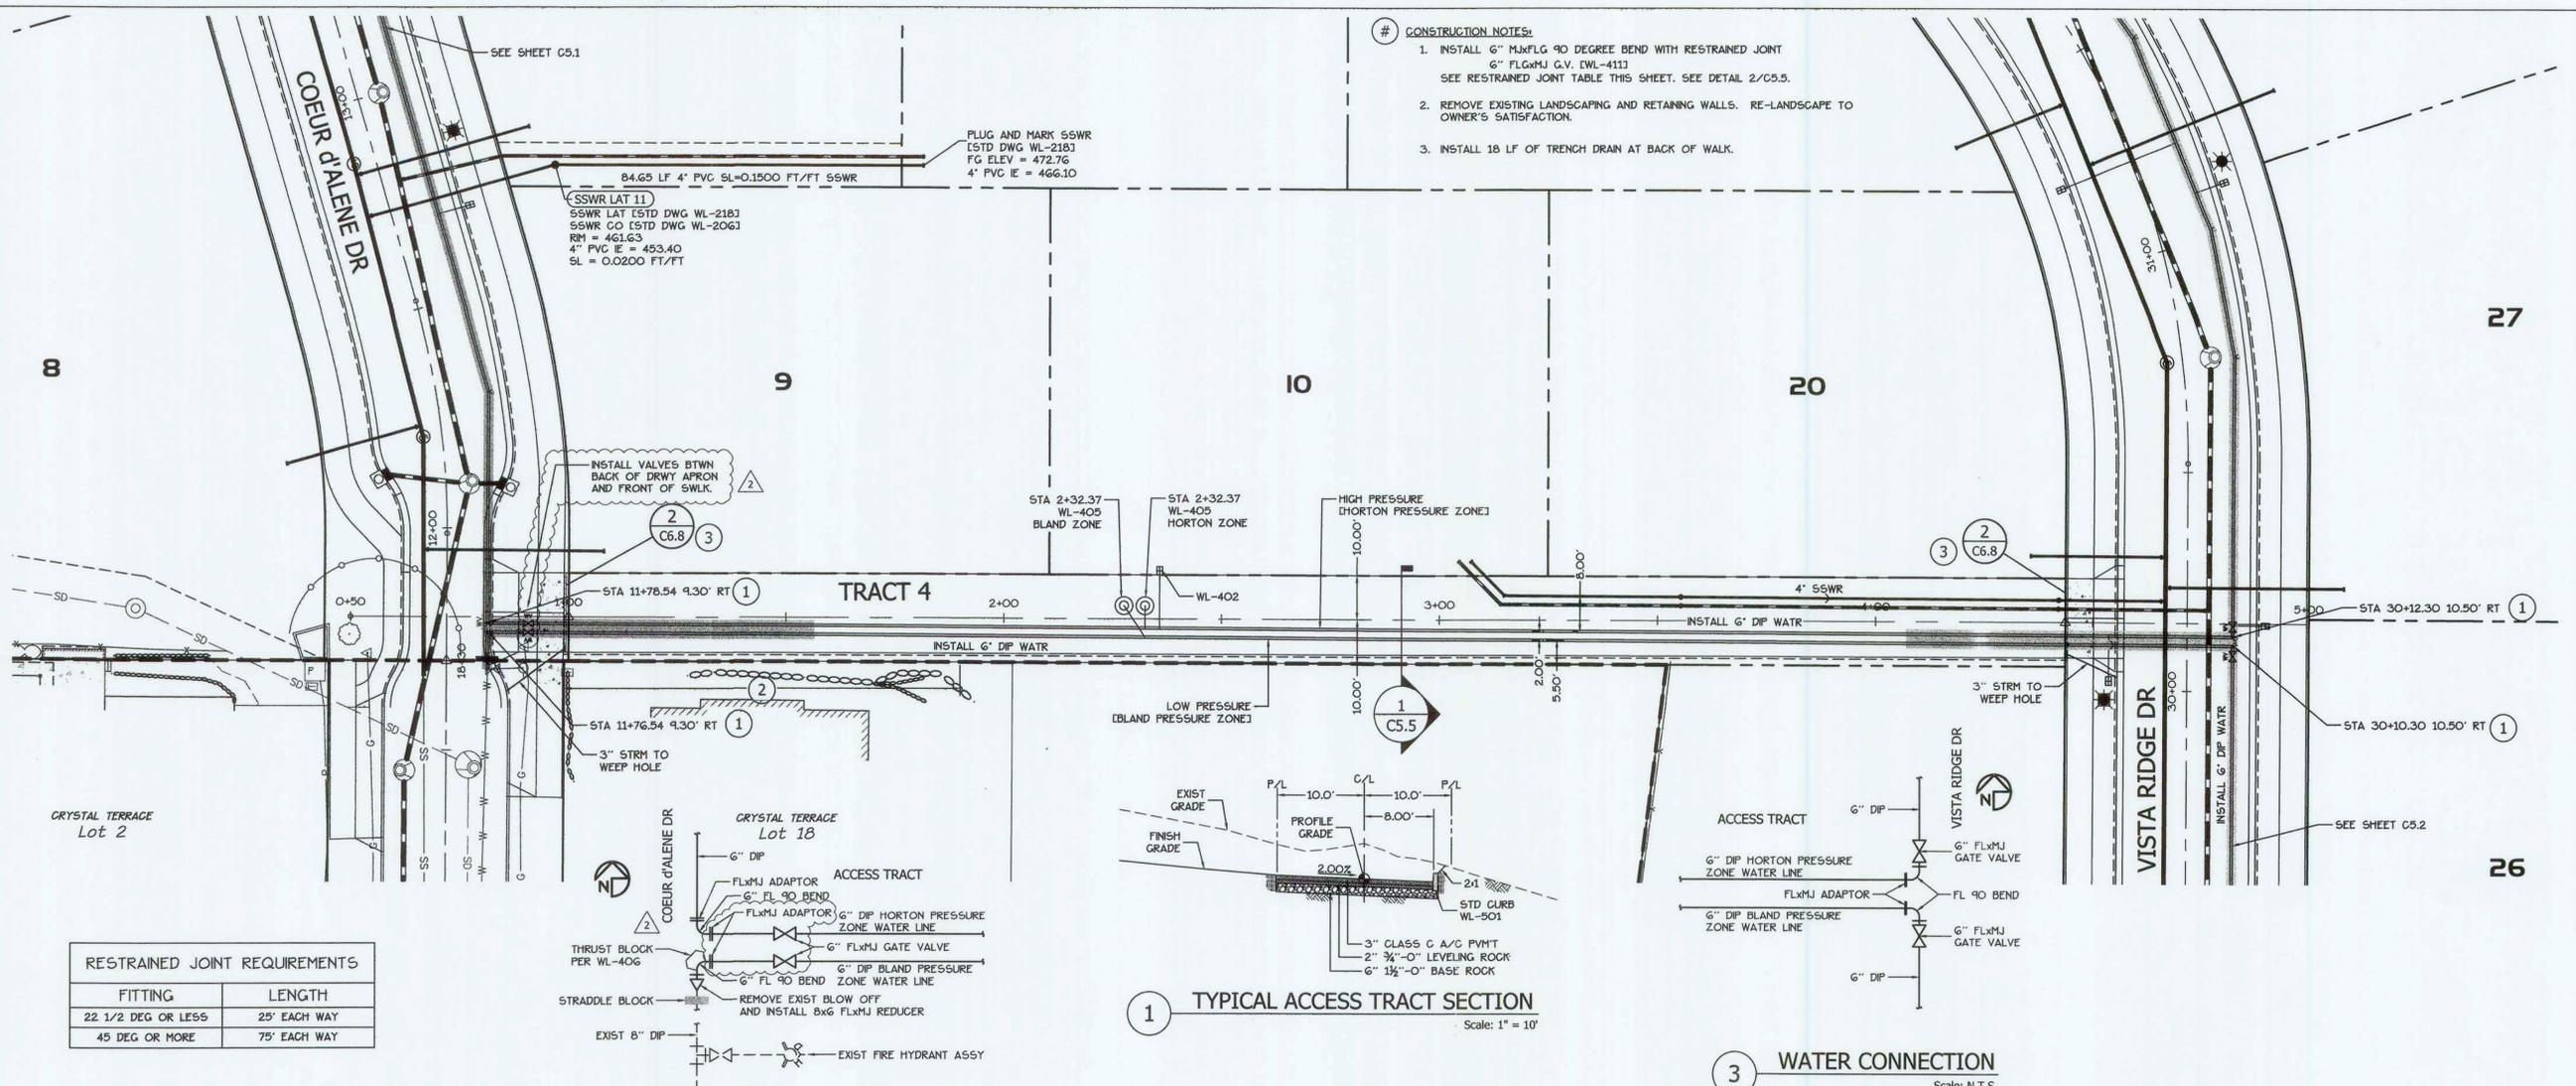

**RESTRAINED JOINT REQUIREMENTS**

FITTING	LENGTH
22 1/2 DEG OR LESS	25' EACH WAY
45 DEG OR MORE	75' EACH WAY

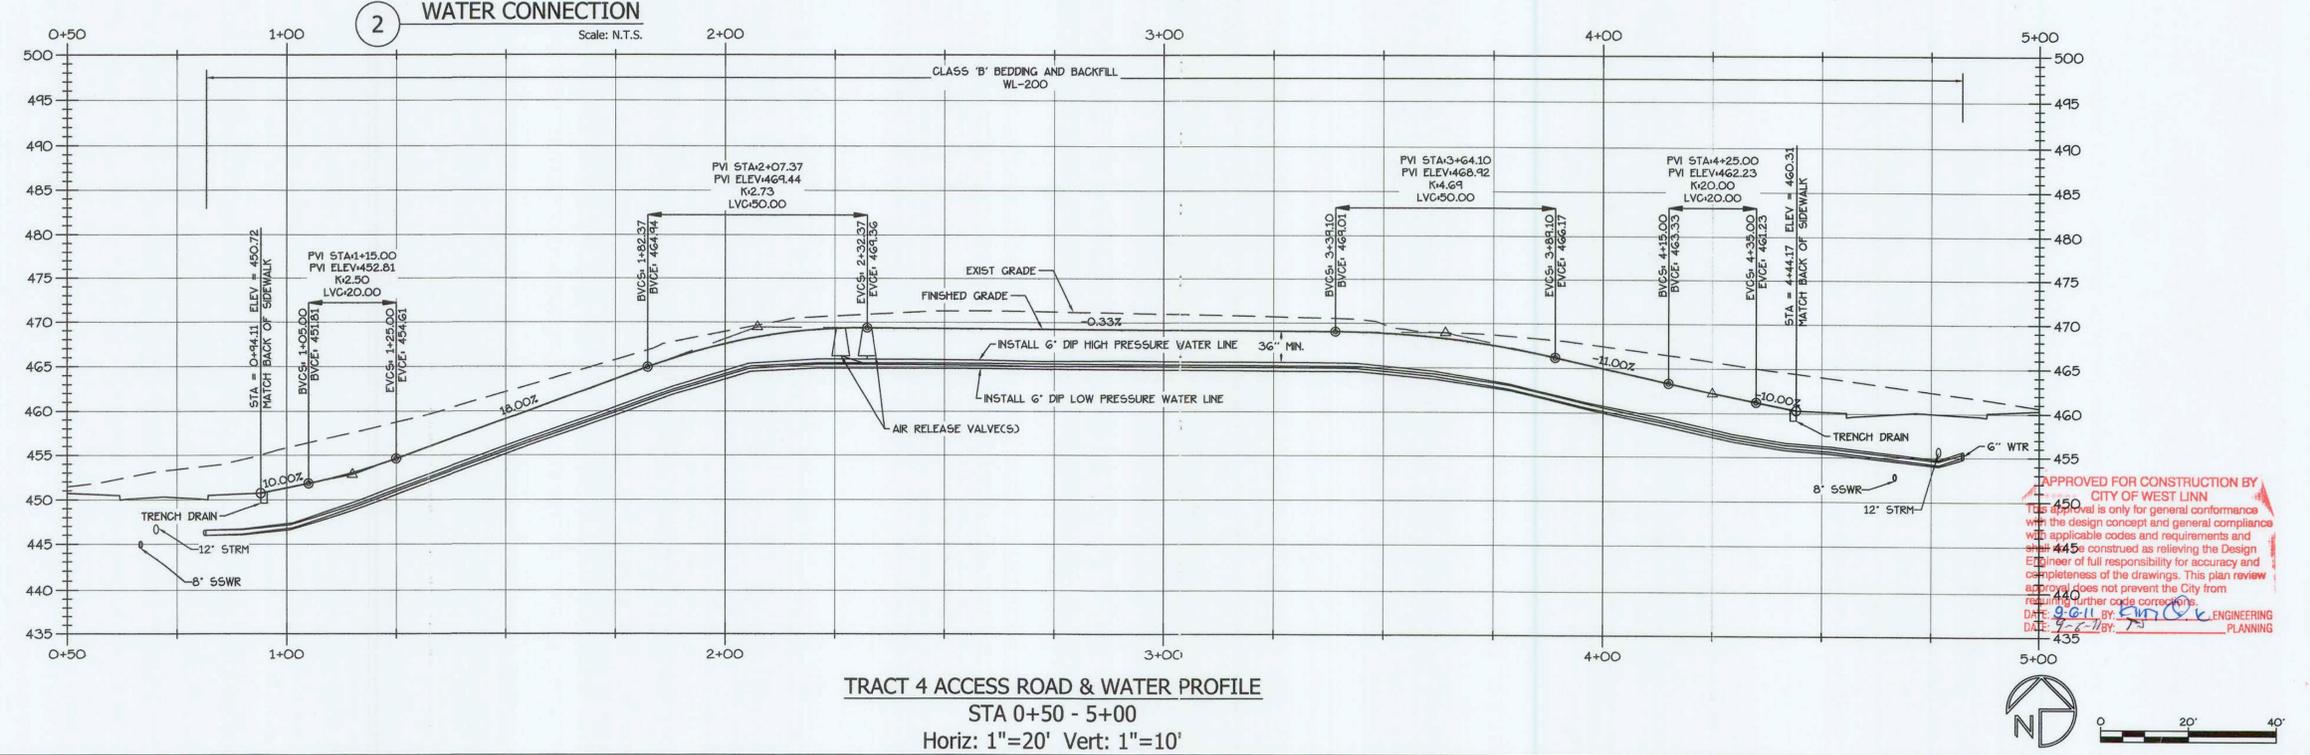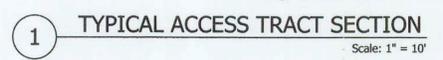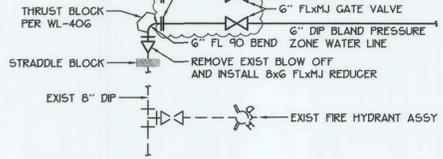

APPROVED FOR CONSTRUCTION BY  
**450** CITY OF WEST LINN  
 This approval is only for general conformance with the design concept and general compliance with applicable codes and requirements and shall not be construed as relieving the Design Engineer of full responsibility for accuracy and completeness of the drawings. This plan review approval does not prevent the City from enforcing other code corrections.  
 DATE: 8/2/11 BY: [Signature] ENGINEERING  
 DATE: 8/2/11 BY: [Signature] PLANNING

