



ARCHITECTURE • INTERIORS • PLANNING

DULL OLSON WEEKES architects inc.

807 SW STARK STREET, PORTLAND, OR 97204
P: 503 226 8950 F: 503 273 8192 WWW.DOWA.COM

TRILLIUM CREEK PRIMARY SCHOOL

West Linn Wilsonville School District

22210 SW STAFFORD ROAD - WEST LINN, OR 97068

t: (503) 673 7976

f: (503) 673 7044

WINZLER & KELLY

15575 SW SEQUOIA PARKWAY, SUITE 140
PORTLAND, OR 97224
PH (503) 226-3921 • FAX (503) 226-3926
WWW.W-AND-K.COM



EXPIRES 6/30/12

phase CONSTRUCTION SET

date April 6, 2011


revisions

ADD #1 02/23/2011
ADD #0 03/18/2011

project # 09014

UTILITY IMPROVEMENTS


PI4.4

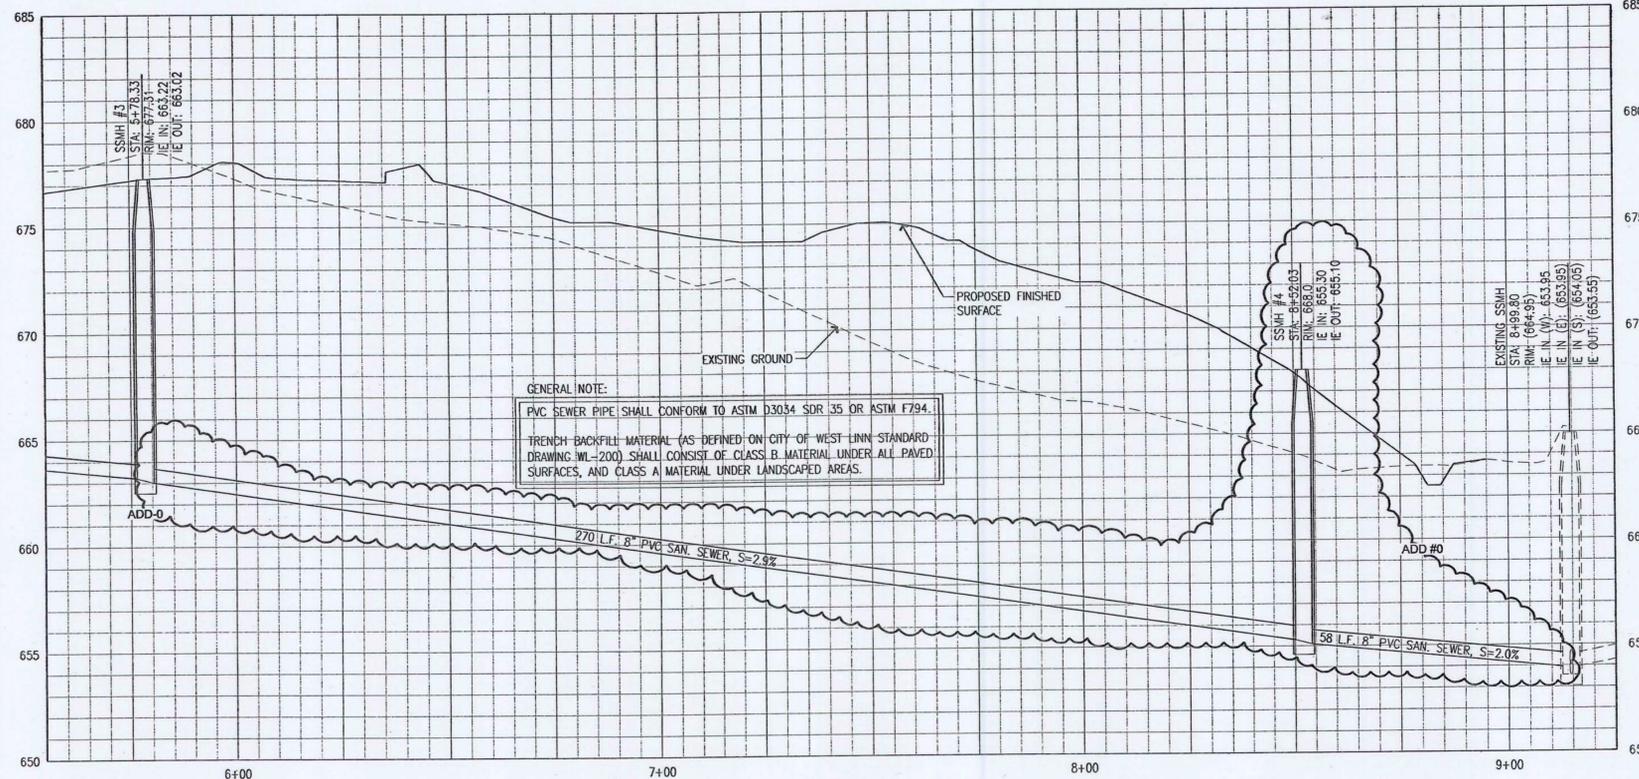


GENERAL NOTE:
PVC SEWER PIPE SHALL CONFORM TO ASTM D3034 SDR 35 OR ASTM F794.
TRENCH BACKFILL MATERIAL (AS DEFINED ON CITY OF WEST LINN STANDARD DRAWING WL-200) SHALL CONSIST OF CLASS B MATERIAL UNDER ALL PAVED SURFACES, AND CLASS A MATERIAL UNDER LANDSCAPED AREAS.

CONSTRUCTION NOTES

- 1 INSTALL 8" PVC SAN. SEWER PIPE PER CITY OF WEST LINN STANDARD DRAWING WL-200.
- 2 INSTALL STANDARD SAN. SEWER MANHOLE PER CITY OF WEST LINN STANDARD DRAWING WL-207.
- 3 CONNECT EXISTING SAN. SEWER PIPE TO NEW MANHOLE USING FLEXIBLE CONNECTOR PER CITY OF WEST LINN STANDARD DRAWING WL-212. CONTRACTOR TO CONFIRM EXACT LOCATION OF EXISTING LINE (HORIZONTAL AND VERTICAL) PRIOR TO CONSTRUCTION AND NOTIFY ENGINEER OF ANY DISCREPANCY BETWEEN WHAT IS SHOWN ON THESE PLANS AND WHAT IS OBSERVED IN FIELD.
- 4 CORE DRILL INTO EXISTING MANHOLE AND CONNECT NEW SAN. SEWER PIPE TO EXISTING MANHOLE USING FLEXIBLE CONNECTOR PER CITY OF WEST LINN STANDARD DRAWING WL-212.

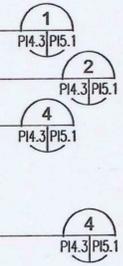

1 PUBLIC SANITARY SEWER - PROFILE
PI4.4/PI4.4 SCALE: H: 1"=20'-0" V: 1"=4'-0"

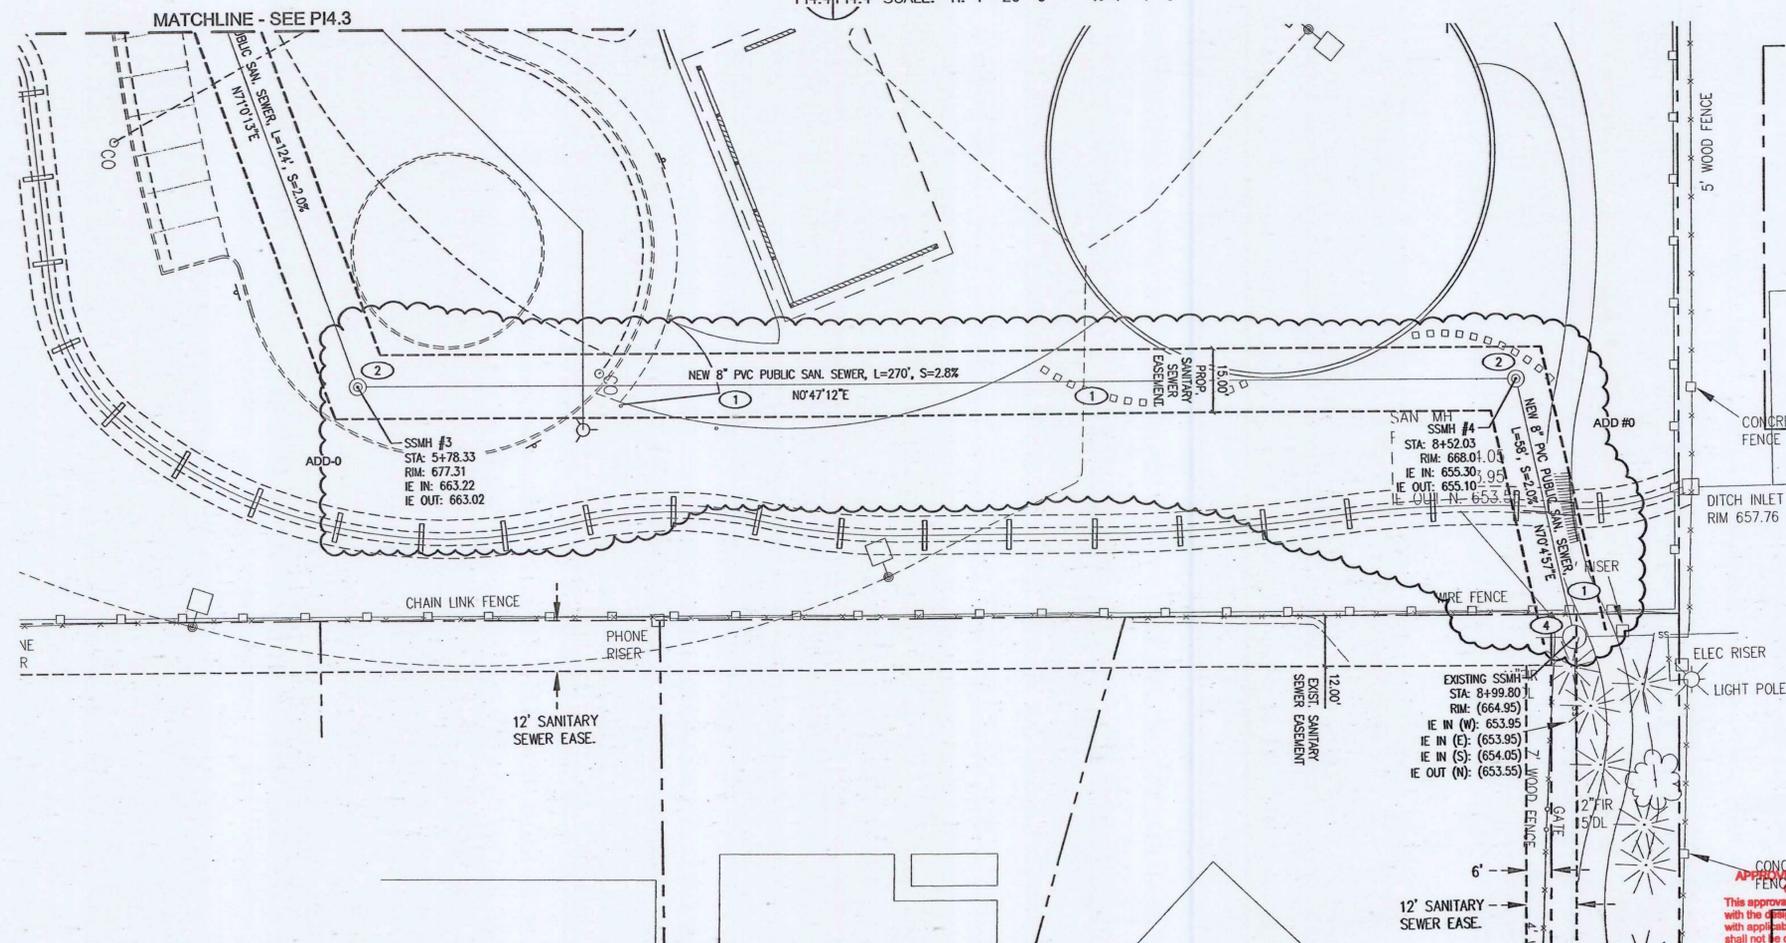

2 PUBLIC SANITARY SEWER - PLAN
PI4.4/PI4.4 SCALE: 1"=20'-0"

NOTE
ALL WORK ON PUBLIC SANITARY SEWER SYSTEM SHOULD CONFORM TO THE CITY OF WEST LINN PUBLIC WORKS STANDARD CONSTRUCTION SPECIFICATIONS AND DETAILS.

NOTE
PRIOR TO DISCONNECTING FROM AND DEMOLISHING EXISTING PUBLIC SANITARY SEWER SYSTEM AND CONNECTING TO NEW SANITARY SEWER SYSTEM, NEW SYSTEM TO BE COMPLETELY INSTALLED, TESTED, AND APPROVED BY CITY INSPECTOR.

APPROVED FOR CONSTRUCTION BY
CITY OF WEST LINN
This approval is only for general conformance with the design concept and general compliance with applicable codes and requirements and shall not be construed as relieving the Design Engineer of full responsibility for accuracy and completeness of the drawings. This plan review approval does not prevent the City Inspector from requiring further code corrections in the field.
DATE: 5-2-11 BY: KWS/PLW ENGINEERING
DATE: _____ BY: _____ PLANNING