





X:\Projects\2009\PO9031-003 (West Linn Erickson Primary School TIS\ACAD\09031\_SN04.dwg

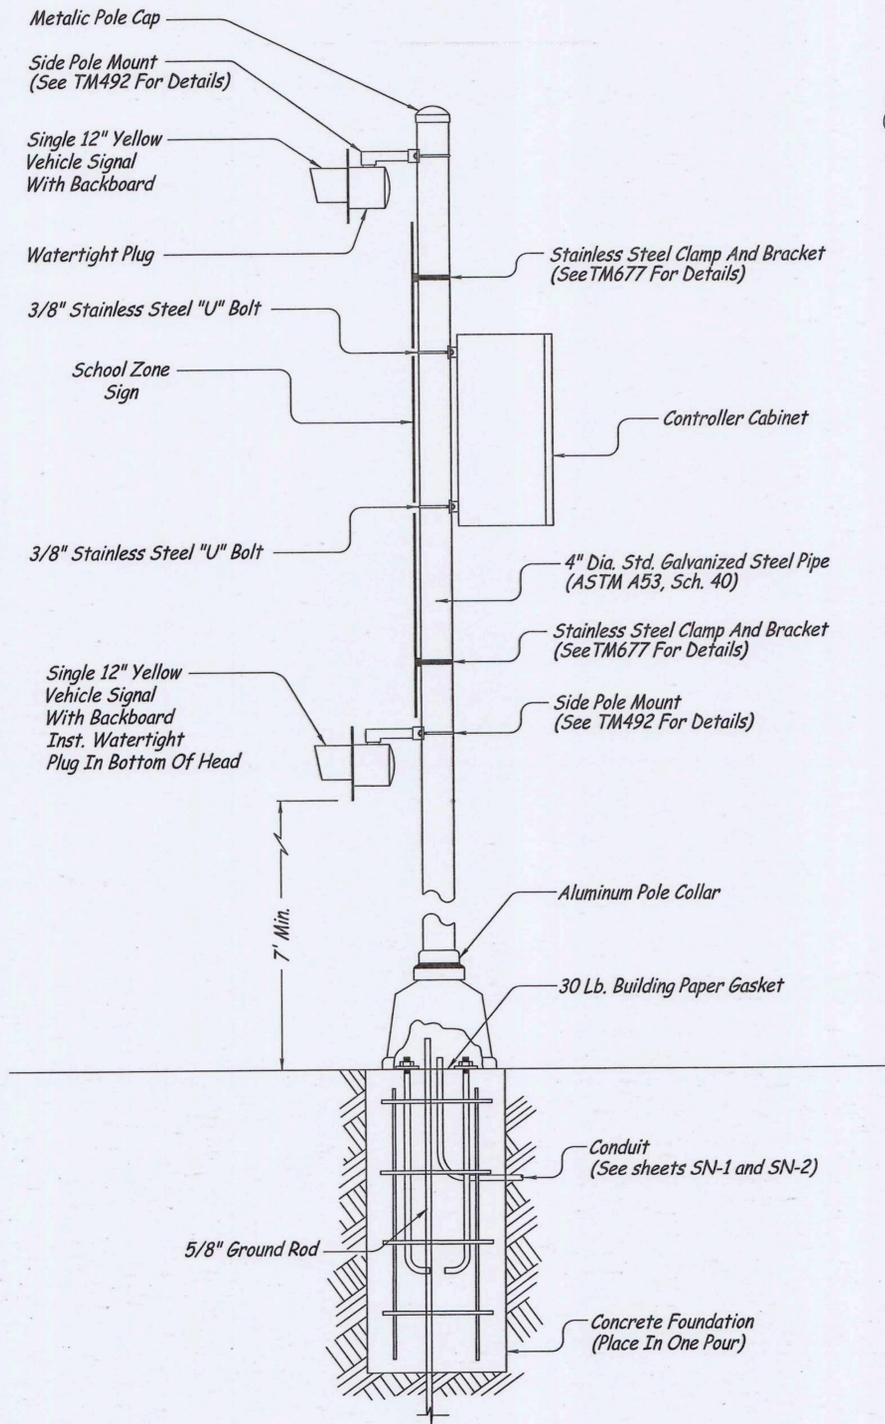

SCHOOL ZONE FLASHER

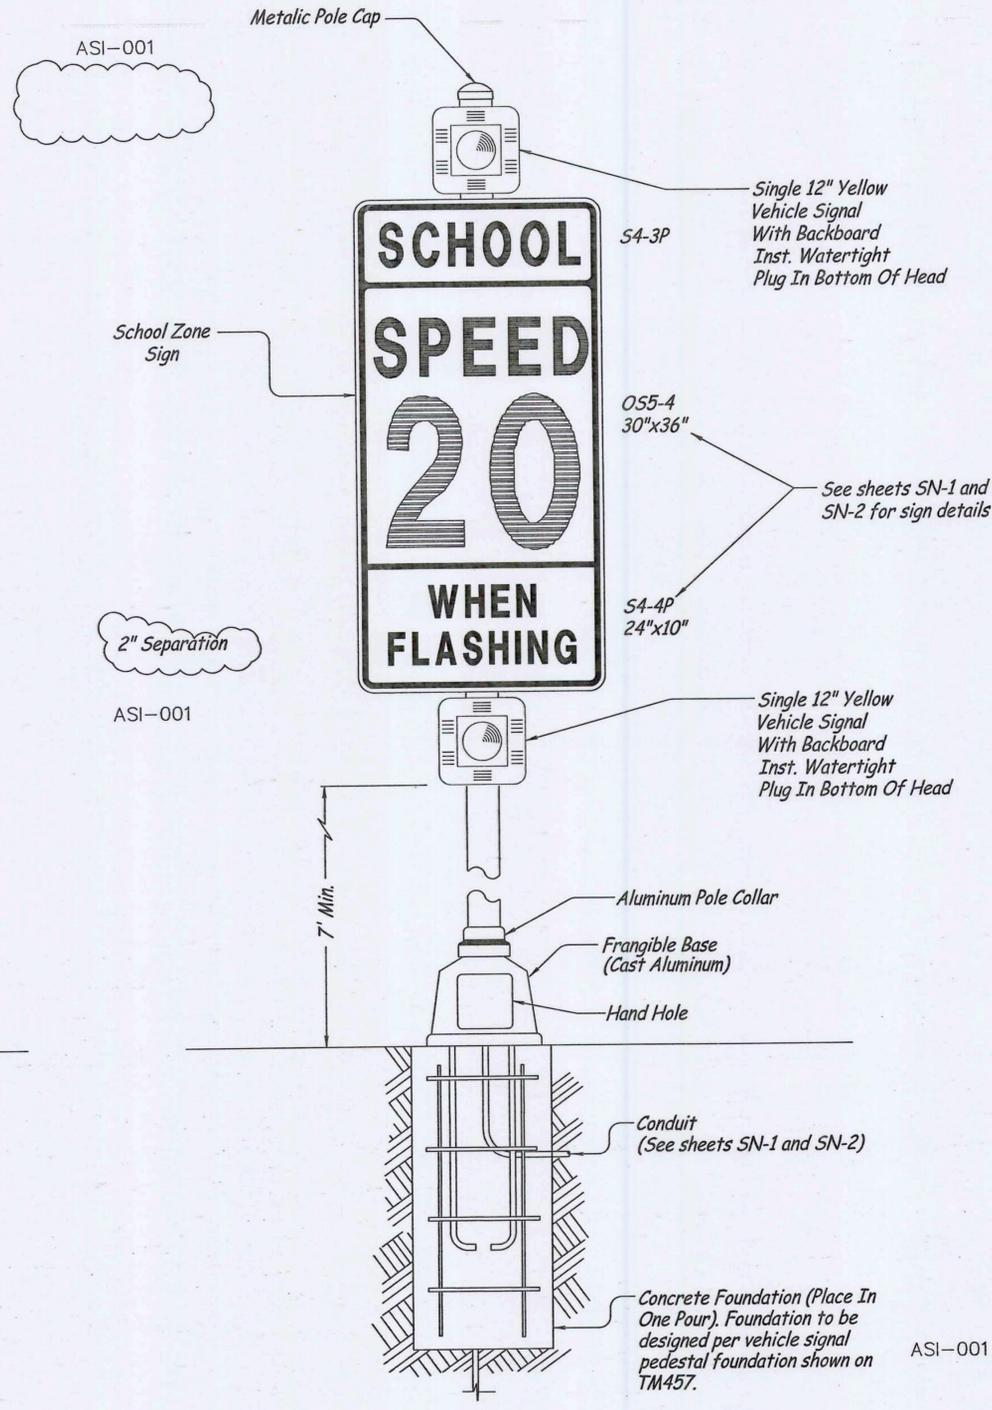

SCHOOL ZONE FLASHER

APPROVED FOR CONSTRUCTION BY  
CITY OF WEST LINN  
This approval is only for general conformance with the design concept and general compliance with applicable codes and requirements and shall not be construed as relieving the Design Engineer of full responsibility for accuracy and completeness of the drawings. This plan review approval does not prevent the City Inspector from requiring further code corrections in the field.  
DATE: 5-3-11 BY: K.W.J. ENGINEERING  
DRAWN: J.C.F. ENGINEERING

TRILLIUM CREEK PRIMARY SCHOOL  
West Linn Wilsonville School District  
22210 SW STAFFORD ROAD - WEST LINN, OR 97088  
t: (503) 673 7976  
f: (503) 673 7044



phase	CONSTRUCTION SET
date	04/06/2011
revisions	
Addendum 1	02/23/2011
ASI-001	04/06/2011

project # | 09014  
SURFACE IMPROVEMENTS  
STA: 10+50 TO 15+50

SN-4

DKS Associates  
TRANSPORTATION SOLUTIONS

1400 SW Fifth Avenue, Suite 500 Telephone: (503) 243-3500  
Portland, Oregon 97201-5502 Fax: (503) 243-1934