


# RENAISSANCE AT WILLAMETTE


## AS-BUILT CONSTRUCTION PLANS

AS-BUILT DISCLAIMER:  
AS-BUILT INFORMATION IS BASED ON A COMBINATION OF FIELD SURVEY INFORMATION, INSPECTION INFORMATION, AND CONTRACTOR-PROVIDED INFORMATION. THE ENGINEER ONLY CERTIFIES INFORMATION WHICH COULD BE FIELD-VERIFIED AFTER CONSTRUCTION WAS COMPLETED. AS-BUILTS ARE ONLY FOR PUBLIC IMPROVEMENTS WITHIN PUBLIC RIGHT-OF-WAYS OR EASEMENTS.

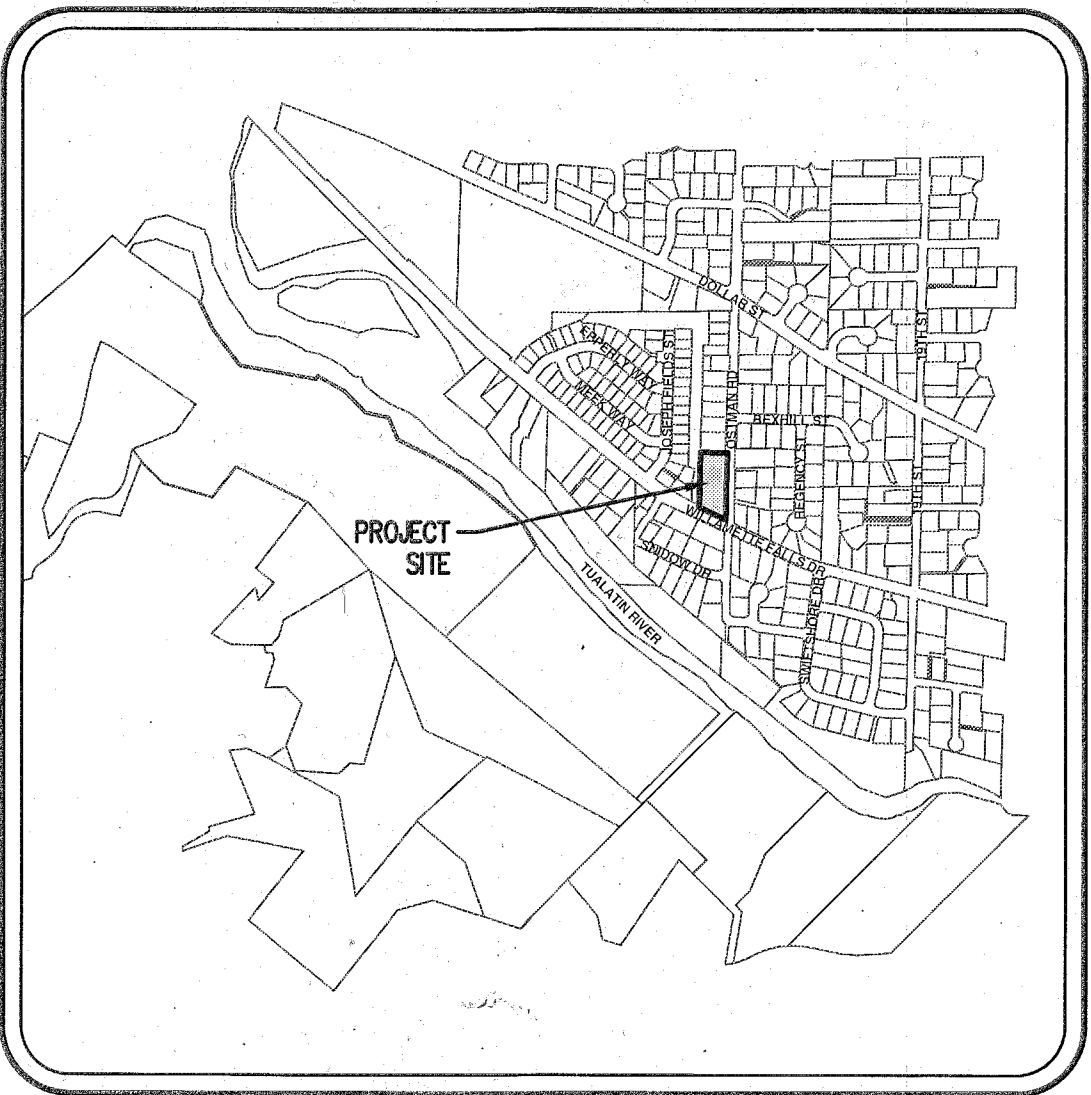

VICINITY MAP

SCALE: 1" = 1000'

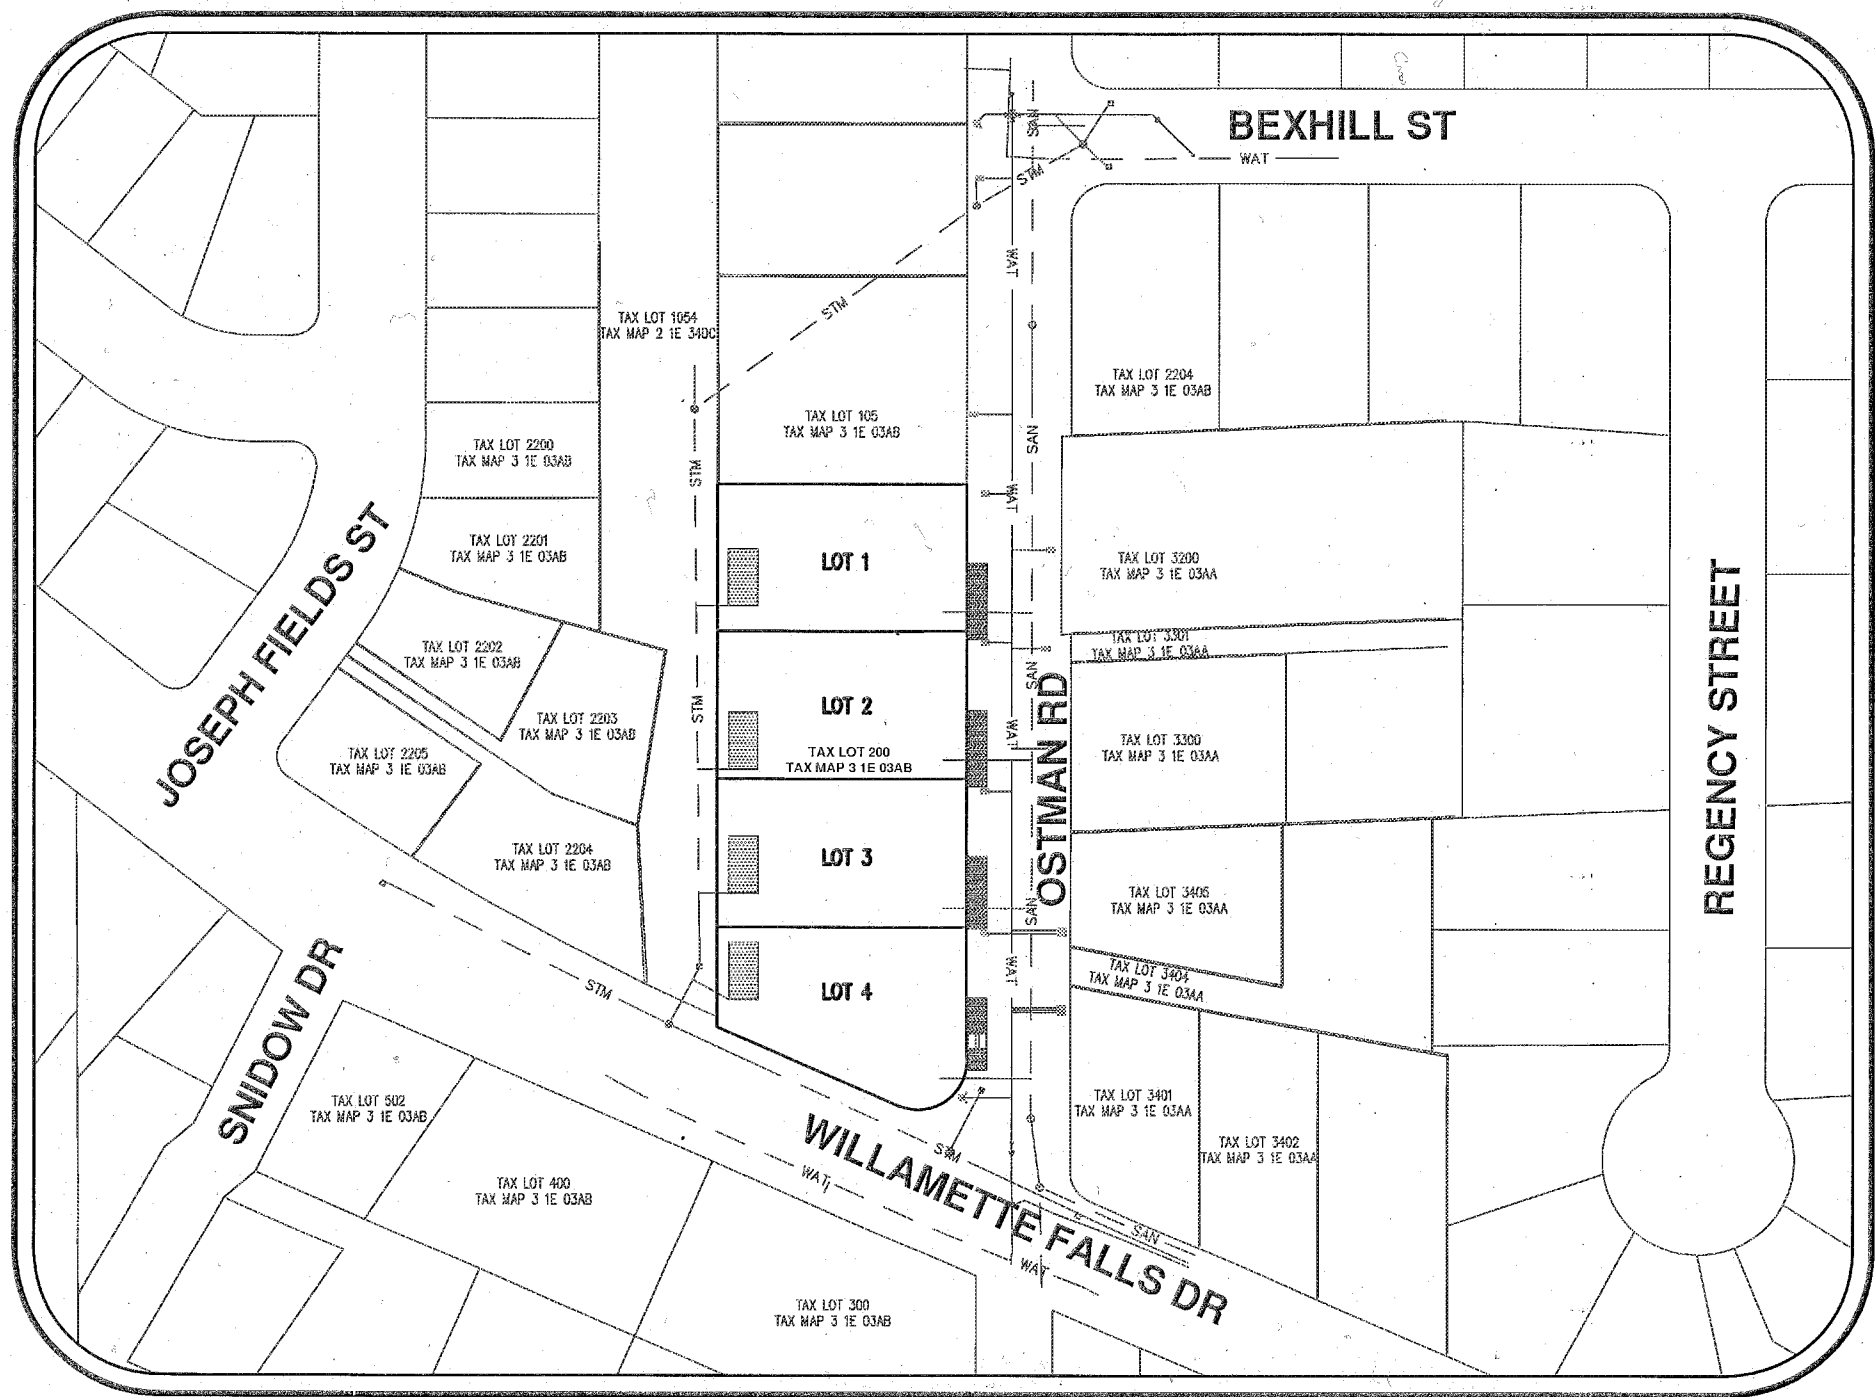

SITE MAP

SCALE: 1" = 100'

### LEGEND

EXISTING	PROPOSED	EXISTING	PROPOSED
DECIDUOUS TREE			
CONIFEROUS TREE			
FIRE HYDRANT			
WATER BLOWOFF			
WATER METER			
WATER VALVE			
WATER REDUCER			
DOUBLE CHECK VALVE			
AIR RELEASE VALVE			
SANITARY SEWER CLEAN OUT			
SANITARY SEWER MANHOLE			
SIGN			
STREET LIGHT			

	EXISTING	PROPOSED
RIGHT-OF-WAY LINE		
BOUNDARY LINE		
PROPERTY LINE		
CENTERLINE		
DITCH		
CURB		
EDGE OF PAVEMENT		
EASEMENT		
FENCE LINE		
GRAVEL EDGE		
POWER LINE		
OVERHEAD WIRE		
COMMUNICATIONS LINE		
FIBER OPTIC LINE		
GAS LINE		
STORM SEWER LINE		
SANITARY SEWER LINE		
WATER LINE		

### ATTENTION EXCAVATORS:

OREGON LAW REQUIRES YOU TO FOLLOW RULES ADOPTED BY THE OREGON UTILITY NOTIFICATION CENTER. THOSE RULES ARE SET FORTH IN OAR 952-001-0010 THROUGH OAR 952-001-0090. YOU MAY OBTAIN COPIES OF THESE RULES FROM THE CENTER BY CALLING 503-232-1987. IF YOU HAVE ANY QUESTIONS ABOUT THE RULES, YOU MAY CONTACT THE CENTER. YOU MUST NOTIFY THE CENTER AT LEAST TWO BUSINESS DAYS BUT NOT MORE THAN TEN BUSINESS DAYS, BEFORE COMMENCING AN EXCAVATION. CALL 503-246-6699.



### SHEET INDEX

- C000 - COVER SHEET WITH VICINITY AND SITE MAPS
- C001 - CONSTRUCTION NOTES
- C002 - EXISTING CONDITIONS PLAN AND TREE TABLE
- C030 - DEMOLITION AND TREE REMOVAL AND PRESERVATION PLAN
- C050 - EROSION AND SEDIMENT CONTROL COVER SHEET
- C051 - PHASE I EROSION AND SEDIMENT CONTROL PLAN
- C052 - PHASE II GRADING AND EROSION PLAN
- C053 - EROSION CONTROL DETAILS
- C100 - STREET PLAN AND CROSS SECTIONS
- C101 - STREET PLAN AND PROFILE - WILLAMETTE FALLS DRIVE
- C102 - STREET PLAN AND PROFILE - OSTMAN ROAD
- C103 - STREET DETAILS
- C104 - STREET DETAILS
- C110 - STRIPING AND SIGNAGE PLAN
- C200 - PUBLIC STORM SEWER PLAN AND PROFILE - OSTMAN ROAD
- C201 - PUBLIC STORM SEWER DETAILS
- C202 - PRIVATE STORM SEWER PLAN
- C300 - PUBLIC SANITARY SEWER PLAN AND PROFILE - OSTMAN ROAD
- C301 - SANITARY SEWER DETAILS
- C400 - WATER PLAN
- C401 - WATER DETAILS
- L100 - LANDSCAPING PLAN

### OWNER/APPLICANT:

RENAISSANCE HOMES  
16771 BOONES FERRY ROAD  
LAKE OSWEGO, OR 97035

### PLANNING/CIVIL ENGINEERING/SURVEYING LANDSCAPE ARCHITECTURE FIRM (APPLICANT'S REPRESENTATIVE):

AKS ENGINEERING & FORESTRY, LLC  
CONTACT: MONTY HURLEY  
12965 SW HERMAN DR, SUITE 100  
TUALATIN, OR 97062  
PH: 503-563-6151  
FAX: 503-563-6152

### SITE LOCATION:

1770 OSTMAN ROAD  
WEST LINN, OR 97068

### SITE DESCRIPTION:

TAX LOT 200, CLACKAMAS COUNTY ASSESSOR'S MAP 3 1E 03AB, LOCATED IN THE NORTHWEST 1/4 OF THE NORTHEAST 1/4 OF SECTION 3, TOWNSHIP 3 SOUTH, RANGE 1 EAST, WILLAMETTE MERIDIAN, CITY OF WEST LINN, CLACKAMAS COUNTY, OREGON

### PROJECT PURPOSE:

FOUR LOT RESIDENTIAL SUBDIVISION FOR FUTURE SINGLE-FAMILY DETACHED HOMES IN THE R-10 ZONE, AS APPROVED IN THE CITY OF WEST LINN FINAL DECISION NOTICE DATED 4-10-2014 FOR SUB-14-01/VAR-14-01/VAR-14-02/VAR-14-03/VAR-14-04/VAR-14-05.

### BENCHMARK:

VERTICAL DATUM: ELEVATIONS ARE BASED ON NGS BENCHMARK 89 B (PID: RD0258) ON THE WEST SIDE OF HIGHWAY 99E, 2.4 MILES SOUTH OF THE PROJECT SITE WITH A NAVD 88 ELEVATION OF 93.78 FEET.

### TOTAL SITE AREA:

44,463 SF± (1.02 ACRES±)

### UTILITY CONTACTS:

#### POWER

PORTLAND GENERAL ELECTRIC  
121 SW SALMON ST  
PORTLAND, OREGON. 97024  
PH: (503) 736-5450

#### CABLE / INTERNET

COMCAST  
9605 SW NIMBUS  
BEAVERTON, OREGON. 97008  
PH: (503) 912-8307

#### TELEPHONE

CENTURY LINK  
1001 MOLALLA AVE  
OREGON CITY, OREGON. 97045  
PH: (888) 496-1650

#### GAS

NW NATURAL  
220 NW 2ND AVE  
PORTLAND, OREGON. 97209  
PH: (503) 226-4211

#### FIRE

TUALATIN VALLEY FIRE AND RESCUE  
11945 SW 70TH AVENUE  
TIGARD, OREGON. 97223  
PH: (503) 649-8577

#### GARBAGE

WEST LINN REFUSE AND RECYCLING  
1600 SE 4TH AVE  
CANBY, OREGON. 97013  
PH: (503) 557-3900

#### WATER / SANITARY / STORM SEWER

CITY OF WEST LINN PUBLIC WORKS  
22500 SALAMO RD  
WEST LINN, OREGON. 97034  
PH: (503) 656-4261

COVER SHEET WITH  
VICINITY AND SITE  
MAPS

DESIGNED BY: DCN

DRAWN BY: JDR

CHECKED BY: MBH

SCALE: AS NOTED

DATE: 2/9/2015

REGISTERED PROFESSIONAL  
ENGINEER  
58542PE  
JULY 9, 2007  
MONTGOMERY B. HURLEY  
RENEWAL DATE: 6/30/15

REVISIONS

JOB NUMBER  
3745

SHEET

C000

AKS  
ENGINEERING AND FORESTRY, LLC  
12965 SW HERMAN DR  
SUITE 100  
TUALATIN, OR 97062  
PHONE: 503-563-6151  
FAX: 503-563-6152  
www.aks-eng.com  
ENGINEERING • PLANNING • SURVEYING  
LANDSCAPE ARCHITECTURE


RENAISSANCE  
AT WILLAMETTE  
AS-BUILTS  
WEST LINN  
CLACKAMAS COUNTY ASSESSOR'S TAXMAP 31E03AB  
TAX LOT 0200







AS-BUILT DISCLAIMER:  
AS-BUILT INFORMATION IS BASED ON A COMBINATION OF FIELD SURVEY INFORMATION, INSPECTION INFORMATION, AND CONTRACTOR-PROVIDED INFORMATION. THE ENGINEER ONLY CERTIFIES INFORMATION WHICH COULD BE FIELD-VERIFIED AFTER CONSTRUCTION WAS COMPLETED. AS-BUILTS ARE ONLY FOR PUBLIC IMPROVEMENTS WITHIN PUBLIC RIGHT-OF-WAYS OR EASEMENTS.

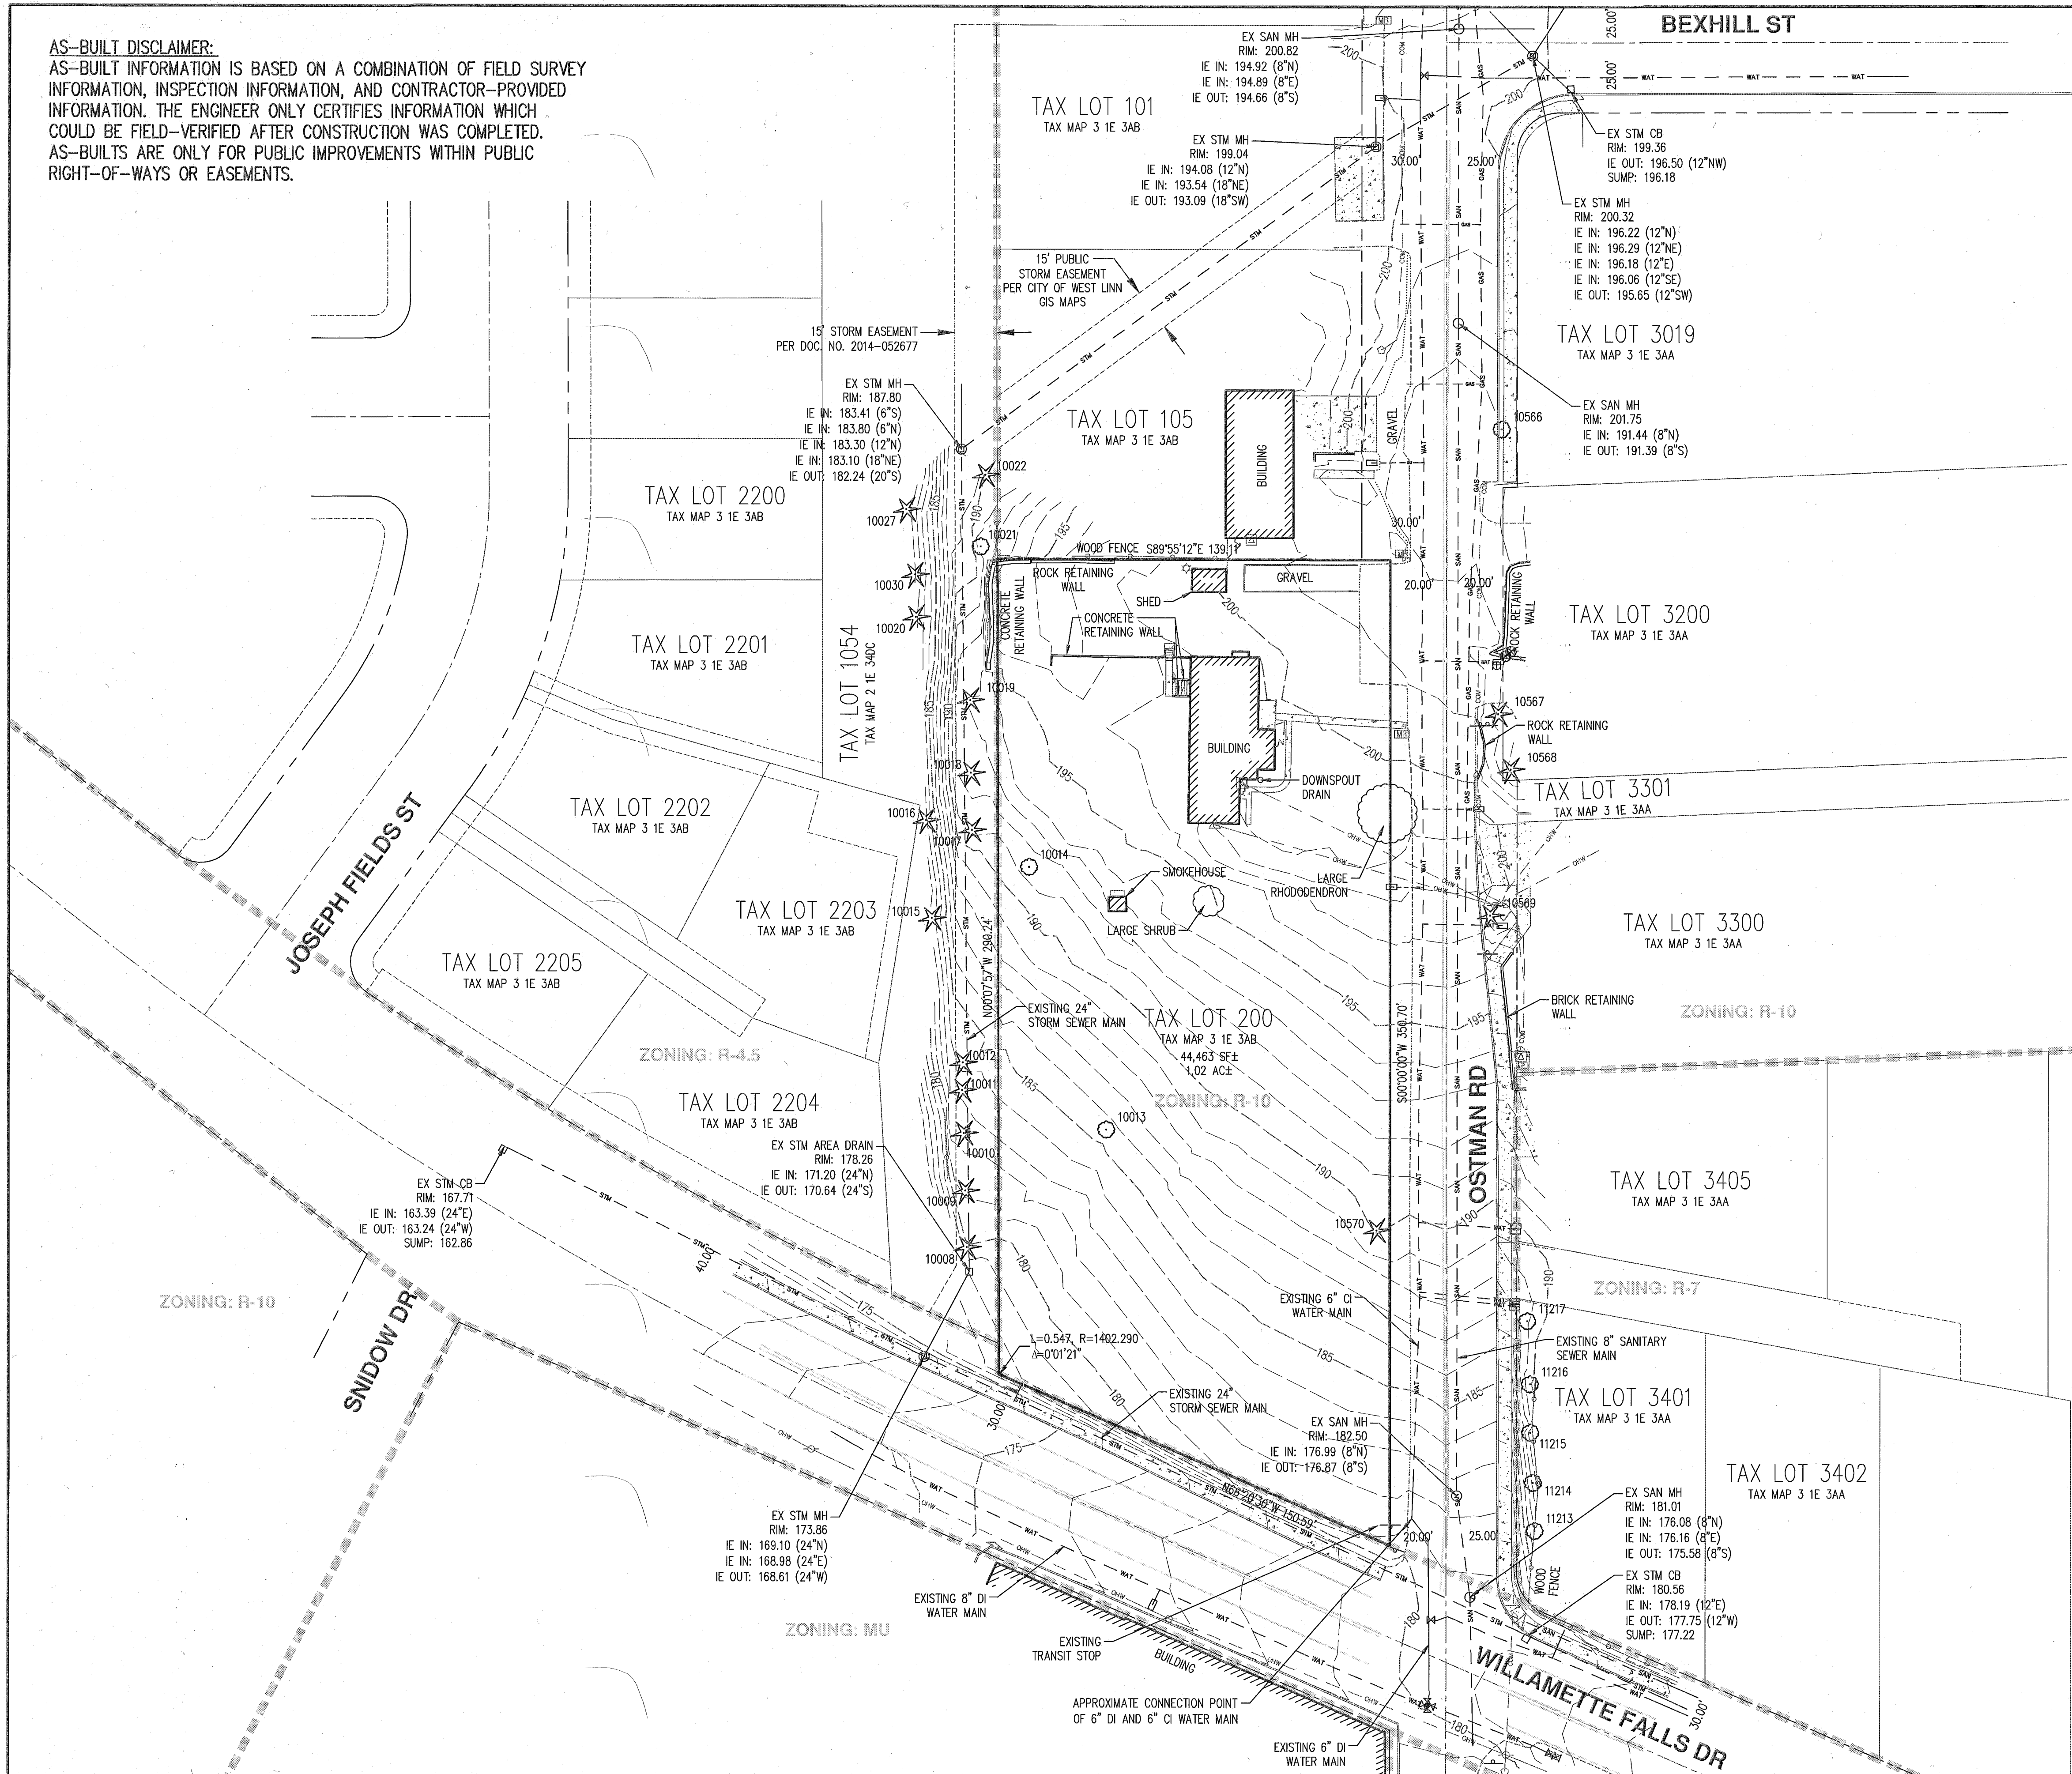

- NOTES:
- UTILITIES SHOWN ARE BASED ON UNDERGROUND UTILITY LOCATE MARKINGS BY OTHERS. PROVIDED PER UTILITY LOCATE TICKET NUMBER 13235032. THE SURVEYOR MAKES NO GUARANTEE THAT THE UNDERGROUND LOCATES REPRESENT THE ONLY UTILITIES IN THE AREA. CONTRACTORS ARE RESPONSIBLE FOR VERIFYING ALL EXISTING CONDITIONS PRIOR TO BEGINNING CONSTRUCTION.
  - FIELD WORK WAS CONDUCTED OCTOBER 30 - NOVEMBER 6, 2013.
  - VERTICAL DATUM: ELEVATIONS ARE BASED ON NGS BENCHMARK 89 B (PID: RD0258) ON THE WEST SIDE OF HWY 99E, 2.4 MILES SOUTH OF THE PROJECT SITE WITH A NAVD 88 ELEVATION OF 93.78 FEET.
  - THIS MAP DOES NOT CONSTITUTE A PROPERTY BOUNDARY SURVEY.
  - SURVEY IS ONLY VALID WITH SURVEYOR'S STAMP AND SIGNATURE.
  - BUILDING FOOTPRINTS ARE MEASURED TO SIDING UNLESS NOTED OTHERWISE. CONTACT SURVEYOR WITH QUESTIONS REGARDING BUILDING TIES.
  - CONTOUR INTERVAL IS 1 FOOT.
  - ONLY TREES HAVING A DIAMETER OF 6" AND GREATER, MEASURED AT BREAST HEIGHT, WERE SURVEYED.

TREE TABLE

TREE NO.	SPECIES	DBH(IN.)
10008	PINE	18
10009	PINE	6,15
10010	PINE	20
10011	DOUGLAS FIR	20
10012	DOUGLAS FIR	25
10013	CHERRY	8,7,7
10014	APPLE	26(ROTTEN)
10015	PINE	11,11
10016	PINE	12
10017	PINE	23
10018	PINE	15
10019	PINE	19
10020	PINE	9
10021	COTTONWOOD	65(STUMP)
10022	DOUGLAS FIR	31
10027	PINE	9
10030	PINE	6
10566	CHERRY	11,11,12
10567	DOUGLAS FIR	49
10568	DOUGLAS FIR	56
10569	DOUGLAS FIR	27
10570	DOUGLAS FIR	38(DEAD)
11213	MAPLE	26
11214	MAPLE	11
11215	MAPLE	14
11216	MAPLE	13
11217	BIRCH	18

AKS  
AKS ENGINEERING AND FORESTRY, LLC  
12965 SW HERMAN RD  
SUITE 100, CLATSOP, OR 97132  
PHONE: 503.663.6151  
FAX: 503.663.6152  
www.aks-eng.com

RENAISSANCE  
AT WILLAMETTE  
AS-BUILTS

WEST LINN  
TAX LOT 0200

EXISTING  
CONDITIONS PLAN  
AND TREE TABLE


DESIGNED BY: DCN  
DRAWN BY: JDR  
CHECKED BY: MBH  
SCALE: AS NOTED  
DATE: 2/9/2015  
REGISTERED  
PROFESSIONAL  
LAND SURVEYOR  
MONTGOMERY B. HURLEY  
JULY 15, 2003  
58542LS  
RENEWS: 6/30/15

JOB NUMBER  
3745  
SHEET  
C002

SCALE 1" = 30 FEET  
30 0 12 18 24 30



AS-BUILT DISCLAIMER:  
AS-BUILT INFORMATION IS BASED ON A COMBINATION OF FIELD SURVEY INFORMATION, INSPECTION INFORMATION, AND CONTRACTOR-PROVIDED INFORMATION. THE ENGINEER ONLY CERTIFIES INFORMATION WHICH COULD BE FIELD-VERIFIED AFTER CONSTRUCTION WAS COMPLETED. AS-BUILTS ARE ONLY FOR PUBLIC IMPROVEMENTS WITHIN PUBLIC RIGHT-OF-WAYS OR EASEMENTS.

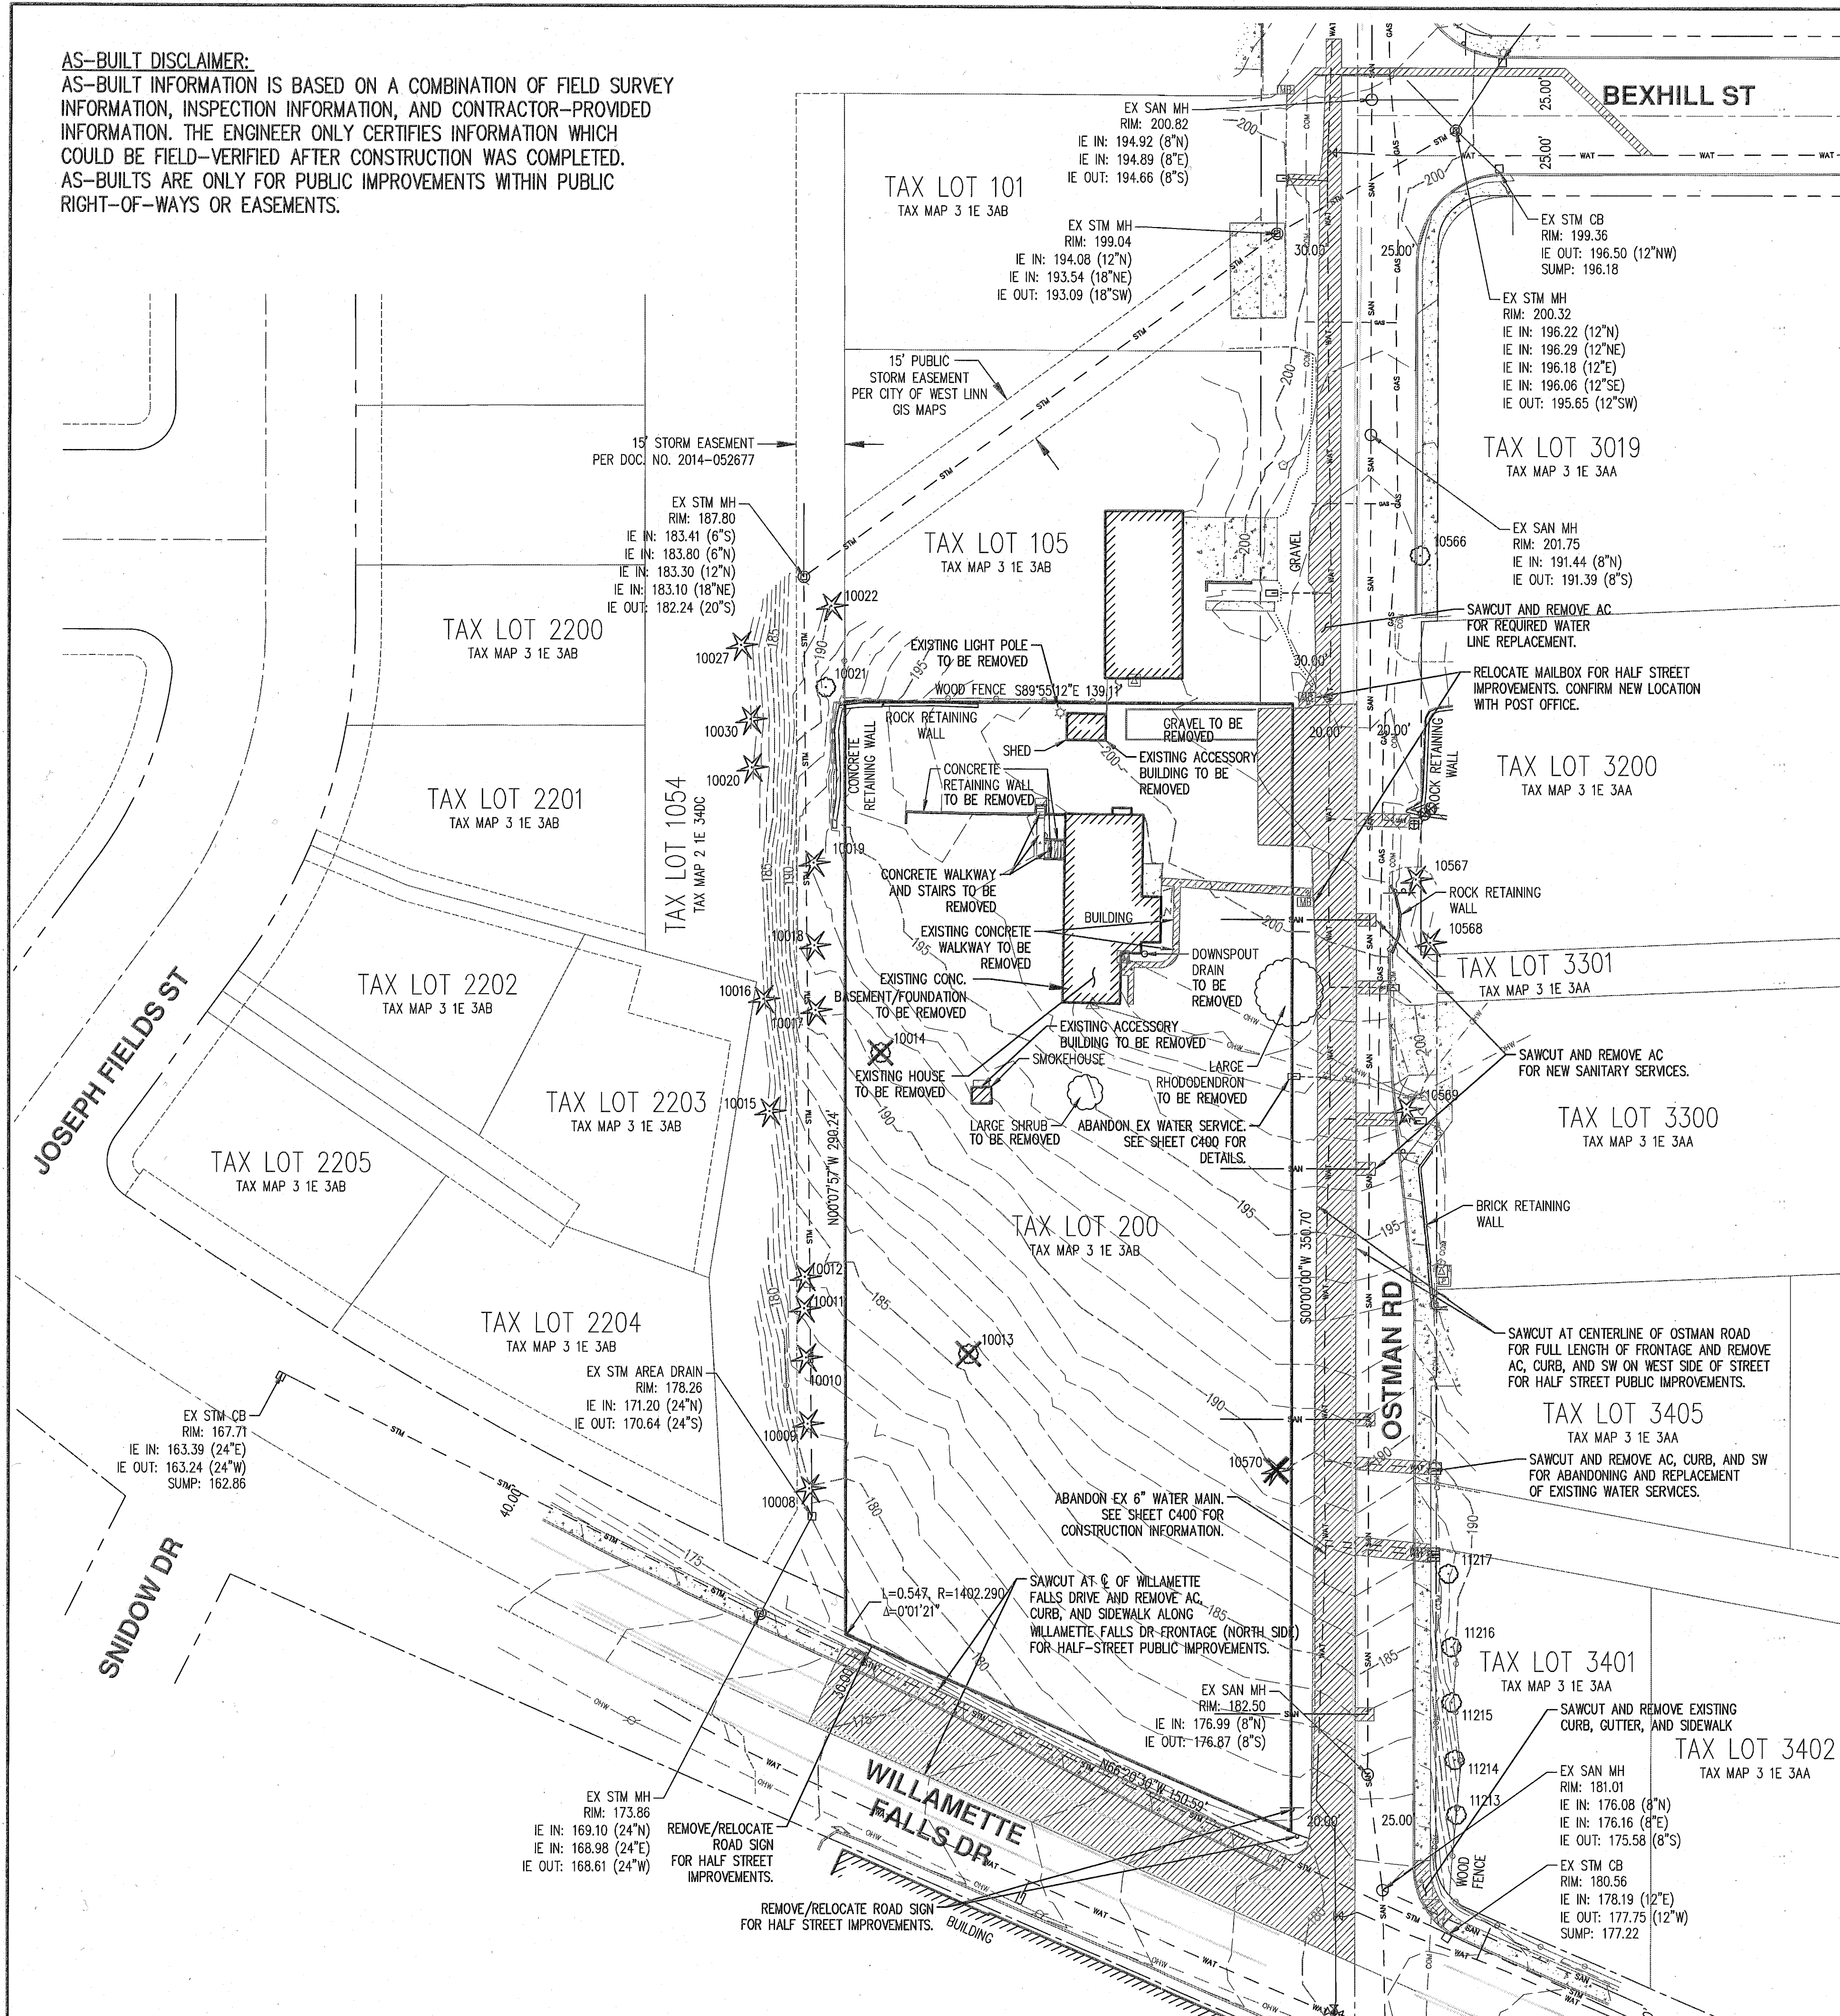

DEMOLITION NOTES:

1. PRIOR TO STARTING DEMOLITION OPERATIONS, THE CONTRACTOR SHALL APPLY FOR AND OBTAIN ALL NECESSARY PERMITS REQUIRED BY FEDERAL, STATE, CITY, AND LOCAL LAWS, CODES, AND REGULATIONS. CITY DEMOLITION PERMIT SHALL BE REQUIRED.
2. THE CONTRACTOR SHALL PROVIDE ALL THE "MEANS AND METHODS" NECESSARY TO PREVENT MOVEMENT, SETTLEMENT, OR COLLAPSE OF EXISTING STRUCTURES AND/OR IMPROVEMENTS TO REMAIN ON OR OFF SITE. THE CONTRACTOR IS RESPONSIBLE FOR ANY DAMAGE TO EXISTING STRUCTURES AND/OR IMPROVEMENTS TO REMAIN AND SHALL RESTORE ANY DAMAGE TO THE PRE-DEMOLITION CONDITION OR BETTER USING NEW MATERIALS. ANY REPAIRS REQUIRED SHALL BE PERFORMED AT THE CONTRACTOR'S SOLE COST AND EXPENSE.
3. CONTRACTOR SHALL BE REQUIRED TO SECURE ALL NECESSARY PERMITS AND APPROVALS FOR ALL OFF SITE MATERIAL SOURCES AND DISPOSAL FACILITIES. CONTRACTOR SHALL SUPPLY A COPY OF APPROVALS TO OWNER'S REPRESENTATIVE PRIOR TO INITIATING WORK.
4. CONTRACTOR SHALL INSTALL EROSION CONTROL MEASURES IN CONFORMANCE WITH THE EROSION CONTROL PLAN, NOTES, AND DETAILS PRIOR TO STARTING DEMOLITION OPERATIONS.
5. THE LOCATION OF ALL UTILITIES SHALL BE MARKED IN THE FIELD PRIOR TO DEMOLITION. CONTRACTOR SHALL PROTECT AND MAINTAIN IN A SAFE AND OPERABLE CONDITION ALL UTILITIES INDICATED TO REMAIN, AND PREVENT INTERRUPTION OF EXISTING UTILITY SERVICES EXCEPT WHEN AUTHORIZED IN WRITING BY THE AUTHORITIES HAVING JURISDICTION. CONTRACTOR SHALL PROVIDE TEMPORARY SERVICES, ACCEPTABLE TO GOVERNING AUTHORITIES AND OWNER'S REPRESENTATIVE, FOR BUILDING(S) TO REMAIN AS REQUIRED DURING INTERRUPTIONS TO EXISTING UTILITY SERVICES.
6. DEMOLITION ACTIVITIES AND EQUIPMENT SHALL NOT USE AREAS OUTSIDE THE PROJECT LIMITS WITHOUT WRITTEN PERMISSION FROM THE OWNER'S REPRESENTATIVE AND/OR GOVERNMENTAL AGENCIES HAVING JURISDICTION IF APPLICABLE.
7. THE CONTRACTOR SHALL KEEP ALL STREETS AND PUBLIC RIGHT-OF-WAYS CLEAN OF MUD, DIRT, AND DEMOLITION DEBRIS. THE CONTRACTOR SHALL MONITOR THE HAULING OF DEBRIS TO INSURE THAT ANY SPILLAGE FROM TRUCKS IS PROMPTLY AND COMPLETELY REMOVED AND CLEANED UP. IF REQUIRED AND/OR NECESSARY, THE CONTRACTOR SHALL COVER ALL HAUL VEHICLES.
8. CONTRACTOR SHALL CONDUCT DEMOLITION ACTIVITIES IN SUCH A MANNER TO ENSURE MINIMUM INTERFERENCE WITH ROADS, STREETS, SIDEWALKS, WALKWAYS, AND OTHER ADJACENT FACILITIES. IF APPLICABLE STREET CLOSURE PERMITS MUST BE RECEIVED FROM THE APPROPRIATE GOVERNMENTAL AUTHORITY PRIOR TO THE COMMENCEMENT OF ANY STREET OPENING OR DEMOLITION ACTIVITIES IN THE RIGHT-OF-WAY.
9. CONTRACTOR SHALL CLEAN ADJACENT STRUCTURES AND IMPROVEMENTS OF DUST, DIRT, AND DEBRIS CAUSED BY DEMOLITION OPERATIONS. RETURN ADJACENT AREAS TO CONDITIONS EXISTING PRIOR TO THE START OF THE WORK.


TREE TABLE

TREE NO.	SPECIES	DBH(IN.)
10008	PINE	18
10009	PINE	6,15
10010	PINE	20
10011	DOUGLAS FIR	20
10012	DOUGLAS FIR	25
* 10013	CHERRY	8,7,7
* 10014	APPLE	26(ROTTEN)
10015	PINE	11,11
10016	PINE	12
10017	PINE	23
10018	PINE	15
10019	PINE	19
10020	PINE	9
10021	COTTONWOOD	65(STUMP)
10022	DOUGLAS FIR	31
10027	PINE	9
10030	PINE	6
10566	CHERRY	11,11,12
10567	DOUGLAS FIR	49
10568	DOUGLAS FIR	56
10569	DOUGLAS FIR	27
* 10570	DOUGLAS FIR	38(DEAD)
11213	MAPLE	26
11214	MAPLE	11
11215	MAPLE	14
11216	MAPLE	13
11217	BIRCH	18

\* TREE TO BE REMOVED

LEGEND

- EXISTING GROUND CONTOUR (1 FT) ——— 101 ———
- EXISTING GROUND CONTOUR (5 FT) ——— 100 ———
- EXISTING TREE TO BE REMOVED ✕ ✕
- EXISTING TREE TO REMAIN ☆ ○
- A.C. / CONCRETE TO BE REMOVED [Hatched Box]

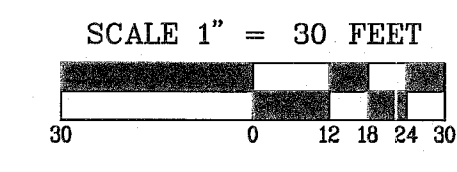

AKS  
AKS ENGINEERING AND FORESTRY, LLC  
12985 SW HERMAN RD  
TULSA, OK 74102  
PHONE: 918.463.6151  
FAX: 918.463.6152  
www.aks-eng.com


RENAISSANCE  
AT WILLAMETTE  
AS-BUILTS  
DEMOLITION AND TREE  
REMOVAL AND  
PRESERVATION PLAN

DESIGNED BY: DCN  
DRAWN BY: JDR  
CHECKED BY: MBH  
SCALE: AS NOTED  
DATE: 2/9/2015  
REGISTERED PROFESSIONAL  
ENGINEER  
58542PE  
MONTGOMERY B. HURLEY  
RENEWAL DATE: 6/30/15  
REVISIONS  
JOB NUMBER  
3745  
SHEET  
C030


WEST LINN  
TAX LOT 0200  
CLACKAMUS COUNTY ASSESSOR'S TAXMAP 35E03AB  
ENGINEERING • PLANNING • SURVEYING  
FORESTRY • LANDSCAPE ARCHITECTURE  
OREGON



**AKS**  
AKS ENGINEERING AND FORESTRY, LLC  
12895 SW HERMAN RD  
SUITE 100  
TUALATIN, OR 97062  
PHONE: 503.563.6151  
FAX: 503.563.6152  
[www.aks-eng.com](http://www.aks-eng.com)  
ENGINEERING • PLANNING • SURVEYING  
FORESTRY • LANDSCAPE ARCHITECTURE

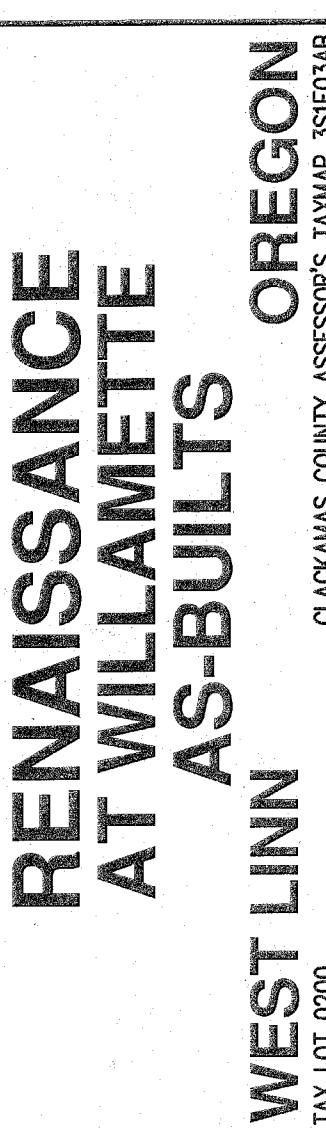

# EROSION AND SEDIMENT CONTROL COVER SHEET

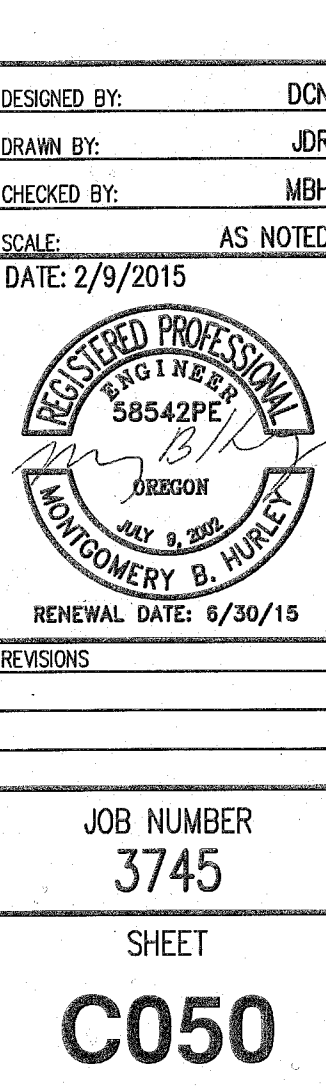

OREGON UTILITY NOTIFICATION CENTER

Know what's below.  
Call before you dig.

811

DIG SAFELY OREGON 1-800-332-2344

OREGON LAW REQUIRES YOU TO FOLLOW RULES ADOPTED BY THE OREGON UTILITY NOTIFICATION CENTER. THOSE RULES ARE SET FORTH IN OAR 952-001-0010 THROUGH OAR 952-001-0090. YOU MAY OBTAIN COPIES OF THESE RULES FROM THE CENTER BY CALLING 503-232-1987. IF YOU HAVE ANY QUESTIONS ABOUT THE RULES, YOU MAY CONTACT THE CENTER. YOU MUST NOTIFY THE CENTER AT LEAST TWO BUSINESS DAYS BUT NOT MORE THAN TEN BUSINESS DAYS, BEFORE COMMENCING AN EXCAVATION. CALL 503-246-6699.

A COMPREHENSIVE LIST OF AVAILABLE BEST MANAGEMENT PRACTICES (BMP) OPTIONS BASED ON DEQ'S GUIDANCE MANUAL HAS BEEN REVIEWED TO COMPLETE THIS EROSION AND SEDIMENT CONTROL PLAN. SOME OF THE ABOVE LISTED BMP'S WERE NOT CHOSEN BECAUSE THEY WERE DETERMINED TO NOT EFFECTIVELY MANAGE EROSION PREVENTION AND SEDIMENT CONTROL FOR THIS PROJECT BASED ON SPECIFIC SITE CONDITIONS, INCLUDING SOIL CONDITIONS TOPOGRAPHIC CONSTRAINTS, ACCESSIBILITY TO THE SITE, AND OTHER RELATED CONDITIONS, AS THE PROJECT PROGRESSES AND THERE IS A NEED TO REVISE THE ESC PLAN, AN ACTION PLAN WILL BE SUBMITTED.

AS-BUILT INFORMATION IS BASED ON A COMBINATION OF FIELD SURVEY INFORMATION, INSPECTION INFORMATION, AND CONTRACTOR-PROVIDED INFORMATION. THE ENGINEER ONLY CERTIFIES INFORMATION WHICH COULD BE FIELD-VERIFIED AFTER CONSTRUCTION WAS COMPLETED. AS-BUILTS ARE ONLY FOR PUBLIC IMPROVEMENTS WITHIN PUBLIC RIGHT-OF-WAYS OR EASEMENTS.



AKS DRAWING FILE: 3745 C051 GRADING AND ESC REV.DWG [ LAYOUT: C051 ]

### GRADING AND EROSION CONTROL LEGEND


EXISTING GROUND CONTOUR (1 FT)	
EXISTING GROUND CONTOUR (5 FT)	
FINISHED GRADE CONTOUR (1 FT)	
FINISHED GRADE CONTOUR (5 FT)	
LIMITS OF DISTURBANCE (1.39 ACRES ±)	
SEDIMENT FENCE (TO BE INSTALLED PRIOR TO GRADING)	
SEDIMENT FENCE (TO BE INSTALLED AFTER GRADING)	
INLET PROTECTION	
CONCRETE WASHOUT AREA	
DRAINAGE FLOW DIRECTION	
GRAVEL CONSTRUCTION ENTRANCE	
SLOPE MATTING	

**AS-BUILT DISCLAIMER:**  
AS-BUILT INFORMATION IS BASED ON A COMBINATION OF FIELD SURVEY INFORMATION, INSPECTION INFORMATION, AND CONTRACTOR-PROVIDED INFORMATION. THE ENGINEER ONLY CERTIFIES INFORMATION WHICH COULD BE FIELD-VERIFIED AFTER CONSTRUCTION WAS COMPLETED. AS-BUILTS ARE ONLY FOR PUBLIC IMPROVEMENTS WITHIN PUBLIC RIGHT-OF-WAYS OR EASEMENTS.

### LEGEND

EXISTING	PROPOSED	EXISTING	PROPOSED
DECIDUOUS TREE		STORM SEWER CLEAN OUT	
CONIFEROUS TREE		STORM SEWER CATCH BASIN	
FIRE HYDRANT		STORM SEWER AREA DRAIN	
WATER BLOWOFF		STORM SEWER MANHOLE	
WATER METER		GAS METER	
WATER VALVE		GAS VALVE	
DOUBLE CHECK VALVE		GUY WIRE ANCHOR	
AIR RELEASE VALVE		POWER POLE	
SANITARY SEWER CLEAN OUT		POWER VAULT	
SANITARY SEWER MANHOLE		POWER JUNCTION BOX	
SIGN		POWER PEDESTAL	
STREET LIGHT		COMMUNICATIONS VAULT	
MAILBOX		COMMUNICATIONS JUNCTION BOX	
		COMMUNICATIONS RISER	
EXISTING	PROPOSED	EXISTING	PROPOSED
RIGHT-OF-WAY LINE			
BOUNDARY LINE			
PROPERTY LINE			
CENTERLINE			
DITCH			
CURB			
EDGE OF PAVEMENT			
EASEMENT			
FENCE LINE			
GRAVEL EDGE			
POWER LINE			
OVERHEAD WIRE			
COMMUNICATIONS LINE			
FIBER OPTIC LINE			
GAS LINE			
STORM SEWER LINE			
SANITARY SEWER LINE			
WATER LINE			

**NOTE:**  
THE CONTRACTOR SHALL REPLACE THE EXISTING HOUSE FOUNDATION DEMOLITION AREA WITH STRUCTURAL FILL. THE PLACEMENT OF THE STRUCTURAL FILL MATERIAL SHALL BE APPROVED FOR USE BY THE PROJECT GEOTECHNICAL ENGINEER PRIOR TO PLACEMENT. THE CONTRACTOR SHALL SCHEDULE INSPECTIONS OF THE STRUCTURAL FILL MATERIAL WITH THE PROJECT GEOTECHNICAL ENGINEER DURING PLACEMENT OF THE STRUCTURAL FILL.

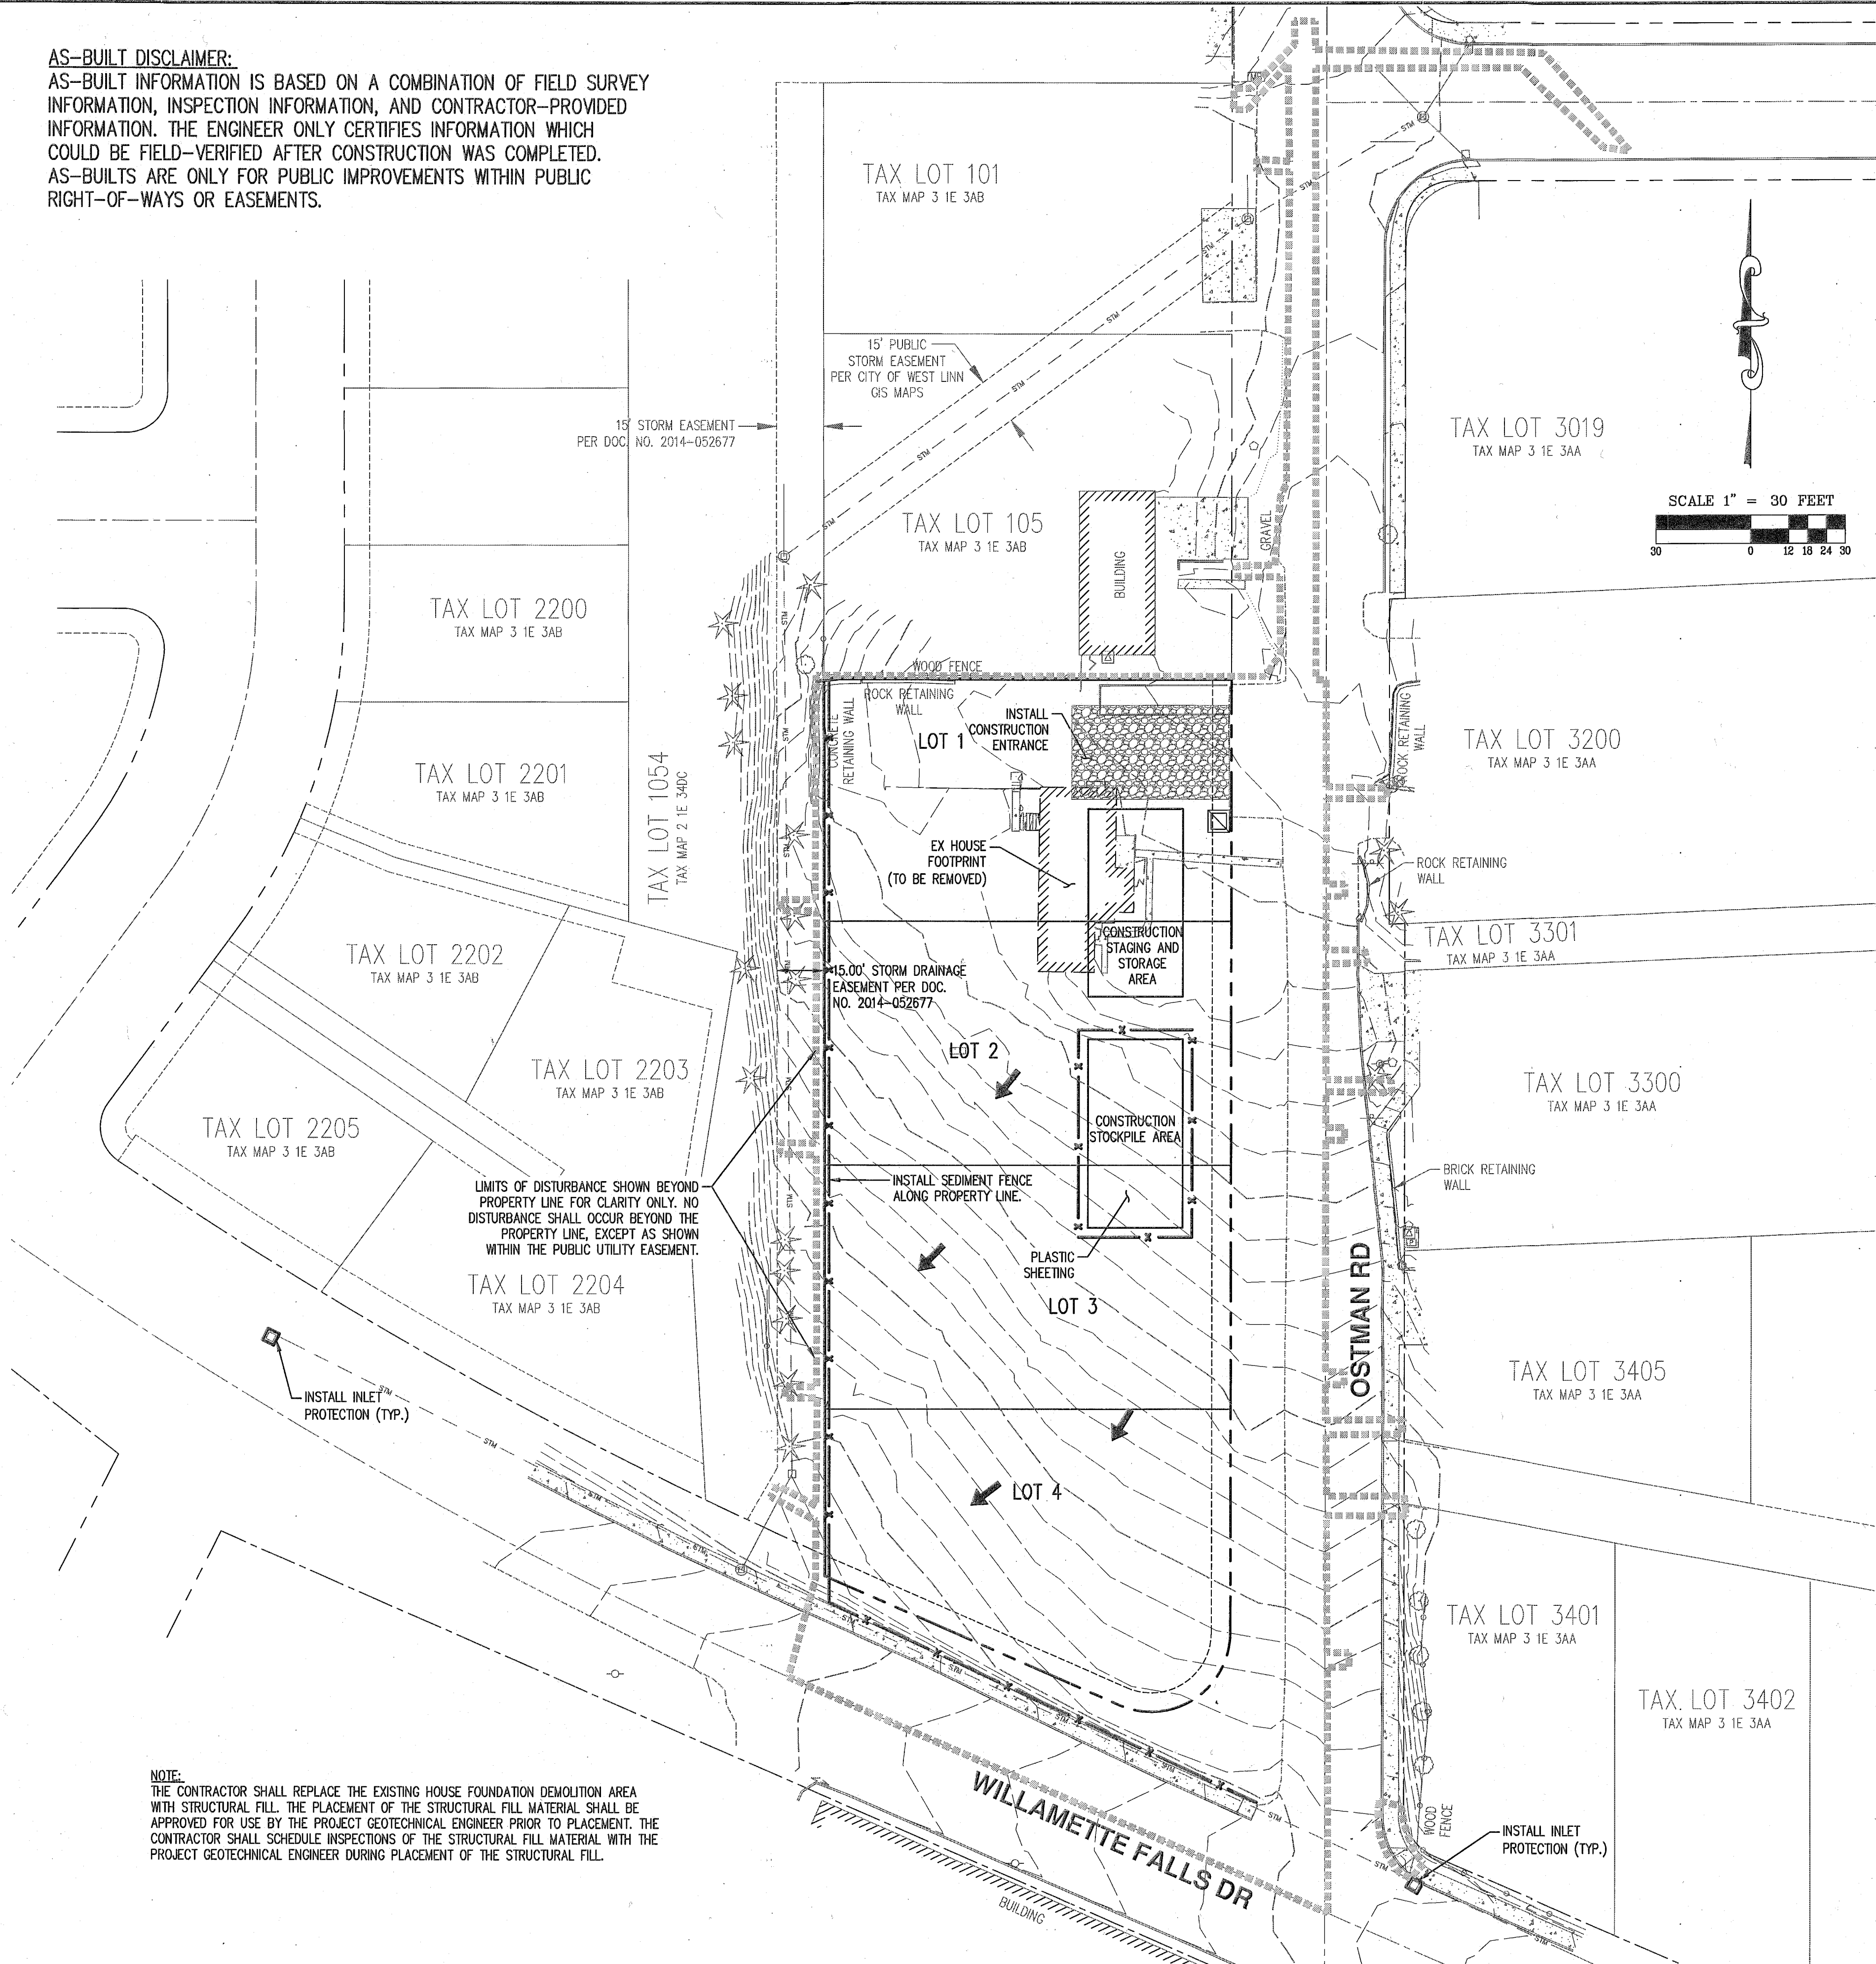

**AKS**  
AKS ENGINEERING AND FORESTRY, LLC  
1995 SW HERMAN RD  
SUITE 200  
TUALATIN, OR 97062  
PHONE: 503.653.6151  
FAX: 503.653.6152  
www.aks-eng.com

ENGINEERING • PLANNING • SURVEYING  
LANDSCAPE ARCHITECTURE

**RENAISSANCE  
AT WILLAMETTE  
AS-BUILTS**  
WEST LINN  
OREGON  
CLACKAMAS COUNTY ASSESSOR'S TAXMAP 331E034B  
TAX LOT 0200

### PHASE I EROSION AND SEDIMENT CONTROL PLAN

DESIGNED BY: DCN  
DRAWN BY: JOR  
CHECKED BY: MBH  
SCALE: AS NOTED  
DATE: 2/9/2015

**REGISTERED PROFESSIONAL ENGINEER**  
58542PE  
JORGON  
JULY 9, 2007  
MONTGOMERY B. HULEY  
RENEWAL DATE: 6/30/15

REVISIONS  
JOB NUMBER  
3745  
SHEET  
**C051**



AKS DRAWING FILE: 3745 C052 GRADING AND ESC REVIEWING [ LAYOUT: C052 ]

GRADING AND EROSION CONTROL  
LEGEND

EXISTING GROUND CONTOUR (1 FT)

EXISTING GROUND CONTOUR (5 FT)

FINISHED GRADE CONTOUR (1 FT)

FINISHED GRADE CONTOUR (5 FT)

LIMITS OF DISTURBANCE (1.39 ACRES ±)

SEDIMENT FENCE (TO BE INSTALLED PRIOR TO GRADING)

SEDIMENT FENCE (TO BE INSTALLED AFTER GRADING)

INLET PROTECTION

CONCRETE WASHOUT AREA

DRAINAGE FLOW DIRECTION

GRAVEL CONSTRUCTION ENTRANCE

SLOPE MATTING

AS-BUILT DISCLAIMER:  
AS-BUILT INFORMATION IS BASED ON A COMBINATION OF FIELD SURVEY INFORMATION, INSPECTION INFORMATION, AND CONTRACTOR-PROVIDED INFORMATION. THE ENGINEER ONLY CERTIFIES INFORMATION WHICH COULD BE FIELD-VERIFIED AFTER CONSTRUCTION WAS COMPLETED. AS-BUILTS ARE ONLY FOR PUBLIC IMPROVEMENTS WITHIN PUBLIC RIGHT-OF-WAYS OR EASEMENTS.

LEGEND

EXISTING

PROPOSED

DECIDUOUS TREE

CONIFEROUS TREE

FIRE HYDRANT

WATER BLOWOFF

WATER METER

WATER VALVE

DOUBLE CHECK VALVE

AIR RELEASE VALVE

SANITARY SEWER CLEAN OUT

SANITARY SEWER MANHOLE

SIGN

STREET LIGHT

MAILBOX

STORM SEWER CLEAN OUT

STORM SEWER CATCH BASIN

STORM SEWER AREA DRAIN

STORM SEWER MANHOLE

GAS METER

GAS VALVE

GUY WIRE ANCHOR

POWER POLE

POWER VAULT

POWER JUNCTION BOX

POWER PEDESTAL

COMMUNICATIONS VAULT

COMMUNICATIONS JUNCTION BOX

COMMUNICATIONS RISER

EXISTING

PROPOSED

RIGHT-OF-WAY LINE

BOUNDARY LINE

PROPERTY LINE

CENTERLINE

DITCH

CURB

EDGE OF PAVEMENT

EASEMENT

FENCE LINE

GRAVEL EDGE

POWER LINE

OVERHEAD WIRE

COMMUNICATIONS LINE

FIBER OPTIC LINE

GAS LINE


STORM SEWER LINE

SANITARY SEWER LINE

WATER LINE

EXISTING

PROPOSED

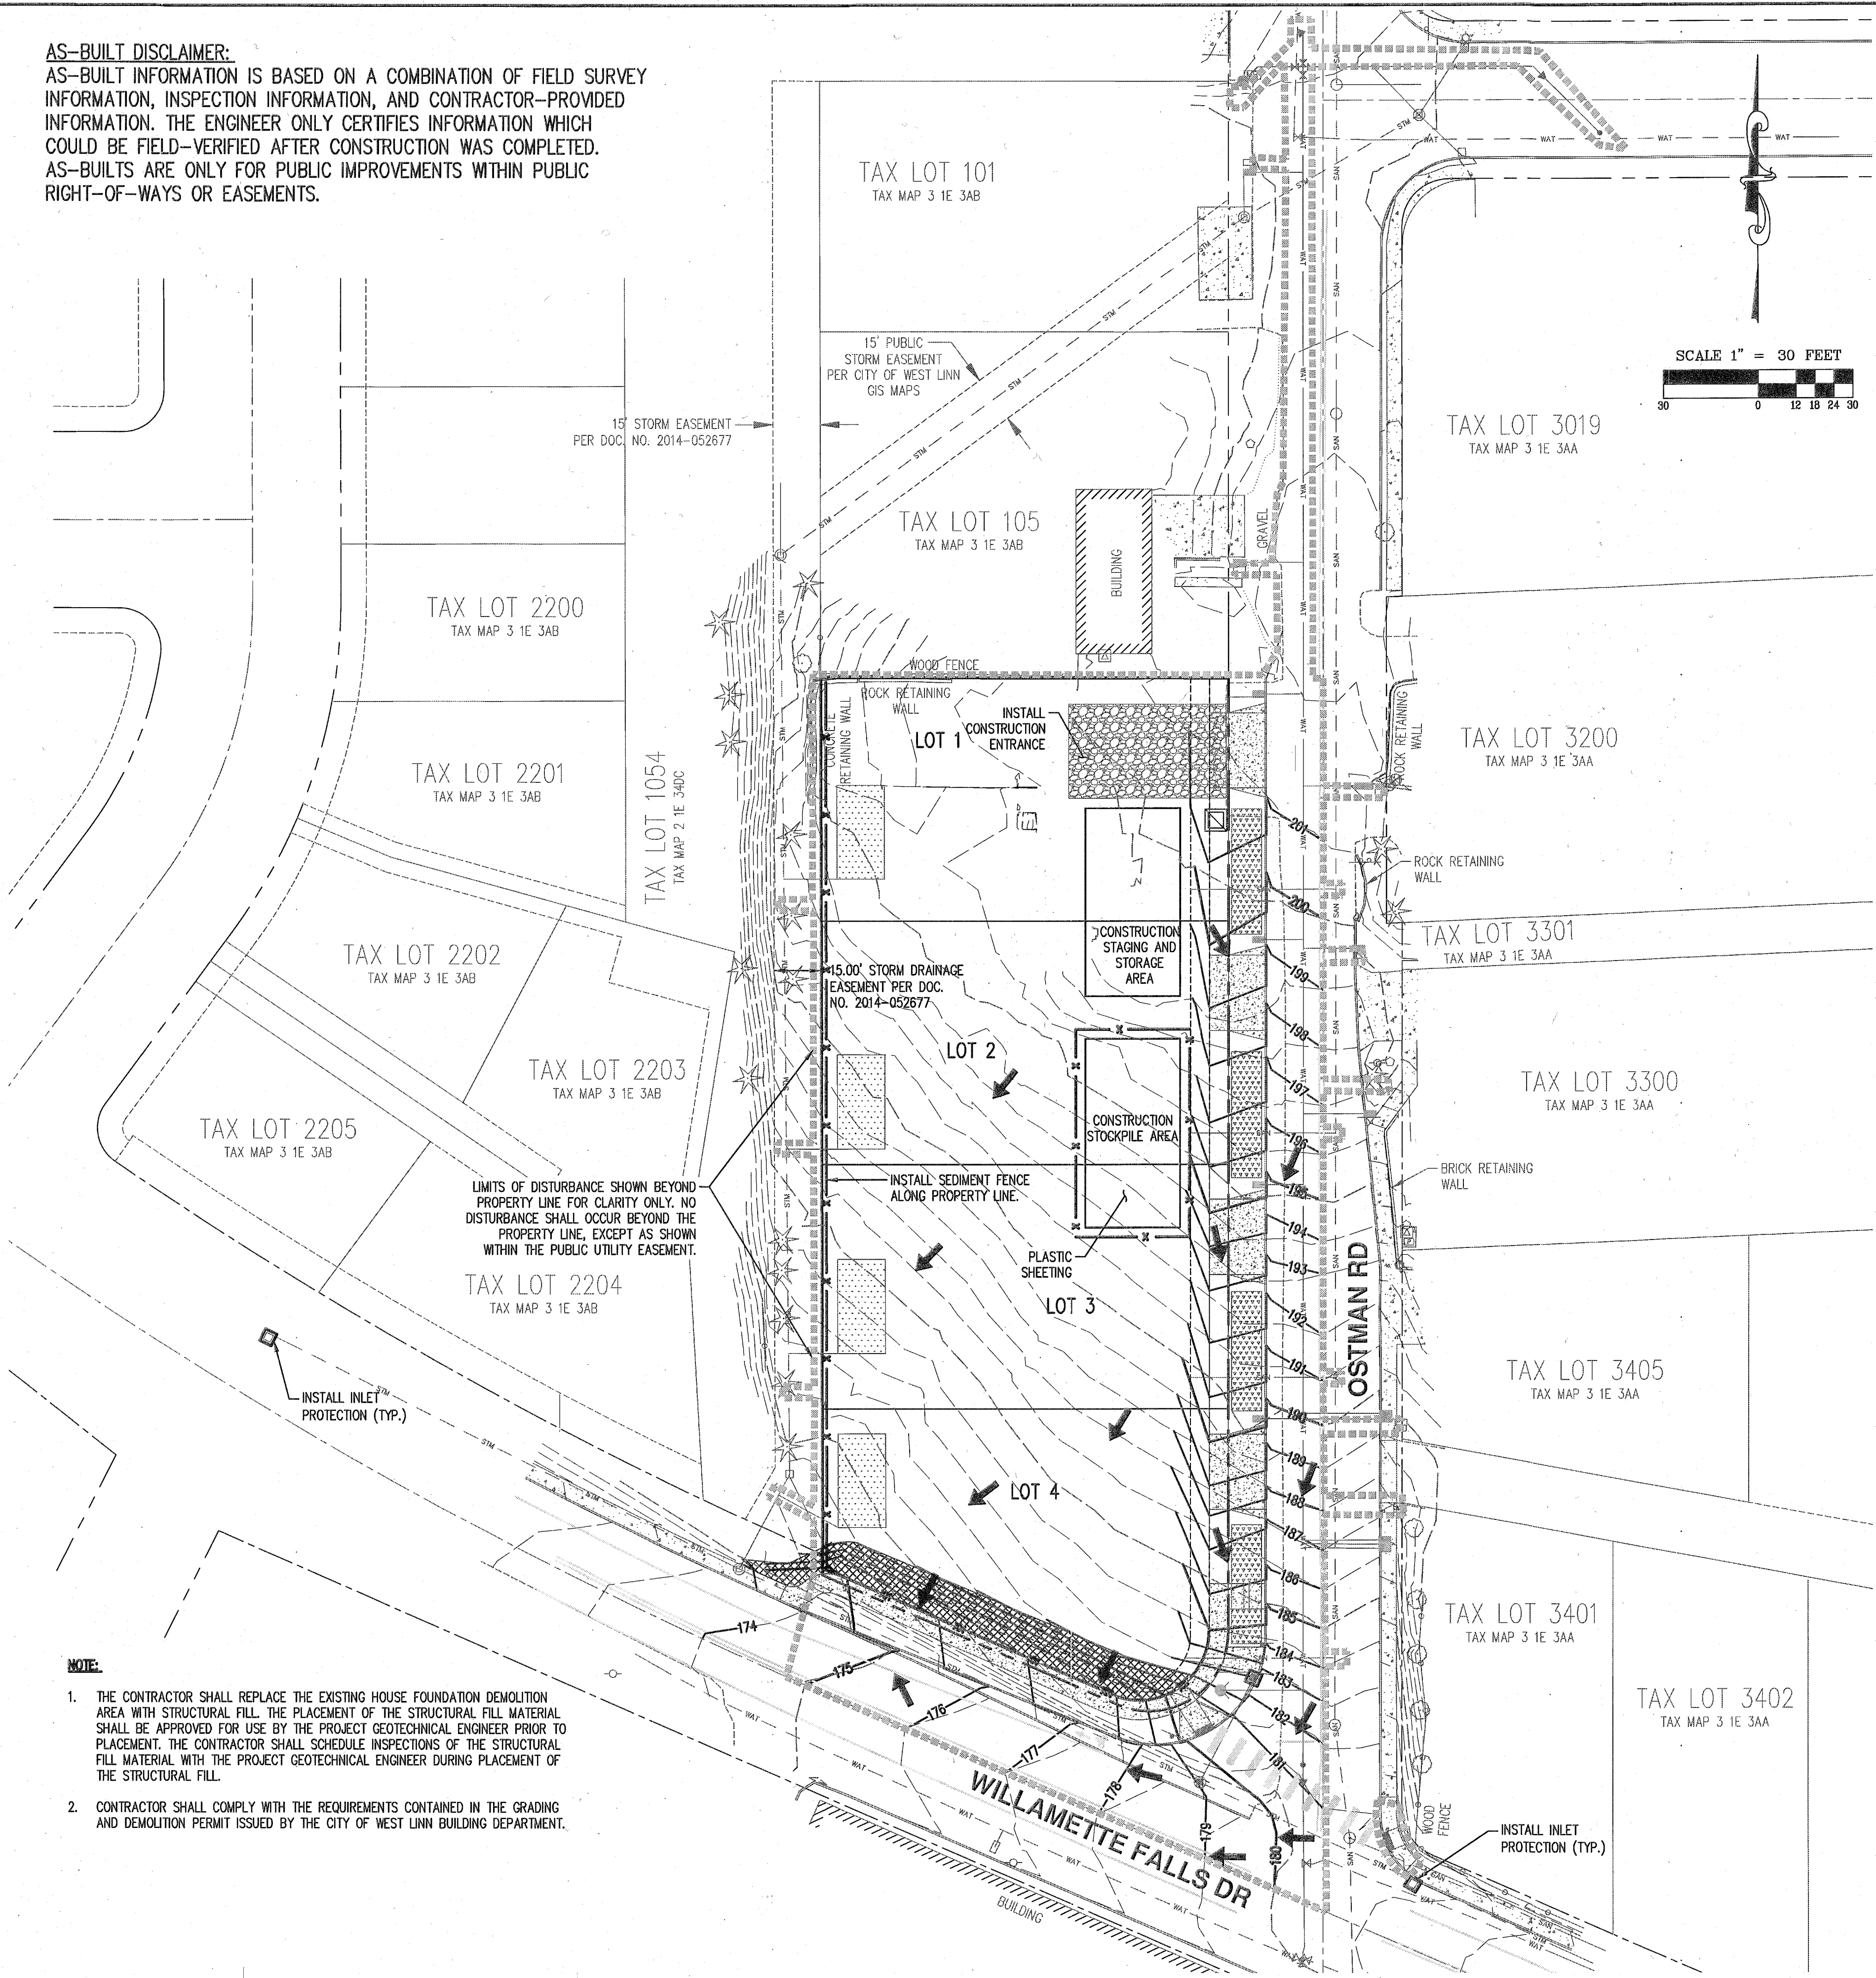

NOTE:

- THE CONTRACTOR SHALL REPLACE THE EXISTING HOUSE FOUNDATION DEMOLITION AREA WITH STRUCTURAL FILL. THE PLACEMENT OF THE STRUCTURAL FILL MATERIAL SHALL BE APPROVED FOR USE BY THE PROJECT GEOTECHNICAL ENGINEER PRIOR TO PLACEMENT. THE CONTRACTOR SHALL SCHEDULE INSPECTIONS OF THE STRUCTURAL FILL MATERIAL WITH THE PROJECT GEOTECHNICAL ENGINEER DURING PLACEMENT OF THE STRUCTURAL FILL.
- CONTRACTOR SHALL COMPLY WITH THE REQUIREMENTS CONTAINED IN THE GRADING AND DEMOLITION PERMIT ISSUED BY THE CITY OF WEST LINN BUILDING DEPARTMENT.


AKS  
AKS ENGINEERING AND FORESTRY, LLC  
2485 SW HERMAN RD  
TUALATA, OR 97062  
PHONE: 503.563.6151  
FAX: 503.563.6152  
WWW.AKS-ENG.COM

RENAISSANCE  
AT WILLAMETTE  
AS-BUILTS  
WEST LINN  
TAX LOT 0200  
OREGON  
CLACKAMAS COUNTY ASSESSOR'S TAXMAP S10303AB  
ENGINEERING • PLANNING • SURVEYING  
LANDSCAPE ARCHITECTURE

PHASE II GRADING AND  
EROSION PLAN


DESIGNED BY: DCN  
DRAWN BY: JDR  
CHECKED BY: MBH  
SCALE: AS NOTED  
DATE: 2/9/2015  
REGISTERED PROFESSIONAL  
ENGINEER  
58542PE  
OREGON  
JULY 9, 2007  
MONTGOMERY B. HUBLEY  
RENEWAL DATE: 6/30/15  
REVISIONS  
JOB NUMBER  
3745  
SHEET  
C052



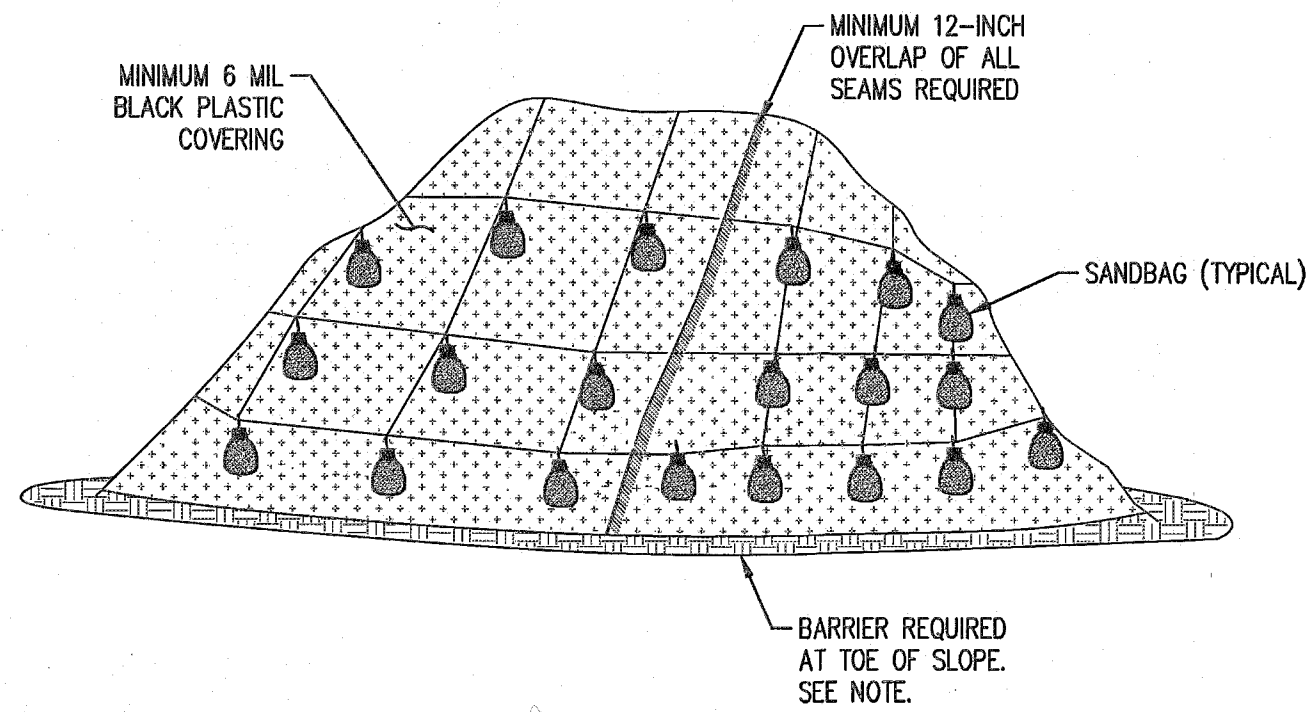


- NOTES:**
- COVERING MAINTAINED TIGHTLY IN PLACE BY USING SANDBAGS OR TIRES ON ROPES WITH A MAXIMUM 10' GRID SPACING IN ALL DIRECTIONS.
  - BARRIER SHALL CONSIST OF SOIL BERM, SILT FENCE, STRAW WATTLE, GRASS LINED DITCH, SANDBAGS, OR OTHER APPROVED MATERIAL.
  - STOCKPILE(S) MUST BE LOCATED IN AREAS THAT WILL NOT IMPOUND OR BLOCK STORMWATER RUNOFF.
  - ALL SEAMS SHALL BE TAPED OR WEIGHTED DOWN FOR FULL LENGTH.
  - PLASTIC SHEETING REQUIRED FOR ALL TEMPORARY STOCKPILED MATERIAL.

**PLASTIC SHEETING**  
NTS

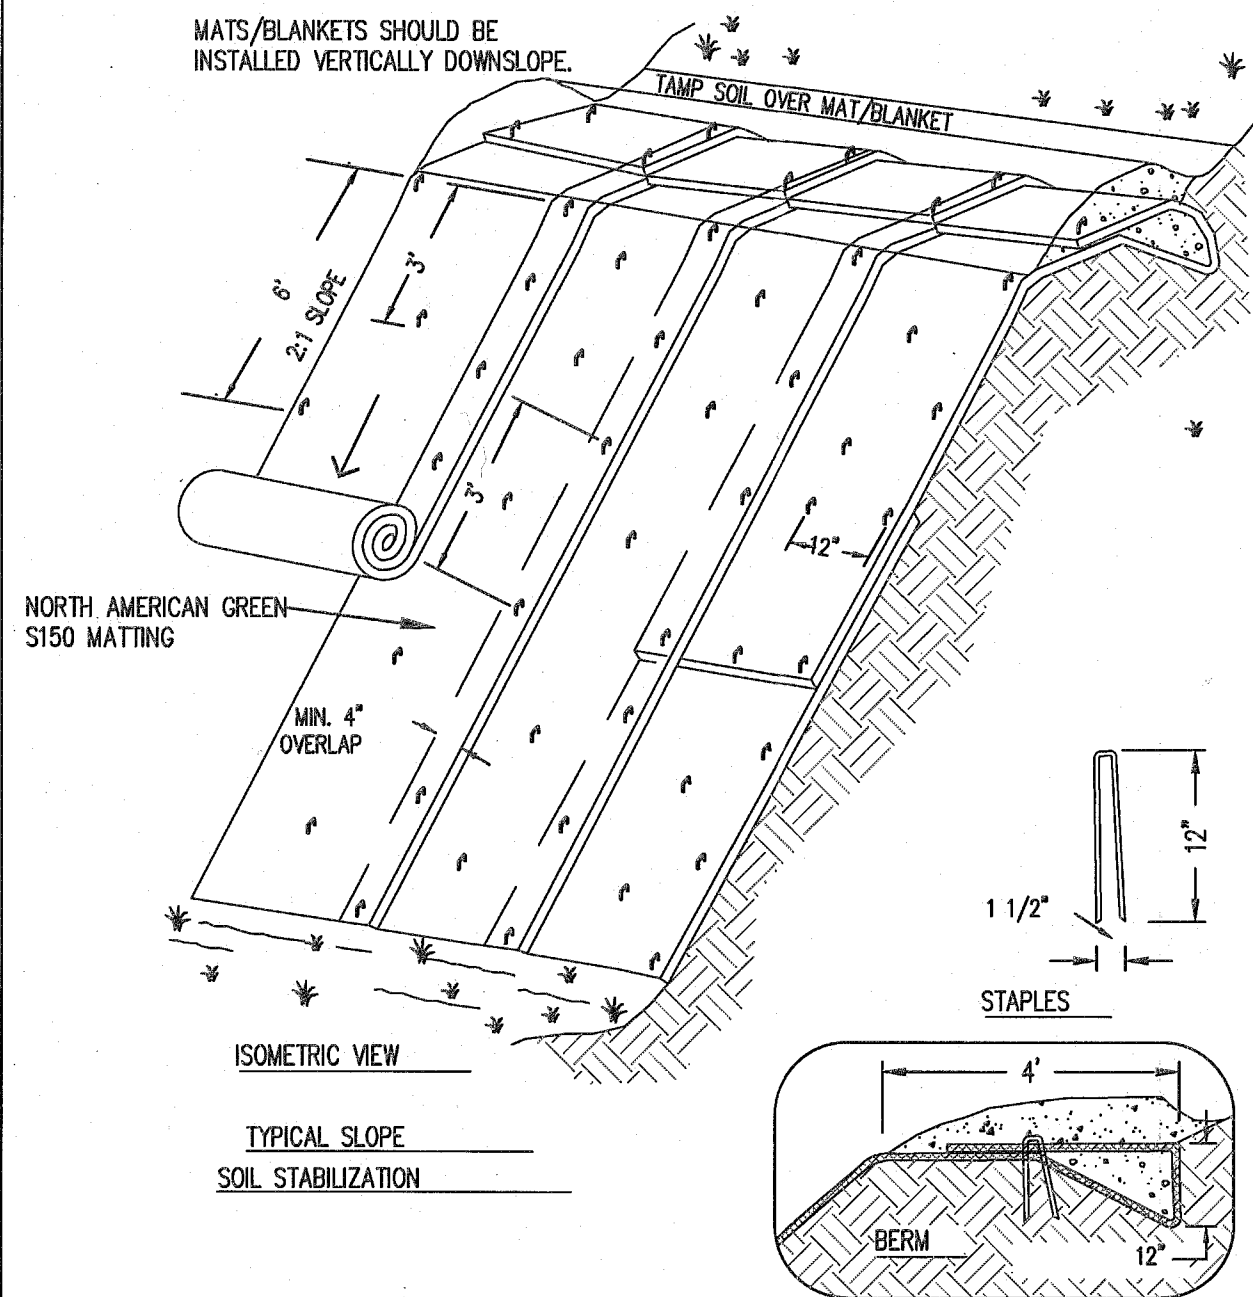


- NOTES:**
- SLOPE SURFACE SHALL BE FREE OF ROCKS, CLOUDS, STICKS AND GRASS. MATS/BLANKETS SHALL HAVE GOOD SOIL CONTACT.
  - APPLY PERMANENT SEEDING BEFORE PLACING BLANKETS.
  - LAY BLANKETS LOOSELY AND STAKE OR STAPLE TO MAINTAIN DIRECT CONTACT WITH THE SOIL. DO NOT STRETCH.
  - STAKING OR STAPLING LAYOUT PER MANUFACTURERS SPECIFICATIONS.

**SLOPE MATTING**  
NTS

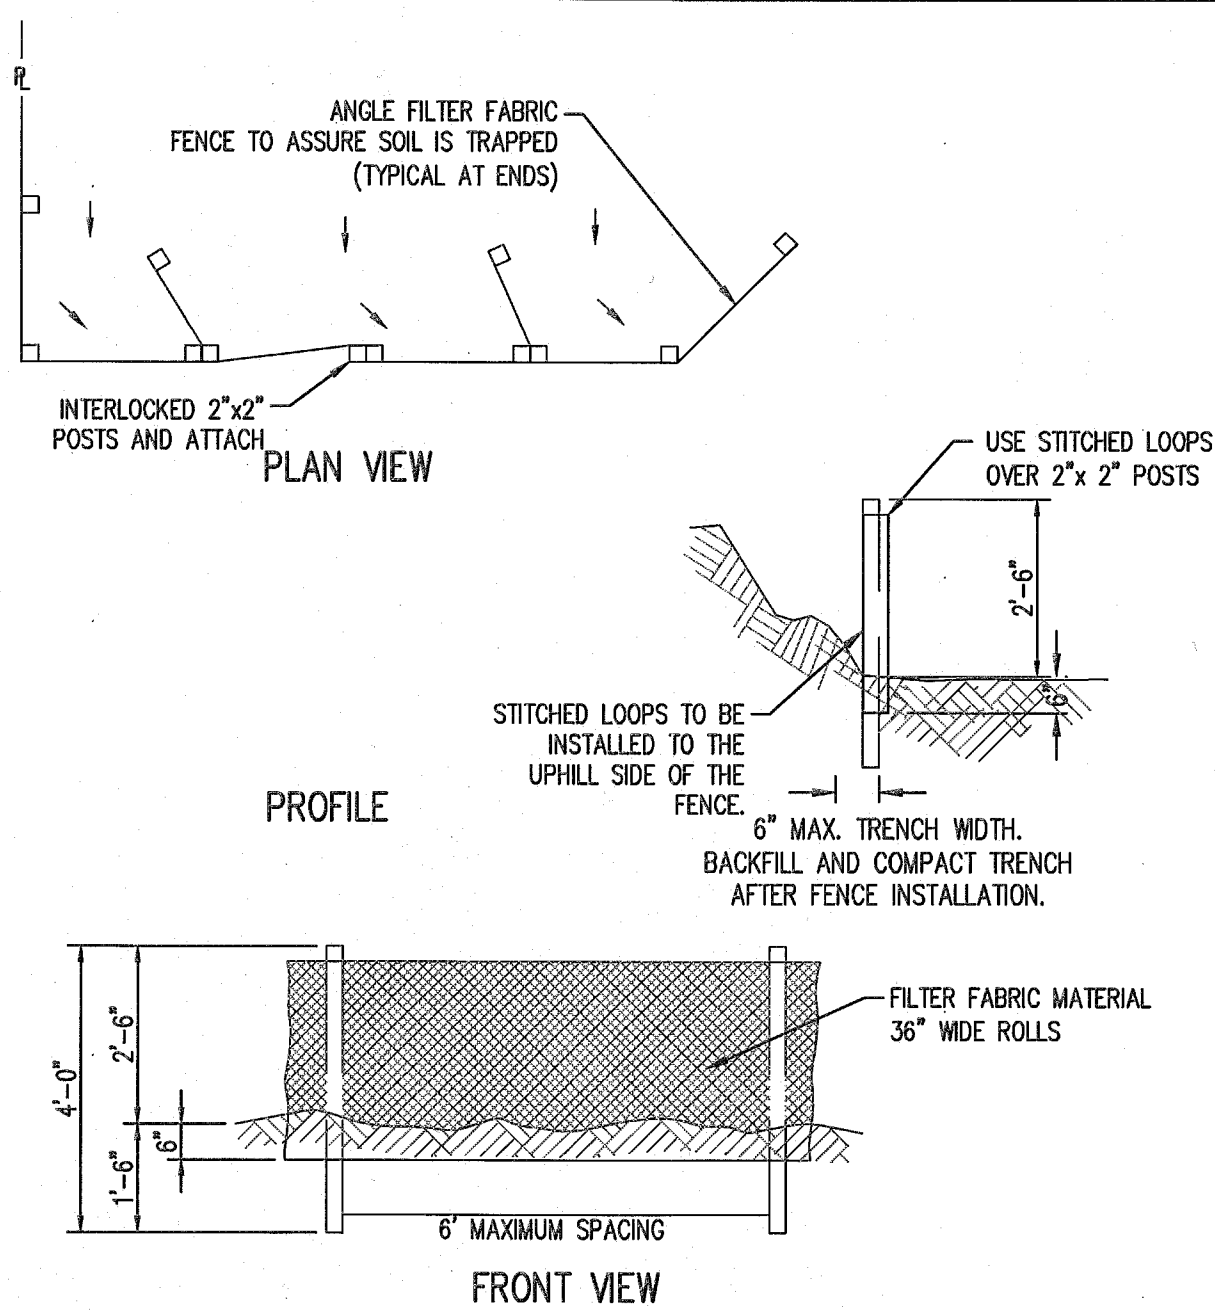

- NOTES:**
- BURY BOTTOM OF FILTER FABRIC 6\"
  - 2\"
- MAINTENANCE NOTES:**
- SEDIMENT BARRIERS SHALL BE MAINTAINED UNTIL UP-SLOPE AREA IS PERMANENTLY STABILIZED.
  - AT NO TIME SHALL MORE THAN 10 INCHES OF SEDIMENT BE ALLOWED TO ACCUMULATE BEHIND SEDIMENT FENCES.
  - NEW SEDIMENT BARRIERS SHALL BE INSTALLED UPHILL AS REQUIRED TO CONTROL SEDIMENT TRANSPORT.
  - SEDIMENT FENCE MUST BE ADEQUATELY SUPPORTED AS REQUIRED TO CONTROL SEDIMENT TRANSPORT.
  - FENCE SHALL NOT BE STAPLED TO EXISTING TREES.
- SEDIMENT FENCE SPECS:**
- SEDIMENT FENCE SHALL BE CONSTRUCTED OF CONTINUOUS FILTER FABRIC TO MINIMIZE USE OF JOINTS.
  - WHEN A JOINT IS REQUIRED, FABRIC SHALL BE SPLICED TOGETHER ONLY AT A SUPPORT POST WITH A MINIMUM 6-INCH OVERLAP AND BOTH ENDS SECURELY FASTENED TO A POST.

**SEDIMENT FENCE**  
NTS

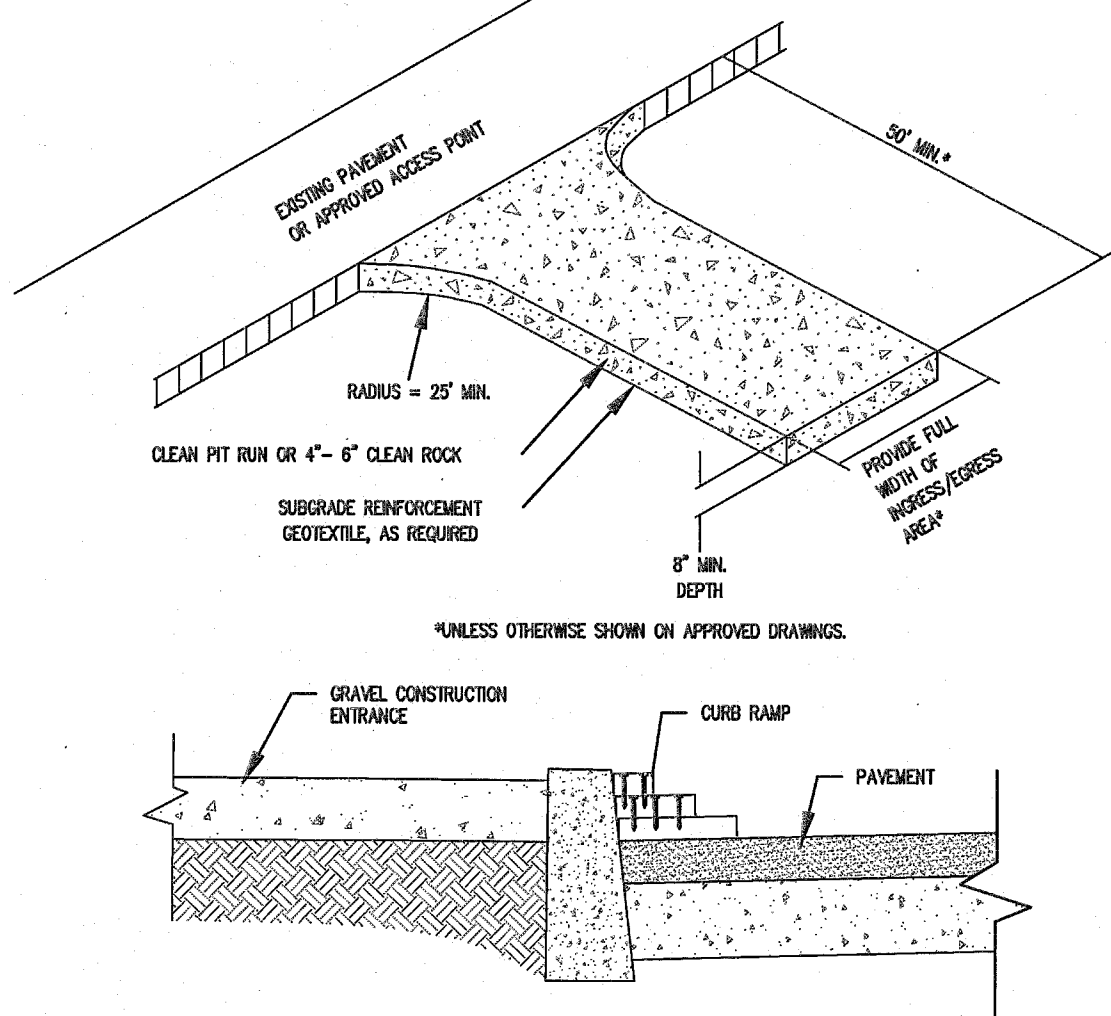

- NOTES:**
- THE ENTRANCE SHALL BE MAINTAINED IN A CONDITION THAT WILL PREVENT TRACKING OR FLOWING OF SEDIMENT ONTO PUBLIC RIGHT-OF-WAYS. THIS MAY REQUIRE TOP DRESSING, REPAIR AND/OR CLEAN OUT OF ANY MEASURES USED TO TRAP SEDIMENT.
  - WHEN NECESSARY, WHEELS SHALL BE CLEANED PRIOR TO ENTRANCE ONTO PUBLIC RIGHT-OF-WAY.
  - WHEN WASHING IS REQUIRED, IT SHALL BE DONE ON AN AREA STABILIZED WITH CRUSHED STONE THAT DRAINS INTO AN APPROVED SEDIMENT TRAP OR SEDIMENT BASIN.
  - WHERE RUNOFF CONTAINING SEDIMENT LADEN WATER IS LEAVING THE SITE VIA THE CONSTRUCTION ENTRANCE, OTHER MEASURES SHALL BE IMPLEMENTED TO DIVERT RUNOFF THROUGH AN APPROVED FILTERING SYSTEM.

**CONSTRUCTION ENTRANCE**  
NTS

## PRE-CONSTRUCTION, CLEARING, AND DEMOLITION NOTES:

- ALL BASE ESC MEASURES (INLET PROTECTION, PERIMETER SEDIMENT CONTROL, GRAVEL CONSTRUCTION ENTRANCES, ETC.) MUST BE IN PLACE, FUNCTIONAL, AND APPROVED IN AN INITIAL INSPECTION, PRIOR TO COMMENCEMENT OF CONSTRUCTION ACTIVITIES.
- SEDIMENT BARRIERS APPROVED FOR USE INCLUDE SEDIMENT FENCE OR OTHER APPROVED MATERIALS.
- SENSITIVE RESOURCES INCLUDING, BUT NOT LIMITED TO, TREES, WETLANDS, AND RIPARIAN PROTECTION AREAS SHALL BE CLEARLY DELINEATED WITH ORANGE CONSTRUCTION FENCING OR CHAIN LINK FENCING IN A MANNER THAT IS CLEARLY VISIBLE TO ANYONE IN THE AREA. NO ACTIVITIES ARE PERMITTED TO OCCUR BEYOND THE CONSTRUCTION BARRIER.
- CONSTRUCTION ENTRANCES SHALL BE INSTALLED AT THE BEGINNING OF CONSTRUCTION AND MAINTAINED FOR THE DURATION OF THE PROJECT. ADDITIONAL MEASURES INCLUDING, BUT NOT LIMITED TO, STREET SWEEPING, AND VACUUMING, MAY BE REQUIRED TO INSURE THAT ALL PAVED AREAS ARE KEPT CLEAN FOR THE DURATION OF THE PROJECT.
- RUN-ON AND RUN-OFF CONTROLS SHALL BE IN PLACE AND FUNCTIONING PRIOR TO BEGINNING SUBSTANTIAL CONSTRUCTION ACTIVITIES.

### AS-BUILT DISCLAIMER:

AS-BUILT INFORMATION IS BASED ON A COMBINATION OF FIELD SURVEY INFORMATION, INSPECTION INFORMATION, AND CONTRACTOR-PROVIDED INFORMATION. THE ENGINEER ONLY CERTIFIES INFORMATION WHICH COULD BE FIELD-VERIFIED AFTER CONSTRUCTION WAS COMPLETED. AS-BUILTS ARE ONLY FOR PUBLIC IMPROVEMENTS WITHIN PUBLIC RIGHT-OF-WAYS OR EASEMENTS.

## EROSION AND SEDIMENT CONTROL BMP IMPLEMENTATION:

- ALL BASE ESC MEASURES (INLET PROTECTION, PERIMETER SEDIMENT CONTROL, GRAVEL CONSTRUCTION ENTRANCES, ETC.) MUST BE IN PLACE, FUNCTIONAL, AND APPROVED IN AN INITIAL INSPECTION, PRIOR TO COMMENCEMENT OF CONSTRUCTION ACTIVITIES.
- ALL "SEDIMENT BARRIERS (TO BE INSTALLED AFTER GRADING)" SHALL BE INSTALLED IMMEDIATELY FOLLOWING ESTABLISHMENT OF FINISHED GRADE AS SHOWN ON THESE PLANS.
- INLET PROTECTION SHALL BE IN-PLACE IMMEDIATELY FOLLOWING PAVING ACTIVITIES.
- LONG TERM SLOPE STABILIZATION MEASURES SHALL BE IN PLACE OVER AREAS WITH A SLOPE MORE THAN 5:1.

## OTHER MISCELLANEOUS BMP NOTES:

### TO PREVENT ILLICIT CONNECTION AND ILLEGAL DISCHARGE:

- INSPECT SITE BEFORE BEGINNING THE JOB FOR EVIDENCE OF ILLICIT CONNECTIONS OR ILLEGAL DUMPING OR DISCHARGES.
- INSPECT SITE REGULARLY DURING PROJECT EXECUTION FOR EVIDENCE OF ILLICIT CONNECTIONS OR ILLEGAL DUMPING OR DISCHARGES.
- OBSERVE SITE PERIMETER FOR EVIDENCE OR POTENTIAL OF ILLICITLY DISCHARGED OR ILLEGALLY DUMPED MATERIAL WHICH MAY ENTER THE JOB SITE.
- IDENTIFICATION OF ILLICIT CONNECTIONS AND ILLEGAL DUMPING OR DISCHARGES:
  - SOLIDS: LOOK FOR DEBRIS, OR RUBBISH PILES. SOLID WASTE DUMPING OFTEN OCCURS ON ROADWAYS WITH LIGHT TRAFFIC LOADS OR IN AREAS NOT EASILY VISIBLE FROM THE TRAVELED WAY.
  - LIQUIDS:
    - VISIBLE SIGNS OF STAINING OR UNUSUAL COLORS TO THE PAVEMENT OR SURROUNDING ADJACENT SOILS.
    - DISCOLORATION OR OILY SUBSTANCES IN THE WATER OR STAINS AND RESIDUES DETAINED WITH DITCHES, CHANNELS OR DRAINAGE BOXES.
    - PUNGENT ODORS COMING FROM THE DRAINAGE SYSTEMS.
    - ABNORMAL WATER FLOW DURING THE DRY WEATHER SEASON.
    - URBAN AREAS - EVIDENCE OF ILLICIT CONNECTIONS OR ILLEGAL DISCHARGES IS TYPICALLY DETECTED AT THE STORM DRAIN OUTFALL LOCATIONS OR AT THE MANHOLES. SIGNS OF AN ILLICIT CONNECTION OR ILLEGAL DISCHARGE CAN INCLUDE:
      - ABNORMAL WATER FLOW DURING THE DRY WEATHER SEASON.
      - UNUSUAL FLOWS IN SUB-DRAIN SYSTEMS USED FOR DEWATERING.
      - PUNGENT ODORS COMING FROM THE DRAINAGE SYSTEMS.
      - DISCOLORATION OR OILY SUBSTANCES IN THE WATER OR STAINS AND RESIDUES DETAINED WITHIN DITCHES.
      - EXCESSIVE SEDIMENT DEPOSITS, PARTICULARLY ADJACENT TO OR NEAR ACTIVE OFF-SITE CONSTRUCTION.


- NOTIFY THE PROJECT SUPERINTENDENT OF ANY ILLICIT CONNECTIONS, DUMPINGS, OR DISCHARGES AT THE TIME OF DISCOVERY.
- VEHICLES AND EQUIPMENT SHOULD BE WASHED OFF SITE AT A CONTROLLED WASH FACILITY WHEN AT ALL POSSIBLE.
- USE "DRY CLEANING METHODS" SUCH AS WIPING DOWN WHENEVER POSSIBLE RATHER THAN WATER WASHING VEHICLES ON SITE.
- IF CLEANING MUST BE CONDUCTED ON-SITE, IT SHALL BE CONDUCTED IN A DEDICATED AREA WITH THE FOLLOWING CHARACTERISTICS:
  - LOCATED AWAY FROM THE STORM DRAIN INLETS, DRAINAGE FACILITIES, OR WATERCOURSES.
  - PAVED WITH CONCRETE OR ASPHALT, OR STABILIZED WITH AN AGGREGATE BASE.
  - BERMED TO CONTAIN WASH WATERS AND TO PREVENT RUN-ON AND RUNOFF.
  - CONFIGURED WASH AREA WITH A SUMP TO ALLOW COLLECTION AND DISPOSAL OF WASH WATER.
  - DISCHARGE WASH WATER TO A SANITARY OR PROCESS WASTE SEWER (WHERE PERMITTED), OR TO A DEAD END SUMP. WASH WATERS SHALL NOT BE DISCHARGED TO STORM DRAINS OR WATERCOURSES.
  - USED ONLY WHEN NECESSARY.
- WHEN CLEANING VEHICLES OR EQUIPMENT WITH WATER:
  - USE AS LITTLE WATER AS POSSIBLE. CONSIDER USING A HIGH PRESSURE SPRAYER AND USE THE POSITIVE SHUTOFF VALVE.
  - DO NOT USE SOLVENTS OR DETERGENTS TO CLEAN VEHICLES OR EQUIPMENT ON SITE.
  - DO NOT USE STEAM CLEANING ON SITE.
- INSPECT AND CLEAN WORK AREAS REGULARLY TO LIMIT WIND BLOWN DEBRIS AND POLLUTANTS TRANSPORTED BY STORMWATER.

### TO REUSE AND RECYCLE CONSTRUCTION WASTES:

- USE TRENCH SPOILS AND CUT AREA SOIL FOR FILL. UNSUITABLE AND EXCESS MATERIAL SHALL BE HAULED OFF SITE TO AN APPROVED LOCATION. IMPORTED FILL MATERIAL SHALL BE APPROVED BY THE PROJECT'S GEOTECHNICAL ENGINEER.

## GRADING, STREET, AND UTILITY EROSION AND SEDIMENT CONSTRUCTION NOTES:

- LONG TERM SLOPE STABILIZATION MEASURES SHALL INCLUDE THE ESTABLISHMENT OF PERMANENT VEGETATIVE COVER VIA SLOPE MATTING.
- TEMPORARY SLOPE STABILIZATION MEASURES SHALL INCLUDE: COVERING EXPOSED SOIL WITH PLASTIC SHEETING, STRAW MULCHING, OR OTHER APPROVED MEASURES.
- STOCKPILED SOIL OR STRIPPINGS SHALL BE PLACED IN A STABLE LOCATION AND CONFIGURATION. DURING "WET WEATHER" PERIODS, STOCKPILES SHALL BE COVERED WITH PLASTIC SHEETING. SEDIMENT FENCE IS REQUIRED AROUND THE PERIMETER OF THE STOCKPILE.
- EXPOSED CUT OR FILL AREAS SHALL BE STABILIZED THROUGH THE USE OF TEMPORARY SEEDING AND MULCHING, EROSION CONTROL BLANKETS OR MATS, MID-SLOPE SEDIMENT FENCES OR WATTLES, OR OTHER APPROPRIATE MEASURES. SLOPES EXCEEDING 25% MAY REQUIRE ADDITIONAL EROSION CONTROL MEASURES.
- AREAS SUBJECT TO WIND EROSION SHALL USE APPROPRIATE DUST CONTROL MEASURES INCLUDING THE APPLICATION OF A FINE SPRAY OF WATER, PLASTIC SHEETING, STRAW MULCHING, OR OTHER APPROVED MEASURES.
- CONSTRUCTION ENTRANCES SHALL BE INSTALLED AT THE BEGINNING OF CONSTRUCTION AND MAINTAINED FOR THE DURATION OF THE PROJECT. ADDITIONAL MEASURES INCLUDING, BUT NOT LIMITED TO, TIRE WASHES, STREET SWEEPING, AND VACUUMING MAY BE REQUIRED TO INSURE THAT ALL PAVED AREAS ARE KEPT CLEAN FOR THE DURATION OF THE PROJECT.
- ACTIVE INLETS TO STORM WATER SYSTEMS SHALL BE PROTECTED THROUGH THE USE OF APPROVED INLET PROTECTION MEASURES. ALL INLET PROTECTION MEASURES ARE TO BE REGULARLY INSPECTED AND MAINTAINED AS NEEDED.
- SATURATED MATERIALS THAT ARE HAULED OFF-SITE MUST BE TRANSPORTED IN WATER-TIGHT TRUCKS TO ELIMINATE SPILLAGE OF SEDIMENT AND SEDIMENT-LADEN WATER.
- AN AREA SHALL BE PROVIDED FOR THE WASHING OUT OF CONCRETE TRUCKS IN A LOCATION THAT DOES NOT PROVIDE RUN-OFF THAT CAN ENTER THE STORM WATER SYSTEM. IF THE CONCRETE WASH-OUT AREA CAN NOT BE CONSTRUCTED GREATER THAN 50' FROM ANY DISCHARGE POINT, SECONDARY MEASURES SUCH AS BERMS OR TEMPORARY SETTLING PITS MAY BE REQUIRED. THE WASH-OUT SHALL BE LOCATED WITHIN SIX FEET OF TRUCK ACCESS AND BE CLEANED WHEN IT REACHES 50% OF THE CAPACITY.
- SWEEPINGS FROM EXPOSED AGGREGATE CONCRETE SHALL NOT BE TRANSFERRED TO THE STORMWATER SYSTEM. SWEEPINGS SHALL BE PICKED UP AND DISPOSED IN THE TRASH.
- AVOID PAVING IN WET WEATHER WHEN PAVING CHEMICALS CAN RUN-OFF INTO THE STORMWATER SYSTEM.
- USE BMPs SUCH AS INLET PROTECTION TO PREVENT RUN-OFF FROM REACHING DISCHARGE POINTS.
- COVER CATCH BASINS, MANHOLES, AND OTHER DISCHARGE POINTS WHEN APPLYING SEAL COAT, TACK COAT, ETC. TO PREVENT INTRODUCING THESE MATERIALS TO THE STORM WATER SYSTEM.

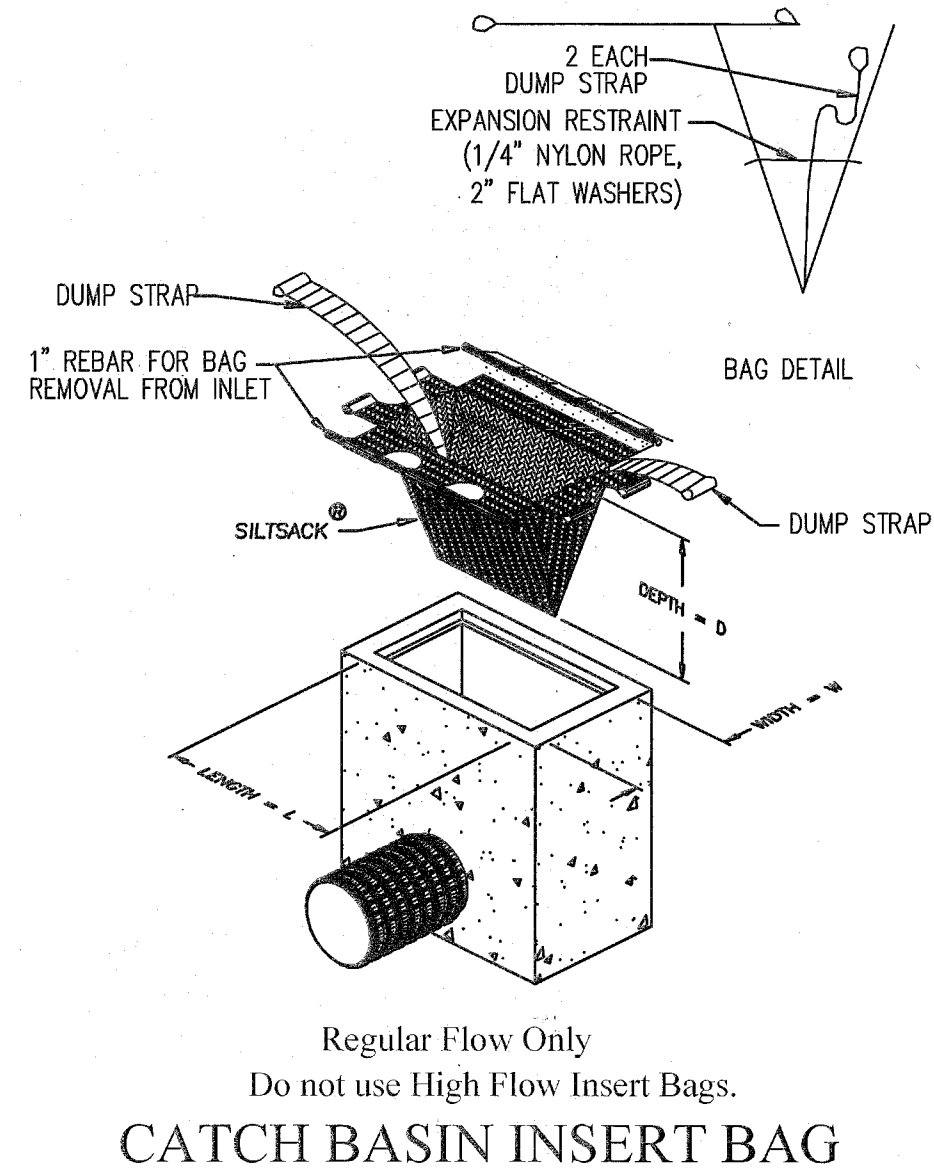

Regular Flow Only  
Do not use High Flow Insert Bags.

**CATCH BASIN INSERT BAG**

- NOTES:**
- RECESSED CURB INLET CATCH BASINS MUST BE BLOCKED WHEN USING FILTER FABRIC INLET SACKS. SIZE OF FILTER FABRIC INLET SACKS TO BE DETERMINED BY MANUFACTURER.

**INLET PROTECTION DETAIL**  
NTS




AKS  
AKS ENGINEERING AND FORESTRY, LLC  
12965 SW HERMAN RD  
TUALATIN, OR 97062  
PHONE: 503.663.6151  
FAX: 503.663.6152  
www.aks-eng.com

ENGINEERING • PLANNING • SURVEYING  
FORESTRY • LANDSCAPE ARCHITECTURE


RENAISSANCE  
AT WILLAMETTE  
AS-BUILTS  
WEST LINN  
TAX LOT 0200  
OREGON  
CLATSOP COUNTY ASSESSOR'S TAXMAP SHEET 38

STREET PLAN AND  
CROSS SECTIONS

DESIGNED BY: DCN  
DRAWN BY: JDR  
CHECKED BY: MBH  
SCALE: AS NOTED  
DATE: 2/9/2015  
REGISTERED PROFESSIONAL  
ENGINEER  
58542PE  
J. B. BROWN  
MONTGOMERY B. BUREY  
RENEWAL DATE: 6/30/15  
REVISIONS  
JOB NUMBER  
3745  
SHEET  
C100

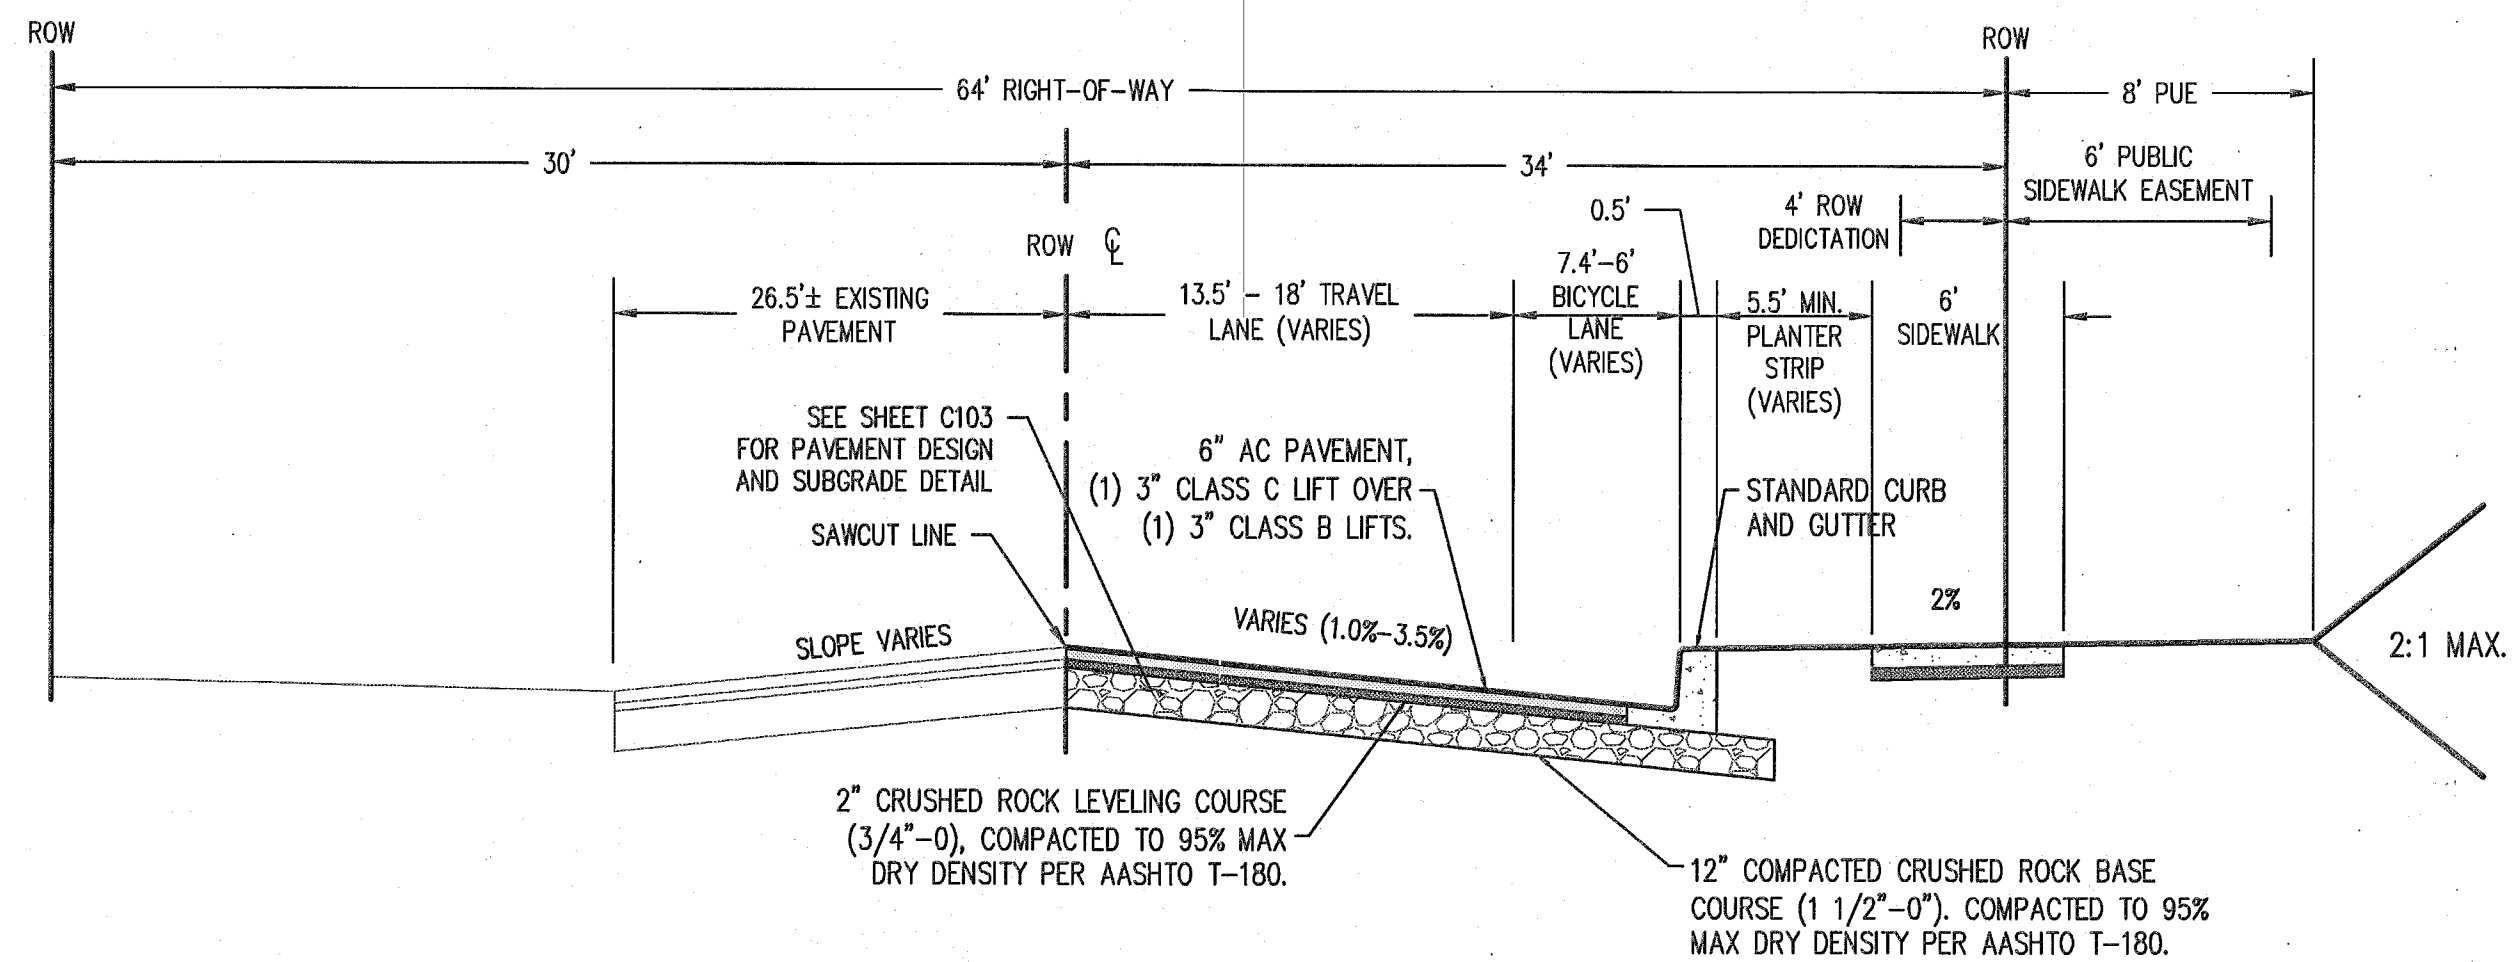


WILLAMETTE FALLS DRIVE (HALF STREET)  
CROSS-SECTION  
STA 10+00.00 – STA 11+95.24 (WILLAMETTE FALLS)  
NOT TO SCALE

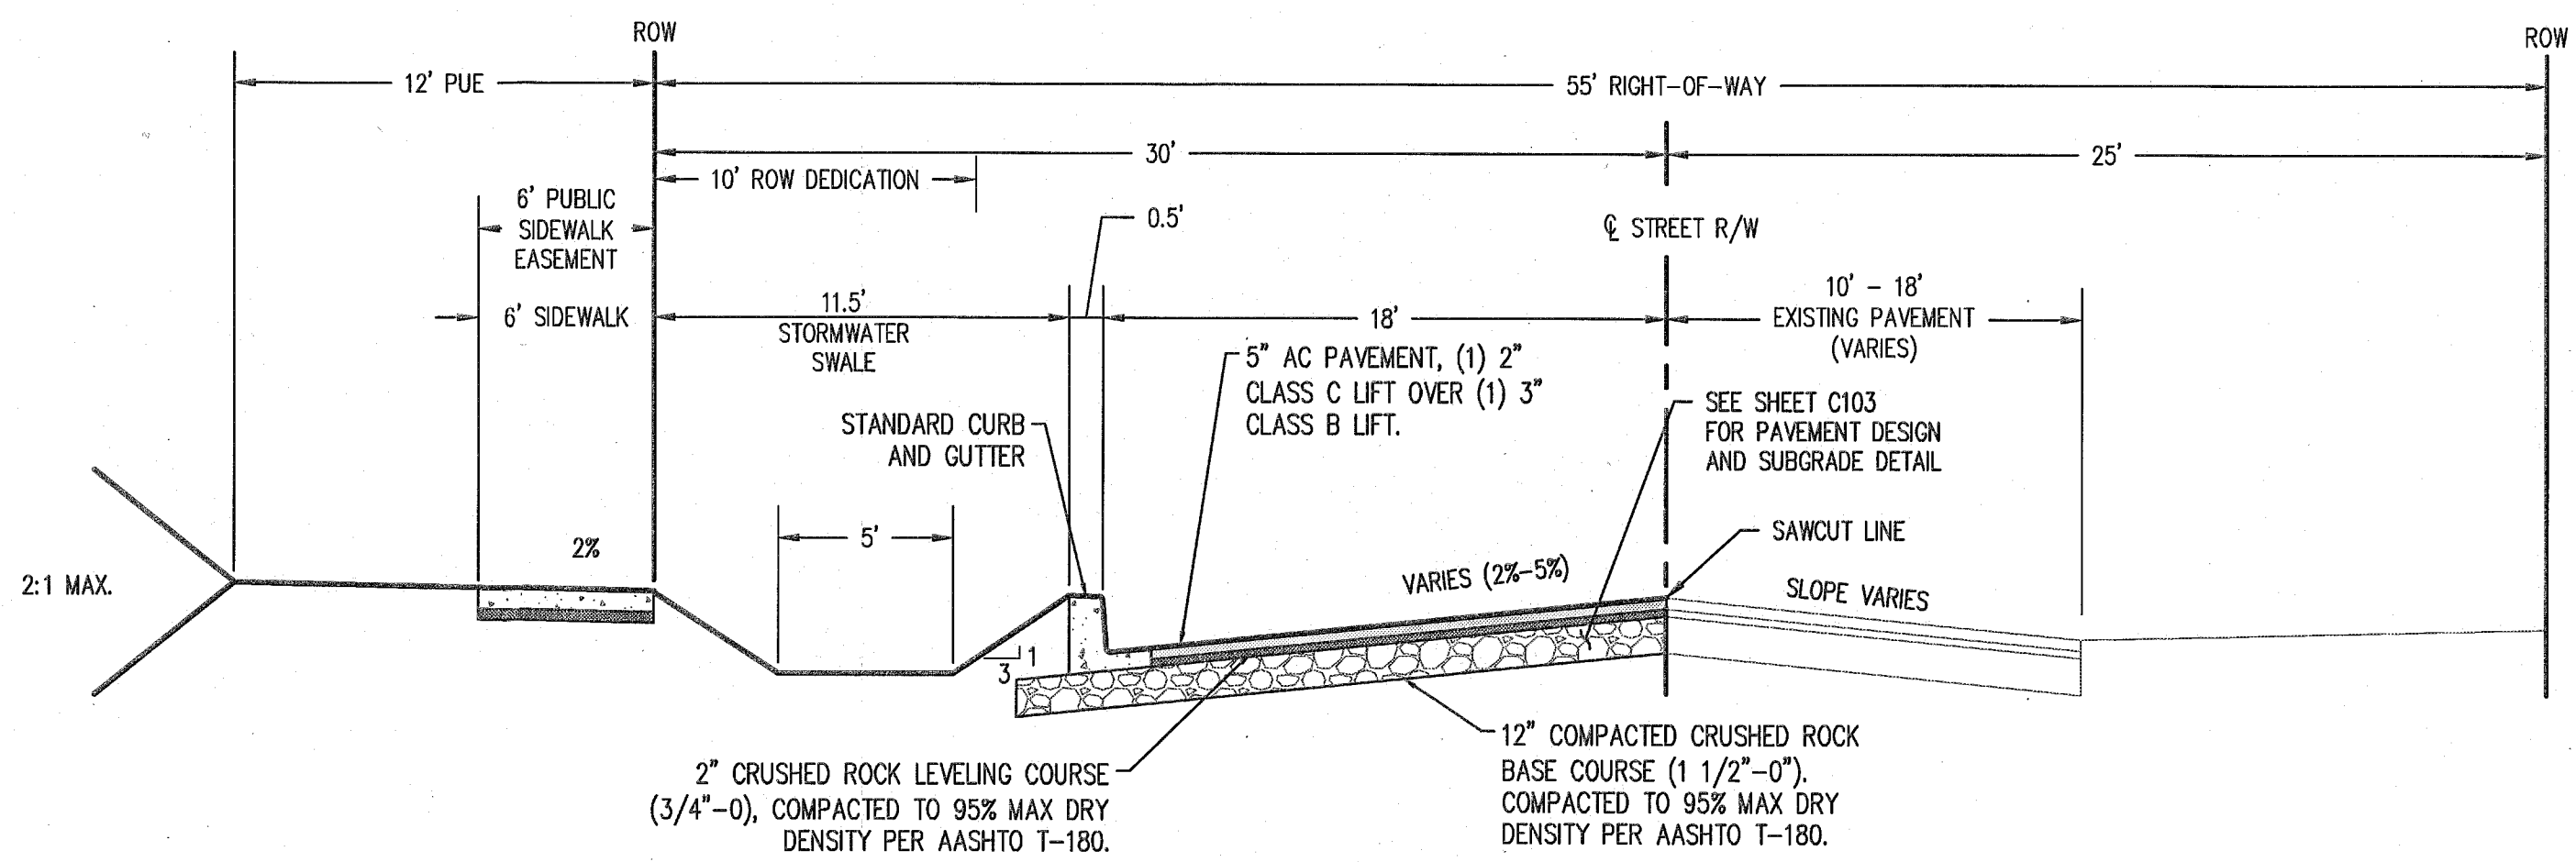

OSTMAN ROAD (HALF STREET)  
CROSS-SECTION  
STA 10+00.00 – STA 14+07.21 (OSTMAN)  
NOT TO SCALE

NOTE:  
1. ALL PUBLIC CONSTRUCTION SHALL BE IN COMPLIANCE WITH THE CITY OF WEST LINN PUBLIC WORKS STANDARD CONSTRUCTION SPECIFICATIONS, DIVISIONS, AND STREET TECHNICAL REQUIREMENTS.

AS-BUILT DISCLAIMER:  
AS-BUILT INFORMATION IS BASED ON A COMBINATION OF FIELD SURVEY INFORMATION, INSPECTION INFORMATION, AND CONTRACTOR-PROVIDED INFORMATION. THE ENGINEER ONLY CERTIFIES INFORMATION WHICH COULD BE FIELD-VERIFIED AFTER CONSTRUCTION WAS COMPLETED. AS-BUILTS ARE ONLY FOR PUBLIC IMPROVEMENTS WITHIN PUBLIC RIGHT-OF-WAYS OR EASEMENTS.

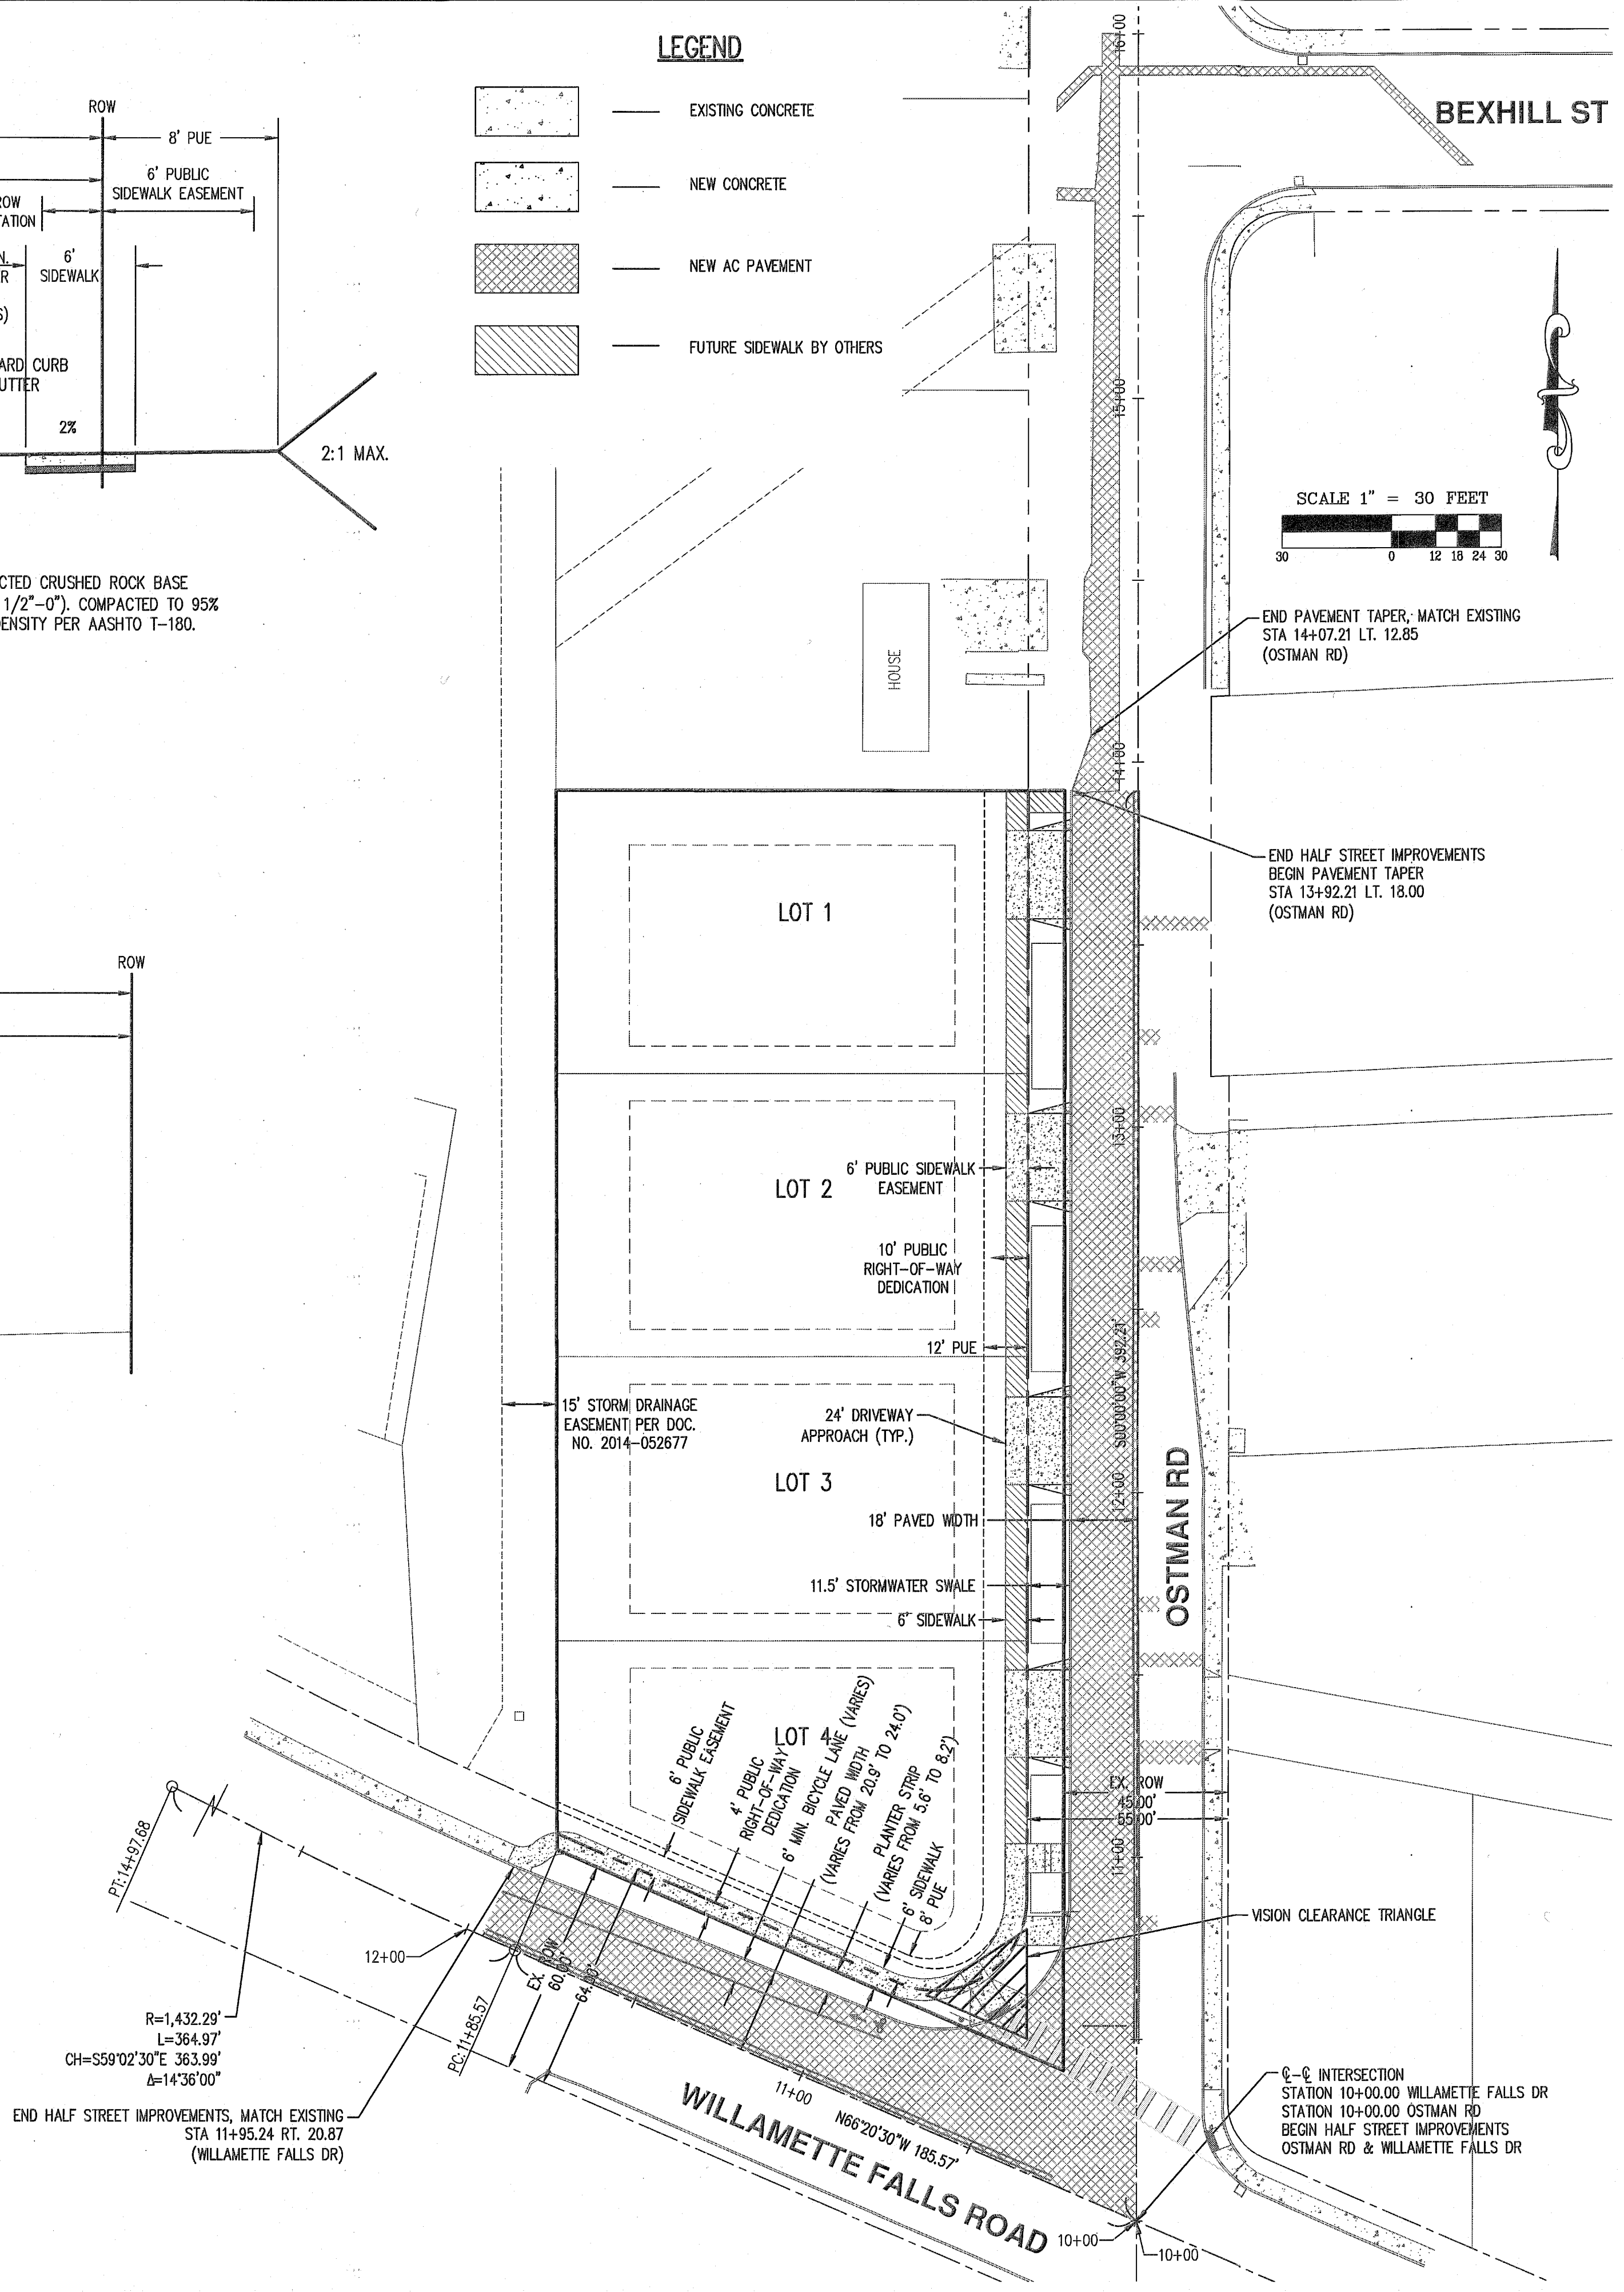



AS-BUILT DISCLAIMER:  
AS-BUILT INFORMATION IS BASED ON A COMBINATION OF FIELD SURVEY INFORMATION, INSPECTION INFORMATION, AND CONTRACTOR-PROVIDED INFORMATION. THE ENGINEER ONLY CERTIFIES INFORMATION WHICH COULD BE FIELD-VERIFIED AFTER CONSTRUCTION WAS COMPLETED. AS-BUILTS ARE ONLY FOR PUBLIC IMPROVEMENTS WITHIN PUBLIC RIGHT-OF-WAYS OR EASEMENTS.



**LEGEND**

EXISTING CONCRETE

NEW CONCRETE


NEW AC PAVEMENT

FUTURE SIDEWALK BY OTHERS

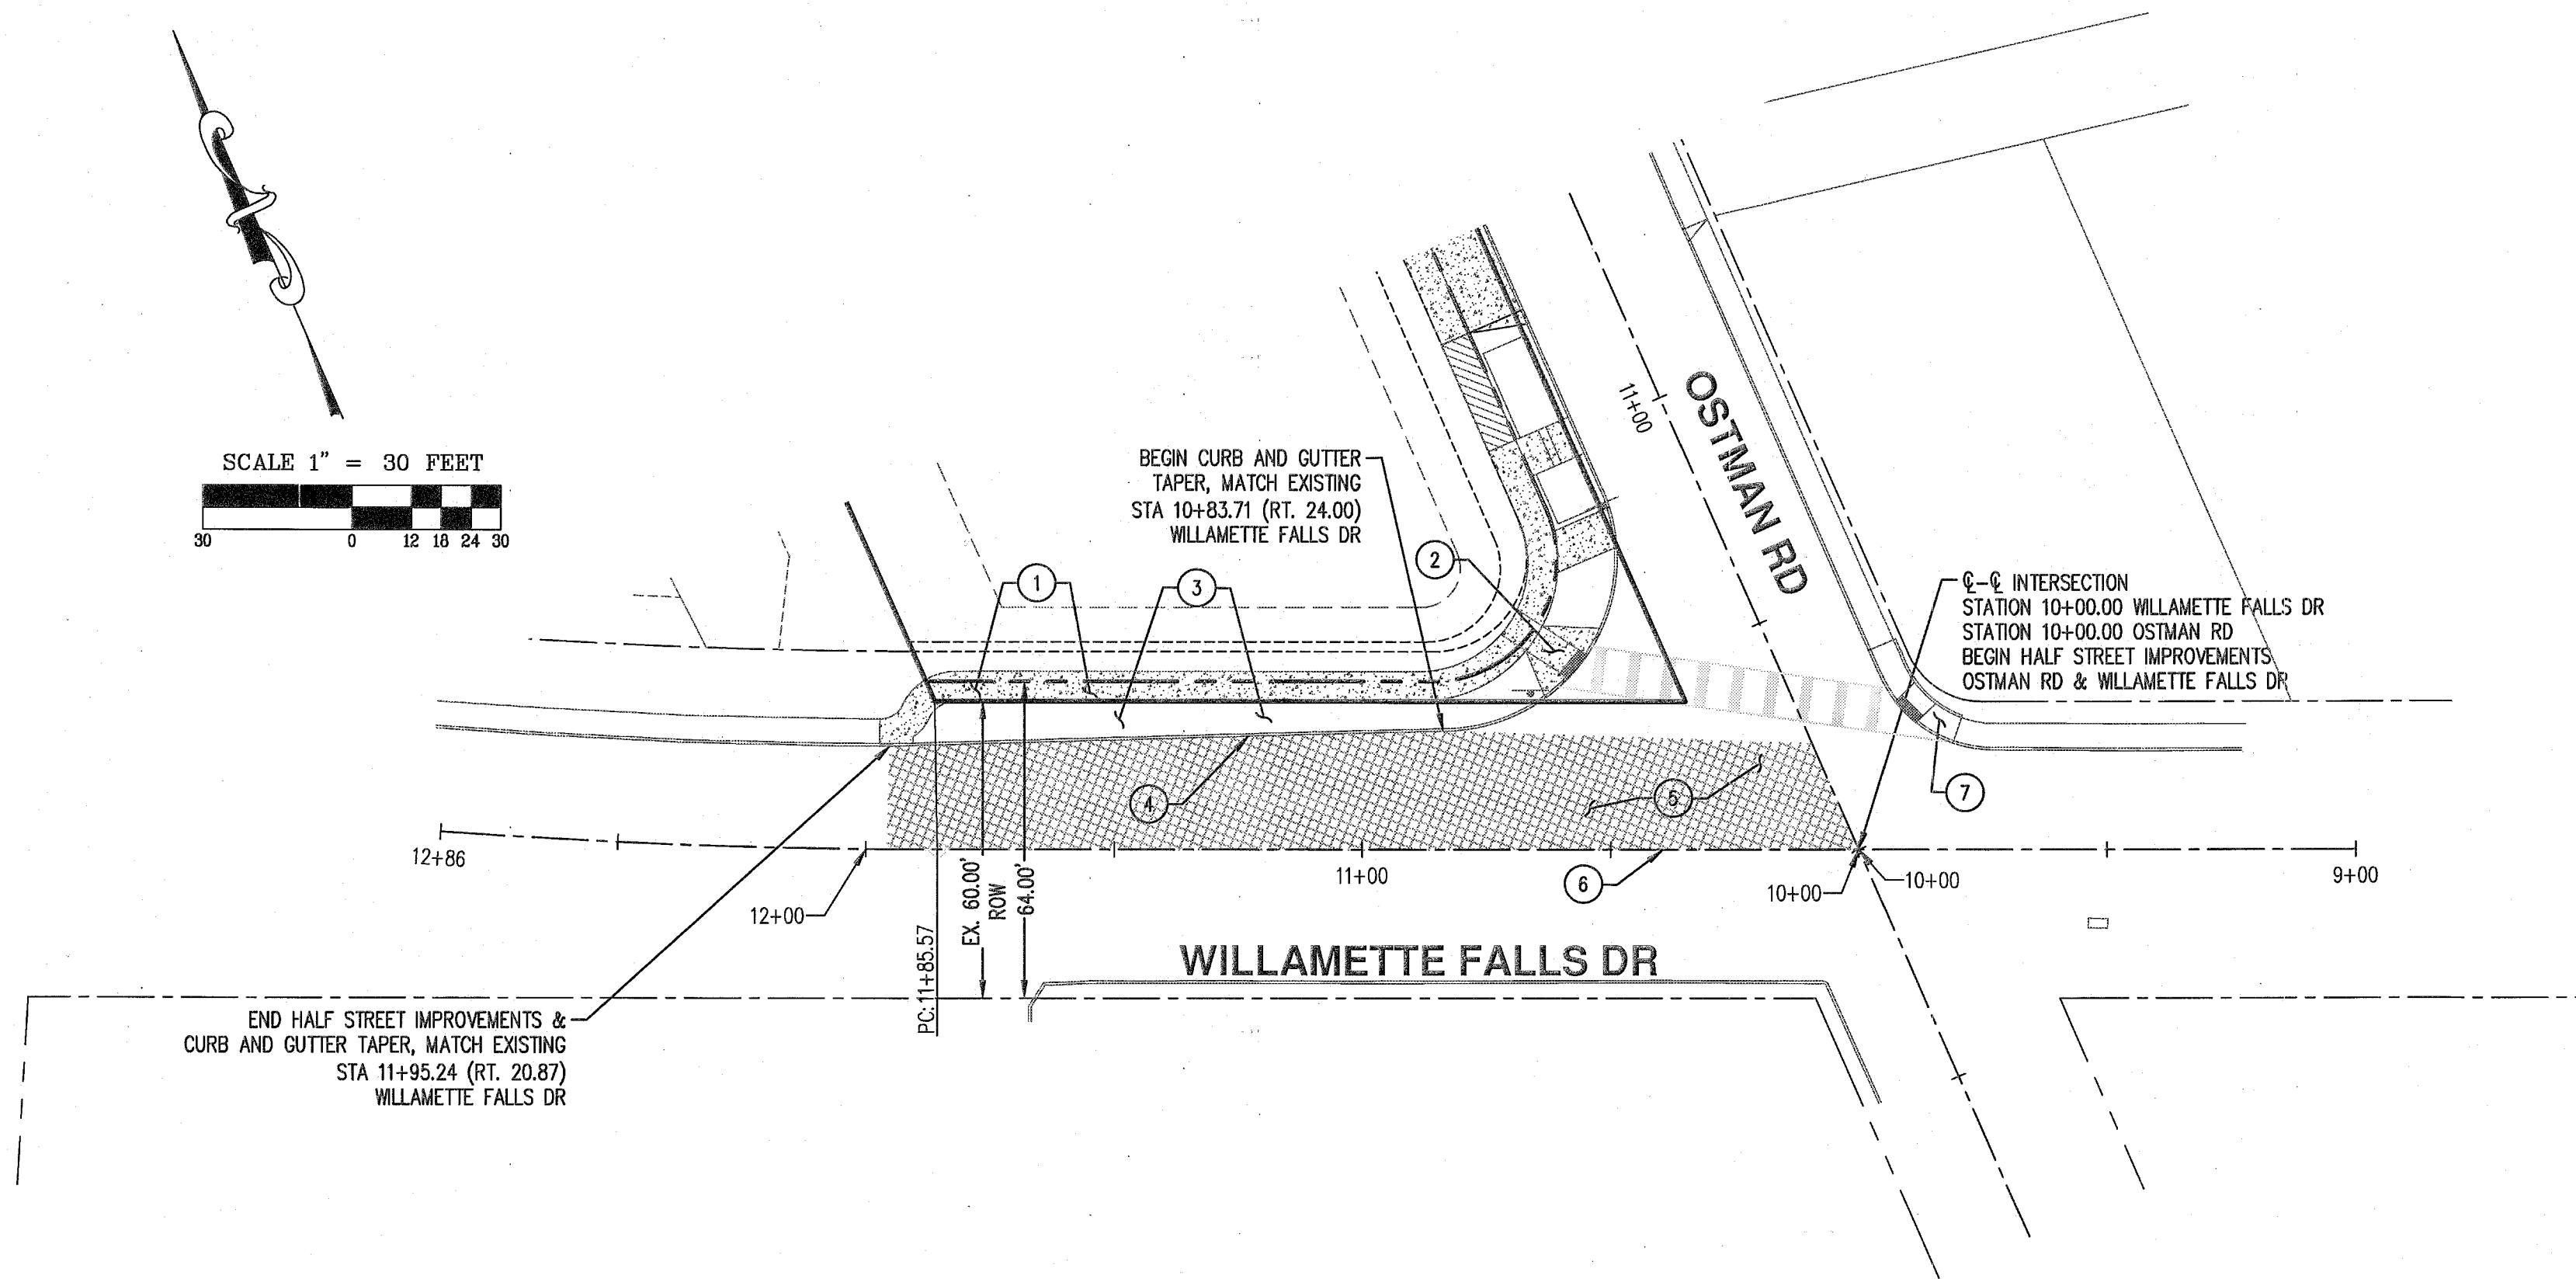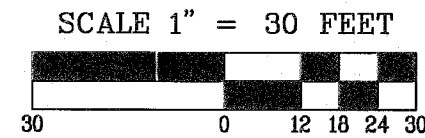

**PUBLIC STREET KEYED NOTES**

1. INSTALL 6' WIDE CONCRETE SIDEWALK, SEE DETAIL ON SHEET C103, SEE SHEET C104 FOR DETAILED GRADING.
2. INSTALL SIDEWALK RAMP, SEE DETAIL ON SHEET C103. SEE SHEET C104 FOR DETAILED GRADING.
3. INSTALL LANDSCAPING AND STREET TREES, SEE SHEET L100 (TO BE APPROVED BY CITY ARBORIST).
4. INSTALL STANDARD CURB AND GUTTER, SEE DETAIL ON SHEET C103.
5. INSTALL AC PAVEMENT AND AGGREGATE BASE, SEE DETAIL ON SHEET C103.
6. SAWCUT EX AC AT CENTERLINE. SAND AND SEAL SAWCUT JOINT PER CITY CONSTRUCTION STANDARDS.
7. INSTALL SIDEWALK RAMP, SEE DETAIL ON SHEET C104.

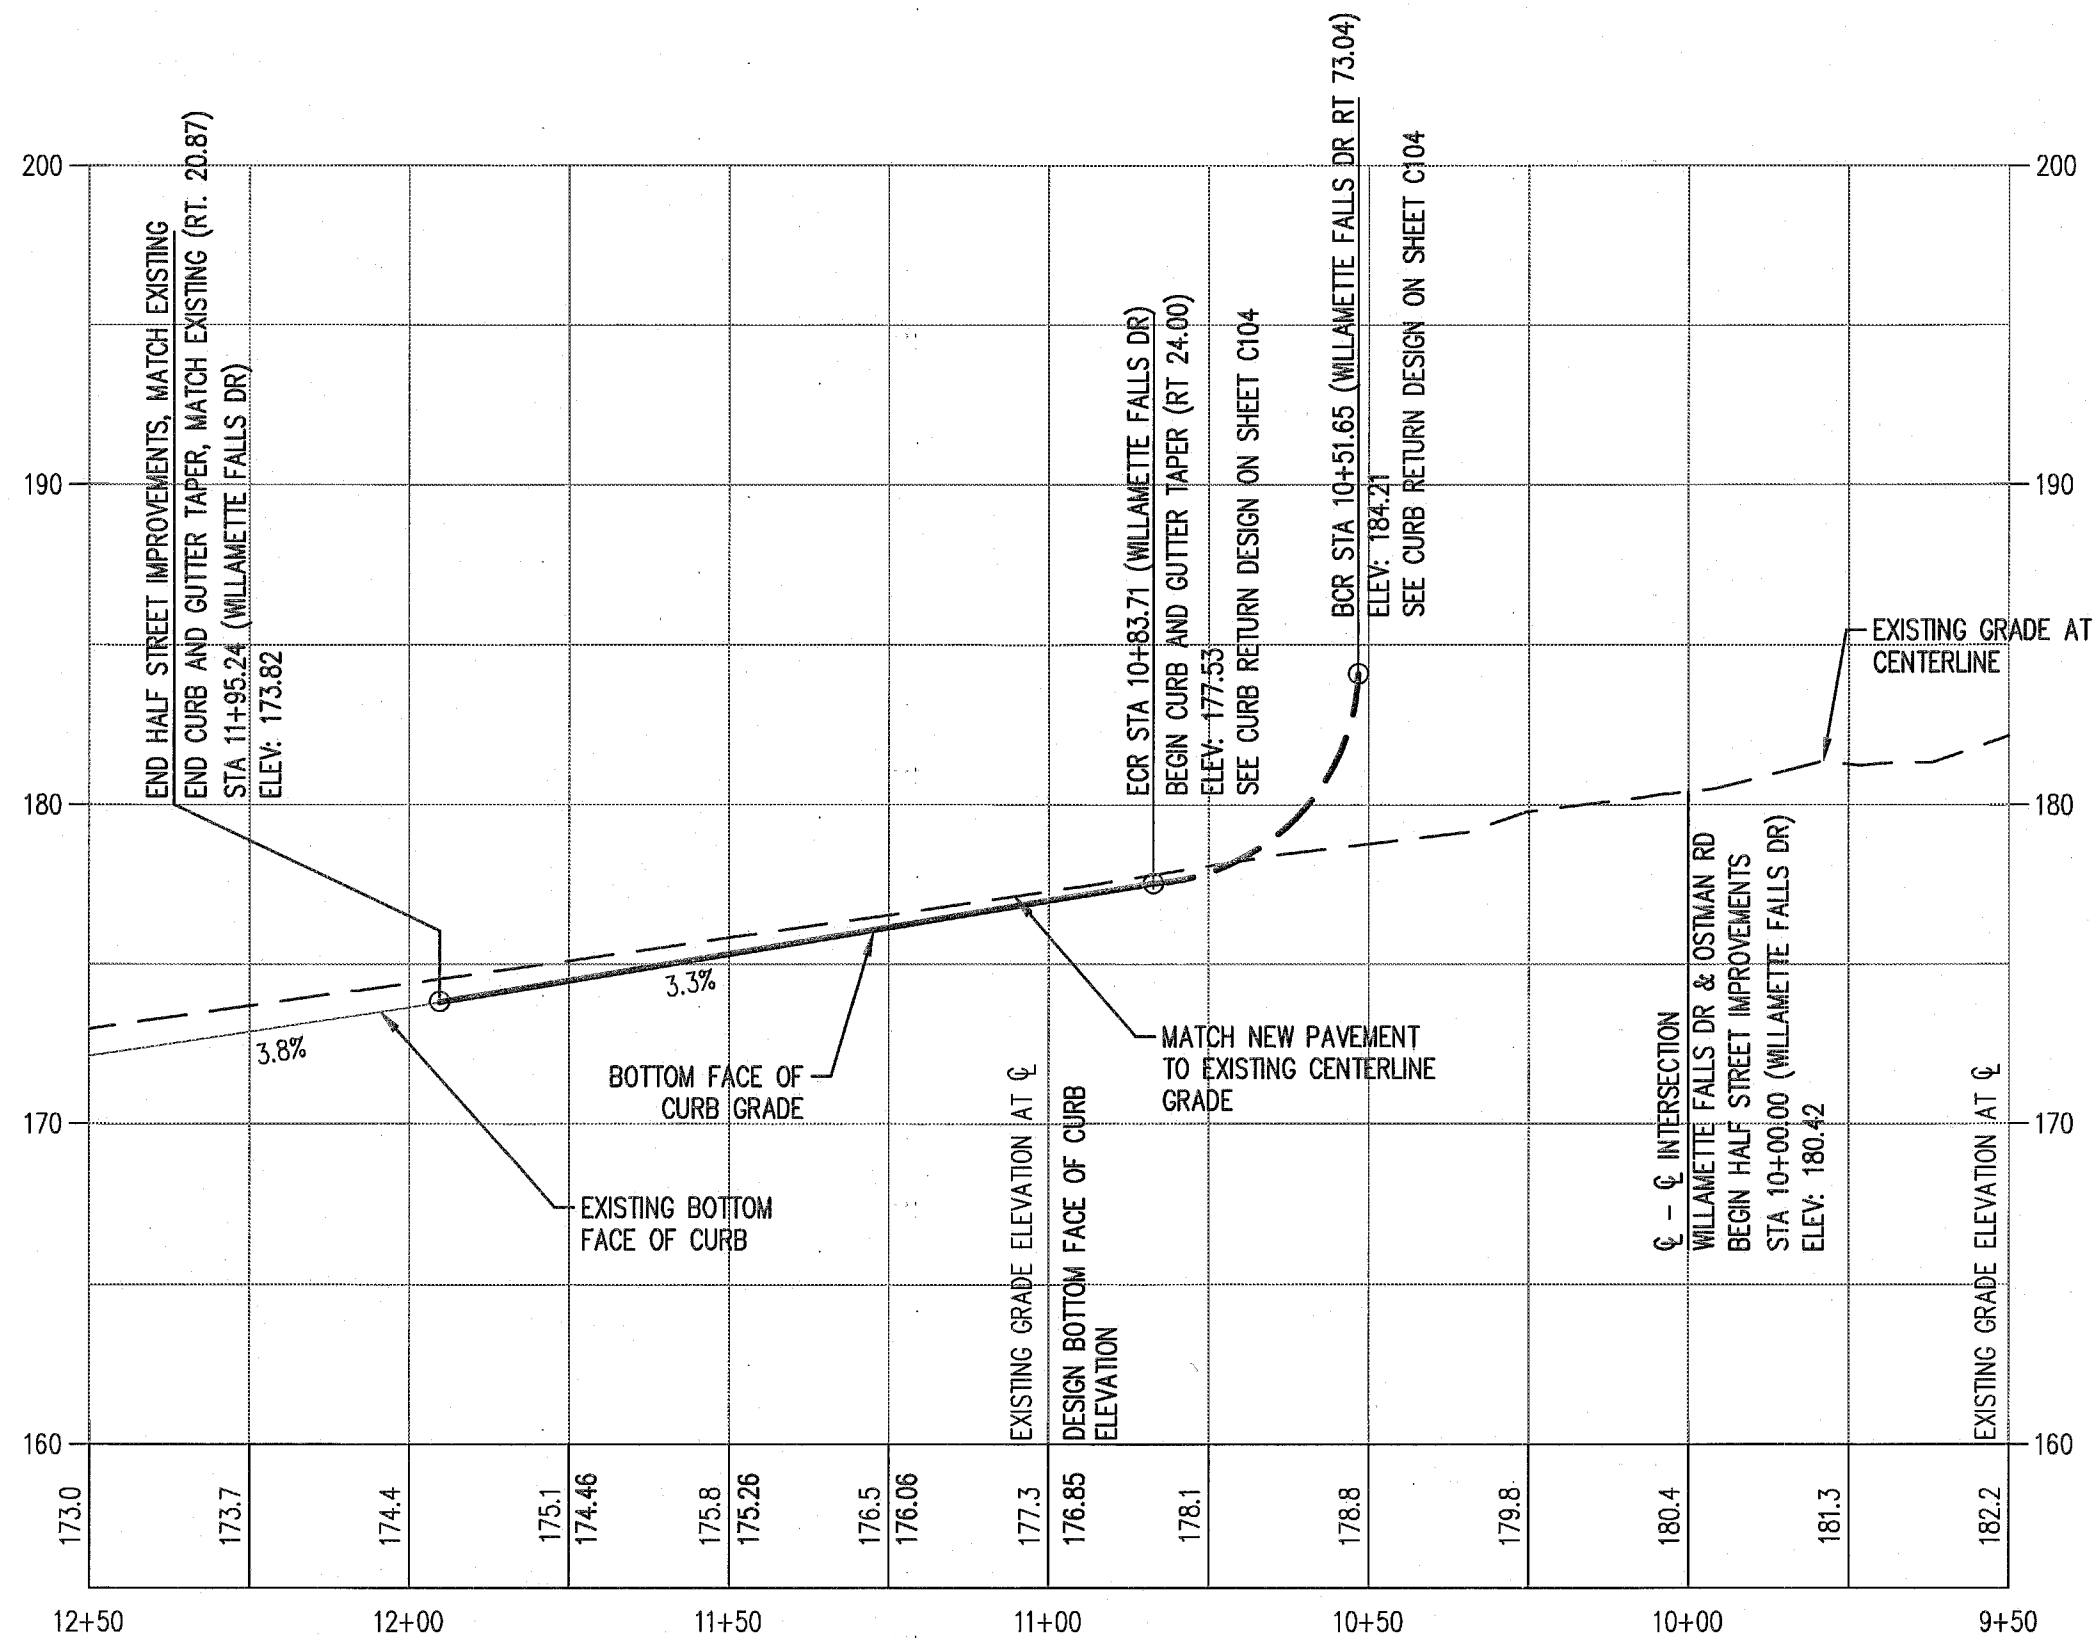

WILLAMETTE FALLS DRIVE CENTERLINE PROFILE  
Hor. Scale: 1" = 30'  
Vert. Scale: 1" = 6'  
STATIONING BASED ON CENTERLINE OF WILLAMETTE FALLS DRIVE

WILLAMETTE FALLS DRIVE CENTERLINE ALIGNMENT				
CENTERLINE STATION	TANGENT / CURVE	BEARING / RADIUS	LENGTH	DELTA
PT STA: 10+00.00				
	TANGENT	N66°20'30"W	185.57'	
PC STA: 11+85.57				
	CURVE RT	1432.29'	9.66'	00°23'00"
PT STA: 11+95.24				

AKS  
ENGINEERING AND FORESTRY, LLC  
12965 SW HERMAN RD  
TUALATIN, OR 97062  
PHONE: 503.583.6151  
FAX: 503.583.6152  
www.aks-eng.com

ENGINEERING • PLANNING • SURVEYING  
FORESTRY • LANDSCAPE ARCHITECTURE

RENAISSANCE  
AT WILLAMETTE  
AS-BUILTS

WEST LINN  
TAX LOT 0200

OREGON  
CLATSOP COUNTY ASSESSOR'S TAXMAP 35103AB

STREET PLAN AND  
PROFILE - WILLAMETTE  
FALLS DRIVE

DESIGNED BY: DCH  
DRAWN BY: JDR  
CHECKED BY: MBH  
SCALE: AS NOTED  
DATE: 2/9/2015

RENEWAL DATE: 6/30/15

REVISIONS


JOB NUMBER  
3745

SHEET  
C101



AS-BUILT DISCLAIMER:  
AS-BUILT INFORMATION IS BASED ON A COMBINATION OF FIELD SURVEY INFORMATION, INSPECTION INFORMATION, AND CONTRACTOR-PROVIDED INFORMATION. THE ENGINEER ONLY CERTIFIES INFORMATION WHICH COULD BE FIELD-VERIFIED AFTER CONSTRUCTION WAS COMPLETED. AS-BUILTS ARE ONLY FOR PUBLIC IMPROVEMENTS WITHIN PUBLIC RIGHT-OF-WAYS OR EASEMENTS.

#### LEGEND

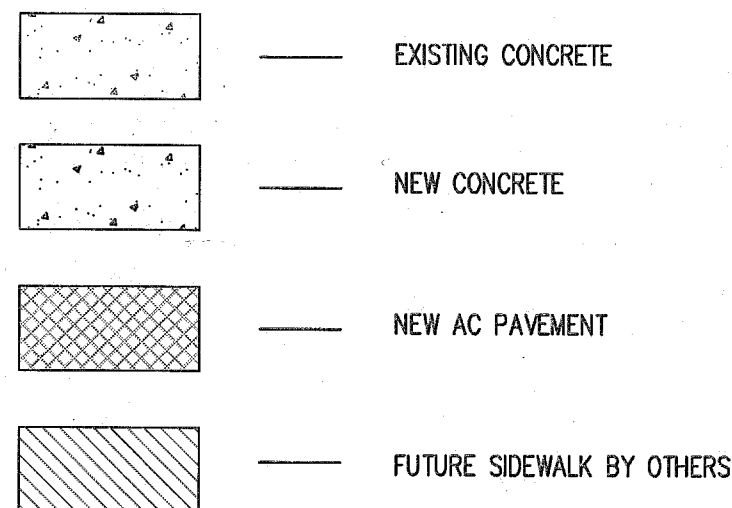


#### OSTMAN ROAD CENTERLINE ALIGNMENT


CENTERLINE STATION	TANGENT	BEARING	LENGTH	DELTA
PT STA: 10+00.00				
	TANGENT	S00°00'00"W	392.21'	
PT STA: 13+92.21				

#### PUBLIC STREET KEYED NOTES

1. INSTALL STANDARD CURB AND GUTTER, SEE DETAIL ON SHEET C103.
2. INSTALL CONCRETE DRIVEWAY APRON, SEE DETAIL ON SHEET C103.
3. FUTURE SIDEWALK BY OTHERS, NOT PART OF THIS PERMIT.
4. SEE SHEETS C200 AND C202 FOR PUBLIC STORMWATER FACILITY.
5. SAWCUT EXISTING AC AT CENTERLINE. SAND AND SEAL SAWCUT JOINT PER CITY CONSTRUCTION STANDARDS.
6. INSTALL AC PAVING AND AGGREGATE BASE, SEE DETAIL ON SHEET C103.
7. INSTALL LANDSCAPING AND STREET TREES, SEE DETAIL ON SHEET L100.
8. TRENCH RESTORATION AND PAVING, SEE DETAILS ON SHEET C103.
9. NEW ADA CROSSWALK (PROJECT SIDE OF STREET ONLY), SEE DETAILED GRADING ON SHEET C104. SEE SHEET C110 FOR DETAILS OF PAVEMENT MARKING.
10. INSTALL 8' WIDE CONCRETE SIDEWALK, SEE DETAIL ON SHEET C103. SEE SHEET C104 FOR GRADES.

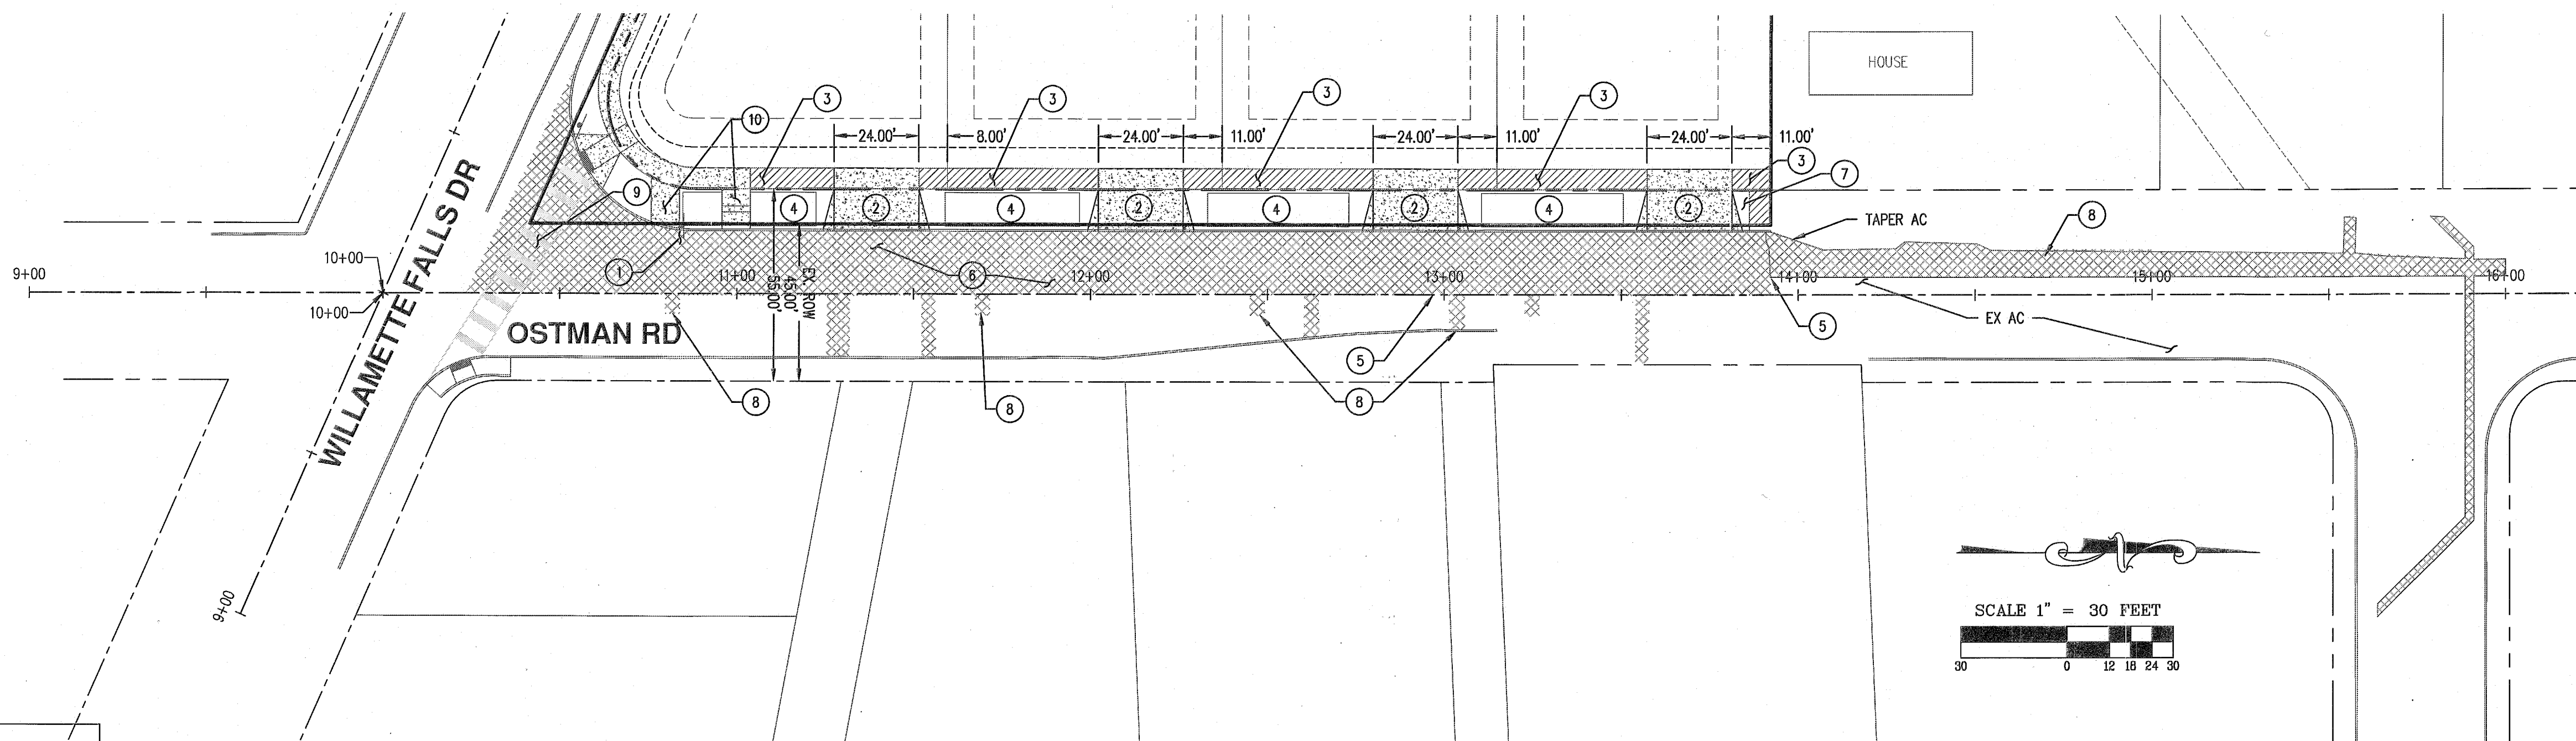

SCALE 1" = 30 FEET

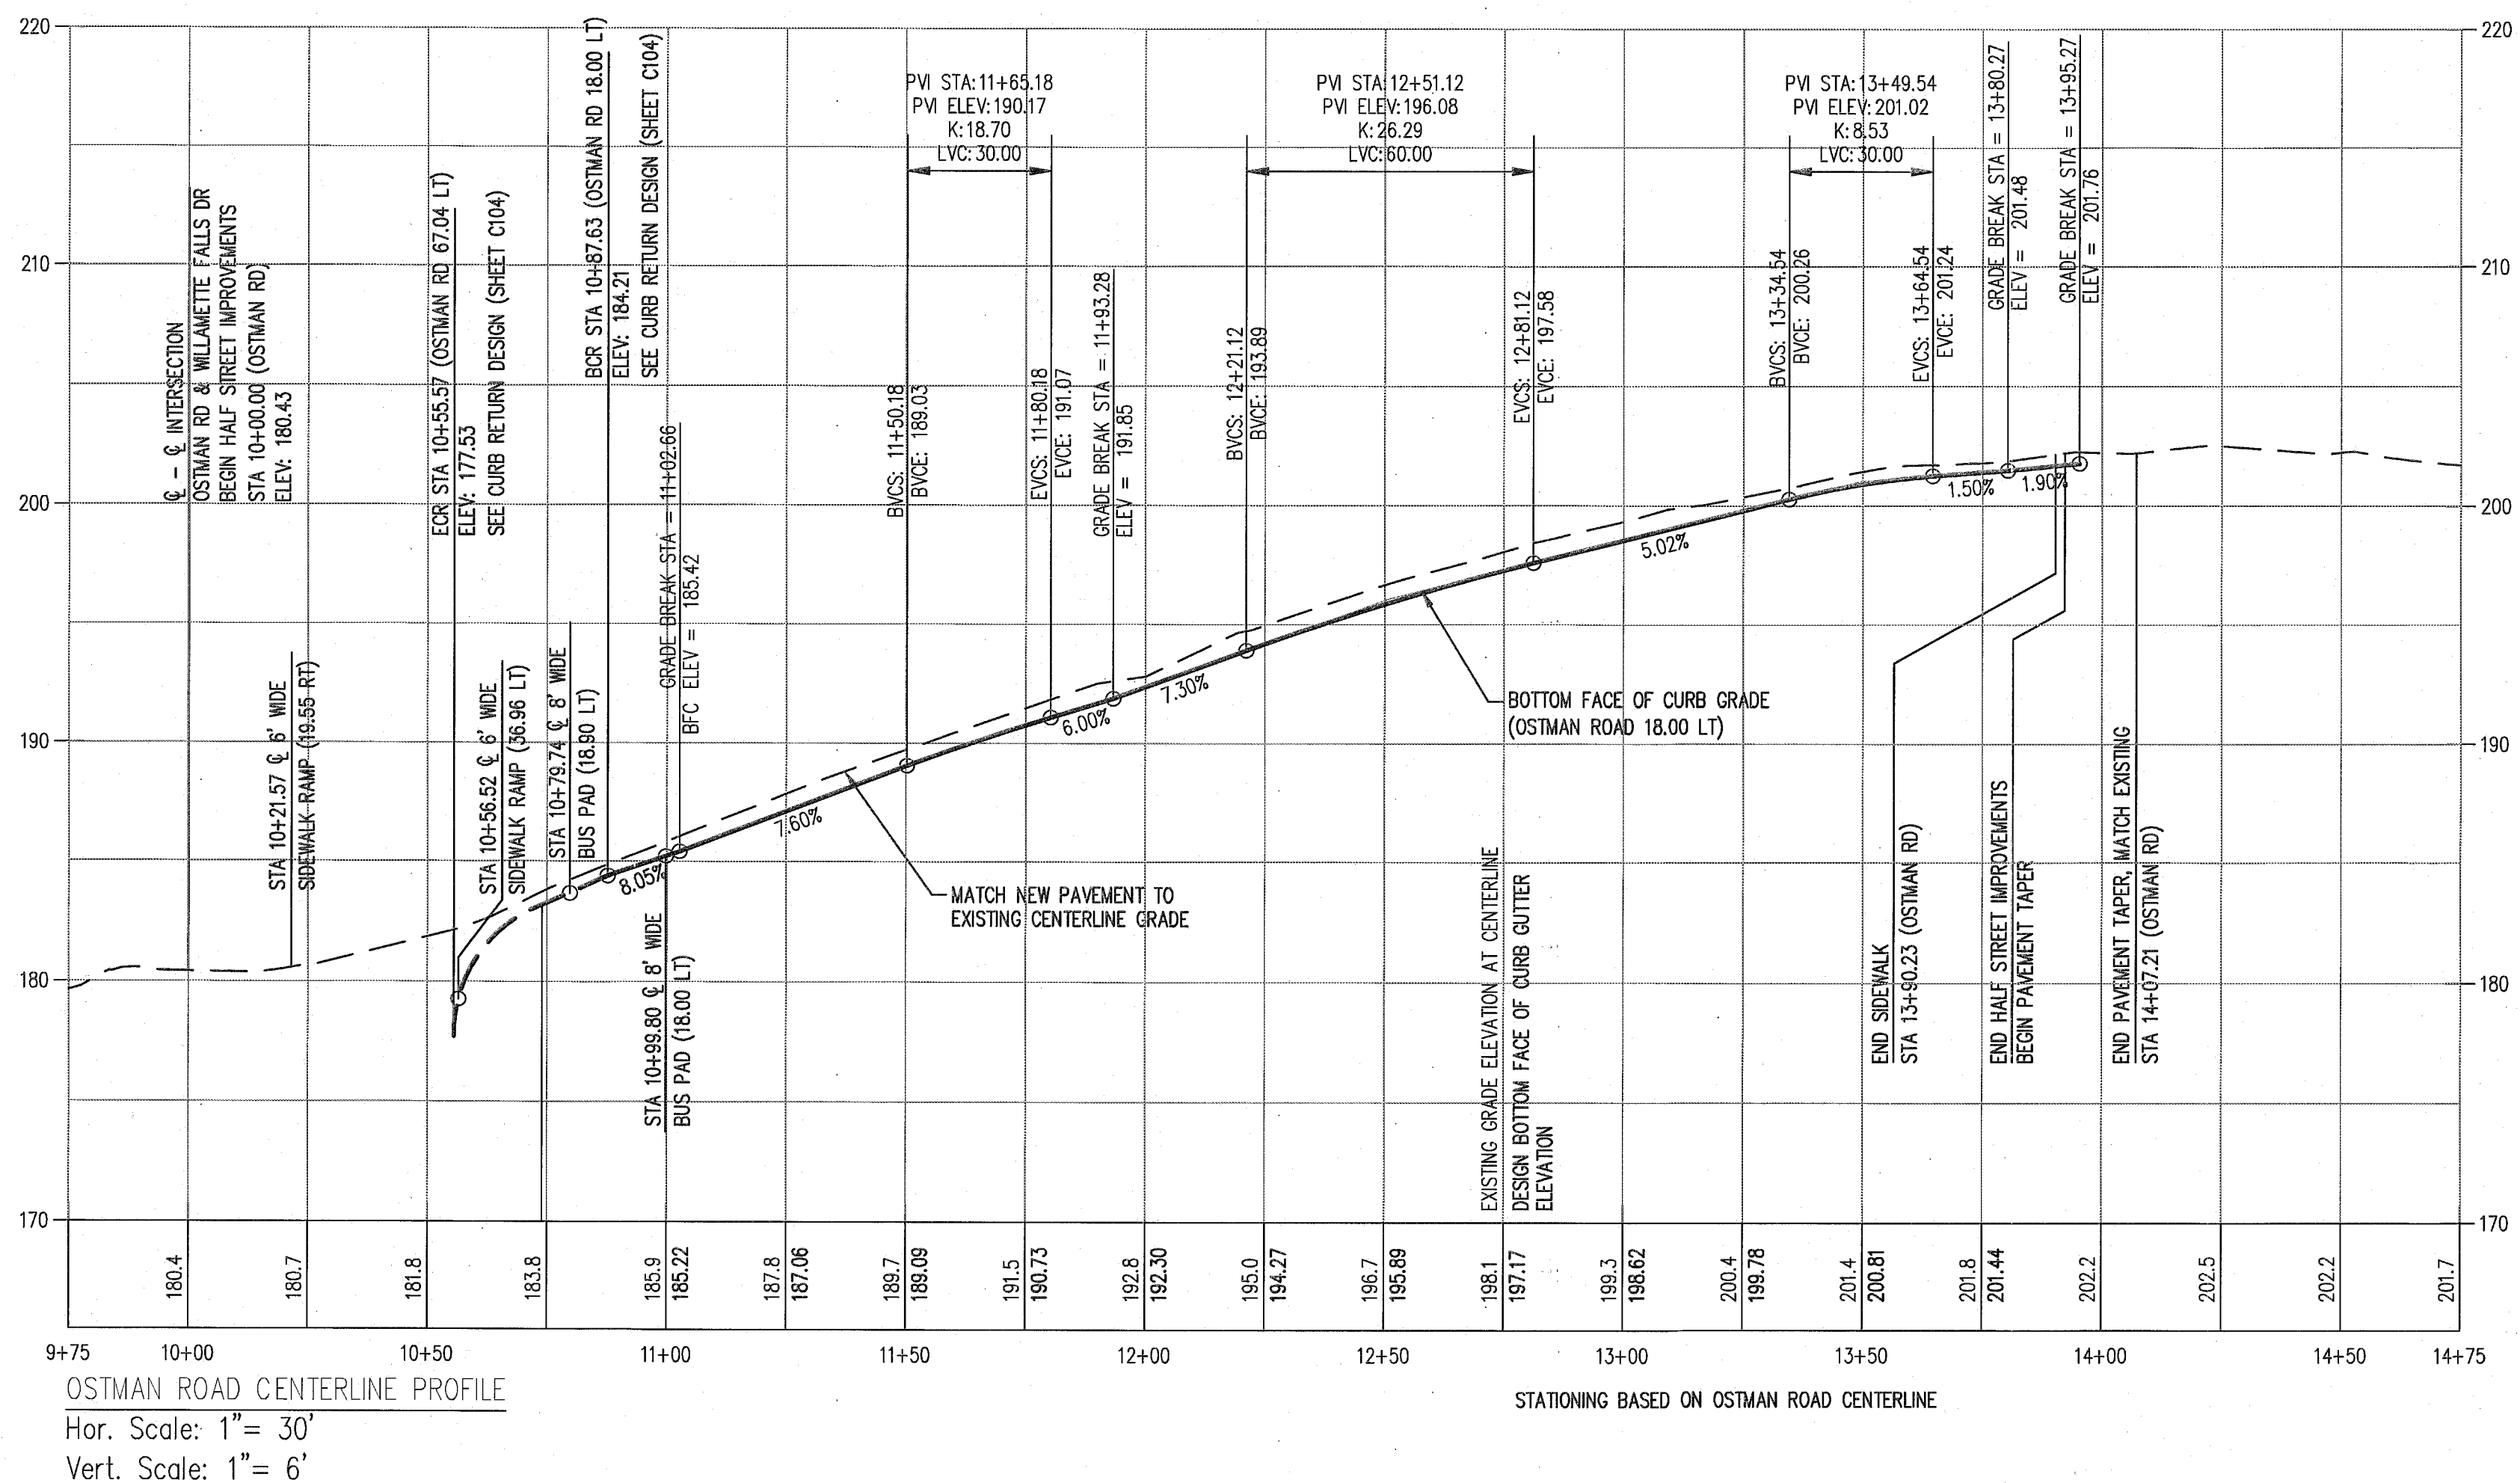

AKS ENGINEERING AND FORESTRY, LLC  
12985 SW HERMAN RD  
TULSA, OK 74106  
PHONE: 503.563.6151  
FAX: 503.563.6152  
www.aks-eng.com

ENGINEERING • PLANNING • SURVEYING  
FORESTRY • LANDSCAPE ARCHITECTURE

RENAISSANCE  
AT WILLAMETTE  
AS-BUILTS

WEST LINN  
TAX LOT 0200

OREGON  
CLACKAMAS COUNTY ASSESSOR'S TAXMAP 350204B

#### STREET PLAN AND PROFILE - OSTMAN ROAD

DESIGNED BY: DCN  
DRAWN BY: JDR  
CHECKED BY: MBH  
SCALE: AS NOTED  
DATE: 2/9/2015

REGISTERED PROFESSIONAL  
ENGINEER  
58542PE  
J. B. JOHNSON  
MONTGOMERY B. HURLEY  
RENEWAL DATE: 6/30/15



REVISIONS

JOB NUMBER  
3745


SHEET  
C102




THIS DETAIL DRAWING SHALL NOT BE ALTERED OR CHANGED IN ANY MANNER EXCEPT BY THE CITY ENGINEER. IT IS THE RESPONSIBILITY OF THE USER TO ACQUIRE THE MOST CURRENT VERSION OF THE DETAIL.

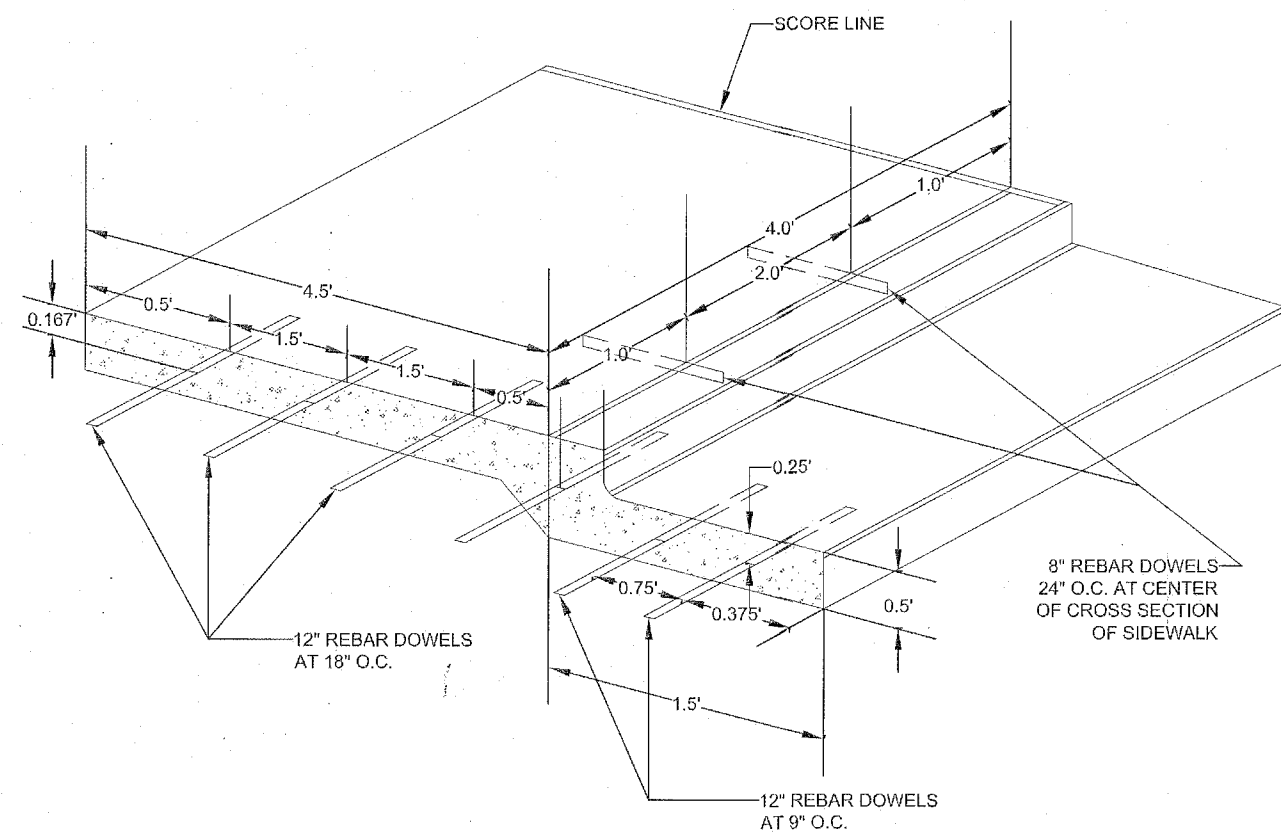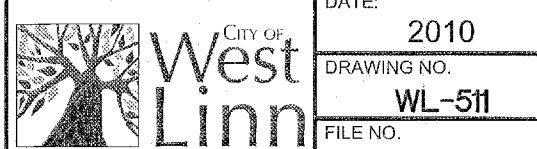CURB, GUTTER AND  
SIDEWALK  
DOWELING DETAIL

DATE: 2010  
DRAWING NO. WL-511  
FILE NO.

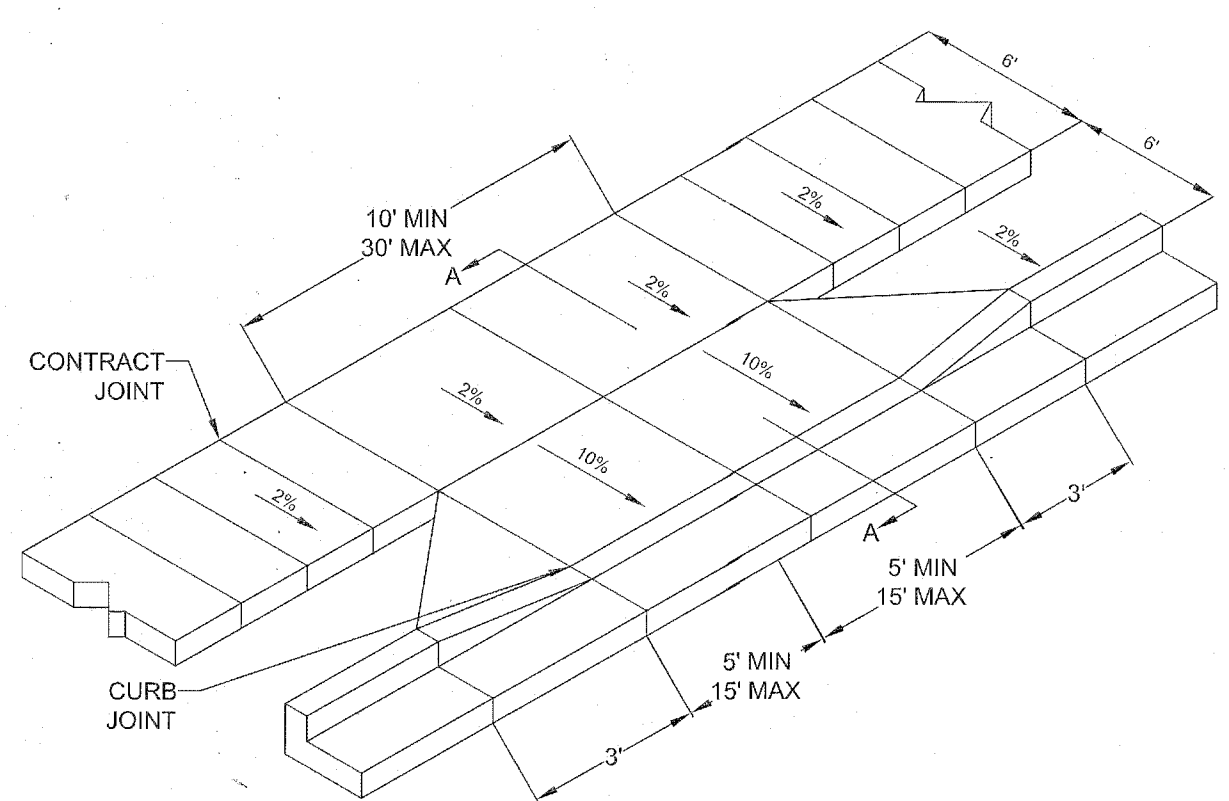

SIDEWALK AWAY FROM CURB

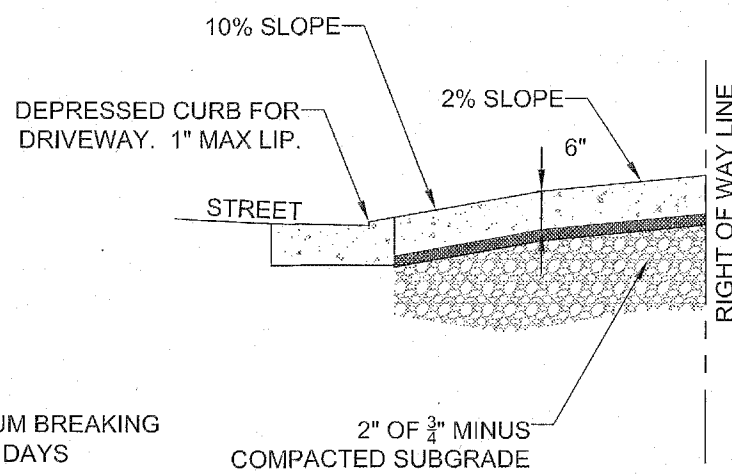


SECTION A-A

RESIDENTIAL DRIVEWAY  
WITH  
SIDEWALK AWAY FROM CURB

DATE: 2010  
DRAWING NO. WL-503A  
FILE NO.

- NOTE:
- CONCRETE SHALL HAVE A MINIMUM BREAKING STRENGTH OF 3300 PSI AFTER 28 DAYS 6 SACK MIX
  - CURB SHALL BE TROWELED JOINT WITH MIN. 1/2" RADIUS ALONG BACK OF CURB
  - DRIVEWAY SHALL BE A MINIMUM 6" THICK
  - DRIVEWAY CURB CUT SHALL COMPLY WITH THE CONDITIONS OF 5.0070, "WIDTH AND LOCATION OF CURB CUTS"
  - FOR REPLACEMENT OF EXISTING APPROACH:
    - MUST MEET CURRENT ADA REQUIREMENTS TO GREATEST DEGREE POSSIBLE
    - DAMAGED ROADWAY MUST BE SAWCUT AND REPAVED WITH CLASS C HOT MIX ASPHALT

THIS DETAIL DRAWING SHALL NOT BE ALTERED OR CHANGED IN ANY MANNER EXCEPT BY THE CITY ENGINEER. IT IS THE RESPONSIBILITY OF THE USER TO ACQUIRE THE MOST CURRENT VERSION OF THE DETAIL.

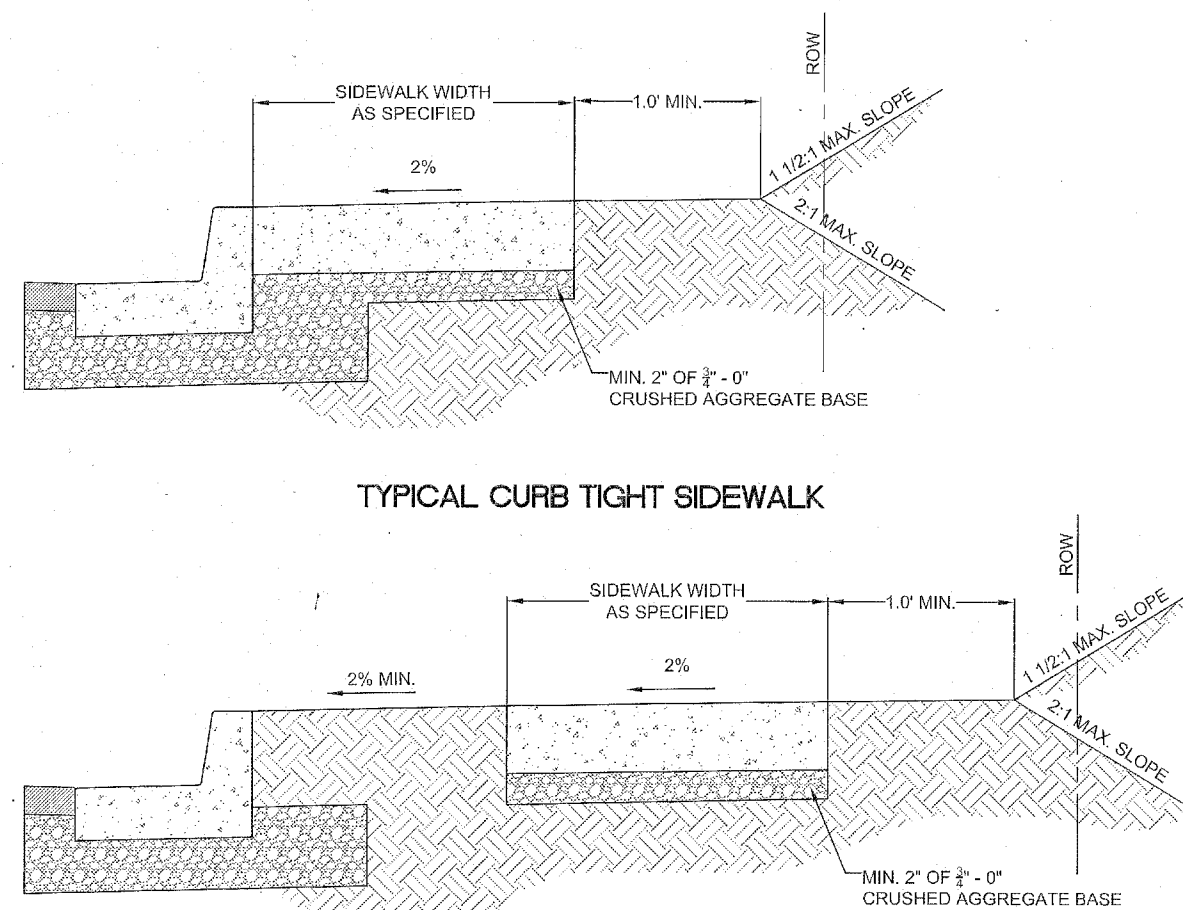

TYPICAL CURB TIGHT SIDEWALK




SIDEWALK AWAY FROM CURB


- NOTE:
- CONCRETE SHALL BE 3300 PSI AT 28 DAYS.
  - PANEL LENGTHS SHALL BE EQUAL TO THE SIDEWALK WIDTH, BUT MAY BE ADJUSTED WITH THE CITY ENGINEER'S APPROVAL.
  - CONTRACTION JOINTS (1/3RD OF THE THICKNESS OF CONCRETE) SHALL BE PLACED EVERY THIRD PANEL, WITH A MAX. SPACING OF 15 FEET. JOINTS SHALL ALSO BE PLACED AT THE SIDES OF DRIVEWAY APPROACHES, UTILITY VAULTS, AND WHEELCHAIR RAMPS.
  - A CURING COMPOUND SHALL BE USED. WHITE REFLECTIVE SHEETING SHALL BE USED IN CASE OF RAIN.
  - FOR SIDEWALKS ADJACENT TO THE CURB AND POURED AT THE SAME TIME AS THE CURB, THE JOINT BETWEEN THEM SHALL BE A TROWELED JOINT WITH A MIN. 1/2" RADIUS.
  - THE SIDEWALK SHALL HAVE A MIN. THICKNESS OF 6" IF THE SIDEWALK IS INTENDED AS A PORTION OF THE DRIVEWAY. OTHERWISE, THE SIDEWALK SHALL HAVE A MIN. THICKNESS OF 4".
  - DRAIN BLOCKOUTS IN THE CURB SHALL BE EXTENDED TO THE BACK OF THE SIDEWALK WITH A 3" DIAMETER PLASTIC PIPE AT A 2% SLOPE. A CONTRACTION JOINT SHALL BE PLACED OVER THE PIPE.

CONCRETE SIDEWALK  
CROSS SECTION

DATE: 2010  
DRAWING NO. WL-508  
FILE NO.

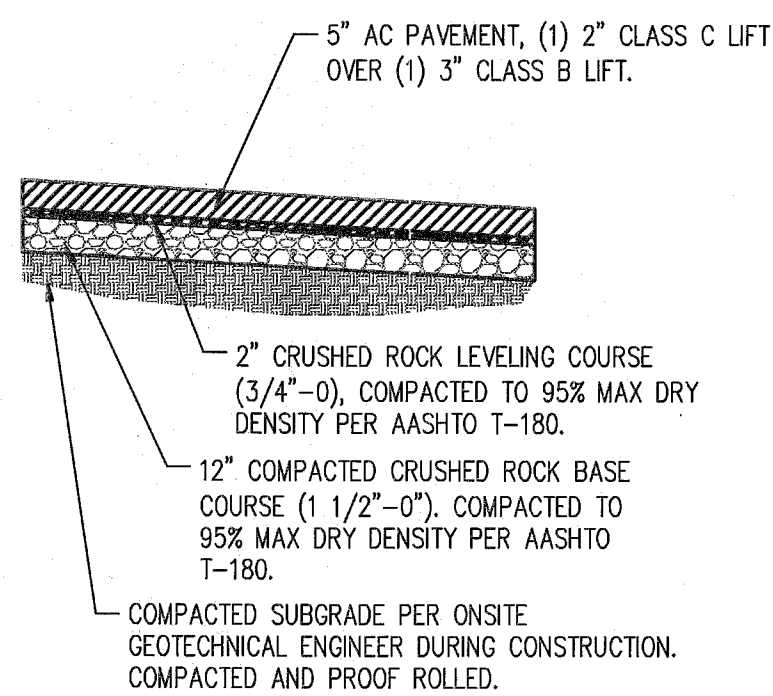


OSTMAN STREET

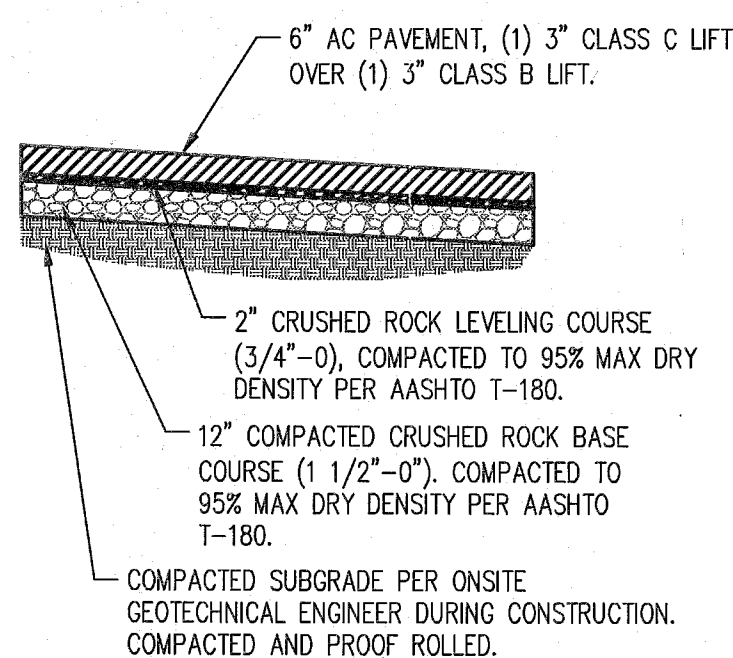

WILLAMETTE FALLS DRIVE


TYPICAL NEW ASPHALT SECTION  
NTS

THIS DETAIL DRAWING SHALL NOT BE ALTERED OR CHANGED IN ANY MANNER EXCEPT BY THE CITY ENGINEER. IT IS THE RESPONSIBILITY OF THE USER TO ACQUIRE THE MOST CURRENT VERSION OF THE DETAIL.

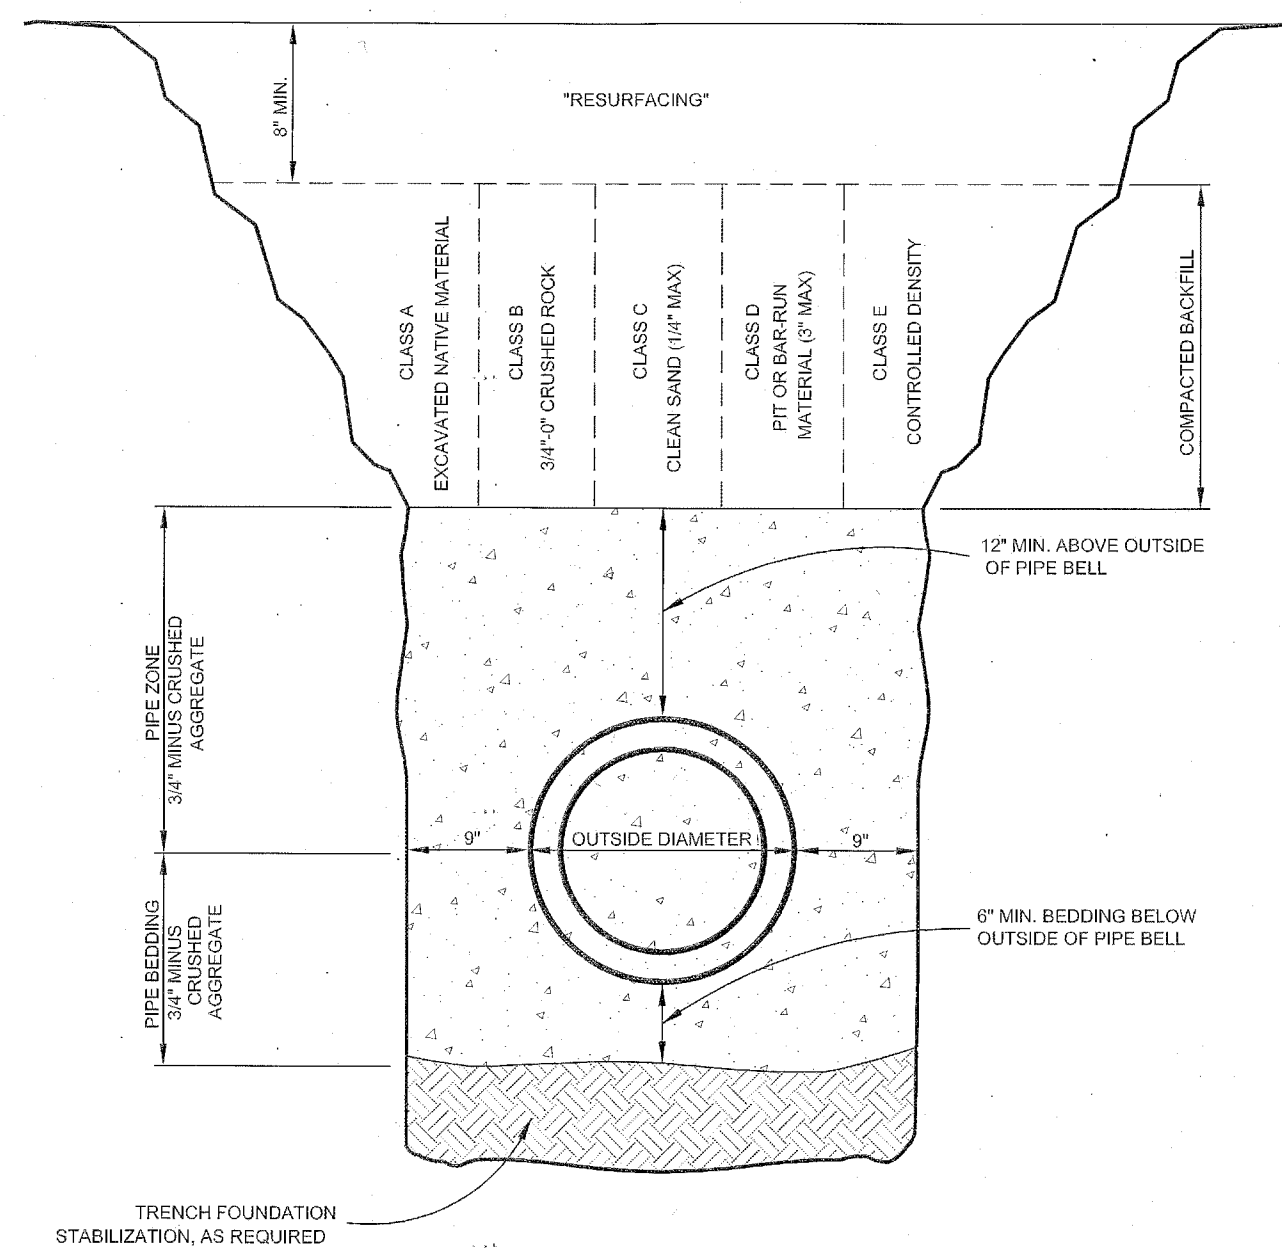TRENCH BACKFILL  
BEDDING AND  
PIPE ZONE

DATE: 2010  
DRAWING NO. WL-200  
FILE NO.

THIS DETAIL DRAWING SHALL NOT BE ALTERED OR CHANGED IN ANY MANNER EXCEPT BY THE CITY ENGINEER. IT IS THE RESPONSIBILITY OF THE USER TO ACQUIRE THE MOST CURRENT VERSION OF THE DETAIL.

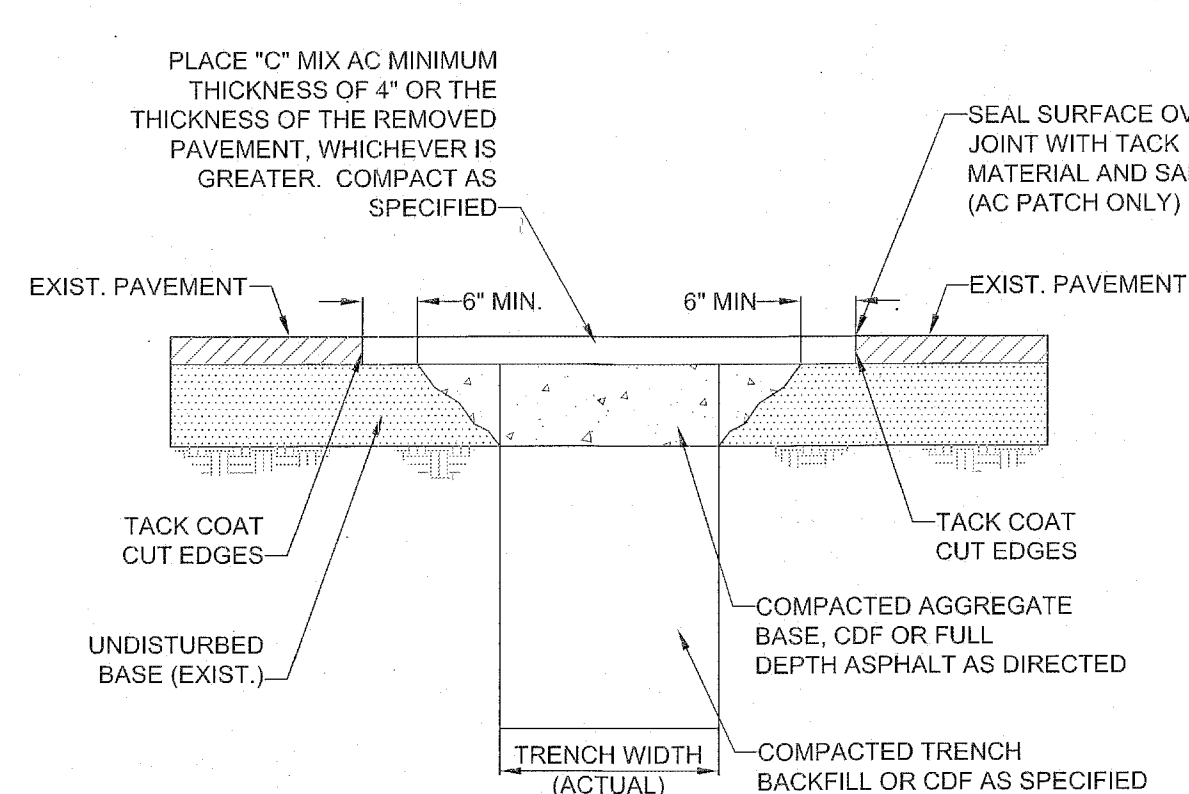


STREET T-CUT



DATE: 2010  
DRAWING NO. WL-203  
FILE NO.

- NOTE:
- ALL EXISTING AC OR PCC PAVEMENT SHALL BE SAWCUT TO NEAT, STRAIGHT LINES PRIOR TO REPAVING.
  - CONCRETE PAVEMENT SHALL BE REPLACED WITH CONCRETE TO A MINIMUM THICKNESS OF REMOVED PAVEMENT, WHICHEVER IS GREATER.
  - IF EXISTING BASE MATERIAL IS CTB OR ATB, THEN REPLACEMENT BASE MATERIAL SHALL MATCH EXISTING.
  - ALL UTILITIES SHALL HAVE A MINIMUM COVER OF 36".
  - ALL TRENCH BACKFILL SHALL BE COMPACTED TO 95% OF MAXIMUM DENSITY PER AASHTO T-180 OR AS SPECIFIED IN THE CONTRACT DOCUMENTS.
  - ALL TRENCH BACKFILL AND PATCHING SHALL CONFORM TO THE STANDARDS AND SPECIFICATIONS OF THE CITY OF WEST LINN.
  - APPROVED CDF SHALL BE USED OR 3/4 - 0" GRAVEL BACKFILL SHALL BE PLACED AND COMPACTED IN 12" MAXIMUM LIFTS. IF 3/4-0" GRAVEL BACKFILL IS USED, COMPACTION TESTING BY A CERTIFIED TESTING COMPANY IS REQUIRED AT DEPTH INTERVALS AS SPECIFIED BY THE CITY ENGINEER.
  - T-CUT MAY BE ENLARGED AT THE DISCRETION OF THE CITY ENGINEER OR CITY INSPECTOR DUE TO SITE CONDITIONS OR PROJECT REQUIREMENTS.
  - ALL CUT EDGES SHALL BE SAND SEALED.
  - COMPACTED BACKFILL OR CDF MUST EXTEND 2 FEET OUTSIDE OF PAVEMENT SURFACE.

THIS DETAIL DRAWING SHALL NOT BE ALTERED OR CHANGED IN ANY MANNER EXCEPT BY THE CITY ENGINEER. IT IS THE RESPONSIBILITY OF THE USER TO ACQUIRE THE MOST CURRENT VERSION OF THE DETAIL.

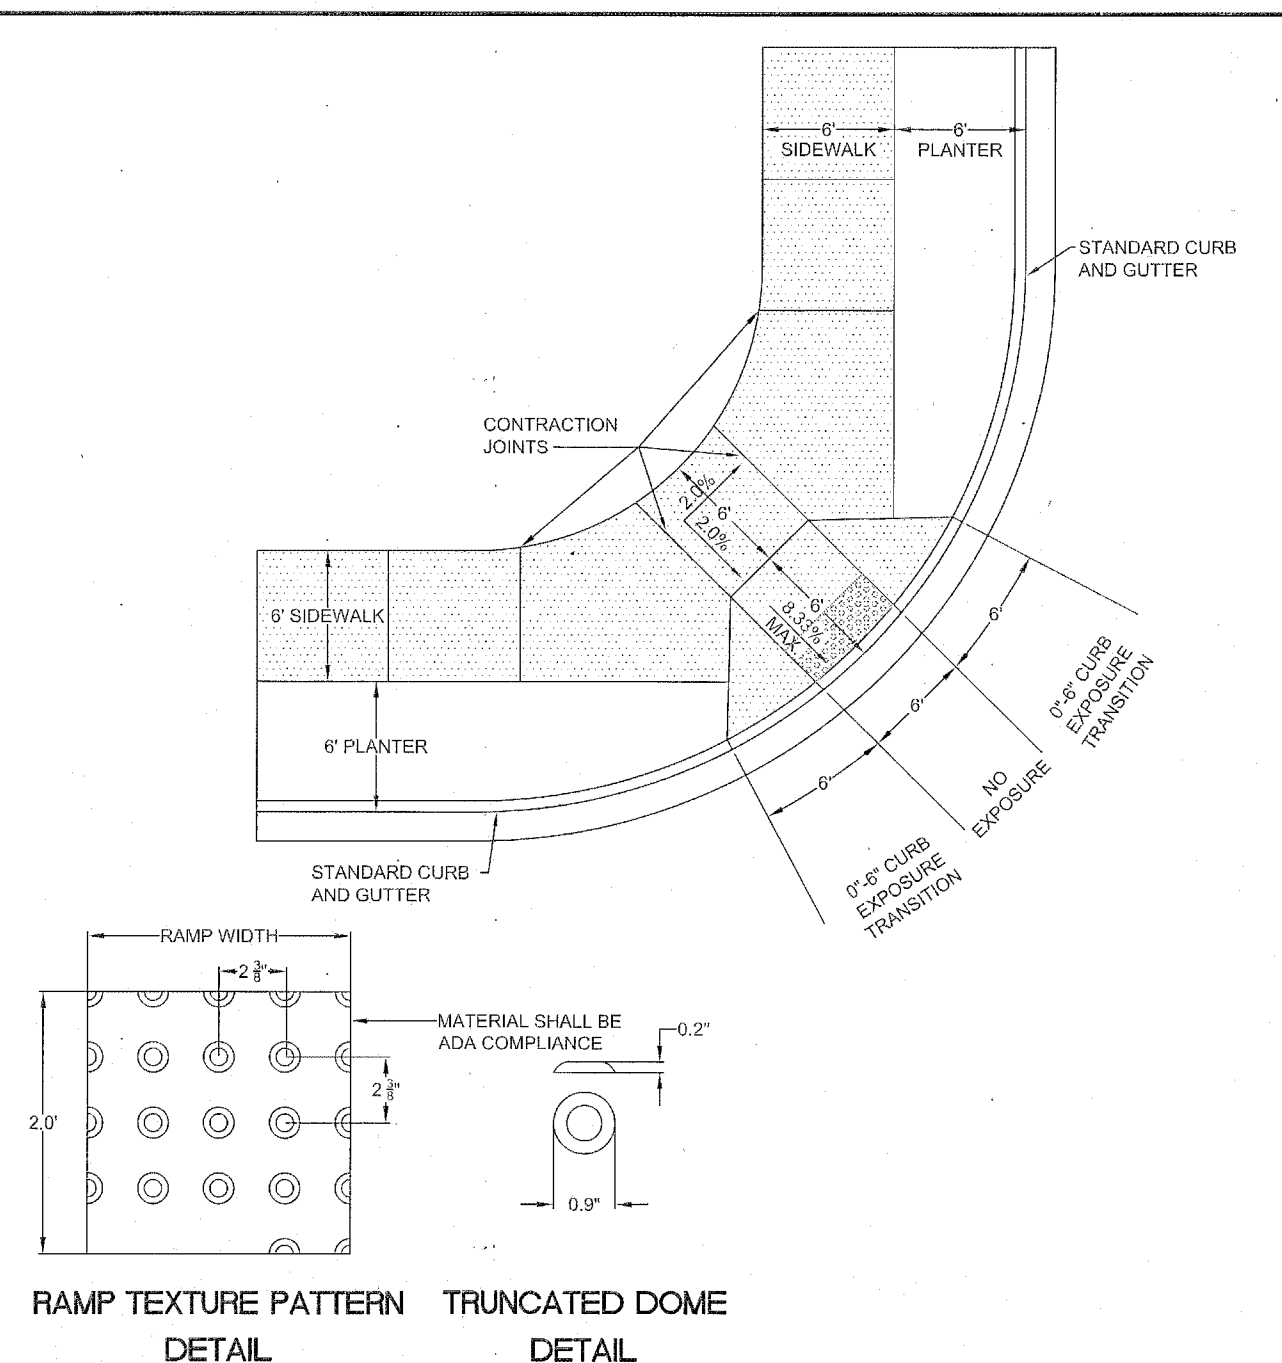


- NOTE:
- LANDING AT TOP OF RAMP SHALL NOT EXCEED 2% IN ANY DIRECTION AND SHALL BE A MINIMUM OF 60" x 60".
  - RAMP CROSS SLOPE SHALL NOT EXCEED 2% (AS MEASURED PERPENDICULAR TO PEDESTRIAN TRAFFIC FLOW).
  - TRUNCATED DOME MUST EXTEND THE FULL WIDTH OF THE RAMP AND COVER THE FIRST 2 FEET OF THE RAMP CLOSEST TO THE STREET.
  - TRANSITIONS FROM THE RAMP TO THE WALKWAY, GUTTER, AND STREET MUST BE FLUSH (LEVEL) AND FREE OF ABRUPT LEVEL CHANGES.
  - THE GUTTER OR ADJACENT ROADWAY MUST HAVE A SLOPE OF NO MORE THAN 5 PERCENT (1:20) TOWARD THE RAMP.
  - FLARED SIDES ("WINGS") OF THE CURB RAMP SHALL NOT EXCEED 10% IN SLOPE (8.33% IF PEDESTRIAN TRAVEL IS REQUIRED OVER THEM PER ADA STANDARDS - I.E. IF MINIMUM 48" x 48" (FOR EXISTING SITES ONLY) LANDING IS NOT PROVIDED AT TOP OF RAMP).
  - CONCRETE STRENGTH SHALL BE 3300 PSI.
  - PLACE CONTRACTION JOINTS AS SHOWN ABOVE.
  - NO ABOVE GROUND UTILITIES ARE PERMITTED WITHIN RAMP AREA.
  - WHEN EITHER OPPOSING CURB RAMP HAS AN EXISTING TWIN RAMP, USE DETAIL WL-507B.

SINGLE CURB RAMP  
(ALLOWED WITH CITY  
ENGINEER APPROVAL ONLY)

DATE: 2010  
DRAWING NO. WL-507A  
FILE NO.


THIS DETAIL DRAWING SHALL NOT BE ALTERED OR CHANGED IN ANY MANNER EXCEPT BY THE CITY ENGINEER. IT IS THE RESPONSIBILITY OF THE USER TO ACQUIRE THE MOST CURRENT VERSION OF THE DETAIL.

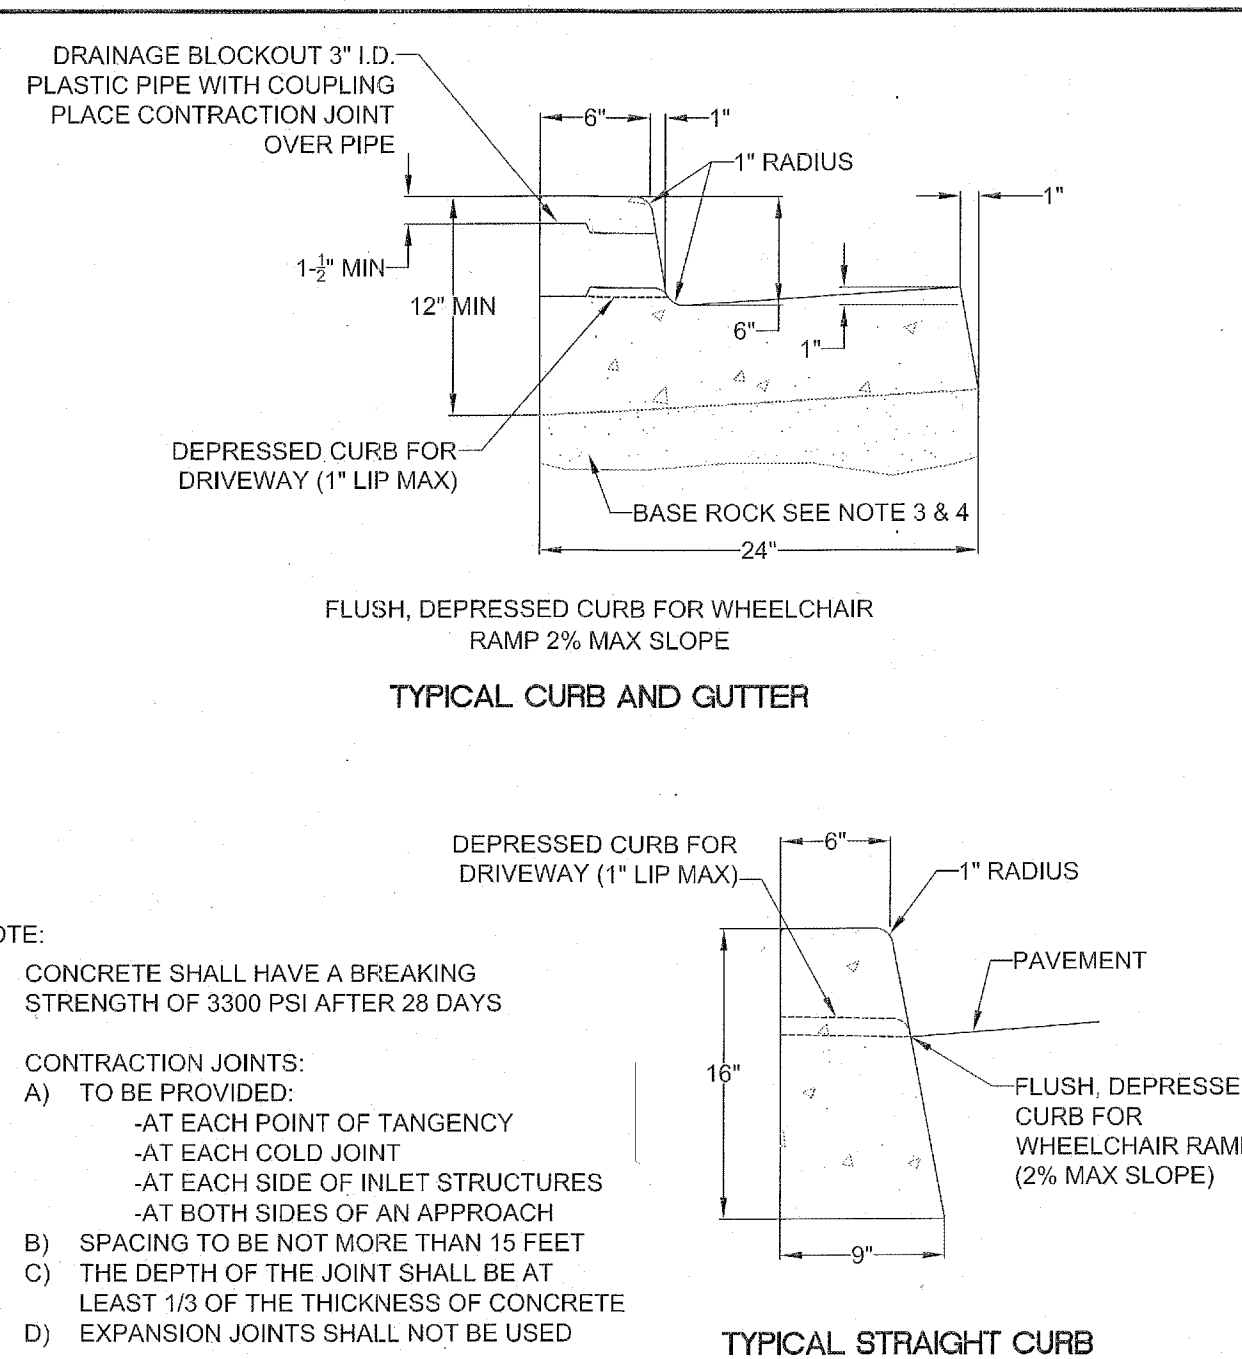

TYPICAL CURB AND GUTTER

- NOTE:
- CONCRETE SHALL HAVE A BREAKING STRENGTH OF 3300 PSI AFTER 28 DAYS
  - CONTRACTION JOINTS:
    - TO BE PROVIDED:
      - AT EACH POINT OF TANGENCY
      - AT EACH COLD JOINT
      - AT EACH SIDE OF INLET STRUCTURES
      - AT BOTH SIDES OF AN APPROACH
    - SPACING TO BE NOT MORE THAN 15 FEET
    - THE DEPTH OF THE JOINT SHALL BE AT LEAST 1/3 OF THE THICKNESS OF CONCRETE
    - EXPANSION JOINTS SHALL NOT BE USED
  - BASE ROCK - 1-1/2" - 0", 95% COMPACTION PER AASHTO T-180  
ROCK SHALL BE TO SUBGRADE OF THE STREET SECTION OR 4" IN DEPTH, WHICHEVER IS GREATER
  - FULL DEPTH PREPARED ROCK SECTION SHALL EXTEND 1' HORIZONTALLY BEYOND BOTH SIDES OF CURB AND GUTTER
  - DRAINAGE BLOCK - 3" DIA. PLASTIC PIPE  
    - DRAINAGE ACCESS THROUGH EXISTING CURBS SHALL BE DONE BY:
      - CORE DRILLING
      - VERTICAL SAWCUT OF CURB 24" EACH SIDE OF DRAIN AND RE-POURED TO FULL DEPTH OF CURB
  - STAMP TOP OF CURB WITH "W" AT WATER SERVICE CROSSING AND "S" AT SANITARY LATERAL CROSSING


TYPICAL CURBS

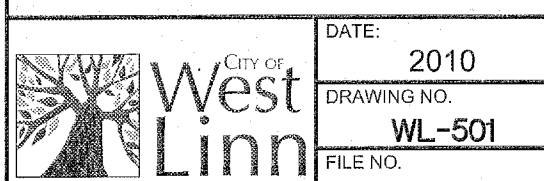

DATE: 2010  
DRAWING NO. WL-501  
FILE NO.

## STREET DETAILS

DESIGNED BY: DKN  
DRAWN BY: JDR  
CHECKED BY: MBH  
SCALE: AS NOTED  
DATE: 2/9/2015

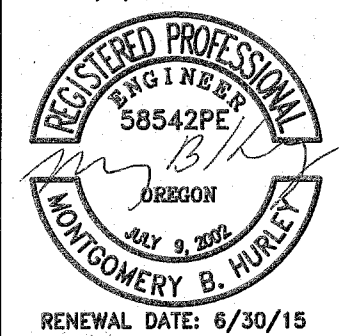

RENEWAL DATE: 6/30/15

REVISIONS

JOB NUMBER  
3745

SHEET  
C103

AKS  
AKS ENGINEERING AND FORESTRY, LLC  
12850 SW HEMLOCK RD  
TUALUMIN, OR 97062  
PHONE: 503.563.6151  
FAX: 503.563.6152  
www.aks-eng.com

RENAISSANCE  
AT WILLAMETTE  
AS-BUILTS  
WEST LINN  
TAX LOT 0200  
CLACKAMAS COUNTY ASSESSOR'S TAXMAP 35E03AB  
ENGINEERING • PLANNING • SURVEYING  
FORESTRY • LANDSCAPE ARCHITECTURE  
OREGON








TM503.dgn 06-10-2014

SOSW/L

TM530.dgn 7-1-2010

OCSW/L

F:\mkg\Traffic\Standard Drawings\2014 July Update\plotfile\TM200s.dgn :: Default 7/6/2014 10:43:15 AM Hwyr:20m

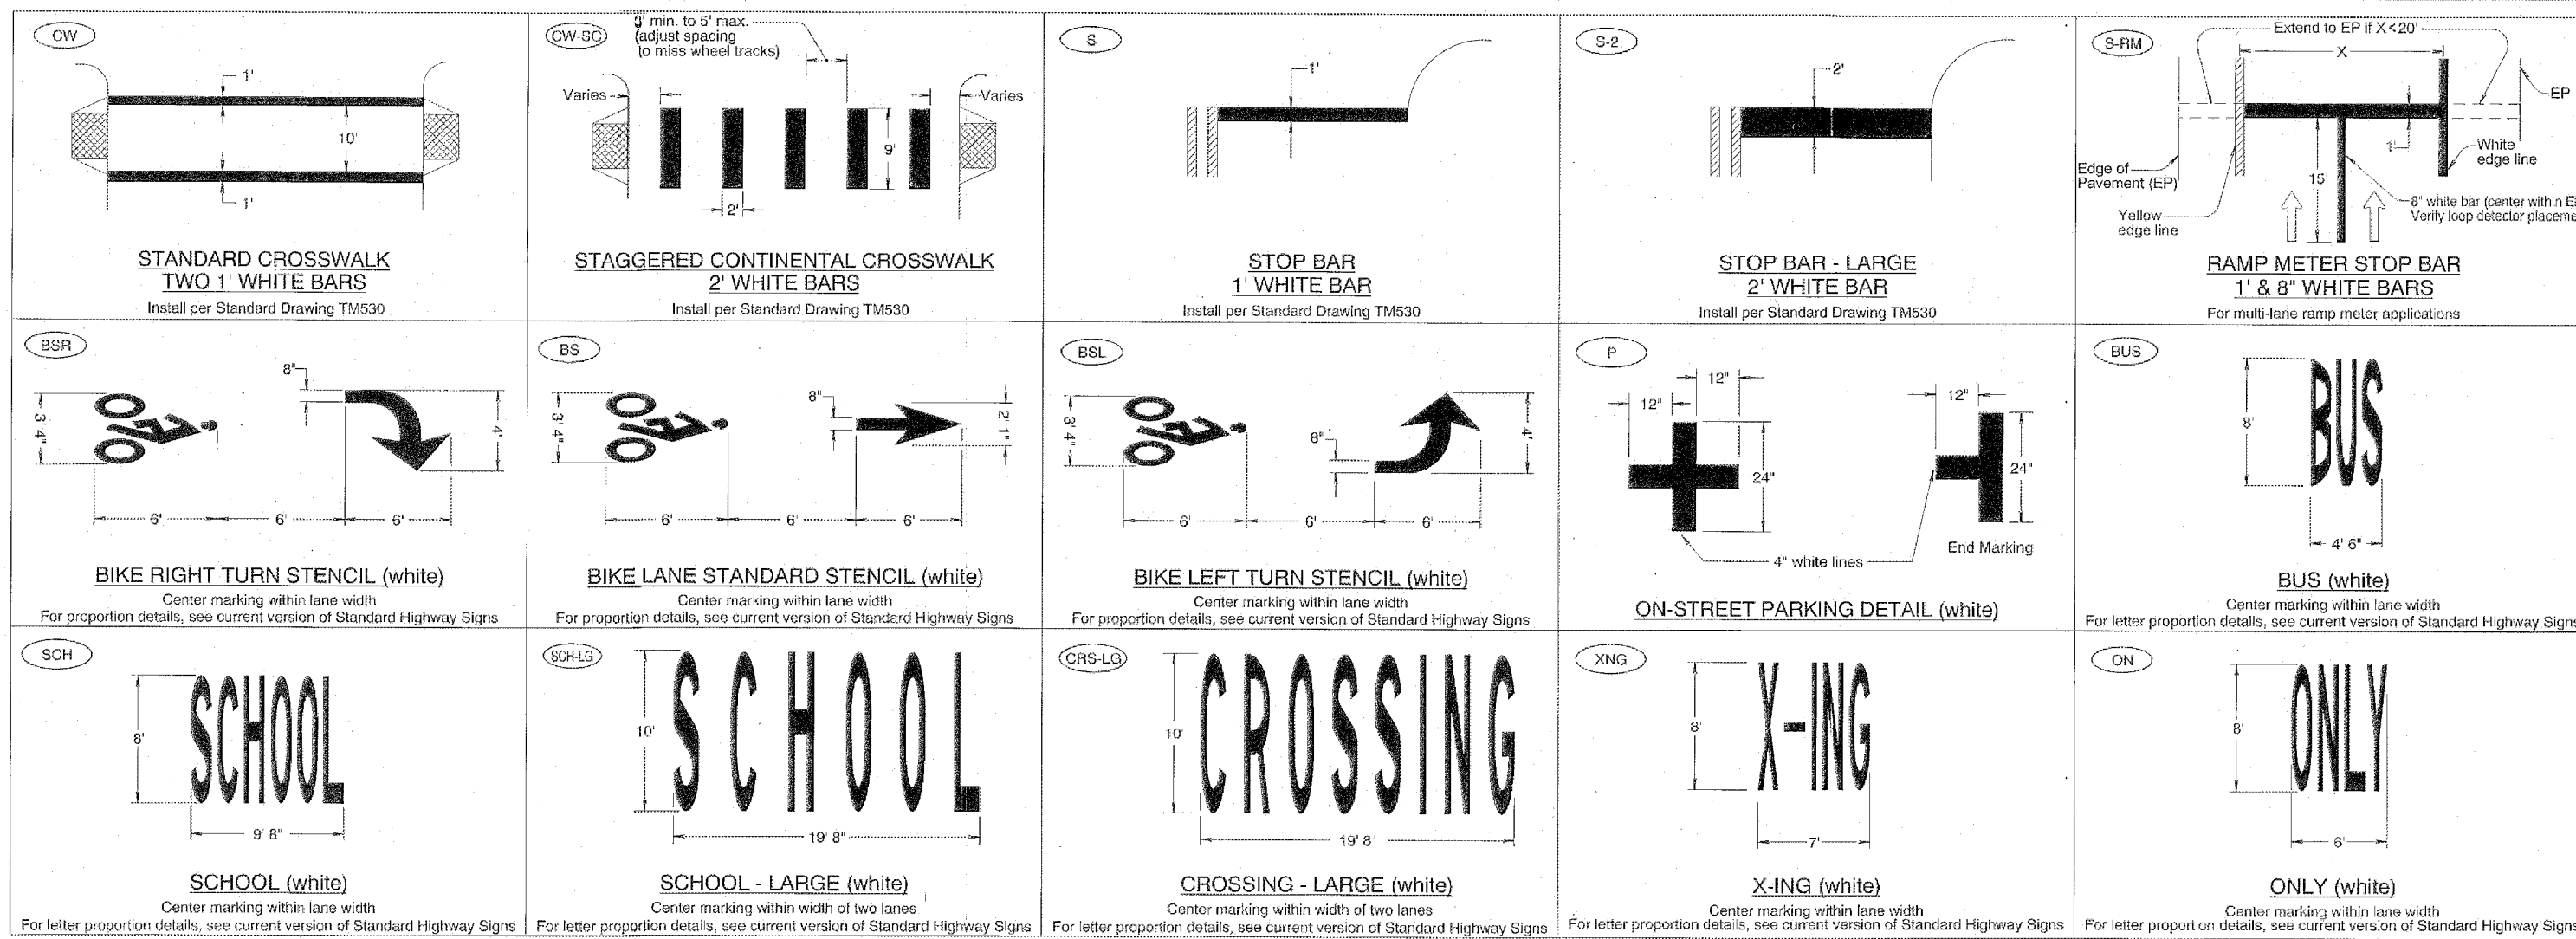



General Note:  
1. Arrow, letter, and bike symbol dimensions nominal.

**LEGEND**  
Direction of Travel

CALC. BOOK NO.	RA
BASELINE REPORT DATE	7/6/2014
NOTE: All material and workmanship shall be in accordance with the current Oregon Standard Specifications	
OREGON STANDARD DRAWINGS	
PAVEMENT MARKING	
STANDARD DETAIL BLOCKS	
2015	
DATE	REVISION DESCRIPTION

The selection and use of this Standard Drawing, while designed in accordance with generally accepted engineering principles and practices, is the sole responsibility of the user and should not be used without consulting a Registered Professional Engineer.

R:\PAVEMENT MARKINGS\SECURE\STANDARD DRAWINGS\2015Standards\14\_June\plotfile\TM500s.dgn :: Default 6/9/2014 9:17:45 AM Hwyr:30m Effective Date February 1, 2015 - May 31, 2015 TM503

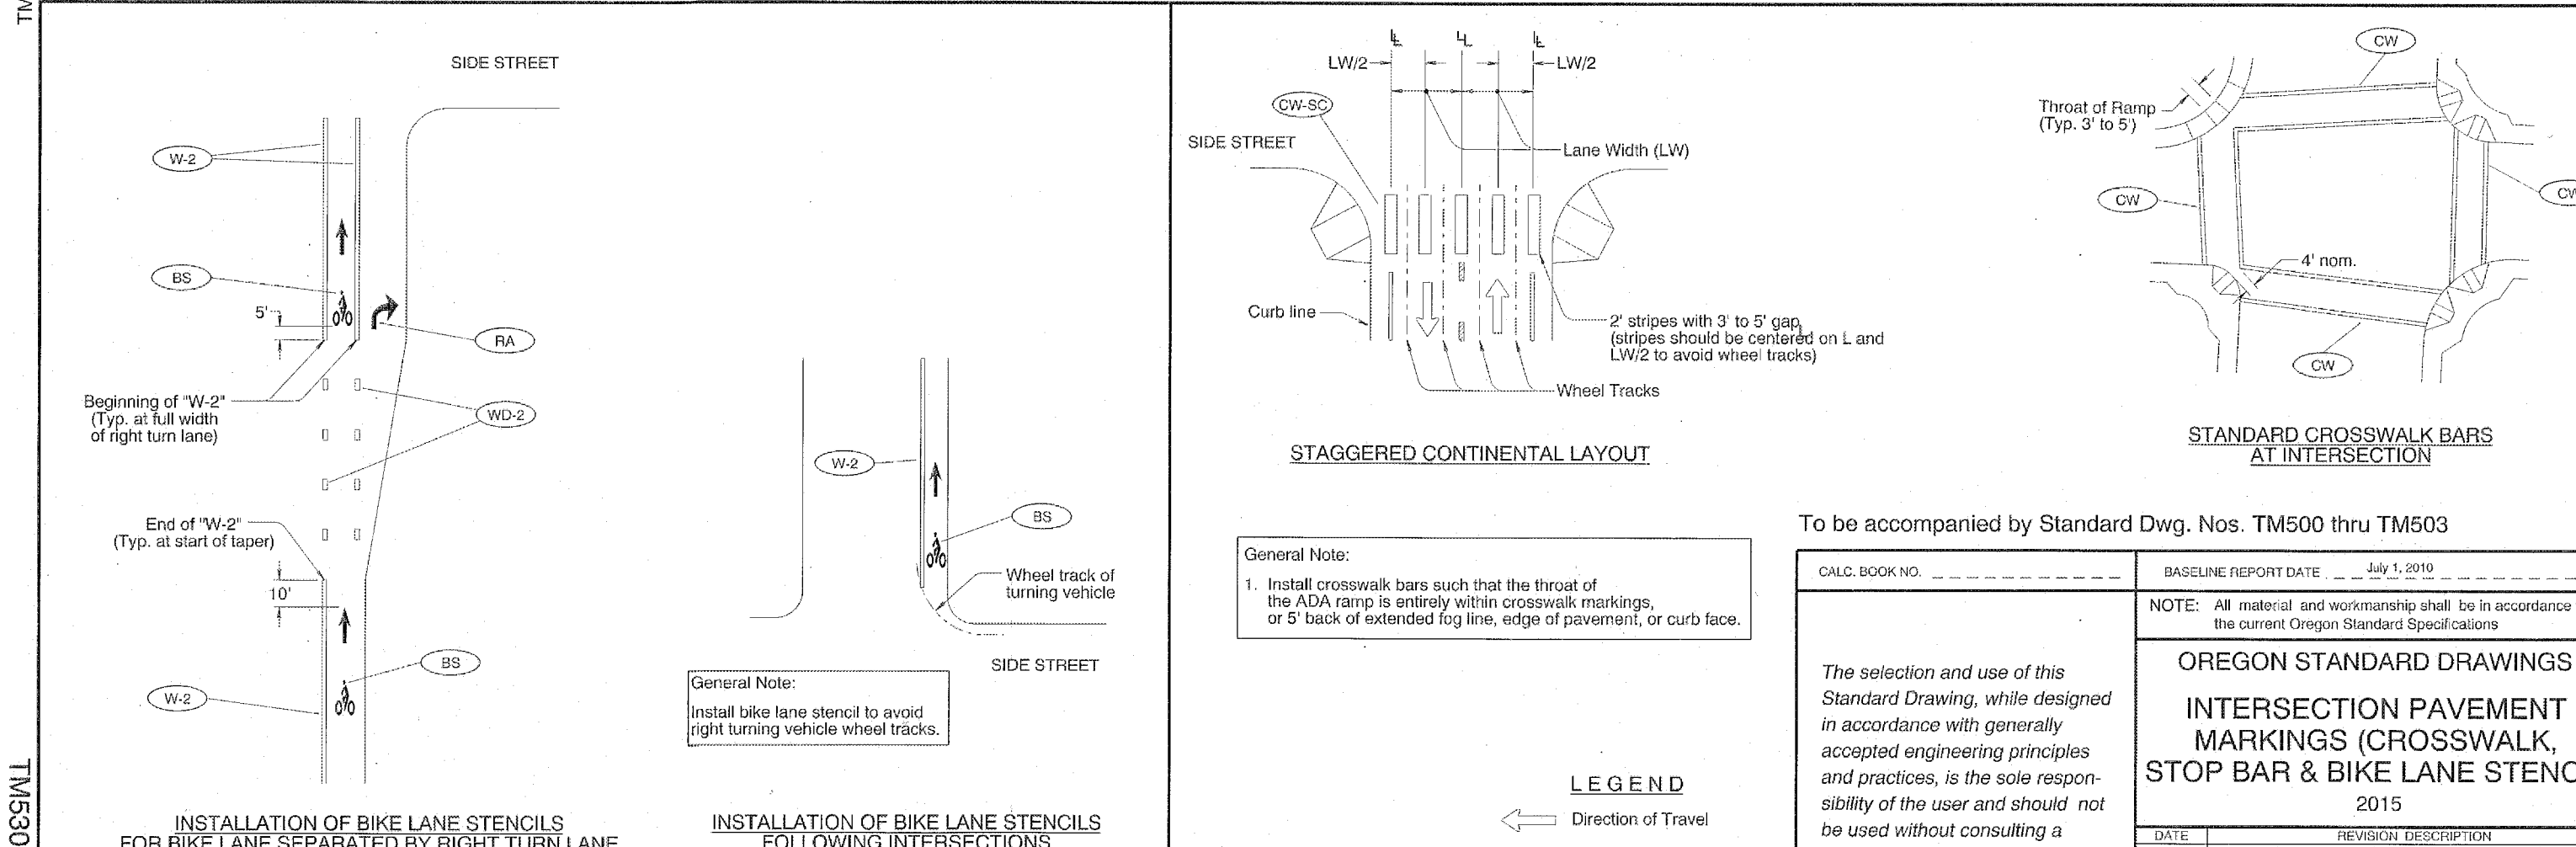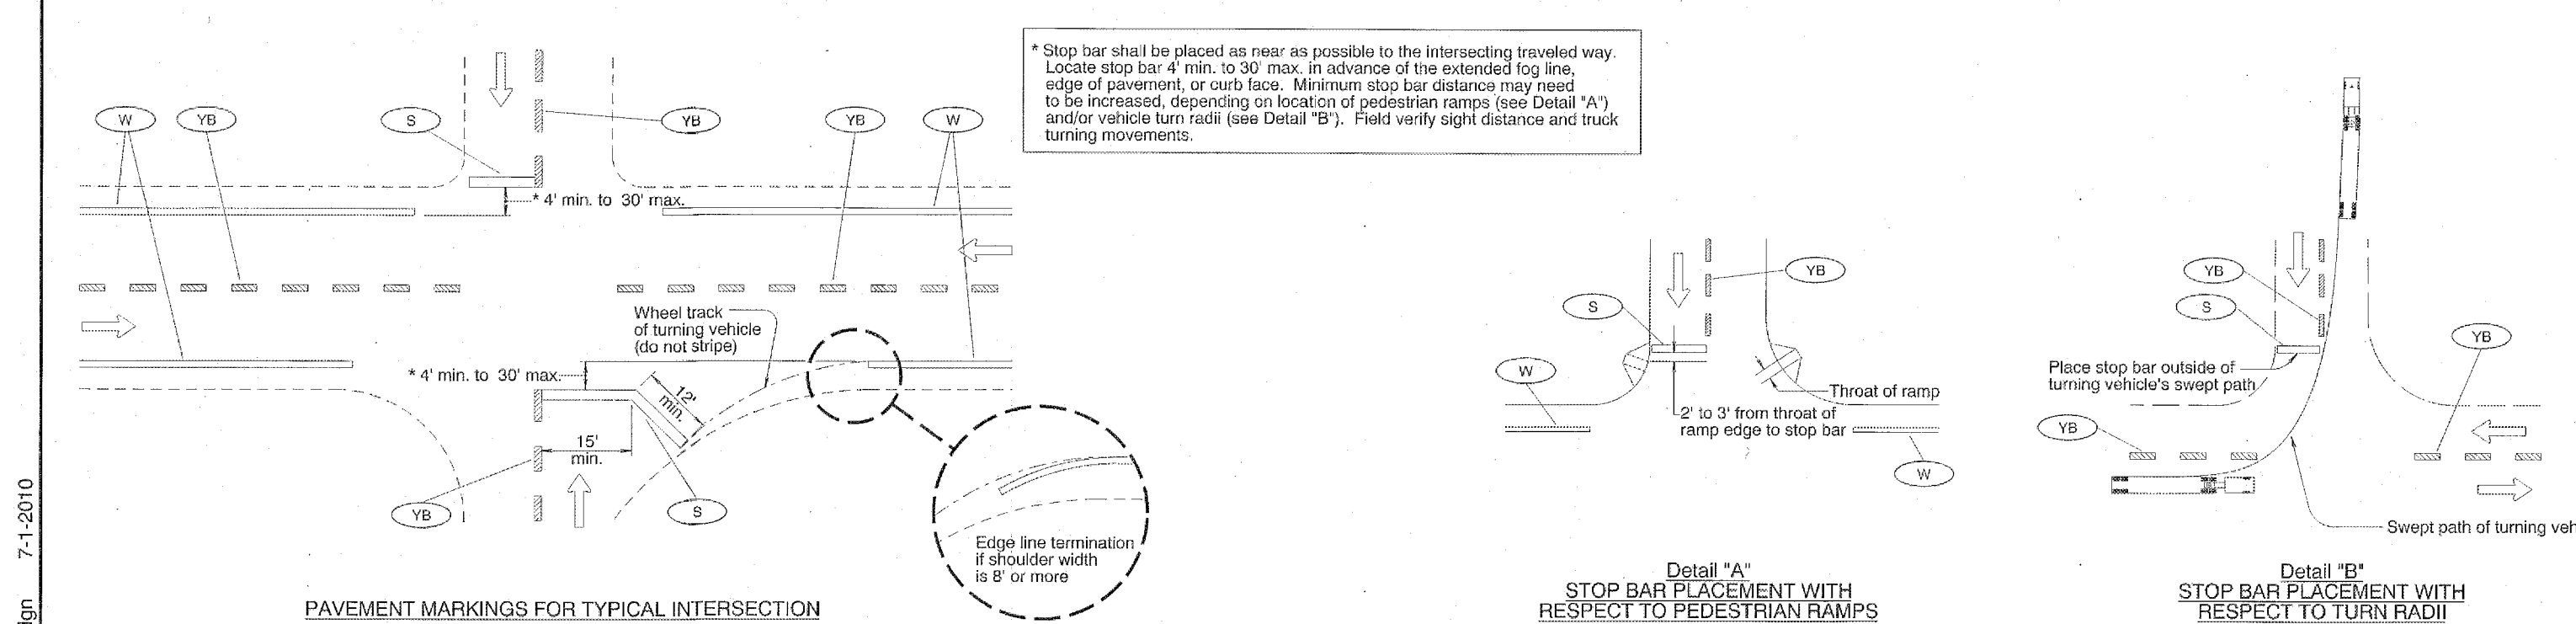


To be accompanied by Standard Dwg. Nos. TM500 thru TM503

CALC. BOOK NO.	RA
BASELINE REPORT DATE	July 1, 2010
NOTE: All material and workmanship shall be in accordance with the current Oregon Standard Specifications	
OREGON STANDARD DRAWINGS	
INTERSECTION PAVEMENT MARKINGS (CROSSWALK, STOP BAR & BIKE LANE STENCIL)	
2015	
DATE	REVISION DESCRIPTION

The selection and use of this Standard Drawing, while designed in accordance with generally accepted engineering principles and practices, is the sole responsibility of the user and should not be used without consulting a Registered Professional Engineer.

Effective Date: February 1, 2015 - May 31, 2015

TM530

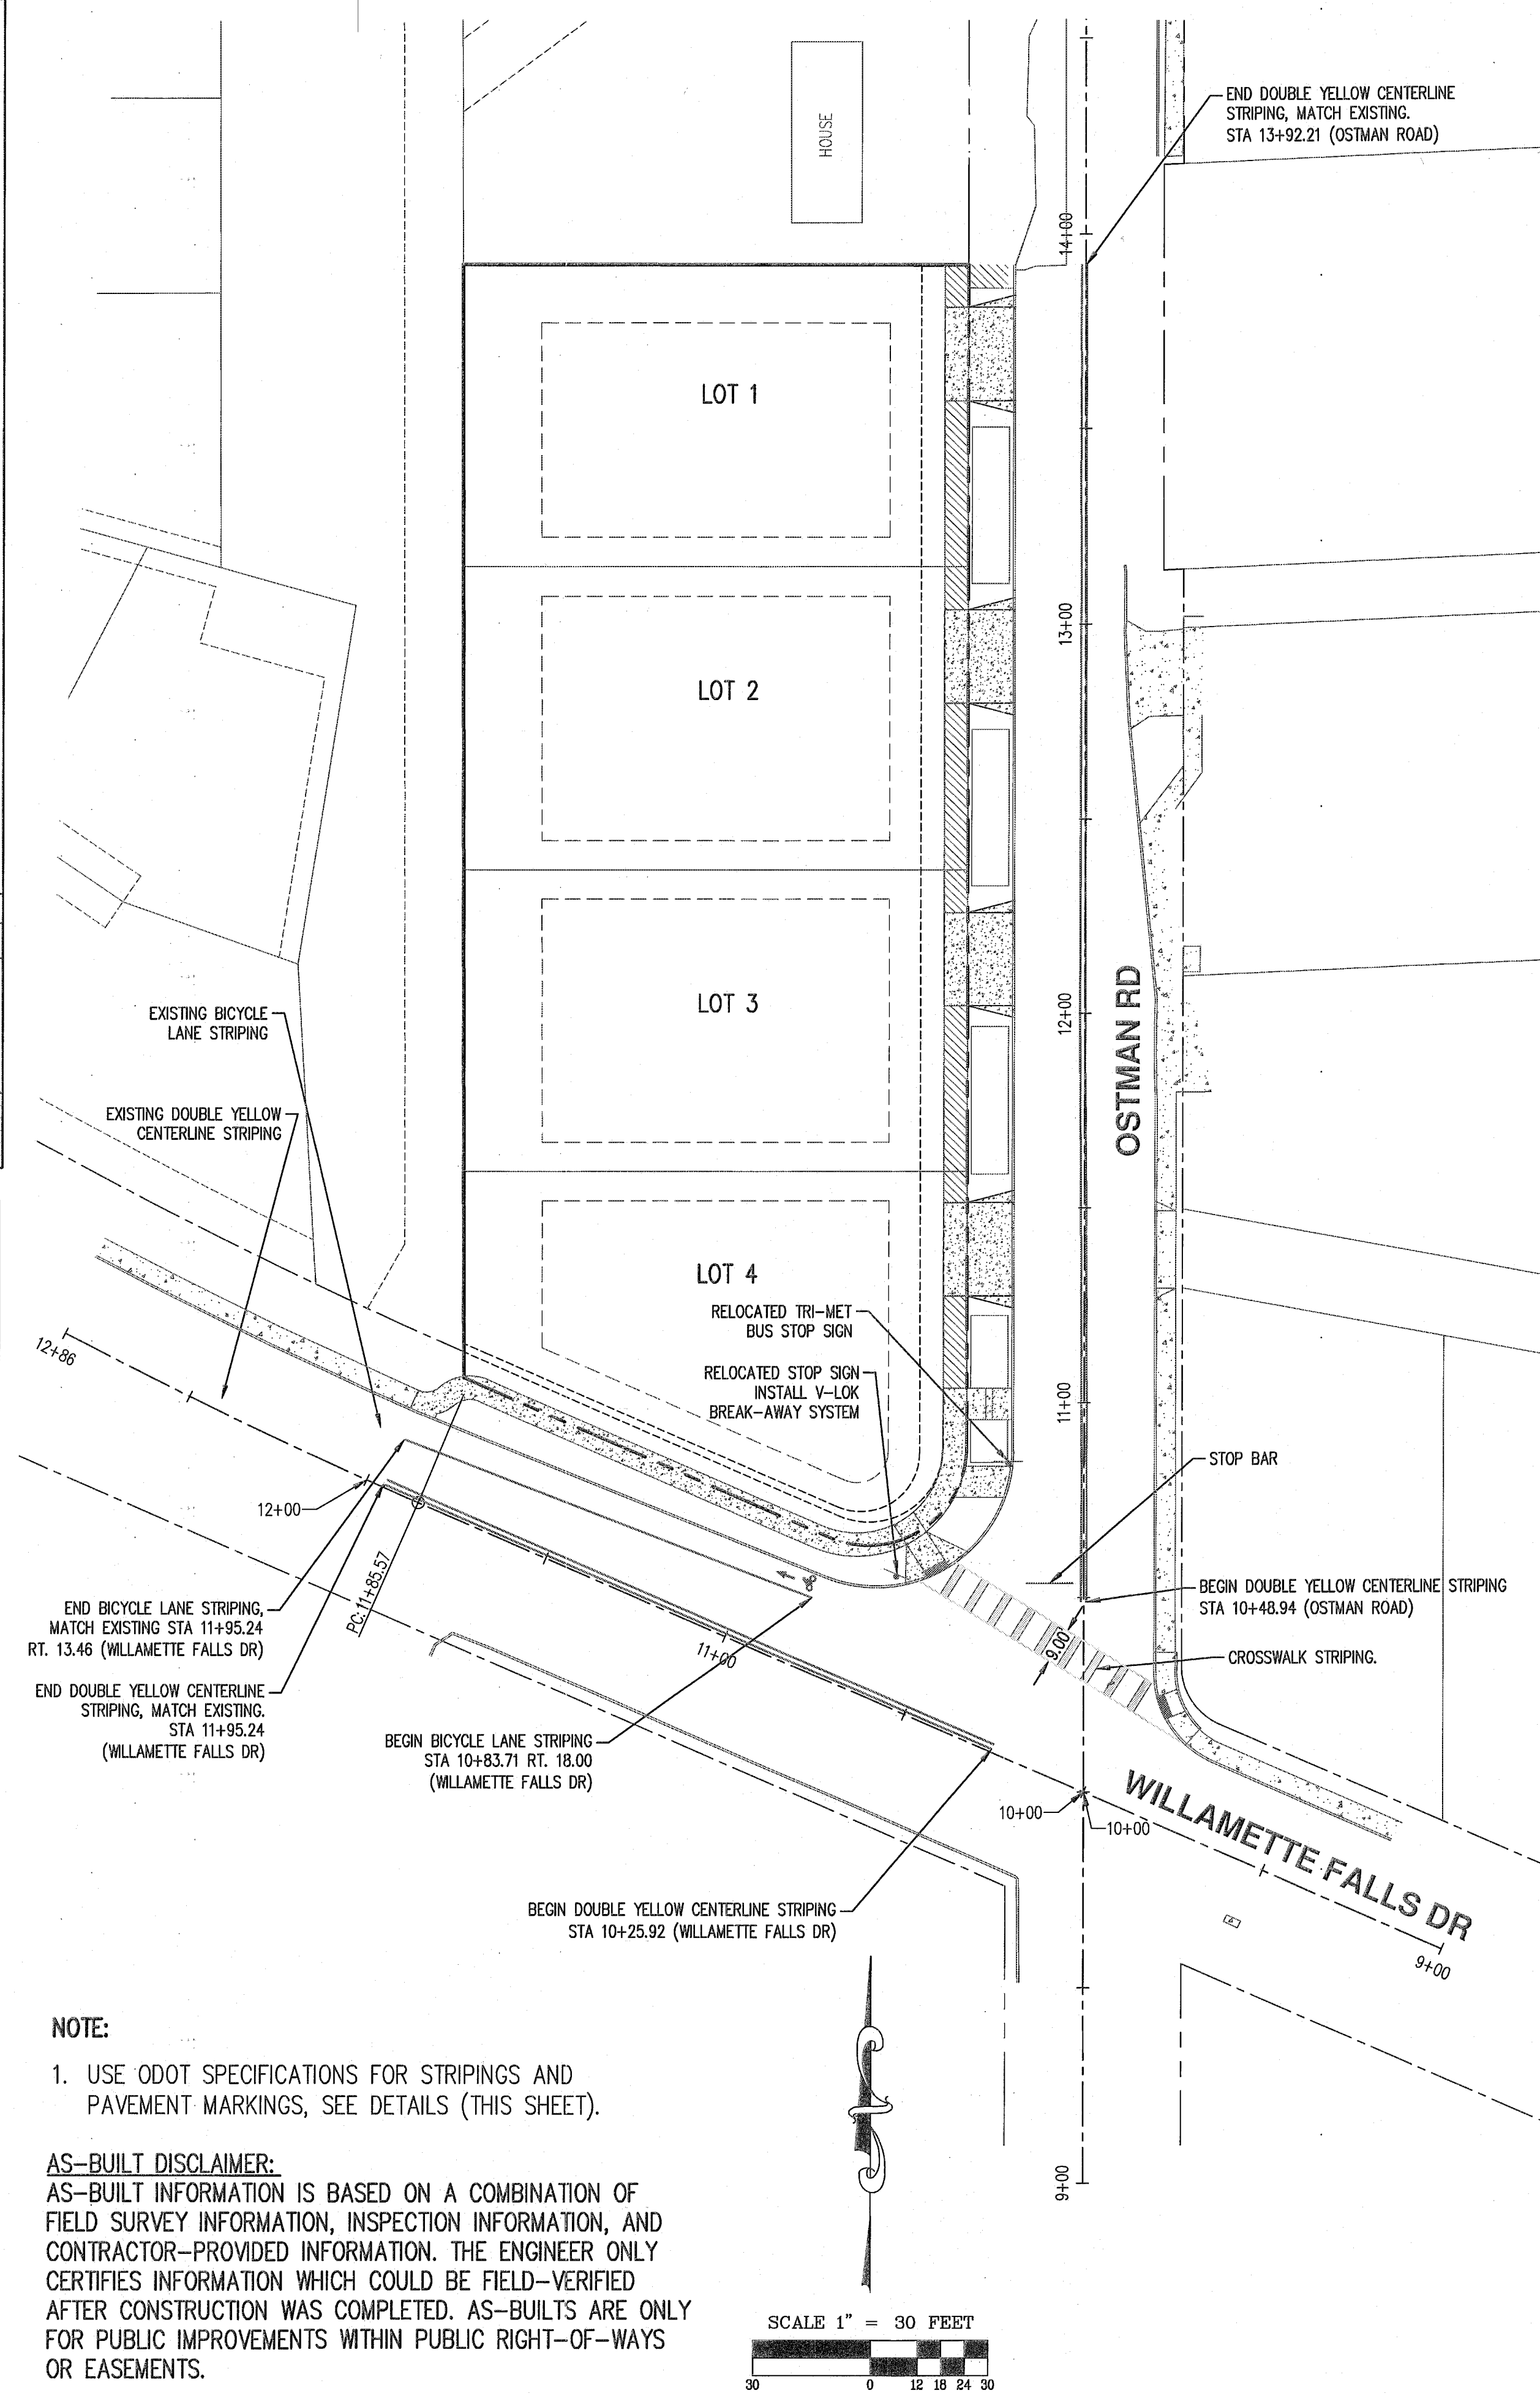

**RENAISSANCE AT WILLAMETTE AS-BUILTS**

**WEST LINN OREGON**

**STRIPING AND SIGNAGE PLAN**

DESIGNED BY: DCN  
DRAWN BY: JDR  
CHECKED BY: MBH  
SCALE: AS NOTED  
DATE: 2/9/2015  
RENEWAL DATE: 6/30/15

**JOB NUMBER 3745**

**SHEET C110**

**AKS**

AKS ENGINEERING AND FORESTRY, LLC  
12865 SW HERMAN RD  
SUITE 100  
PORTLAND, OR 97262  
PHONE: 503.553.1551  
FAX: 503.553.1552  
WWW.AKS-ENG.COM



ENGINEERING • SURVEYING  
FORESTRY • LANDSCAPE ARCHITECTURE



AKS DRAWING FILE: 3745 C200 STORM SEWER PLANNING LAYOUT: C200

**AS-BUILT DISCLAIMER:**

AS-BUILT INFORMATION IS BASED ON A COMBINATION OF FIELD SURVEY INFORMATION, INSPECTION INFORMATION, AND CONTRACTOR-PROVIDED INFORMATION. THE ENGINEER ONLY CERTIFIES INFORMATION WHICH COULD BE FIELD-VERIFIED AFTER CONSTRUCTION WAS COMPLETED. AS-BUILTS ARE ONLY FOR PUBLIC IMPROVEMENTS WITHIN PUBLIC RIGHT-OF-WAYS OR EASEMENTS.

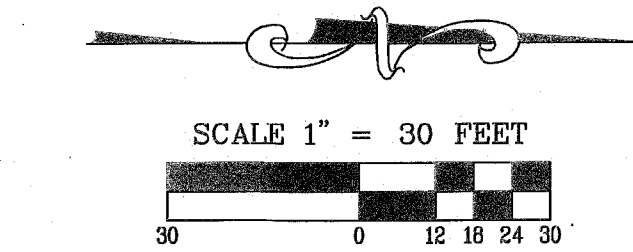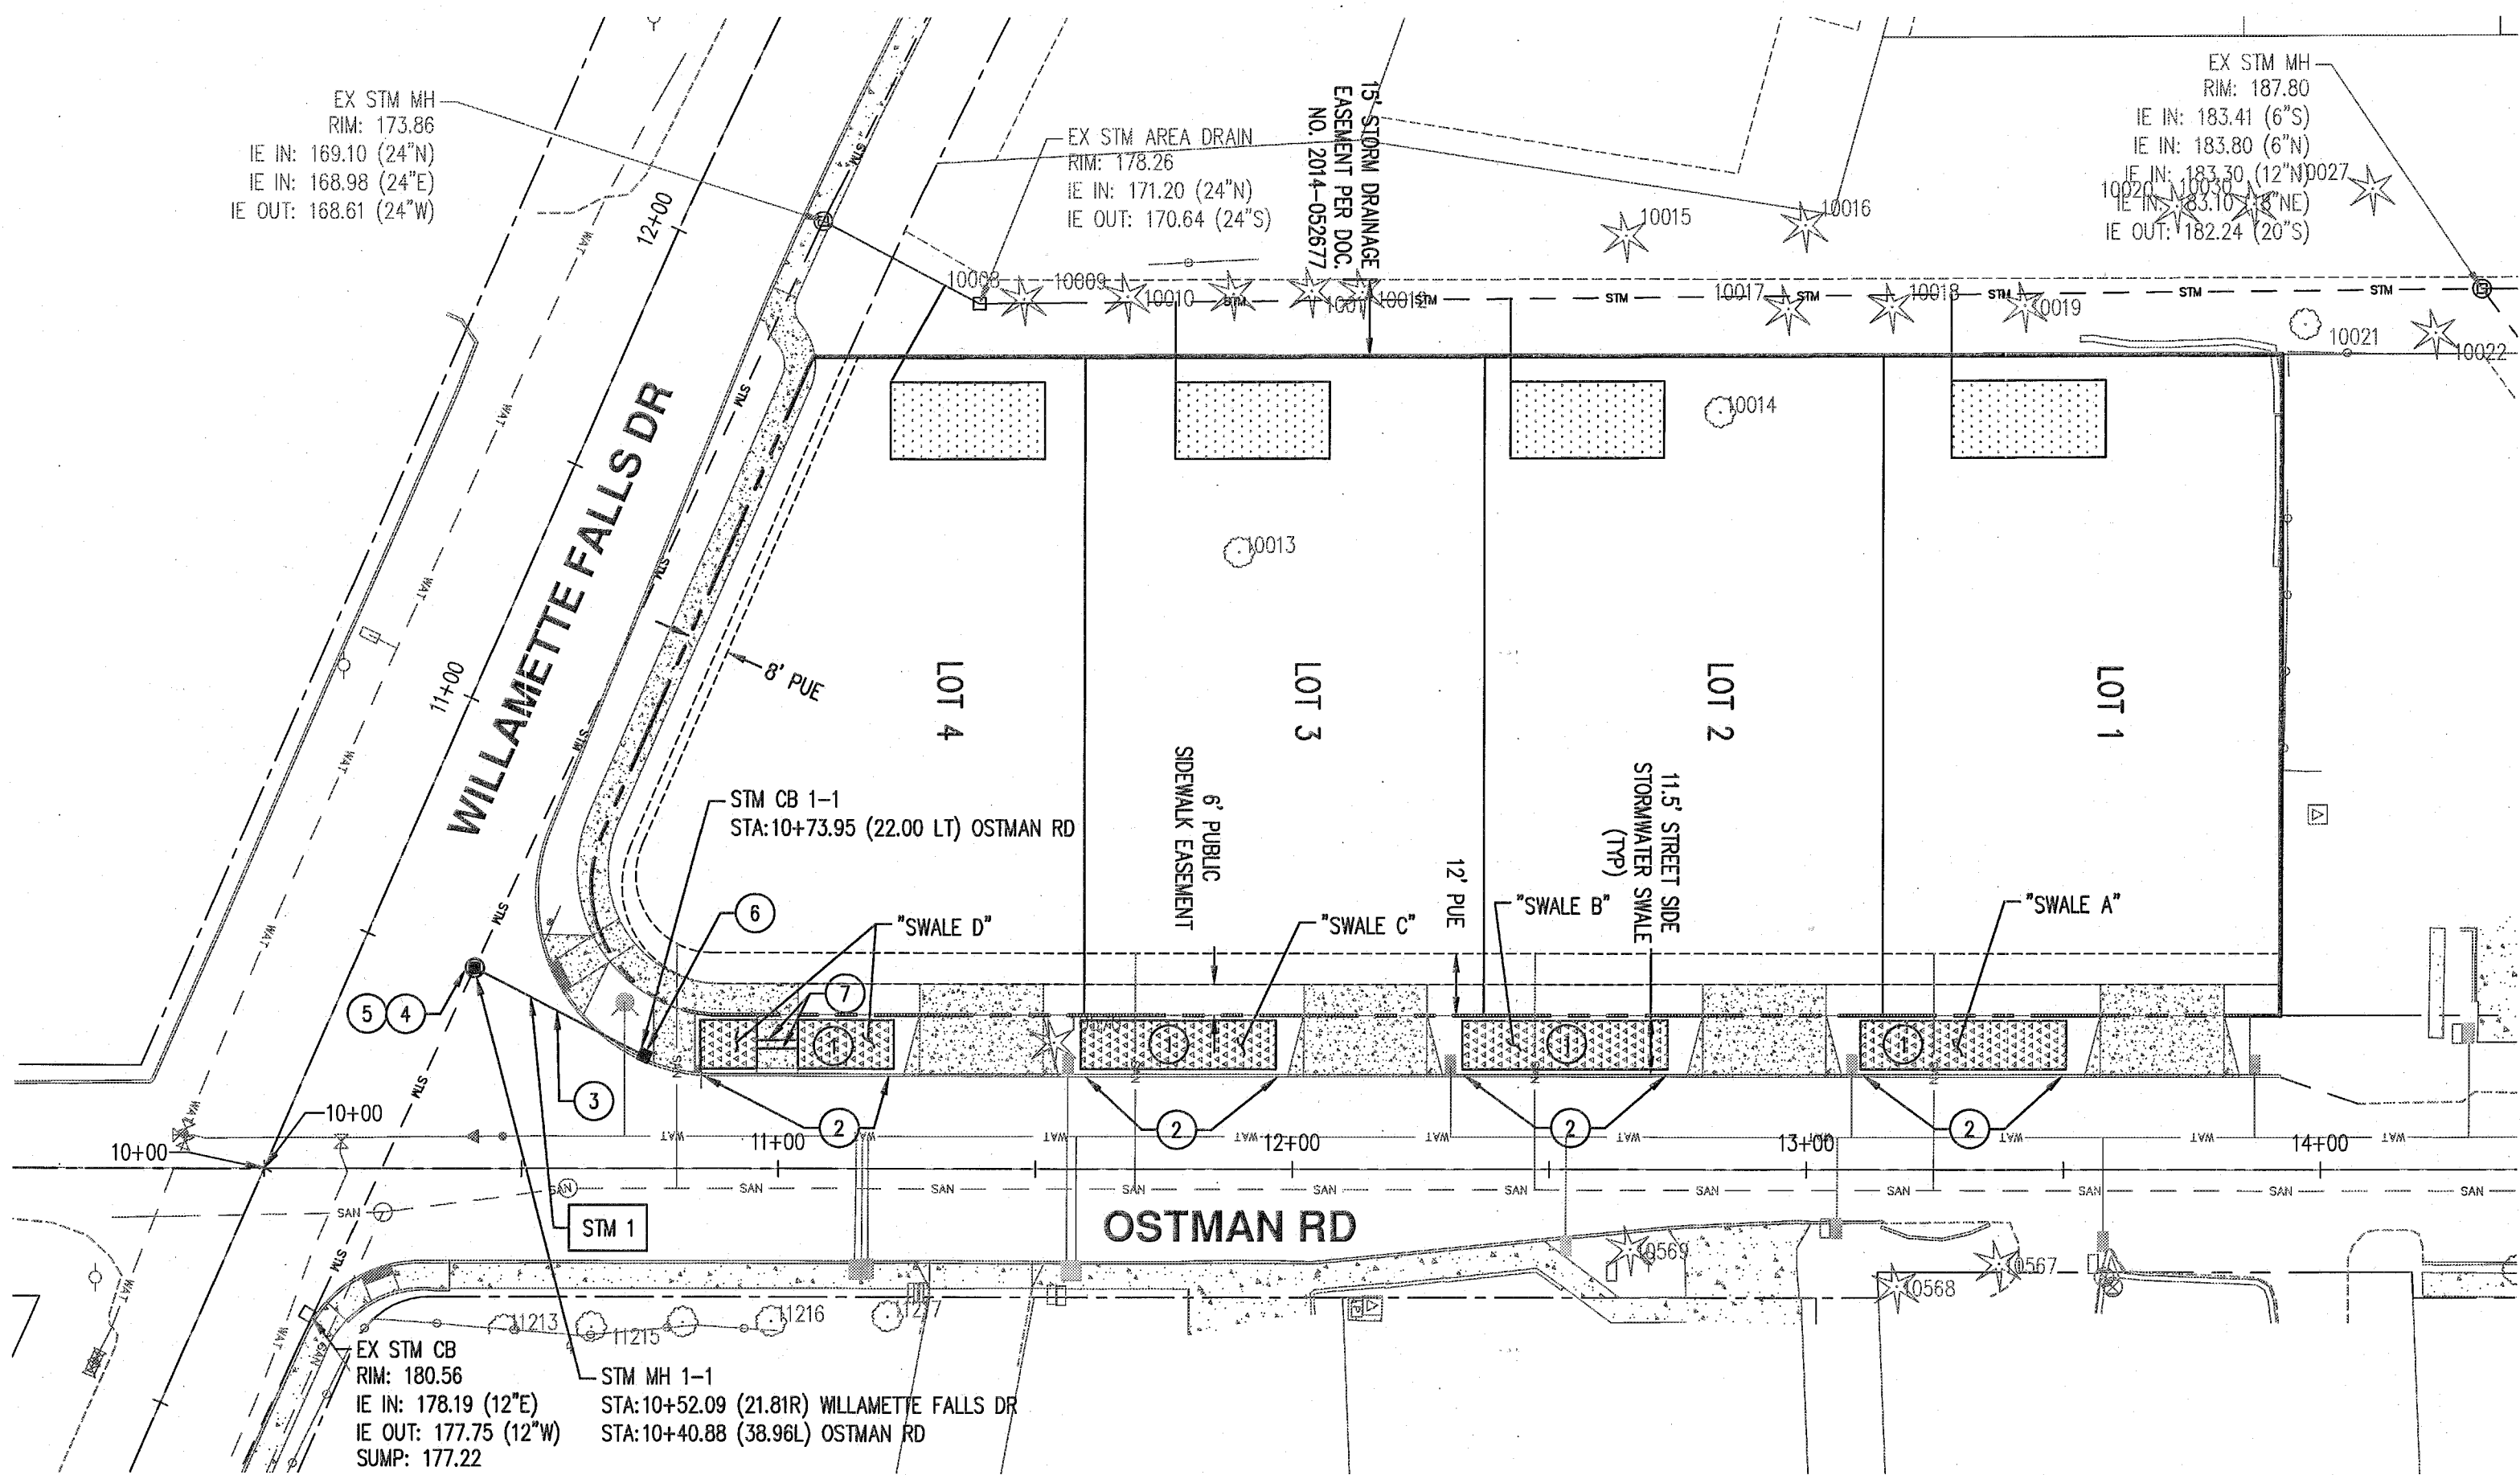


**LEGEND**

- PRIVATE STORMWATER "RAINGARDEN" FACILITY FOR LOTS, BY OTHERS. NOT PART OF THIS PERMIT.
- PUBLIC STREETSIDE STORMWATER FACILITY, SEE DETAIL ON SHEET C202.

**PUBLIC STORMWATER DRAINAGE KEYED NOTES**

- INSTALL PUBLIC STREETSIDE STORMWATER FACILITY PER DETAILS ON SHEET C201.
- INSTALL INLET AND OUTLET IN CURB PER DETAIL ON SHEET C201. REVERSE SLOPE ON OUTLET WING WALL ONLY, 0.10' TO PREVENT GUTTER DRAINAGE FROM ENTERING SWALE AT SWALE OUTLET LOCATION. ALL INLETS TO BE 30" WIDE AT THROAT.
- INSTALL 37 LF 10" DIP AT S = 0.1044.
- CONTRACTOR SHALL POTHOLE TO VERIFY EXISTING PIPE SIZE AND FLOWLINE AT THIS LOCATION PRIOR TO ORDERING AND INSTALLING STORM MANHOLE 1-1.
- INSTALL 60" STORMWATER MANHOLE, SEE DETAIL ON SHEET C201.
- INSTALL "2 1/2 A" GUTTER INLET, SEE DETAIL ON SHEET C201.
- INSTALL (2) 8" ASTM D3034 SDR 35 CULVERT PIPES AT BOTTOM OF "SWALE D". MATCH FLOWLINES TO SWALE FLOWLINE.

**NOTE:**  
ALL PUBLIC STORM SEWER CONSTRUCTION SHALL BE IN COMPLIANCE WITH THE CITY OF WEST LINN PUBLIC WORKS STANDARD CONSTRUCTION SPECIFICATIONS, DIVISION 6, STORM DRAIN TECHNICAL REQUIREMENTS.

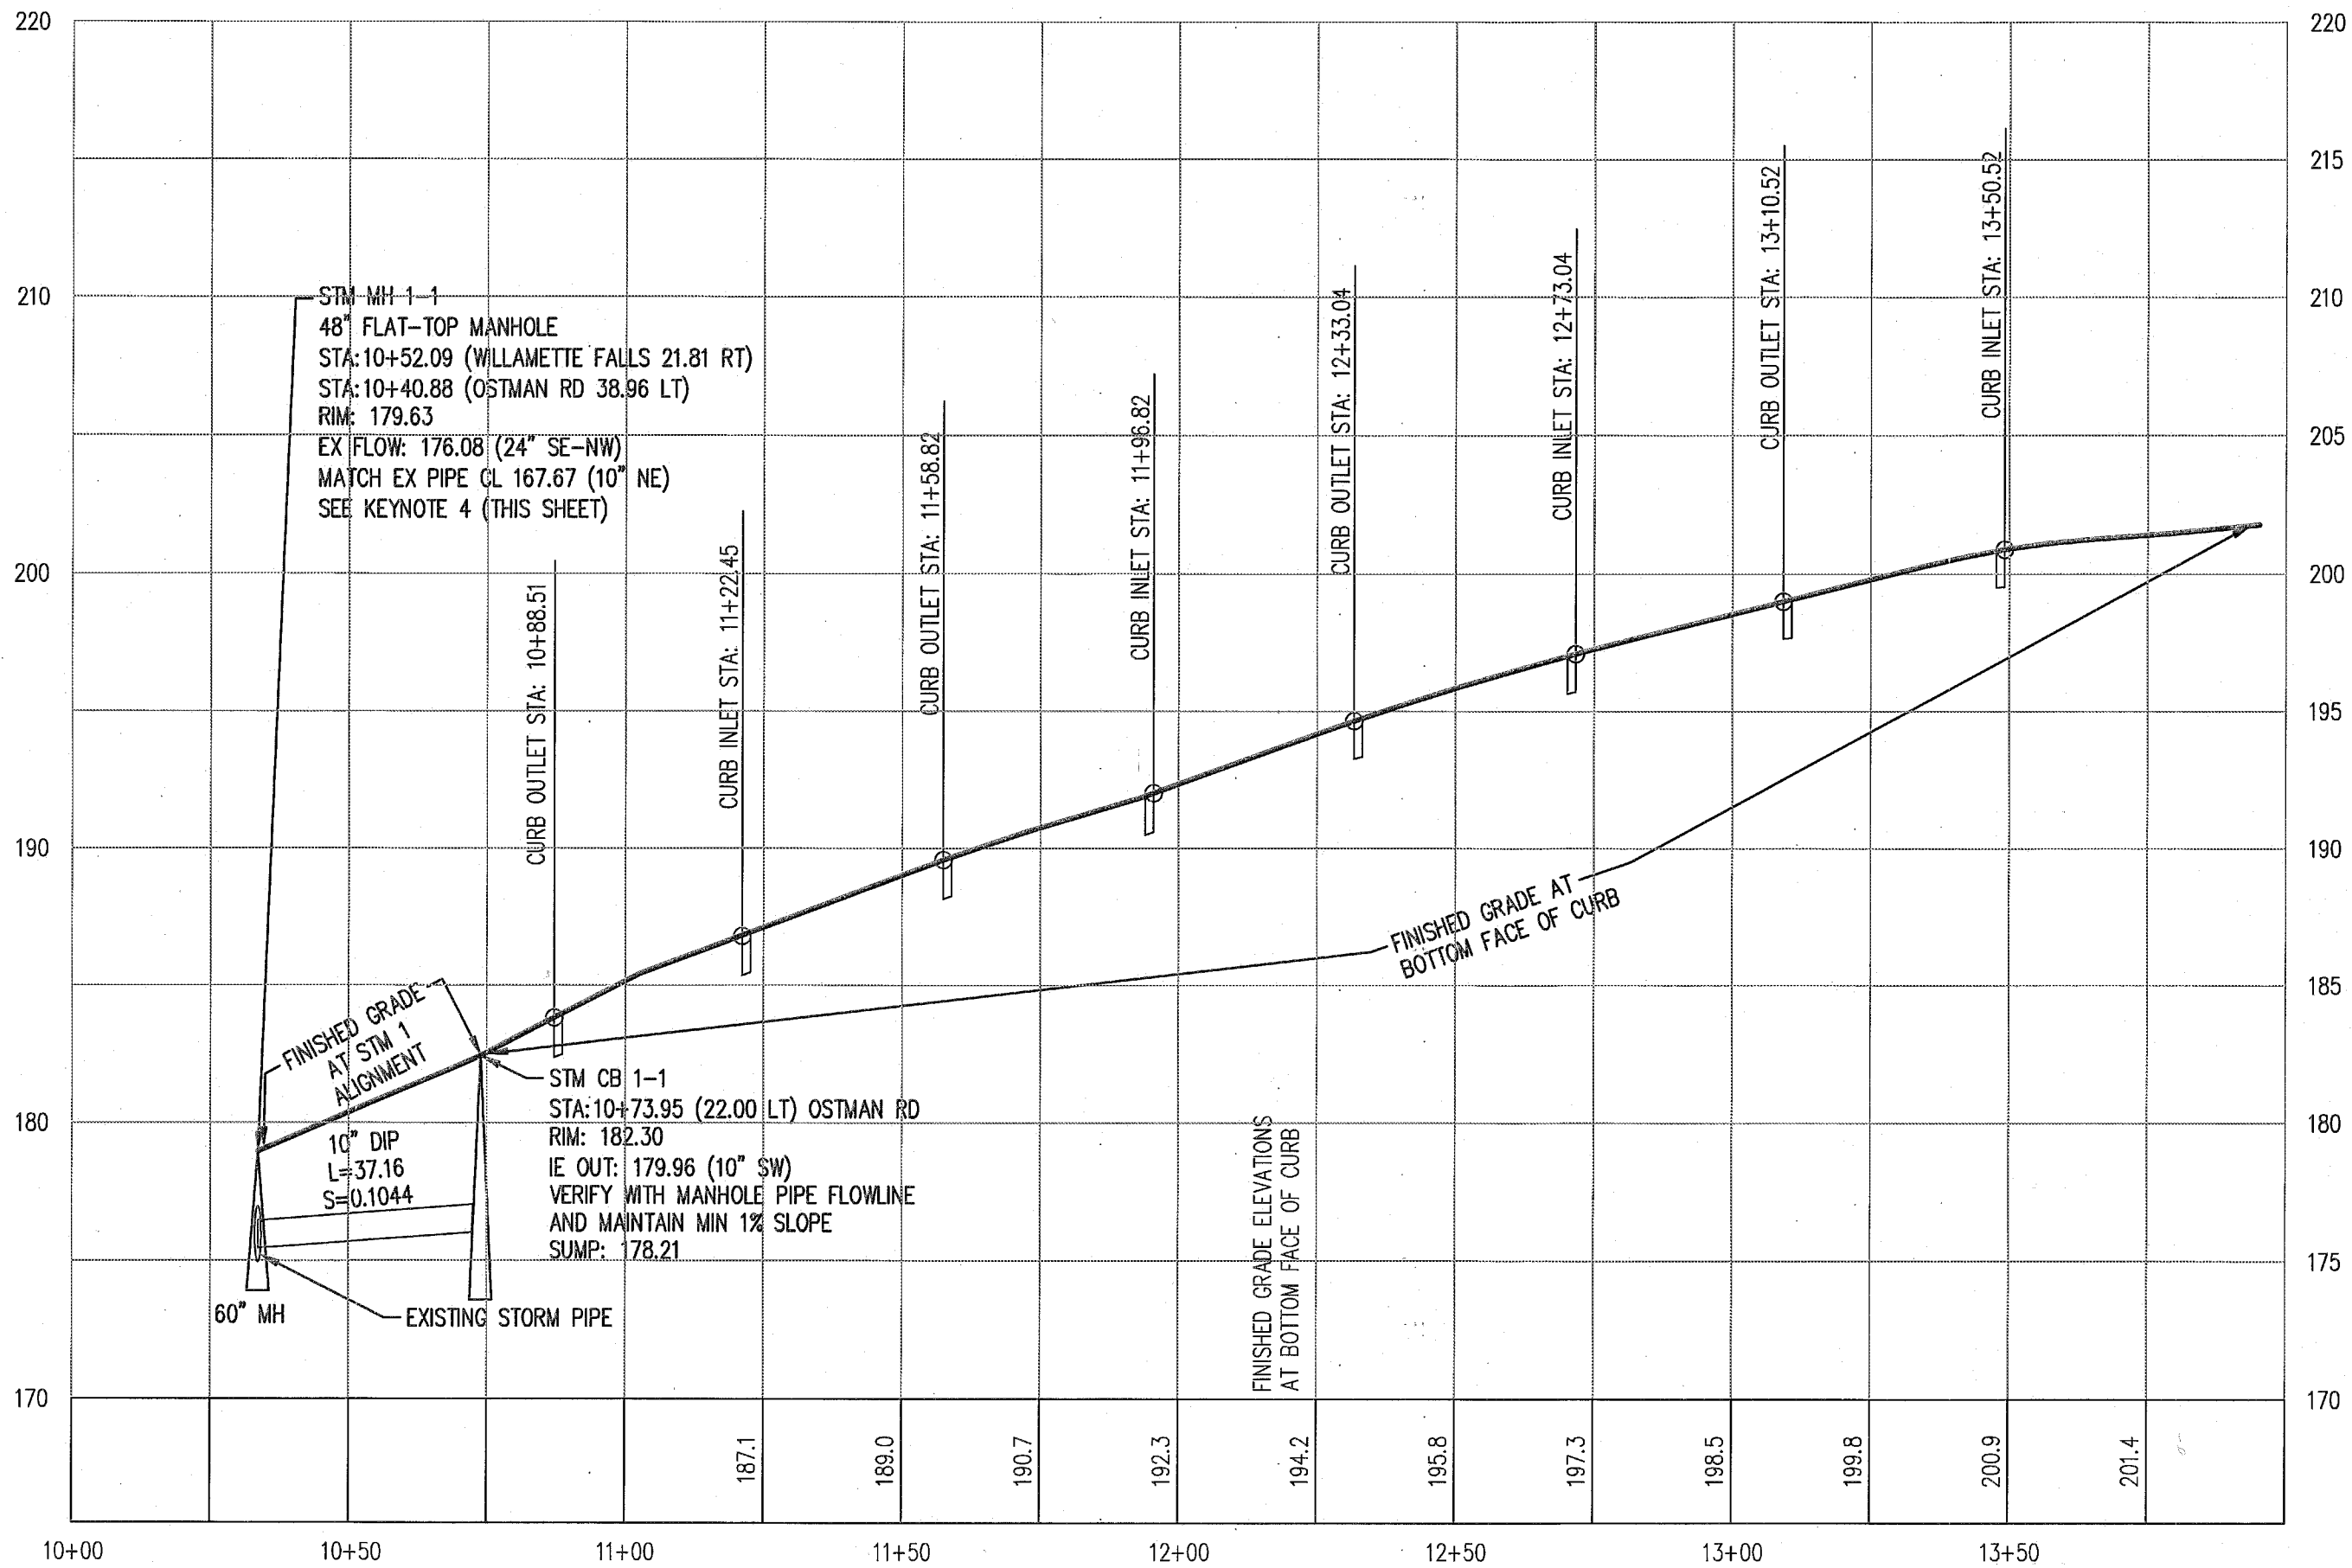



**STM 1**  
HOR: 1" = 30'  
VERT: 1" = 6'

STATIONING BASED ON OSTRMAN ROAD CENTERLINE




AS-BUILT DISCLAIMER:  
AS-BUILT INFORMATION IS BASED ON A COMBINATION OF FIELD SURVEY INFORMATION, INSPECTION INFORMATION, AND CONTRACTOR-PROVIDED INFORMATION. THE ENGINEER ONLY CERTIFIES INFORMATION WHICH COULD BE FIELD-VERIFIED AFTER CONSTRUCTION WAS COMPLETED. AS-BUILTS ARE ONLY FOR PUBLIC IMPROVEMENTS WITHIN PUBLIC RIGHT-OF-WAYS OR EASEMENTS.

PUBLIC STREET SWALE	LENGTH OF FACILITY SEGMENT (ft)	CHECK DAM LENGTH (ft)	BOTTOM WIDTH (ft)	SIDE SLOPE RIGHT (Xright:1)	SIDE SLOPE LEFT (Xleft:1)	DOWNSTREAM DEPTH (ft)	LANDSCAPE WIDTH (ft)	ROCK STORAGE WIDTH (ft)	ROCK STORAGE DEPTH (ft)
A	8	2	5.0	3	3	8	11.5	9	18
B	8	2	5.0	3	3	8	11.5	9	18
C	8	2	5.0	3	3	8	11.5	9	18
D	8	2	5.0	3	3	8	11.5	9	18
E	8	2	5.0	3	3	8	11.5	9	18
F	8	2	5.0	3	3	8	11.5	9	18
G	8	2	5.0	3	3	8	11.5	9	18
H	8	2	5.0	3	3	8	11.5	9	18
I	8	2	5.0	3	3	8	11.5	9	18
J	8	2	5.0	3	3	8	11.5	9	18
K	8	2	5.0	3	3	8	11.5	9	18
L	8	2	5.0	3	3	8	11.5	9	18
M	8	2	5.0	3	3	8	11.5	9	18
N	8	2	5.0	3	3	8	11.5	9	18
O	8	2	5.0	3	3	8	11.5	9	18
P	8	2	5.0	3	3	8	11.5	9	18
Q	8	2	5.0	3	3	8	11.5	9	18
R	8	2	5.0	3	3	8	11.5	9	18
S	8	2	5.0	3	3	8	11.5	9	18
T	8	2	5.0	3	3	8	11.5	9	18
U	8	2	5.0	3	3	8	11.5	9	18
V	8	2	5.0	3	3	8	11.5	9	18
W	8	2	5.0	3	3	8	11.5	9	18
X	8	2	5.0	3	3	8	11.5	9	18
Y	8	2	5.0	3	3	8	11.5	9	18
Z	8	2	5.0	3	3	8	11.5	9	18

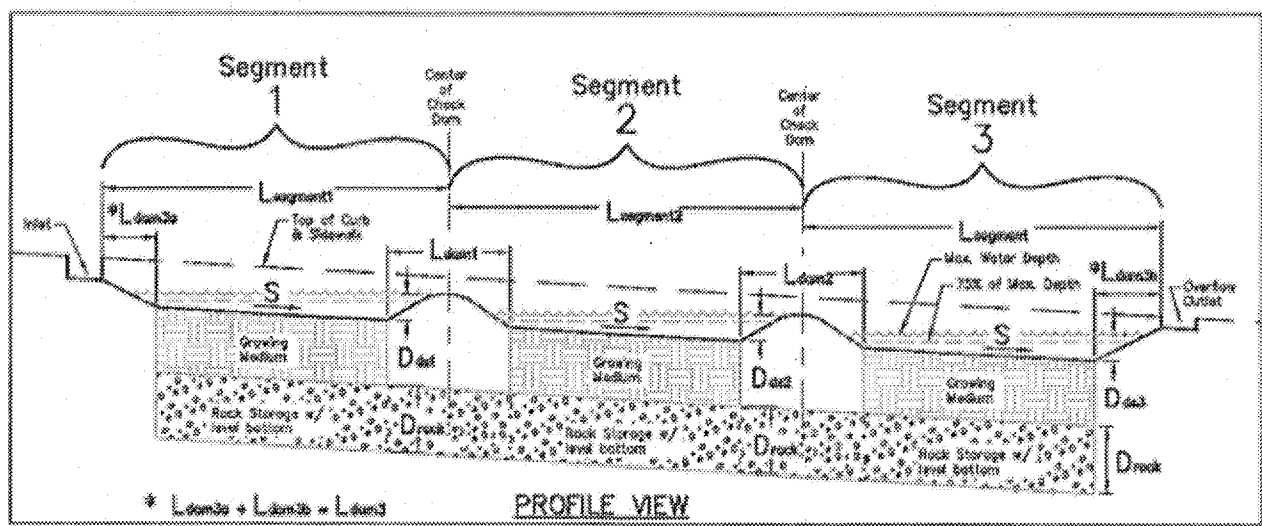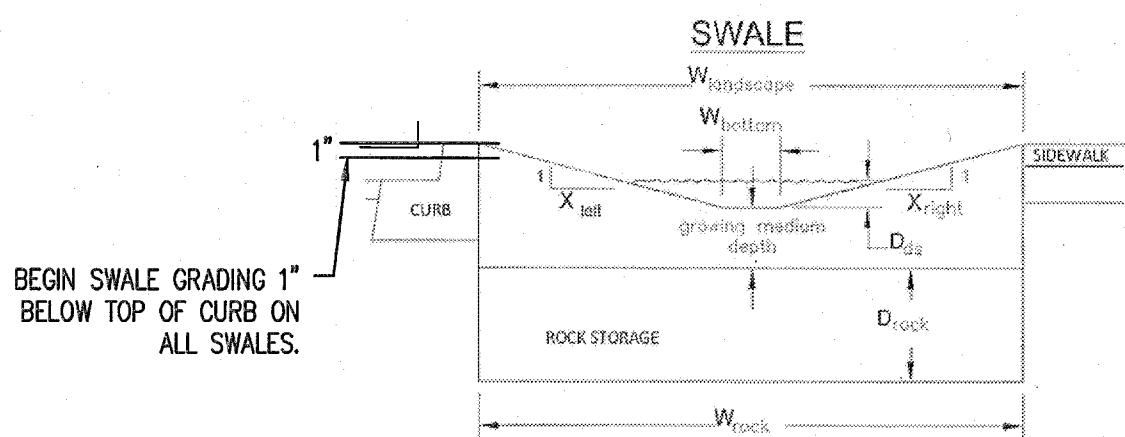

PUBLIC STREET SWALES  
NTS

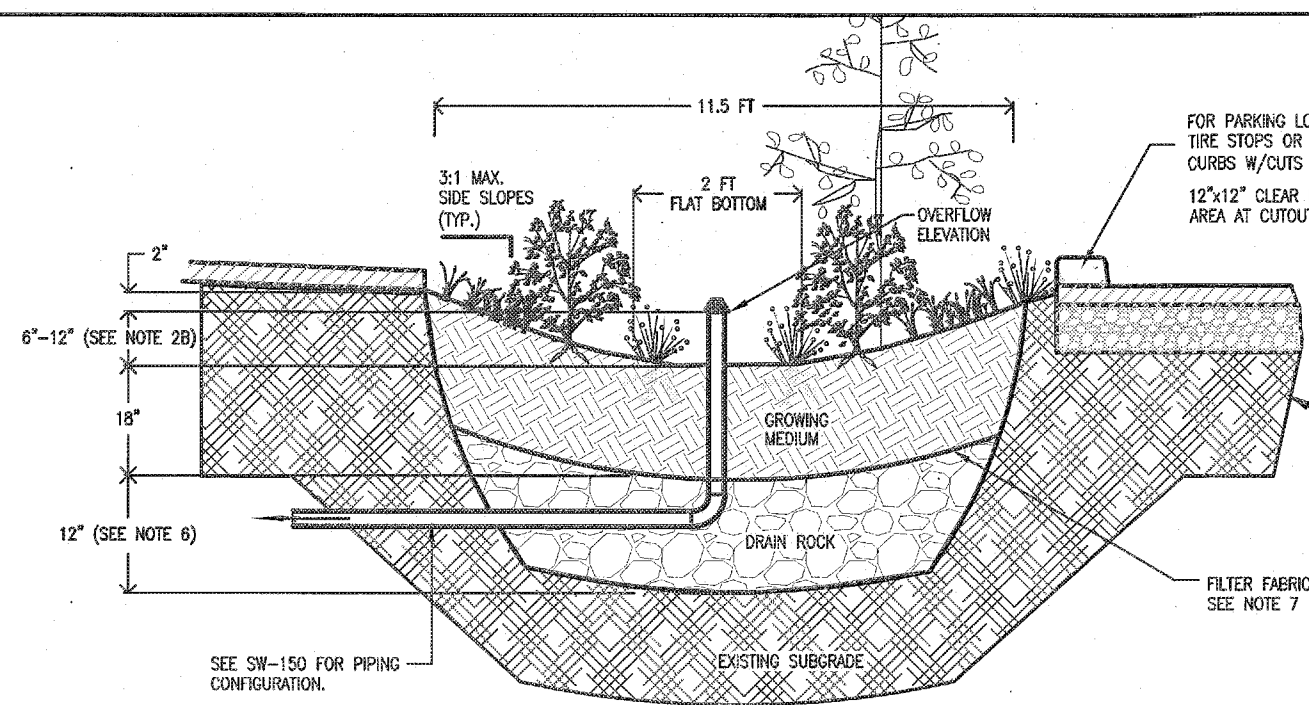

- Provide protection from all vehicle traffic, equipment staging, and foot traffic in proposed infiltration areas prior to, during, and after construction.
- Dimensions:
  - Width of swale: 5' - 12'.
  - Depth of swale (from top of growing medium to overflow elevation): Simplified: 9", Presumptive: 6" - 12".
  - Longitudinal slope of swale: 0.0% or less.
  - Flat bottom width: 2'.
  - Side slopes of swale: 3:1 maximum.
- Setbacks (from centerline of facility):
  - Infiltration swales must be 10' from foundations and 5' from property lines.
  - Flow-through swales must be lined with connection to approved discharge point according to SWMM Section 1.3.
- Overflow:
  - Overflow required for Simplified Approach.
  - Inlet elevation must allow for 2" of freeboard, minimum.
  - Protect from debris and sediment with strainer or grate.
- Piping: shall be ABS Sch. 40, cast iron, or PVS Sch. 40. 3" pipe required for up to 1,500 sq ft of impervious area, otherwise 4" min. Piping must have 1% grade and follow the Uniform Plumbing Code.
- Drain rock:
  - Size for infiltration swale: 1 1/2" - 3/4" washed
  - Size for flow-through swale: 3/4" washed
  - Depth for Simplified: 12"
  - Depth for Presumptive: 0-48", see calcs.
- Separation between drain rock and growing medium: Use filter fabric (see SWMM Exhibit 2-4 Geotextile table) or a gravel lens (1/4" - 1/2" inch washed, crushed rock 2 to 3 inches deep).
- Growing medium:
  - 18" minimum
  - See Appendix F.3 for specification or use sand/loam/compost 3-way mix.
- Vegetation: Follow landscape plans otherwise refer to plant list in SWMM Appendix F. Minimum container size is 1 gallon. # of plantings per 100sf of facility area:
  - Zone A (wet): 115 herbaceous plants OR 100 herbaceous plants and 4 small shrubs.
  - Zone B (moderate to dry): 1 tree AND 3 large shrubs / small trees AND 4 small shrubs AND 140 groundcover plants.The delineation between Zone A and B shall be either at the outlet elevation or the check dam elevation, whichever is lowest.
- Waterproof liner: Shall be 30 mil PVC or equivalent for flow-through facilities.
- Install washed pea gravel or river rock to transition from inlets and splash pad to growing medium.
- Check dams: Shall be placed according to facility design. Refer to SW-340 for profile and spacing.
- Inspections: Call BVS IPR Inspection Line, (503) 823-7000, for appropriate inspections.


STORMWATER MANAGEMENT MANUAL TYPICAL DETAILS

- Simplified / Presumptive Design Approach -

Swale

NUMBER SW-120

Bureau of Environmental Services

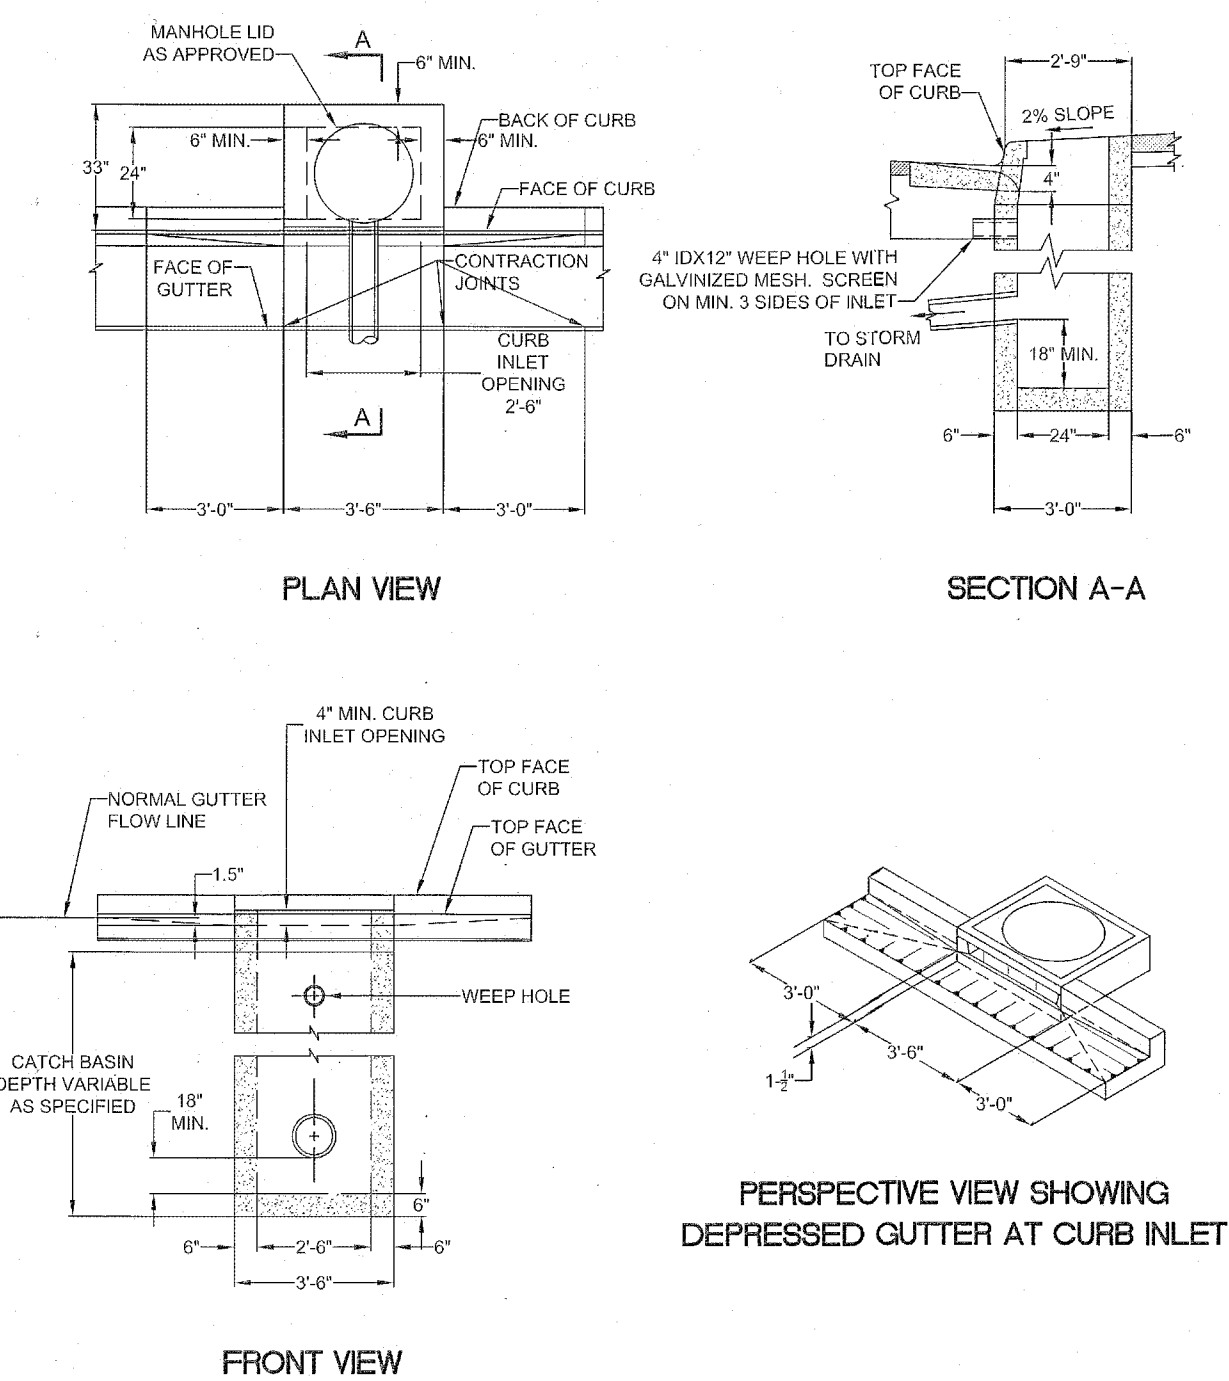


- NOTE:
- ALL FABRICATED METAL PARTS SHALL BE HOT-DIPPED GALVANIZED AFTER FABRICATION.
  - CONCRETE STRENGTH SHALL BE 3300 PSI AT 28 DAYS.
  - CURB INLET BASE MAY BE PRECAST OR CAST-IN-PLACE.
  - FOR SLOPES OF 5% OR GREATER, USE DWG. WL-601.

GUTTER INLET  
2 1/2 A

DATE: 2010  
DRAWING NO. WL-600  
FILE NO.

City of West Linn

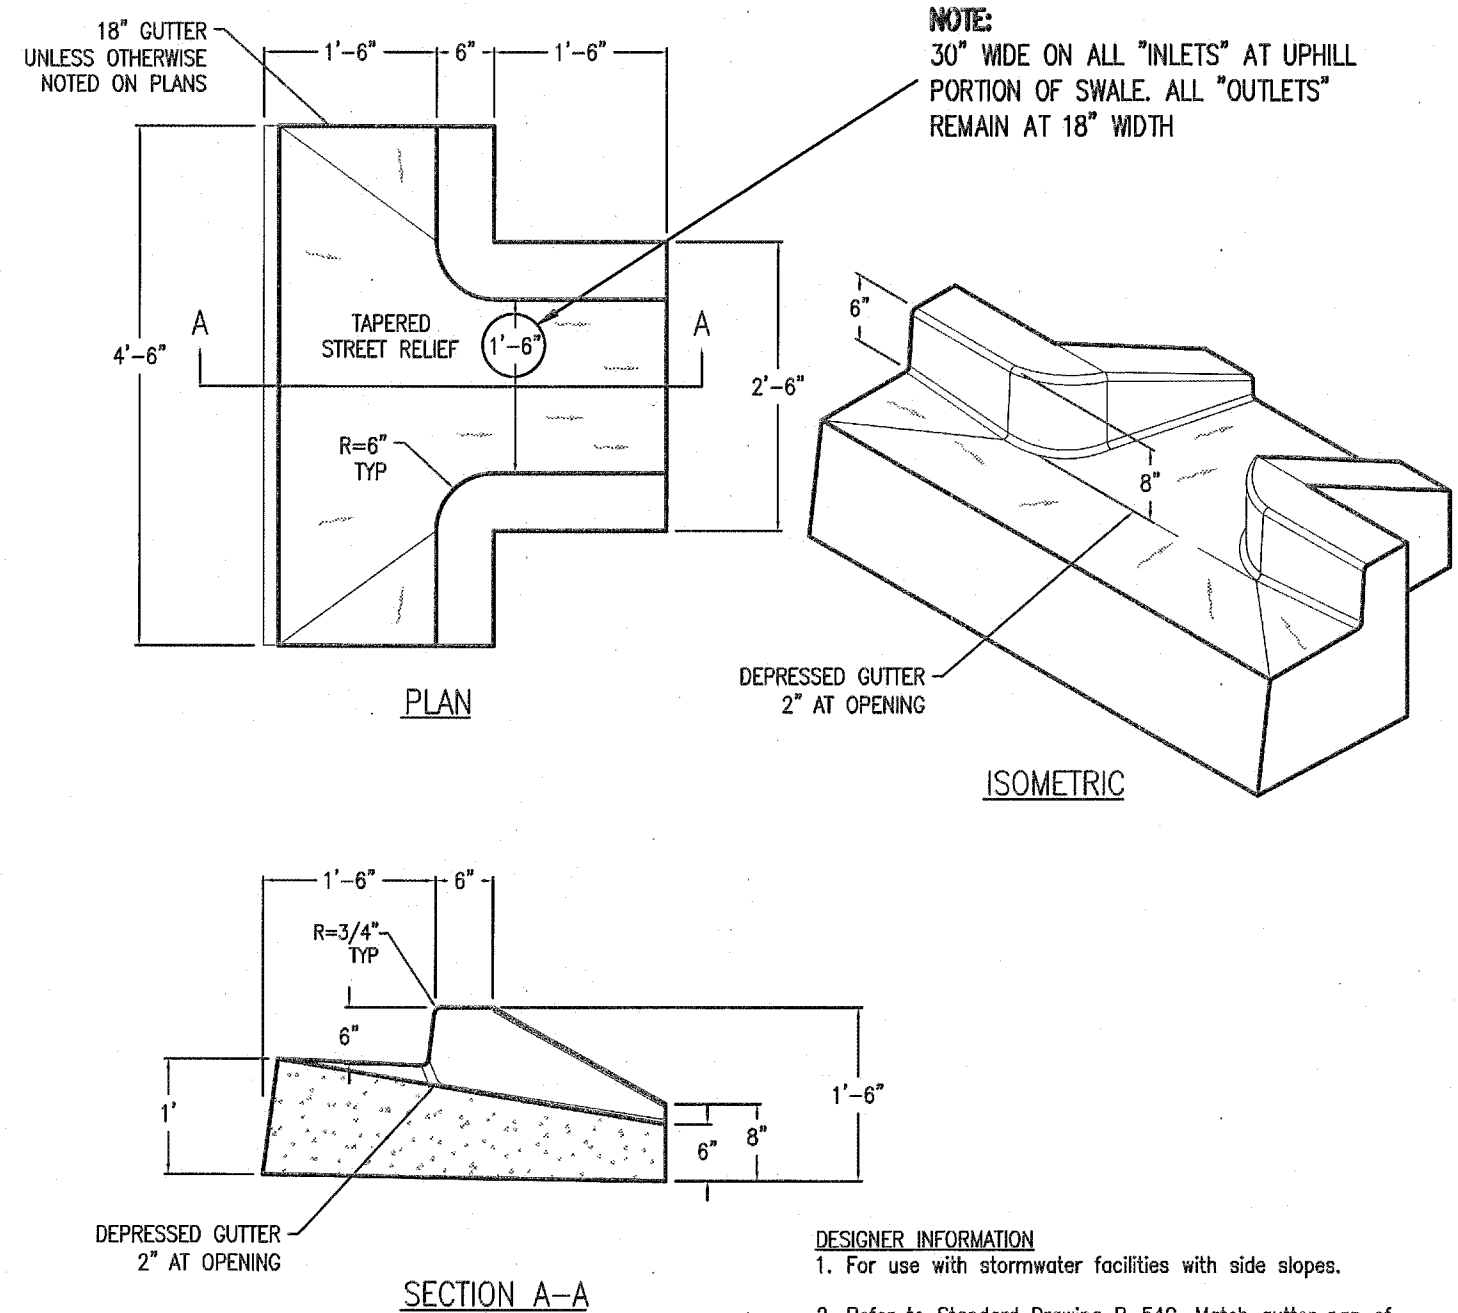


- DESIGNER INFORMATION
- For use with stormwater facilities with side slopes.
  - Refer to Standard Drawing P-540. Match gutter pan of adjacent curb and gutter.
  - Metal Inlet assembly, SW-332, required on high traffic streets.

STORMWATER MANAGEMENT MANUAL TYPICAL DETAILS

- Green Streets -  
Concrete Inlet with Wingwalls  
Curb Inlets

NUMBER SW-330

Bureau of Environmental Services

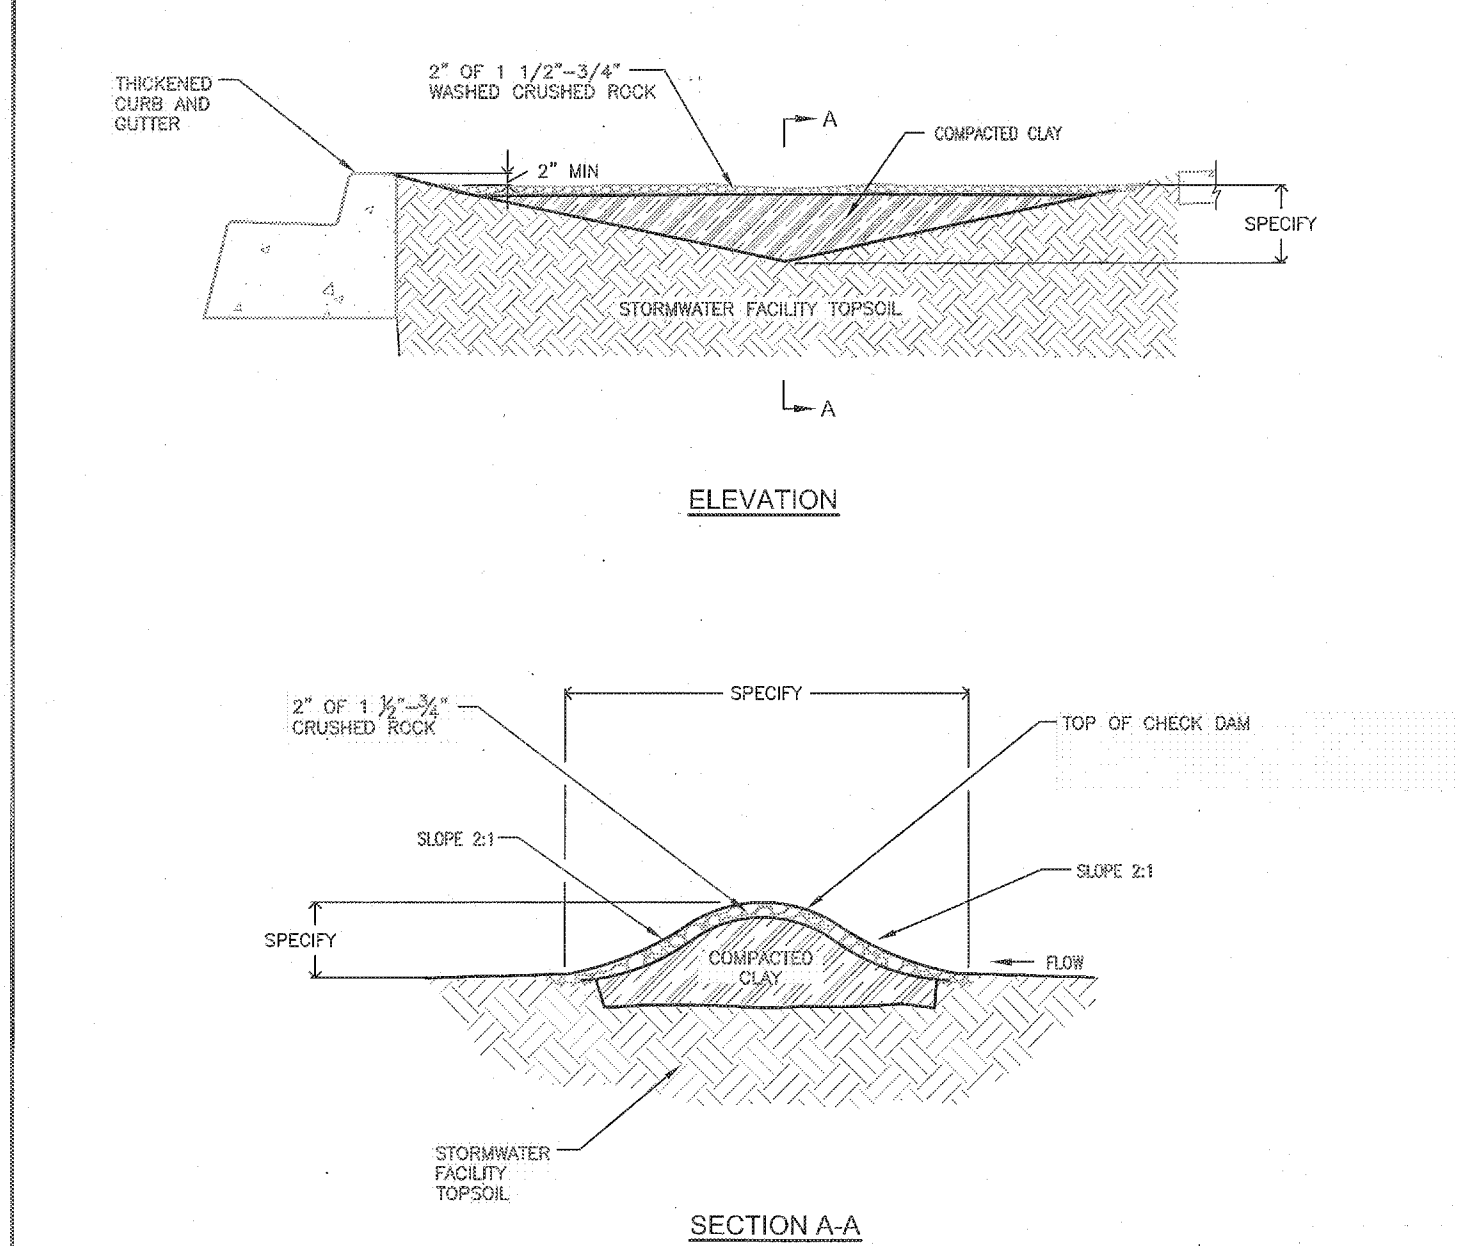


- DESIGNER INFORMATION
- Rock check dam for use in swales and curb extensions with side slopes.
  - Specify check dam elevation and width.
  - Provide stationing and/or dimensioning for check dams.
- CONSTRUCTION NOTES
- Hand tamp topsoil directly under check dam.
  - Key clay core into stormwater facility topsoil.

STORMWATER MANAGEMENT MANUAL TYPICAL DETAILS


- 2011 GREEN STREETS -  
Rock Check Dam for Swales  
Check Dams

NUMBER SW-340


City of Portland

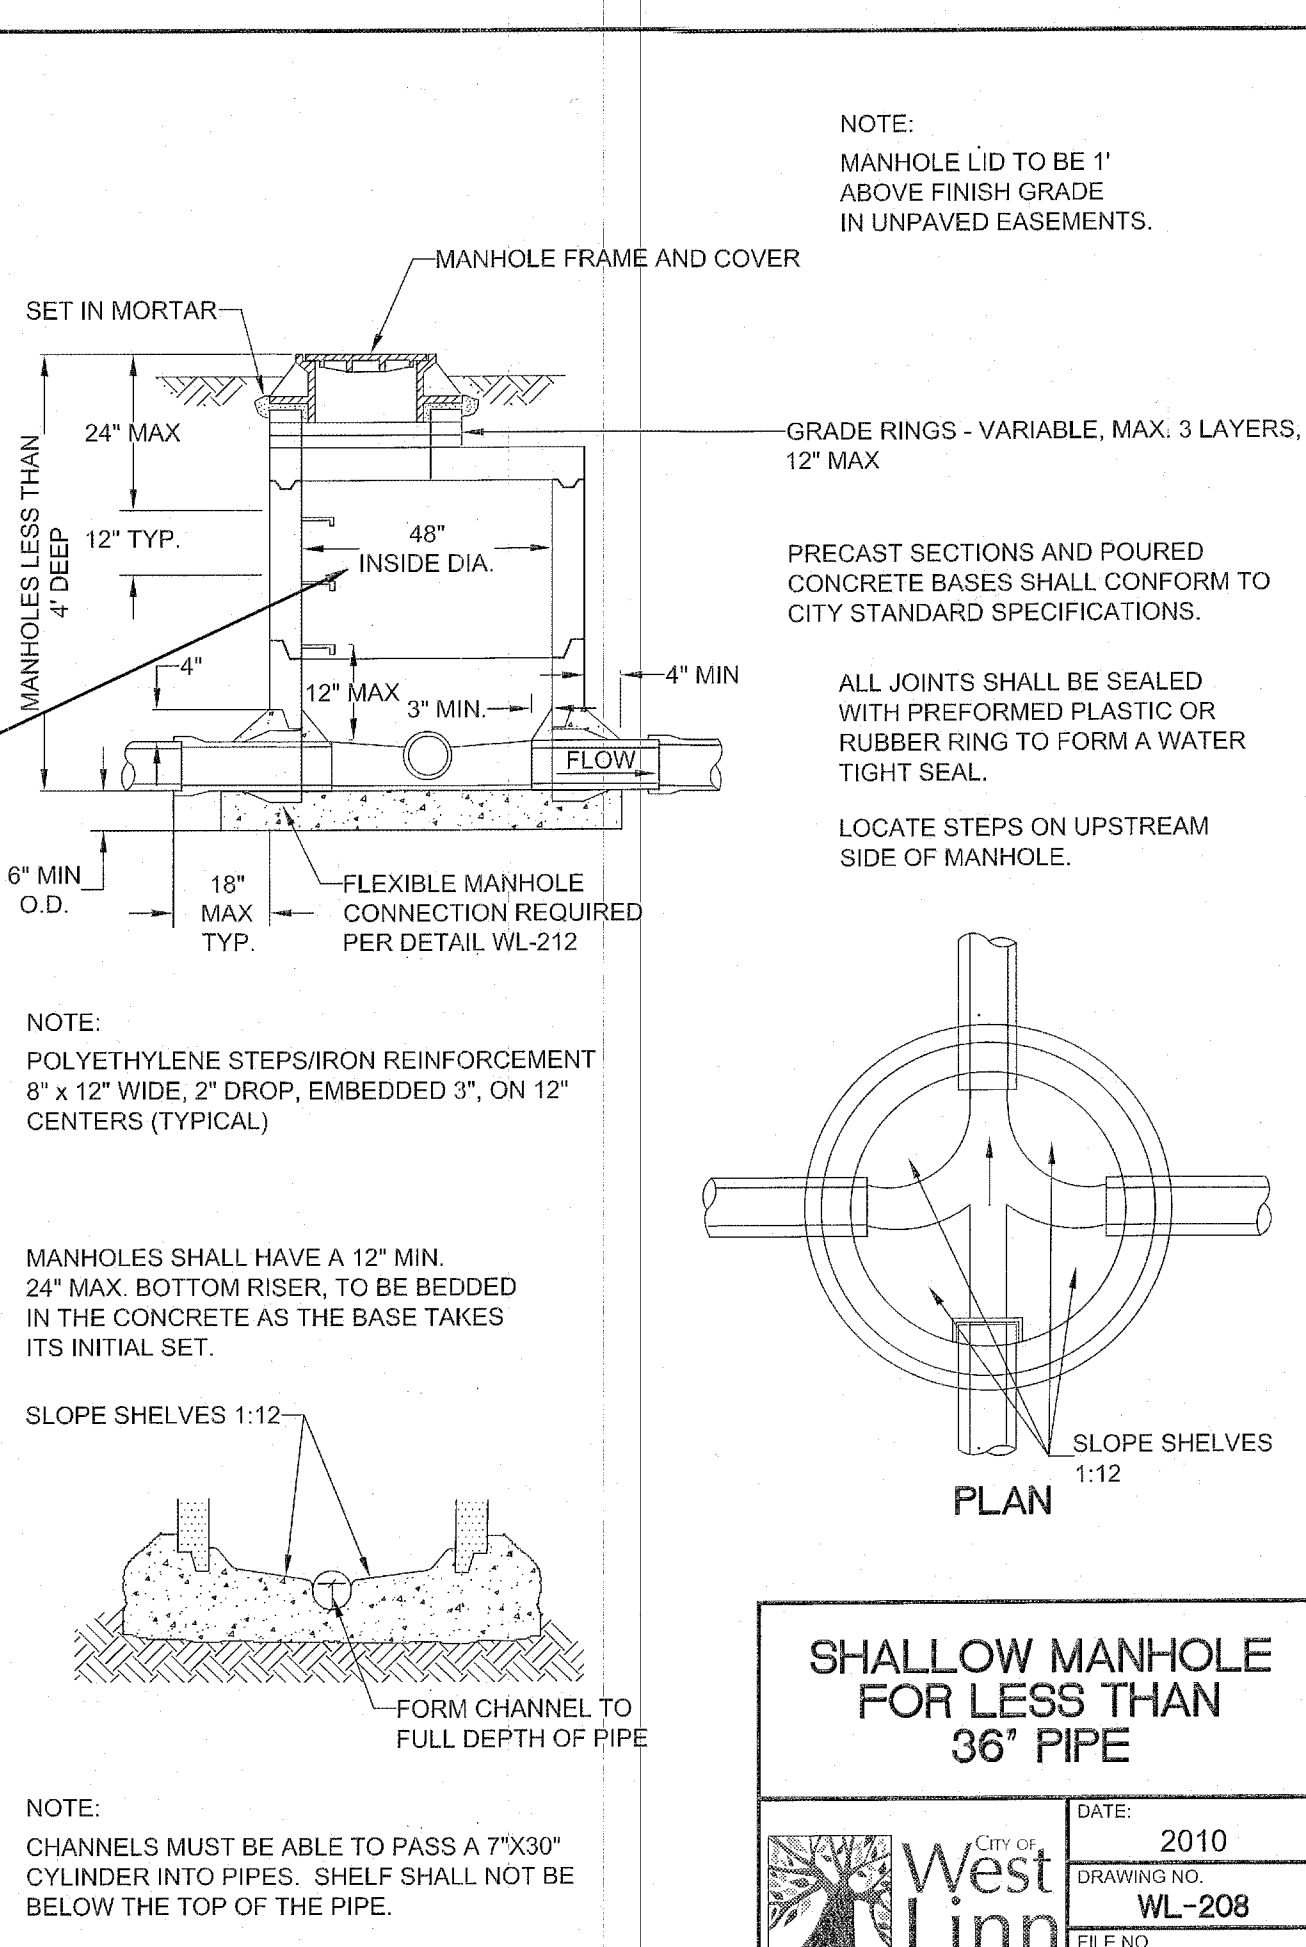

- NOTE:
- CHANNELS MUST BE ABLE TO PASS A 7"x30" CYLINDER INTO PIPES. SHELF SHALL NOT BE BELOW THE TOP OF THE PIPE.

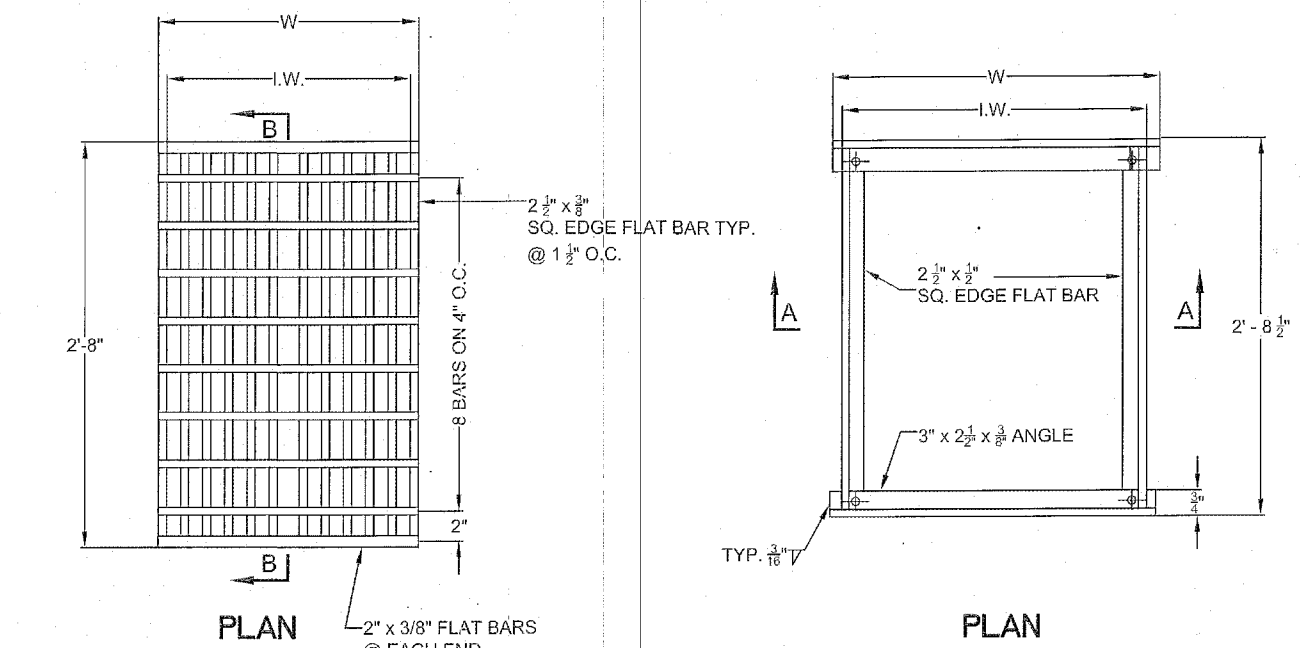

TYPE	W	LW
STANDARD	1'-8"	1'-8 1/4"

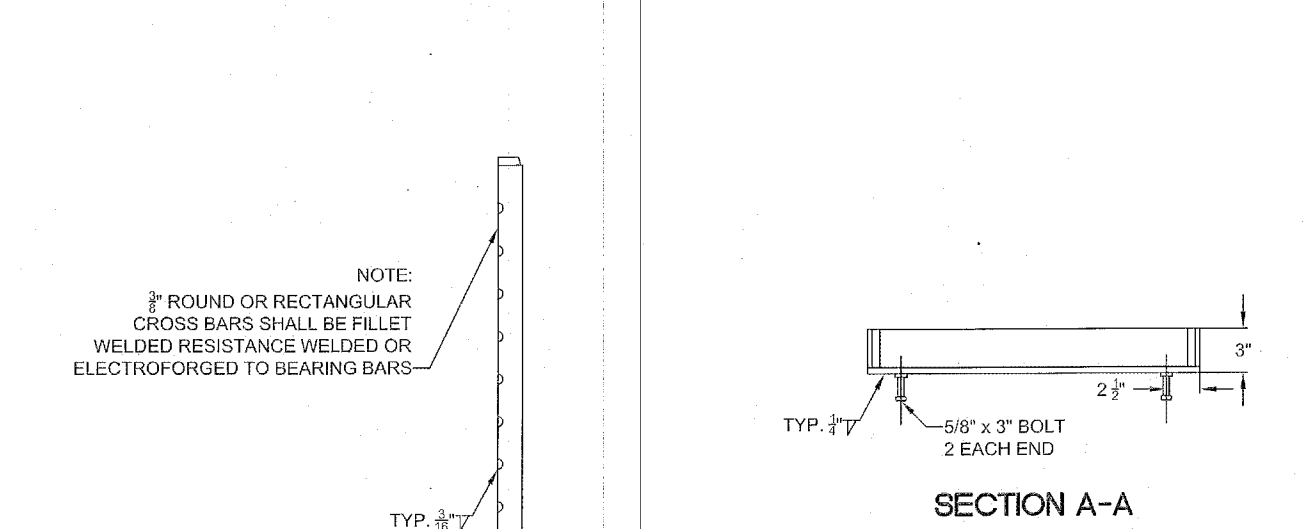

FRAME AND GRATE  
FOR GUTTER AND CURB INLET

DATE: 2010  
DRAWING NO. WL-602B  
FILE NO.

City of West Linn

AKS ENGINEERING AND FORESTRY, LLC  
12865 SW HERMAN RD  
SUITE 100  
TUALATIN, OR 97062  
PHONE: 503.363.0151  
FAX: 503.363.0152  
WWW.AKS-ENG.COM

RENAISSANCE  
AT WILLAMETTE  
AS-BUILTS

WEST LINN  
TAX LOT 020

OREGON  
CLACKAMAS COUNTY ASSESSOR'S TAMAP JSTED008

PLANNING · SURVEYING  
ENGINEERING · LANDSCAPE ARCHITECTURE

PUBLIC STORM  
SEWER DETAILS

DESIGNED BY: DCN  
DRAWN BY: JDR  
CHECKED BY: MBH  
SCALE: AS NOTED  
DATE: 2/9/2015

REGISTERED PROFESSIONAL  
ENGINEER  
58542PE  
OREGON  
JAN 9, 2010  
MONTGOMERY B. HULES

RENEWAL DATE: 6/30/15

REVISIONS

JOB NUMBER  
3745

SHEET  
C201



WEST LINN  
MAY 10 1920

DESIGNED BY:	DCN
DRAWN BY:	JDR
CHECKED BY:	MBH
SCALE:	AS NOTED
DATE: 2/9/2015	




SHEET

AKS DRAWING FILE: 3745 C200 STORM SEWER PLAN.DWG | LAYOUT: C202




**AS-BUILT DISCLAIMER:**  
AS-BUILT INFORMATION IS BASED ON A COMBINATION OF FIELD SURVEY INFORMATION, INSPECTION INFORMATION, AND CONTRACTOR-PROVIDED INFORMATION. THE ENGINEER ONLY CERTIFIES INFORMATION WHICH COULD BE FIELD-VERIFIED AFTER CONSTRUCTION WAS COMPLETED. AS-BUILTS ARE ONLY FOR PUBLIC IMPROVEMENTS WITHIN PUBLIC RIGHT-OF-WAYS OR EASEMENTS.

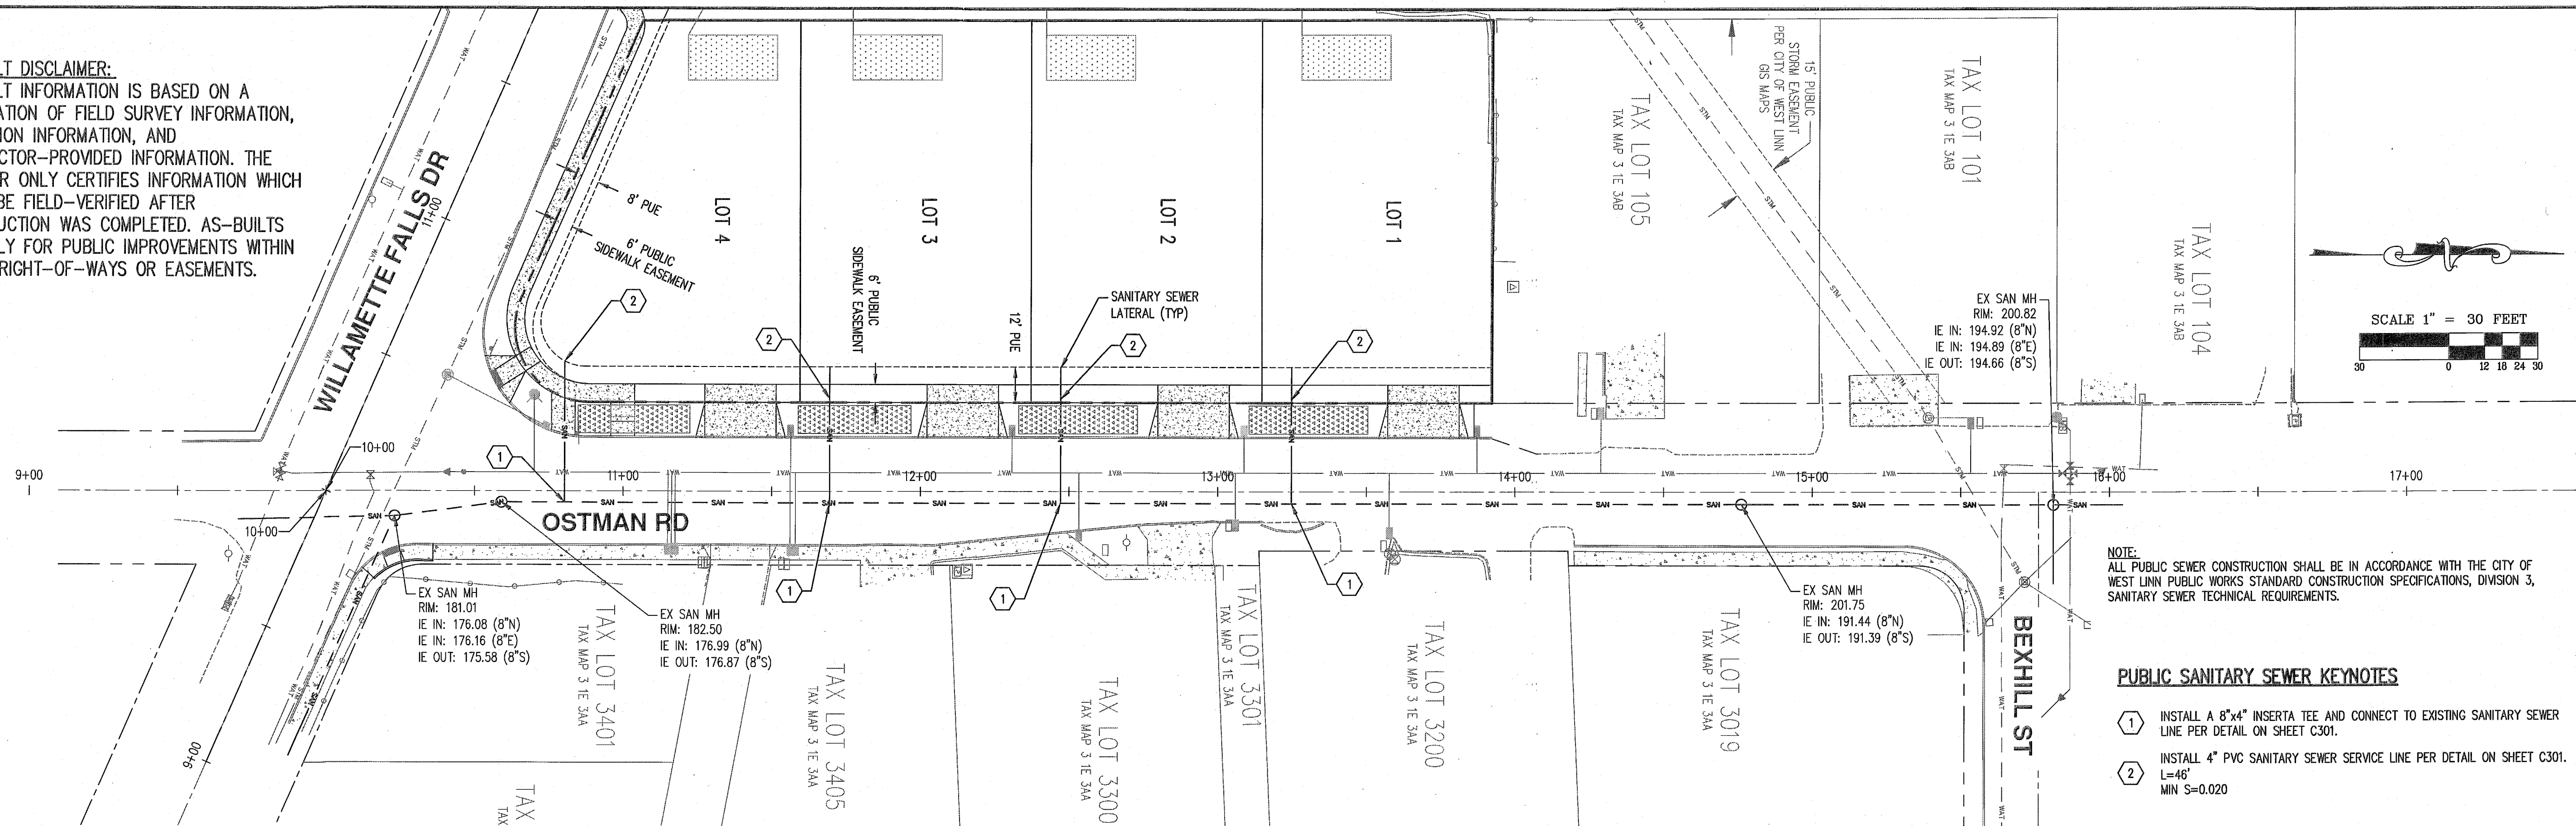

**PUBLIC SANITARY SEWER KEYNOTES**

1. INSTALL A 8"x4" INSERTA TEE AND CONNECT TO EXISTING SANITARY SEWER LINE PER DETAIL ON SHEET C301.
2. INSTALL 4" PVC SANITARY SEWER SERVICE LINE PER DETAIL ON SHEET C301.  
L=46'  
MIN S=0.020

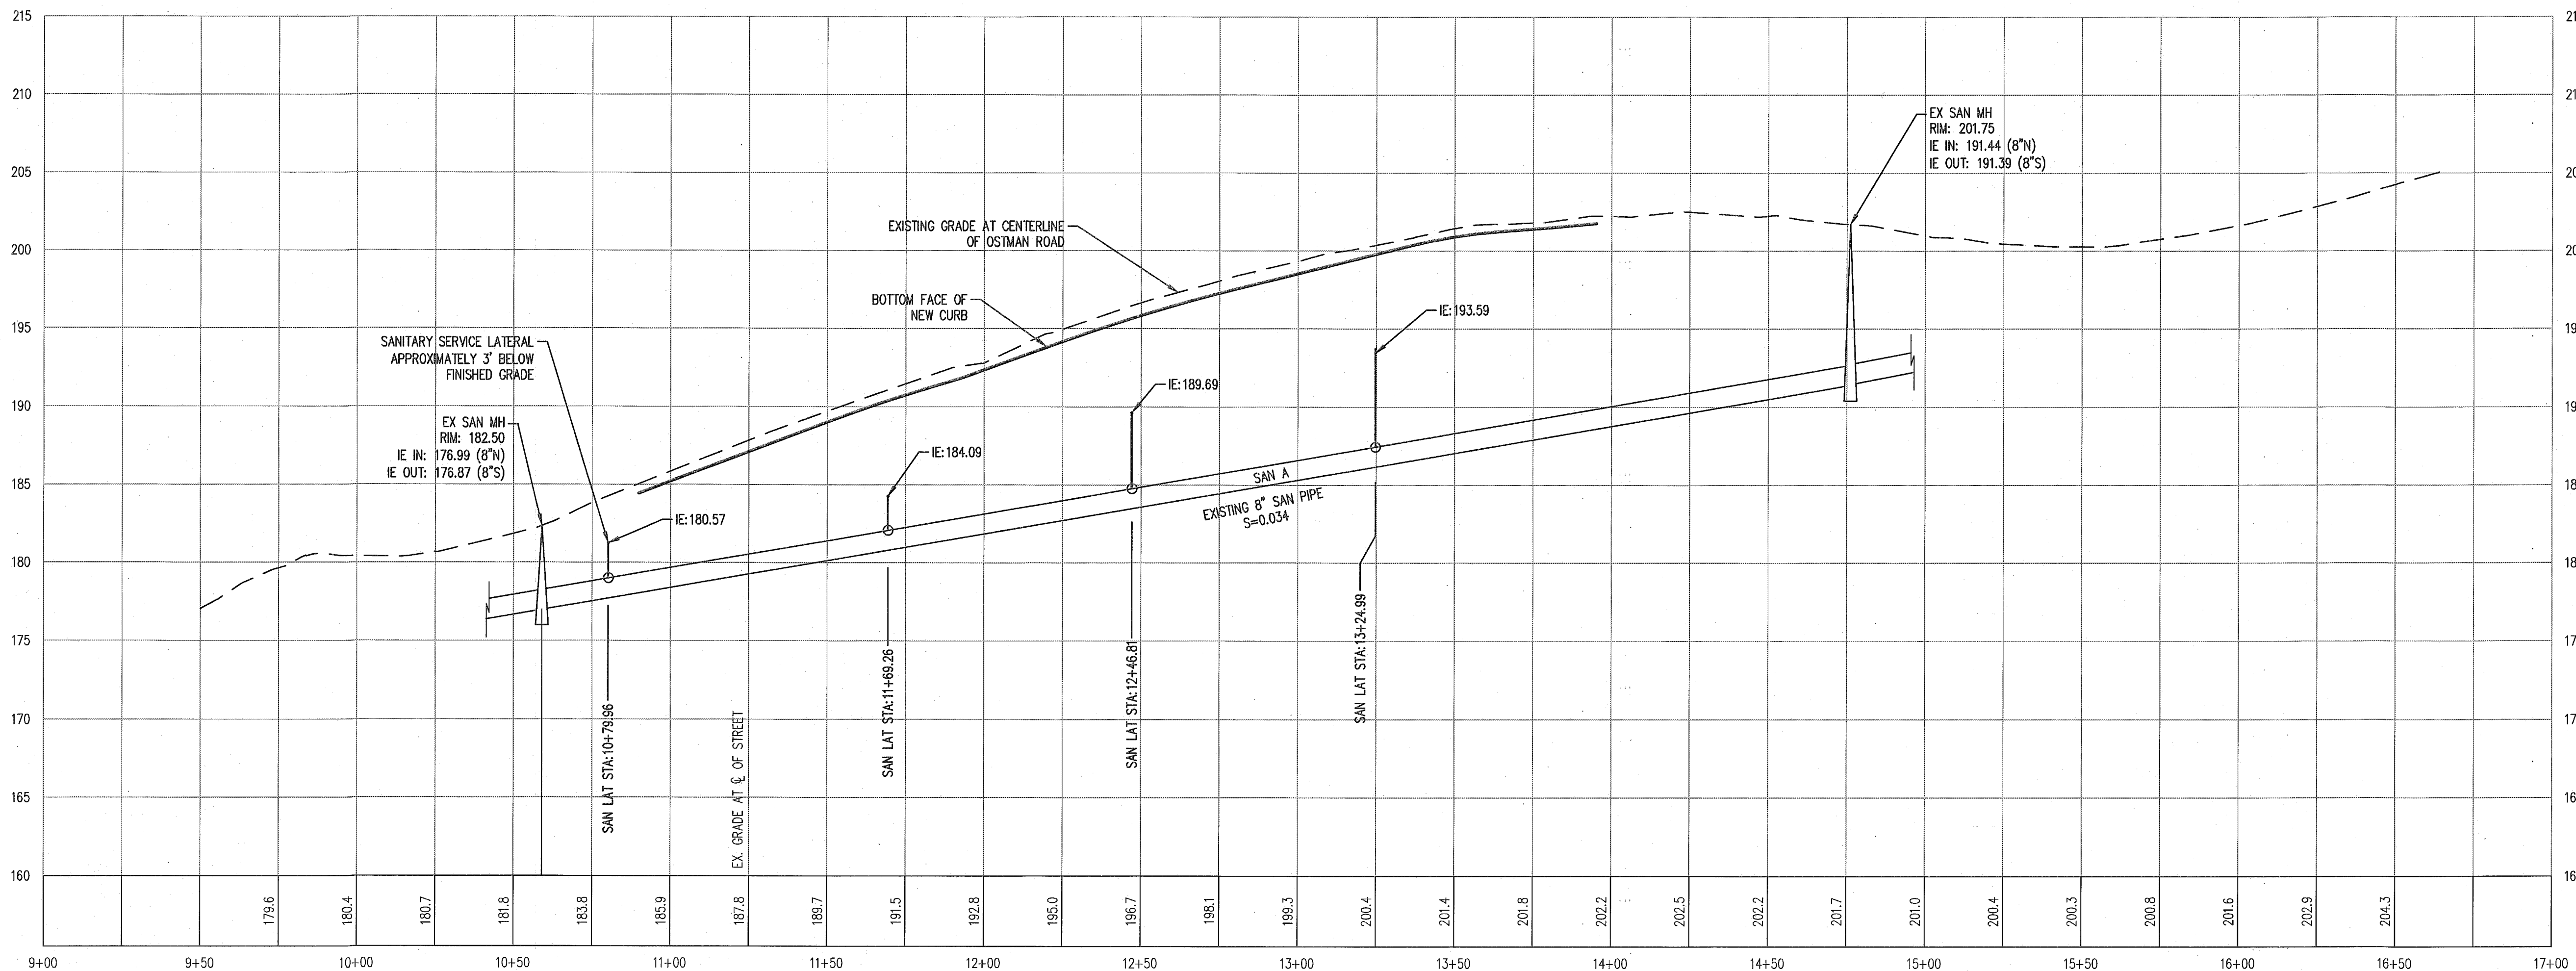

**SAN A \***  
HOR: 1" = 30'  
VERT: 1" = 6'

\* STATIONING BASED ON OSTRMAN ROAD CENTERLINE

**AKS**  
AKS ENGINEERING AND FORESTRY, LLC  
12585 SW HERMAN RD  
SUITE 100, PORTLAND, OR 97262  
PHONE: 503.553.6151  
FAX: 503.553.6152  
WWW.AKS-ENG.COM



**RENAISSANCE AT WILLAMETTE AS-BUILTS**  
WEST LINN OREGON  
CLACKAMAS COUNTY ASSESSOR'S TAXMAP 351003AB  
TAX LOT 020

**PUBLIC SANITARY SEWER PLAN AND PROFILE - OSTRMAN ROAD**

DESIGNED BY: DCN  
DRAWN BY: JDR  
CHECKED BY: MBH  
SCALE: AS NOTED  
DATE: 2/9/2015  
REGISTERED PROFESSIONAL ENGINEER  
58542PE  
OREGON  
JULY 9, 2001  
RENEWAL DATE: 6/30/15  
REVISIONS  
JOB NUMBER 3745  
SHEET C300



**AS-BUILT DISCLAIMER:**  
AS-BUILT INFORMATION IS BASED ON A COMBINATION OF FIELD SURVEY INFORMATION, INSPECTION INFORMATION, AND CONTRACTOR-PROVIDED INFORMATION. THE ENGINEER ONLY CERTIFIES INFORMATION WHICH COULD BE FIELD-VERIFIED AFTER CONSTRUCTION WAS COMPLETED. AS-BUILTS ARE ONLY FOR PUBLIC IMPROVEMENTS WITHIN PUBLIC RIGHT-OF-WAYS OR EASEMENTS.

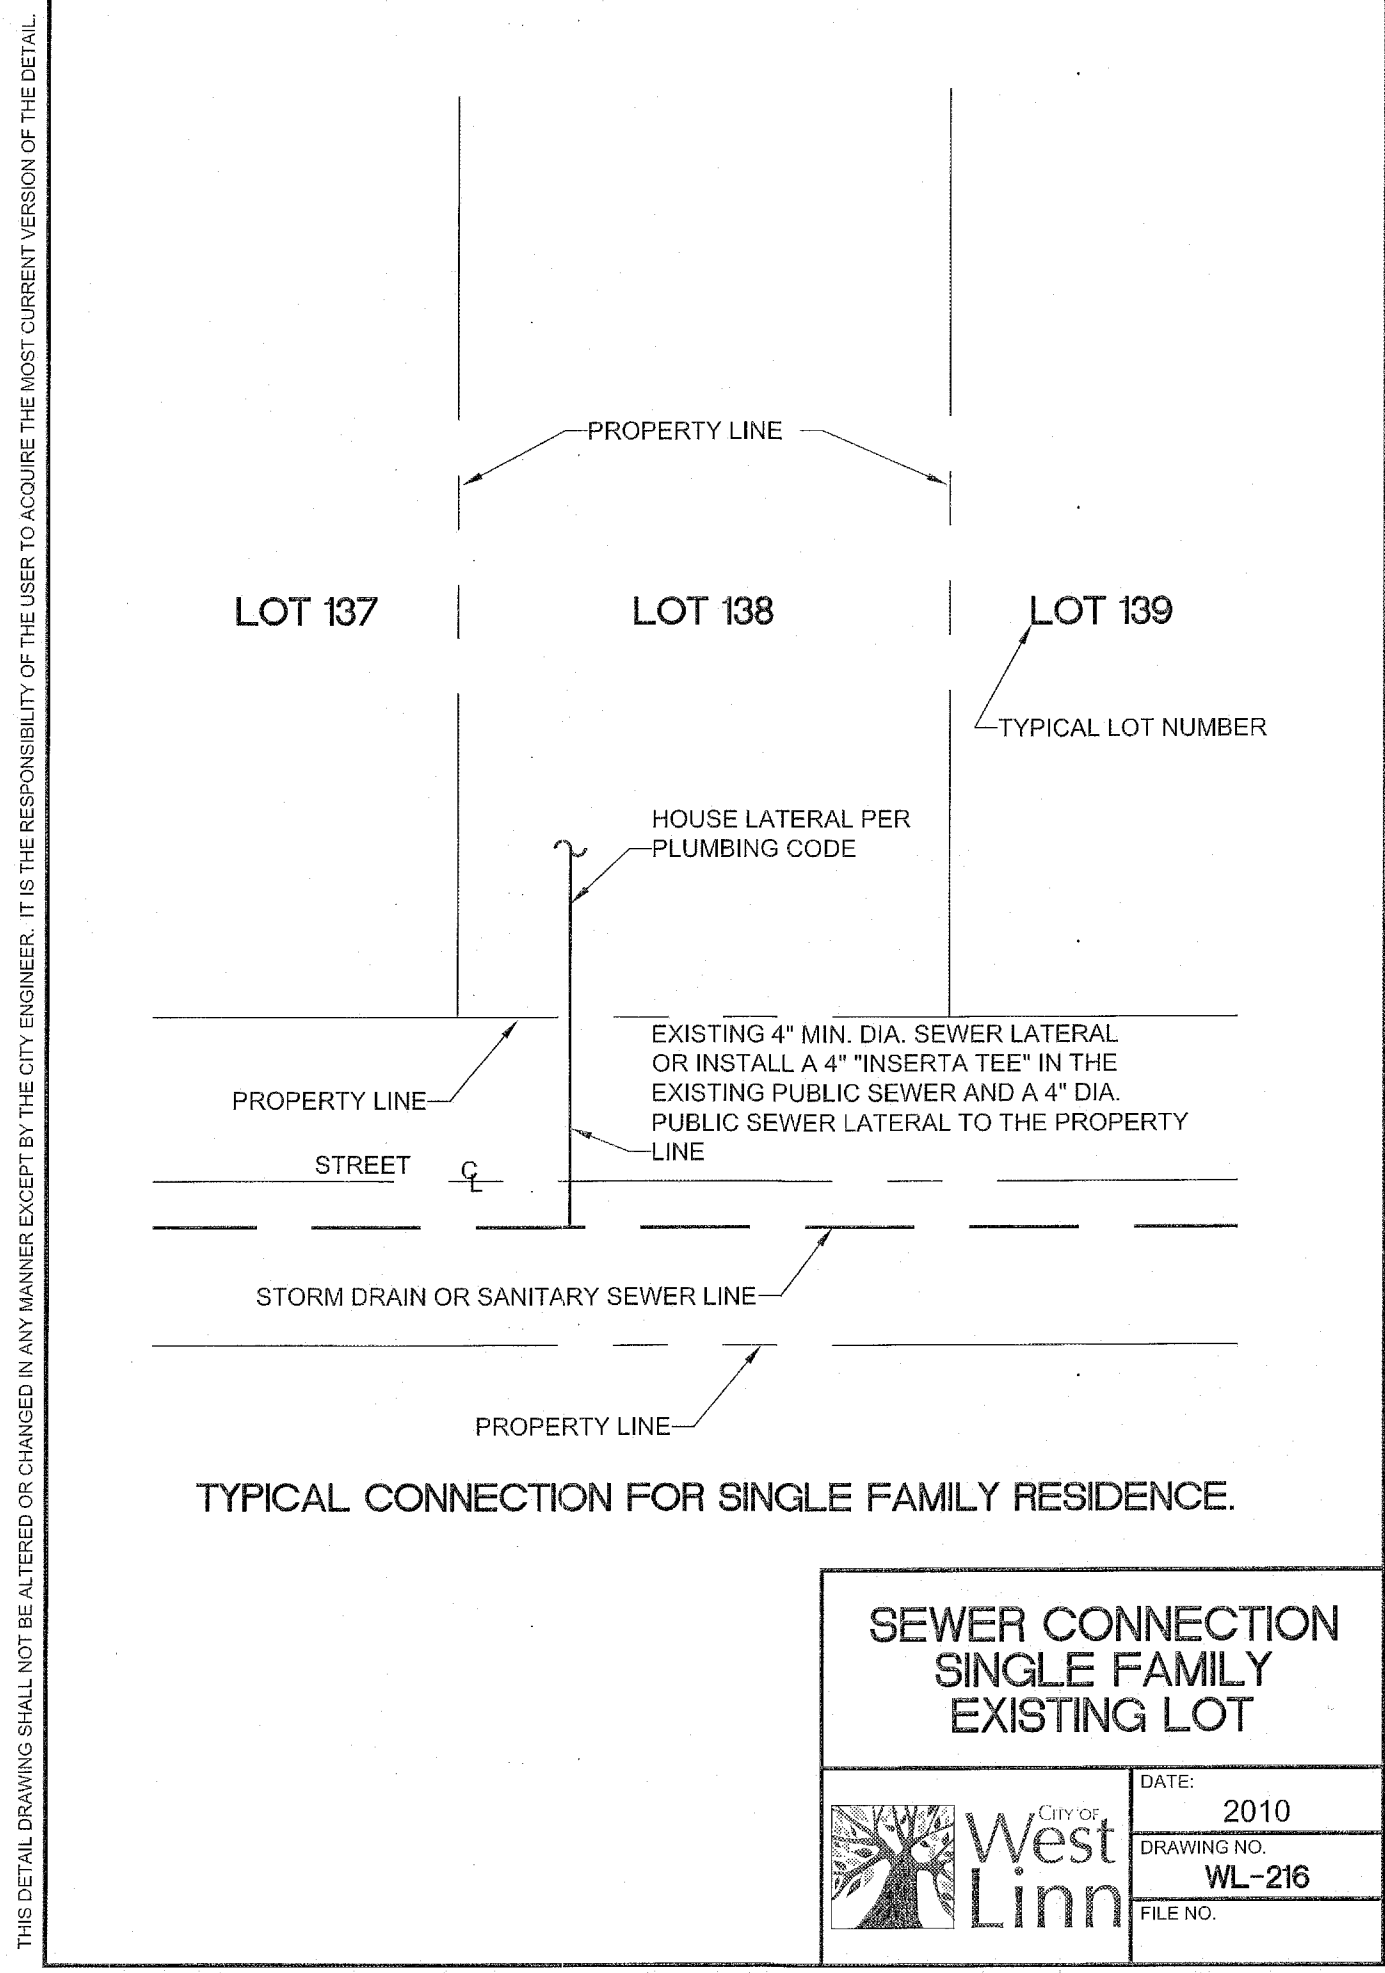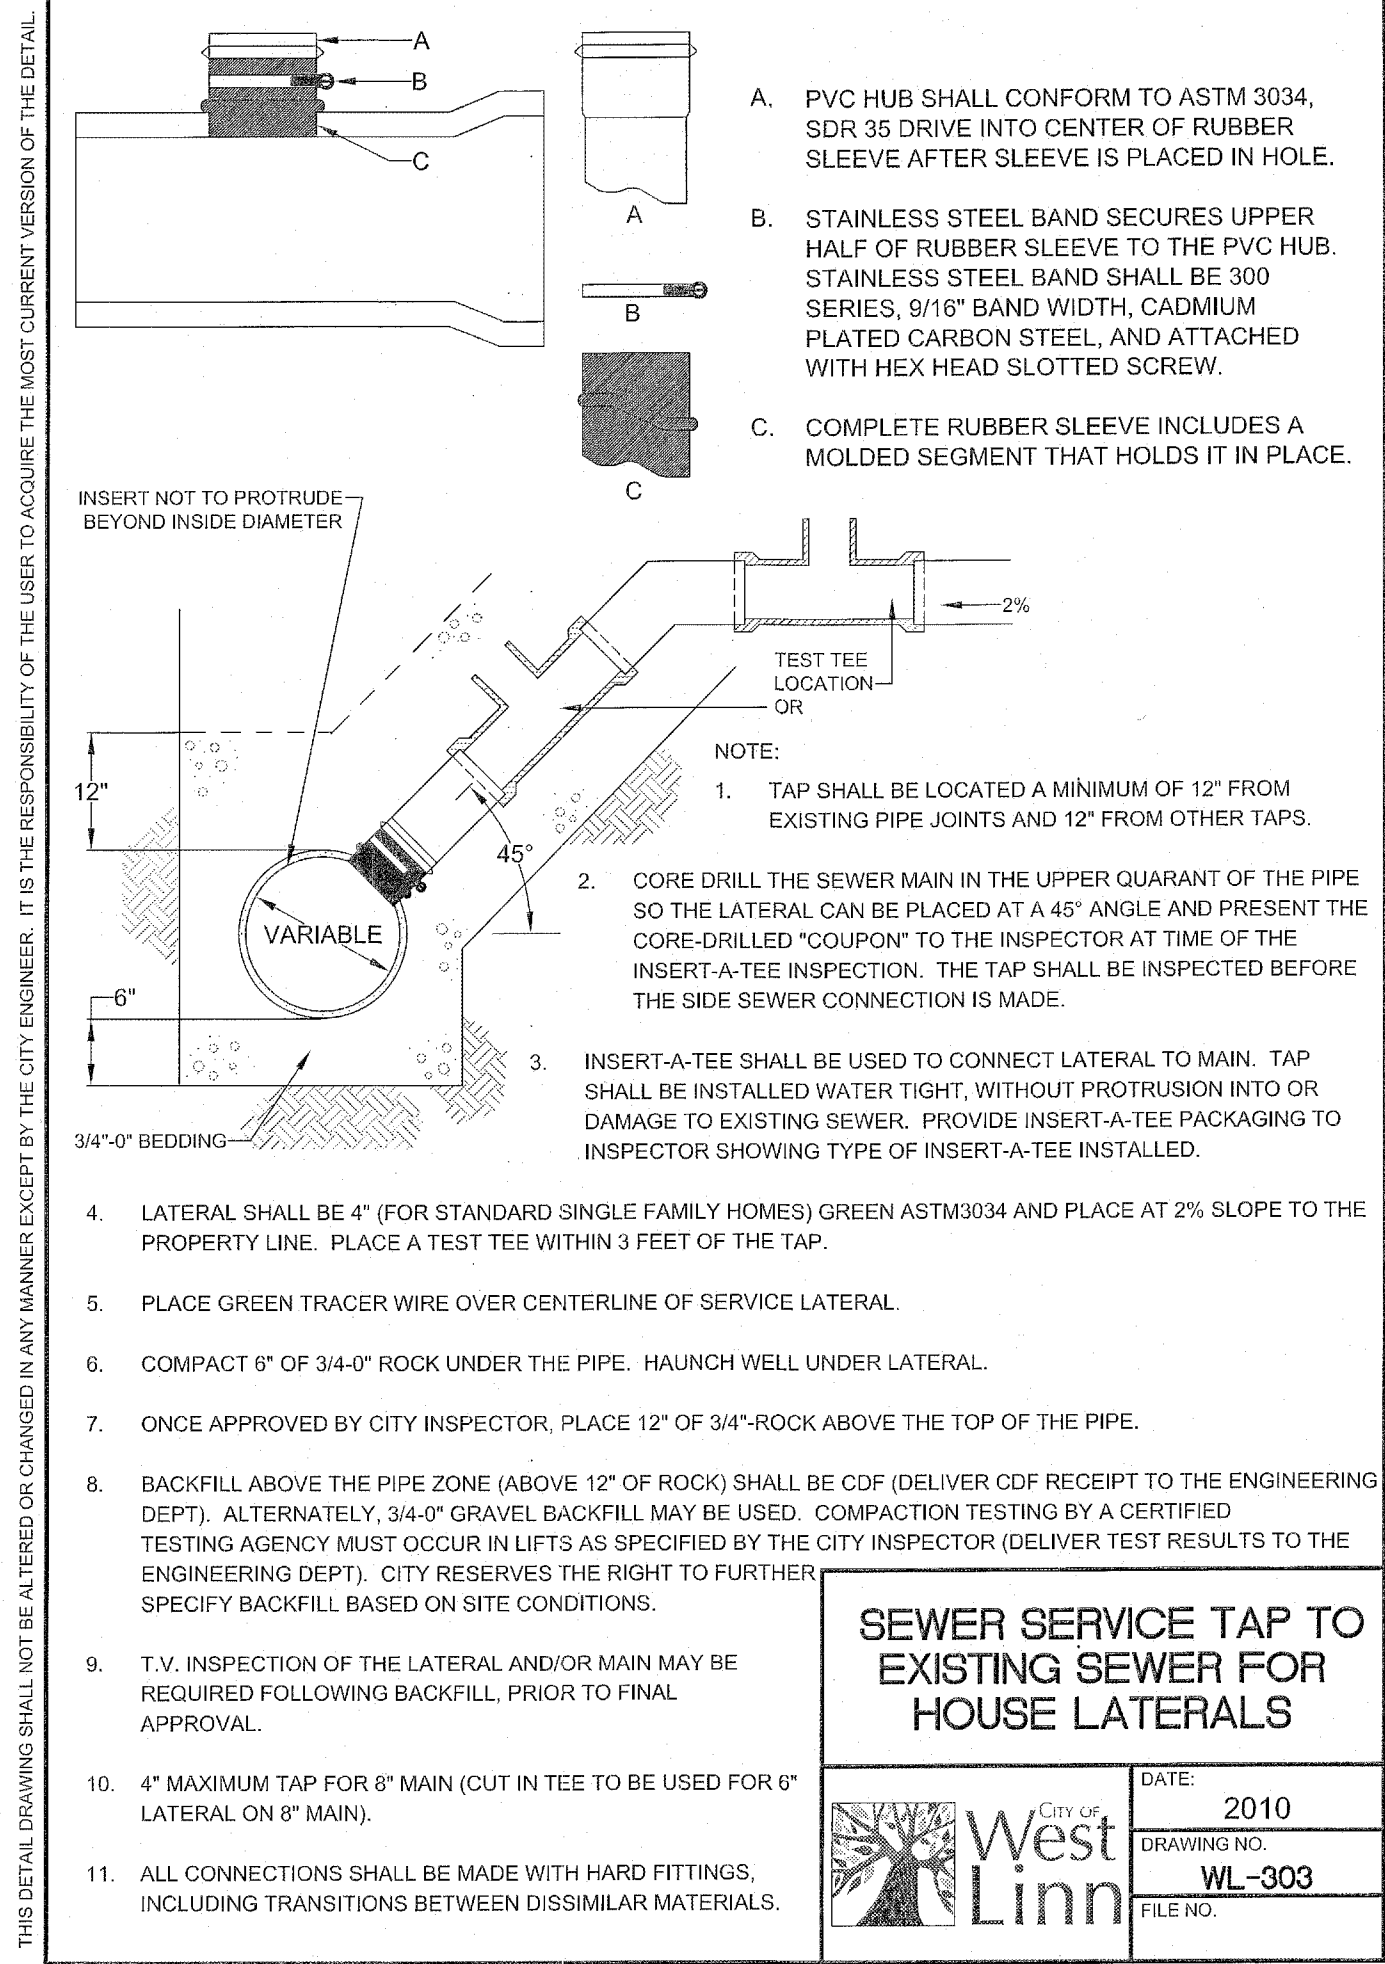

AKS

AKS ENGINEERING AND FORESTRY, LLC  
12985 SW HERMAN RD  
SUITE 100  
DAVATON, OR 97062  
PHONE: 503.663.6151  
FAX: 503.663.6152  
www.aks-eng.com

ENGINEERING • PLANNING • SURVEYING  
FORESTRY • LANDSCAPE ARCHITECTURE

RENAISSANCE  
AT WILLAMETTE  
AS-BUILTS

WEST LINN  
TAX LOT 0200

OREGON  
CLACKAMAS COUNTY ASSESSOR'S TAXMAP - S20CAB

DESIGNED BY: DCN  
DRAWN BY: JDR  
CHECKED BY: MBH  
SCALE: AS NOTED  
DATE: 2/9/2015


REGISTERED PROFESSIONAL  
ENGINEER  
88542PE  
OREGON  
MONTGOMERY B. HURLEY  
MAY 9, 2005  
RENEWAL DATE: 6/30/15

REVISIONS

JOB NUMBER  
3745  
SHEET  
C301



AKS DRAWING FILE: 3745 C400 WATER PLANDWG | LAYOUT: C400

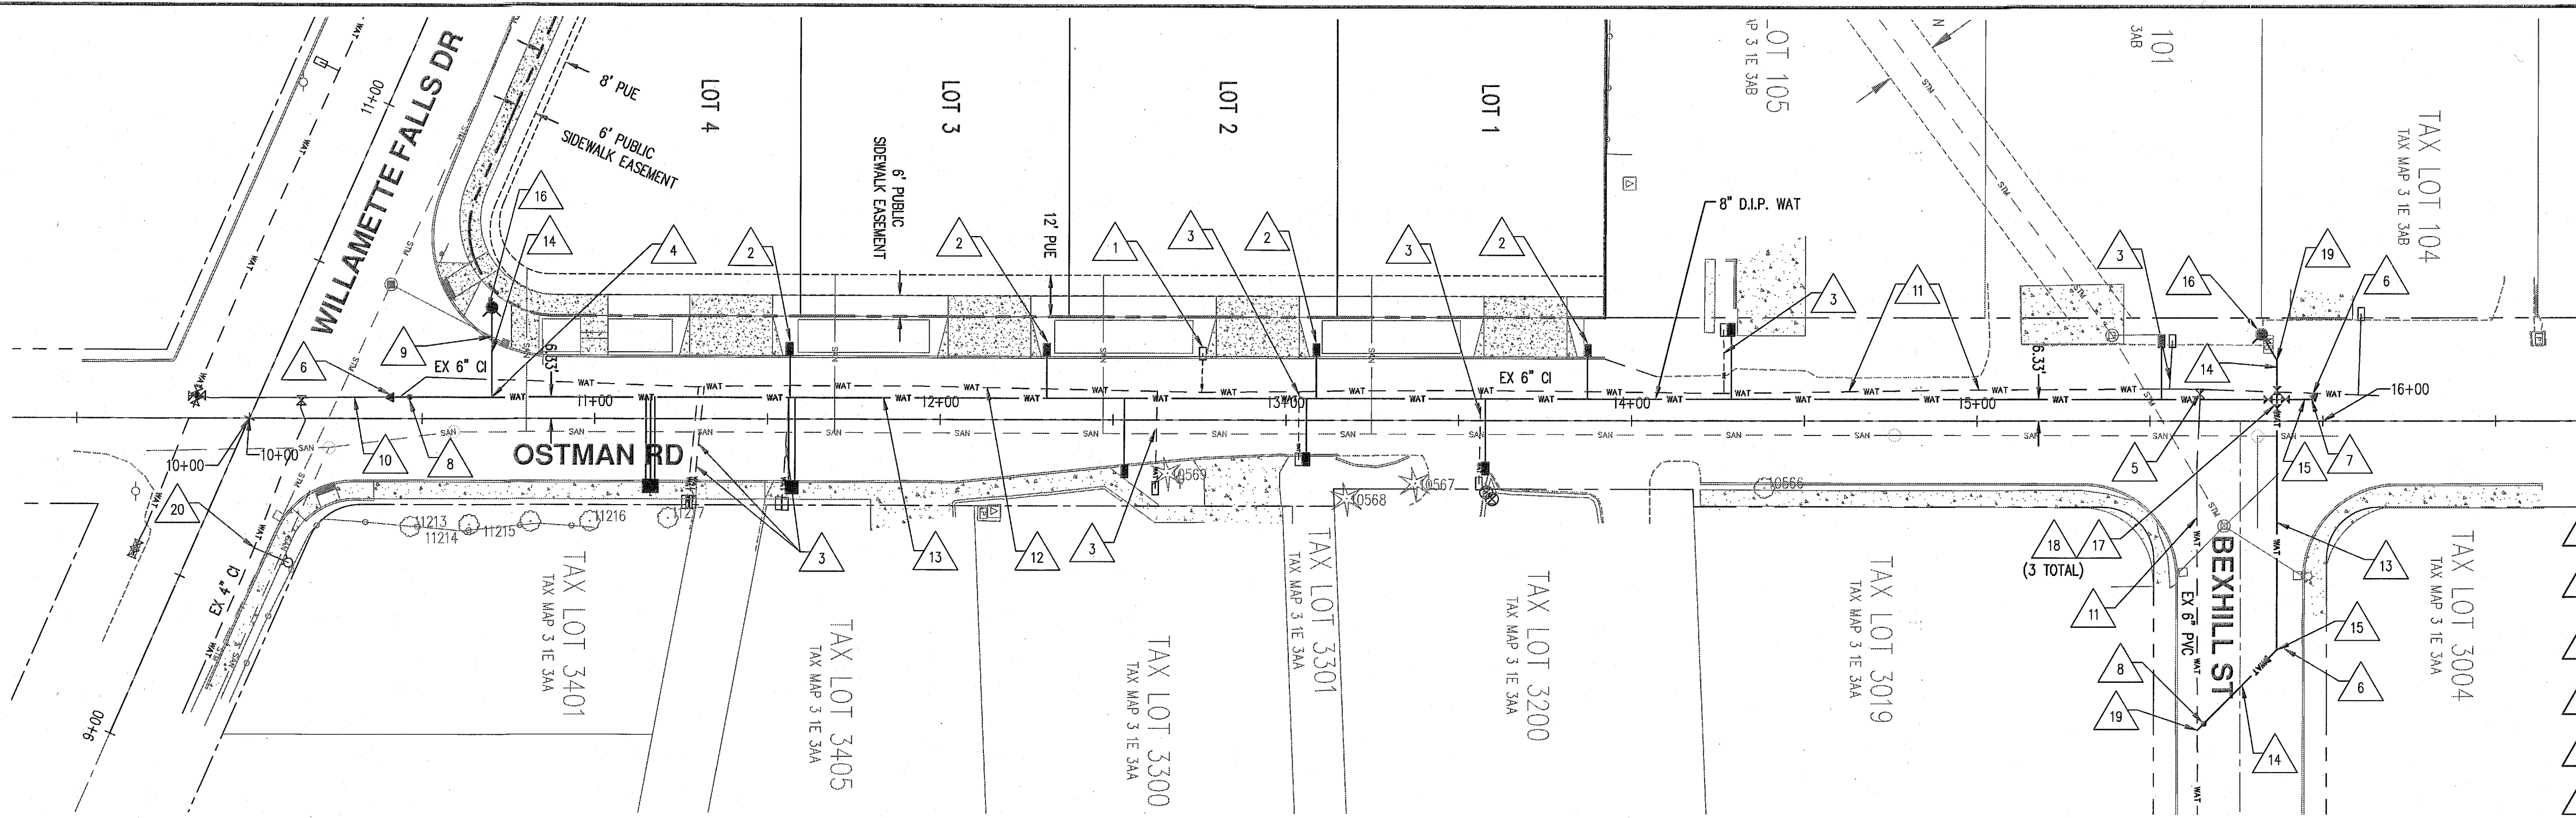

### WATER KEYED NOTES


1. ABANDON EXISTING WATER SERVICE. WATER METER TO BE RETURNED TO THE CITY.
2. INSTALL 1" SINGLE WATER SERVICE (TYP). SEE DETAIL ON SHEET C401 FOR CONSTRUCTION INFORMATION.
3. ABANDON EXISTING WATER SERVICE LINES. CONNECT TO NEW D.I.P. WATER MAIN, SEE DETAILS ON SHEET C401. INSTALL NEW 1" SINGLE WATER SERVICE LINES, SEE DETAIL ON SHEET C401 FOR CONSTRUCTION INFORMATION.
4. INSTALL 8"x8"x6" TEE FLG.xFLG.xFLG. WITH THRUST BLOCKING PER DETAIL ON SHEET C401.
5. REMOVE EXISTING 6" VALVE BOX AND REPLACE WITH CDF.
6. INSTALL 8"x6" M.J.xM.J. REDUCER. THRUST BLOCKING PER DETAIL ON SHEET C401.
7. INSTALL 8"x6" M.J. 45° BEND. THRUST BLOCKING, SEE DETAIL ON SHEET C401. VERIFY PIPE JOINT CONNECTION REQUIREMENT WITH THE CITY.
8. INSTALL TEMPORARY BLOWOFF, SEE DETAIL ON SHEET C401.
9. INSTALL 6"x6" M.J. 45° BENDS UNDER EXISTING STORM PIPE (4 EACH). THRUST BLOCKING PER DETAIL ON SHEET C401.
10. EX 6" WATER LINE (TO REMAIN).
11. ABANDON PIPE IN PLACE. FILL WATER LINE ENDS WITH CONCRETE.
12. EXISTING 6" MAIN LINE TO BE ABANDONED IN-PLACE AFTER ALL SERVICE CONNECTIONS HAVE BEEN MADE TO THE NEW WATER MAIN AND TESTING AND DISINFECTION ARE COMPLETED AND APPROVED. PLUG ENDS OF PIPE WITH CONCRETE.
13. INSTALL 8" D.I.P. CL. 52.
14. INSTALL 6" D.I.P. CL. 52.
15. INSTALL 8"x8" M.J. 45° BEND. THRUST BLOCKING SEE DETAIL ON SHEET C401.
16. INSTALL FIRE HYDRANT PER DETAIL ON SHEET C401.
17. INSTALL 8"x8"x8"x6" CROSS FLG.xFLG.xFLG.xFLG. WITH THRUST BLOCKING PER DETAIL ON SHEET C401.
18. INSTALL 8" GATE VALVE M.J. x FLG.
19. INSTALL 6"x6" M.J. 45° BEND. VERIFY PIPE JOINT CONNECTION REQUIREMENT WITH THE CITY. SEE DETAIL ON SHEET C401 FOR THRUST BLOCKING.
20. EXISTING FIRE HYDRANT REMOVED AT MAIN WATER LINE.

### NOTES

1. ALL PUBLIC WATER LINE CONSTRUCTION SHALL BE IN ACCORDANCE WITH THE CITY OF WEST LINN PUBLIC WORKS STANDARD CONSTRUCTION SPECIFICATION DIVISION 4, WATER TECHNICAL REQUIREMENTS.
2. ALL WATER PIPE PRODUCTS BEING REMOVED SHALL BE RETURNED TO THE CITY AS DIRECTED BY THE CITY PROJECT ENGINEER / INSPECTOR.
3. PROVIDE RESTRAIN JOINTS WITH FIELD-LOK GASKET. RESTRAIN LENGTH CALCULATIONS PER PUBLIC WORKS STANDARDS, SECTION 4.0014 USE EBBA AS NEEDED.

### AS-BUILT DISCLAIMER:

AS-BUILT INFORMATION IS BASED ON A COMBINATION OF FIELD SURVEY INFORMATION, INSPECTION INFORMATION, AND CONTRACTOR-PROVIDED INFORMATION. THE ENGINEER ONLY CERTIFIES INFORMATION WHICH COULD BE FIELD-VERIFIED AFTER CONSTRUCTION WAS COMPLETED. AS-BUILTS ARE ONLY FOR PUBLIC IMPROVEMENTS WITHIN PUBLIC RIGHT-OF-WAYS OR EASEMENTS.

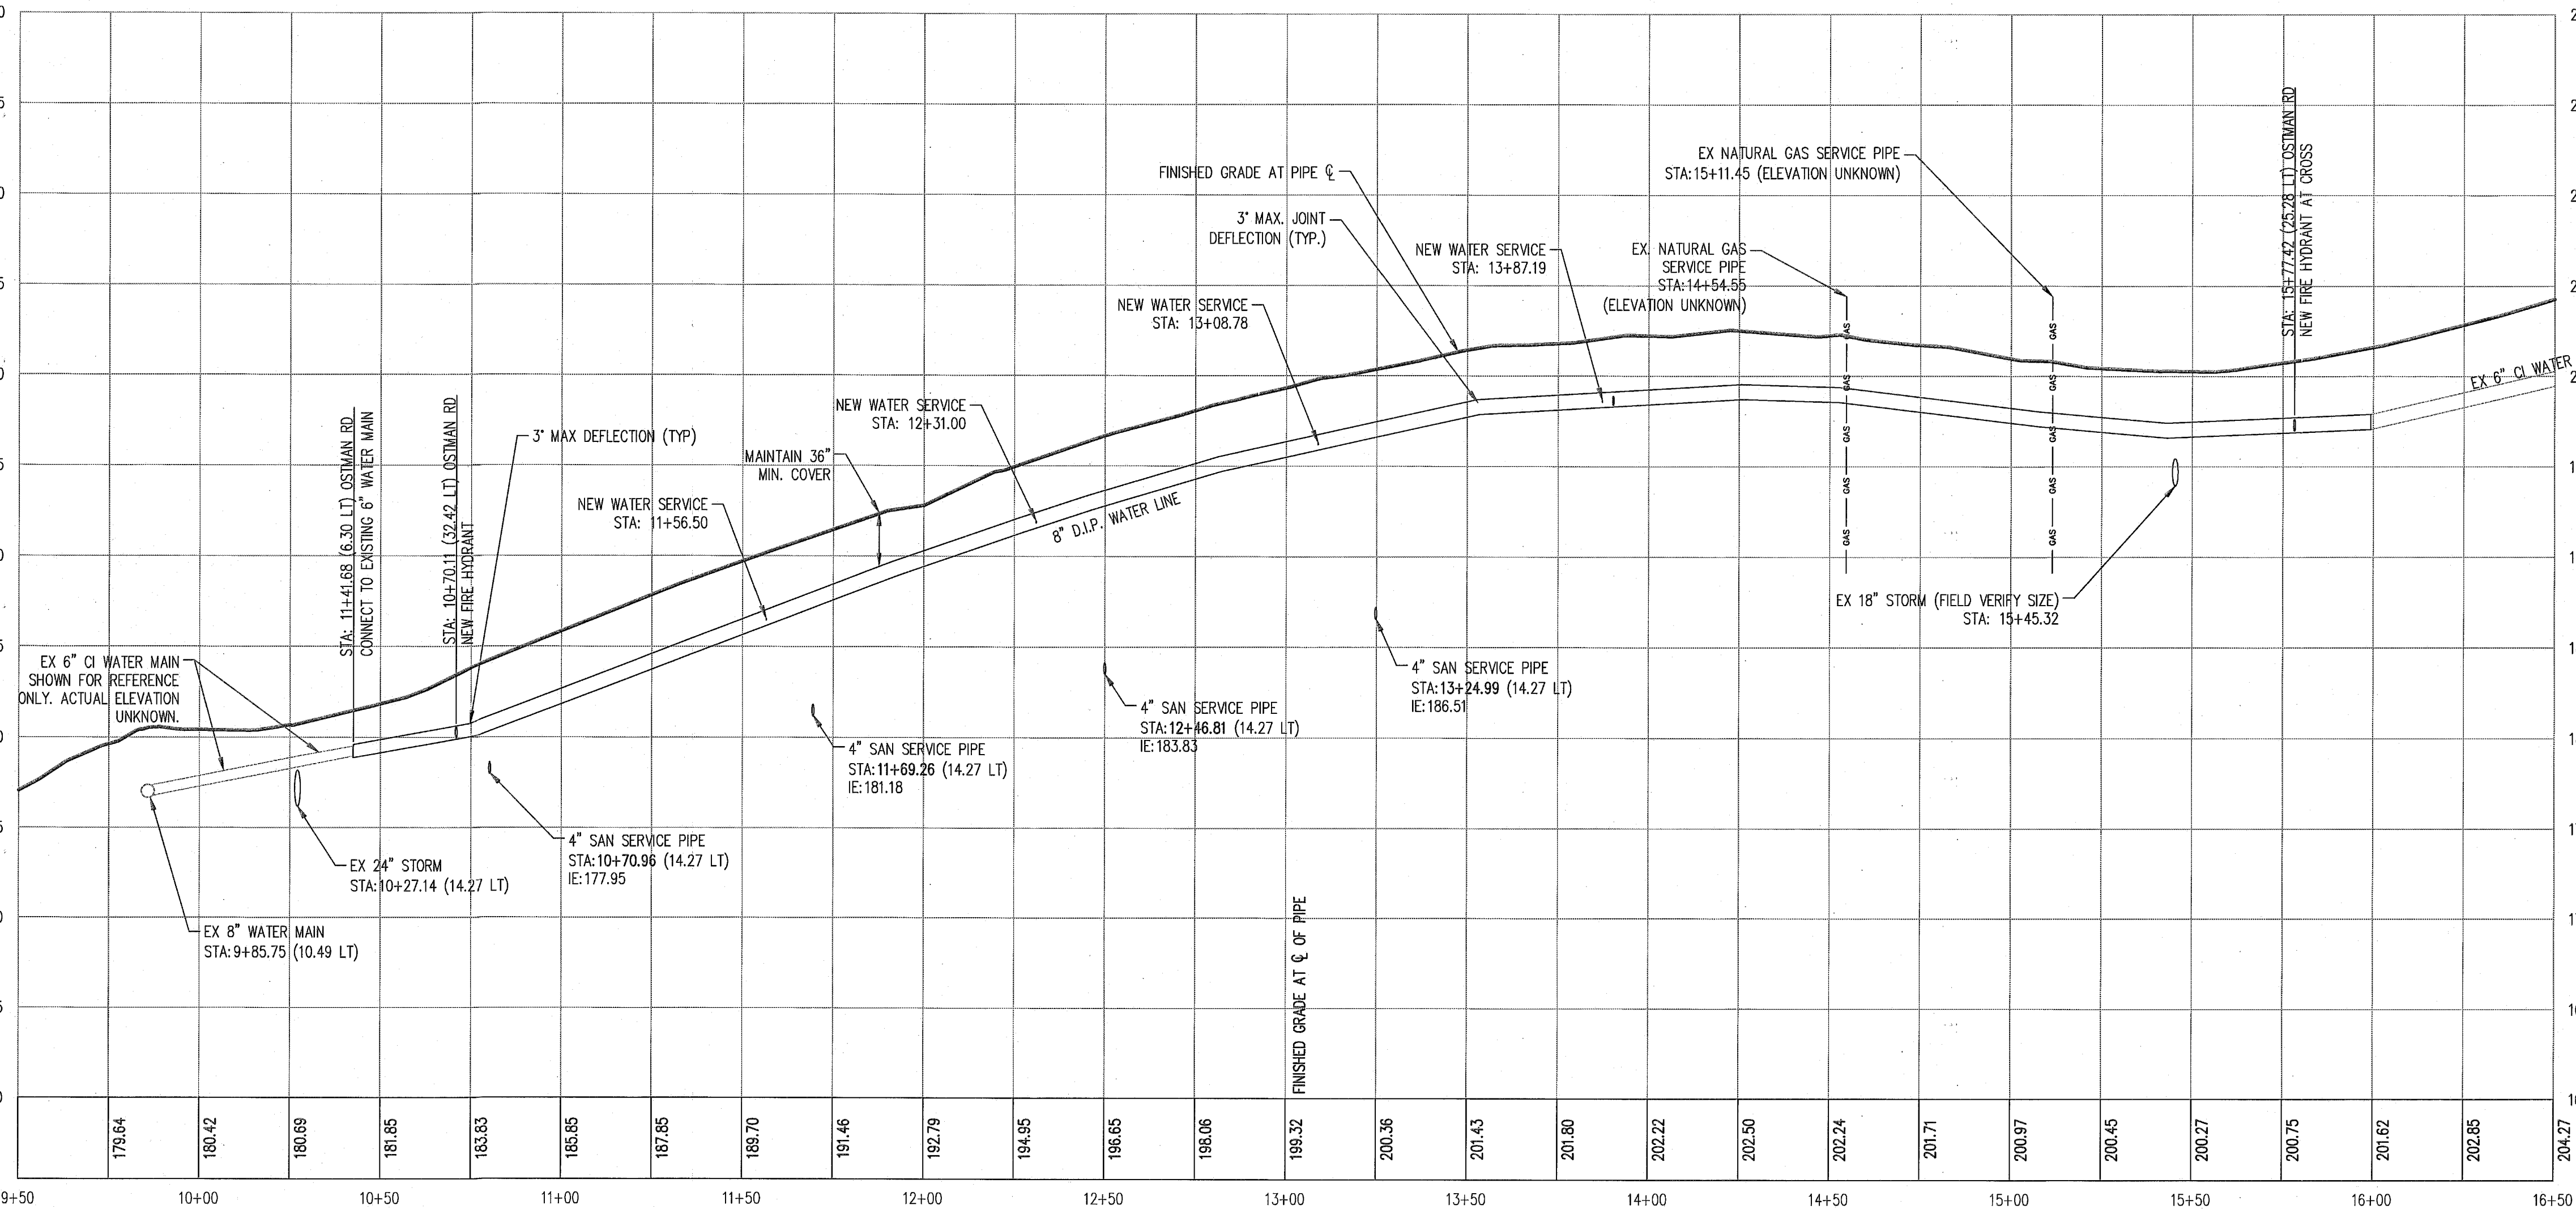

### OSTRMAN ROAD WATER LINE PROFILE

HOR: 1" = 30'  
VERT: 1" = 6'

STATIONING IS BASED ON CENTERLINE OF OSTRMAN ROAD.




# AS-BUILT DISCLAIMER:

AS-BUILT INFORMATION IS BASED ON A COMBINATION OF FIELD SURVEY INFORMATION, INSPECTION INFORMATION, AND CONTRACTOR-PROVIDED INFORMATION. THE ENGINEER ONLY CERTIFIES INFORMATION WHICH COULD BE FIELD-VERIFIED AFTER CONSTRUCTION WAS COMPLETED. AS-BUILTS ARE ONLY FOR PUBLIC IMPROVEMENTS WITHIN PUBLIC RIGHT-OF-WAYS OR EASEMENTS.

BLOW-OFF SIZES REQUIRED	
MAIN SIZE	BLOW-OFF SIZE
4" TO 6"	2"
8" TO 12"	4"
14" TO 18"	6"
20" & UP	PER ENGR.

## NOTE:

- BACKFILL WITH SELECT CRUSHED AGGREGATE A MINIMUM OF 6" ON ALL SIDES. COMPACTED TO 95% OF MAX DENSITY AS DETERMINED BY AASHTO T100.
- ON TEMPORARY BLOW-OFFS ONLY, AN MJ CAP TAPPED 4" OR 6" MAY BE SUBSTITUTED FOR REDUCER.
- TEMPORARY BLOW-OFF IS ONE REMOVED AT THE END OF PROJECT CONSTRUCTION. A PERMANENT BLOW-OFF REMAINS ON THE PROJECT AFTER ACCEPTANCE.
- PLACE BLOW-OFF STANDPIPE 3 FT. INSIDE R.O.W. LINE AT END OF STREET (2 FT FROM BARRICADE).

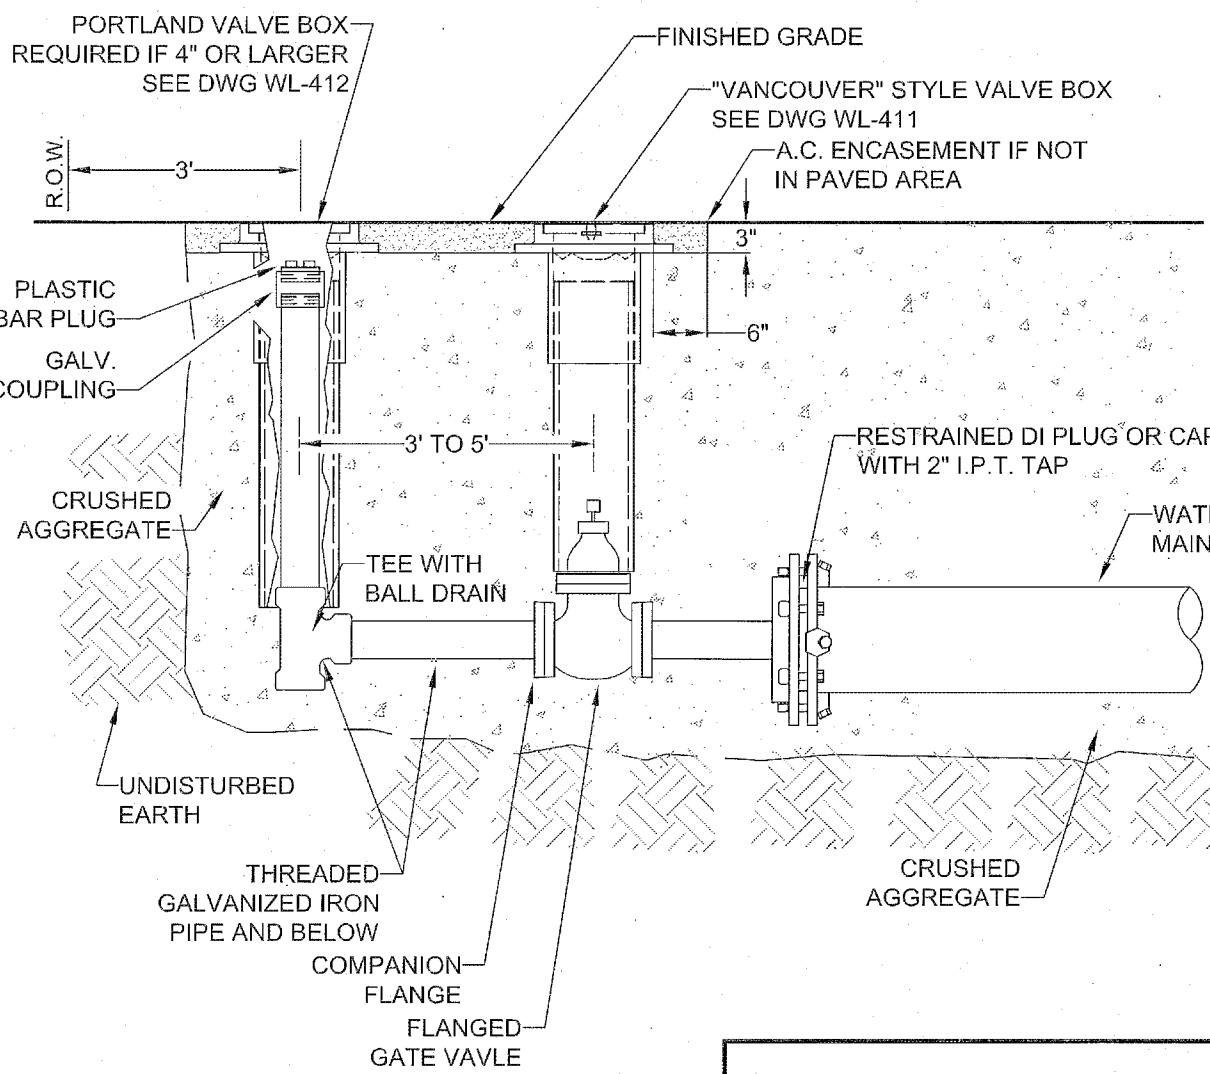


PERMANENT OR TEMPORARY  
4' AND 6' BLOW-OFF

DATE:	2010
DRAWING NO.	WL-404B
FILE NO.	

FITTING SIZE (Inches)	TEE, WYE, & HYDRANTS	STRADDLE BLOCK	90° BEND PLUGGED CROSS TEE PLUGGED-RUNS	45° BEND	22 1/2° BEND	11 1/2° BEND
2	-	-	-	-	-	-
4	1.7	2.1	2.4	1.3	-	-
6	3.7	4.9	5.3	2.9	1.5	-
8	6.7	8.7	9.5	5.1	2.7	1.3
10	10.5	13.6	14.8	8	4.1	2
12	15.1	19.6	21.3	11.6	5.9	2.9
14	-	-	-	-	-	-
16	28.8	34.8	37.9	20.5	10.4	5.2
18	33.9	44	47.9	25.9	12.8	6.7
LARGER	-	-	-	-	-	-

BEARING AREA OF THRUST BLOCKS (sq. ft.)



- ALL VALUES ARE BASED ON THE FOLLOWING ASSUMPTIONS:  
AVG. PRESSURE = 100 PSI X 2 (safety factor); 1500 PSF SOIL BEARING CAPACITY; NORMAL DISTRIBUTION DESIGN VELOCITY NOT TO EXCEED 5 F/S.
- ALL FITTINGS SHALL BE WRAPPED IN 8 MM PLASTIC PRIOR TO PLACEMENT OF CONCRETE.
- BEARING SURFACE OF THRUST BLOCKING SHALL BE AGAINST UNDISTURBED SOIL
- ALL CONCRETE MIX SHALL HAVE A MIN. 28 DAY STRENGTH OF 3000 PSI.
- ALL PIPE ZONES SHALL BE GRAVEL FILLED AND COMPACTED.
- THRUST BLOCKS FOR PLUGGED CROSS AND PLUGGED TEE SHALL HAVE #4 REBAR LIFTING LOOPS INSTALLED AS SHOWN.
- VERTICAL THRUST DETAILS-SEE DWG. WL-407.
- STRADDLE BLOCK DETAILS-SEE DWG. WL-408.

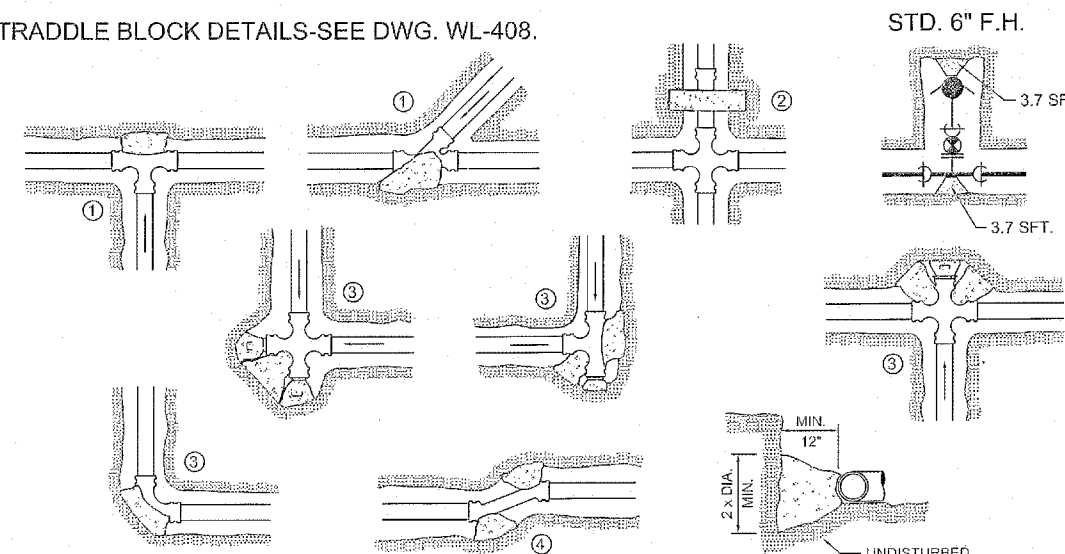

HORIZONTAL  
THRUST BLOCKING

DATE:	2010
DRAWING NO.	WL-406
FILE NO.	

- \* BLOCK TO UNDISTURBED TRENCH WALLS.
- \*\* THRUST BLOCKS FOR PIPES LARGER THAN 18" WILL BE INDIVIDUALLY DESIGNED BY THE ENGINEER.

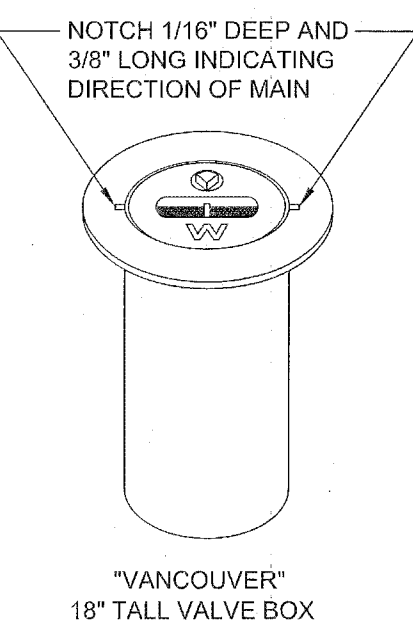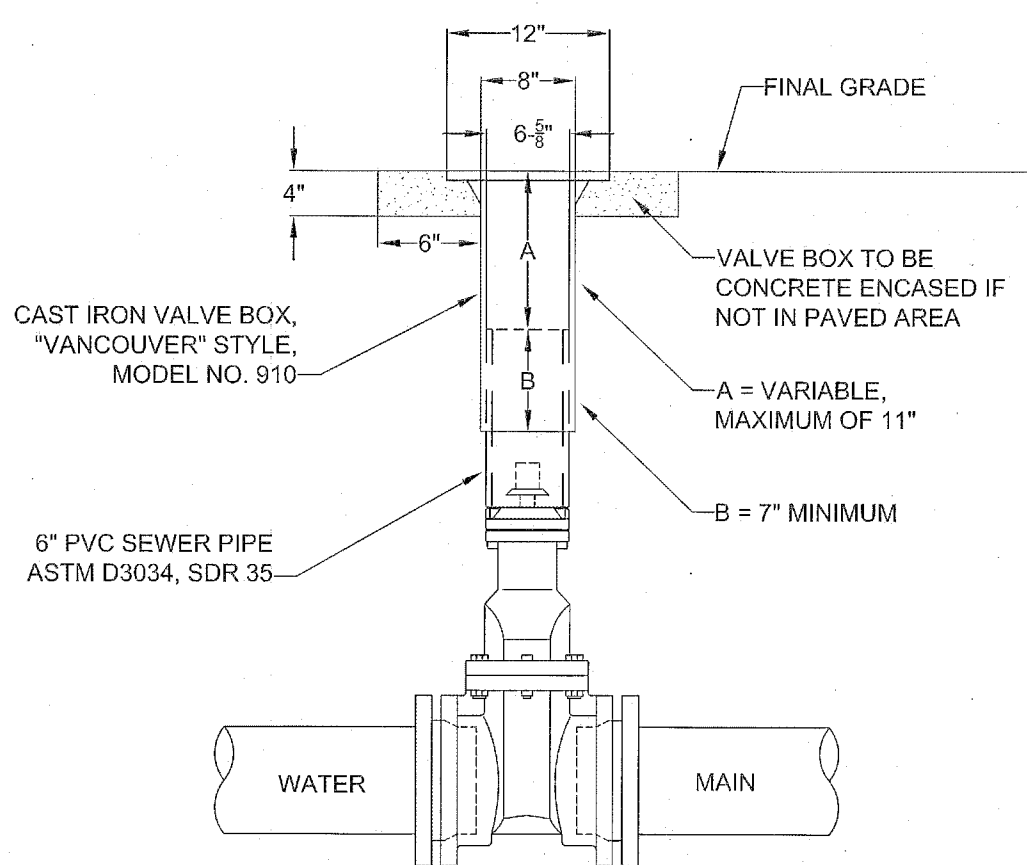


STANDARD VALVE BOX  
DETAIL

DATE:	2010
DRAWING NO.	WL-411
FILE NO.	

## NOTE:

- VALVE BOXES SHALL BE CENTERED DIRECTLY OVER THE VALVE NUT IN A VERTICAL POSITION.
- VALVE BOX TOP SHALL BE ADJUSTED TO MEET FINISHED GRADE.
- PVC SHALL BE ONE CONTINUOUS PIECE-NO BELLS OR COUPLERS.
- ON VALVES 8" AND LARGER, PVC SHALL BE NOTCHED OVER VALVE PACKING BOLTS SO PVC SITS ON BONNET.

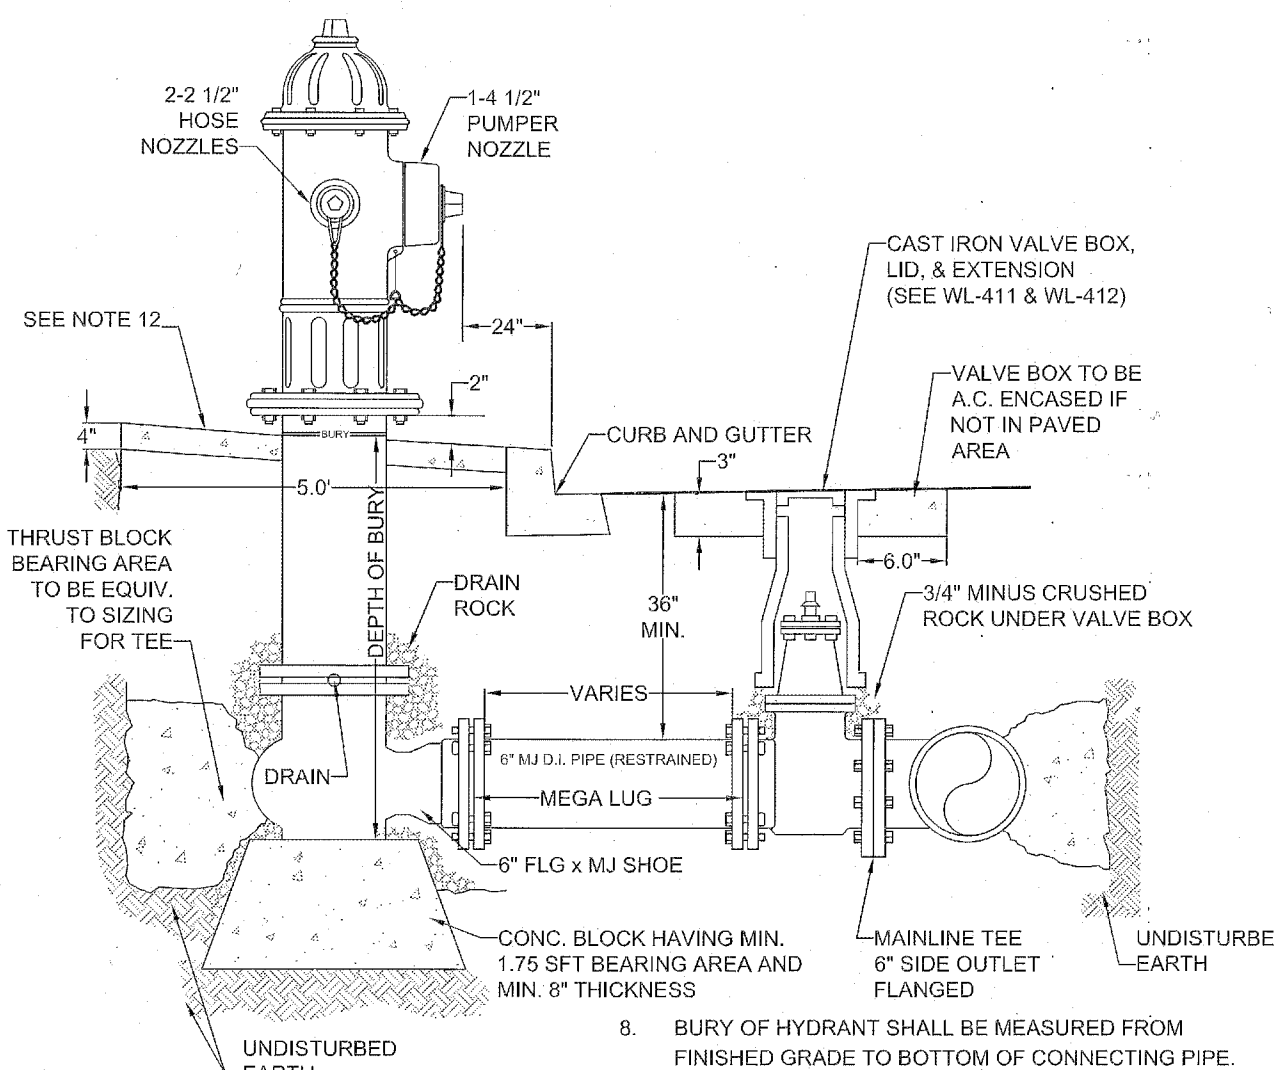

STANDARD FIRE HYDRANT  
ASSEMBLY

DATE:	2010
DRAWING NO.	WL-401
FILE NO.	


## NOTE:

- HYDRANT TO BE MUELLER CENTURION MDL A-423 ONLY WITH 1 1/2" OPER. NUTS OR CLOW MEDALLION F-2545.
- HYDRANT COLOR TO BE MILLER EQUIP. ENAMEL D E 40 (SAFETY YELLOW).
- JOINTS TO BE RESTRAINED BY 3/4" DIA GALVANIZED STEEL RODS AND THRUST BLOCKS OR MEGALUGS AND THRUST BLOCKS.
- ALL FITTINGS IN CONTACT W/CONCRETE SHALL BE WRAPPED IN PLASTIC, HYDRANT DRAIN HOLES TO REMAIN OPEN TO DRAIN ROCK AND OPERATIONAL.
- MIN. 4 CFT OF 1 1/2" - 3/4" CLEAN DRAIN ROCK SHALL BE PLACED AROUND SHOE UP TO A MIN. OF 6" ABOVE DRAIN OUTLETS.
- WHERE PLANTER STRIP EXISTS, HYDRANT SHALL BE PLACED SO THE FRONT PORT IS A MINIMUM OF 24" BEHIND THE FACE OF THE CURB.
- WHERE INTEGRAL SAW & CURB EXISTS, HYDRANT SHALL BE PLACED AT BACK OF THE SIDEWALK, OR AS DIRECTED BY ENGINEER.
- BURY OF HYDRANT SHALL BE MEASURED FROM FINISHED GRADE TO BOTTOM OF CONNECTING PIPE.
- THRUST BLOCK AT FIRE HYDRANT TEE SHALL BE EQUIVALENT TO TEE PIPE SIZING (SEE WL-408).
- HYDRANT VALVE SHALL BE MUELLER RESILIENT WEDGE GATE VALVE #A-2360-16 ONLY.
- NO EXTENSIONS ALLOWED
- HYDRANT SHALL HAVE A 5' x 5' x 4" THICK CONCRETE APRON. THERE SHALL BE 2" OF CLEARANCE BETWEEN THE TOP OF THE APRON AND THE BOTTOM OF THE FLANGED BOLT PATTERN OF THE HYDRANT.
- CONCRETE SHALL BE COMMERCIAL MIXED WITH A BREAKING STRENGTH OF NOT LESS THAN 3000 PSI.

THIS DETAIL DRAWING SHALL NOT BE ALTERED OR CHANGED IN ANY MANNER EXCEPT BY THE CITY ENGINEER. IT IS THE RESPONSIBILITY OF THE USER TO ACQUIRE THE MOST CURRENT VERSION OF THE DETAIL.

## MATERIAL:

- BROOKS METER BOX, BODY NO. 37, LID AND COVER NO.37-S.
- MUELLER CORP. STOP NO. H-15008 OR FORD F1000-4Q CORP. STOP WITH OPERATING NUT AT 3 OR 9 O'CLOCK.
- 1" SOFT TEMPER, TYPE "K" COPPER TUBING COMPLYING WITH ASTM B-88.
- MUELLER ANGLE METER STOP NO. H-14258 (FORD NO. KV43-444W-Q).

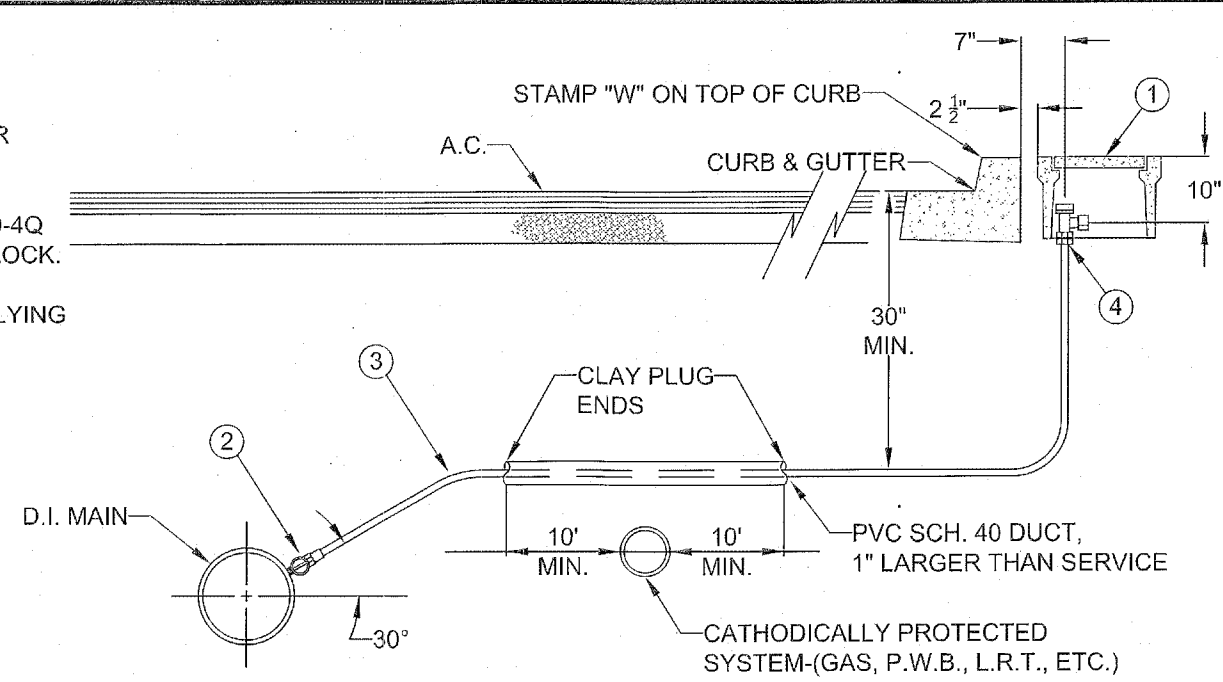

## NOTE:

- MACHINE DRILLED AND TAPPED ONLY. NO HAND DRILLING IS ALLOWED.
- SUBSTITUTES FOR ANY MATERIALS SHOWN SHALL BE APPROVED BY THE CITY ENGINEER.
- ALL PIPE AND STRUCTURE ZONE SHALL BE BACKFILLED USING 3/4" MINUS CRUSHED AGG. AND COMPACTED TO 95% MAX DENSITY AS DETERMINED BY AASHTO T-100.
- WHEN AN ACTIVE CATHODIC PROTECTED SYSTEM IS ENCOUNTERED, SCH. 40 PVC SHALL BE INSTALLED AS SHOWN ABOVE WITH CLAY PLUG.
- METER BOX SHALL BE CENTERED OVER THE COMPLETED METER ASSEMBLY.
- TAPS INTO MAIN TO HAVE 18" SEPARATION ON CENTER MINIMUM.
- ANGLE METER STOPS TO BE 18" FROM PROPERTY LINE AND NOT IN DRIVEWAY APPROACH.
- METER BOXES IN CURB TIGHT SIDEWALK AND THOSE SUBJECT TO INCIDENTAL AUTO TRAFFIC MUST HAVE METAL LIDS AND BE TRAFFIC RATED.

DATE:	2010
DRAWING NO.	WL-402
FILE NO.	

AKS  
ENGINEERING AND FORESTRY, LLC  
2285 SW HERMAN RD  
TULSA, OK 74106  
PHONE: 918.563.6151  
FAX: 918.563.6152  
www.aks-eng.com

RENAISSANCE  
AT WILLAMETTE  
AS-BUILTS  
WEST LINN  
OREGON  
ENGINEERING • PLANNING • SURVEYING  
LANDSCAPE ARCHITECTURE  
CLACKAMAS COUNTY ASSESSOR'S TAXMAP 351030AB  
TAX LOT 0200

# WATER DETAILS

DESIGNED BY:	DCN
DRAWN BY:	JDR
CHECKED BY:	MBH
SCALE:	AS NOTED
DATE:	2/9/2015
RENEWAL DATE:	6/30/15
REVISIONS	
JOB NUMBER	3745
SHEET	C401



AS-BUILT DISCLAIMER:  
AS-BUILT INFORMATION IS BASED ON A COMBINATION OF FIELD SURVEY INFORMATION, INSPECTION INFORMATION, AND CONTRACTOR-PROVIDED INFORMATION. THE ENGINEER ONLY CERTIFIES INFORMATION WHICH COULD BE FIELD-VERIFIED AFTER CONSTRUCTION WAS COMPLETED. AS-BUILTS ARE ONLY FOR PUBLIC IMPROVEMENTS WITHIN PUBLIC RIGHT-OF-WAYS OR EASEMENTS.

AX LOT 2201  
TAX MAP 3 1E 3AB

TAX LOT 1054  
TAX MAP 2 1E 34DC

T 2202  
3 1E 3AB

TAX LOT 2203  
TAX MAP 3 1E 3AB

TAX LOT 2204  
TAX MAP 3 1E 3AB

LOT 1


LOT 2

LOT 3

LOT 4

OSTMAN RD

WILLAMETTE FALLS DR

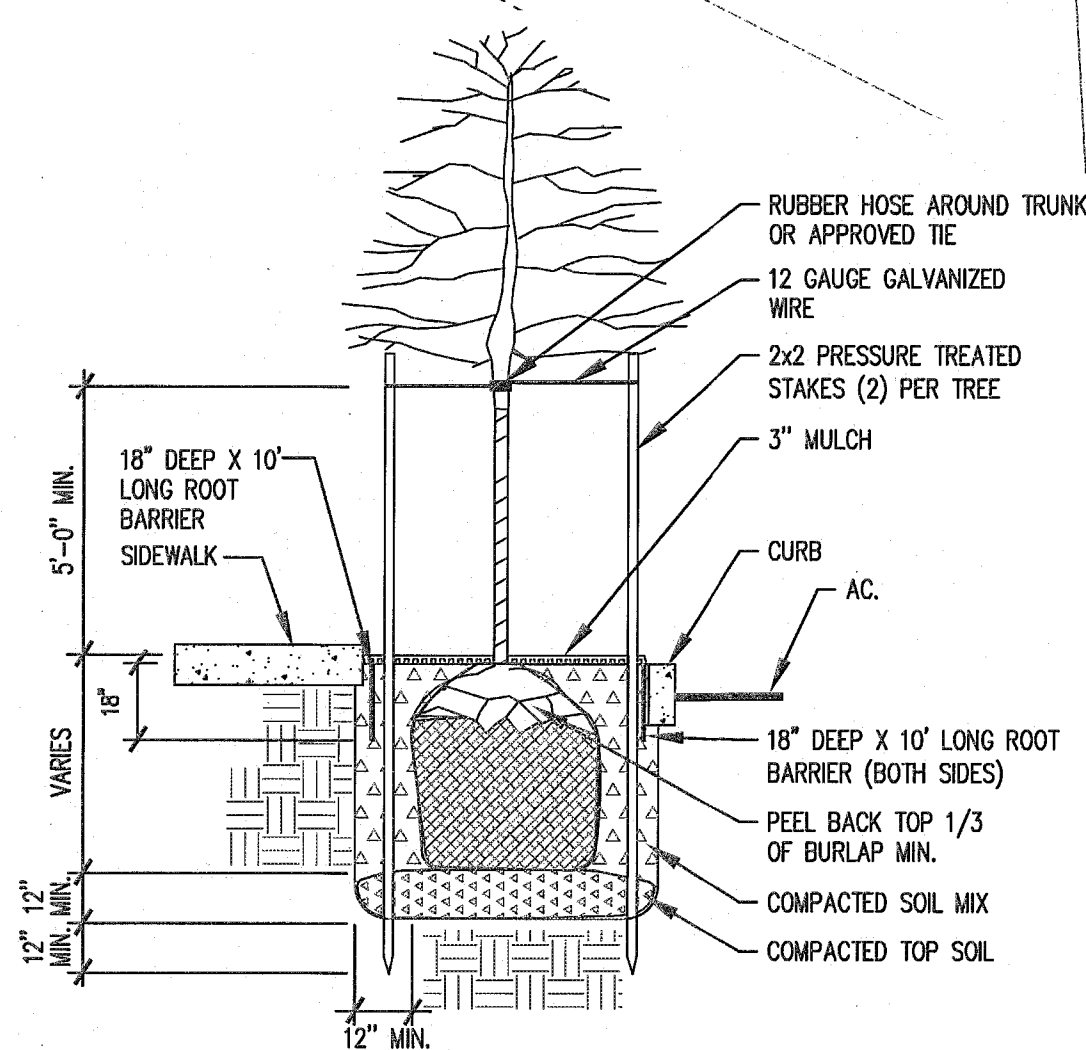

1 TYPICAL STREET TREE PLANTING DETAIL

- NOTES:
1. DRIVE STAKES OUTSIDE OF ROOTBALL PARALLEL TO STREET AND SIDEWALK. SINGLE STAKE TREES LESS THAN 6' TALL.
  2. SET TREE 2" ABOVE FINISH GRADE TO ALLOW FOR SETTLING OF SOIL.
  3. PROVIDE A 10' LONG ROOT BARRIER NEXT TO SIDEWALK AND CURB. CENTER BARRIER ON TREE TRUNK.
  4. SOIL MIX FOR TREE PLANTING TO BE 1/3 ORGANIC MATERIALS, 1/3 TOPSOIL, AND 1/3 SANDY LOAM.

COMPACT OREGON GRAPE (TYP)

RED FLOWERING CURRANT (TYP)

OREGON GRAPE (TYP)

COMPACT OREGON GRAPE (TYP)

RED FLOWERING CURRANT (TYP)

SPREADING RUSH 12" O.C. (TYP)

KELSEY DOGWOOD (TYP)

PROPOSED RESIDENTIAL WATER METER (TYP)

COASTAL STRAWBERRY 12" O.C. (TYP)

FUTURE SIDEWALK (TYP)

OREGON GRAPE (TYP)

RED FLOWERING CURRANT (TYP)

PAPERBARK MAPLE (TYP)

RED FLOWERING CURRANT (TYP)

RED SUNSET MAPLE (TYP)

KELSEY DOGWOOD (TYP)










COMPACT OREGON GRAPE (TYP)

COASTAL STRAWBERRY 12" O.C. (TYP)

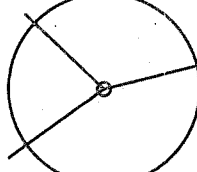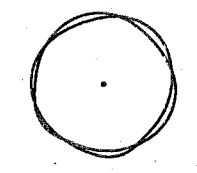OREGON GRAPE (TYP)

BLUE FESCUE (TYP)

## PLANT SCHEDULE

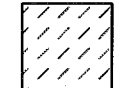TREES	QTY	BOTANICAL NAME / COMMON NAME	SIZE/CONTAINER	SPACING
	3	ACER RUBRUM 'FRANKSRED' / RED SUNSET MAPLE	2" CAL B&B	AS SHOWN
STORMWATER TREES	QTY	BOTANICAL NAME / COMMON NAME	SIZE/CONTAINER	SPACING
	8	ACER GRISEUM / PAPERBARK MAPLE	1.5" CAL. B&B	AS SHOWN
SHRUBS	QTY	BOTANICAL NAME / COMMON NAME	SIZE/CONTAINER	SPACING
	128	MAHONIA AQUIFOLIUM 'COMPACTA' / COMPACT OREGON GRAPE	1 GAL CONT.	36" o.c.
GRASSES	QTY	BOTANICAL NAME / COMMON NAME	SIZE/CONTAINER	SPACING
	30	FESTUCA GLAUCA / BLUE FESCUE	1 GAL CONT.	24" o.c.
STORMWATER SHRUBS	QTY	BOTANICAL NAME / COMMON NAME	SIZE/CONTAINER	SPACING
	50	CORNUS SERICEA 'KELSEY' / KELSEY DOGWOOD	1 GAL CONT.	24" o.c.
	32	MAHONIA AQUIFOLIUM / OREGON GRAPE	1 GAL CONT.	36" o.c.
	11	RIBES SANGUINEUM / RED FLOWERING CURRANT	3 GAL CONT.	48" o.c.
STORMWATER HERBACEOUS PLANTS	QTY	BOTANICAL NAME / COMMON NAME	SIZE/CONTAINER	SPACING
	647	JUNCUS PATENS / SPREADING RUSH	1 GAL CONT.	12" o.c.
STORMWATER GROUNDCOVER	QTY	BOTANICAL NAME / COMMON NAME	SIZE/CONTAINER	SPACING
	601	FRAGARIA CHILOENSIS / COASTAL STRAWBERRY	1 GAL CONT.	12" o.c.

### GENERAL NOTES:

1. CONTRACTOR IS RESPONSIBLE FOR VERIFYING PLANT QUANTITIES. IF DISCREPANCIES OCCUR, DESIGN INTENT PREVAILS OVER QUANTITIES LISTED.
2. ALL PLANTS AND PLANTINGS SHALL CONFORM TO CITY OF WEST LINN DESIGN STANDARDS AND TO AMERICAN NURSERY STANDARDS ASN 1260.1.
3. REVISIONS OR SUBSTITUTIONS TO PLANTINGS, INCLUDING CHANGES TO LOCATION, QUANTITIES, SPECIES, SIZES, SPACING, ETC. DUE TO UNFORESEEN SITE CONDITIONS, PLANT AVAILABILITY, ETC. MAY BE MADE BY THE LANDSCAPE ARCHITECT WHERE ALLOWED BY CITY OF WEST LINN DESIGN STANDARDS, PRIOR TO FINAL INSTALLATION.
4. TREES TO BE PLANTED SHALL MEET THE REQUIREMENTS OF THE AMERICAN ASSOCIATION OF NURSERYMEN (AAN) STANDARDS FOR NURSERY STOCK (ANSI Z60.1) FOR GRADE NO. 1 OR BETTER. DOUBLE STAKE ALL TREES. PROVIDE ROOT BARRIERS WHERE ADJACENT TO HARD SURFACING, CURBS, SIDEWALKS, ETC. ROOT BARRIER SHALL BE A MINIMUM OF 18" DEEP BY 10' LONG. CENTER ROOT BARRIER ON TREE TRUNK.
5. CENTER TREES IN PLANTER STRIP WHERE NOT IN STORMWATER SWALES. KEEP SHRUBS AND GROUNDCOVERS A MINIMUM OF 24" O.C. FROM PAVING AND 3' O.C. FROM TREES. ADJUST PLANTINGS AS NECESSARY ON SITE TO AVOID CONFLICT WITH UTILITIES, HYDRANTS, LIGHT POLES, METERS, ETC.
6. MULCH: APPLY 3" DEEP WELL-AGED MEDIUM GRIND OR SHREDDED DARK HEMLOCK OR FIR BARK MULCH UNDER AND AROUND ALL PLANTINGS. CARE SHALL BE TAKEN TO AVOID COVERING FOLIAGE OR ROOT CROWN OF PLANTS WITH BARK MULCH.  
\* SEE STORMWATER NOTES FOR BARK MULCH IN SWALES.
7. GROWING MEDIUM: GROWING MEDIUM IN ALL NEW PLANTING BEDS SHALL BE A MINIMUM OF 12" DEEP. EXISTING, NON-COMPACTED, NATIVE SOIL MAY COUNT TOWARDS THIS REQUIREMENT. REUSE SURFACE SOIL STOCKPILED ON THE SITE AND/OR IMPORT NEW TOPSOIL TO MAKE UP REQUIRED AMOUNTS FOR INSTALLATION. TOPSOIL SHALL BE FREE OF ROOTS, PLANTS, SOD, STONES, CLAY LUMPS, DEBRIS, ALKALI SALTS, AND OTHER EXTRANEEOUS MATERIALS HARMFUL TO PLANT GROWTH AND HAVE A MINIMUM OF 15%-30% ORGANIC MATERIAL CONTENT. SOIL PLACEMENT AND PLANTINGS SHALL OCCUR IN CONDITIONS THAT DO NOT RESULT IN OVER-COMPACTION OR EROSION, SATURATED SOIL OR OTHER CONDITIONS SUCH AS FREEZING OR ABOVE AVERAGE TEMPERATURES, RAINY CONDITIONS, ETC. SOIL SHALL BE IN FRIABLE (WORKABLE) CONDITION WHEN PLACED. FINISHED GRADE OF NEW PLANTING SHALL SEAMLESSLY MEET FINISH GRADE SET IN GRADING PLANS.  
\* SEE STORMWATER NOTES FOR SOIL PREPARATION IN SWALES.
8. ALL PLANTING AREAS SHALL BE AUTOMATICALLY IRRIGATED USING THE LATEST IN WATER SAVING TECHNOLOGY (I.E. DRIP IRRIGATION, FOR PLANTING BEDS, EVAPOTRANSPIRATION (ET) CONTROL CLOCK, ETC.). LANDSCAPE CONTRACTOR TO 'DESIGN-BUILD' IRRIGATION SYSTEM AND SUBMIT PLANS TO CITY OF WEST LINN AND THE LANDSCAPE ARCHITECT FOR APPROVAL PRIOR TO BEGINNING INSTALLATION. COORDINATE POINT OF CONNECTION (POC), SLEEVING, AND CONTROL CLOCK LOCATION WITH GENERAL CONTRACTOR PRIOR TO PAVING AND OTHER HARD SURFACE CONSTRUCTION COMMENCEMENT.  
\* SEE STORMWATER NOTES FOR IRRIGATION IN SWALES.

### STORMWATER NOTES:

1. ALL PLANTS AND PLANTINGS SHALL CONFORM TO THE CITY OF WEST LINN DESIGN STANDARDS AND BUREAU OF ENVIRONMENTAL SERVICES (BES) MANUAL. PLANT IN ACCORDANCE WITH STANDARDS ADOPTED BY THE OREGON LANDSCAPE CONTRACTORS BOARD (OLCB).
2. PLANTING SHALL OCCUR IN THE SPRING (MARCH) OR EARLY FALL (SEPTEMBER THROUGH OCTOBER) UNLESS SUPPLEMENTAL MEASURES ARE TAKEN TO ENSURE PLANT SURVIVAL.
3. HATCHED AREAS ARE MEANT TO PORTRAY GENERAL PLANT AREAS. PLANT AREA FOR FULL COVERAGE AT SPACING NOTED IN PLANT LEGEND. ADJUST PLANTINGS AS NECESSARY TO AVOID VAULTS, INLETS, ETC.
4. GROWING MEDIUM: 18" DEEP, IMPORTED SOIL, SANDY LOAM MIXED WITH PLANT DERIVED COMPOST OR SAND/SOIL/COMPOST BLEND IN ACCORDANCE WITH BUREAU OF ENVIRONMENTAL SERVICES (BES) STANDARDS. GROWING MEDIUM SHALL BE APPROXIMATELY ONE-THIRD COMPOST BY VOLUME, FREE-DRAINING, AND SUPPORT PLANT GROWTH. COMPOST SHALL BE ENTIRELY PLANT DERIVED.
5. SOIL PLACEMENT AND PLANTING SHALL OCCUR IN CONDITIONS THAT DO NOT RESULT IN OVER-COMPACTION OR EROSION, SATURATED SOIL OR OTHER CONDITIONS SUCH AS FREEZING OR ABOVE AVERAGE TEMPERATURES, RAINY CONDITIONS, ETC.
6. INVASIVE PLANT MATERIAL, INCLUDING HIMALAYAN BLACKBERRY, THISTLE SPECIES, ETC. SHALL BE REMOVED ENTIRELY FROM THE STORMWATER SWALES BEFORE PLANTING IF PRESENT. REMOVE INVASIVE VEGETATION IN ACCORDANCE WITH BES STANDARDS.
7. MULCH: APPLY 3" DEEP FINE TO MEDIUM HEMLOCK MULCH OR WELL-AGED ORGANIC YARD DEBRIS COMPOST UNDER AND AROUND ALL PLANTINGS IN ZONE 'B' (DRY ZONE) ONLY. CARE SHALL BE TAKEN TO AVOID PLACING MULCH IN ZONE 'A' (WET ZONE), IN A STORMWATER FLOW PATH, OR IN AREAS WHERE IT MAY CLOG INLETS OR OUTLETS OR ESCAPE THE SWALES.
8. MANURE MULCHING AND HIGH-FERTILIZER HYDROSEEDING SHALL BE PROHIBITED IN THE SWALES DURING AND AFTER CONSTRUCTION.
9. IRRIGATION: CONTRACTOR SHALL PROVIDE A TEMPORARY 'DESIGN-BUILD' IRRIGATION SYSTEM FOR THE STORMWATER SWALES. TEMPORARY IRRIGATION SYSTEM SHALL MEET ALL CITY OF WEST LINN STANDARDS AND INCLUDE ALL NECESSARY COMPONENTS, CONTROL VALVES, DOUBLE CHECKVALVES, ETC. NECESSARY FOR FULL COVERAGE. IRRIGATION SYSTEM SHALL BE REMOVED AT THE END OF TWO-YEARS OR PLANT ESTABLISHMENT, WHICHEVER IS LONGER. COORDINATE WITH GENERAL CONTRACTOR AND/OR OWNER.
10. MAINTENANCE WARRANTY PERIOD: MAINTENANCE WARRANTY PERIOD SHALL BE PROVIDED BY THE LANDSCAPE CONTRACTOR FOR A PERIOD OF 2-YEARS AFTER DATE OF COMPLETION. REGULAR MAINTENANCE TASKS SHALL BE PERFORMED IN ACCORDANCE WITH INDUSTRY STANDARDS. THESE TASKS MAY INCLUDE, BUT NOT LIMITED TO, REMOVAL OF UNDESIRABLE WEEDS OR INVASIVE VEGETATION, PRUNING, MULCHING, PLANT REPLACEMENT, AND IRRIGATION SYSTEM REPAIR.

SCALE 1" = 20 FEET

