

GENERAL NOTES:

1. ALL MATERIAL, WORKMANSHIP AND CONSTRUCTION METHODS SHALL BE IN STRICT ACCORDANCE TO THE MOST RECENT VERSION OF THE CITY OF WEST LINN CONSTRUCTION AND DESIGN SPECIFICATIONS.
2. THE DESIGN ENGINEER WILL BE RESPONSIBLE FOR INSPECTION OF THE PROPOSED IMPROVEMENTS WITH OVERSIGHT FROM CITY'S PUBLIC WORKS AND ENGINEERING STAFF.
3. A WORK SCHEDULE WILL BE REQUIRED FROM THE CONTRACTOR SO THAT THE ENGINEER CAN HAVE AN INSPECTOR ONSITE AT THE APPROPRIATE TIMES. IF THE WORK SCHEDULE IS REVISED THE CONTRACTOR IS TO NOTIFY THE ENGINEER OF THE CHANGES. ADDITIONALLY THE CONTRACTOR IS TO GIVE THE ENGINEER AT LEAST 24 HOURS NOTICE OF ANY TESTING REQUIRING THE PRESENCE OF THE ENGINEER AND/OR CITY STAFF.
4. THE CONTRACTOR IS TO RECEIVE THE APPROVAL OF THE ENGINEER AND THE CITY OF WEST LINN OF ANY PROPOSED CHANGES TO THE PLANS OR STANDARD REQUIREMENTS.
5. A BUILDING DEPARTMENT PLUMBING PERMIT IS REQUIRED FOR UTILITIES BEYOND THE FIRST CLEANOUT OR METER ON PRIVATE PROPERTY.
6. A PUBLIC IMPROVEMENT GUARANTEE AGREEMENT AND A PRE-CONSTRUCTION MEETING WITH THE CITY OF WEST LINN ARE REQUIRED PRIOR TO BEGINNING CONSTRUCTION. PRIOR TO SITE CLEARING, CONSTRUCTION "SNOW" FENCING SHALL BE PLACED AROUND TREES TO BE PRESERVED 10 FEET BEYOND THE DRIPLINE OF THE TREES AND SHALL REMAIN IN PLACE THROUGHOUT THE INFRASTRUCTURE IMPROVEMENTS.
7. COARSE AND FINE AGGREGATES SHALL CONFORM TO REQUIREMENTS OF SECTION 205, MATERIALS--TYPES AND USE. REFERENCES MADE TO SECTIONS REFER TO THE CITY OF WEST LINN'S PUBLIC WORKS STANDARDS.
8. ALL FEES FOR STREET TREES SHALL BE PAID TO THE CITY OF WEST LINN PARKS AND RECREATION DEPARTMENT.
9. NO BUILDING PERMITS SHALL BE ISSUED UNTIL ALL THE IMPROVEMENTS HAVE BEEN ACCEPTED BY THE CITY.
10. THE CITY SHALL WITNESS ALL TESTING FOR THE PROJECT AND SHALL RECEIVE COPIES OF ALL TEST RESULTS.
11. THE CONTRACTOR SHALL MEET ALL THE "CITY CONSTRUCTION AND DESIGN STANDARDS" OF THE CITY OF WEST LINN.

UTILITIES:

1. IF NOT NOTED ON THE PLANS UTILITY INFORMATION AND CROSSING LOCATIONS WILL HAVE TO BE OBTAINED FROM THE UTILITIES.
2. UTILITY CONTACTS ARE AS FOLLOWS: PGE – CINDY MANSELLE, (503) 650-1411; TCI CABLE – LINDA PETERSEN, (503) 243-7497, U.S. WEST COMMUNICATIONS – JACKIE LOLLAR (503) 242-8496.
3. THE UNDERGROUND UTILITIES SHOWN HAVE BEEN LOCATED FROM LOCATE PAINT MARKINGS TIED IN THE FIELD SURVEY AS PROVIDED BY UTILITY COMPANIES. THESE PLANS DO NOT SHOW ANY PAINT MARKINGS PROVIDED AFTER THE FIELD SURVEY WAS COMPLETED.
4. THIS SURVEY MAKES NO GUARANTEES THAT THE EXISTING UNDERGROUND UTILITIES SHOWN COMPRISE ALL SUCH UTILITIES IN THE AREA. THE EXISTING UNDERGROUND UTILITIES SHOWN MAY NOT BE IN THE EXACT LOCATION AS NOTED ON THESE PLANS, BUT ARE LOCATED AS ACCURATELY AS POSSIBLE FROM THE INFORMATION PROVIDED. MANHOLES OTHER THAN SANITARY AND STORM SEWER WERE IDENTIFIED BY MANHOLE LIDS AND MAY NOT BE LABELED CORRECTLY.

WATER SUPPLY:

- 1A. CONTRACTOR TO VERIFY EXISTING LINE SIZE IN LANCASTER STREET PRIOR TO CONSTRUCTION. NOTIFY THE ENGINEER IF THE EXISTING LINE SIZE IN FIELD IS DIFFERENT THAN NOTED ON PLANS.
1. WATER MAINS SHALL BE DUCTILE IRON PIPE CONFORMING TO AWWA C151 CLASS 52. PIPE IS TO HAVE CEMENT MORTAR LINING AND BITUMINOUS SEAL COAT CONFORMING TO AWWA C104. JOINTS ARE TO BE PUSH-ON JOINT. PIPE FITTINGS ARE TO BE OF THE SAME MATERIAL AND CLASS AS PIPE AND OF DOMESTIC ORIGIN.
2. WATER MAINS TO HAVE A MINIMUM COVER OF 36".
3. THRUST BLOCKS ARE TO BE PROVIDED AT ALL CHANCES IN DIRECTION AND BRANCHES. THRUST BLOCKING CONCRETE MIN. 28 DAY STRENGTH IS TO BE 3300 PSI. SEE DETAIL WL-406 & WL-407 FOR THRUST BLOCK SIZING. PLACE THRUST BLOCKS AGAINST UNDISTURBED EARTH.
4. GATE VALVES SHALL BE A DOUBLE DISC TYPE CONFORMING TO AWWA CLASS "C" SPEC'S. BUTTERFLY VALVES SHALL BE CLASS 150 B SHORT BODY TYPE IN CONFORMANCE WITH AWWA C504. VALVE BOXES SHALL BE "VANCOUVER" TYPE MODEL 910.
5. FIRE HYDRANTS SHALL BE CLOW MEDALLION TYPE 2545 OR MUELLER CENTURION A-423 ONLY, AND SHALL BE INSTALLED IN ACCORDANCE WITH SECTION 403.06 PLACING FIRE HYDRANT ASSEMBLIES.
6. GRANULAR BACKFILL IS TO BE COMPACTED TO 95% MAXIMUM DRY DENSITY PER AASHTO T 180 TEST METHOD AND NATIVE MATERIAL SHALL BE COMPACTED TO 85% OF IN-PLACE DRY DENSITY OF SURROUNDING SOIL. BACKFILL UNDER STREETS SHALL BE IN ACCORDANCE WITH CLASS 'B' BACKFILL AS INDICATED ON THE DETAIL SHEET OF THE PLANS. EXCAVATION, BEDDING AND BACKFILL SHALL BE IN ACCORDANCE WITH SECTION 204, EXCAVATION, EMBANKMENT, BEDDING AND BACKFILL. BACKFILL COMPACTION CAN BE 85% ONLY IN UNIMPROVED SURFACES OUTSIDE OF THE RIGHT-OF-WAY.
7. SERVICE LATERALS SHALL BE TYPE K. LATERAL SIZES SHALL BE 1". FOR DOUBLE SERVICES TWO 1" WATER SERVICE SHALL BE LAID SIDE BY SIDE. CORPORATION STOPS SHALL BE FORD OR APPROVED EQUAL. CURB STOP SHALL BE 1" FORD METER STOP. METER BOXES SHALL BE EQUAL TO BROOKS #37. METER BOXES ARE TO BE INSTALLED 3/4" ABOVE FINISH GRADE. PER STANDARD DETAIL WL-402.
8. ALL WATERLINES WILL BE PRESSURE TESTED AND PURIFICATION TESTED BEFORE CONNECTION TO THE CITY WATER SYSTEM. PRESSURE TEST SHALL MAINTAIN 180 PSI FOR ONE HOUR WITH NO LOSS.
9. DISINFECTION SHALL CONFORM WITH THE OREGON STATE HEALTH DIVISION'S PUBLICATION, "PUBLIC WATER SYSTEMS" ORS CH. 333.
10. DO NOT CONNECT NEW PIPE TO EXISTING PIPE PRIOR TO TESTING. THE CITY OF WEST LINN REQUIRES ACCEPTANCE OF NEW WATERLINE PRIOR TO CONNECTION TO EXISTING WATER SYSTEM.
11. A PLUMBING PERMIT FROM THE CITY OF WEST LINN BUILDING DEPARTMENT IS REQUIRED FOR SERVICE LATERAL INSTALLATIONS BEYOND THE WATER METER.
12. ALL MATERIALS, INSTALLATION, TESTS, AND CHLORINATION TO BE IN STRICT ACCORDANCE WITH APWA'S STANDARD SPECIFICATIONS FOR PUBLIC WORKS CONSTRUCTION, THE SUPPLEMENTAL STANDARDS AND CODES OF THE CITY OF WEST LINN, AND THE OREGON STATE HEALTH DIVISION ADMINISTRATIVE RULES, CHAPTER 333.

STREETS:

1. NEW STREET SECTIONS ARE TO BE CLEARED OF ALL SURFACE VEGETATION AND OTHER MISCELLANEOUS STRUCTURES OR MATERIALS. GRUB IMPROVEMENT AREAS TO REMOVE ALL BURIED VEGETATIVE MATTER AND DEBRIS TO A DEPTH OF 8" BELOW SUBGRADE. PROPERLY DISPOSE OF ALL WASTE MATERIAL. PER SECTION 203, CLEARING AND GRUBBING.
2. STREET SUBGRADE SHALL CONFORM TO SECTION 501, SUBGRADE. AREAS TO RECEIVE FILL ARE TO BE INSPECTED BY CITY OF WEST LINN PERSONNEL PRIOR TO PLACEMENT OF THE FILL. THE CONTRACTOR SHALL HAVE FILL AREAS TESTED FOR COMPACTION BY A CERTIFIED TESTING LAB IN ACCORDANCE WITH AASHTO T-191. SUCH TESTING WILL BE AT THE CONTRACTOR'S EXPENSE.
3. AGGREGATE BASE ROCK SHALL CONFORM TO SECTION 205, MATERIALS--TYPE AND USE. ODOT TM106 AND TM306C. BASE COURSE SHALL BE (1 1/2"-0) CRUSHED ROCK AND LEVELING COURSE SHALL BE (3/4"-0). CITY OF WEST LINN REQUIRES A PROOF ROLL WITH A LOADED 10 YARD DUMP TRUCK OF THE SUBGRADE PRIOR TO PLACEMENT OF THE ROCK AND AGAIN AFTER PLACEMENT OF THE BASE ROCK AND PRIOR TO PAVING. ALL UNDERGROUND UTILITIES INCLUDING LATERALS, SERVICES AND POWER OR GAS CONDUITS WILL BE IN PLACE BEFORE SUBGRADE PROOF ROLL WILL TAKE PLACE.
4. ASPHALT CONCRETE SHALL CONFORM TO THE REQUIREMENTS OF SECTION 505, ASPHALT CONCRETE PAVEMENT. 2" BASE LIFT SHALL BE CLASS 'B' A.C. AND 2" FINAL LIFT SHALL BE CLASS 'C' A.C. THE TOP LIFT OF ASPHALT CONCRETE SHALL NOT BE PLACED PRIOR TO RECEIVING PERMISSION FROM THE CITY OF WEST LINN ENGINEERING DEPARTMENT. THE DENSITY REQUIREMENT FOR ASPHALT IS 92% USE THE GREATER THICKNESS BETWEEN THE CITY OF WEST-LINN SPECIFICATIONS AND GEOTECH REPORT FOR THIS PROJECT.
5. CONSTRUCT CURB AND GUTTER USING CLASS 'A' 3300 PSI CONCRETE WITH MAXIMUM 1 1/2" AGGREGATE SIZE. CONNECTION JOINTS AT 15' MAXIMUM ON CENTERS. THREE INCH WEEPHOLES ARE TO BE INSTALLED ON ALL LOTS UPHILL OR EVEN WITH THE STREET. GENERALLY, WEEPHOLES SHALL BE LOCATED AT THE CENTER AND LOWEST EDGE OF CURB FOR EACH LOT. CURB DEPRESSIONS FOR HANDICAP RAMPS SHALL BE CENTERED BETWEEN CURB RETURNS AT INTERSECTIONS UNLESS OTHERWISE NOTED ON THE PLANS. CONTRACTOR SHALL STAMP LOCATION OF SEWER AND WATER CROSSINGS WITH AN (S) OR A (W).
6. ALL MATERIALS, INSTALLATION, TESTS, AND INSPECTIONS TO BE IN STRICT ACCORDANCE WITH CITY OF WEST LINN'S PUBLIC WORKS STANDARDS, AS REFERENCED BY SECTION.
7. A STREET CONSTRUCTION ENCROACHMENT PERMIT OR SIMILAR PERMIT MAY BE REQUIRED FROM THE CITY OF WEST LINN. CONSTRUCTION PERMIT FEES OR OTHER SIMILAR FEES OR BONDING REQUIRED OF THE CONTRACTOR WILL BE THE CONTRACTOR'S RESPONSIBILITY TO OBTAIN.

SANITARY SEWER:

0. DO NOT COMPLETE CONNECTION BETWEEN MANHOLE B-1 AND B-2 UNTIL ALL REMAINING SANITARY SEWER CONSTRUCTION FOR THE PROJECT IS COMPLETE AND TESTED PER CITY OF WEST LINN STANDARDS.
1. PIPE SHALL BE PVC SEWER PIPE CONFORMING TO ASTM D-3034-SDR 35. RUBBER GASKETS FOR PVC PIPE SHALL CONFORM TO ASTM F477.
2. MANHOLE BASE SHALL BE PRE-CAST OR POURED IN-PLACE CONCRETE BASE PER ASTM C478, AND SECTION 302, MANHOLES AND CONCRETE STRUCTURES. MANHOLE RISERS AND TOPS SHALL BE PRECAST SECTIONS WITH MINIMUM COMPRESSIVE STRENGTH OF 4000 PSI. TOPS SHALL BE ECCENTRIC CONES EXCEPT WHERE INSUFFICIENT HEADROOM REQUIRES FLAT TOPS. INVERTS SHALL BE CONSTRUCTED SO AS TO PROVIDE SMOOTH FLOW-THROUGH CHARACTERISTICS. PVC PIPE SHALL BE CONNECTED TO MANHOLE BY MEANS OF AN ELASTOMERIC GASKET, AN APPROVED WATERSTOP OR FLEXIBLE SLEEVE. CEMENT GROUT FOR CONNECTING PVC SEWER PIPE TO MANHOLE WILL NOT BE PERMITTED.
3. ALL MANHOLES LOCATED IN EASEMENT AREAS REQUIRE TAMPER PROOF LIDS. ALL MANHOLE RIMS NOT IN PAVEMENT AREA TO BE SET 12 INCHES ABOVE PROPOSED GRADE.
4. CLEANOUT PIPE, FITTINGS, AND JOINTS SHALL BE THE SAME SPECIFICATIONS AS FOR PIPE. CASTINGS ARE AS SHOWN ON DETAIL AND SHALL CONFORM TO ASTM A48 (GRADE 30). CLEANOUT RISER SHALL MATCH DOWNSTREAM PIPE DIAMETER.
5. GRANULAR BACKFILL IS TO BE COMPACTED TO 95% MAXIMUM DRY DENSITY PER AASHTO T-180 TEST METHOD AND NATIVE MATERIAL SHALL BE COMPACTED TO 85% OF IN-PLACE DRY DENSITY OF SURROUNDING SOIL. BACKFILL COMPACTION CAN BE 85% ONLY IN UNIMPROVED SURFACES OUTSIDE OF THE RIGHT-OF-WAY.
6. PVC SERVICE LATERALS SHALL BE 4" PIPE CONFORMING TO THE SAME SPECIFICATIONS AS THE SEWER MAINS. SERVICE LATERALS SHALL BE INSTALLED TO A POINT BEYOND THE LINE OF THE SEWER OR UTILITY EASEMENT AS SHOWN ON THE PLAN. THE SERVICE LATERAL SHALL BE PLUGGED WITH A 4" RUBBER RING PLUG, AND THE LOCATION OF THE LATERAL'S END MARKED WITH A 2" X 4" STAKE AND PAINTED GREEN, AND AT A SLOPE OF 2% MIN.
7. SANITARY SEWER PIPE AND APPURTENANCES SHALL BE TESTED FOR LEAKAGE IN ACCORDANCE WITH SECTION 301.03.09 TESTING. LEAKAGE TESTS WILL INCLUDE REQUIRED AIR TESTING PER SECTION 301.03.09F FOR SEWER LINES AND REQUIRED VACUUM TEST OF MANHOLES PER SECTION 302.03.07. ALL PVC PIPE SHALL BE TESTED FOR DEFLECTION. DEFLECTION SHALL BE TESTED WITH A MANDREL EQUAL TO 95% OF THE PIPE SIZE BEING TESTED. IN ADDITION, SEWER LINES SHALL BE VIDEO INSPECTED BY THE CONTRACTOR PER SECTION 301.03.11. ALL TESTS SHALL BE WITNESSED BY THE ENGINEER AND CITY PERSONNEL.
8. A PLUMBING PERMIT FROM THE CITY OF WEST LINN BUILDING DEPARTMENT IS REQUIRED FOR SANITARY SEWER LATERALS BEYOND THE FIRST CLEANOUT.
9. ALL MATERIALS, INSTALLATION, TESTS, AND INSPECTIONS TO BE MADE IN STRICT ACCORDANCE WITH CITY OF WEST LINN'S PUBLIC WORKS STANDARDS AND THE UNIFORM PLUMBING CODE.
10. THE NEW SANITARY SEWER LINE SHALL NOT BE CONNECTED TO THE CITY'S SYSTEM PRIOR TO TESTING AND APPROVAL.

STORM DRAINS:

1. PIPE MATERIAL SHALL BE ULTRARIB PVC PIPE CONFORMING TO ASTM F 794 FOR STORM DRAINS OF 24" OR LESS IN DIAMETER. WHERE REQUIRED ON CONSTRUCTION PLANS, DUCTILE IRON PIPE CENTRIFUGALLY CAST OF 60-42-10 IRON SHALL CONFORM TO ANSI A21.51 CLASS 150 OR AWWA C151, WITH PUSH-ON JOINT OR MECHANICAL JOINTS AS SPECIFIED, CONFORMING TO ANSI SPECIFICATION A21.11/AWWA C111. DUCTILE IRON PIPE SHALL BE LINED WITH CEMENT MORTAR AND SEAL COATED IN ACCORDANCE WITH ANSI STANDARD A21.4/AWWA C104.
2. GUTTER INLETS SHALL BE POURED IN-PLACE CONCRETE PER SECTION 205.02.02, PORTLAND CEMENT, WITH STEEL REINFORCEMENT PER SECTION 205.02.07 AND FRAME SHALL BE PER STANDARD DETAIL WL-602A.
3. MANHOLE BASE MAY BE POURED IN-PLACE CONCRETE OR PRECAST. MANHOLE RISERS AND TOPS SHALL BE PRECAST SECTIONS WITH A MINIMUM COMPRESSIVE STRENGTH OF 4000 PSI. TOPS SHALL BE ECCENTRIC CONES EXCEPT WHERE INSUFFICIENT HEADROOM REQUIRES FLAT TOPS. SOME OR ALL OF THE STORM DRAIN MANHOLES REQUIRED WILL BE OVERSIZED MANHOLES. INTERIOR DIMENSIONS NOTED ON THE PLANS ARE MINIMUMS. CHECK WITH MANHOLE MANUFACTURER FOR ACTUAL SIZE NEEDED FOR TYPE OF PIPE TO BE USED.
4. ALL MANHOLES LOCATED IN EASEMENT AREAS REQUIRE TAMPER PROOF LIDS. ALL MANHOLE RIMS NOT IN PAVEMENT AREA TO BE SET 12 INCHES ABOVE PROPOSED GRADE.
5. CLEANOUT PIPE, FITTINGS AND JOINTS SHALL BE THE SAME SPECIFICATION AS FOR PIPE. CASTINGS ARE SHOWN ON DETAIL AND SHALL CONFORM TO ASTM A 48 (GRADE 30). CLEANOUT RISER SHALL MATCH DOWNSTREAM PIPE DIAMETER.
6. GRANULAR BACKFILL IS TO BE COMPACTED TO 95% MAXIMUM DRY DENSITY PER AASHTO T-180 TEST METHOD AND NATIVE MATERIAL SHALL BE COMPACTED TO 85% OF IN-PLACE DRY DENSITY OF SURROUNDING SOIL. BACKFILL COMPACTION CAN BE 85% ONLY IN UNIMPROVED SURFACES OUTSIDE OF THE RIGHT-OF-WAY.
7. RIPRAP WHERE NOTED ON THE PLANS IS TO BE CLASS 100 IN ACCORDANCE WITH OREGON STATE HIGHWAY DIVISION SPECIFICATION 714.
8. STORM DRAINS SHALL BE TESTED FOR DEFLECTION WITH A MANDREL EQUAL TO 95% OF THE PIPE SIZE BEING TESTED. IN ADDITION, STORM LINES SHALL BE VIDEO INSPECTED BY THE CONTRACTOR. ALL TESTS SHALL BE WITNESSED BY THE ENGINEER AND CITY PERSONNEL, AND IN ACCORDANCE WITH SECTION 601.03.10 TESTING STORM DRAINS.
9. A PLUMBING PERMIT FROM THE CITY OF WEST LINN BUILDING DEPARTMENT IS REQUIRED FOR STORM DRAINS BEYOND THE FIRST CLEANOUT.
10. ALL MATERIALS, INSTALLATION, TESTS, AND INSPECTIONS TO BE IN STRICT ACCORDANCE WITH CITY OF WEST LINN'S PUBLIC WORKS STANDARDS.

EROSION CONTROL:

SUMMARY:

1. THE INTENT OF THE REQUIREMENT IS TO PREVENT SILTATION FROM REACHING STORM DRAIN SYSTEMS AND DRAINAGEWAYS.
2. THE MINIMUM MEASURES NEED TO BE MADE ON ALL PROJECTS.
 - A) A GRAVEL PAD, AT LEAST 50 FEET LONG, IS REQUIRED WHERE VEHICLES WILL LEAVE THE CONSTRUCTION SITE.
 - B) A SEDIMENT BARRIER IS TO BE CONSTRUCTED OF A SEDIMENT FENCE WHERE NOTED IN THE DETAILS OR WHERE SEDIMENT WILL CROSS OUTSIDE THE WORK AREA.
 - C) EROSION CONTROL MEASURES MUST BE INSTALLED AND APPROVED PRIOR TO THE START OF ANY EARTHWORK/EXCAVATION.
 - D) RIPRAP EXITS FROM ALL CULVERTS AND STORM DRAIN PIPES DRAINING INTO THE DITCHES OR SWALES. RIPRAP IS TO BE CLASS 50 RIPRAP OR LARGER OR AS NOTED ELSEWHERE IN THE PLANS.
 - E) RESEED OR COVER DISTURBED AREAS AS SOON AS IS POSSIBLE AND PRACTICAL BUT NO LATER THAN THE COMPLETION OF CONSTRUCTION ON THE OTHER PHASES OF WORK. EROSION CONTROL MEASURES MUST REMAIN IN PLACE UNTIL SEEDED AREAS SHOW GROWTH SUBSTANTIAL TO PREVENT EROSION.
 - F) EMPLOYEES FOR CONSTRUCTION SHALL PARK ON PAVED OR GRAVEL AREAS ONLY.
 - G) ALL CATCH BASINS SHALL BE CLEANED OF ANY DEBRIS PRIOR TO FINAL APPROVAL.

GENERAL:

1. APPROVAL OF THIS EROSION CONTROL (ESC) PLAN DOES NOT CONSTITUTE AN APPROVAL OF PERMANENT ROAD OR DRAINAGE DESIGN (E.G. SIZE AND LOCATION OF ROADS, PIPES, RESTRICTORS, CHANNELS, RETENTION FACILITIES, UTILITIES, ETC.)
2. THE IMPLEMENTATION OF THESE ESC PLANS AND THE CONSTRUCTION, MAINTENANCE, REPLACEMENT, AND UPGRADING OF THESE ESC FACILITIES IS THE RESPONSIBILITY OF THE APPLICANT/CONTRACTOR UNTIL ALL CONSTRUCTION IS COMPLETED AND APPROVED, AND VEGETATION OF LANDSCAPING IS ESTABLISHED.
3. THE ESC FACILITIES ON THIS PLAN MUST BE CONSTRUCTED IN CONJUNCTION WITH ALL CLEARING AND GRADING ACTIVITIES, AND IN SUCH A MANNER AS TO ENSURE THAT SEDIMENT LADEN WATER DOES NOT ENTER THE DRAINAGE SYSTEM OR VIOLATE APPLICABLE WATER STANDARDS.
4. THE ESC FACILITIES SHOWN ON THIS PLAN ARE THE MINIMUM REQUIREMENTS FOR ANTICIPATED SITE CONDITIONS. DURING THE CONSTRUCTION PERIOD, THESE ESC FACILITIES SHALL BE UPGRADED AS NEEDED FOR UNEXPECTED STORM EVENTS AND TO ENSURE THAT SEDIMENT LADEN WATER DOES NOT LEAVE THE SITE.
5. THE ESC FACILITIES SHALL BE INSPECTED DAILY BY THE APPLICANT/CONTRACTOR AND MAINTAINED AS NECESSARY TO ENSURE THEIR CONTINUED FUNCTIONING.
6. THE ESC FACILITIES ON INACTIVE SITES SHALL BE INSPECTED AND MAINTAINED A MINIMUM OF ONCE EVERY TWO WEEKS, OR WITHIN 24 HOURS FOLLOWING A STORM EVENT.

GENERAL (CONT.):

7. AT NO TIME SHALL SEDIMENT BE ALLOWED TO ACCUMULATE MORE THAN 1/3 THE BARRIER HEIGHT. ALL CATCH BASINS AND CONVEYANCE LINES SHALL BE CLEANED PRIOR TO PAVING. THE CLEANING OPERATIONS SHALL NOT FLUSH SEDIMENT-LADEN WATER INTO THE DOWNSTREAM SYSTEM. SEDIMENTS BASINS MUST BE CLEANED WHEN THE SEDIMENT RETENTION CAPACITY IS REDUCED BY 50%.
8. STABILIZED CONSTRUCTION ENTRANCES SHALL BE INSTALLED AT THE BEGINNING OF CONSTRUCTION AND MAINTAINED FOR THE DURATION OF THE PROJECT. ADDITIONAL MEASURES MAY BE REQUIRED TO ENSURE THAT ALL PAVED AREAS ARE KEPT CLEAN FOR THE DURATION OF THE PROJECT.
9. THE BOUNDARIES OF THE CLEARING LIMITS SHOWN ON THIS PLAN SHALL BE CLEARLY FLAGGED IN THE FIELD PRIOR TO CONSTRUCTION. DURING THE CONSTRUCTION PERIOD, NO DISTURBANCE BEYOND THE FLAGGED CLEARING LIMITS SHALL BE PERMITTED. THE FLAGGING SHALL BE MAINTAINED BY THE APPLICANT/CONTRACTOR FOR THE DURATION OF CONSTRUCTION.

GENERAL GRADING AND EROSION CONTROL

1. CLEAN WASTE MATERIAL EXCAVATED FROM ROAD CUT OR TRENCHING AREAS NOT USED IN STREET FILL AREAS MAY BE SPREAD EVENLY ACROSS LOT AREAS IN DEPTHS OF LESS THAN ONE FOOT, EXCEPT WHERE NOTED OTHERWISE ON THE PLANS.
2. DURING CONSTRUCTION, CUTOFF TRENCHES OR SOME OTHER METHOD OF RUNOFF CONTROL SHALL BE USED TO PREVENT EROSION AND/OR SILTATION FROM CROSSING OUTSIDE THE WORK AREA BOUNDARIES.
3. LARGE ORGANIC MATERIAL, MISCELLANEOUS PIPE OR CONSTRUCTION MATERIAL MUST BE REMOVED FROM THE SITE AND DISPOSED OF PROPERLY.
4. NO FILLING OR CUTTING SHALL BE DONE OUTSIDE OF APPROVED GRADING AREAS, INCLUDING SPREADING OVER LOTS.
5. ALL EROSION CONTROL FACILITIES SHALL MEET THE REQUIREMENTS OF THE CLACKAMAS COUNTY DEPARTMENT OF WATER ENVIRONMENT SERVICES, EROSION PREVENTION AND SEDIMENT CONTROL PLANNING AND DESIGN MANUAL, REVISED DECEMBER, 2000 AND THE OREGON ADMINISTRATIVE RULES.
6. EROSION CONTROL MEASURES DURING CONSTRUCTION SHALL BE GOVERNED BY CLACKAMAS COUNTY EROSION CONTROL STANDARDS.

SEEDING/MULCHING

1. ALL AREAS DISTURBED DURING CONSTRUCTION TO BE GRADED TO DRAIN AND COMPACTED TO A MINIMUM OF 90% OF AASHTO T-180 IMMEDIATELY AFTER INSTALLATION OF UTILITIES OR GRADING.
2. RECOMMENDED SEED MIXTURE: 80% ELKA DWARF PERENNIAL RYEGRASS AND 20% CREEPING RED FESCUE, BY WEIGHT. APPLICATION RATE SHALL BE 100 POUNDS MINIMUM PER ACRE.
3. FERTILIZER SHALL BE 12-16-8 WITH 50% OF THE NITROGEN DERIVED FROM UREA FORMALDEHYDE, AND APPLIED AT A RATE OF 400 POUNDS PER ACRE.
4. SEED AND MULCH AT A RATE OF 2000 LBS/AC WITH HEAVY BONDING AGENT OR NETTING AND ANCHORS. MULCH SHALL BE A WOOD CELLULOSE FIBER OR OTHER MATERIAL SUITABLE FOR HYDOMULCHING.
5. TEMPORARY OR PERMANENT HYDROSEEDING ARE ACCEPTABLE SEEDING AND MULCHING MUST BE PROVIDED WHENEVER PERENNIAL COVER CANNOT BE ESTABLISHED ON SITES WHICH WILL BE EXPOSED FOR 60 DAYS OR MORE.

SEDIMENT FENCE:

1. THE FILTER FABRIC SHALL BE PURCHASED IN A CONTINUOUS ROLL CUT TO THE LENGTH OF THE BARRIER TO AVOID USE OF JOINTS. WHEN JOINTS ARE NECESSARY, FILTER CLOTH SHALL BE SPICED TOGETHER ONLY AT A SUPPORT POST, WITH A MINIMUM 6-INCH OVERLAP, AND BOTH ENDS SECURELY FASTENED TO THE POST.
2. THE FILTER FABRIC FENCE SHALL BE INSTALLED TO FOLLOW THE CONTOURS, WHERE FEASIBLE. THEN FENCE POSTS SHALL BE SPACED A MAXIMUM OF SIX FEET APART AND DRIVEN SECURELY INTO THE GROUND A MINIMUM OF 18 INCHES.
3. A TRENCH SHALL BE EXCAVATED, ROUGHLY 6 INCHES WIDE BY 6 INCHES DEEP, DOWNSLOPE AND ADJACENT TO THE WOOD POST TO ALLOW THE FILTER FABRIC TO BE BURIED. BURY THE BOTTOM OF THE FABRIC 6" VERTICALLY BELOW FINISHED GRADE. ALL AREAS OF FILTER FABRIC TRENCH SHALL BE COMPACTED.
4. THE FILTER FABRIC SHALL BE INSTALLED WITH STITCHED LOOPS OVER FENCE POSTS. THE FENCE POST SHALL BE CONSTRUCTED OF 2" X 2" FIR, PINE, OR STEEL. THE FENCE POST MUST BE A MINIMUM OF 48" LONG. THE FILTER FABRIC SHALL NOT BE STAPLED OR ATTACHED TO EXISTING TREES.
5. SEDIMENT FENCES SHALL BE REMOVED WHEN THEY HAVE SERVED THEIR USEFUL PURPOSE, BUT NOT BEFORE THE UPSLOPE AREA HAS BEEN PERMANENTLY STABILIZED.
6. SEDIMENT FENCES SHALL BE INSPECTED BY APPLICANT/CONTRACTOR IMMEDIATELY AFTER EACH RAINFALL, AND AT LEAST DAILY DURING PROLONGED RAINFALL. ANY REQUIRED REPAIRS SHALL BE MADE IMMEDIATELY.

CONDITIONS OF APPROVAL:

1. THE APPLICANT SHALL CONNECT THE PUBLIC WATER LINES FROM PARKER ROAD AND YORK STREET THROUGH THE PROPOSED PUBLIC PEDESTRIAN EASEMENT AREA.
2. THE APPLICANT SHALL PROTECT TREE #1382, AS IDENTIFIED IN THE SITE PLAN, IN ADDITION TO THE OTHER TREES TO BE PROTECTED. THE APPLICANT SHALL PLANT A NUMBER OF ADDITIONAL TREES, 8-10 FEET IN HEIGHT, WITH A COMBINED DBH DIAMETER OF 24 INCHES (THE DIAMETER OF TREE #1410 TO BE REMOVED), AND OF A SPECIES AND IN A LOCATION APPROVED BY THE WEST LINN CITY ARBORIST.
3. THE APPLICANT SHALL EXTEND FULL HALF-STREET IMPROVEMENTS ALONG LANCASTER STREET TO INCLUDE THE FRONTAGE OF THE PROPERTY AT 2799 LANCASTER STREET.
4. THE APPLICANT SHALL RECORD A PUBLIC PEDESTRIAN EASEMENT ALONG THE DRIVEWAY CONNECTING THE PEDESTRIAN PATHWAY TO SUMMER RUN (IN ADDITION TO THE EASEMENT OVER THE AREA OF THE PATHWAY ITSELF). THE APPLICANT SHALL PLACE A SIGN AT THE ENTRANCE TO THE SUMMER RUN COMMON DRIVEWAY IDENTIFYING THE DRIVEWAY AS A PEDESTRIAN ACCESS OPEN TO PUBLIC USE.
5. FINAL PLANS FOR THE PEDESTRIAN PATHWAY SHALL ELIMINATE THE PROPOSED STAIRWAY AND REALLOCATE THE ADDITIONAL GRADE CHANGE ALONG THE REST OF THE PROPOSED PATHWAY. THE EXCLUSIVELY PEDESTRIAN PORTION OF THE PATHWAY SHALL BE PAVED WITH A PERMEABLE SURFACE DESIGNED TO DISCOURAGE SKATEBOARDING AND REDUCE THE DRAINAGE IMPACTS OF IMPERVIOUS SURFACES.
6. THE APPLICANT SHALL DEDICATE ADDITIONAL RIGHT OF WAY AT THE END OF YORK STREET SO THAT THE ENTIRE FIRE TURNAROUND AREA REQUIRED BY CDC 85.200(A)(11) IS WITHIN PUBLIC RIGHT OF WAY.
7. THE LOCATION OF THE SANITARY SEWER LINE SERVING LOTS ALONG PARKER ROAD AND SUMMER RUN SHALL BE DETERMINED WITH REGARD AS TO THE PHYSICAL CONSTRAINTS OF THE SITE IN CONSULTATION WITH THE CITY ENGINEER AND IN ACCORDANCE WITH THE CITY OF WEST LINN DESIGN AND CONSTRUCTION STANDARDS.
8. THE PUBLIC SANITARY SEWER LINE SERVING LOTS TAKING ACCESS FROM YORK STREET SHALL END AT THE EDGE OF THE PUBLIC RIGHT OF WAY, AND ALL LINES BEYOND THIS POINT SHALL BE PRIVATELY OWNED AND MAINTAINED.
9. PUBLIC ACCESS EASEMENTS ACCESSIBLE BY CITY MAINTENANCE VEHICLES SHALL BE PROVIDED FOR ALL SANITARY SEWER MANHOLES.
10. THE STORM PIPE IN PARKER ROAD SHALL BE EXTENDED TO THE INTERSECTION OF PARKER AND LANCASTER, ENDING WITH A MANHOLE, AND ALSO PROVIDING A CATCHBASIN ON LANCASTER STREET.
11. THE APPLICANT SHALL DEDICATE A STORM WATER EASEMENT FOR THE STORM PIPE ON LOTS 1 AND 2, PROVIDING ACCESS FOR MAINTENANCE AND REPAIR OF THE PUBLIC LINE.
12. THE APPLICANT SHALL MODIFY THE CAPACITY OF THE STORM DETENTION AND TREATMENT SYSTEMS TO ACCOUNT FOR THE INCREASED RUNOFF FROM IMPROVEMENTS TO LANCASTER STREET, PARKER ROAD, AND SUMMER RUN DRIVE.
13. THE APPLICANT SHALL PROVIDE SEPARATE PRIVATE WATER SERVICE LINES FOR EACH INDIVIDUAL LOT, CONNECTING TO THE PUBLIC SYSTEM.
14. THE APPLICANT MUST DEMONSTRATE ADEQUATE ACCESS TO THE STORM DETENTION AND TREATMENT FACILITIES BY CITY UTILITY VEHICLES FOR MAINTENANCE, AND MUST ALSO PROVIDE FENCING AND LINING FOR WALLS PROTECTING ADJACENT PUBLIC STREETS.
15. THE APPLICANT SHALL CREATE FOUR GUEST PARKING SPACES, TWO ON THE PRIVATE DRIVE FROM SUMMER RUN, AND TWO ACCESSED FROM YORK STREET, WITHIN THE DEVELOPMENT, NOT WITHIN PUBLIC RIGHT-OF-WAY. THE SPACES MAY BE EITHER PARALLEL OR PERPENDICULAR, BUT MUST BE MARKED AS "GUEST SPACES AND MUST BE INCLUDED WITHIN DESIGNATED COMMON SHARED ACCESS EASEMENT AREA."
16. ALL PUBLIC IMPROVEMENTS MUST BE IN ACCORDANCE WITH THE CITY OF WEST LINN AND CONSTRUCTION STANDARDS, PROFESSIONAL ENGINEERING STANDARDS, AND ACCEPTED INDUSTRY STANDARD CONSTRUCTION PRACTICE. WHERE CONFLICT BETWEEN STANDARDS EXISTS, THE MOST STRINGENT WILL APPLY UNLESS ALLOWED BY THE CITY ENGINEER.
17. THE APPLICANT SHALL SUBMIT A LANDSCAPING PLAN FOR THE STORM DETENTION FACILITY AT THE CORNER OF LANCASTER AND PARKER TO THE SATISFACTION OF THE CITY ENGINEER AND THE PLANNING DIRECTOR DESIGNED TO PRESENT AN AESTHETICALLY ATTRACTIVE PRESENCE AT THE CORNER.

WEST LINN CASEFILE SUB05-03 / ZC05-05 / VAR05-03

CONSTRUCTION & EROSION CONTROL NOTES

SIENNA'S ESTATES

City of West Linn, Clackamas County, Oregon

SAM L PAP

2799 LANCASTER STREET
WEST LINN, OREGON 97068
(503) 888-2264

LANPACIFIC

CIVIL ENGINEERING

DEVELOPMENT

CONSULTING

LANDSCAPE

ARCHITECTURE

5125 SW Macadam, Suite 140, Portland, Oregon 97239
503 | 238-2097 FAX: 503 | 238-2447
www.lanpacific.com



EXP. 12/31/09

RECORD
DRAWING

01/18/08

THESE RECORD DRAWINGS HAVE BEEN PREPARED, IN PART, ON THE BASIS OF INFORMATION COMPILED AND FURNISHED BY THE CONTRACTOR. ISSUED CONSTRUCTION PLANS, AND FIELD OBSERVATIONS DURING CONSTRUCTION.

DATE	I	01/18/08
DRAWN	I	JSE
DESIGNED	I	JSE
CHECKED	I	RGN
PROJECT #	I	SLP04-001


SHEET TITLE

CONST. AND EROS.
CONTROL NOTES

SHEET NUMBER

C002

ASBUILT CONSTRUCTION DOCUMENTS

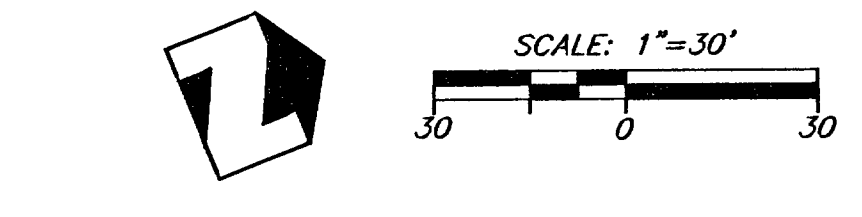

EXISTING UTILITY NOTES:

STORM DRAINAGE:

- (F) CATCH BASIN: RIM=540.19
IE 12" (SW) OUT=535.04
IE 10" (W) IN =535.04
SUMP = 533.49
- (G) CATCH BASIN: RIM=540.33
IE 10" (E) OUT=535.53
IE 4" W.H. =538.13
SUMP = 533.73
- (H) CATCH BASIN: RIM=540.45
IE 12" CPP (NW)=536.25
- (J) CATCH BASIN: RIM=542.80,
- (K) CATCH BASIN: RIM=544.83
IE 12" (W) OUT= 539.68
IE 12" (S)= 539.83
SUMP= 539.33
- (L) CATCH BASIN: RIM=552.64
IE 12" (N) OUT= 550.21
- (M) 8" CPP OUTLET: IE = 581.15
- (N) CATCH BASIN: RIM=582.45
IE 8" (N) OUT=
- (P) 12" CONCRETE OUTFALL: IE 558.23
- (R) STORM MANHOLE: RIM=541.40
IE 15" (NE) IN=534.70
IE 12" (SW) IN=535.20


SANITARY SEWER:

- ② SANITARY MANHOLE: RIM=541.26
IE 8" (S) IN=532.81
IE 4" (NE) LAT. =532.81
IE 4" (E) LAT. =532.81
IE 8" (W) OUT =532.16
- ③ SANITARY MANHOLE: RIM=588.74
IE 6" (NW) LAT. =583.74
IE 6" (NW) LAT. =582.34
IE IN/LAT. =582.19
IE 8" (E) OUT =582.04
- ④ SANITARY MANHOLE: RIM=573.26



EXISTING CONDITIONS PLAN
SIENNA'S ESTATES
City of West Linn, Clackamas County, Oregon

SAM L PAB
2799 LANCASTER STREET
WEST LINN, OREGON 97068
(503) 888-2254

CH. ENGINEERING
ARCHITECT
LANDSCAPE
ARCHITECTURE
LANPACIFIC
5122 SW Macadam, Suite 140, Portland, Oregon 97239
503 238-2097 FAX: 503 238-2447
www.lanpacific.com

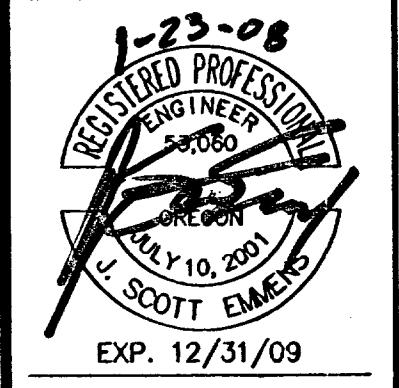

RECORD DRAWING
01/18/08
THESE RECORD DRAWINGS HAVE BEEN PREPARED, IN PART, ON THE BASIS OF INFORMATION COMPILED AND FURNISHED BY THE CONTRACTOR, REVISED CONSTRUCTION PLANS, AND FIELD OBSERVATIONS DURING CONSTRUCTION.
DATE 01/18/08
DRAWN JSE
DESIGNED JSE
CHECKED RGN
PROJECT SLP04-001
SHEET TITLE
EXISTING CONDITIONS PLAN
SHEET NUMBER
C003

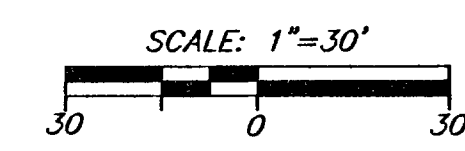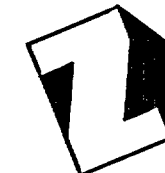

SITE DEMOLITION NOTES:

- ① EXISTING TREE TO BE REMOVED.
 - ② EXISTING TREE TO REMAIN AND BE PROTECTED DURING ALL PHASES OF CONSTRUCTION.
 - ③ EXISTING RESIDENCE TO REMAIN.
 - ④ EXISTING GRAVEL DRIVEWAY TO BE REMOVED.
 - ⑤ EXISTING RESIDENTIAL CONCRETE WORK TO BE REMOVED.
 - ⑥ EXISTING WELL TO BE ABANDONED AND PROPER CERTIFICATIONS FILED WITH JURISDICTION.
 - ⑦ EXISTING CONCRETE SLAB TO BE REMOVED.
 - ⑧ EXISTING SIGN TO BE REMOVED.
 - ⑨ EXISTING MAILBOX TO BE REPLACED WITH NEW SUBDIVISION MAIL LOCK BOX FOR ALL HOMES. COORDINATE WITH THE UNITED STATES POSTAL SERVICE.
 - ⑩ EXISTING TRAFFIC DELINEATORS TO BE REMOVED AND REPLACED PER CITY DIRECTION AND ODOT DETAIL STD. SPECIFICATION 00225.13(c).
 - ⑪ EXISTING FENCE TO BE REMOVED.
 - ⑫ EXISTING OUTBUILDING TO BE REMOVED.
 - ⑬ EXISTING POWER POLE GUYS TO BE RELOCATED OR ADJUSTED AS NECESSARY BY PORTLAND GENERAL ELECTRIC. CONTRACTOR TO COORDINATE ADJUSTMENT OR RELOCATION WITH P.G.E. PRIOR TO WORK COMMENCEMENT.
 - ⑭ EXISTING POWER POLE TO BE REMOVED BY PORTLAND GENERAL ELECTRIC. CONTRACTOR TO COORDINATE REMOVAL WITH P.G.E. PRIOR TO WORK COMMENCEMENT.
 - ⑮ EXISTING OVERHEAD POWER LINE TO BE ABANDONED AND REMOVED BY PORTLAND GENERAL ELECTRIC. CONTRACTOR TO COORDINATE DESERVING AND REMOVAL WITH P.G.E. PRIOR TO WORK COMMENCEMENT.
 - ⑯ EXISTING HOUSE ELECTRICAL METER TO BE MOVED TO FRONT OF HOUSE OR WITHIN 10 FEET OF FRONT ON SIDE. CONTRACTOR TO COORDINATE WITH PROPERTY OWNERS AND PGE.
 - ⑰ INSTALL TREE PROTECTION FENCING. FENCING NEEDS TO BE ATTACHED TO A 7-FOOT TALL STEEL FENCE POSTS PLACED EIGHT FEET APART ON CENTER FORMING A PROTECTIVE LINE AROUND THE PRESERVED TREES AND FENCE POSTS NEED TO BE SECURELY ANCHORED IN THE SOIL TO A DEPTH OF TWO FEET.
- ONCE THE FENCE HAS BEEN ESTABLISHED IT CANNOT BE ADJUSTED OR REMOVED WITHOUT THE CONSENT OF THE CONSULTING ARBORISTS. THE FENCING, AS DESCRIBED, WILL NEED TO BE MAINTAINED THROUGHOUT THE ENTIRETY OF THE PROJECT.
- ⑱ POWER TO REMAIN IN SERVICE DURING CONSTRUCTION. COORDINATE TEMPORARY POWER POLES/SOURCE WITH PGE AND PROPERTY OWNER.
 - ⑲ EXISTING WATER SERVICE LINES FOR TAX LOT 2500 AND TAX LOT 2502 ARE TO BE REMOVED AND REPLACED WITH NEW SERVICE LINE TIED TO NEW 6" WATER LINE PER SHEET C014. COORDINATE WITH WATER DEPT. AND PROPERTY OWNER.
 - ⑳ PVC PIPE FOR OVERHEAD POWER TO BE REMOVED. COORDINATE WITH PGE FOR CONTINUED SERVICE TO EXISTING HOMES.



WEST LINN CASEFILE SUB05-03 / ZC05-05 / VAR05-03

DEMOLITION PLAN

SIENNA'S ESTATES

City of West Linn, Clackamas County, Oregon


SAM L PAP

2789 LANCASTER STREET
WEST LINN, OREGON 97068
(503) 888-2254

CIVIL ENGINEERING
ARCHITECTURE
CONSULTING
LANDSCAPE ARCHITECTURE



5125 SW Macadam, Suite 140, Portland, Oregon 97239
TEL: 503 238-2097 FAX: 503 238-2447
www.lanpacific.com

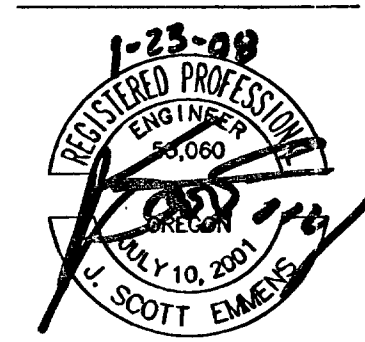

RECORD DRAWING
01/18/08


THESE RECORD DRAWINGS HAVE BEEN PREPARED, IN PART, ON THE BASIS OF INFORMATION OBTAINED AND FURNISHED BY THE CONTRACTOR. REVISED CONSTRUCTION PLANS, AND FIELD OBSERVATIONS DURING CONSTRUCTION.

DATE	01/18/08
DRAWN	JSE
DESIGNED	JSE
CHECKED	RGN
PROJECT #	SLP04-001

SHEET TITLE
DEMOLITION PLAN

SHEET NUMBER
C004

ASBUILT CONSTRUCTION DOCUMENTS

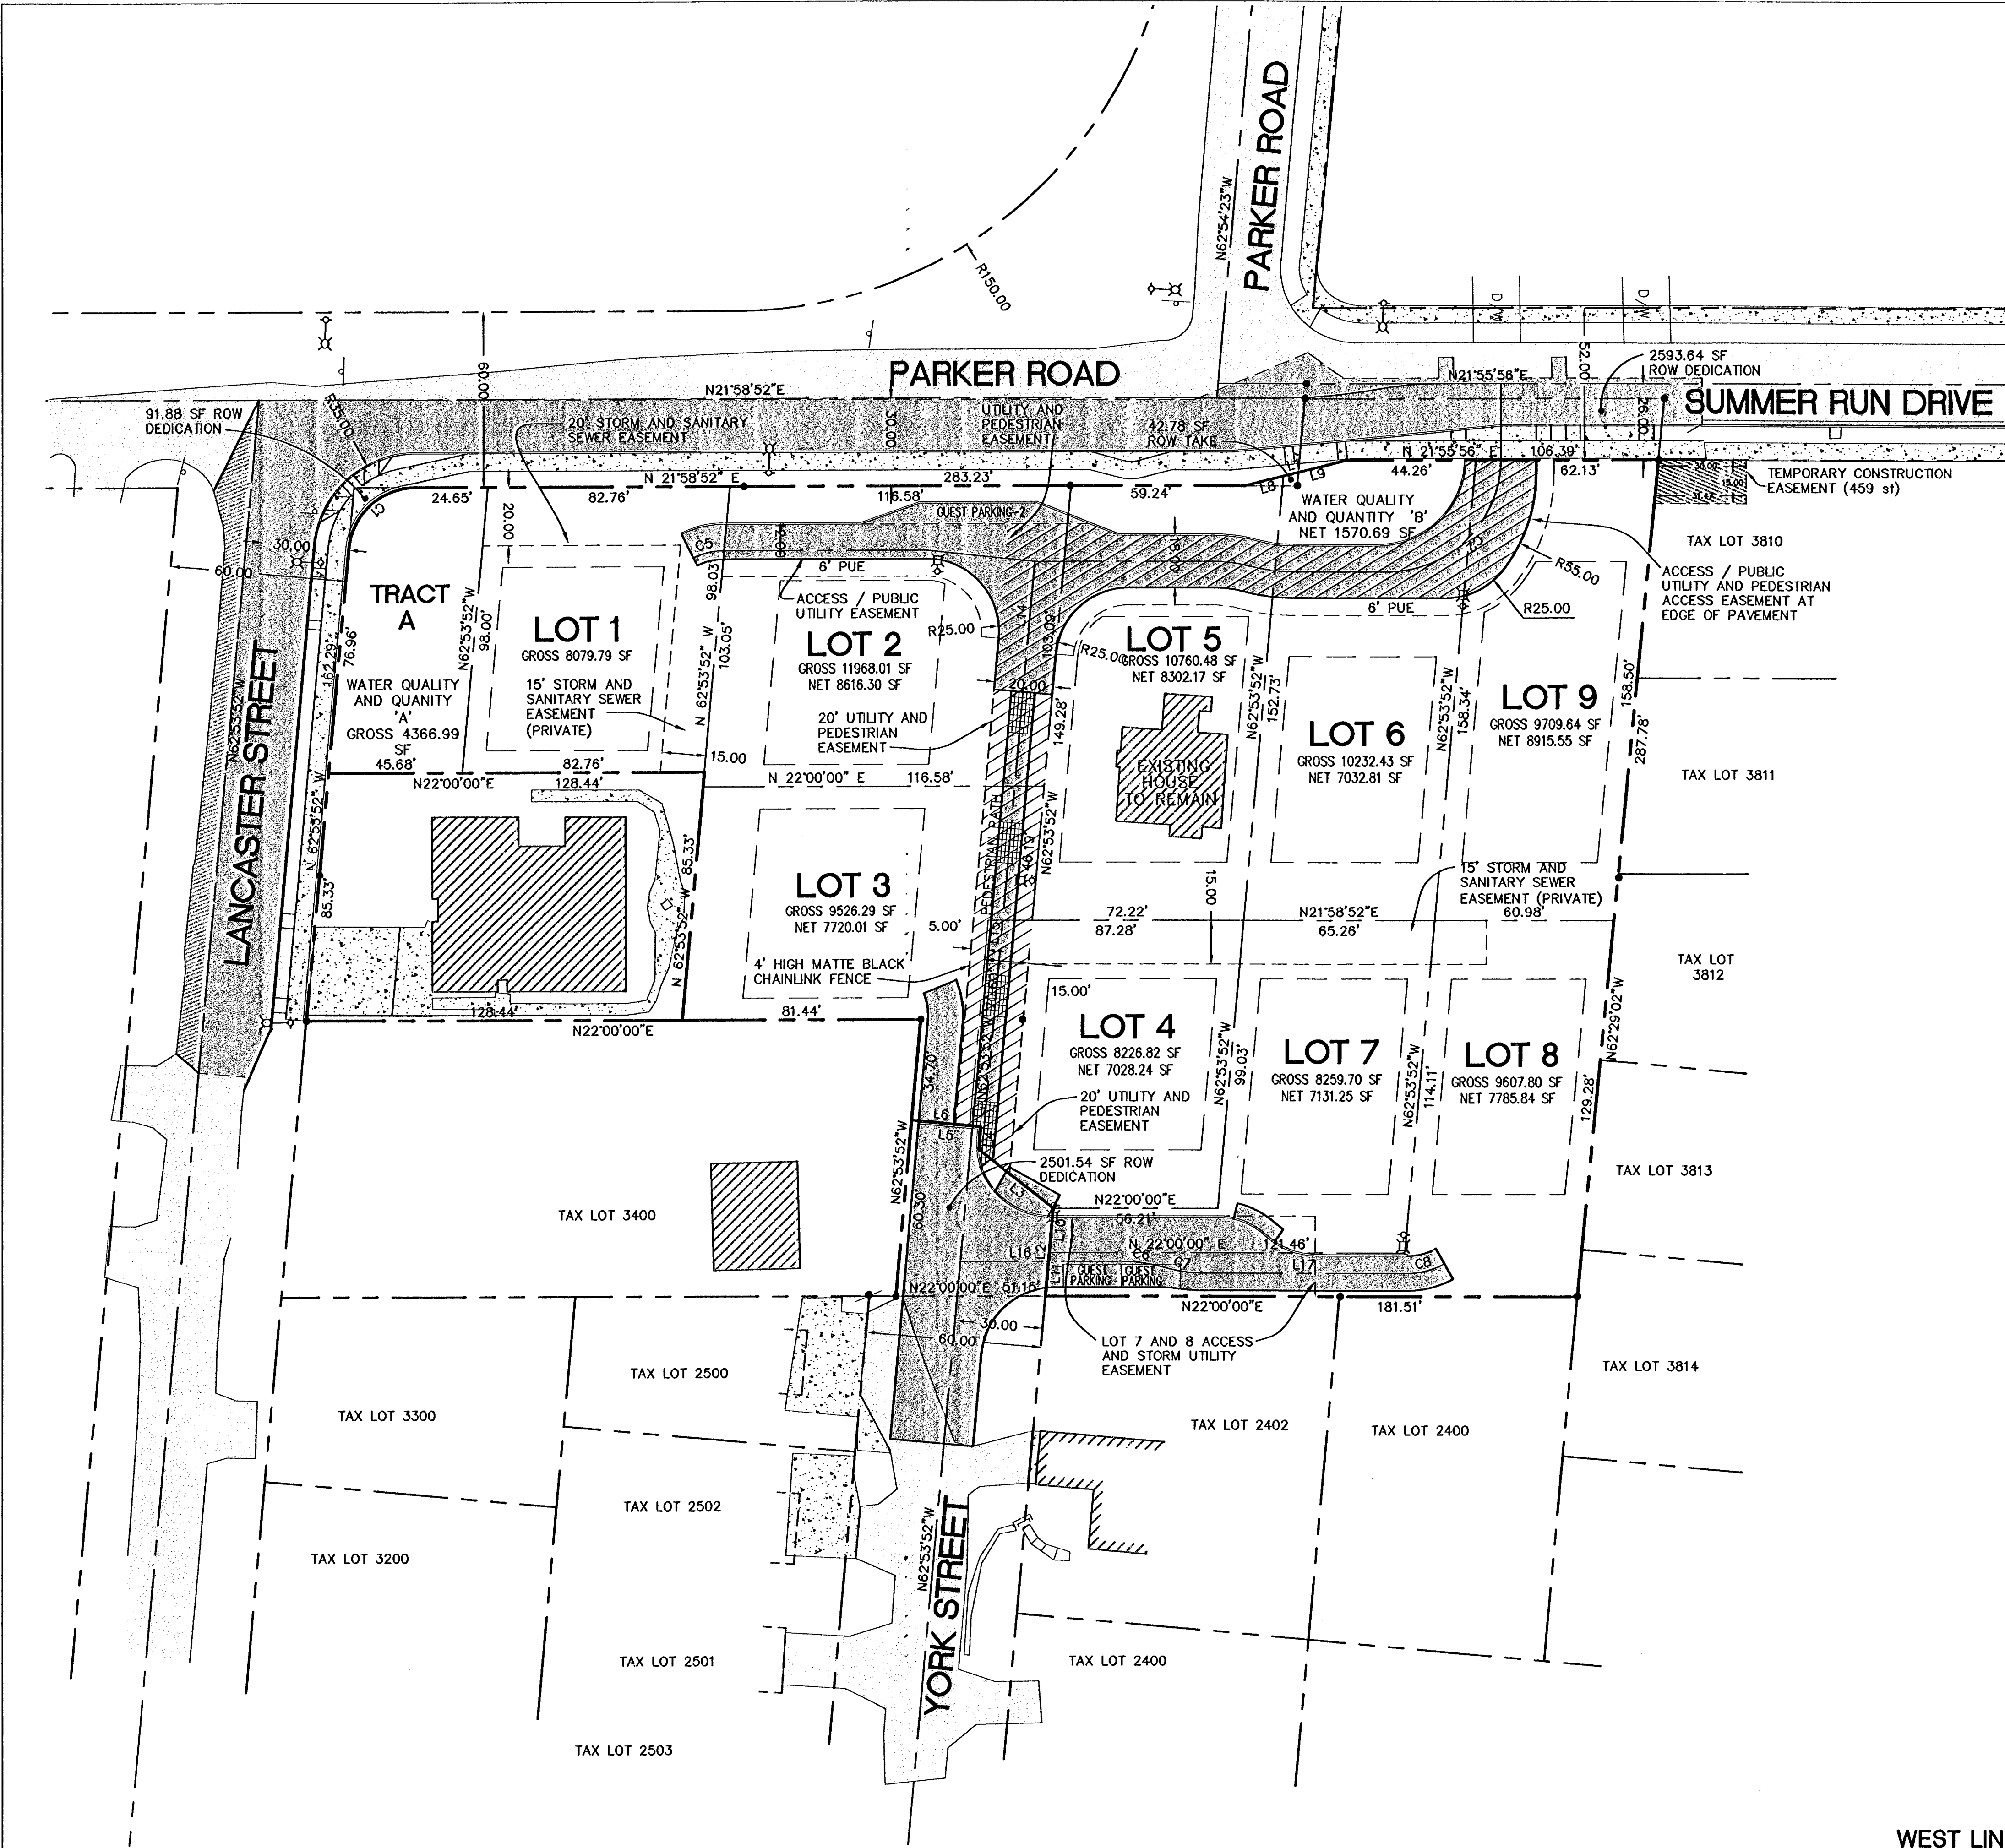

SCALE: 1"=30'

30 0 30

LEGEND

EXISTING ASPHALTIC SURFACE

EXISTING BOUNDARY

EXISTING RIGHT-OF-WAY

PROPOSED ASPHALTIC SURFACE

PROPOSED SETBACK LINE

PROPOSED LOT LINE

8' PUE


8' PUBLIC UTILITY EASEMENT

PROPOSED PEDESTRIAN ACCESS EASEMENT

STREET LIGHT, SEE SHEET C013 FOR DETAILS

CURVE TABLE						
CURVE	DELTA	RADIUS	LENGTH	TANGENT	CHORD BRG	CHORD
C1	84°52'44"	23.00	34.07	21.03	S20°27'30"E	31.04
C2	90°02'56"	39.00	61.29	39.03	N23°02'36"W	55.18
C3	23°04'18"	50.00	20.13	10.21	N33°31'01"E	20.00
C4	23°04'18"	50.00	20.13	10.21	S33°31'01"W	20.00
C5	26°25'38"	23.00	10.61	5.40	S08°46'03"W	10.51
C6	16°15'37"	56.00	15.89	8.00	S30°07'48"W	15.84
C7	16°15'37"	44.00	12.49	6.29	N30°07'48"E	12.45
C8	29°06'39"	26.00	13.21	6.75	N07°26'41"E	13.07

LINE TABLE		
LINE	LENGTH	BEARING
L1	35.94	N07°29'27"E
L2	30.12	N62°53'52"W
L3	32.49	S60°18'00"W
L4	7.85	N62°53'52"W
L5	23.77	S27°06'08"W
L6	20.00	N27°06'08"E
L7	3.77	N27°06'08"E
L8	13.73	N07°29'27"E
L9	22.21	N07°29'27"E
L10	15.06	N62°53'52"W
L11	15.06	N62°53'52"W
L12	33.43	N21°58'52"E
L13	154.05	N21°58'52"E
L14	49.44	N62°53'52"W
L15	162.85	N62°53'52"W
L16	54.13	N22°00'00"E
L17	70.57	N22°00'00"E

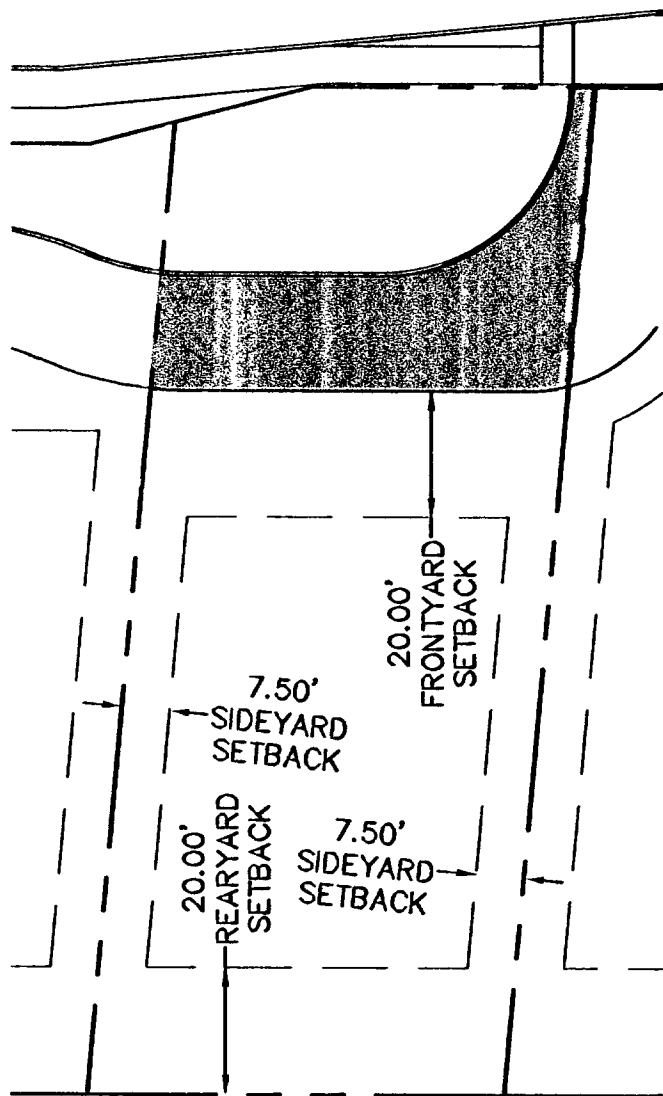

TYPICAL SETBACKS
NOT TO SCALE

PRELIMINARY PLAT AND SITE PLAN
SIENNA'S ESTATES
City of West Linn, Clackamas County, Oregon

SAM L. PAP
2799 LANCASTER STREET
WEST LINN, OREGON 97068
(503) 888-2254

CIVIL ENGINEERING
DEVELOPMENT
CONSULTING
LANDSCAPE
ARCHITECTURE

LANPACIFIC

5125 SW Macadam, Suite 140, Portland, Oregon 97209
TEL: 503.1238-2097 FAX: 503.1238-2447
www.lanpacific.com

REGISTERED PROFESSIONAL ENGINEER
NO. 12345
STATE OF OREGON
EXPIRATION DATE: 12/31/09
SCOTT E. EMERY



RECORD DRAWING
01/18/08

THESE RECORD DRAWINGS HAVE BEEN PREPARED, IN PART, ON THE BASIS OF INFORMATION COMPILED AND FURNISHED BY THE CONTRACTOR. REVISIONS TO CONSTRUCTION PLANS AND FIELD OBSERVATIONS DURING CONSTRUCTION.

DATE 01/18/08
DRAWN JSE
DESIGNED JSE
CHECKED RGN
PROJECT # SLP04-001

SHEET TITLE
PRELIMINARY PLAT AND SITE PLAN
SHEET NUMBER

C005

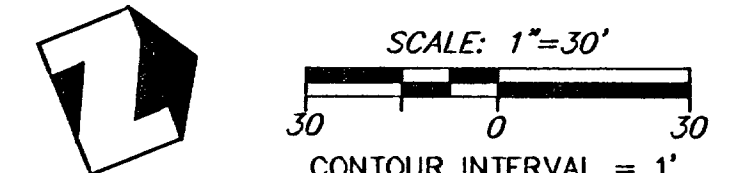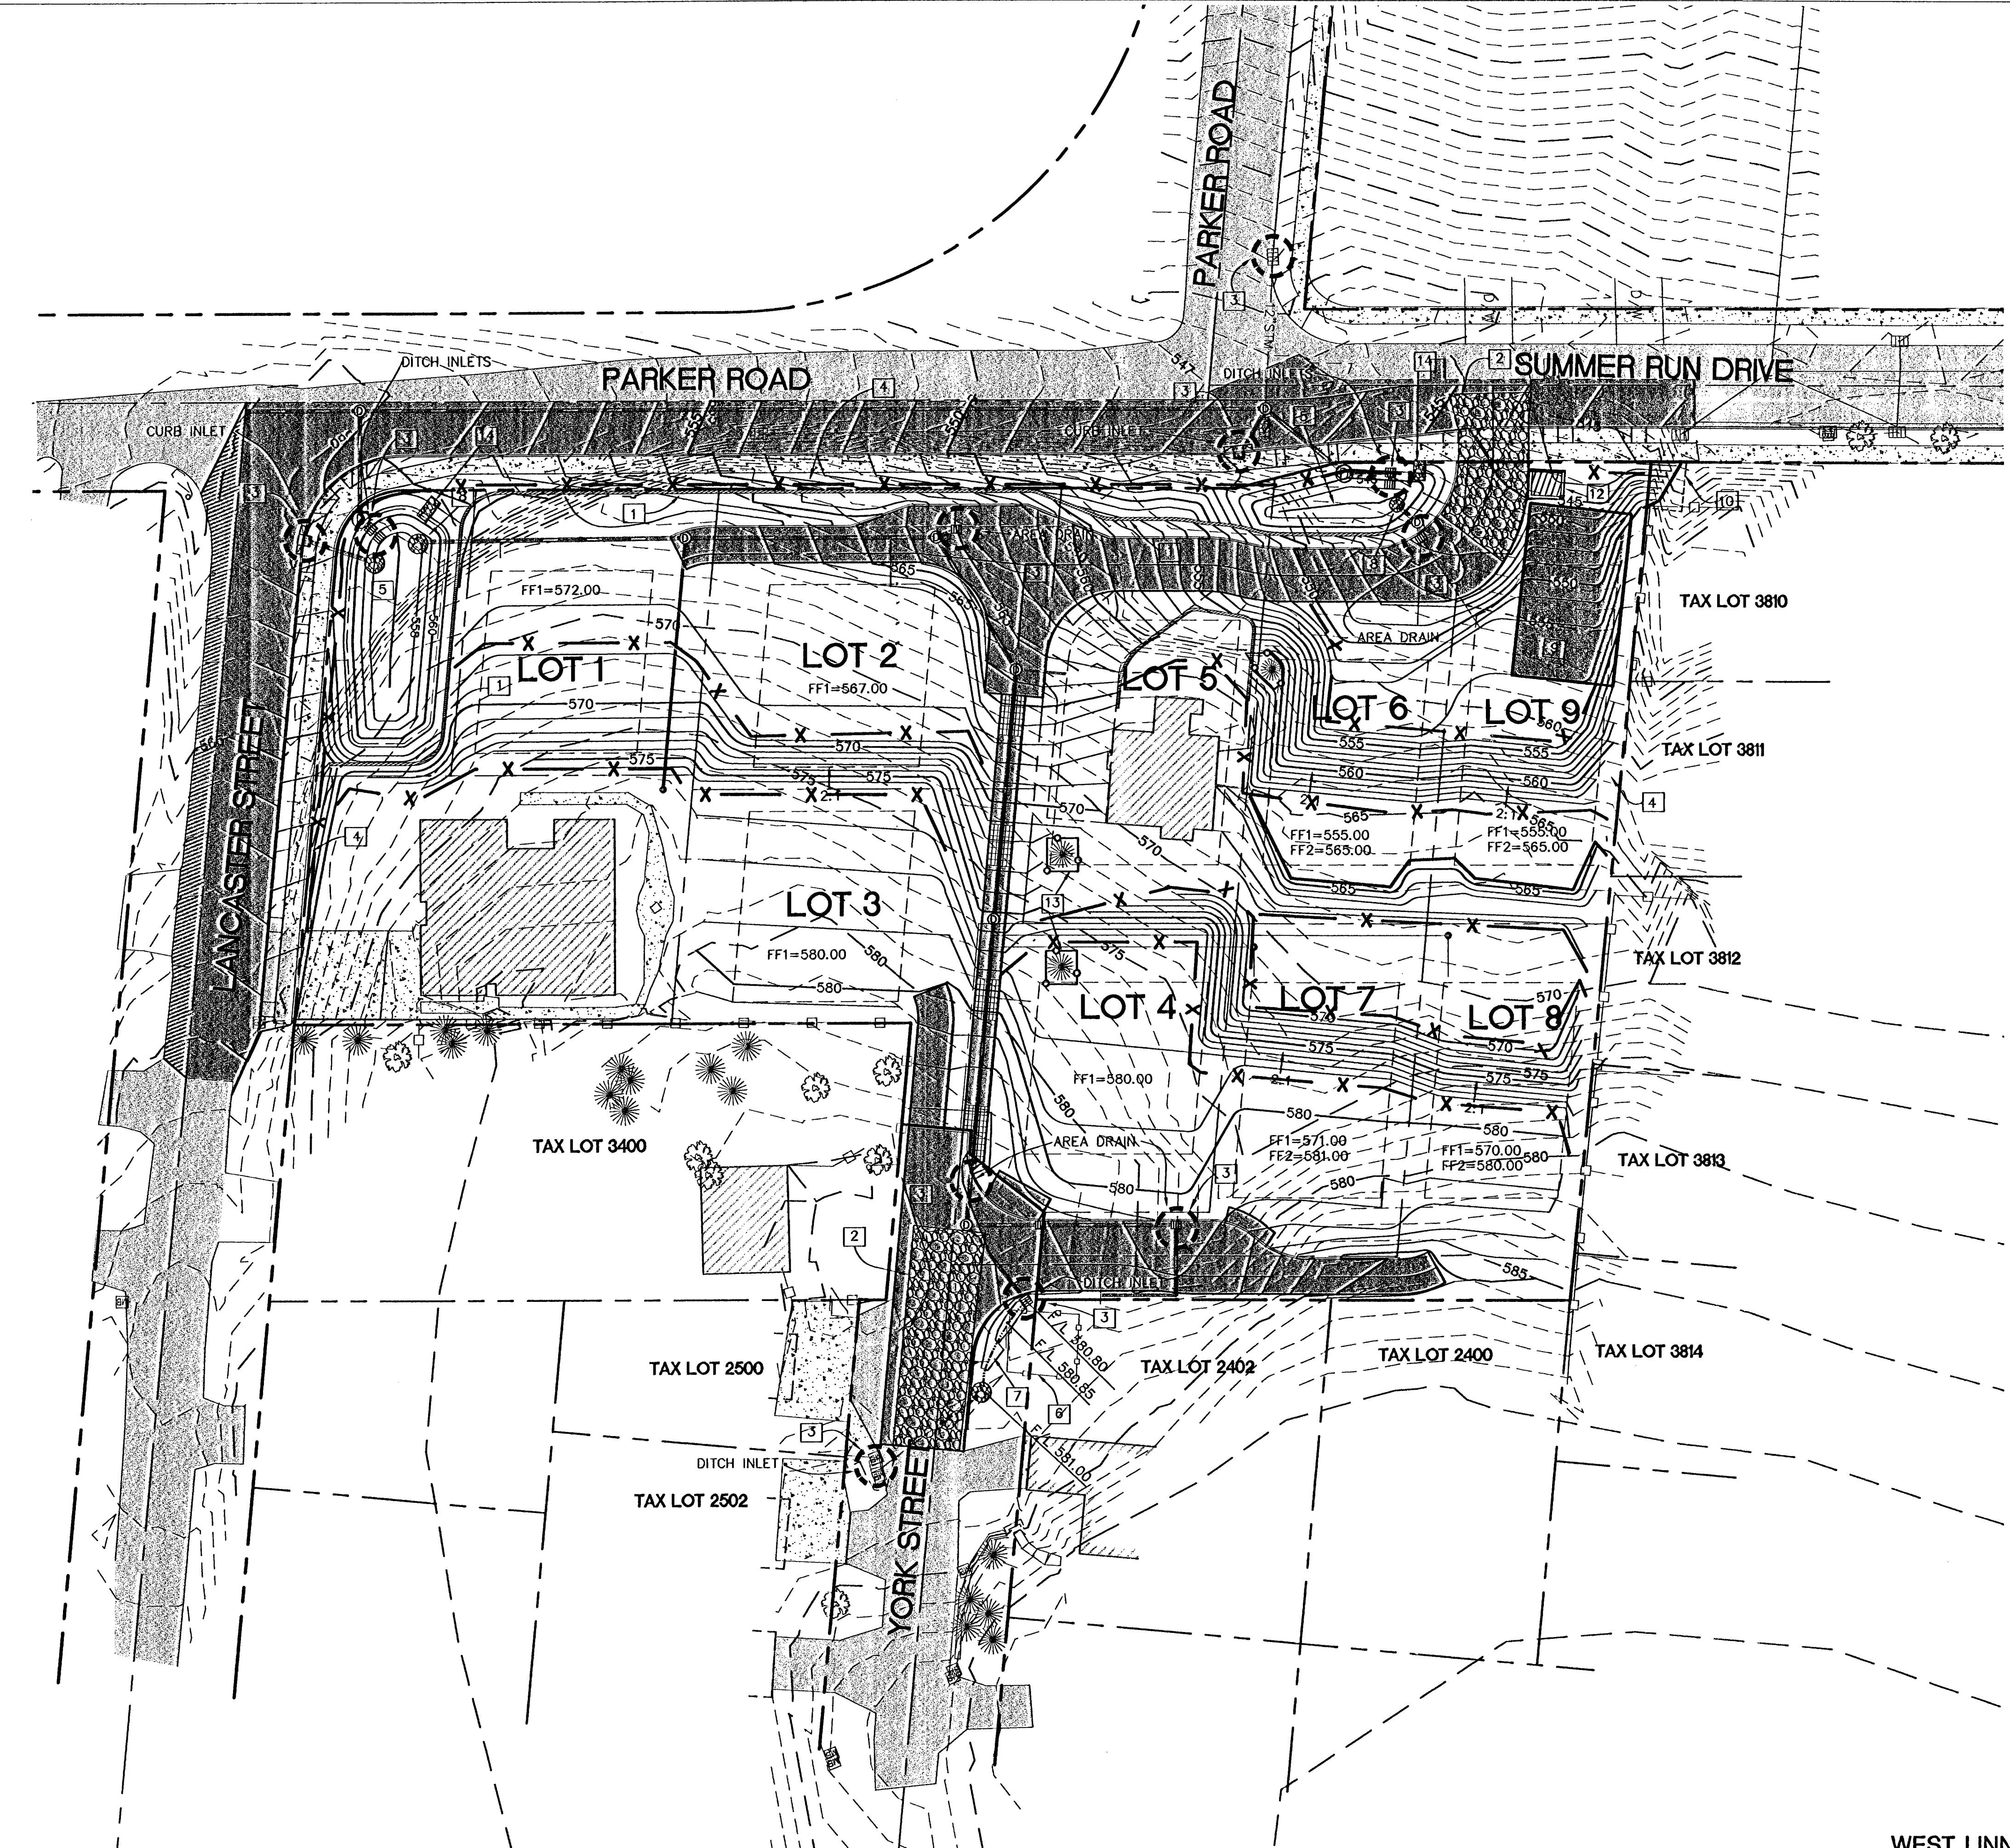

SITE GRADING NOTES:

- [1] INSTALL LOCK AND LOAD RETAINING WALL. SEE SHEET C008 FOR INFORMATION.
- [2] INSTALL GRAVEL CONSTRUCTION ENTRANCE. SEE DETAIL SHEET C007.
- [3] INSTALL BIOFILTER BAG INLET PROTECTION. SEE DETAIL SHEET C007.
- [4] INSTALL SEDIMENT FENCING. SEE DETAIL SHEET C007.
- [5] WATER QUALITY / QUANTITY FACILITY "A". SEE PLANTING PLAN ON C016 AND TYPICAL SECTION ON SHEET C017.
- [6] REMOVE AND RELOCATE EXISTING FENCE WITH IN YORK ST ONTO TAX LOT 2402. COORDINATE WITH PROPERTY OWNER.
- [7] CONSTRUCT DITCH SECTION FROM EXISTING DRIVEWAY TO NEW DITCH INLET. SEE BELOW FOR DIMENSIONS. SEE SHEET C002 FOR SEEDING INSTRUCTIONS
- [8] INSTALL STORM OUTFALL PER DETAIL ON SHEET C017.
- [9] CONSTRUCTION STAGING AREA.
- [10] TEMPORARY CONSTRUCTION EASEMENT AREA.
- [11] IF POND IS CONSTRUCTED DURING WET WEATHER MONTHS (OCT. 1 TO MAY 31), INSTALL CLASS 100 RIP RAP 1' THICK ON BOTTOM OF POND. DURING DRY WEATHER MONTHS, INSTALL POND VEGETATION PER LANDSCAPE PLAN.
- [12] INSTALL CONCRETE TRUCK WASHOUT PIT. 10' X 10' X 3' * DO NOT OVERFILL PIT *
- [13] MAINTAIN TREE PROTECTIVE FENCING. SEE SHEET C004 FOR INSTALLATION NOTES
- [14] INSTALL POND OVERFLOW. SEE SHEET C020 FOR DETAIL.




PERMANENT GROUND COVER MIX

ANNUAL RYEGRASS, 40% BY WEIGHT
TURF-TYPE FESCUE, 60% BY WEIGHT
APPLICATION RATE: 100 POUNDS MINIMUM PER ACRE


TEMPORARY GROUND COVER MIX

DWARF PERENNIAL RYEGRASS, 80% BY WEIGHT
CREEPING RED FESCUE, 20% BY WEIGHT
APPLICATION RATE: 100 POUNDS MINIMUM PER ACRE


LEGEND

-  GRAVEL CONSTRUCTION ENTRANCE
-  INLET PROTECTION
-  SEDIMENT FENCING

INSTALL LOW DENSITY JUTE MATTING FOR EROSION PROTECTION

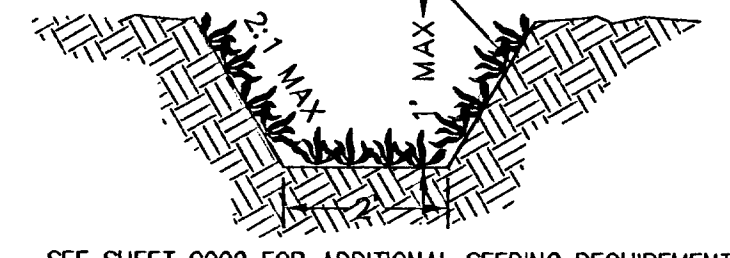

SEE SHEET C002 FOR ADDITIONAL SEEDING REQUIREMENTS
YORK STREET DITCH SECTION
SCALE: NTS

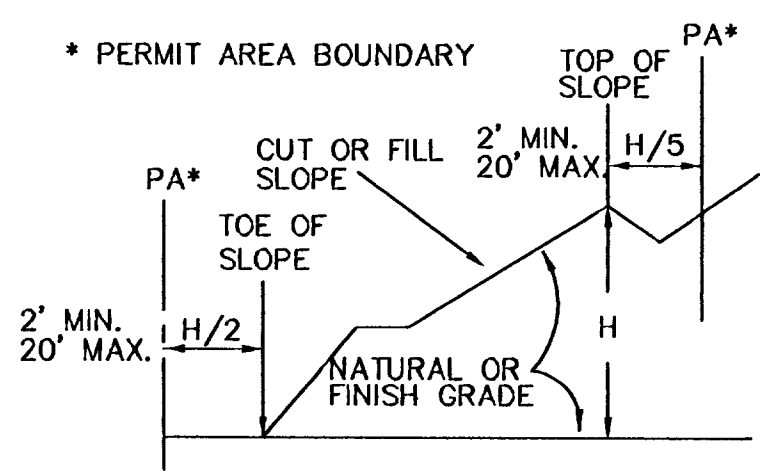

GRADING SETBACK DIMENSIONS
N.T.S.

ASBUILT CONSTRUCTION DOCUMENTS

GRADING AND EROSION CONTROL PLAN
SIENNA'S ESTATES
City of West Linn, Clackamas County, Oregon

SAM L PAP
2799 LANCASTER STREET
WEST LINN, OREGON 97068
(503) 888-2254

LANPACIFIC
CIVIL ENGINEERING
DEVELOPMENT
CONSULTING
LANDSCAPE
ARCHITECTURE
5125 SW Macadam, Suite 140, Portland, Oregon 97239
503 | 238-2097 FAX: 503 | 238-2447
www.lanpacific.com





REGISTERED PROFESSIONAL ENGINEER
OREGON
JULY 10, 2001
SCOTT ELMORE
EXP. 12/31/09


RECORD DRAWING
01/18/08

THESE RECORD DRAWINGS HAVE BEEN PREPARED, IN PART, ON THE BASIS OF INFORMATION COMPILED AND FURNISHED BY THE CONTRACTOR, REVIEWED CONSTRUCTION PLANS, AND FIELD OBSERVATIONS DURING CONSTRUCTION.

DATE | 01/18/08
DRAWN | JSE
DESIGNED | JSE
CHECKED | RGN
PROJECT # | SLP04-001
SHEET TITLE
GRADING AND EROSION CONTROL
SHEET NUMBER

C006

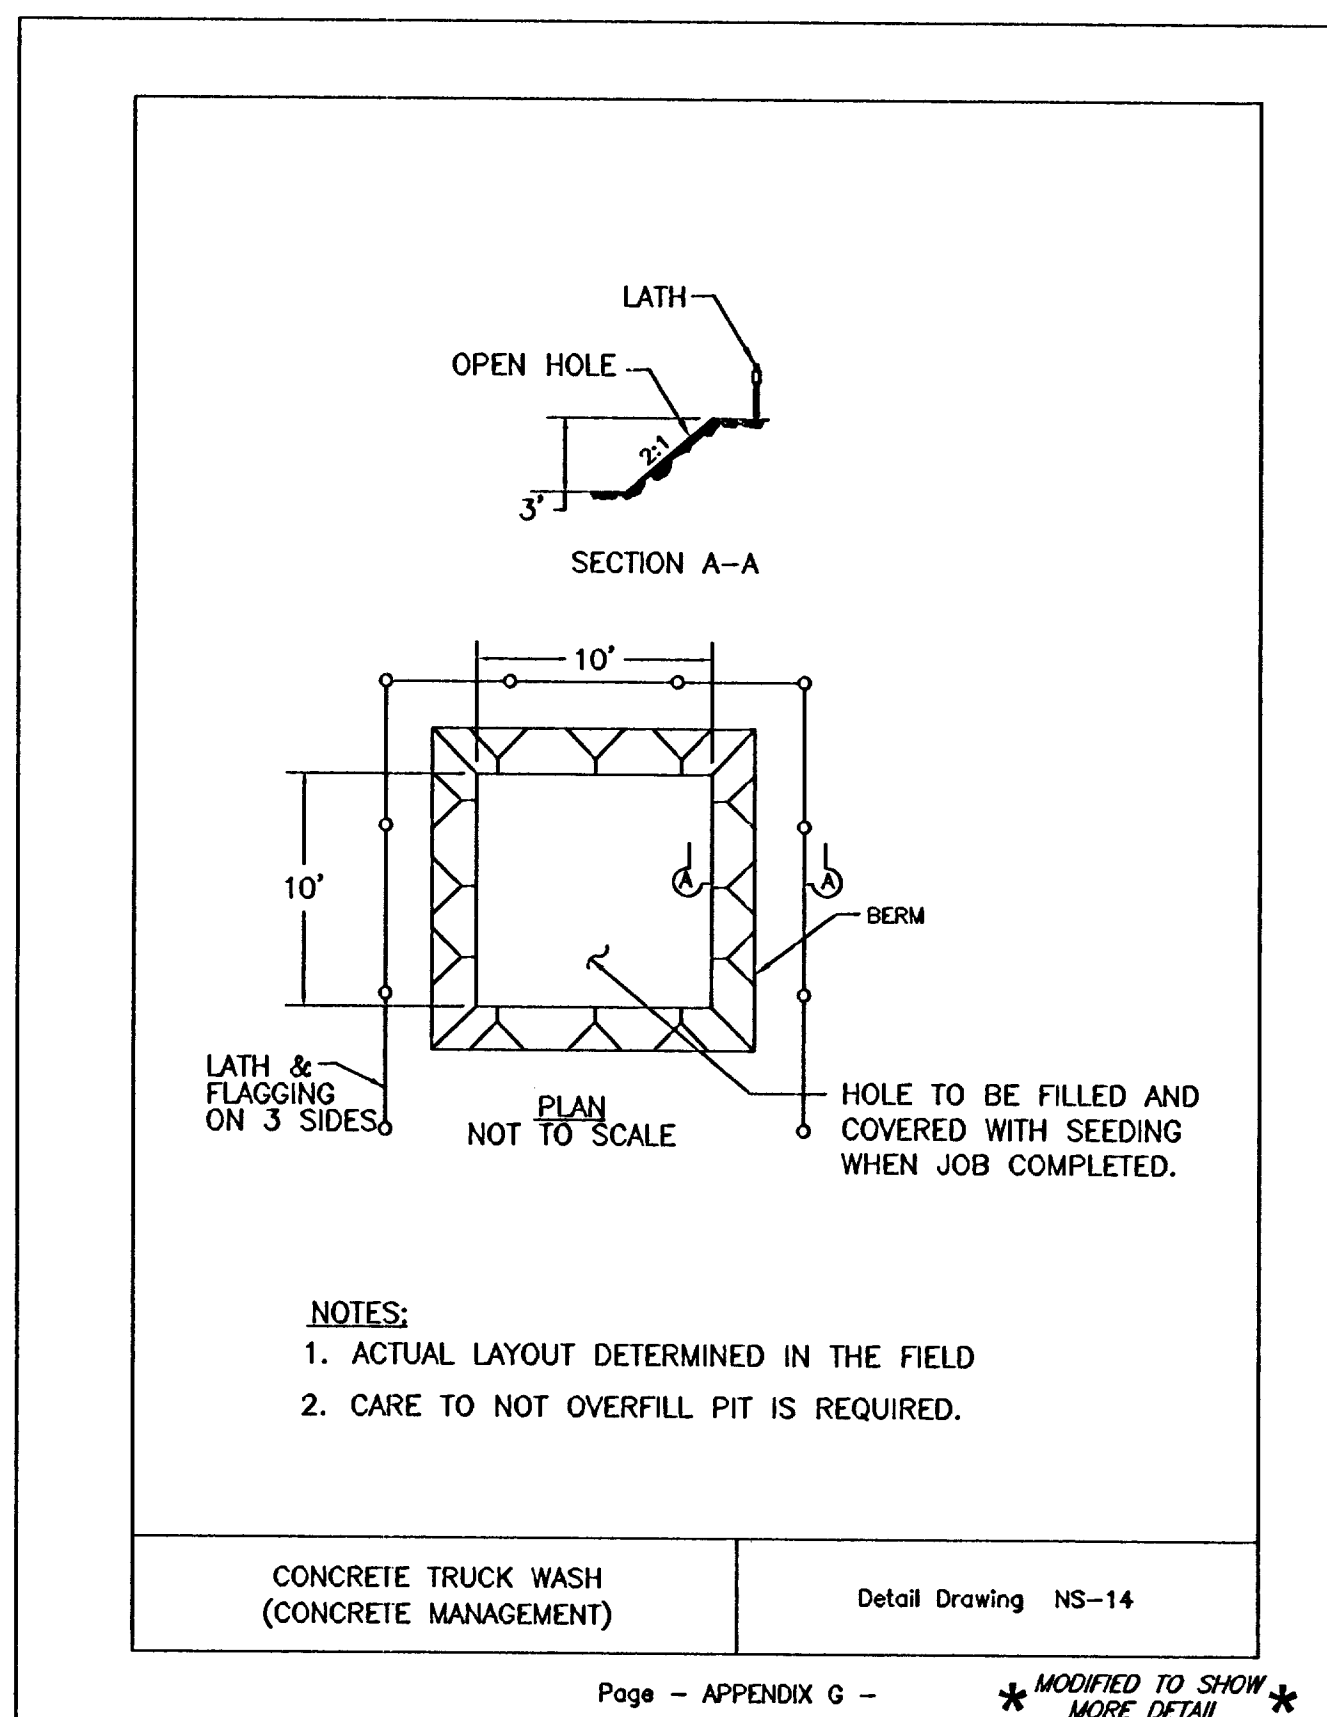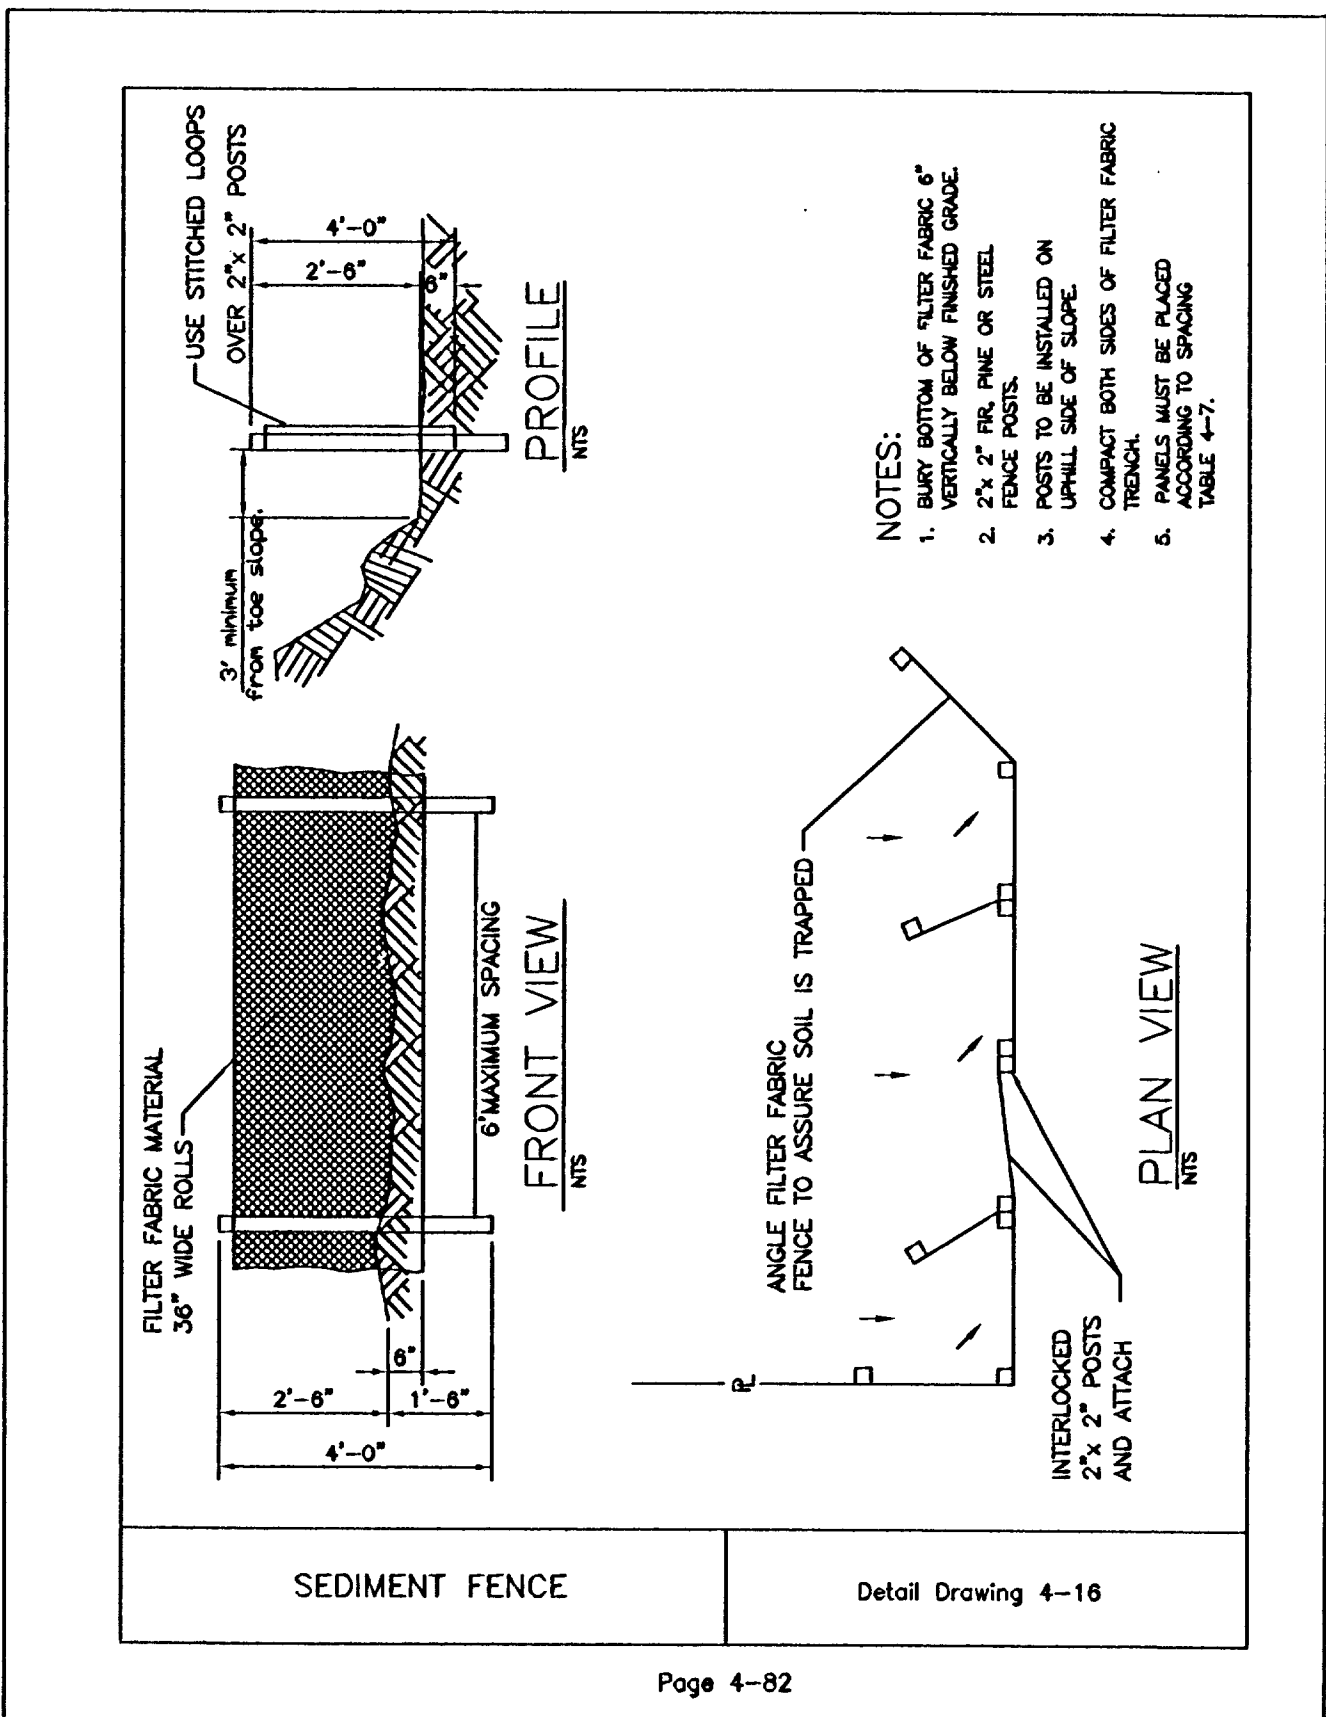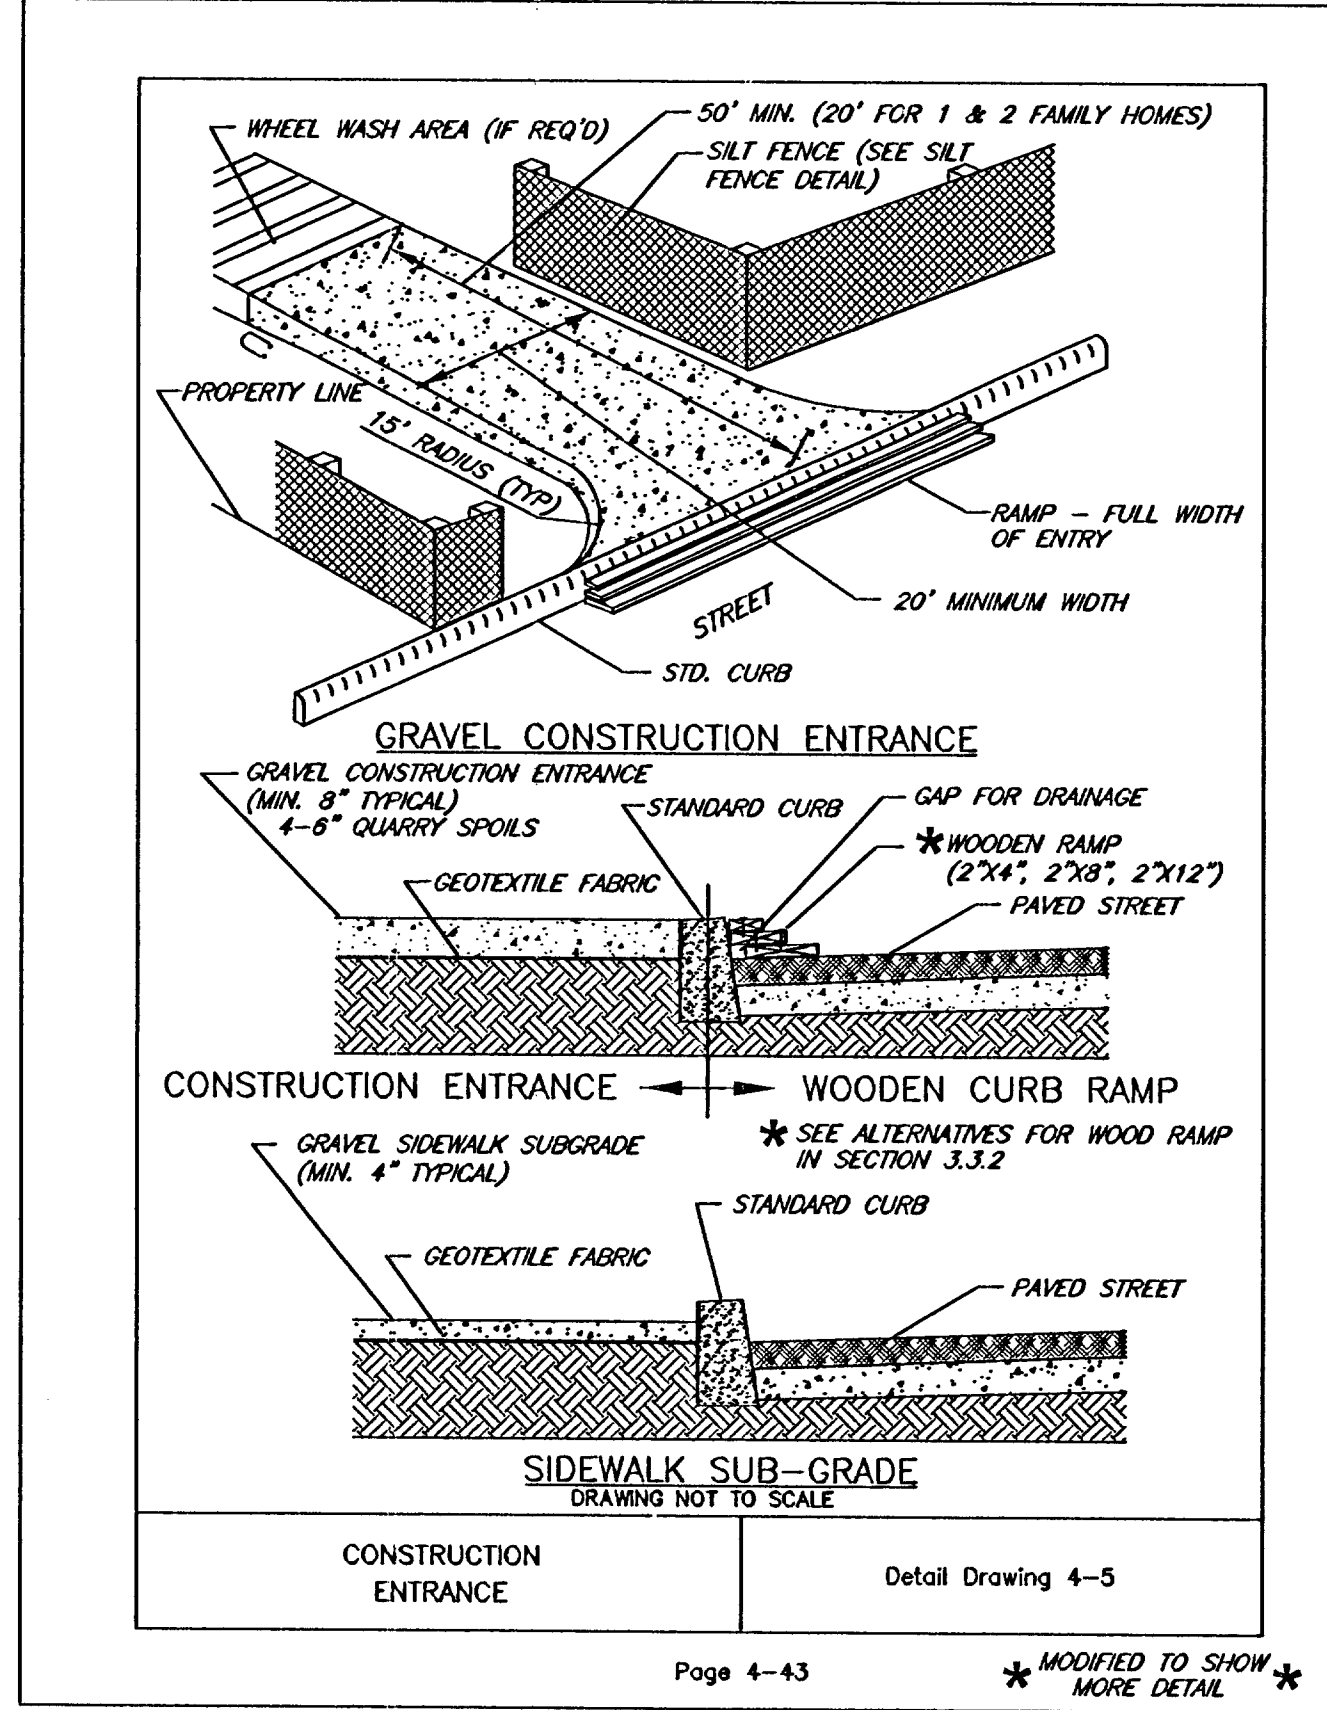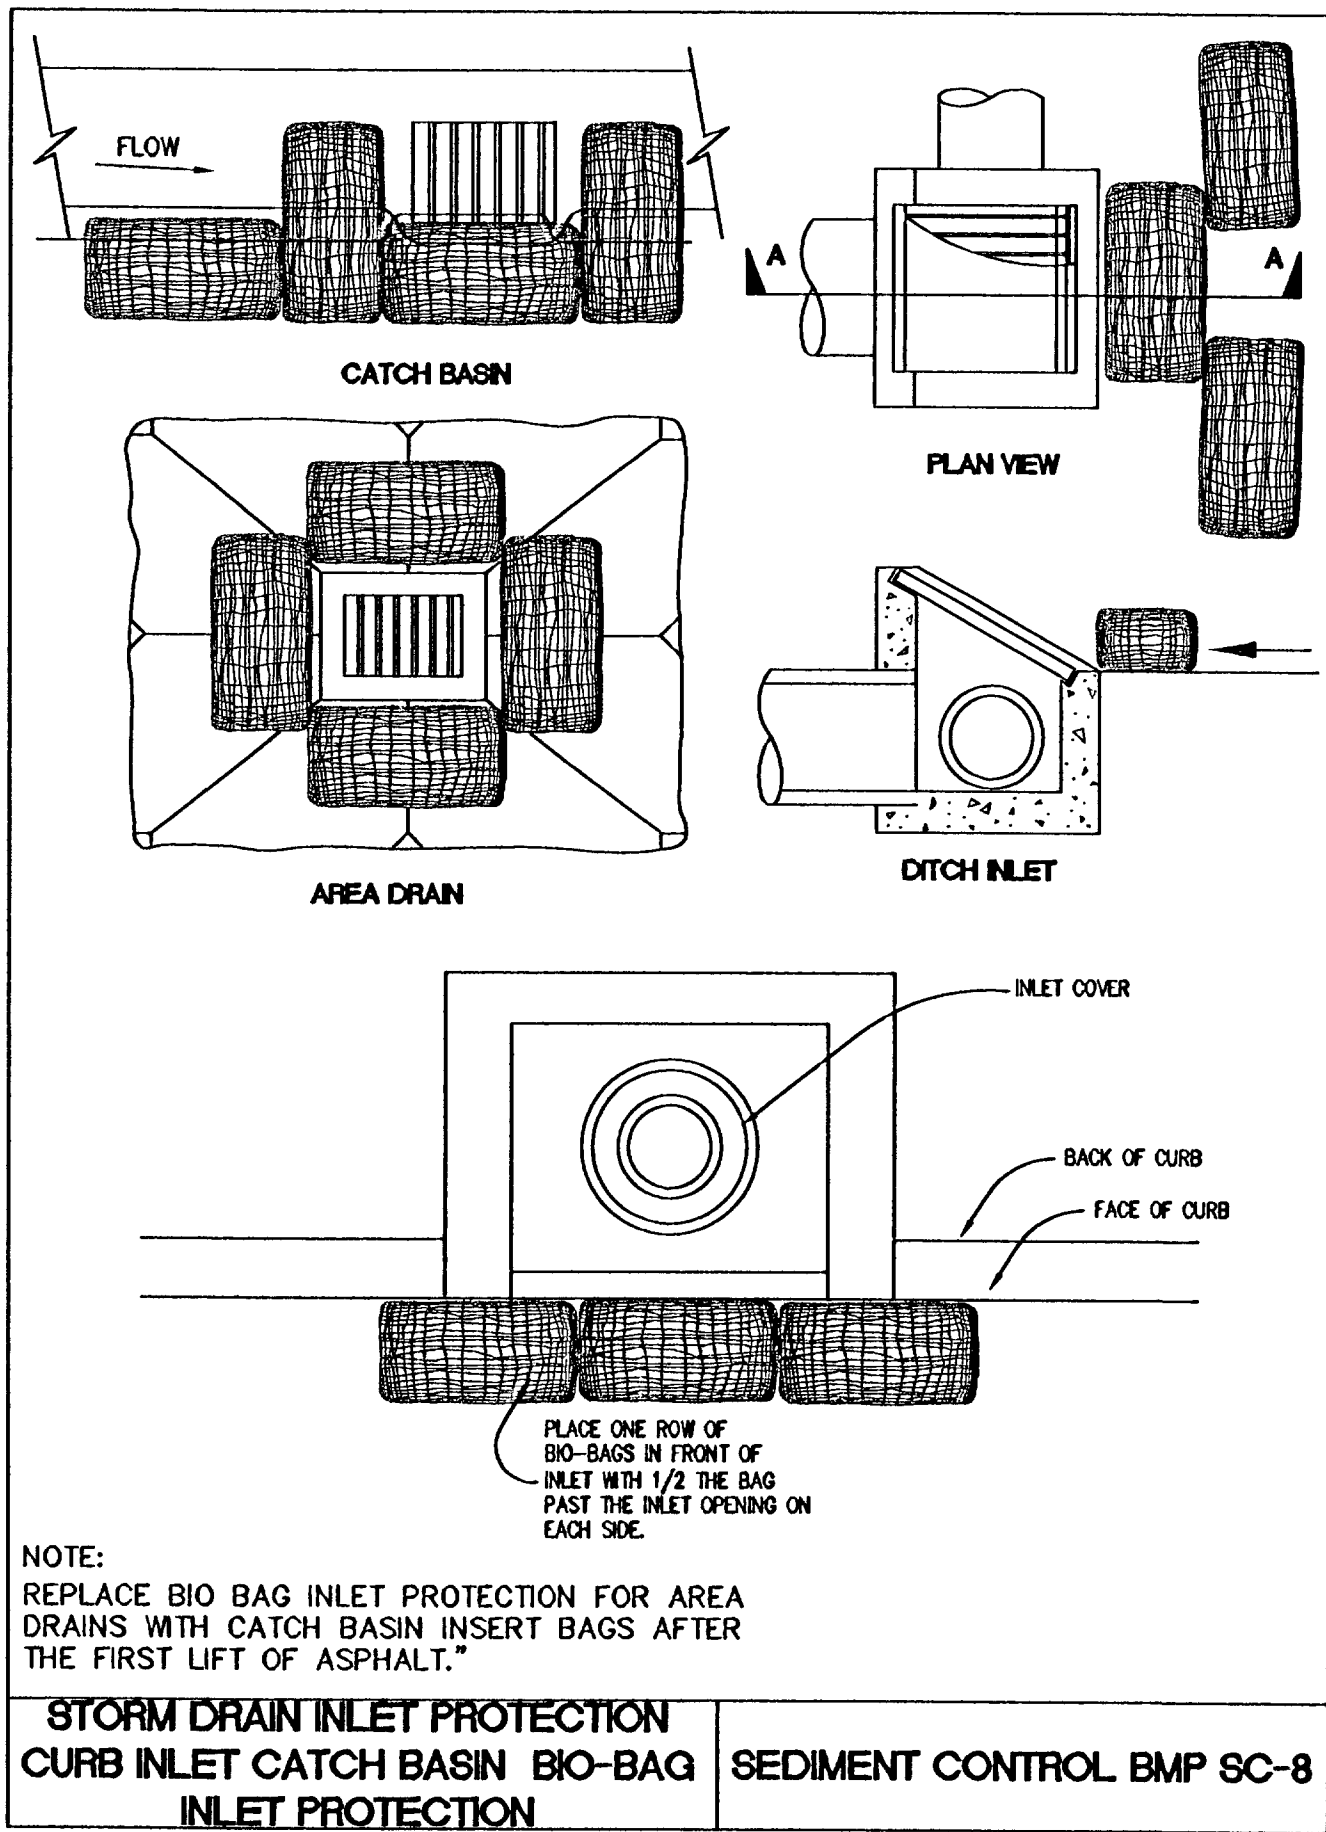


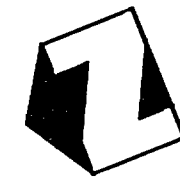

SCALE: 1"=30'

LEGEND






TOW	TOP OF WALL
BOW	BOTTOM OF WALL
	RETAINING WALL
	EXISTING 1' CONTOUR
	EXISTING 5' CONTOUR
	PROPOSED 1' CONTOUR
	PROPOSED 5' CONTOUR
	EXISTING ASPHALTIC SURFACE
	PROPOSED ASPHALTIC SURFACE
	MESH CHAIN LINK FENCING
	AT TOP OF RETAINING WALL (USE SURFACE WATER FACILITY FENCE WL-616 PAGE C017)

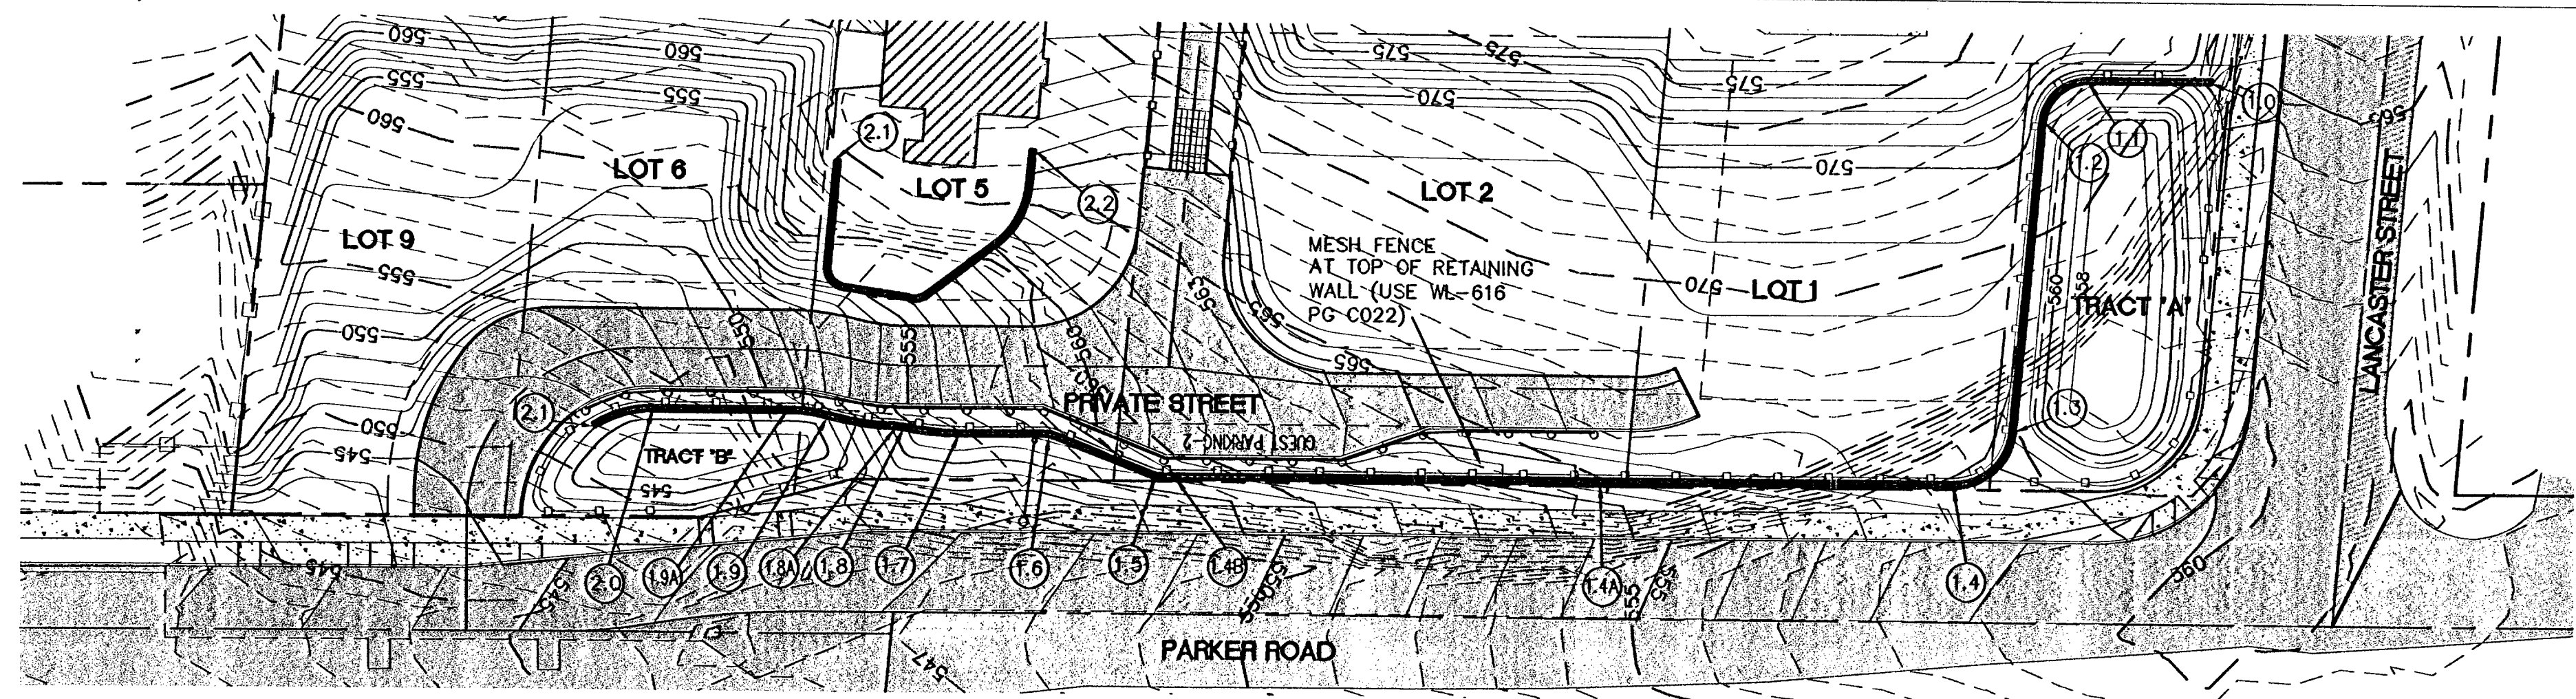

RETAINING WALL NOTES

ALL STATIONS ARE GIVEN AT BOTTOM FACE OF WALL

1.0 STA. 0+00.00 BEGIN WALL	TOW: 569.38 BOW: 561.50	1.7 STA. 3+62.66 PC 61.50' RAD	TOW: 557.56 BOW: 549.69
1.1 STA. 0+28.00 PC 10' RAD	TOW: 569.38 BOW: 561.50	1.8 STA. 3+75.36 PT 61.50' RAD PC 10.00' RAD	TOW: 556.25 BOW: 548.38
1.2 STA. 0+42.82 PT 10' RAD	TOW: 569.38 BOW: 560.19	1.8A STA. 3+77.20 PT 10.00' RAD PC 64.50' RAD	TOW: 556.25 BOW: 548.38
1.3 STA. 1+13.86 PC 14' RAD	TOW: 566.75 BOW: 558.87	1.9 STA. 3+92.84 PT 35.50' RAD PC 35.50' RAD	TOW: 553.63 BOW: 544.44
1.4 STA. 1+34.60 PT 14' RAD	TOW: 566.75 BOW: 557.56	1.9A STA. 4+02.26 PT 35.50' RAD	TOW: 552.31 BOW: 544.44
1.4A STA. 2+14.95	TOW: 565.44 BOW: 554.94	2.0 STA. 4+32.69 PC 24.50' RAD	TOW: 548.38 BOW: 544.44
1.4B STA. 3+11.55	TOW: 561.50 BOW: 549.69	2.1 STA. 4+46.42 PT 24.50' RAD END WALL	TOW: 547.06 BOW: 544.44
1.5 STA. 3+16.41 MID PT 10' RAD	TOW: 561.50 BOW: 549.69		
1.6 STA. 3+42.07 MID PT 10' RAD	TOW: 558.88 BOW: 560.19		

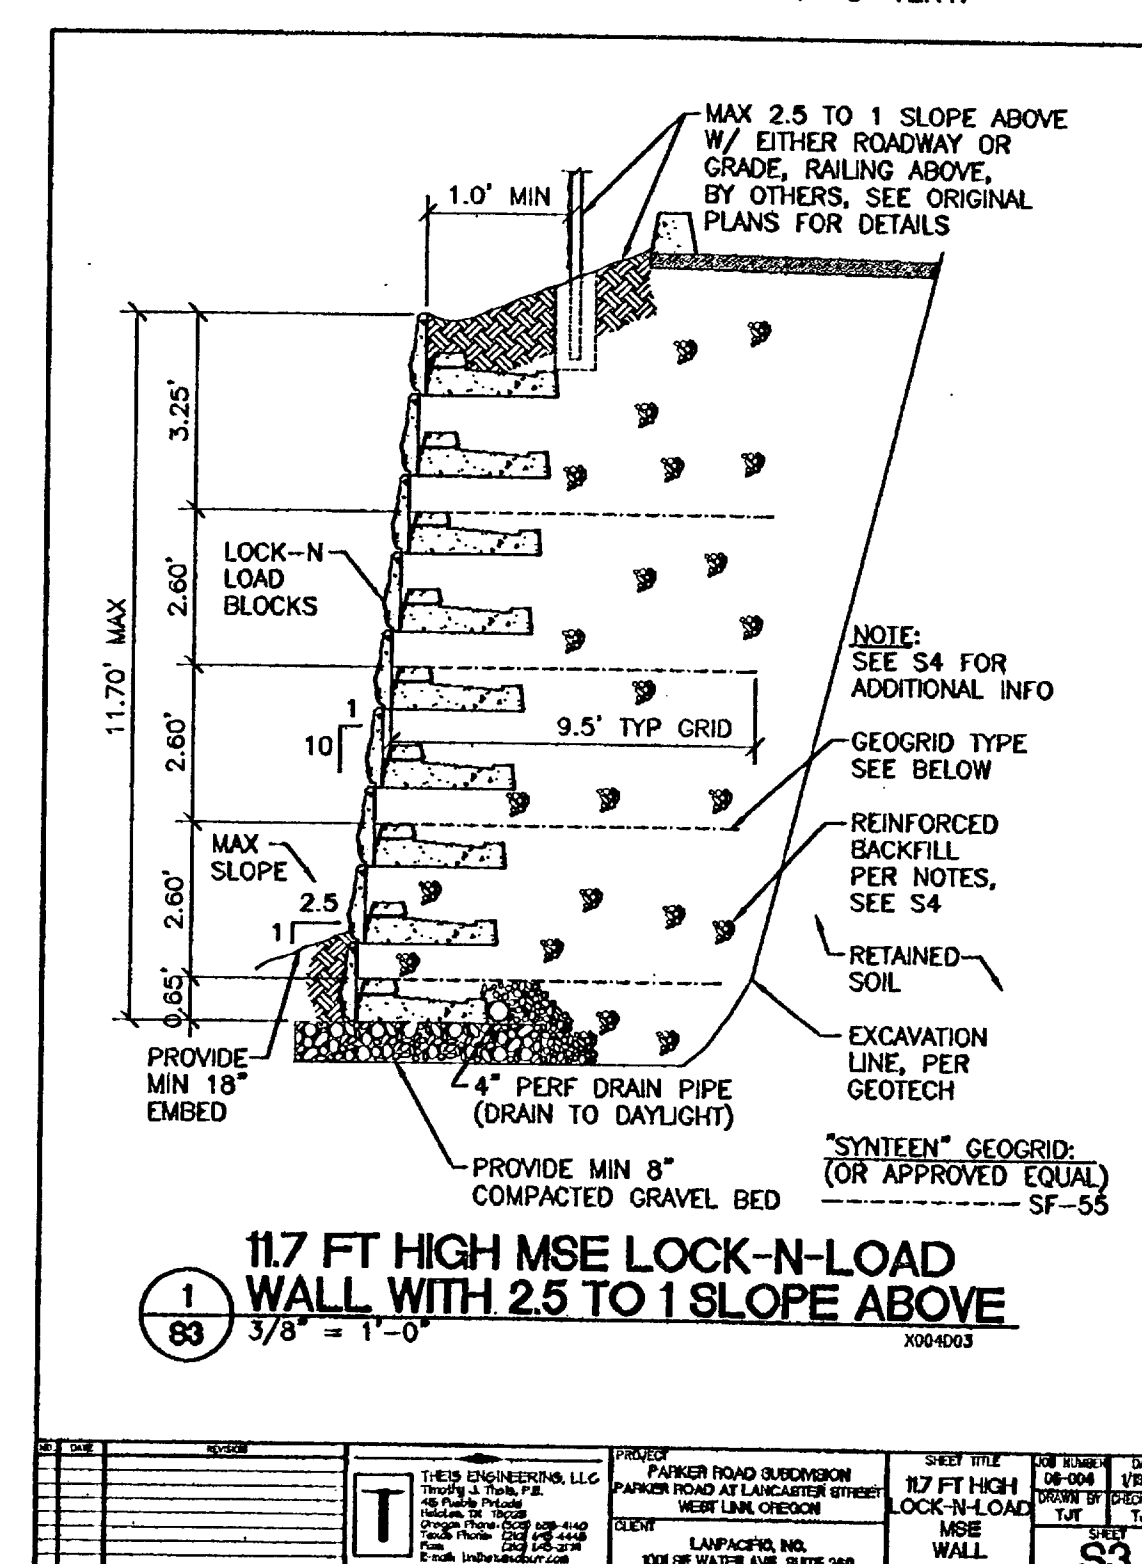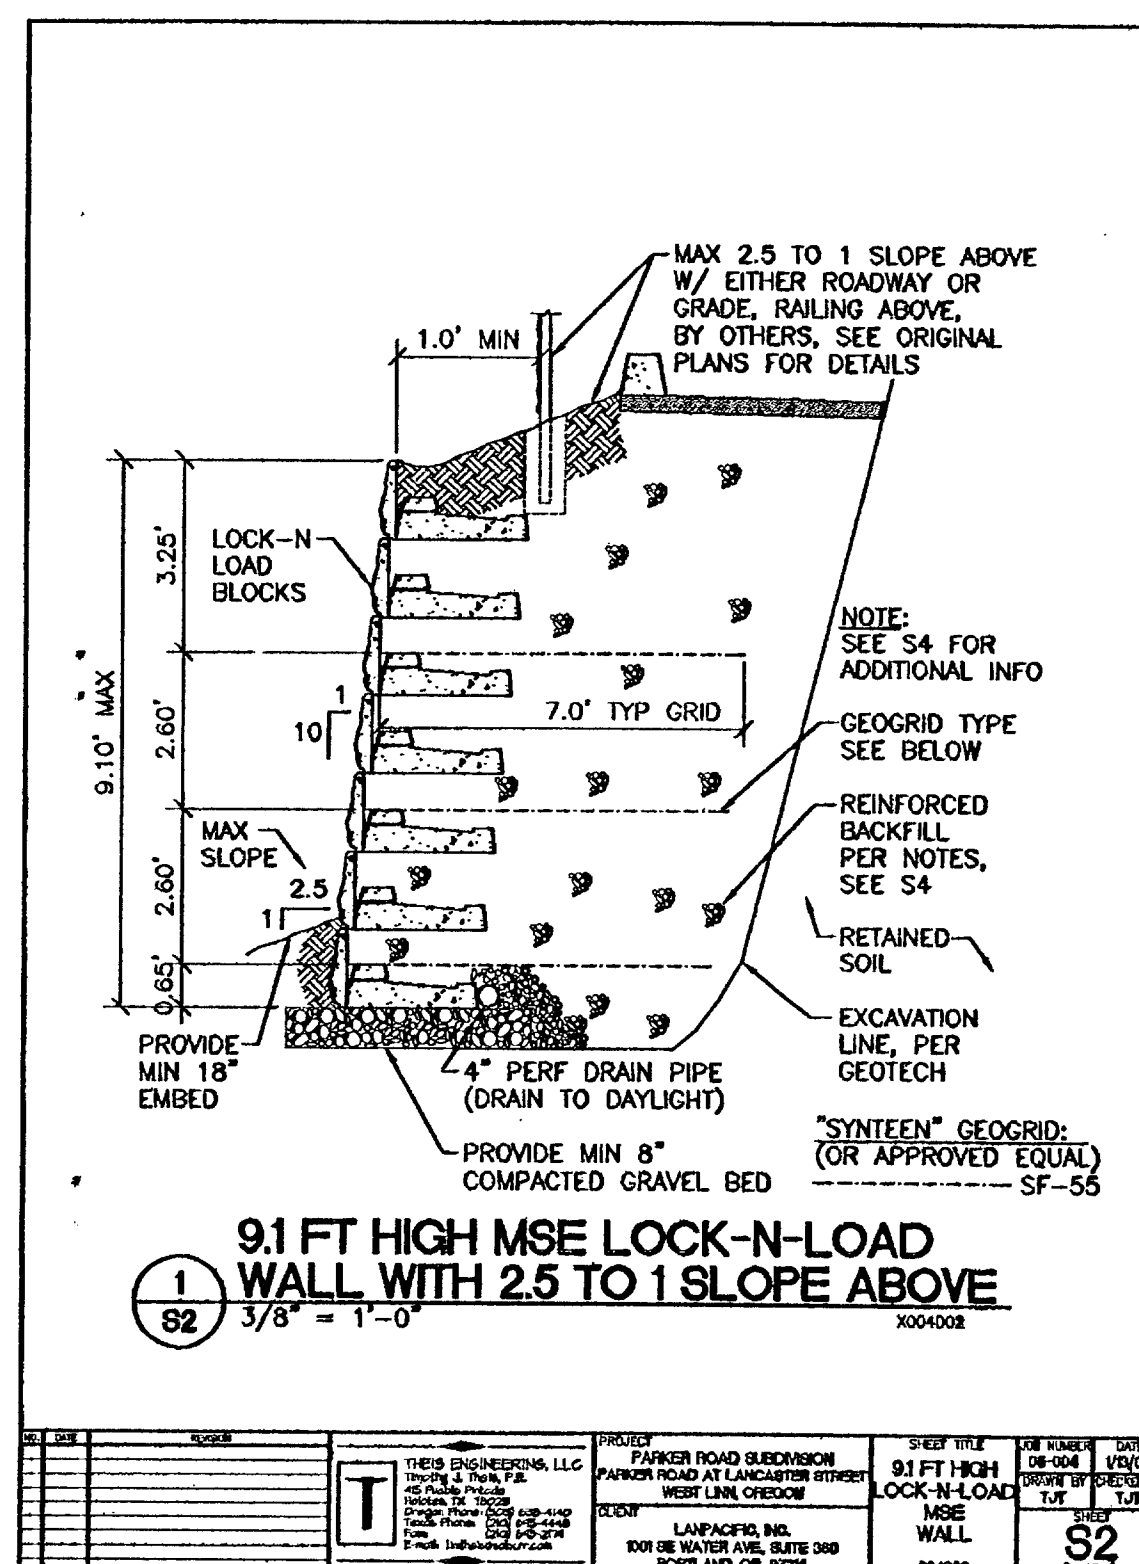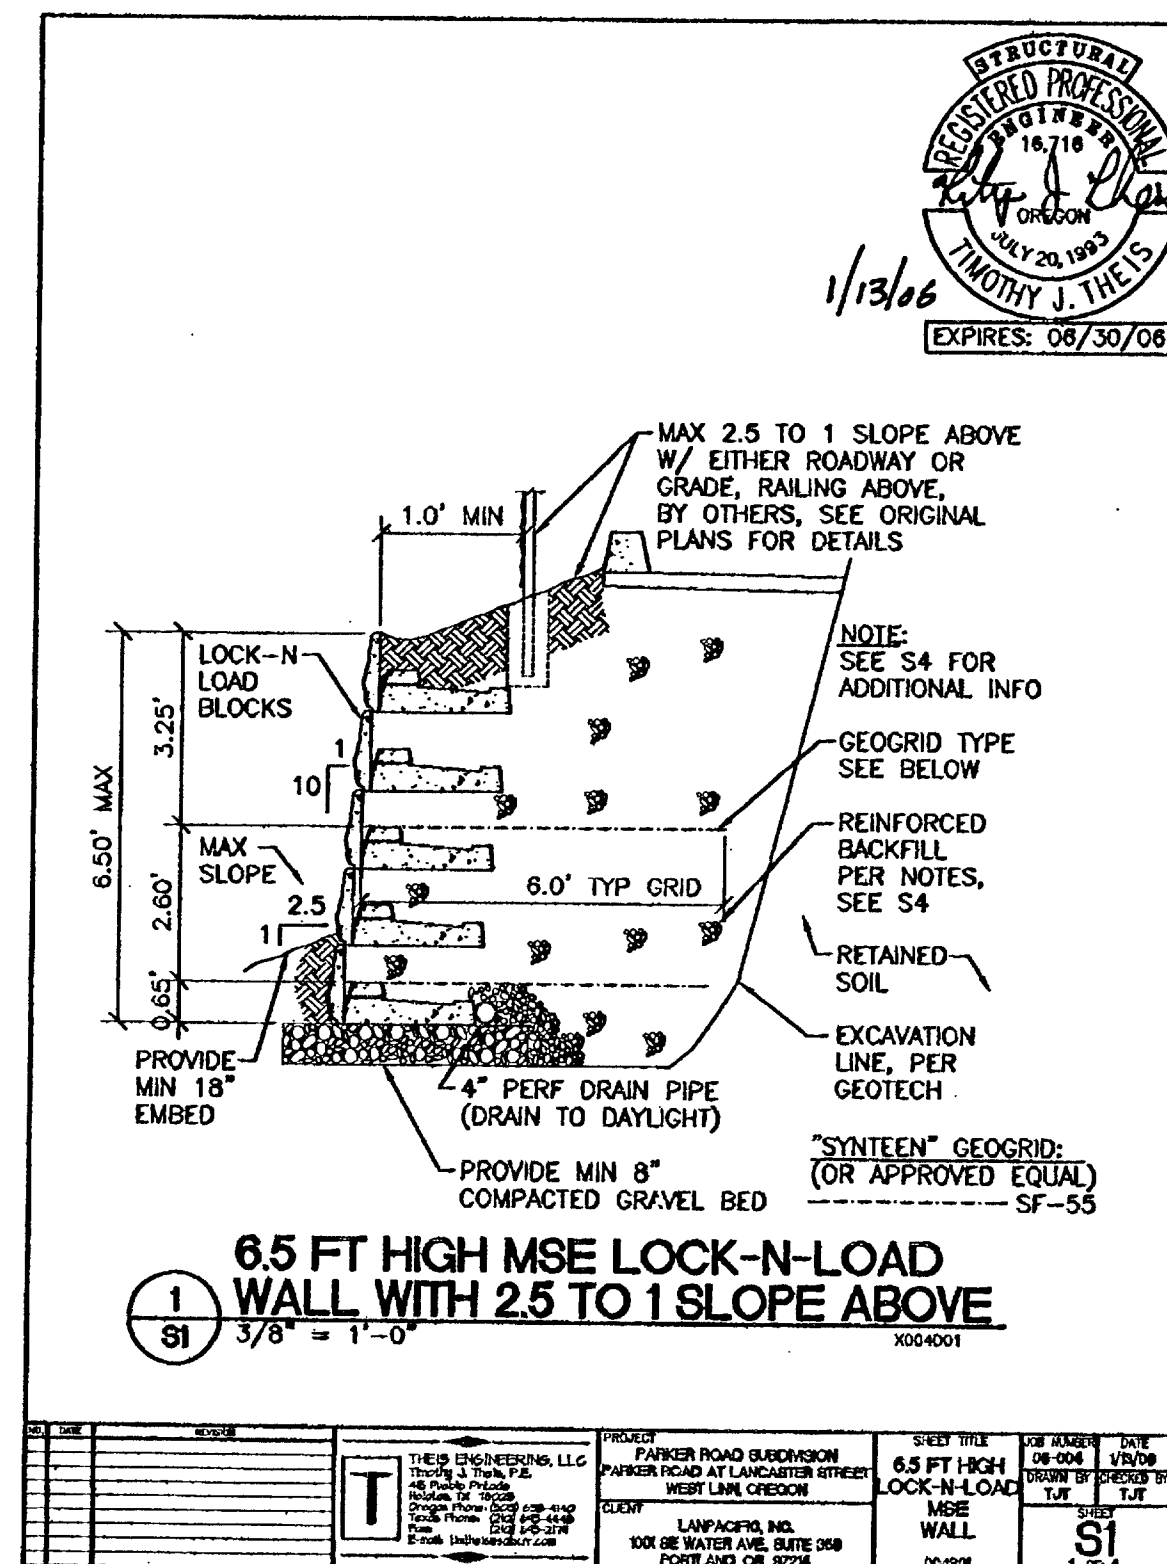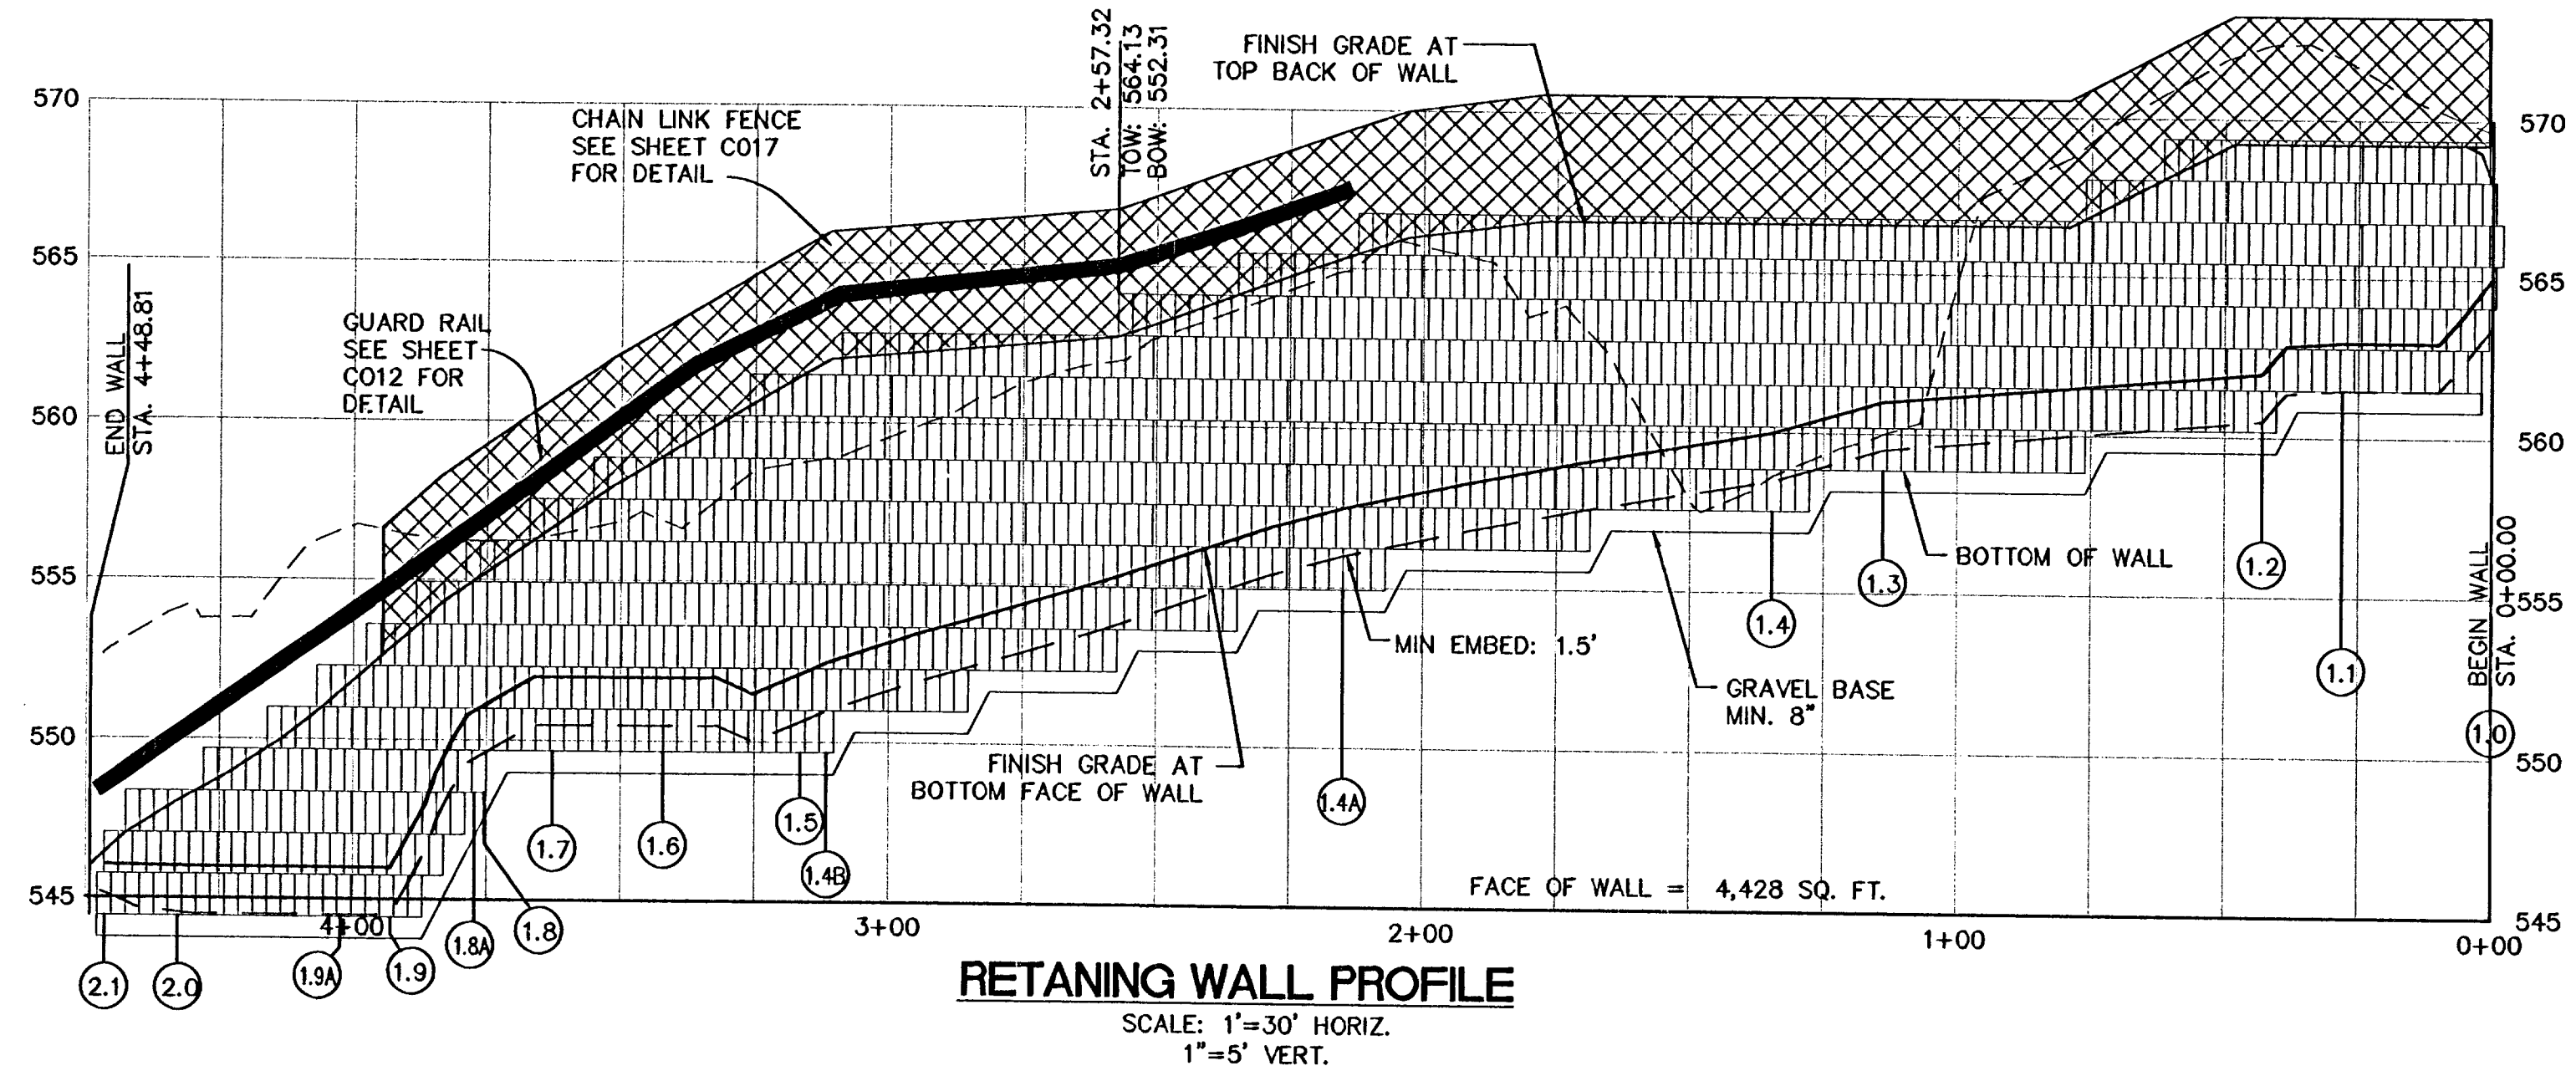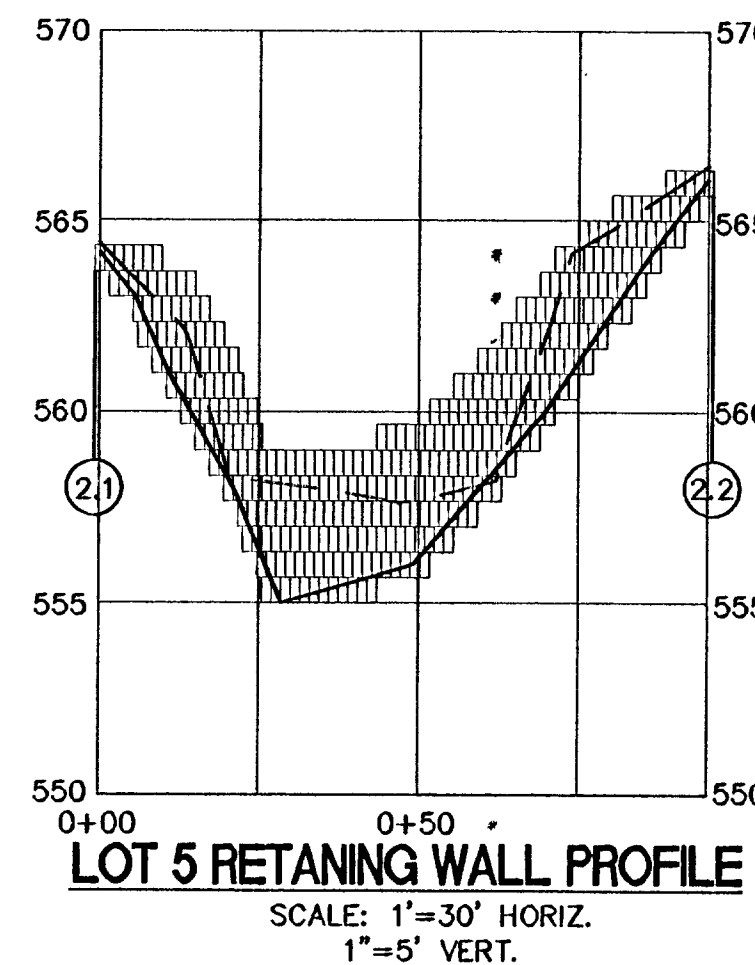

- DESIGN CRITERIA AND LOCK-N-LOAD INSTALLATION NOTES:**
- LOCK-N-LOAD BLOCKS AND SYNTEN GEOTEXTILES ARE TO BE INSTALLED PER MANUFACTURER'S INSTRUCTIONS.
 - DESIGN IS BASED ON THE FOLLOWING:
(PER GEOTECH REPORT BY GEOPACIFIC ENGINEERING, DATED 1/27/05)
ACTIVE EARTH COEFFICIENT, K_a (LEVEL SLOPE): 0.280 (EPF=35 PCF)
SEISMIC EARTH COEFFICIENT, $K_{a,s}$ (LEVEL SLOPE): 0.323
ACTIVE EARTH COEFFICIENT, K_a (MAX 2.5:1 SLOPE): 0.373 (EPF=47 PCF)
SEISMIC EARTH COEFFICIENT, $K_{a,s}$ (MAX 2.5:1 SLOPE): 0.479
MAXIMUM SOIL BEARING CAPACITY: 1,500 PSF
(WALLS OVER 8.5 FT WILL NEED 2,600 PSF BEARING CAPACITY)
COEFFICIENT OF FRICTION AT BASE OF WALL: 0.45
UNIT WEIGHT OF ON-SITE MATERIAL: 125 PCF
INTERNAL ANGLE OF ON-SITE MATERIAL: 35 DEGREES
UNIT WEIGHT OF GRAVEL IMPORT FILL: 135 PCF
INTERNAL ANGLE OF GRAVEL IMPORT FILL: 38 DEGREES
ROADWAY VEHICLE SURCHARGE: 250 PSF
 - DESIGN IS BASED ON AASHTO/FHWA METHODOLOGY.
 - CALCULATIONS WERE PERFORMED ASSUMING 'SYNTEN' GEOTEXTILE, OF TO USE OTHER GEOTEXTILES WITH THE FOLLOWING PROPERTY: 'SYNTEN' SF-55 (LIDS) = 2,165 LBS/FT
 - INSTALL WALLS W/ 10 TO 1 BATTER (5.7 DEGREES). ALIGN FRONT FACE OF UNIT ABOVE WITH BACK FACE OF UNIT BELOW.
 - PROVIDE MINIMUM 18" EMBEDMENT PER PLANS.
 - MINIMUM FACTOR OF SAFETY: (REDUCED BY 1.33 FOR SEISMIC DESIGN)
FACTOR OF SAFETY AGAINST SLIDING: 1.5
FACTOR OF SAFETY AGAINST OVERTURN: 2.0
FACTOR OF SAFETY AGAINST GRID PULL-OUT: 1.5
 - BACKFILL MATERIAL SHALL BE CLEAN ANGULAR COMPACTED GRAVEL THAT MEETS THE PROPERTIES OUTLINED UNDER NOTE 2 ABOVE AND SHALL HAVE LESS THAN 5% PASSING THE NUMBER 200 SIEVE. GRAVEL BACKFILL AND LEVELING BED SHALL BE COMPACTED TO 95% OF THE MAXIMUM DRY DENSITY AS DETERMINED BY ASTM D-698. OVER EXCAVATION MAY BE REQUIRED TO OBTAIN PROPER BEARING CAPACITY. PLANTING SOIL MAY BE USED FOR THE TOP 12" OF THE GEOTEXTILE ZONE.
 - RAILING GUARDRAIL CONTRACTOR SHALL COORDINATE REQ'D FOOTINGS W/ WALL INSTALLER TO AVOID DAMAGE OF GEOTEXTILE. SAUNA TUBES MAY BE REQ'D AT TIME OF GEOTEXTILE INSTALLATION, CAREFULLY CUT GEOTEXTILE AROUND SAUNA TUBES AS REQUIRED.
 - WALLS 3.9 FEET OR LOWER DO NOT REQUIRE GEOTEXTILE.
 - SEE ORIGINAL PLANS FOR PLAN VIEW OF WALL, RAILING REQUIREMENTS AND DETAILS AND ALL OTHER CIVIL INFORMATION.

RETAINING WALL PLAN / PROFILE / DETAILS

SIENNA'S ESTATES

City of West Linn, Clackamas County, Oregon

SAM L PAP

2799 LANCASTER STREET
WEST LINN, OREGON 97068
(503) 888-2254

CIVIL ENGINEERING
DEVELOPMENT
CONSULTING
LANDSCAPE
ARCHITECTURE
LANPACIFIC
5125 SW Macadam, Suite 140, Portland, Oregon 97239
503 | 238-2097 FAX: 503 | 238-2447
www.lanpacific.com

REGISTERED PROFESSIONAL
ENGINEER
NO. 10760
JULY 10, 2001
U.S. SCOTT ELMETS
EXP. 12/31/09

RECORD
DRAWING
01/18/08

THESE RECORD DRAWINGS HAVE BEEN
PREPARED, IN PART, ON THE BASIS OF
INFORMATION COMPILED AND FURNISHED
BY THE CONTRACTOR, REVERED
CONSTRUCTION PLANS AND FIELD
OBSERVATIONS DURING CONSTRUCTION.

DATE: 01/18/08
DRAWN: JSE
DESIGNED: JSE
CHECKED: RGN
PROJECT #: SLP04-001

SHEET TITLE:
RETAINING WALLS
PLAN/PROFILE

SHEET NUMBER:
C008

ASBUILT CONSTRUCTION DOCUMENTS

WEST LINN CASEFILE SUB05-03 / ZC05-05 / VAR05-03

TURNAROUNDS ARE NOT PER JULY 1ST FIRE CODE. ALTERNATIVE METHOD FOR TURNAROUND: SPRINKLE ALL DWELLINGS WITH A NFPA 13D SYSTEM.



SCALE: 1"=30'

STREET AND STORM SEWER PLAN

- STREET INTERSECTION
0+00.00 PEDESTRIAN PATH = 3+07.69 PRIVATE DRIVE - WEST
- INSTALL LANDSCAPE BERM SEPERATOR. SEE SHEET C017 FOR DETAIL.
- PROTECT EXISTING TREES WITH TREE PROTECTION FENCING PER NOTES PAGE C004.
- INSTALL FENCING ALONG PEDESTRIAN ACCESS EASEMENT. PARALLEL AND INSIDE EASEMENT 0.5'. SEE DETAIL ON SHEET C017
- CURB TAPER TRANSITION. BEGIN TAPER - STA: 4+27.49, 23.00' RT END CURB TAPER - STA: 5+20.02, 14' RT.
- INSTALL POND OVERFLOW. SEE SHEET C020 FOR DETAIL
- CONSTRUCT 24.00' RESIDENTIAL DRIVEWAY APPROACH FOR EXISTING HOUSE. REMOVE EXISTING DRIVEWAY, REGRADE AND REPLACE DRIVEWAY. SAWCUT DRIVEWAY AS SHOWN. CL STA: 6+91.21, 23.00' LT (LANCASTER)
- REPLACE STOP BAR STRIPING WITH 1" WIDE THERMOPLASTIC STRIPE PER CITY OF WEST-LINN STANDARDS
- REMOVE EXISTING SIGN AND REPLACE IN NEW PLANTER STRIP.
- REMOVE EXISTING CATCH BASIN.
- ABANDON AND PLUG OR REMOVE EXISTING STORM DRAIN PIPE
- CONSTRUCT 24.00' COMMERCIAL DRIVEWAY
CENTER STA: 5+19.59, 14'RT (SUMMER RUN DRIVE)
- END SAWCUT AND MATCH EXISTING AC, CURB AND SIDEWALK ST STA: 5+88.13, 2.1' LT, 14'RT (SUMMER RUN DRIVE)
- CONSTRUCT 20.00' RESIDENTIAL DRIVEWAY
CENTER STA: 5+56.59, 14'RT (SUMMER RUN DRIVE)
- INSTALL WATER QUALITY CHAINLINK FENCE WITH GATE. SEE SHEET C017 FOR DETAILS.
- PLACE A REMOVABLE BOLLARD AT BOTH ENDS OF PEDESTRIAN PATH. SEE DETAIL ON SHEET C020.
- INSTALL GUARD RAIL. STA: 1+68.00, 11.6'RT TO STA: 2+30.90, 10'RT (PRV DRV WEST). SEE DETAIL SHEET C012.
- REPLACE STREET STRIPING PER CITY OF WEST-LINN STD.
- INSTALL 15.00' COMMERCIAL DRIVEWAY APPROACH FOR WATER QUALITY POND ACCESS.
CL STA: 5+60.15, 23.00' LT (LANCASTER)
CL STA: 4+54.63, 15.66' RT (PARKER)
- INSTALL SIGN "PEDESTRIAN ACCESS OPEN TO PUBLIC"
- SEE SHEET C020 FOR STORM OUTFALL DETAIL.
- EXTEND 8" STORM LINE 17.5 LF (DIP) TO OUTFALL. SEE SHEET C020 FOR STORM OUTFALL DETAIL.
- INSTALL PGE ANCHOR POLE. ALLOW 18.7' MINIMUM HORIZONTAL DIST. BETWEEN ANCHOR POLE AND GUY WIRE ANCHOR POINT
- ROUTE SIDEWALK BEHIND NEW ANCHOR POLE LOCATION

DITCH INLET AND CATCH BASIN DATA

- | | |
|---|---|
| DI #A-15
INSTALL DITCH INLET PER CITY STD. DWG. NO. WL-610
STA. 1+41.62, 44.66' RT (PARKER ROAD)
UPPER GRATE = 557.89
SUMP = 552.90
6.96 LF OF 12" ULTRARIB
S=2.00%
LOWER GRATE = 560.30
IE IN = 558.30
IE OUT = 555.40
3.74 LF OF 12" ULTRARIB
S=2.00% | DI #A-16
INSTALL DITCH INLET PER 10 CITY STD. DWG. NO. WL-6
STA. 4+82.41, 33.03' RT (PARKER ROAD)
UPPER GRATE = 543.92
SUMP = 538.90
7.68 LF OF 12" ULTRARIB
S=2.00%
LOWER GRATE = 546.50
IE IN = 555.40
IE OUT = 555.40
16.03 LF OF 12" ULTRARIB
S=2.00% |
| DI #A-17
INSTALL DITCH INLET PER CITY STD. DWG. NO. WL-603
STA. 0+28.21, 26.62' LT (YORK STREET)
UPPER GRATE = 582.29
IE OUT = 577.80
32.32 LF OF 12" DUCTILE IRON S=2.17% | CB #A-10
INSTALL GUTTER INLET TYPE 2-1/2A PER CITY STD. DWG. NO. WL-601
STA. 5+44.91, 23.14' RT (LANCASTER STREET)
LID (TOP CURB) = 560.77
IE OUT = 558.10
19.23 LF OF 12" ULTRARIB
S=0.88% |
| CB #A-11
INSTALL GUTTER INLET TYPE 2-1/2A PER CITY STD. DWG. NO. WL-601
STA. 4+32.69, 18' RT (LANCASTER STREET)
LID (TOP CURB) = 547.10
IE OUT = 543.30
18.34 LF OF 12" ULTRARIB S=18.00% | CB #A-12
INSTALL CATCH BASIN TYPE G-1 PER CITY STD. DWG. NO. WL-602
STA. 3+31.60, 9.00' RT (PRIVATE DRIVE - WEST)
GRATE = 562.37
IE OUT = 560.30
10.65 LF OF 12" DUCTILE IRON S=0.94% |
| CB #A-13
INSTALL CATCH BASIN TYPE G-1 PER CITY STD. DWG. NO. WL-602
STA. 1+99.74, 7.88' RT (PEDESTRIAN PATH)
GRATE = 581.32
IE = 577.70
SUMP IE=576.20
25.64 LF OF 12" ULTRARIB S=2.34% | CB #A-14
INSTALL CATCH BASIN TYPE G-1 PER CITY STD. DWG. NO. WL-602
STA. 0+94.36, 17.30' LT (PRIVATE DRIVE - EAST)
GRATE = 580.50
IE = 578.10 SUMP IE = 576.50
46.42 LF OF 12" ULTRARIB S=0.65% |
| CO #A-19
INSTALL STD CLEANOUT CITY STD. DWG. NO. WL-206
STA. 1+17.86, 154.47' LT (PEDESTRIAN PATH)
RIM = 569.28
IE = 566.80
155.09 LF OF 4" ULTRARIB S = 2.25% | CO #A-20
INSTALL STD CLEANOUT CITY STD. DWG. NO. WL-206
STA. 1+27.75, 89.03' LT (PEDESTRIAN PATH)
RIM = 569.90 570.64
IE = 567.00 (NO IE GIVEN)
89.39 LF OF 4" ULTRARIB S = 2.50% |
| CB #A-21
INSTALL GUTTER INLET TYPE G-1 PER CITY STD. DWG. NO. WL-602
STA. 1+67.31, 10.55' RT (PVT DR WEST)
GRATE = 545.76
IE OUT = 544.20
6.35 LF OF 8" ULTRARIB S=2.65% TO SDMH A-23 | |

STORM DRAIN LATERALS

- 4" ULTRARIB (TYPICAL)
- LOT 1**
STA. 0+26.92 (SD LINE "B")
IE @ MAINLINE = 558.27
5.28 LF @ 95.3%
IE @ END = 563.30
- LOT 2**
STA. 1+59.83 (SD LINE "B")
IE @ MAINLINE = 559.79
20.09 LF @ 6.02%
IE @ END = 561.00
- LOT 3**
STA. 2+75.95 (SD LINE "B")
IE @ MAINLINE = 562.23
17.20 LF @ 32.20%
IE @ END = 567.60
- LOT 4**
STA. 3+40.70 (SD LINE "B")
IE @ MAINLINE = 567.08
15.35 LF @ 36.60%
IE @ END = 572.70
- LOT 5**
STA. 2+28.35 (SD LINE "B")
IE @ MAINLINE = 561.54
17.91 LF @ 6.48%
IE @ END = 562.70
- LOT 6**
INSTALL AT CB A-21
IE @ MAINLINE = 544.78
34.61 LF @ 6.13%
IE @ END = 546.90
- LOT 7**
INSTALL AT SDCO A-20
IE @ MAINLINE = 567.10
9.97 LF @ 14.00%
IE @ END = 568.50
- LOT 8**
INSTALL AT SDCO A-19
IE @ MAINLINE = 566.80
13.32 LF @ 2.25%
IE @ END = 567.10
- LOT 9**
INSTALL AT CB A-21
IE @ MAINLINE = 544.78
39.44 LF @ 7.66%
IE @ END = 547.80

ASBUILT CONSTRUCTION DOCUMENTS

STREET AND STORM SEWER PLAN

SIENNA'S ESTATES

City of West Linn, Clackamas County, Oregon

SAM L PAP

2798 LANCASTER STREET
WEST LINN, OREGON 97068
(503) 888-2254

LANPACIFIC
5125 SW Macdonald, Suite 140, Portland, Oregon 97239
TEL: 503/258-2097 FAX: 503/258-2447
www.lanpacific.com

REGISTERED PROFESSIONAL
ENGINEER
JULY 10, 2001
SCOTT EMERSON
EXP. 12/31/09

RECORD
DRAWING
01/18/08

THESE RECORD DRAWINGS HAVE BEEN PREPARED, IN PART, ON THE BASIS OF INFORMATION COMPILED AND FURNISHED BY THE CONTRACTOR, REVISOR, CONSTRUCTION PLANS, AND FIELD OBSERVATIONS DURING CONSTRUCTION.


DATE 01/18/08
DRAWN I JSE
DESIGNED I JSE
CHECKED I RGN
PROJECT # I SLP04-001

SHEET TITLE
STREET AND STORM PLAN

SHEET NUMBER

C009

WEST LINN CASEFILE SUB05-03 / ZC05-05 / VAR05-03

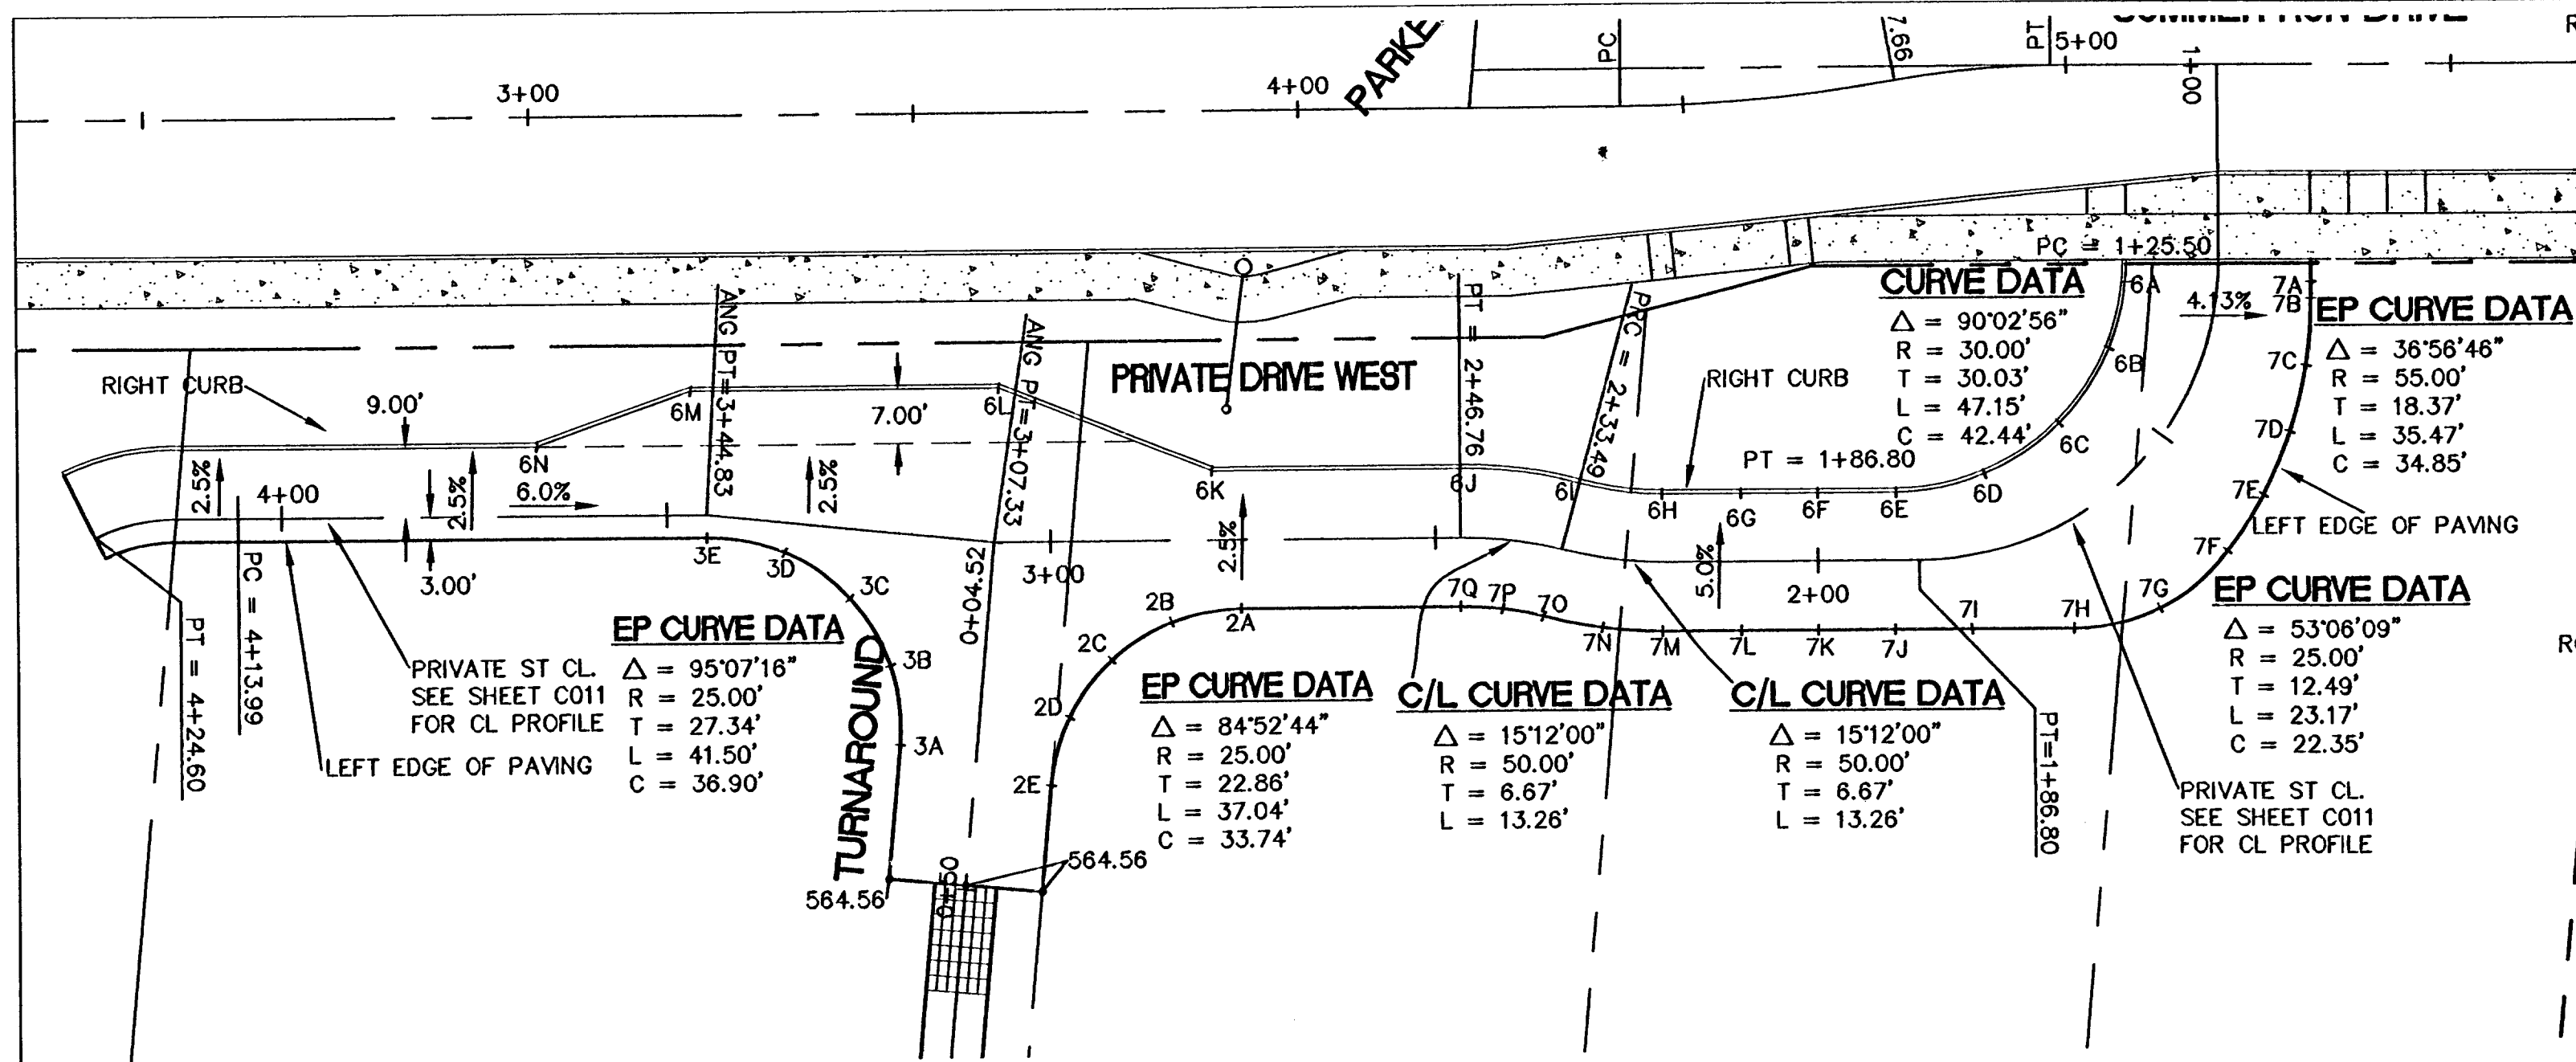

CURB RETURN DATA


	STA / OFF	EOP ELEV.
2A	PC 2+75.23 9.0	558.60
2B	1/4 Δ	559.72
2C	1/2 Δ	560.94
2D	3/4 Δ	562.17
2E	PT 0+35.52 10.0	563.13
3A	PC 0+31.75 10.0	562.81
3B	1/4 Δ	562.40
3C	1/2 Δ	562.75
3D	3/4 Δ	563.47
3E	PT 3+44.51 3.0	564.05

CURB RETURN DATA

	STA / OFF	T.C. ELEV.
6A	PC 1+25.50 12.0	545.43
6B	1/4 Δ 1+42.47 11.75	545.67
6C	1/2 Δ 1+59.11 11.04	546.20
6D	3/4 Δ 1+75.21 10.02	546.72
6E	PT 1+89.80 9.0	547.93
6F	2+00 9.0	548.80
6G	2+10 9.0	549.85
6H	PC 2+20.23 9.0	551.06
6I	PRC 2+33.49 9.0	552.89
6J	PT 2+46.76 9.0	554.88
6K	ANG PT 2+78.97 9.0	559.07
6L	ANG PT 3+08.76 19.96	561.69
6M	ANG PT 3+46.84 16.0	564.53
6N	ANG PT 3+66.84 9.0	565.59

CURB RETURN DATA

	STA / OFF	EOP ELEV.
7A	1+25.50 12.0	544.44
7B	PC 1+29.30 12.24	544.66
7C	1/4 Δ 1+35.96 13.15	545.04
7D	1/2 Δ 1+42.49 14.13	545.44
7E	3/4 Δ 1+48.39 15.14	545.92
7F	PCC 1+55.18 16.17	546.30
7G	1/2 Δ 1+63.32 16.04	546.84
7H	PT 1+71.40 13.0	547.20
7I	1+81.31 9.48	547.70
7J	1+90 9.0	548.32
7K	2+00 9.0	549.20
7L	2+10 9.0	550.25
7M	PC 2+20.23 9.0	551.46
7N	1/2 Δ 2+26.88 9.0	552.29
7O	PRC 2+33.49 9.0	553.17
7P	1/2 Δ 2+40.13 9.0	554.13
7Q	PT 2+46.76 9.0	555.06

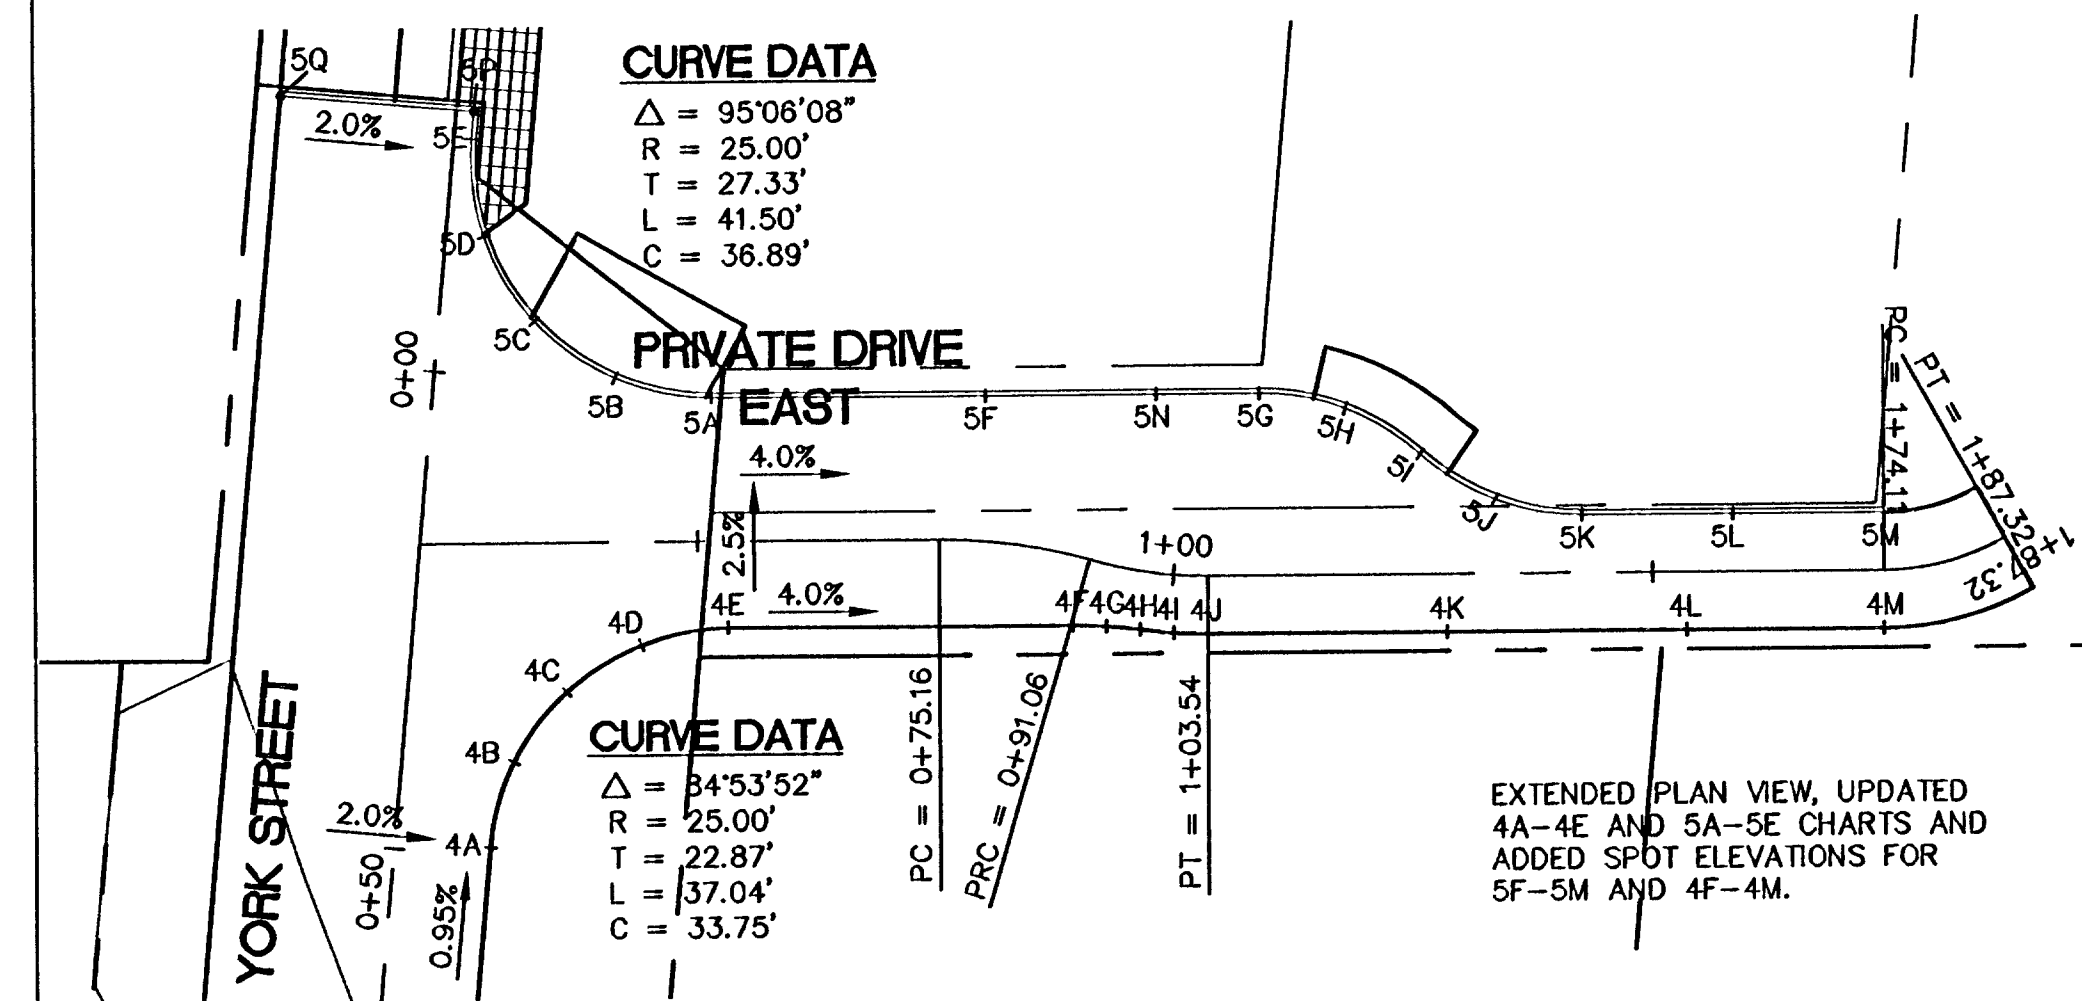

CURB RETURN DATA

	STA / OFF	EOP ELEV.
4A	PC 0+49.08, 10'LT (YORK)	583.36
4B	1/4 Δ	583.27
4C	1/2 Δ	583.12
4D	3/4 Δ	582.89
4E	PT 0+53.14, 9'RT (PRIV)	582.56

CURB RETURN DATA

	STA / OFF	FL ELEV.
5A	PC 0+51.53, 15'RT (PRIV)	582.02
5B	1/4 Δ	582.42
5C	1/2 Δ	582.79
5D	3/4 Δ	583.08
5E	PT -0+24.48, 1.82'LT (YORK)	583.25
5P	-0+27.31, 1.82'LT (YORK)	583.28
5Q	-0+27.31, 18.45'RT (YORK)	583.69

EDGE OF PAVEMENT SPOT ELEVATIONS

	STATION / OFFSET	EOP ELEV.
4F	0+91.21, 6.99'RT	581.15
4G	0+94.22, 6.25'RT	581.12
4H	0+97.31, 6.00'RT	581.13
4I	1+00.43, 6.00'RT	581.17
4J	1+03.54, 6.00'RT	581.23
4K	1+28.54, 6.00'RT	582.75
4L	1+53.54, 6.00'RT	584.75
4M	1+74.11, 6.00'RT	585.31

STATION OFFSET FROM PRIVATE-EAST ALIGNMENT





GUTTER SPOT ELEVATIONS

	STATION / OFFSET	FL ELEV.
5F	0+79.03, 15.17'LT	580.91
5G	1+09.00, 19.00'LT	580.79
5H	1+18.02, 17.32'LT	581.32
5I	1+25.82, 12.50'LT	582.04
5J	1+33.62, 7.68'LT	582.91
5K	1+42.64, 6.00'LT	583.76
5L	1+58.37, 6.00'LT	584.65
5M	1+74.11, 6.00'LT	585.01
5N	0+94.36, 18.45'LT	580.61

STATION OFFSET FROM PRIVATE-EAST ALIGNMENT
 5N IS LOW POINT

CURB RETURN DATA

	STA / OFF	T.C. ELEV.
1A	PC 5+48.01 23.0	560.73
1B	1/4 Δ	560.37
1C	1/2 Δ	560.21
1D	3/4 Δ	560.12
1E	PT 1+48.46 18.0	559.92

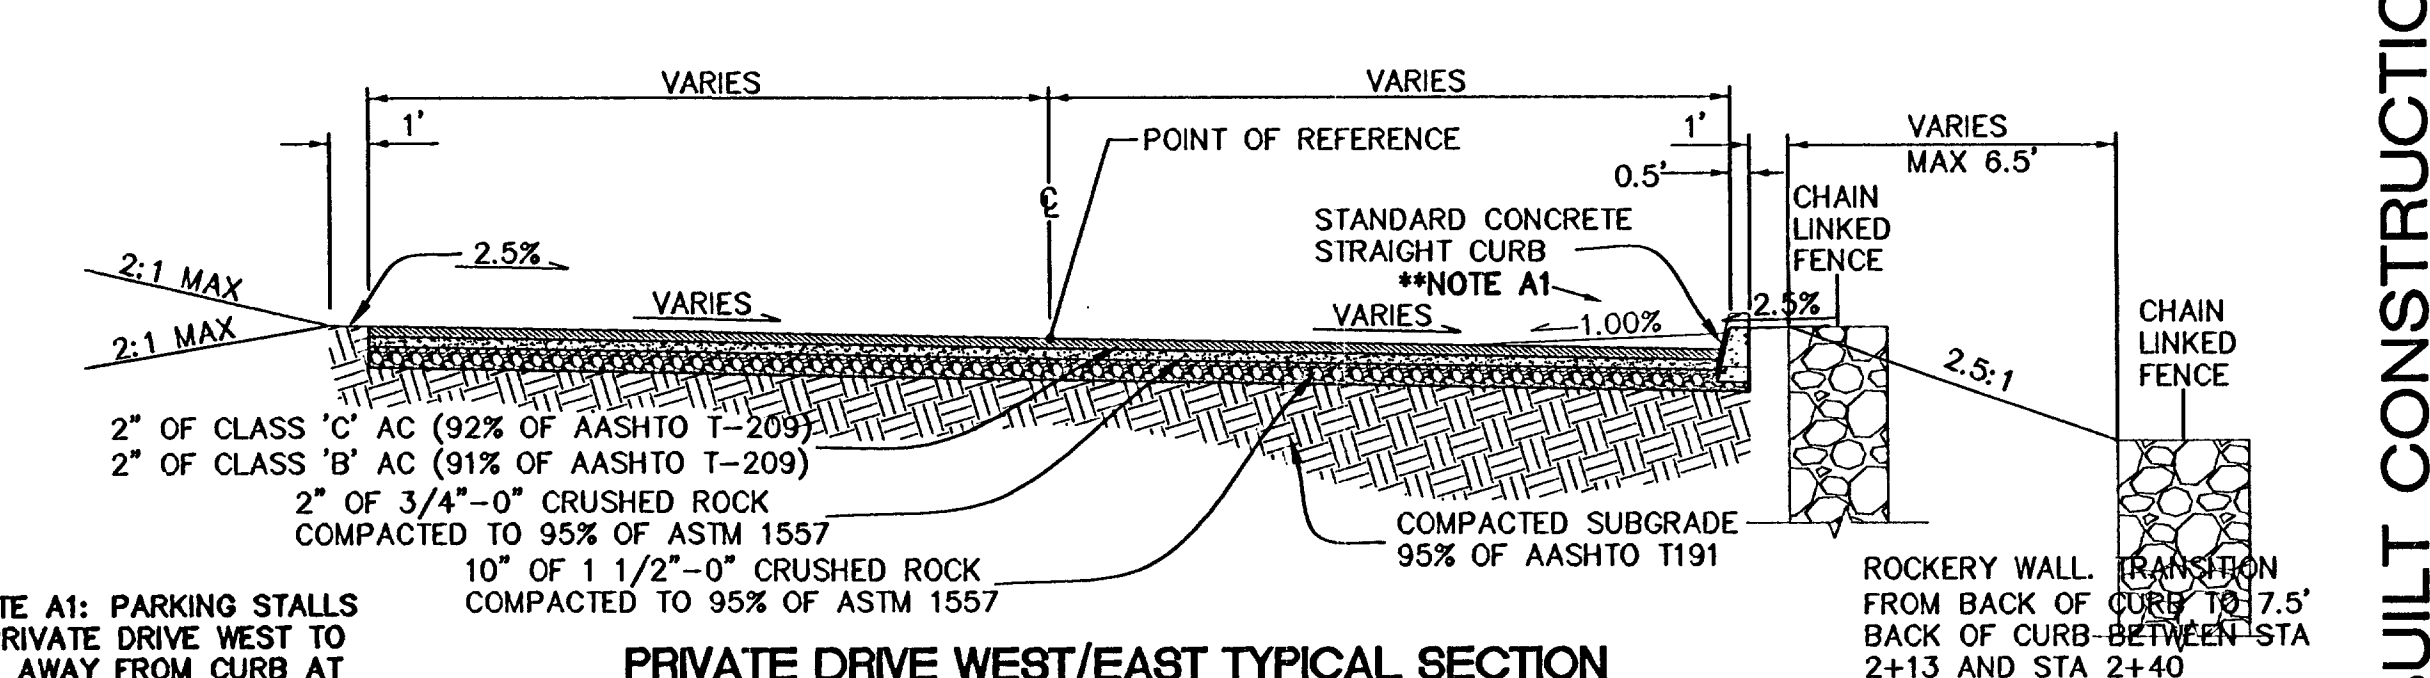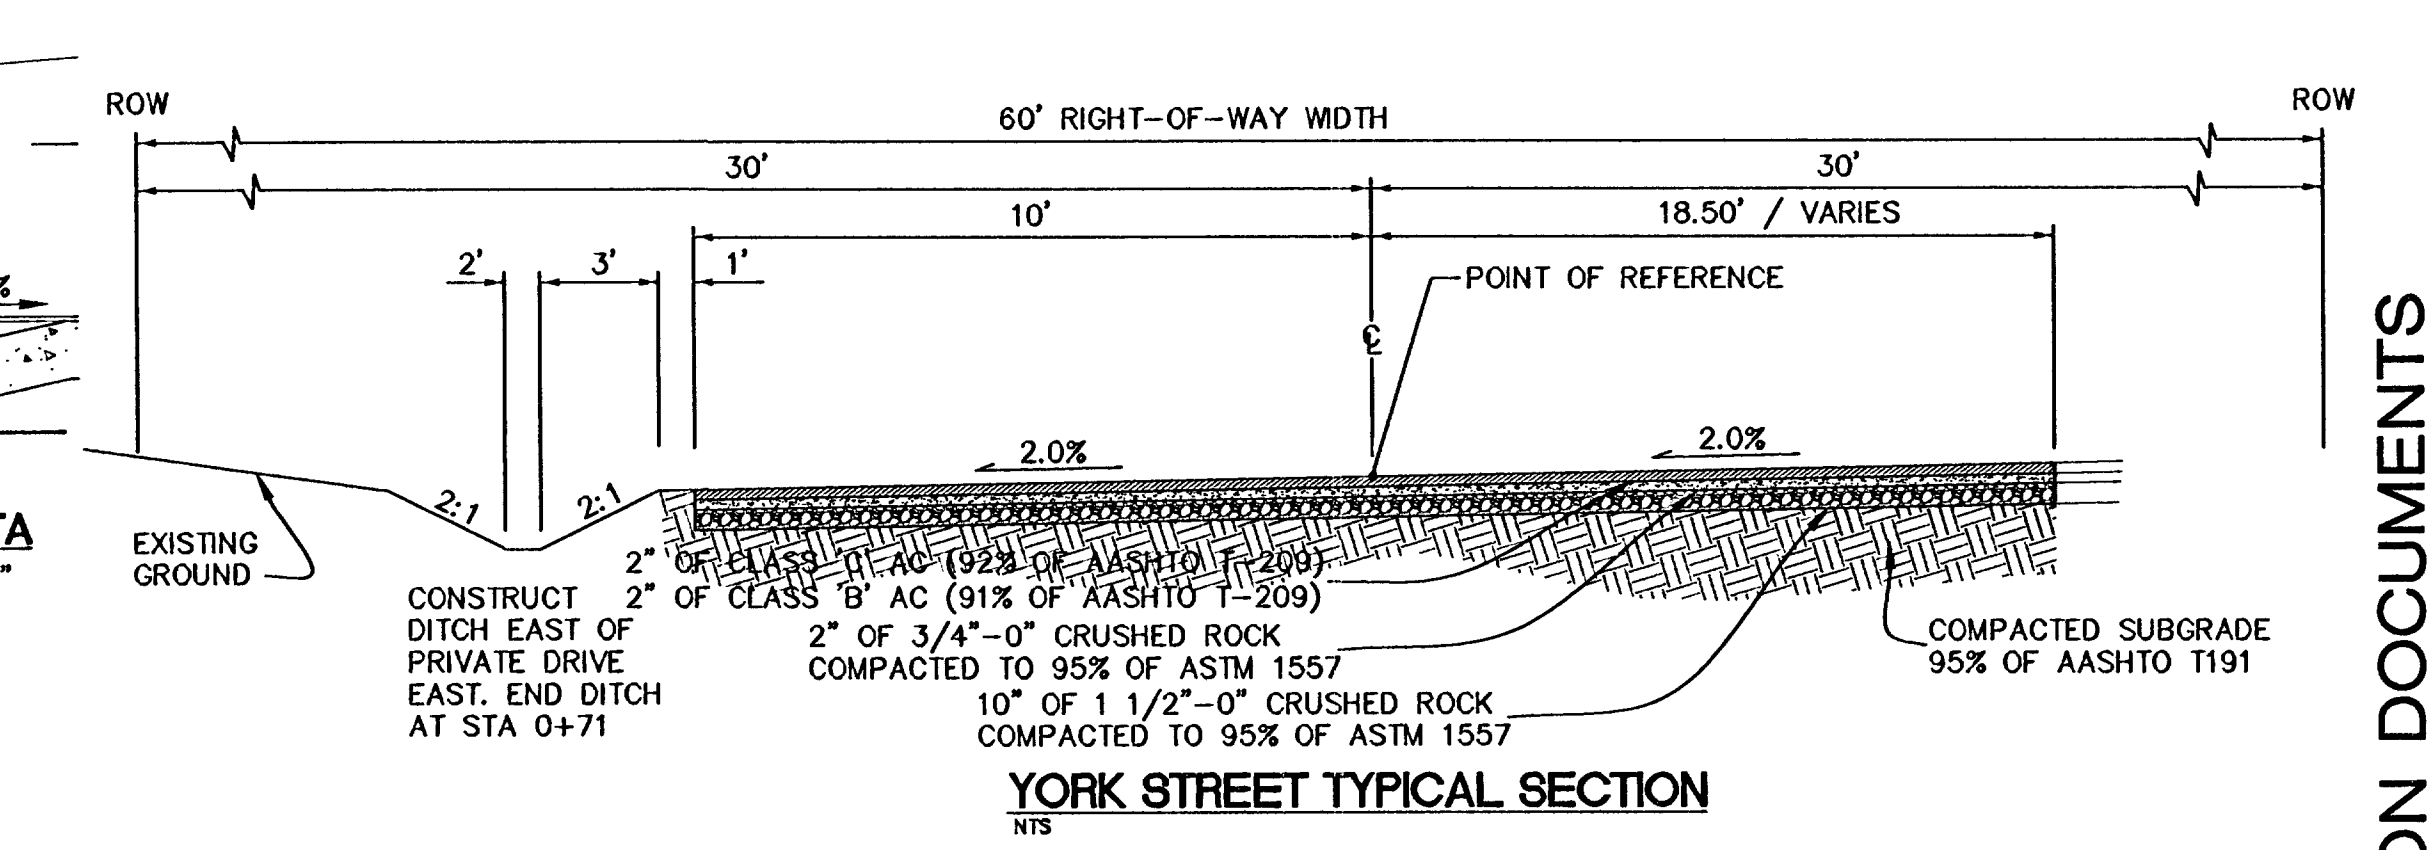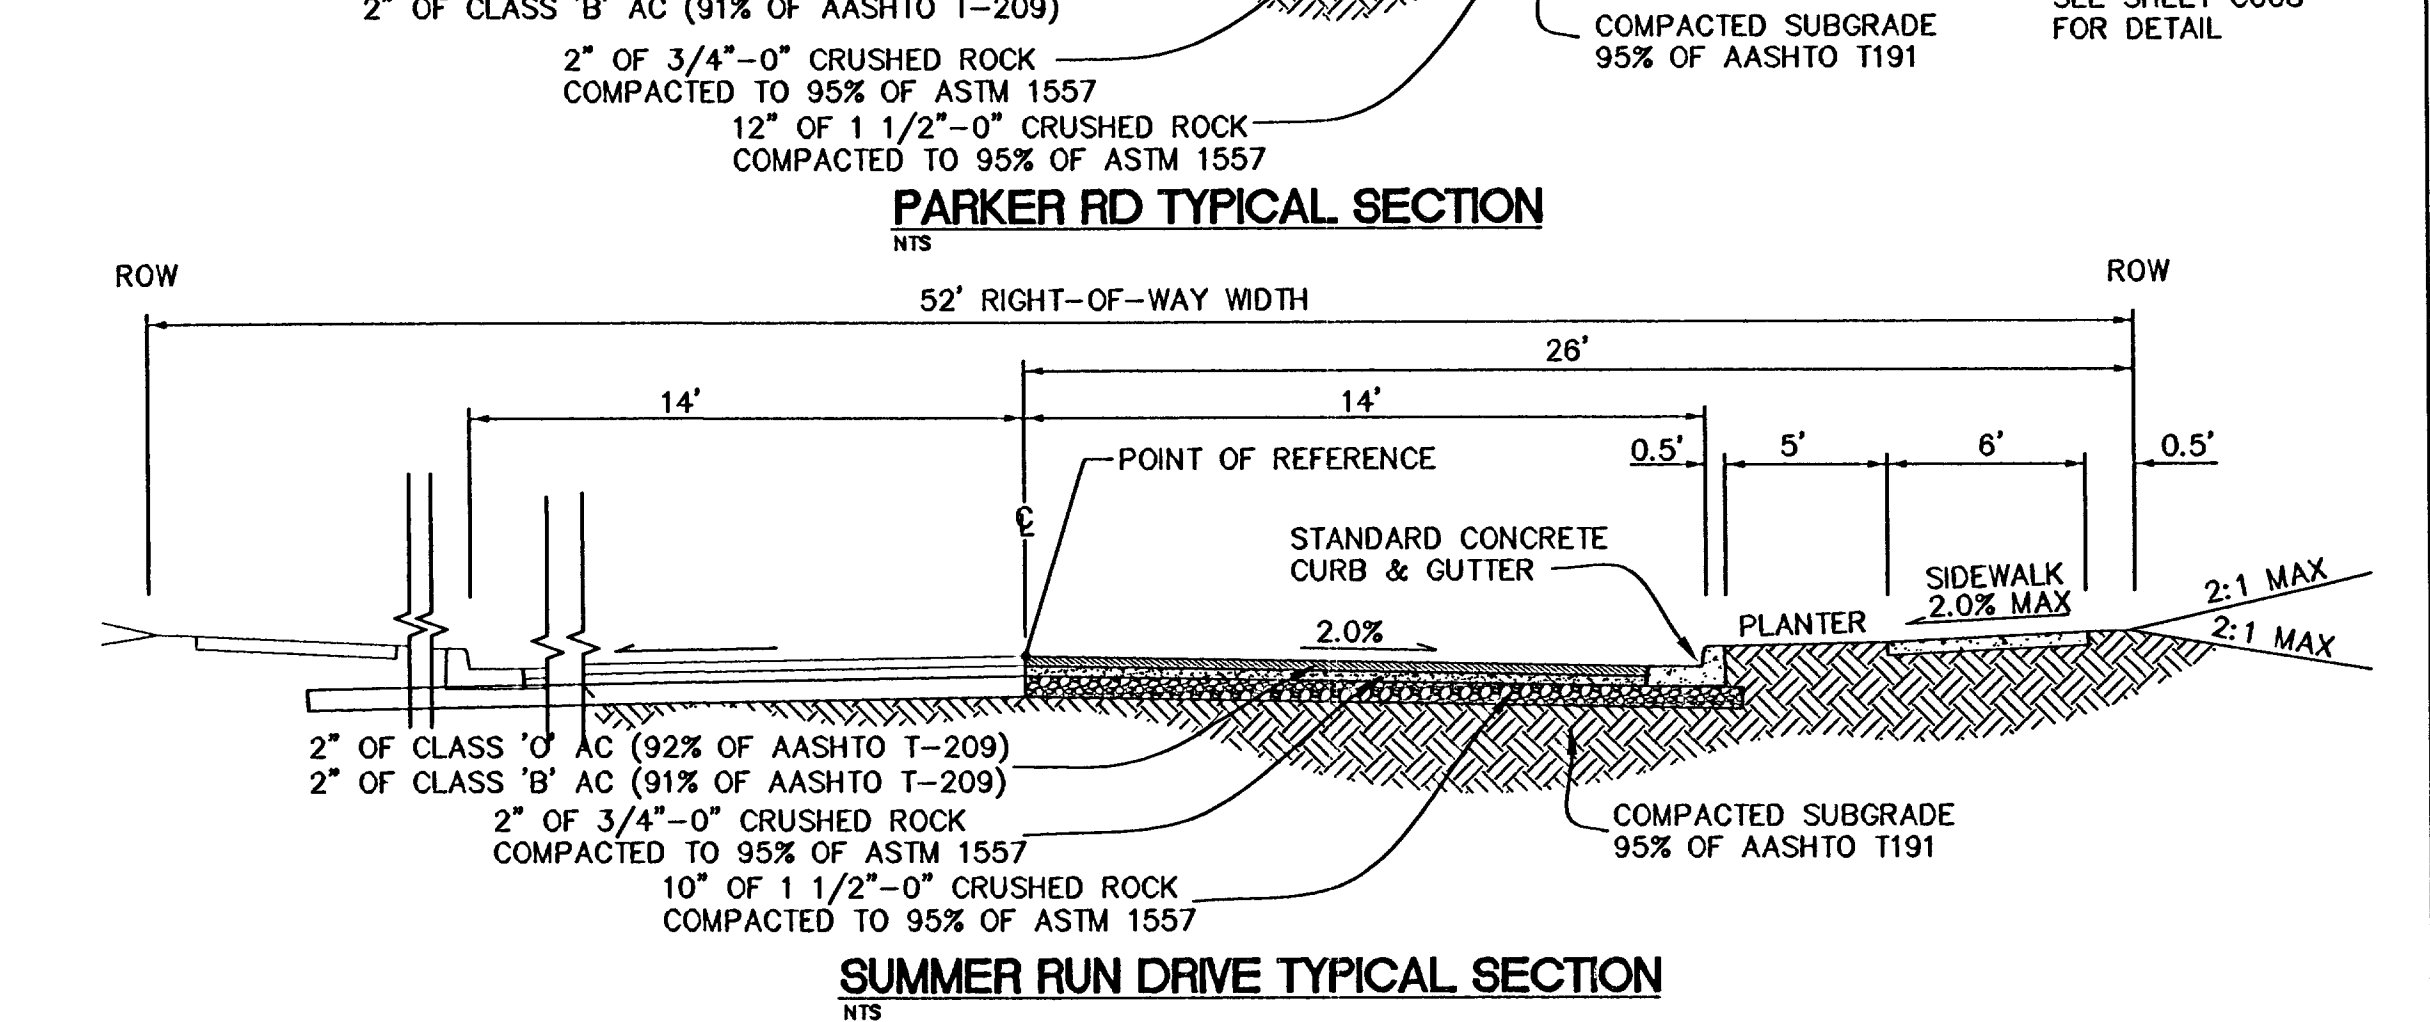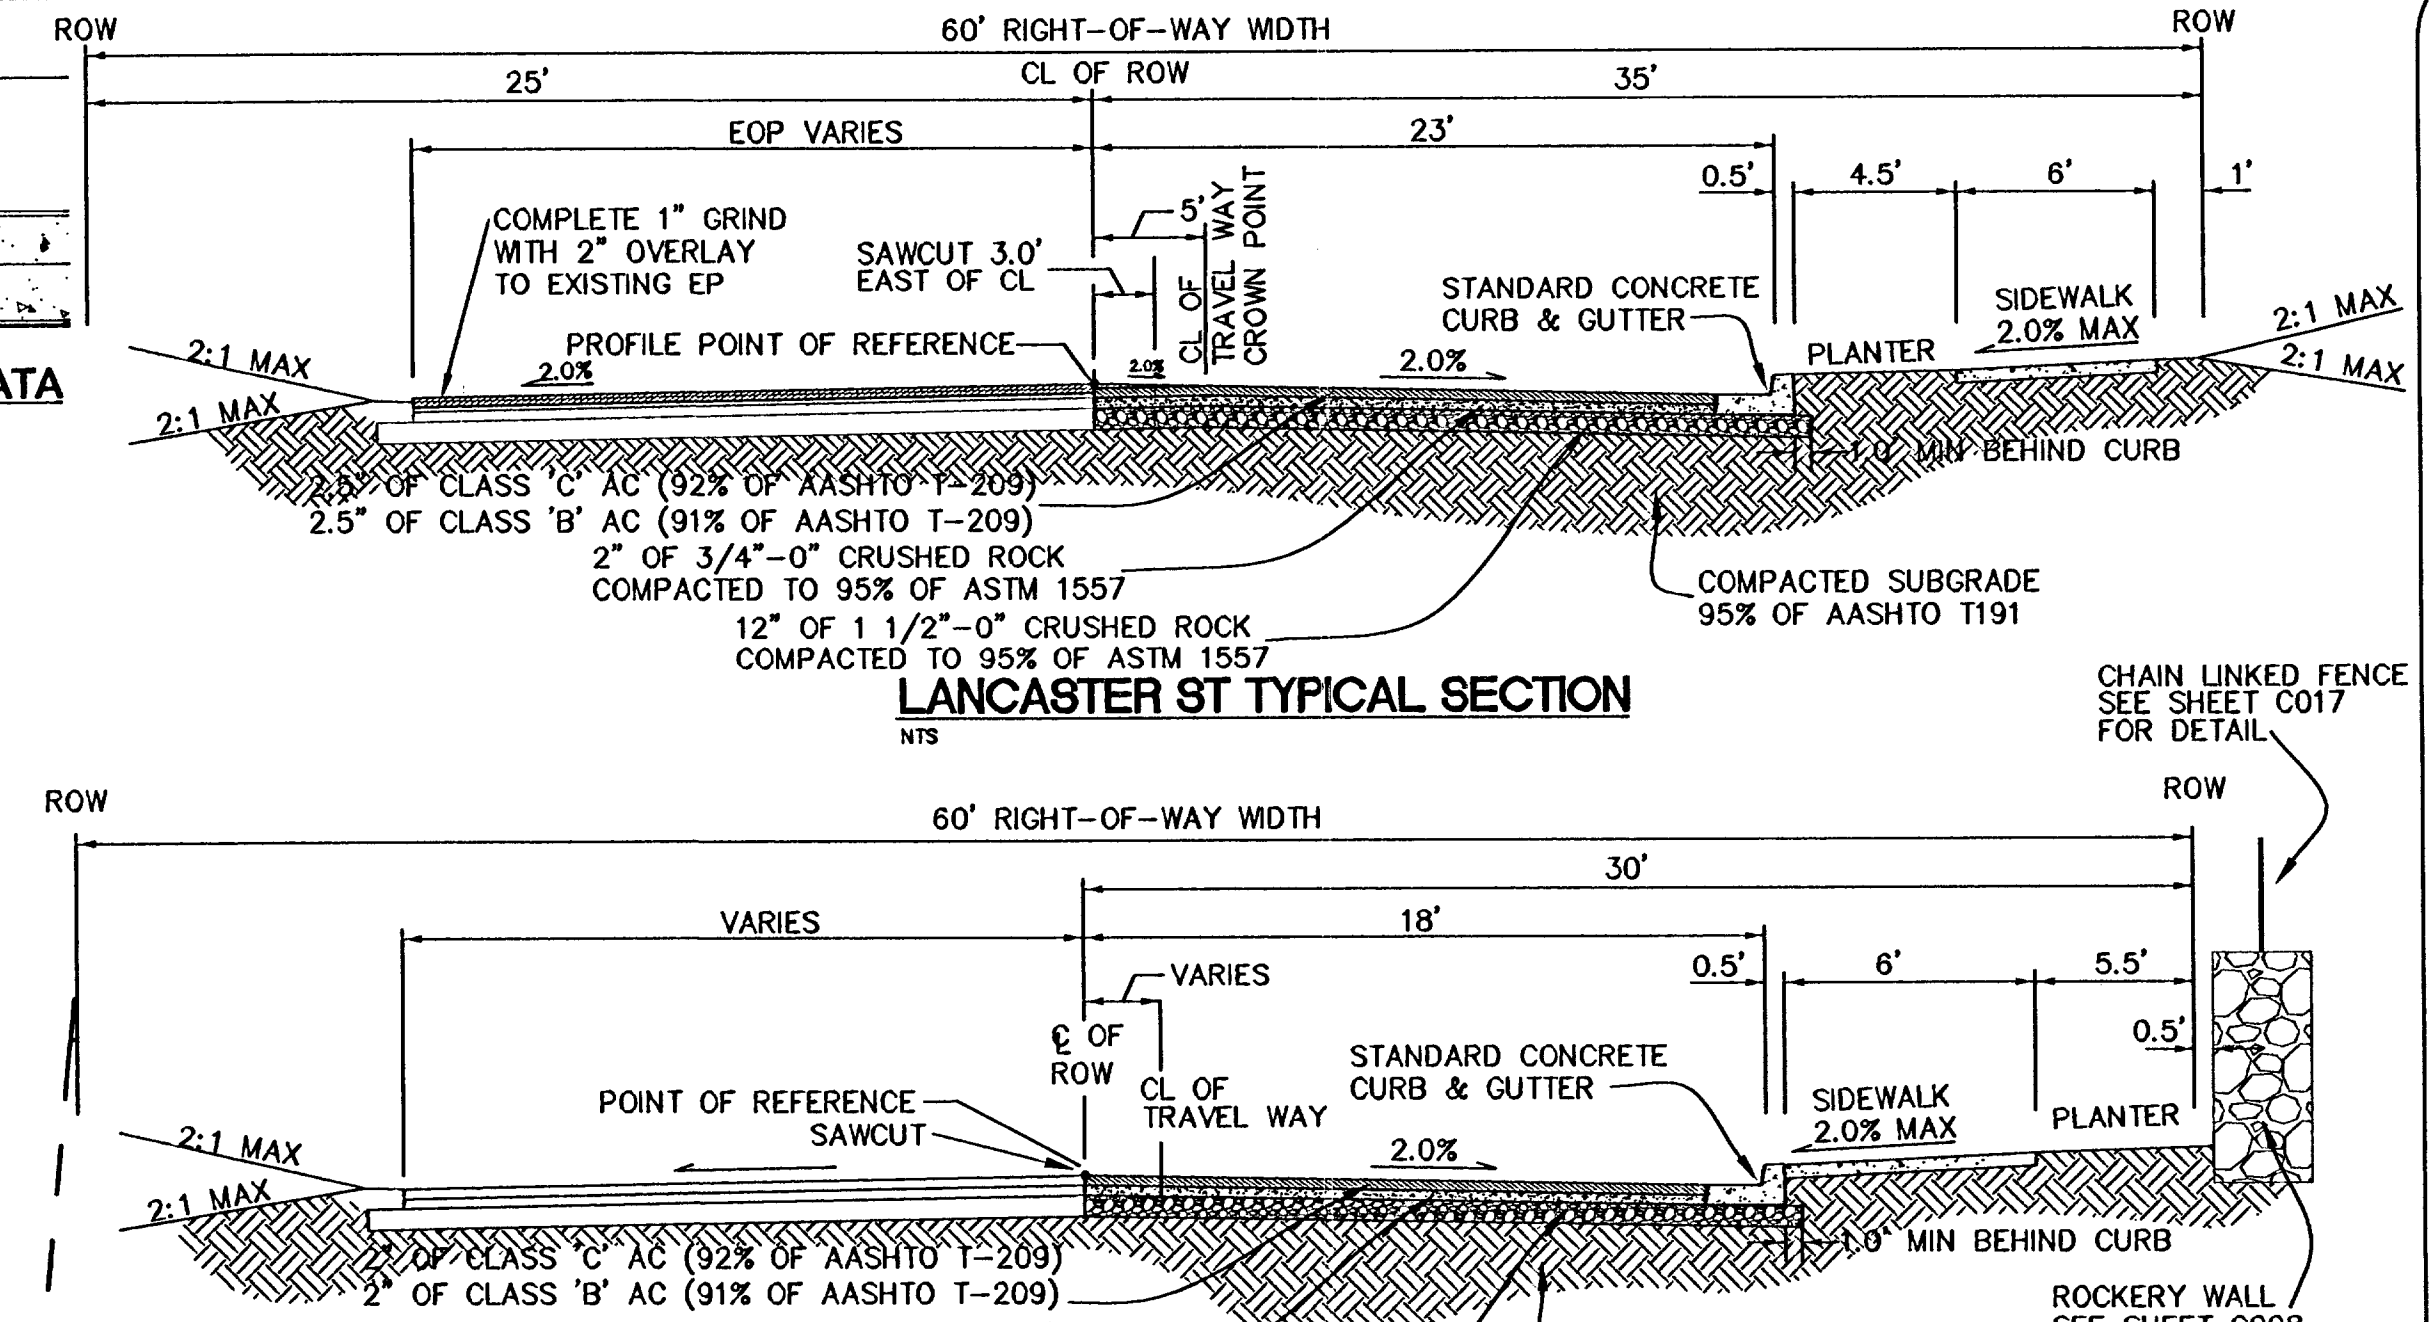

****NOTE A1: PARKING STALLS ON PRIVATE DRIVE WEST TO SHED AWAY FROM CURB AT 1.00% TO VALLEY GUTTER GRADE BREAK TRAVELING THROUGH CATCH BASIN**

WEST LINN CASEFILE SUB05-03 / ZC05-05 / VAR05-03

TYPICAL STREET SECTIONS

SIENNA'S ESTATES

City of West Linn, Clackamas County, Oregon

SAM L PAP

2799 LANCASTER STREET
WEST LINN, OREGON 97068
(503) 885-2254

ENGINEERING
ARCHITECT
CONSULTING
LANDSCAPE
ARCHITECTURE

LANPACIFIC

5125 SW Macadam, Suite 140, Portland, Oregon 97239
503 1238-2097 FAX: 503 1238-2447
www.lanpacific.com

1-23-08
REGISTERED PROFESSIONAL
ENGINEER
NO. 12345
JULY 10, 2001
J. SCOTT ELMORE

EXP. 12/31/09

RECORD DRAWING
01/18/08



THESE RECORD DRAWINGS HAVE BEEN PREPARED, IN PART, ON THE BASIS OF INFORMATION COMPILED AND FURNISHED BY THE CONTRACTOR. REVISIONS TO CONSTRUCTION PLANS, AND FIELD OBSERVATIONS DURING CONSTRUCTION.

DATE 01/18/08
DRAWN J. JSE
DESIGNED J. JSE
CHECKED J. RGN
PROJECT # I SLP04-001




SHEET TITLE
TYPICAL STREET SECTIONS





SHEET NUMBER
C010

ASBUILT CONSTRUCTION DOCUMENTS


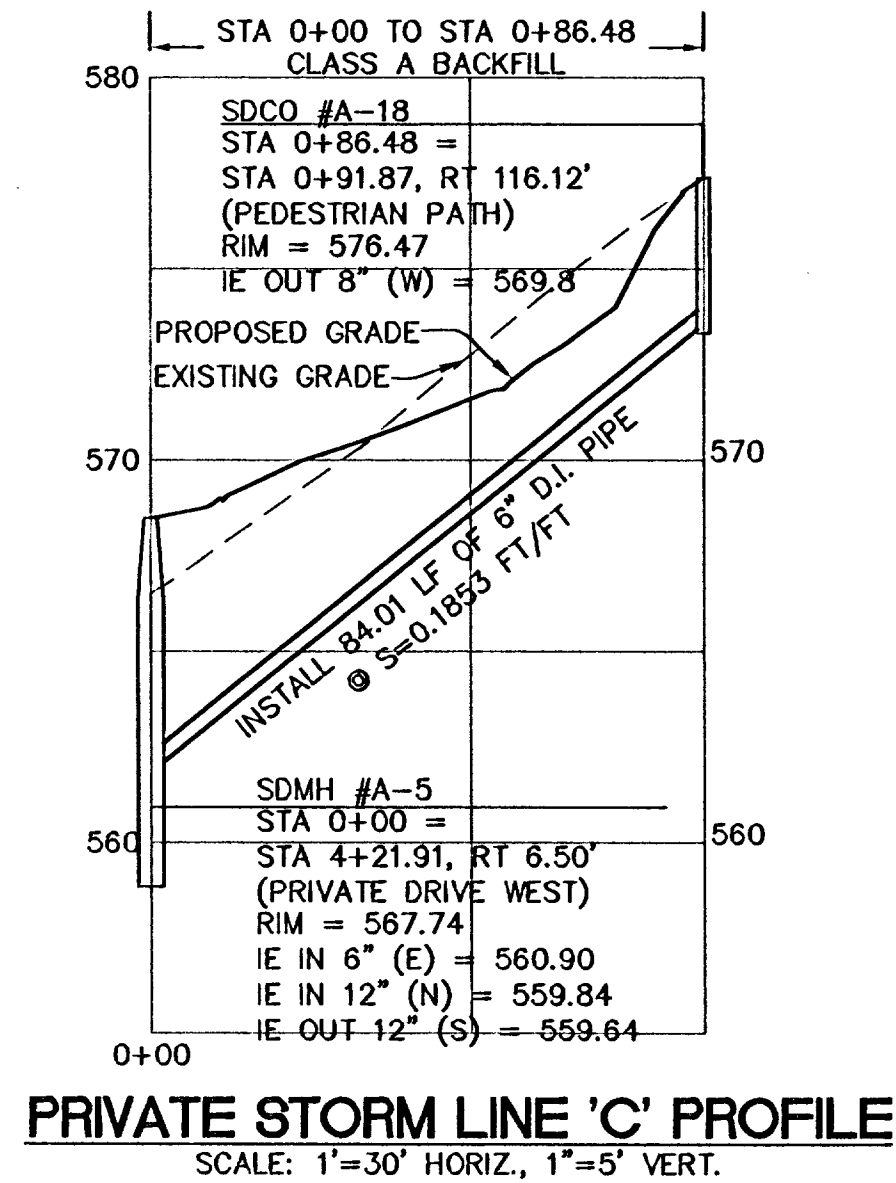
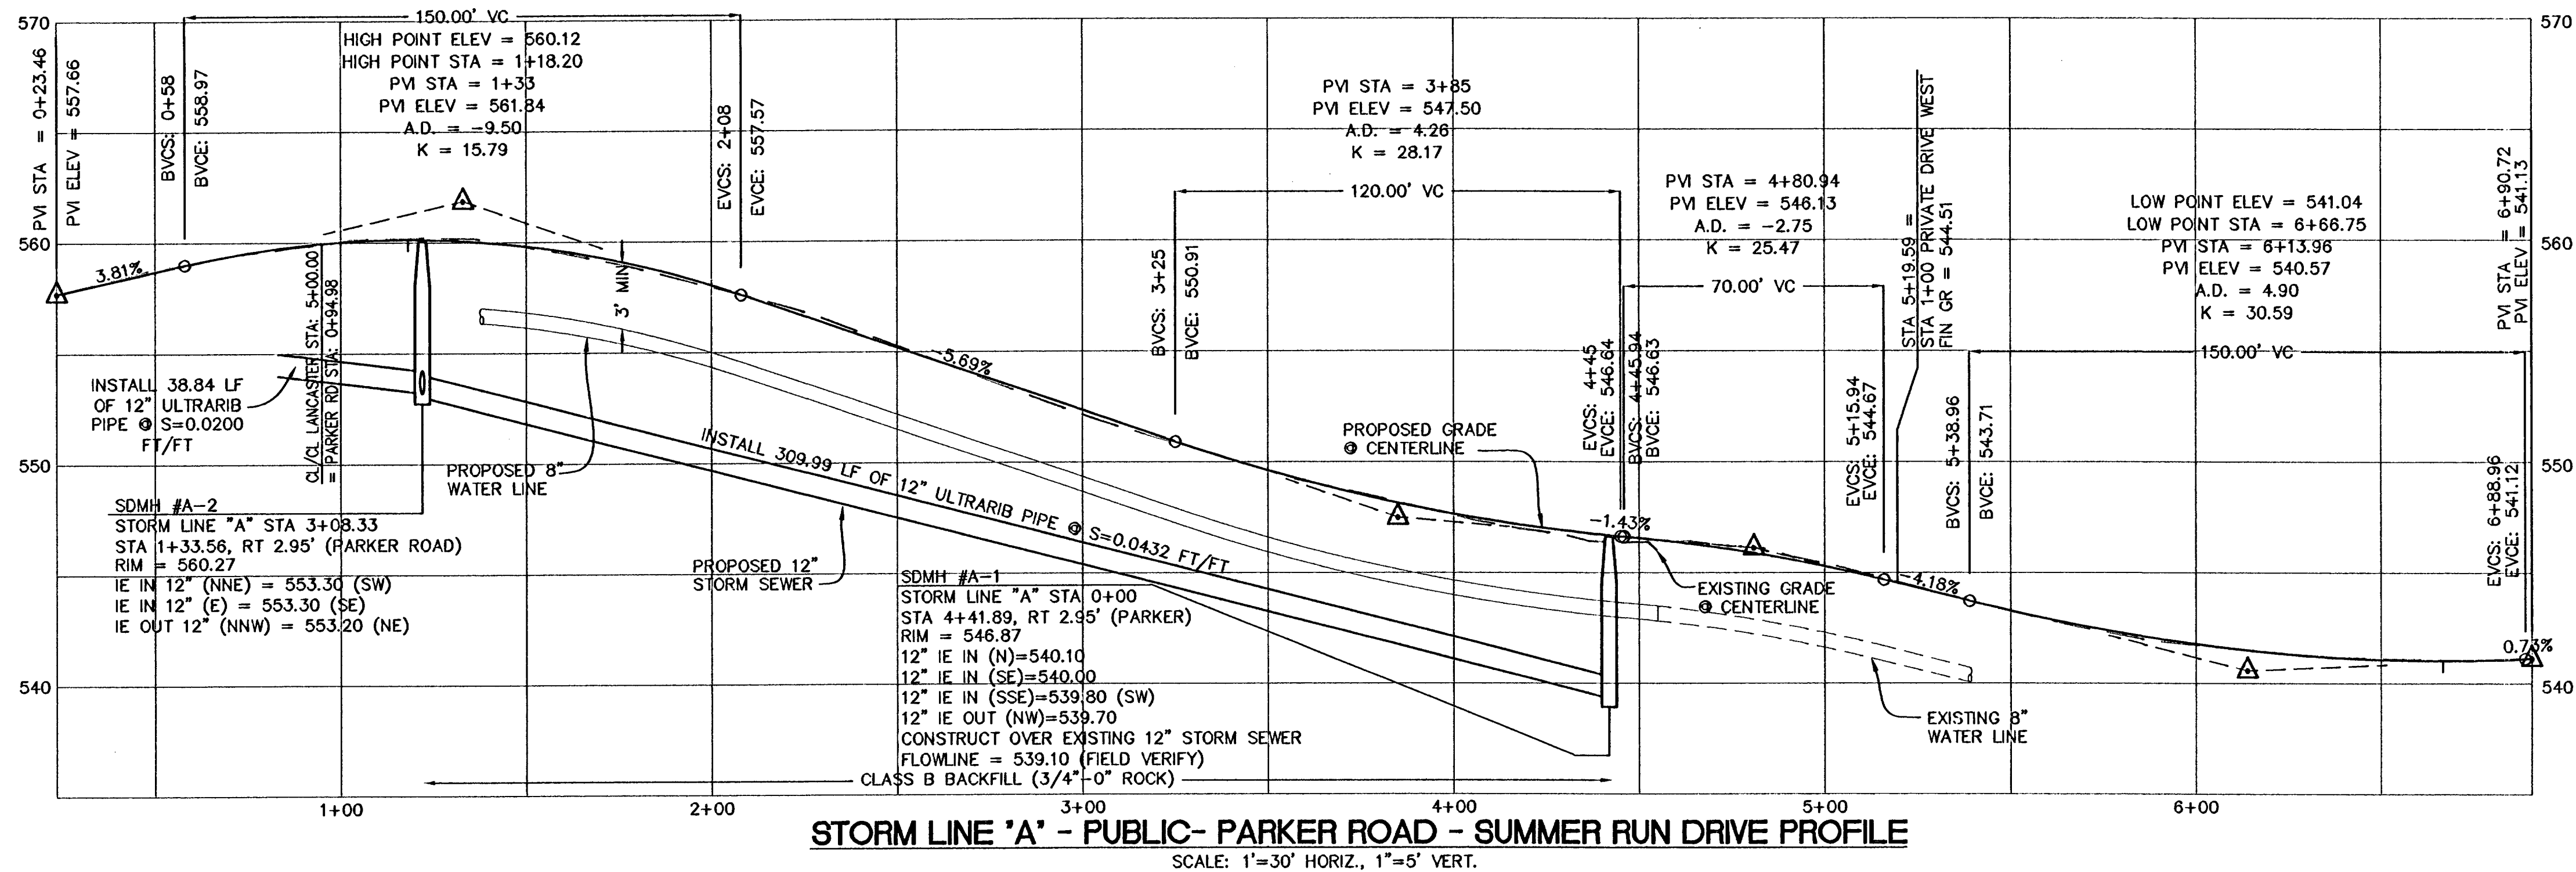


SDMH A-9 DETAIL
NOT TO SCALE




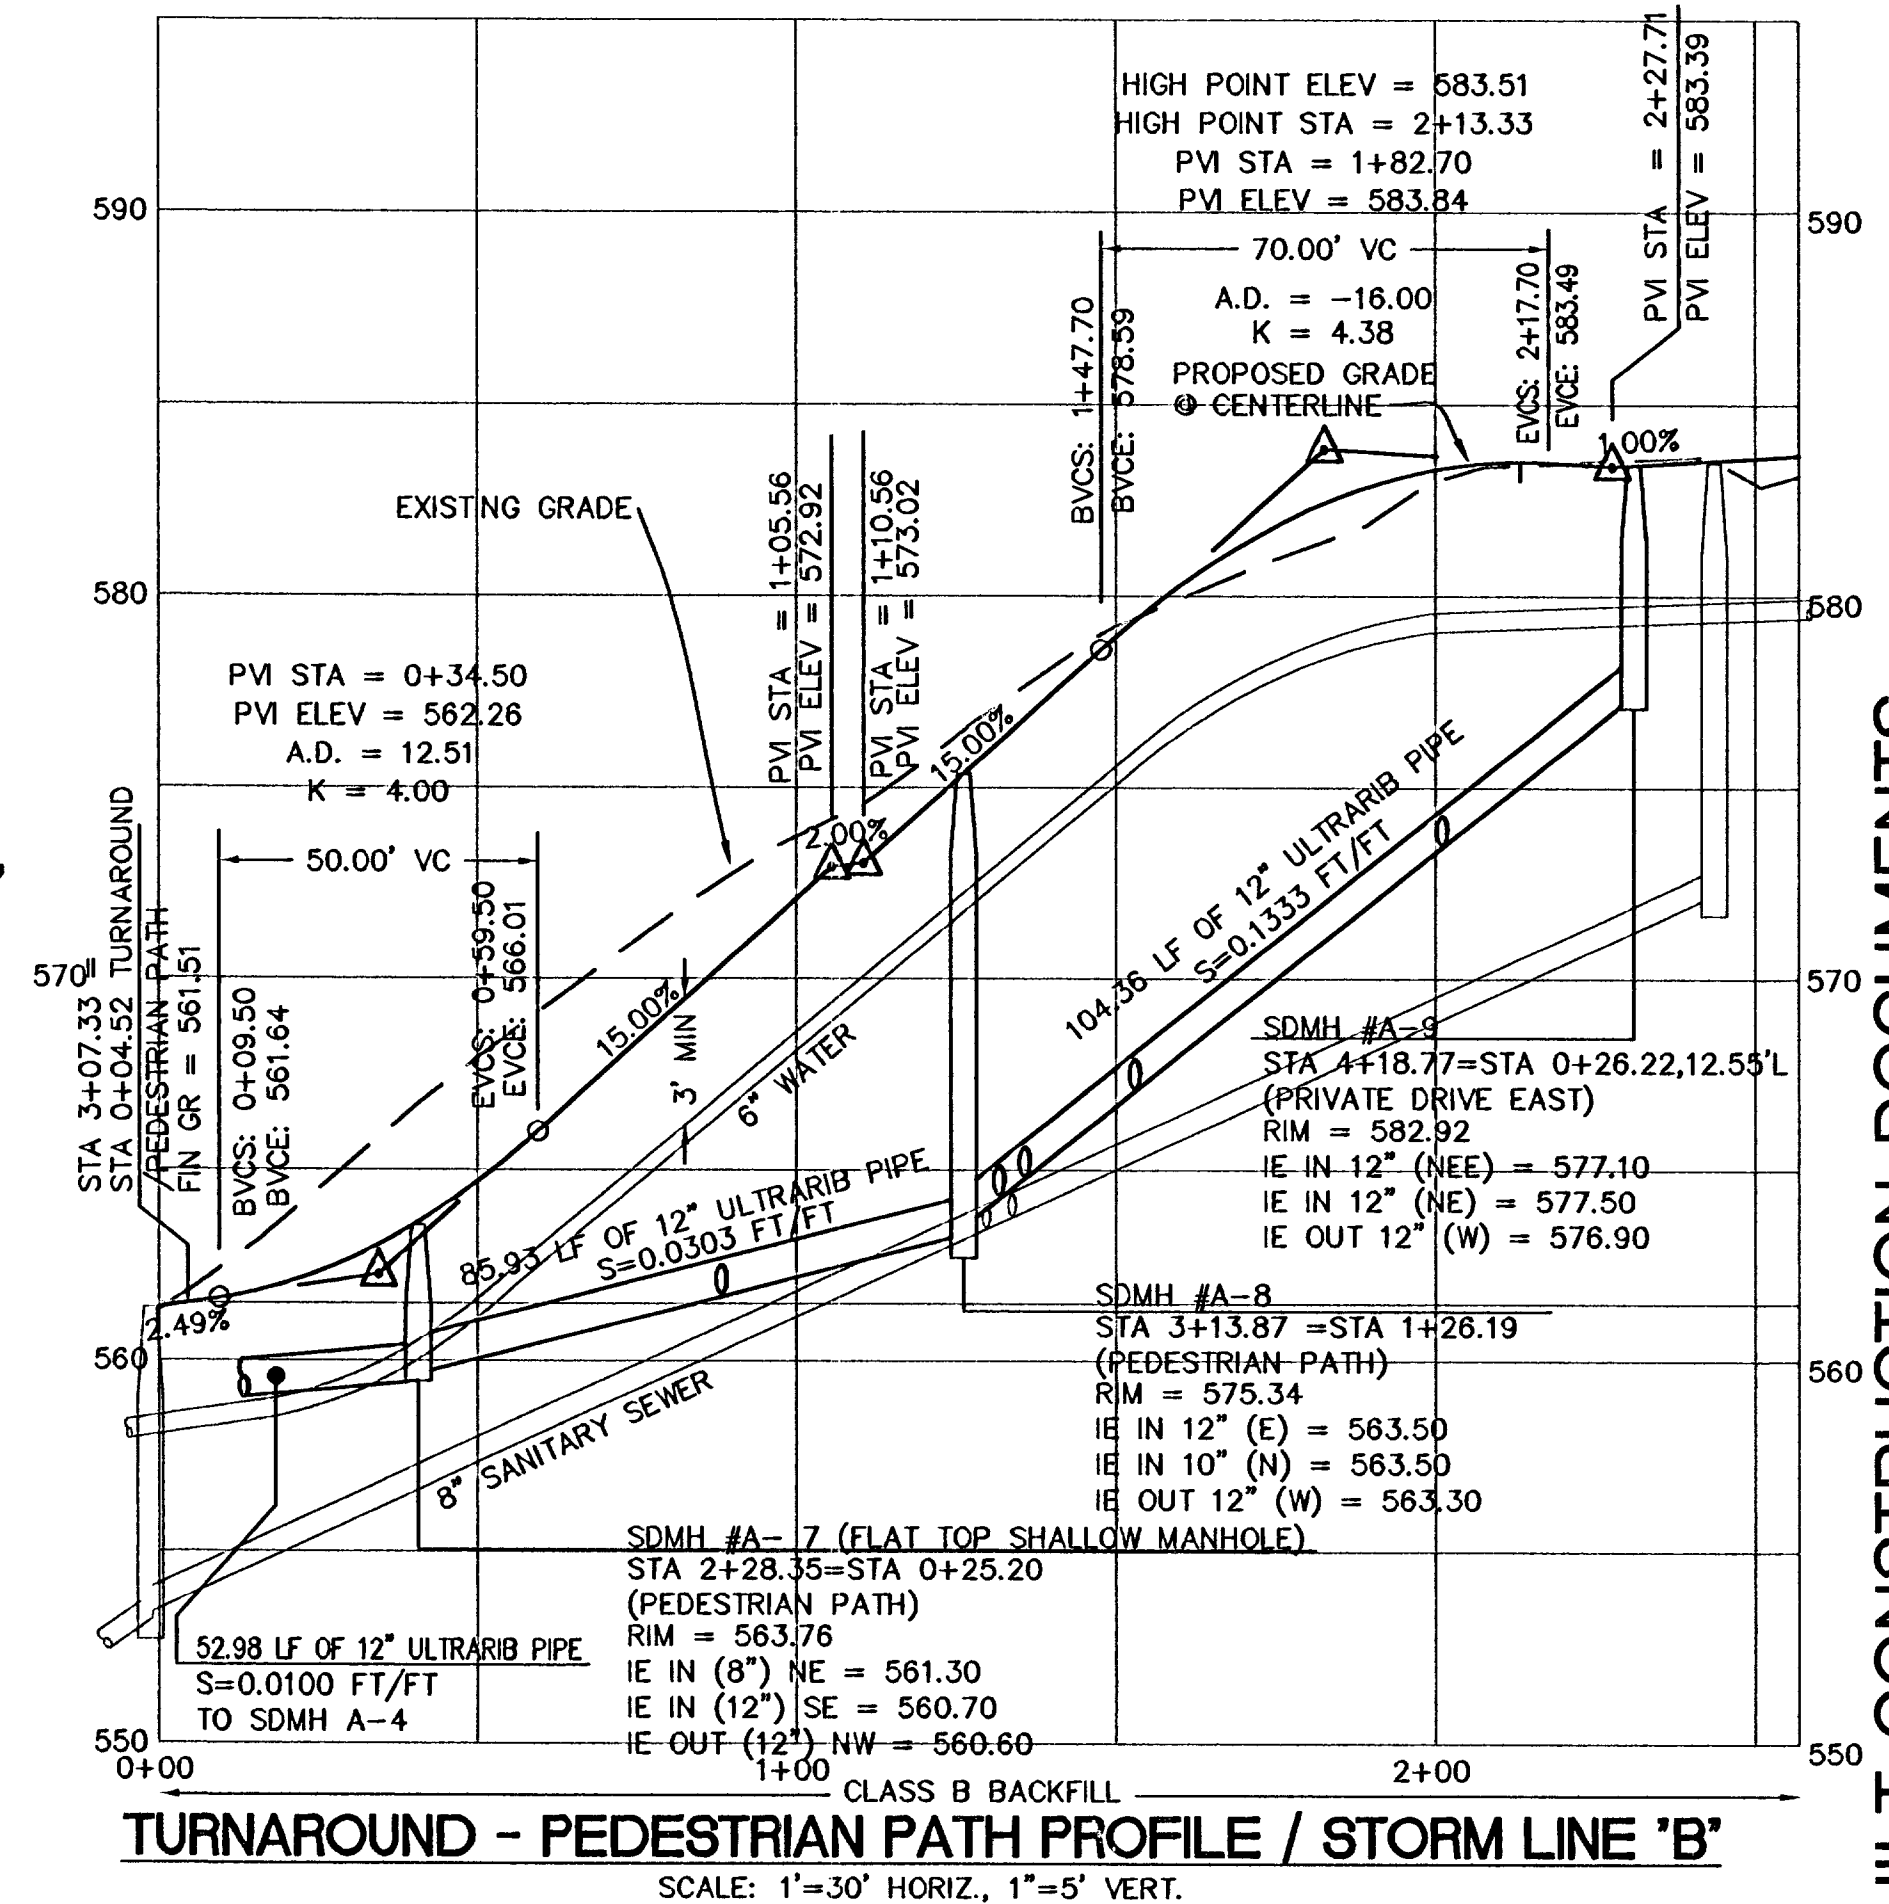
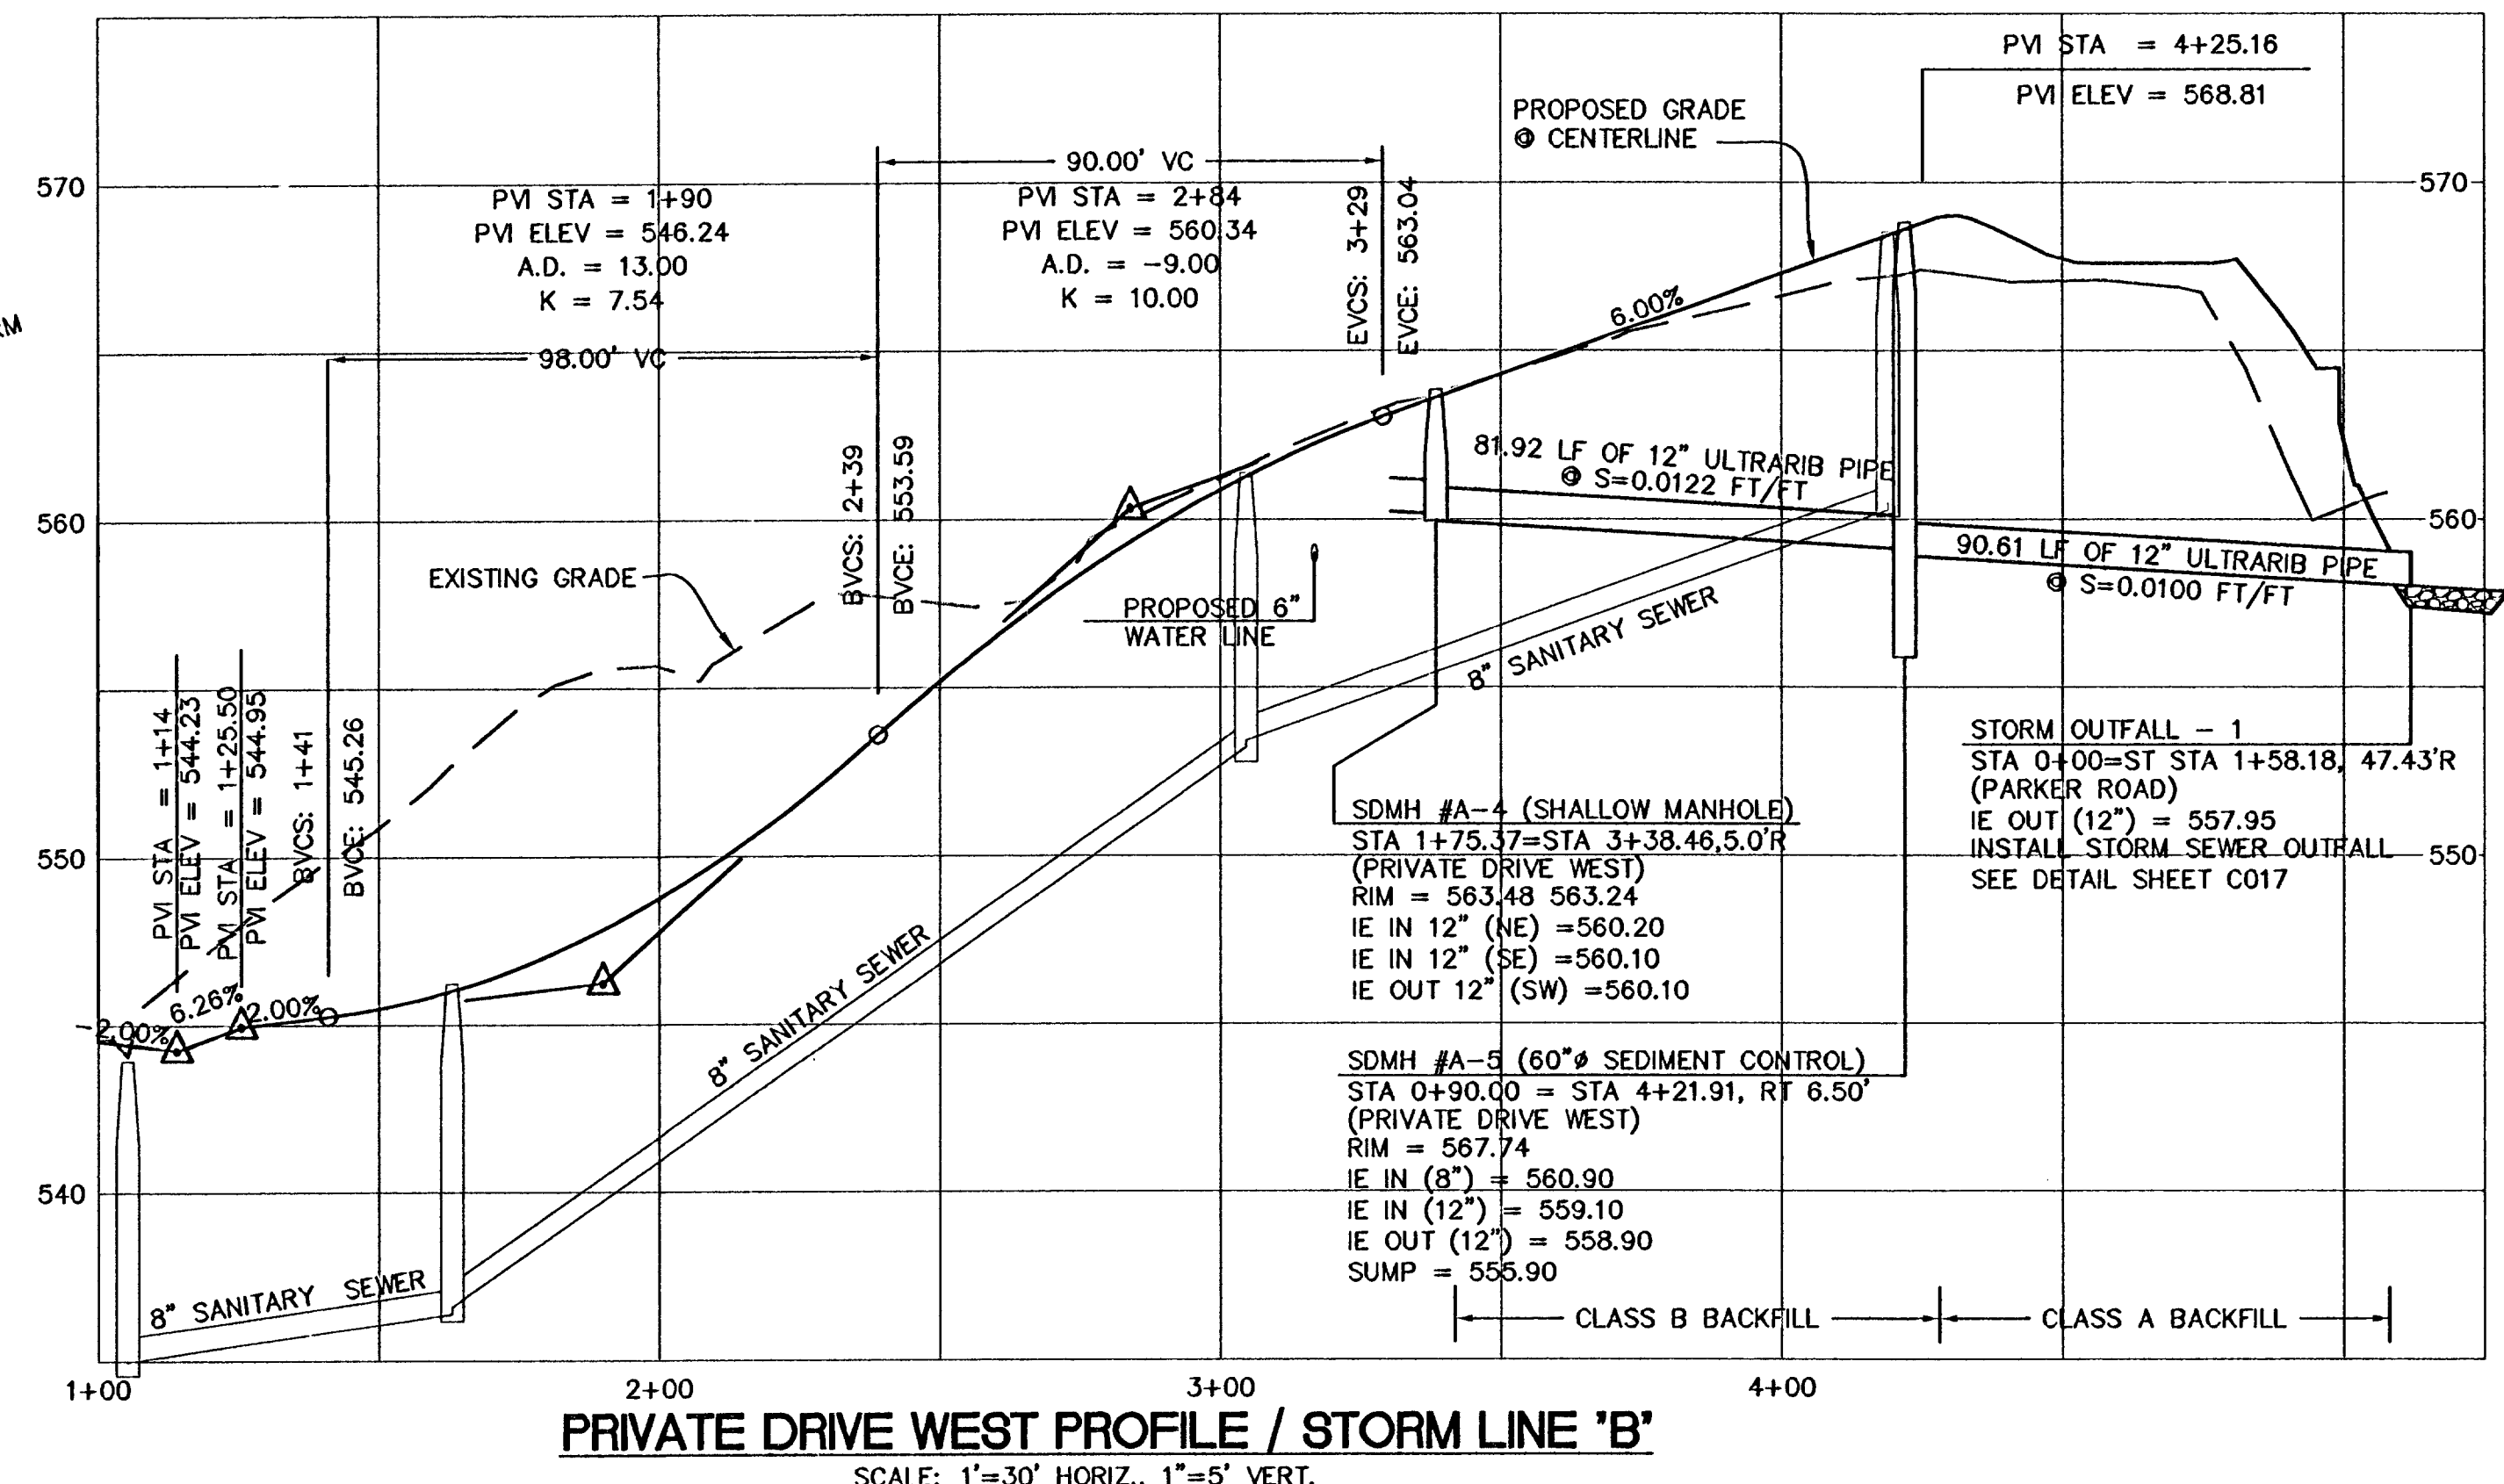
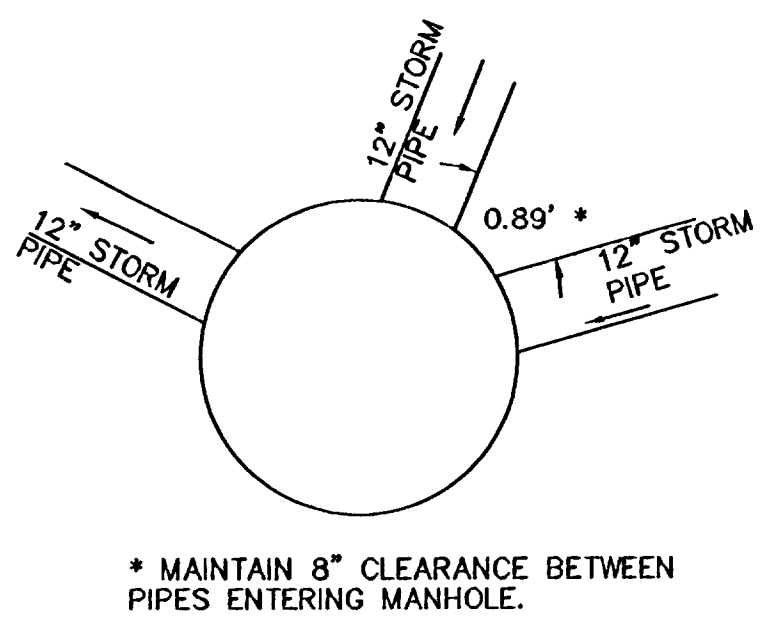


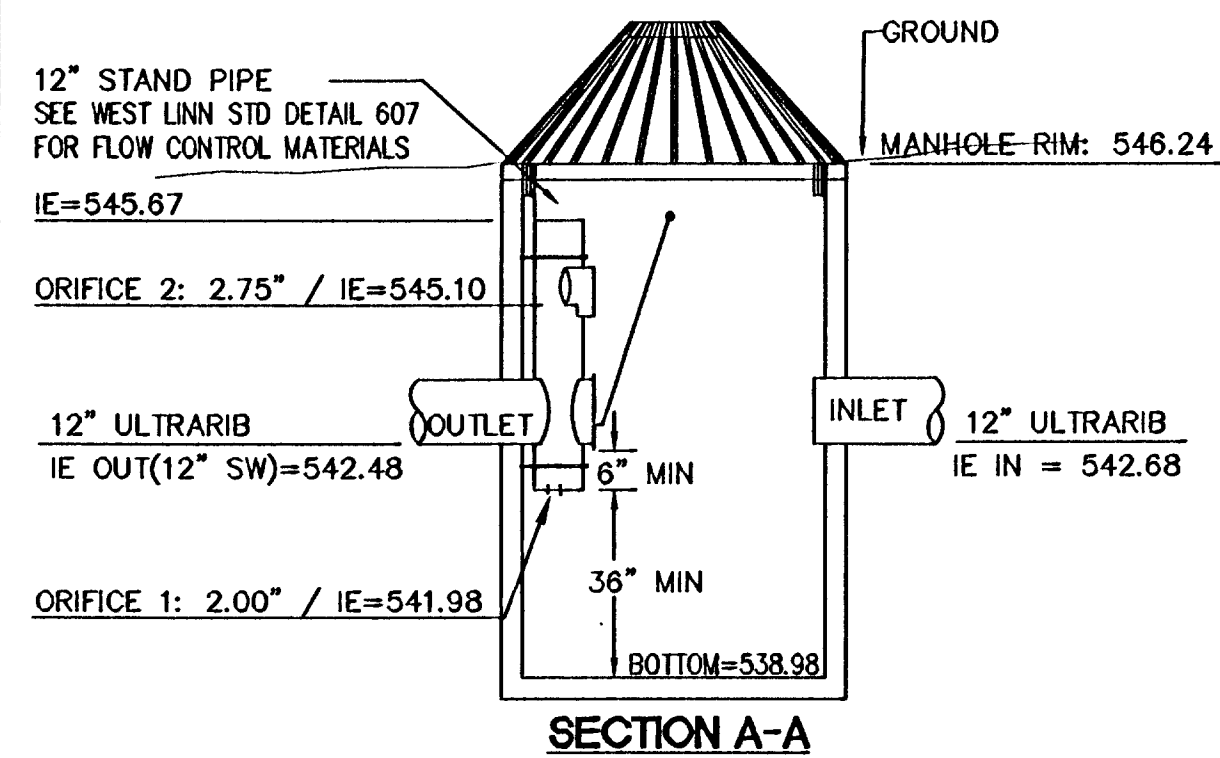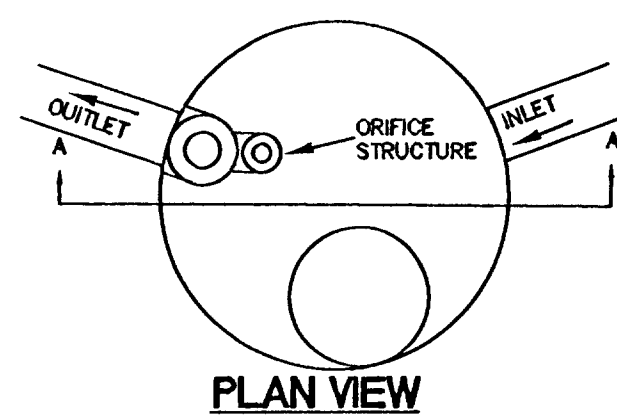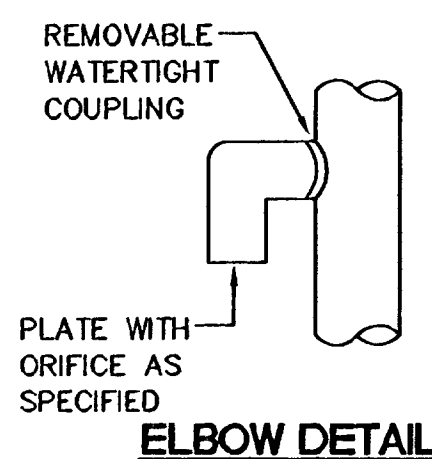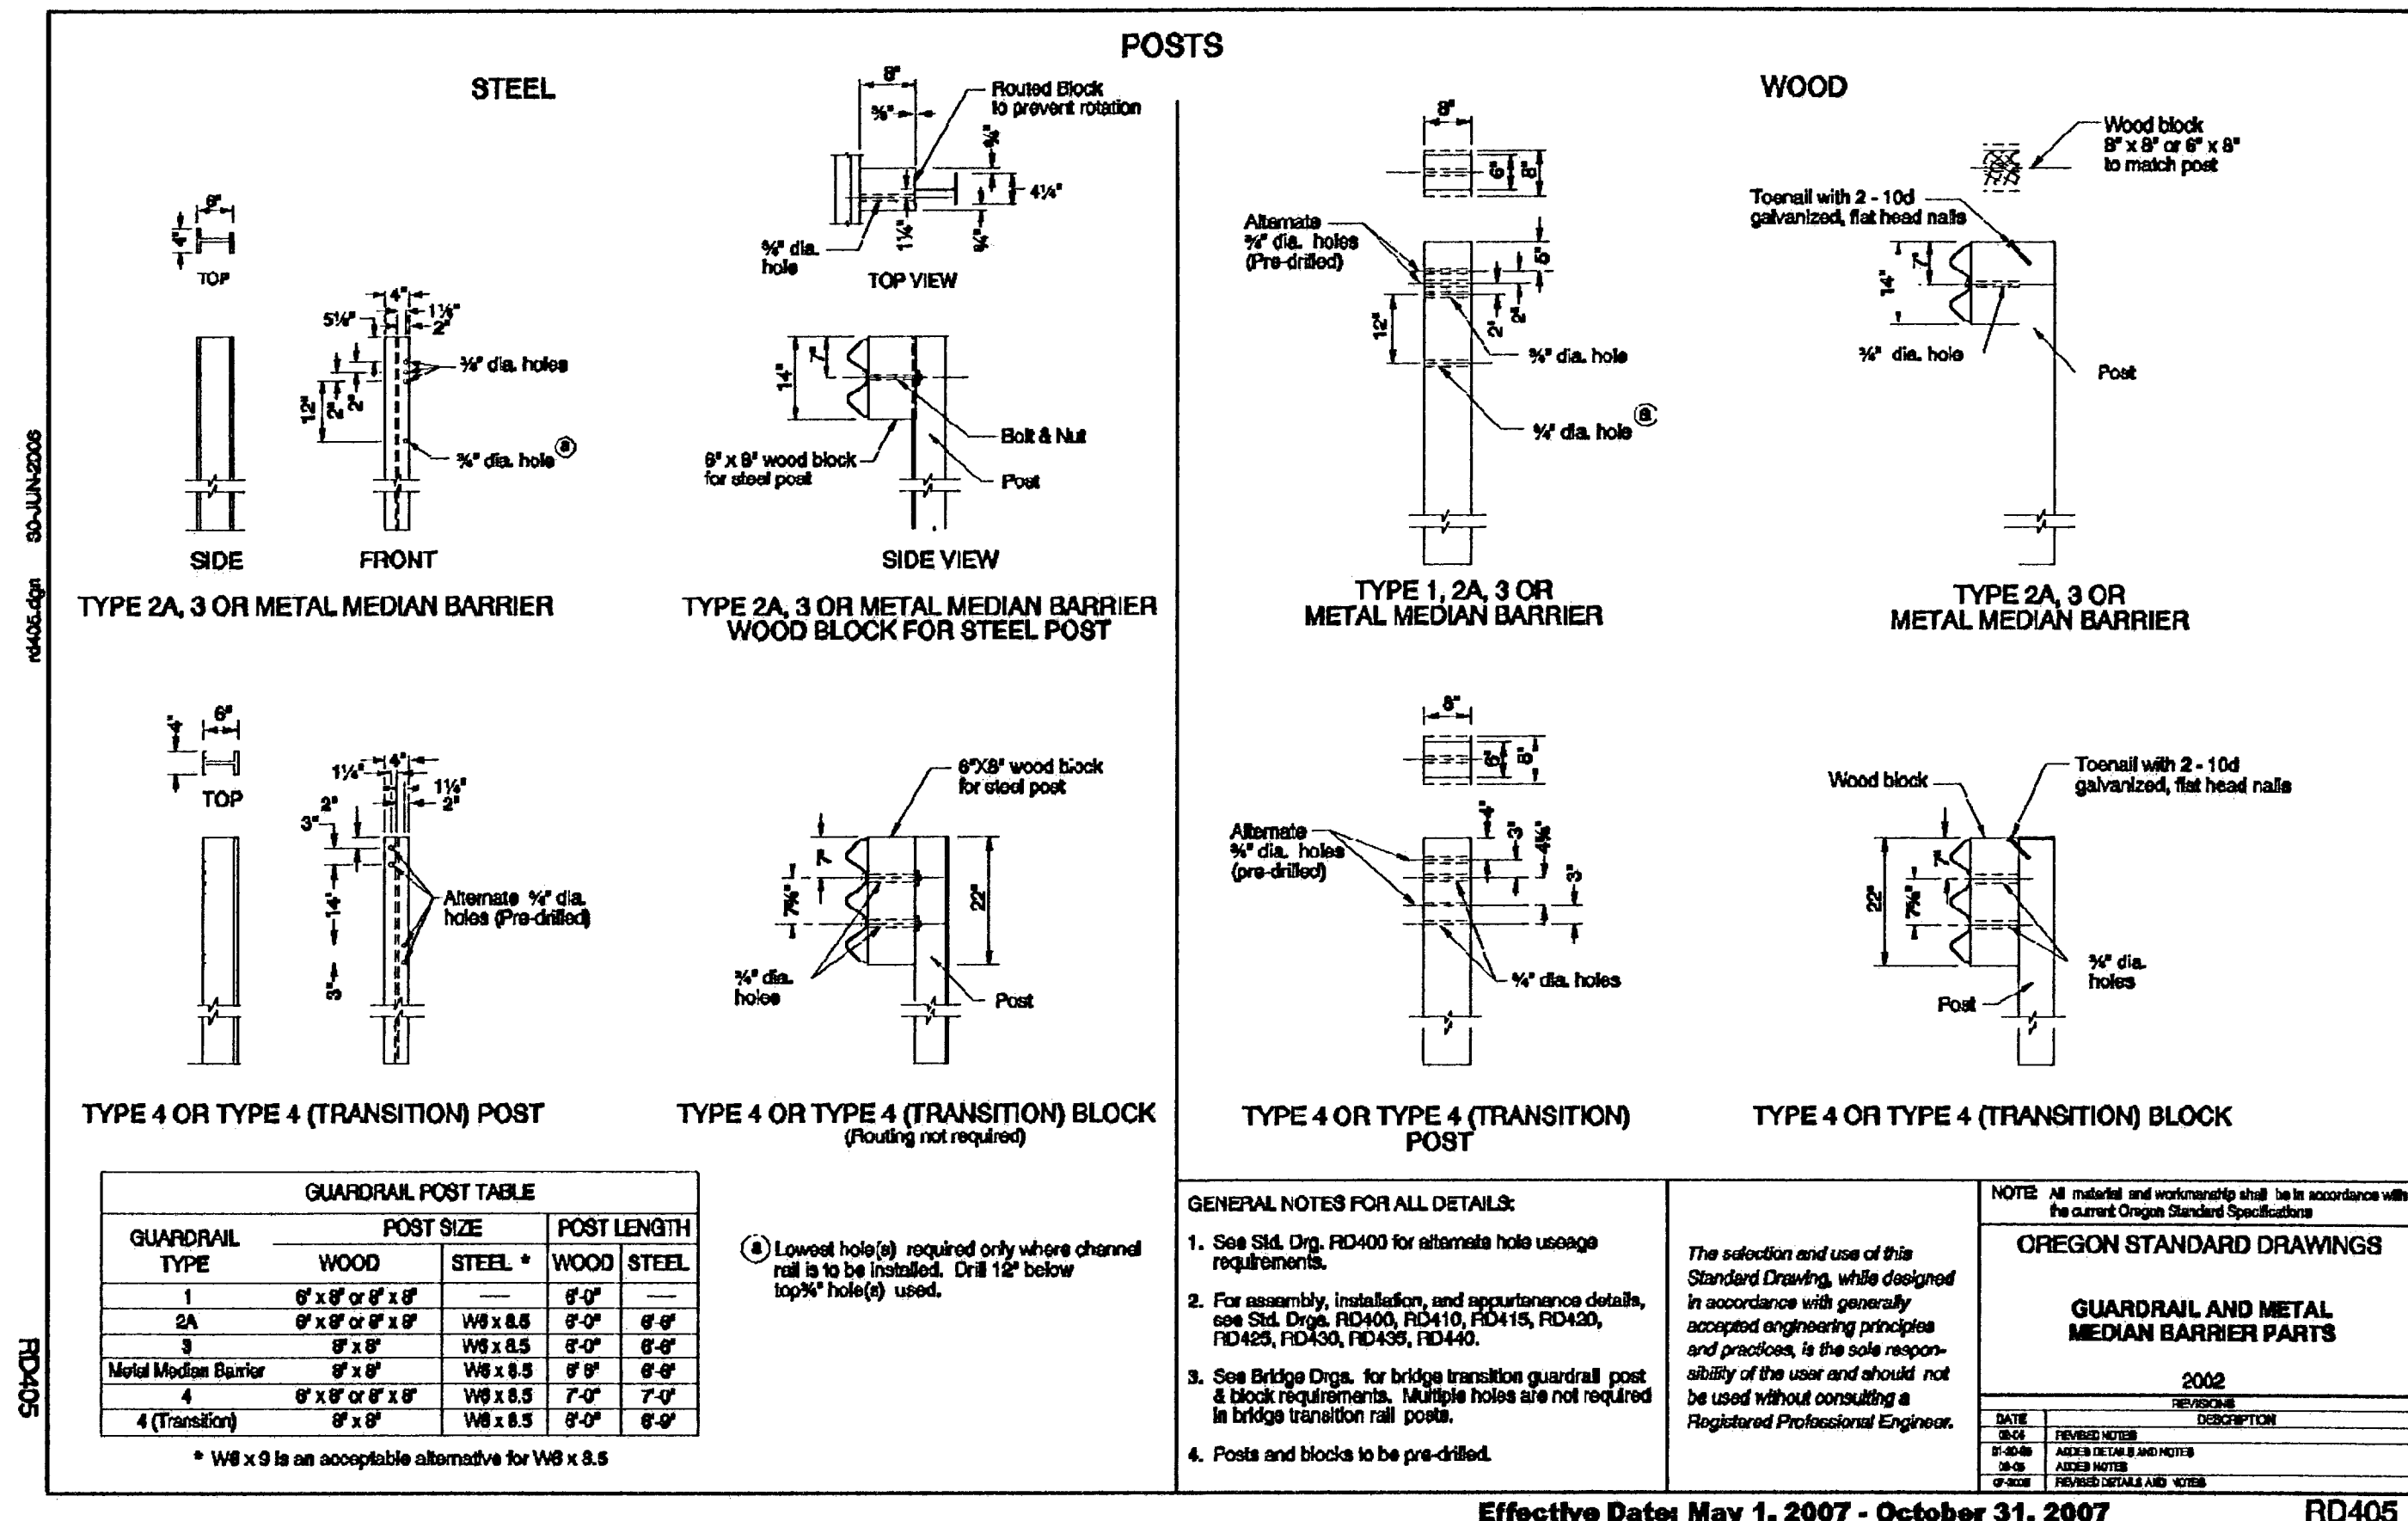

NORTH FLOW CONTROL MANHOLE A-22
ORIFICE LOCATION TEE RISER

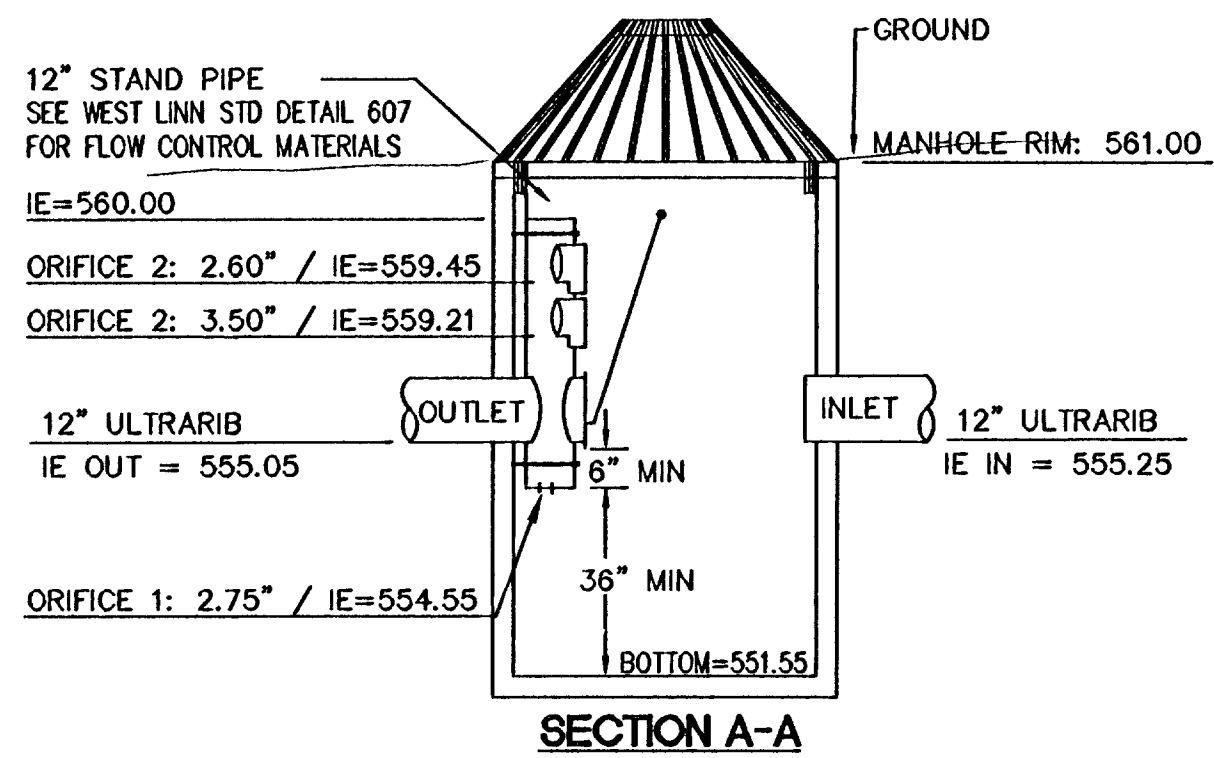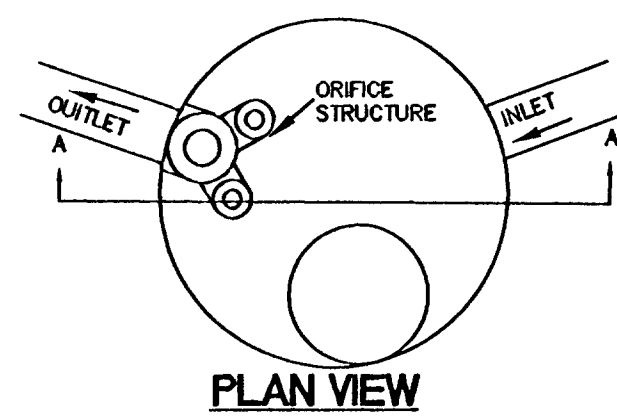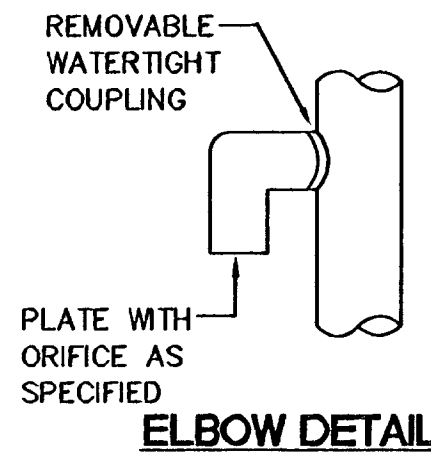

SOUTH FLOW CONTROL MANHOLE A-3
ORIFICE LOCATION TEE RISER

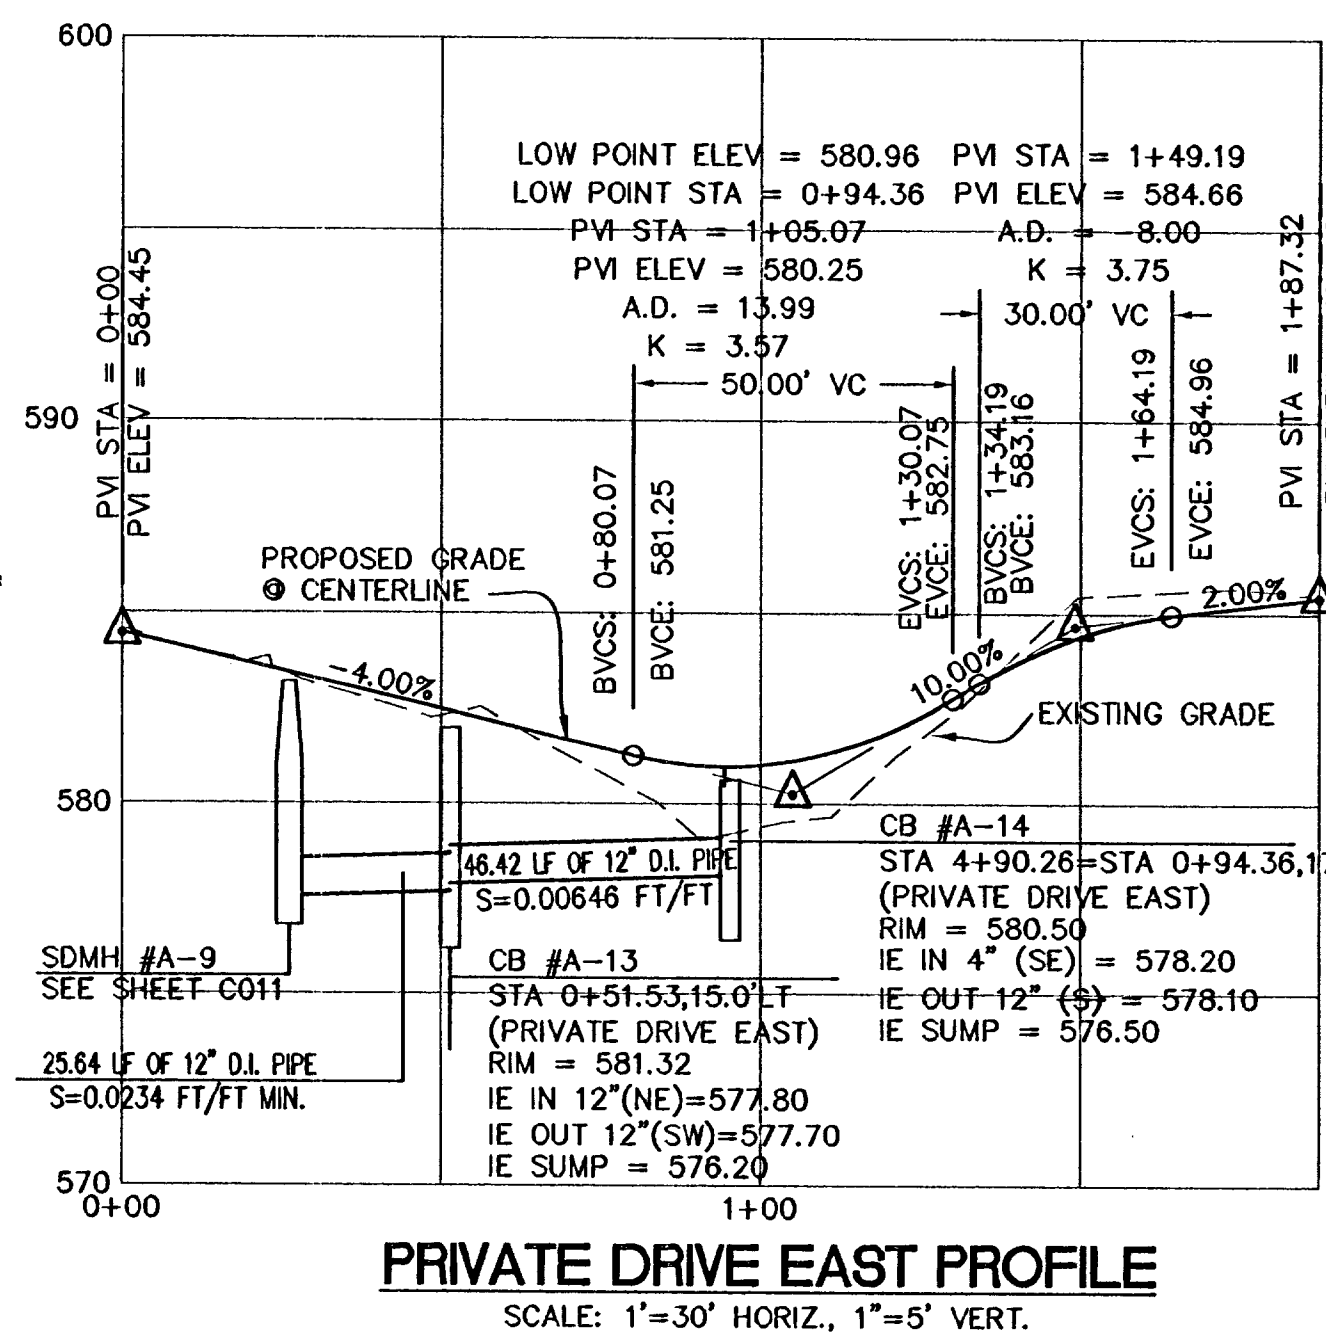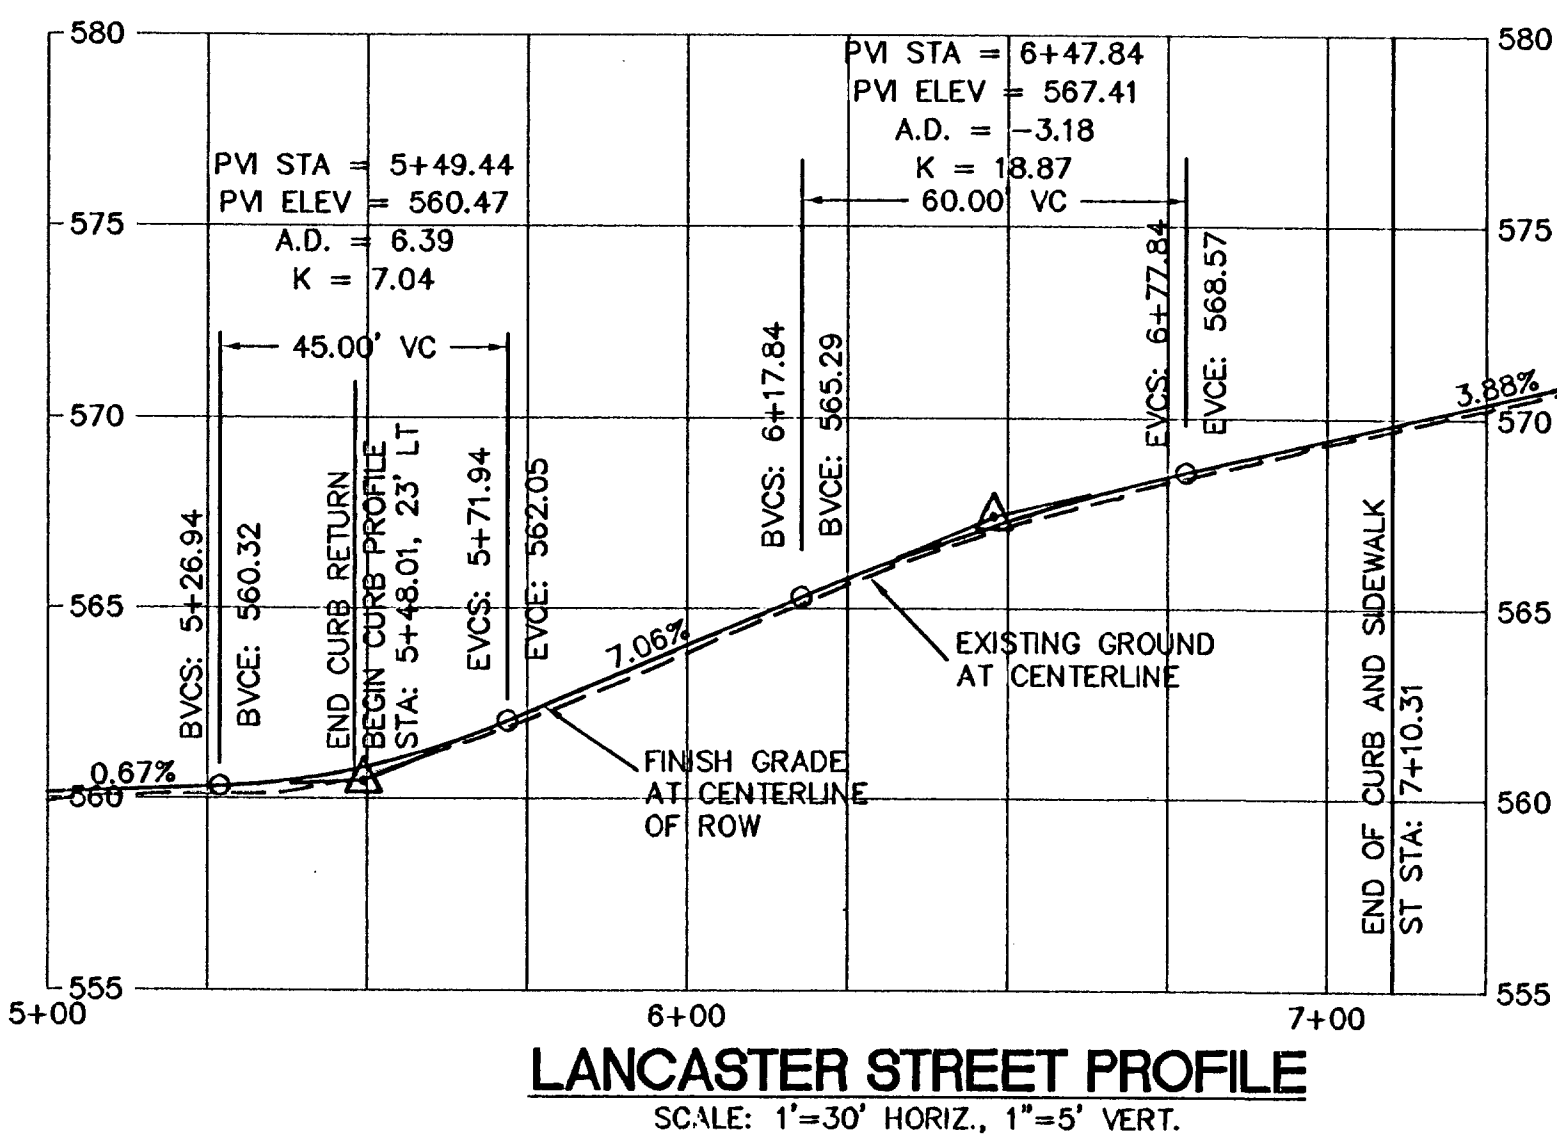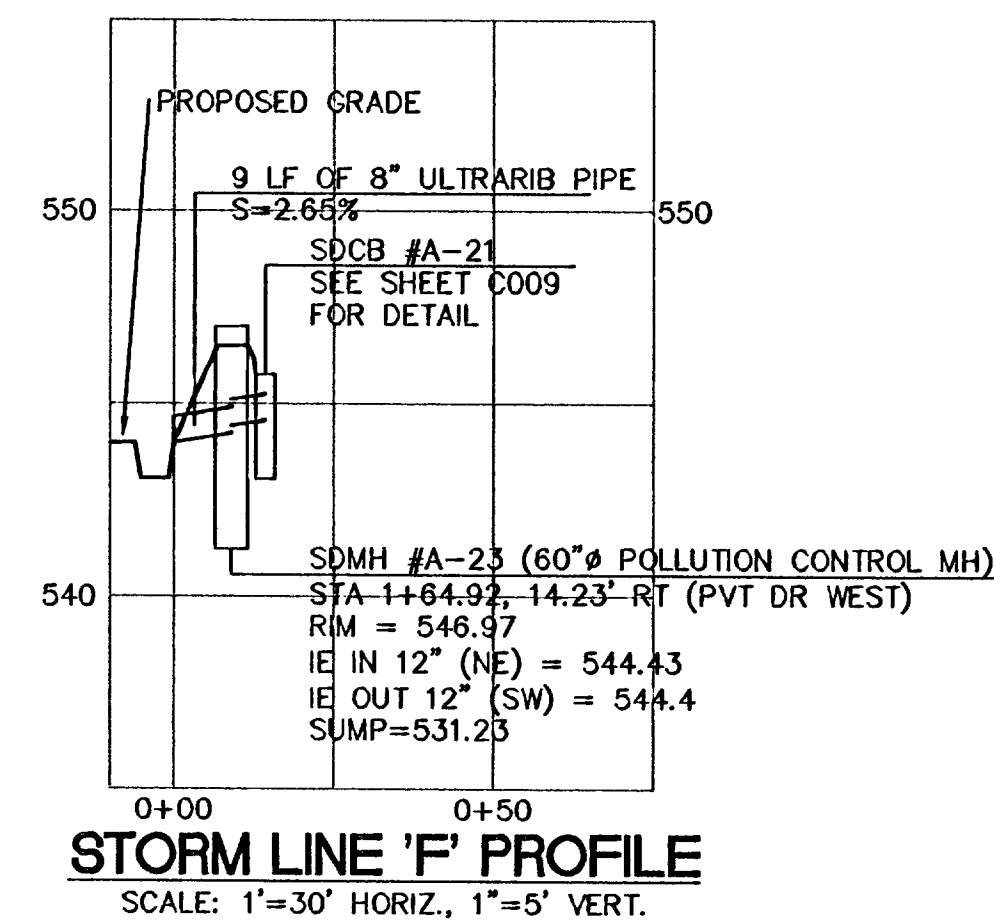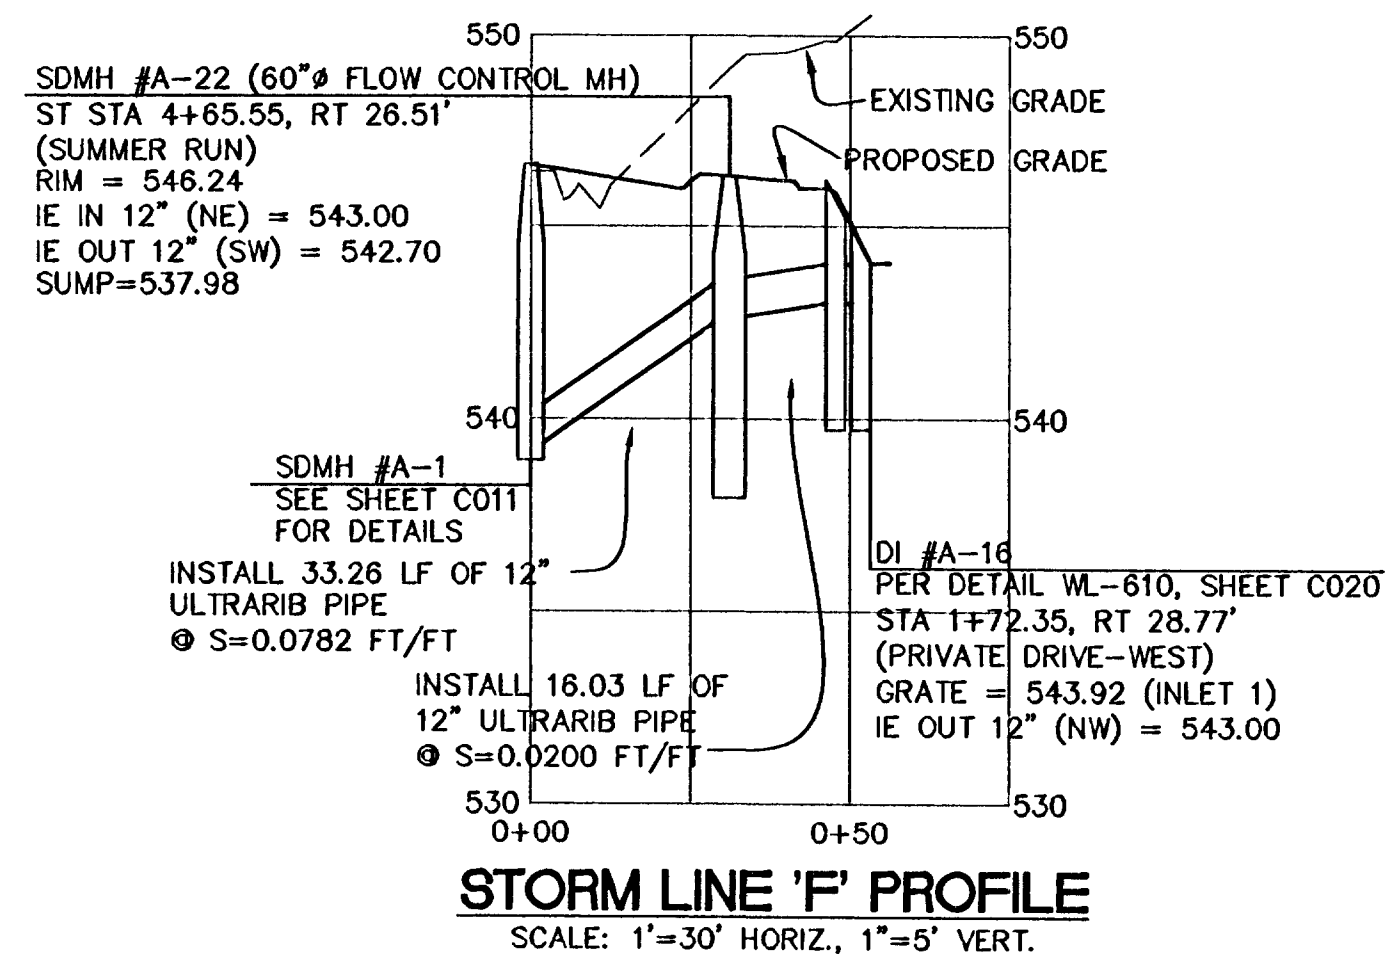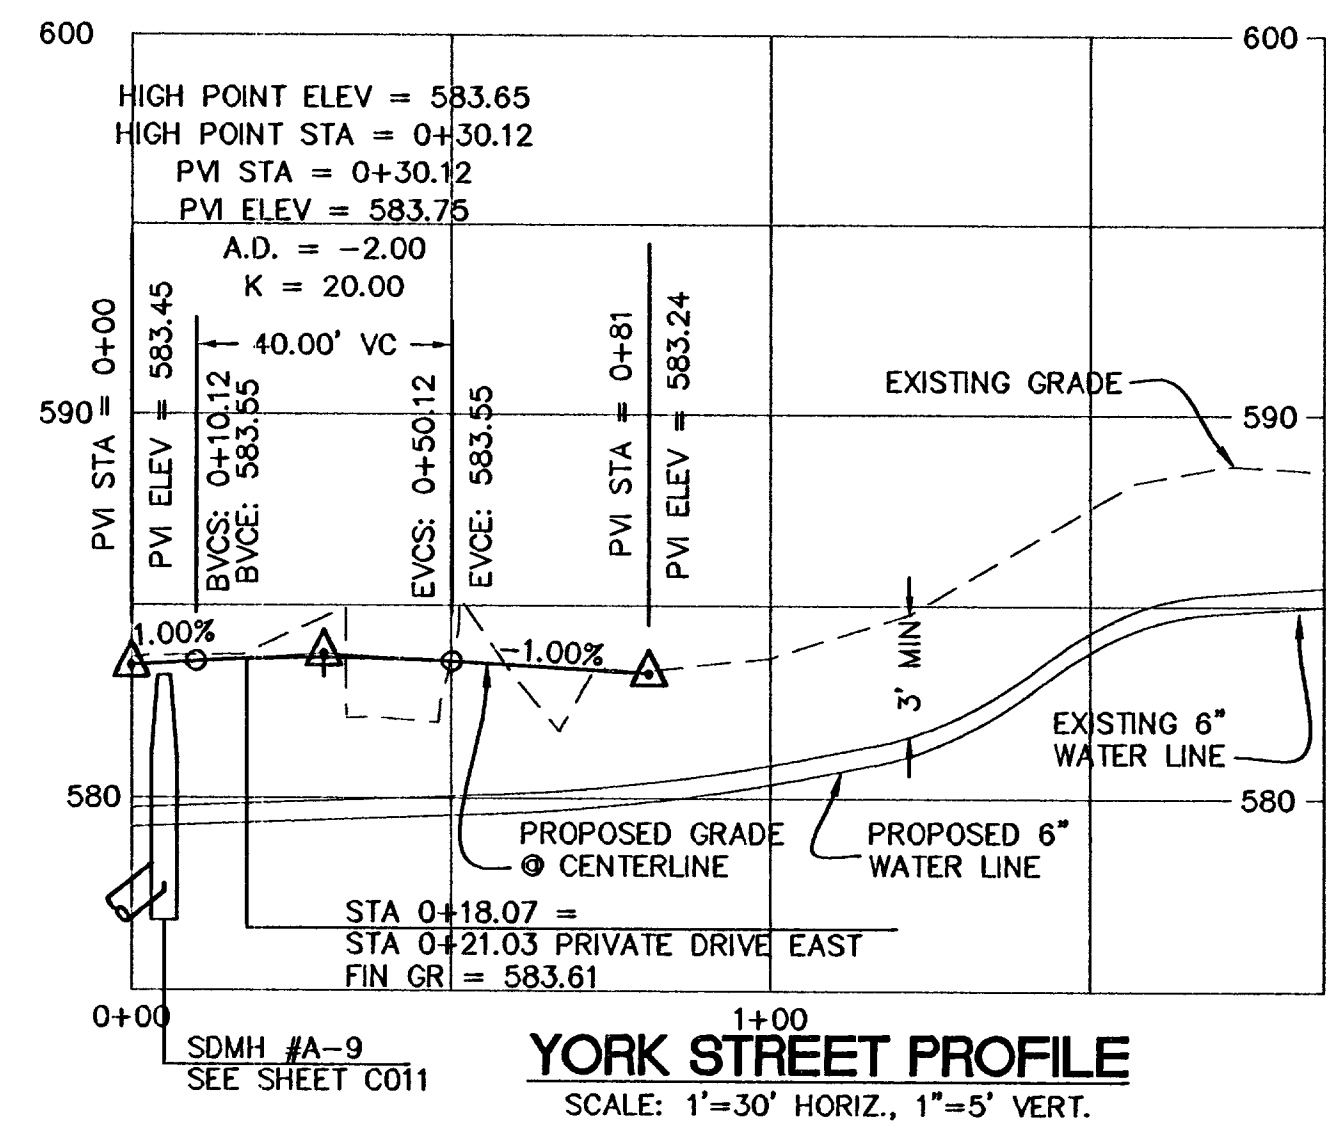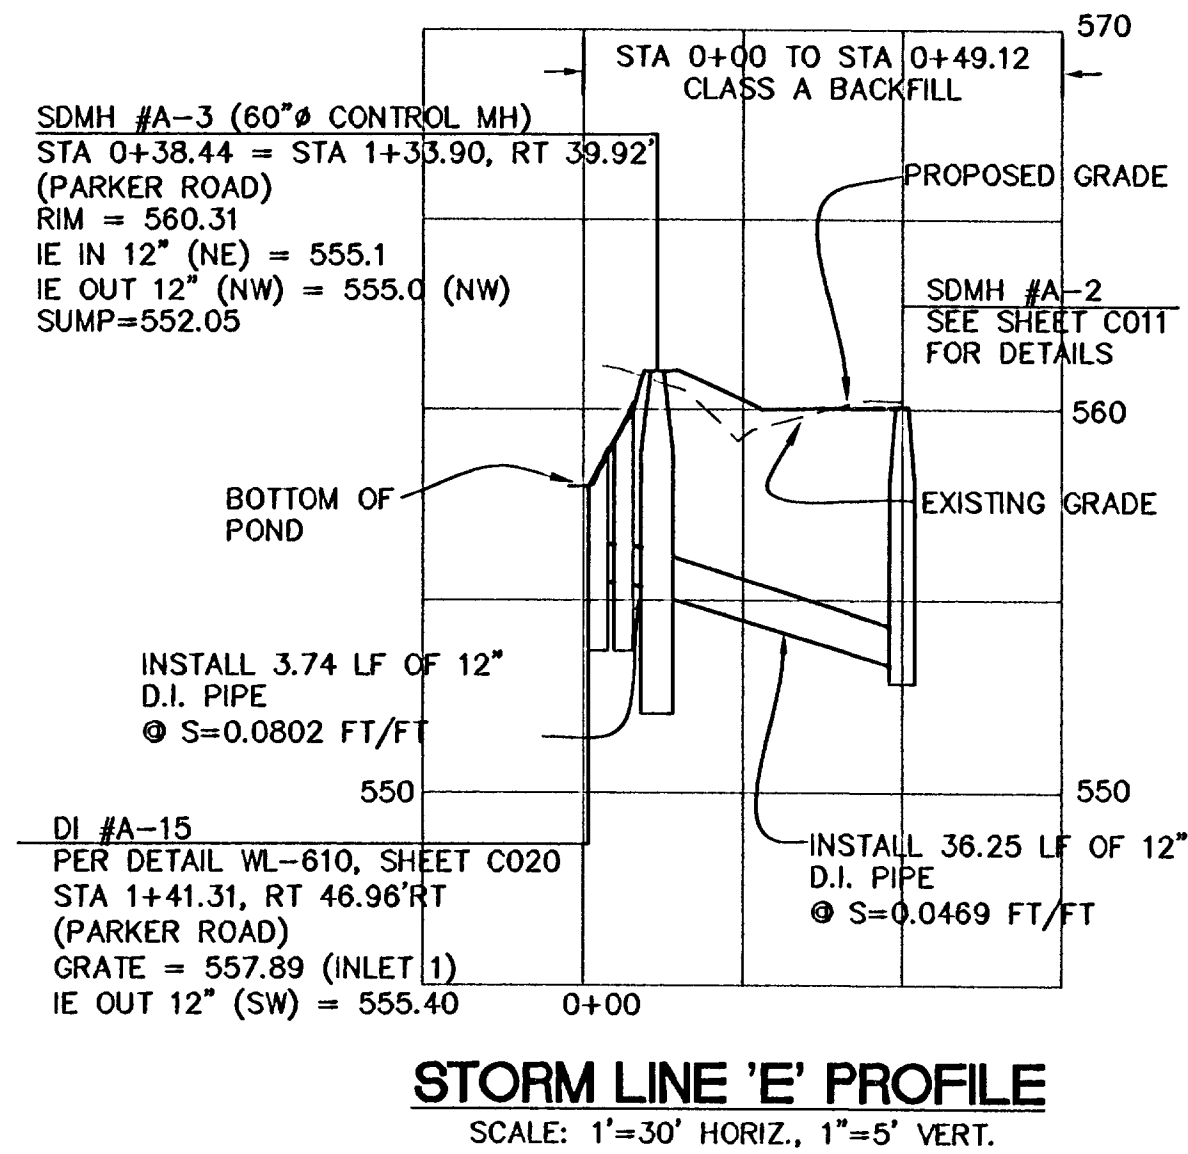

WEST LINN CASEFILE SUB05-03 / ZC05-05 / VAR05-03

STORM SEWER PROFILES

SIENNA'S ESTATES

City of West Linn, Clackamas County, Oregon

SAM L PAP

2798 LANCASTER STREET
WEST LINN, OREGON 97068
(503) 868-2254

LANPACIFIC

ENGINEERING
ARCHITECTURE
LANDSCAPE

5125 SW Macadam, Suite 140, Portland, Oregon 97239
503 1238-2097 FAX: 503 1238-2447
www.lanpacific.com

REGISTERED PROFESSIONAL ENGINEER
No. 660
Exp. 10/31/2011
K. SCOTT EMING

EXP. 12/31/09


RECORD DRAWING
01/18/08

THESE RECORD DRAWINGS HAVE BEEN PREPARED, IN PART, ON THE BASIS OF INFORMATION COMPILED AND FURNISHED BY THE CONTRACTOR, REVISED CONSTRUCTION PLANS, AND FIELD OBSERVATIONS DURING CONSTRUCTION.

DATE: 01/18/08
DRAWN: JSE
DESIGNED: JSE
CHECKED: RGN
PROJECT #: SLP04-001
SHEET TITLE: STORM SEWER PROFILES
SHEET NUMBER:

C012

ASBUILT CONSTRUCTION DOCUMENTS

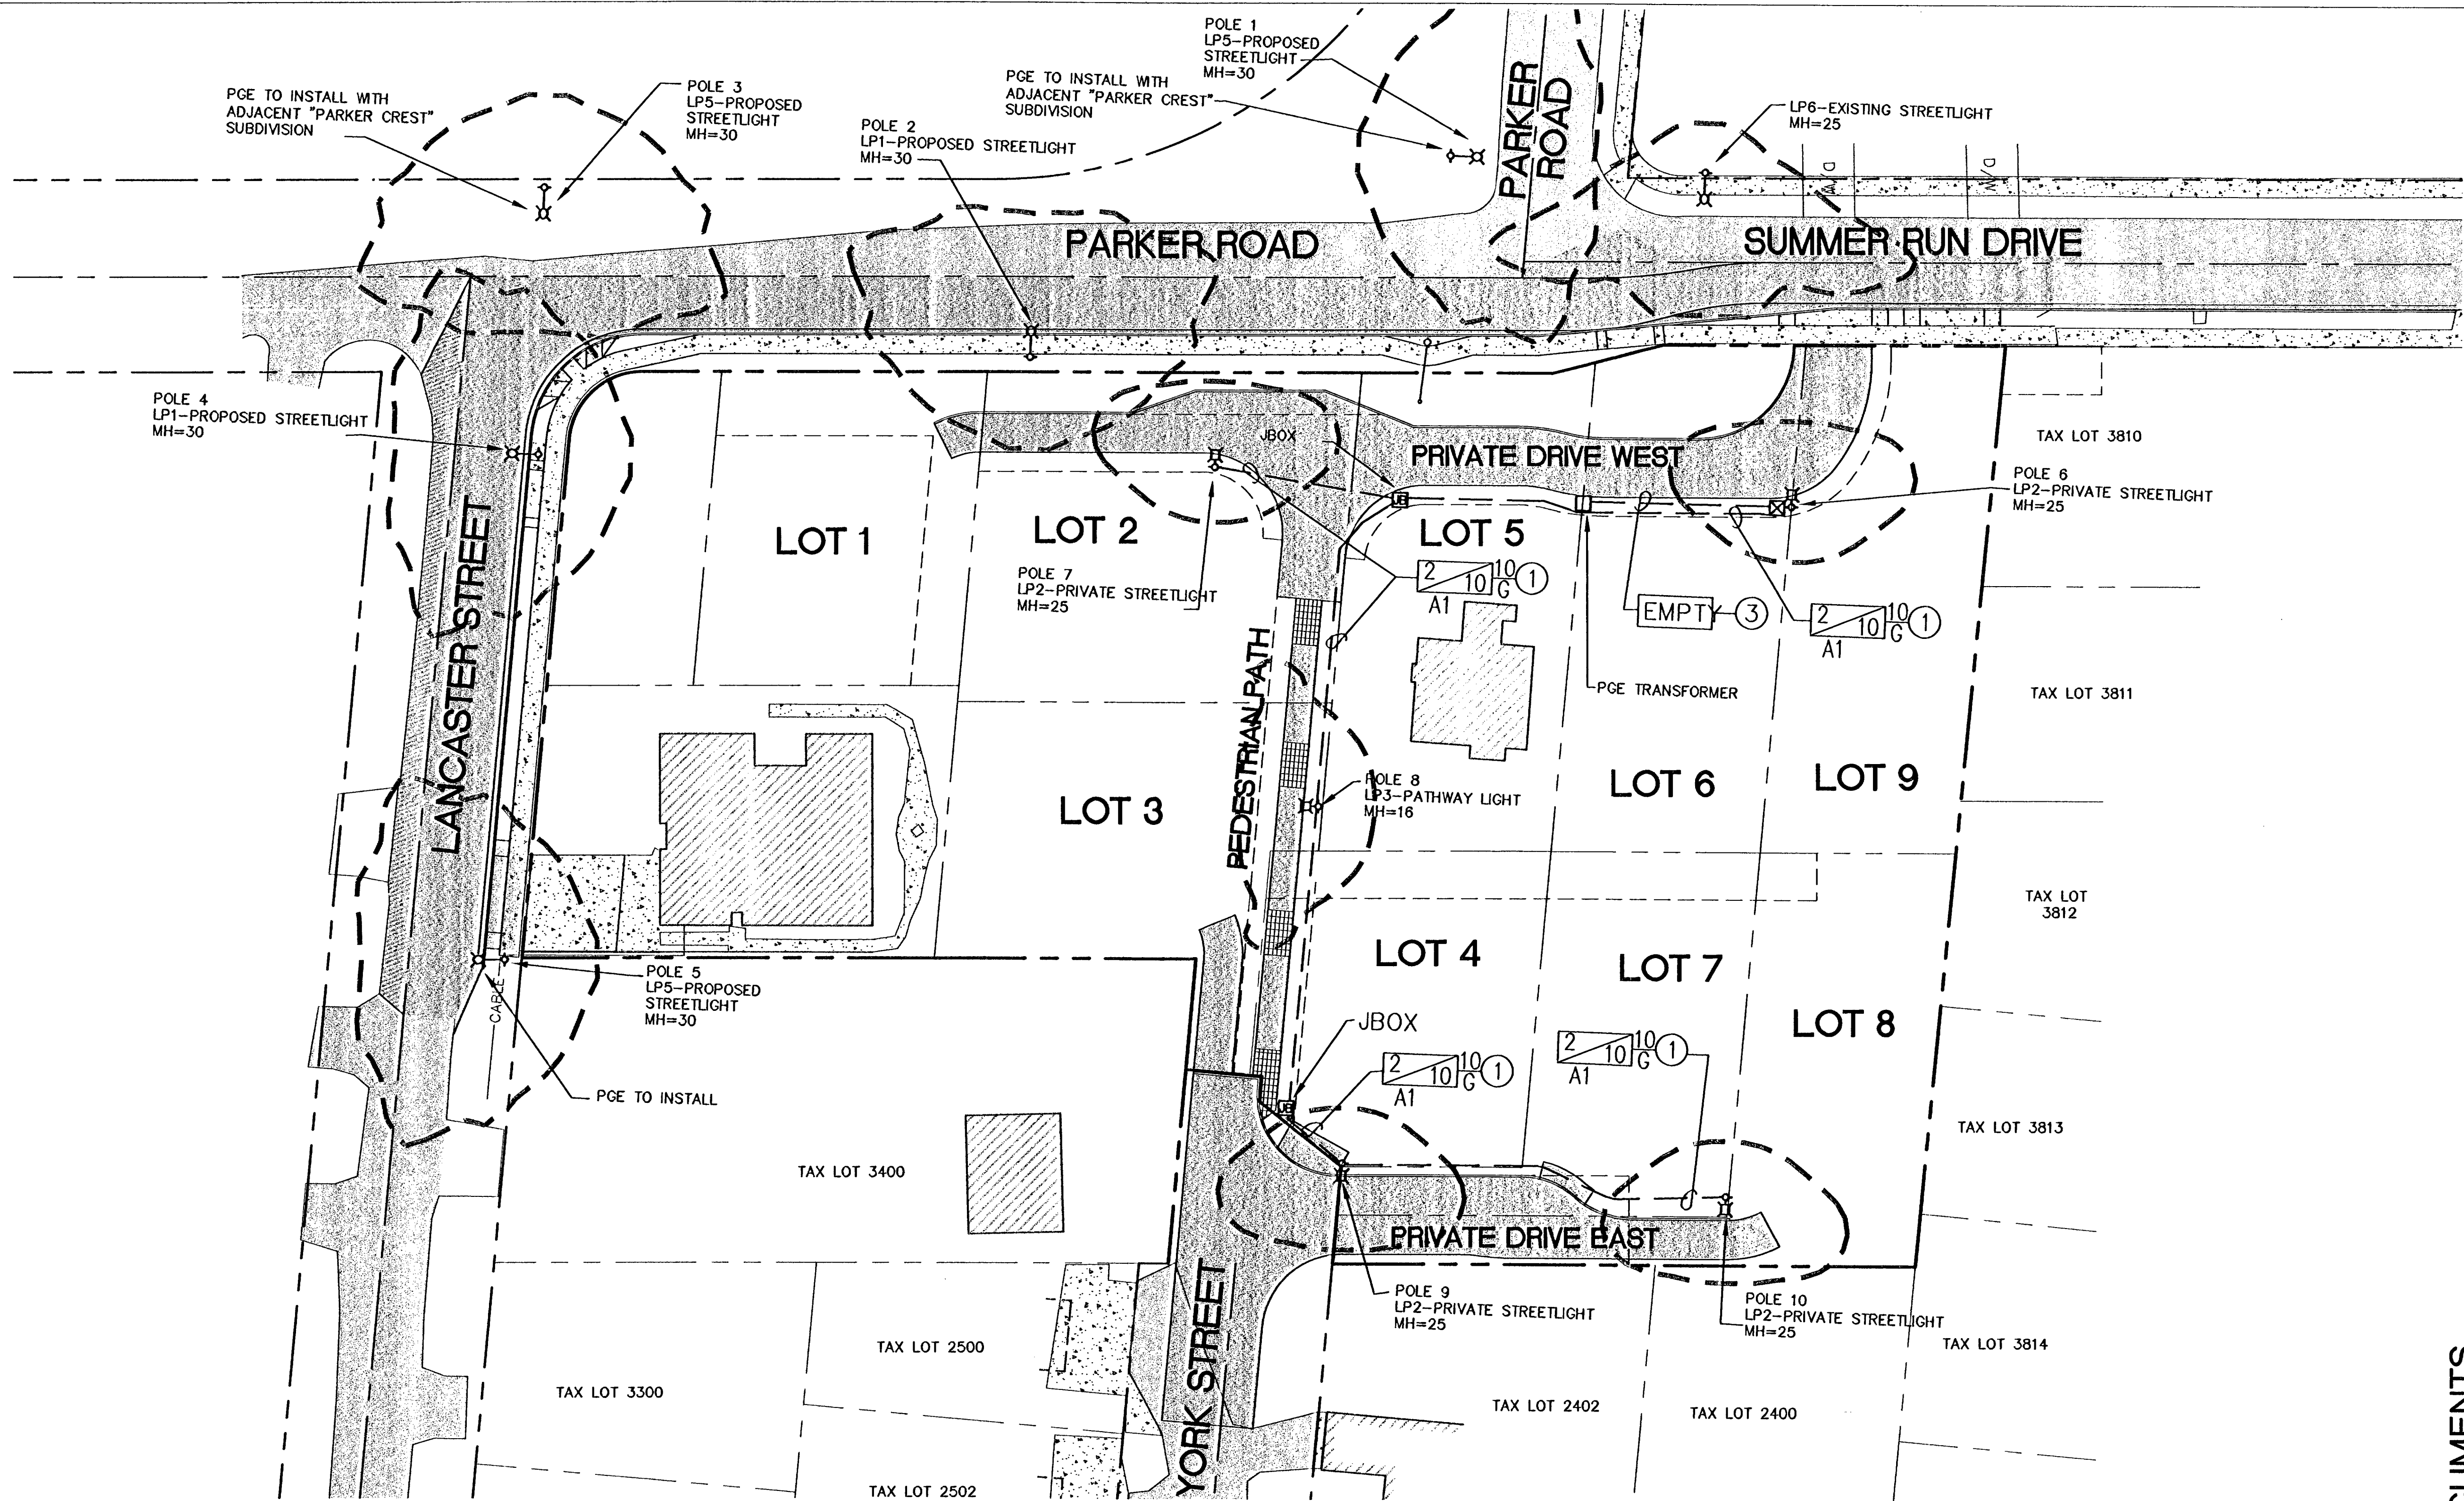


NUMERIC SUMMARY							
PROJECT: SIENNA ESTATES							
LABEL	CALC TYPE	UNITS	AVG	MAX	MIN	AVG/MIN	MAX/MIN
PARKER ROAD	ILLUMINANCE	Fc	0.69	3.0	0.2	3.45	15.00
LANCASTER	ILLUMINANCE	Fc	0.67	2.9	0.2	3.35	14.50
PRIVATE DRIVE WEST	ILLUMINANCE	Fc	0.40	1.5	0.1	4.00	15.00
PRIVATE DRIVE EAST	ILLUMINANCE	Fc	0.44	1.4	0.1	4.40	14.00
PATHWAY	ILLUMINANCE	Fc	0.61	2.8	0.1	6.10	28.00

LUMINAIRE SCHEDULE							
PROJECT: SIENNA ESTATES							
QTY	LABEL	DESCRIPTION	WATTS	LUMENS	ARM	ARRANGEMENT	LLF
2	LP1-PROPOSED STREETLIGHT	HPS, 'COBRA' STYLE, FLAT LENS LUMINAIRE MOUNTED ON A 30' MOUNTING HEIGHT, GRAY, FIBERGLASS POLE	150	16000	6	SINGLE	0.690
4	LP2-PRIVATE STREETLIGHT	HPS, 'SHOEBOX' STYLE LUMINAIRE MOUNTED ON A 25' MOUNTING HEIGHT, BRONZE, FIBERGLASS POLE	70	6200	1	SINGLE	0.690
1	LP3-PATHWAY LIGHT	HPS, 'SHOEBOX' STYLE LUMINAIRE MOUNTED ON A 16' MOUNTING HEIGHT, BRONZE, FIBERGLASS POLE	70	6200	1	SINGLE	0.690
3	LP5-PROPOSED STREETLIGHT	HPS, 'COBRA' STYLE, FLAT LENS LUMINAIRE MOUNTED 30' ON A WOOD POWER POLE	150	16000	6	SINGLE	0.690
1	LP6-EXISTING STREETLIGHT	HPS, 'COBRA' STYLE, DROP LENS LUMINAIRE MOUNTED ON A 25' MOUNTING HEIGHT, GRAY, FIBERGLASS POLE	100	9500	6	SINGLE	0.690

LIGHTING DESIGN PROVIDED BY: NORTHSTAR ELECTRICAL
19450 SW CIPOLE RD. #107
TUALATIN OR 97062
V: 503-612-0840



LIGHT LEVEL REQUIREMENTS				
ROADWAY	CLASSIFICATION	TARGET	LIGHT LEVEL	UNIFORMITY
PARKER	COLLECTOR (RESIDENTIAL)	TARGET	0.6 FC	4:1
		ACHIEVED	0.69 FC	3.45:1
LANCASTER	COLLECTOR (RESIDENTIAL)	TARGET	0.6 FC	4:1
		ACHIEVED	0.67 FC	3.35:1
PRIVATE DRIVE WEST	PRIVATE	TARGET	0.4 FC	6:1
		ACHIEVED	0.40 FC	4.00:1
PRIVATE DIVE EAST	PRIVATE	TARGET	0.4 FC	6:1
		ACHIEVED	0.44 FC	4.40:1
PATHWAY	PRIVATE	TARGET	0.2 FC	10:1
		ACHIEVED	0.61 FC	6.10:1

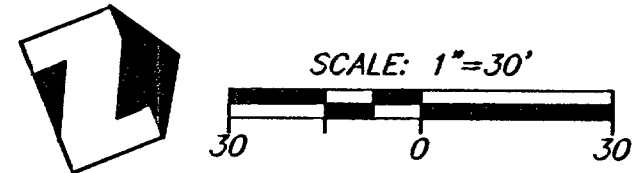

STREET LIGHT LOCATION CHART	
LIGHT NUMBER	STREET STATION / OFFSET
LIGHT 1	4+37.58, 25.53' RT (PARKER ROAD)
LIGHT 2	2+84.77, 26.50' RT (PARKER ROAD)
LIGHT 3	1+43.79, 21.27' RT (PARKER ROAD)
LIGHT 4	5+44.77, 23.00' RT (LANCASTER STREET)
LIGHT 5	6+55.06, 23.00' RT (LANCASTER STREET)
LIGHT 6	7+44.86, 25.50' LT (LANCASTER STREET)
LIGHT 7	1+70.29, 15.71' LT (PRIVATE DRIVE WEST)
LIGHT 8	3+46.45, 5.00' LT (PRIVATE DRIVE WEST)
LIGHT 9	1+09.61, 7.03' LT (PEDESTRIAN PATH)
LIGHT 10	0+59.84, 18.00' LT (PRIVATE DRIVE EAST)
LIGHT 11	1+59.05, 8.63' LT (PRIVATE DRIVE EAST)

WEST LINN CASEFILE SUB05-03 / ZC05-05 / VAR05-03

ASBUILT CONSTRUCTION DOCUMENTS

STREET LIGHTING PLAN

SIENNA'S ESTATES

City of West Linn, Clackamas County, Oregon

SAM L PAP

2799 LANCASTER STREET
WEST LINN, OREGON 97068
(503) 888-2254

CIVIL ENGINEERING
DEVELOPMENT
CONSULTING
LANDSCAPE
ARCHITECTURE

LANPACIFIC

5025 SW Macdonald, Suite 140, Portland, Oregon 97239
503 238-2087 FAX: 503 238-2447
www.lanpacific.com

REGISTERED PROFESSIONAL ENGINEER
No. 0060
JULY 10, 2001
SCOTT EMMES


EXP. 12/31/09

RECORD DRAWING

01/18/08

THESE RECORD DRAWINGS HAVE BEEN PREPARED, IN PART, ON THE BASIS OF INFORMATION COMPILED AND FURNISHED BY THE CONTRACTOR, REVISED BY THE CONTRACTOR, REVISED CONSTRUCTION PLANS, AND FIELD OBSERVATIONS DURING CONSTRUCTION.

DATE 01/18/08
DRAWN JSE
DESIGNED JSE
CHECKED RGN
PROJECT # SLP04-001
SHEET TITLE
STREET LIGHTING
SHEET NUMBER
C013

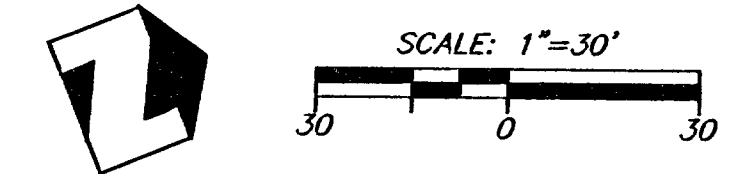

SANITARY SEWER AND WATER NOTES

- 1 CONNECT TO EXISTING WATERLINE. STA: 4+55.07, 13.2' LT (SUMMER RUN). REMOVE EXISTING BLOW OFF AND CONNECT TO END OF PIPE.
- 2 INSTALL 22.5' BEND. STA: 4+02.03, 8' RT (PARKER ROAD). INSTALL THRUST BLOCKING PER WEST LINN STANDARD DWG. NO. WL-406.
- 3 INSTALL 8"x 8" x 6" TEE AND VALVE TO EAST STA. 3+59.37, 8' RT (PARKER ROAD). INSTALL THRUST BLOCKING PER WEST LINN STANDARD DWG. NO. WL-406 AND STANDARD VALVE BOX PER WEST LINN STANDARD DWG. NO. WL-411.
- 4 INSTALL 8" TEE WITH 3-8" GATE VALVES. STA: 1+07.32, 8' RT (PARKER ROAD). INSTALL THRUST BLOCKING PER WEST LINN STANDARD DWG. NO. WL-406 AND STANDARD VALVE BOX PER WEST LINN STANDARD DWG. NO. WL-411.
- 5 INSTALL WATER LINES UNDER RETAINING WALL WITH A MINIMUM CLEARANCE OF 3 FEET BELOW THE FOOTING. ALL VERTICAL AND HORIZONTAL JOINTS MUST BE RESTRAINED FROM THE TEE ON PARKER ROAD TO THE PEDESTRIAN PATH TO YORK STREET.
- 6 CONNECT TO EXISTING CAST IRON WATERLINE WITH STANDARD 6" COUPLING AND 8"x6" REDUCER. STA. 7+14.00, 18.04' LT (LANCASTER ST). INSTALL 6" TEE WITH 2-8" GATE VALVES. STA: 7+12.78, 18.04' LT (LANCASTER ST). INSTALL THRUST BLOCKING PER WEST LINN STANDARD DWG. NO. WL-406 AND STANDARD VALVE BOX PER WEST LINN STANDARD DWG. NO. WL-411. INSTALL NEW HYDRANT WITH 6.6 LF OF 6" DIP PER STD. DWG WL-401. INSTALL NEW HYDRANT AT STA: 7+12.78, 24.64' LT.
- 7 NOT USED
- 8 CONNECT TO EXISTING WATERLINE WITH STANDARD 6" COUPLING. STA. 1+88.46, 9.62' LT (YORK STREET)
- 9 NOT USED
- 10 INSTALL 6" TEE WITH 3-6" GATE VALVES. STA: 1+85.42, 9.62' LT (YORK ST). INSTALL THRUST BLOCKING PER WEST LINN STANDARD DWG. NO. WL-406 AND STANDARD VALVE BOX PER WEST LINN STANDARD DWG. NO. WL-411. INSTALL NEW HYDRANT WITH 28 LF OF 6" DIP PER STD. DWG WL-401. INSTALL HYDRANT AT STA: 1+87.90, 21' LT.
- 11 RECONNECT EXISTING WATER METERS TO NEW 6" LINE. TAX LOTS 2200, 2300, 2400, 2402, 2500, 2501, 2502, 2503
- 12 INSTALL 3/4" IRRIGATION METER. ST STA: 5+72.72, 30.00' LT. (LANCASTER), ST STA: 4+43.59, 18.90' RT. (PARKER / SUMMERUN).
- 13 BEGIN 3' DEFLECTION PER 20 LF OF PIPE SEGMENT. ST STA: 0+43.61, 0.95' R (YORK ST)
- 14 EXTEND SINGLE SERVICE WATER LINE FROM METER TO LOT SETBACK AS SHOWN FOR LOTS 1, 2, 3, 5, 6, 7, 8, 9.

NOTE: CONTRACTOR TO VERIFY EXISTING LINE SIZE IN LANCASTER STREET PRIOR TO CONSTRUCTION. NOTIFY THE ENGINEER IF THE EXISTING LINE SIZE IN FIELD IS DIFFERENT THAN NOTED ON PLANS.

NOTE: CONTRACTOR MAY USE FIELD LOCK GASKET JOINT RESTRAINTS IN LIEU OF THRUST BLOCKING UP TO A MAXIMUM BEND OF 45'. A BEND EQUAL TO OR LESS THAN 22" REQUIRES 18" MIN RESTRAINT FROM BOTH SIDES OF BEND. 45" REQUIRES A MINIMUM OF 54" OF RESTRAINT ON BOTH SIDES OF BEND.

SANITARY SEWER LATERALS

LOT 1 STA. 4+08.63 (SS LINE "A") IE @ MAINLINE = 560.87 16.16 LF @ 18.75% IE @ END = 563.70	LOT 6 STA. 1+71.10 (SS LINE "A") IE @ MAINLINE = 539.02 22.05 LF @ 24.85% IE @ END = 544.50
LOT 2 STA. 3+46.46 (SS LINE "A") IE @ MAINLINE = 556.72 15.15 LF @ 22.31% IE @ END = 560.10	LOT 7 STA. 1+34.64 (SS LINE "B") IE @ MAINLINE = 564.01 90.75 LF @ 2.00% CLEANOUT SSCO #B-5 LID = 569.5 IE @ SSCO = 565.83 10.95 LF @ 15.25% IE @ END = 567.50
LOT 3 STA. 0+94.65 (SS LINE "B") IE @ MAINLINE = 560.86 18.83 LF @ 31.01% IE @ END = 566.7	LOT 8 STA. 1+30.63 (SS LINE "B") IE @ MAINLINE = 563.69 152.77 LF @ 2.00% CLEANOUT SSCO #B-9 LID = 568.5 IE @ SSCO = 566.75 13.32 LF @ 2.05% IE @ END = 567.02
LOT 4 STA. 1+49.39 (SS LINE "B") IE @ MAINLINE = 565.17 9.64 LF @ 77.07% IE @ END = 572.60	LOT 9 STA. 1+38.42 (SS LINE "A") IE @ MAINLINE = 535.37 25.99 LF @ 32.4% IE @ END = 543.80
LOT 5 STA. 0+31.58 (SS LINE "B") IE @ MAINLINE = 555.89 10.38 LF @ 29.96% IE @ END = 559.00	


NOTE: SPRINKLE ALL DWELLINGS WITH A NFPA 13D SYSTEM

ASBUILT CONSTRUCTION DOCUMENTS

WATER AND SANITARY SEWER PLAN
SENNA'S ESTATES
City of West Linn, Clackamas County, Oregon

SAM L PAP
2798 LANCASTER STREET
WEST LINN, OREGON 97068
(503) 888-2254

LANPACIFIC
5125 SW Meadows, Suite 140, Portland, Oregon 97239
503 | 238-2097 FAX: 503 | 238-2447
www.lanpacific.com

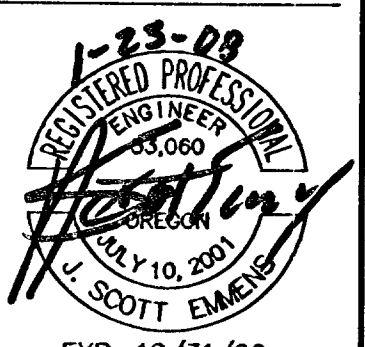


RECORD DRAWING
01/18/08

THESE RECORD DRAWINGS HAVE BEEN PREPARED, IN PART, ON THE BASIS OF INFORMATION COMPILED AND FURNISHED BY THE CONTRACTOR, REVISOR CONSTRUCTION PLANS, AND FIELD OBSERVATIONS DURING CONSTRUCTION.


DATE	01/18/08
DRAWN	JSE
DESIGNED	JSE
CHECKED	RGN
PROJECT #	SLP04-001

SHEET TITLE
WATER AND SANITARY SEWER PLAN

SHEET NUMBER
C014

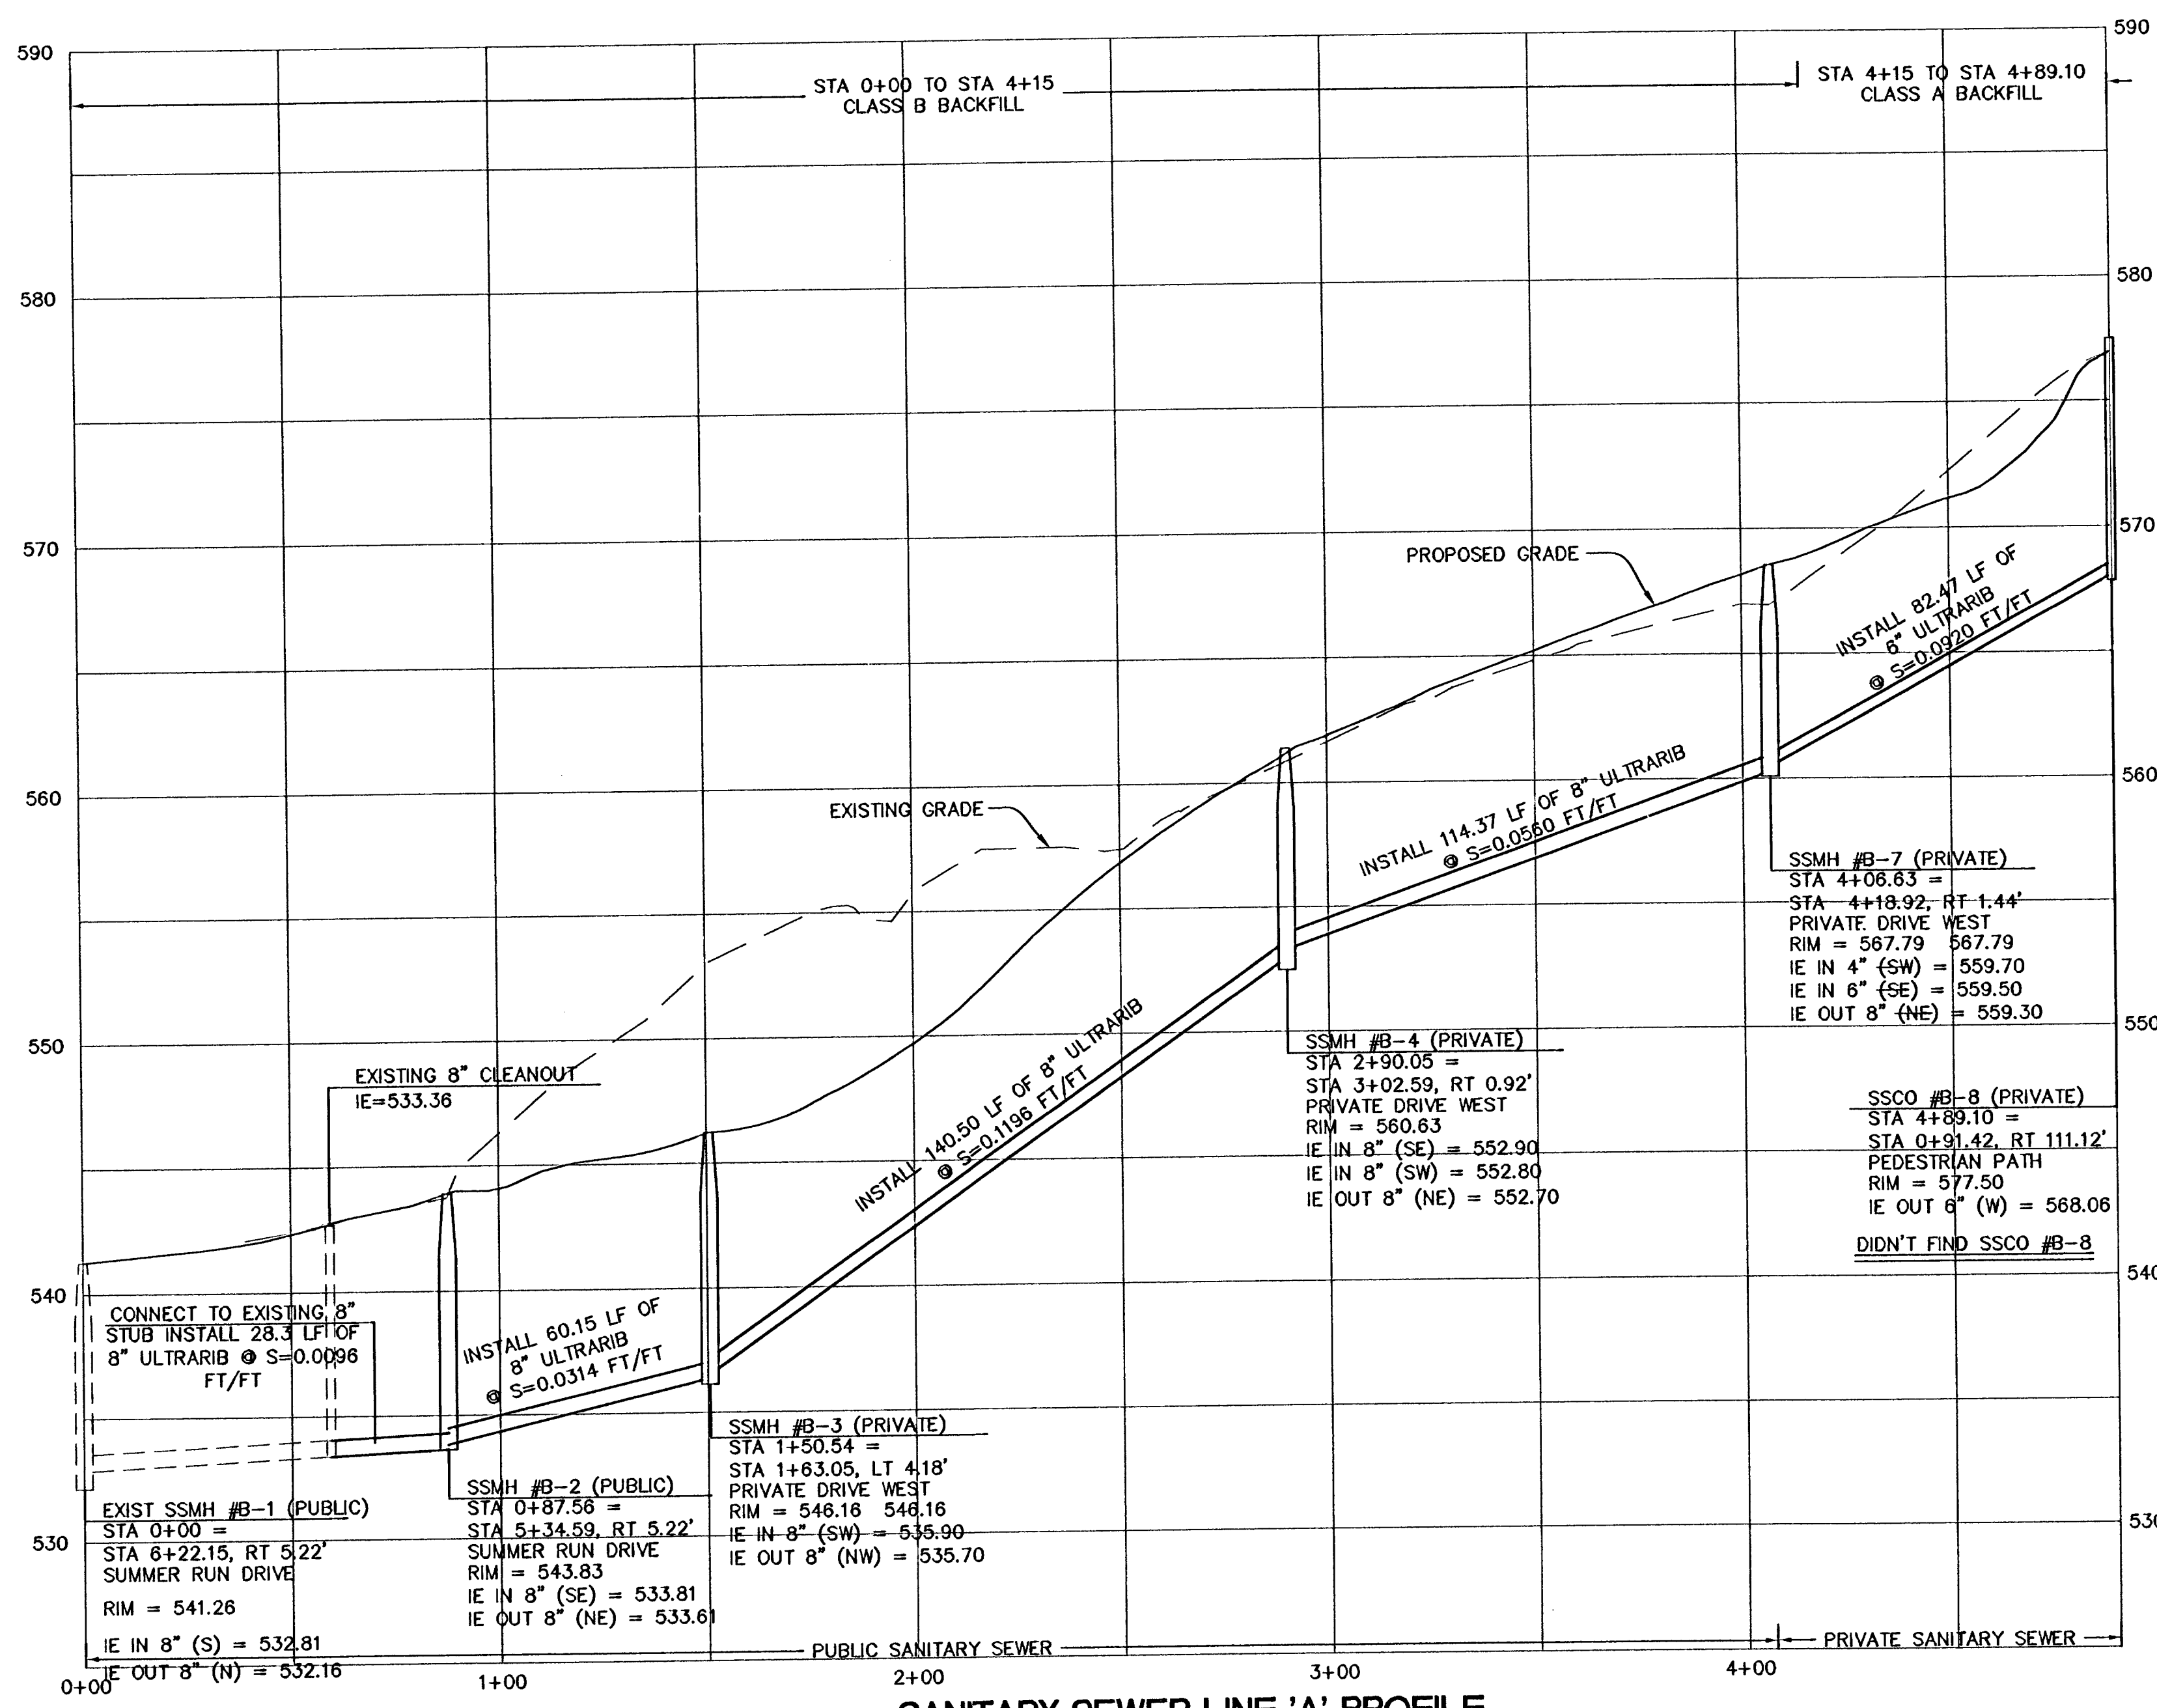

SANITARY SEWER LINE 'A' PROFILE
SCALE: 1"=30' HORIZ.
1"=5' VERT.

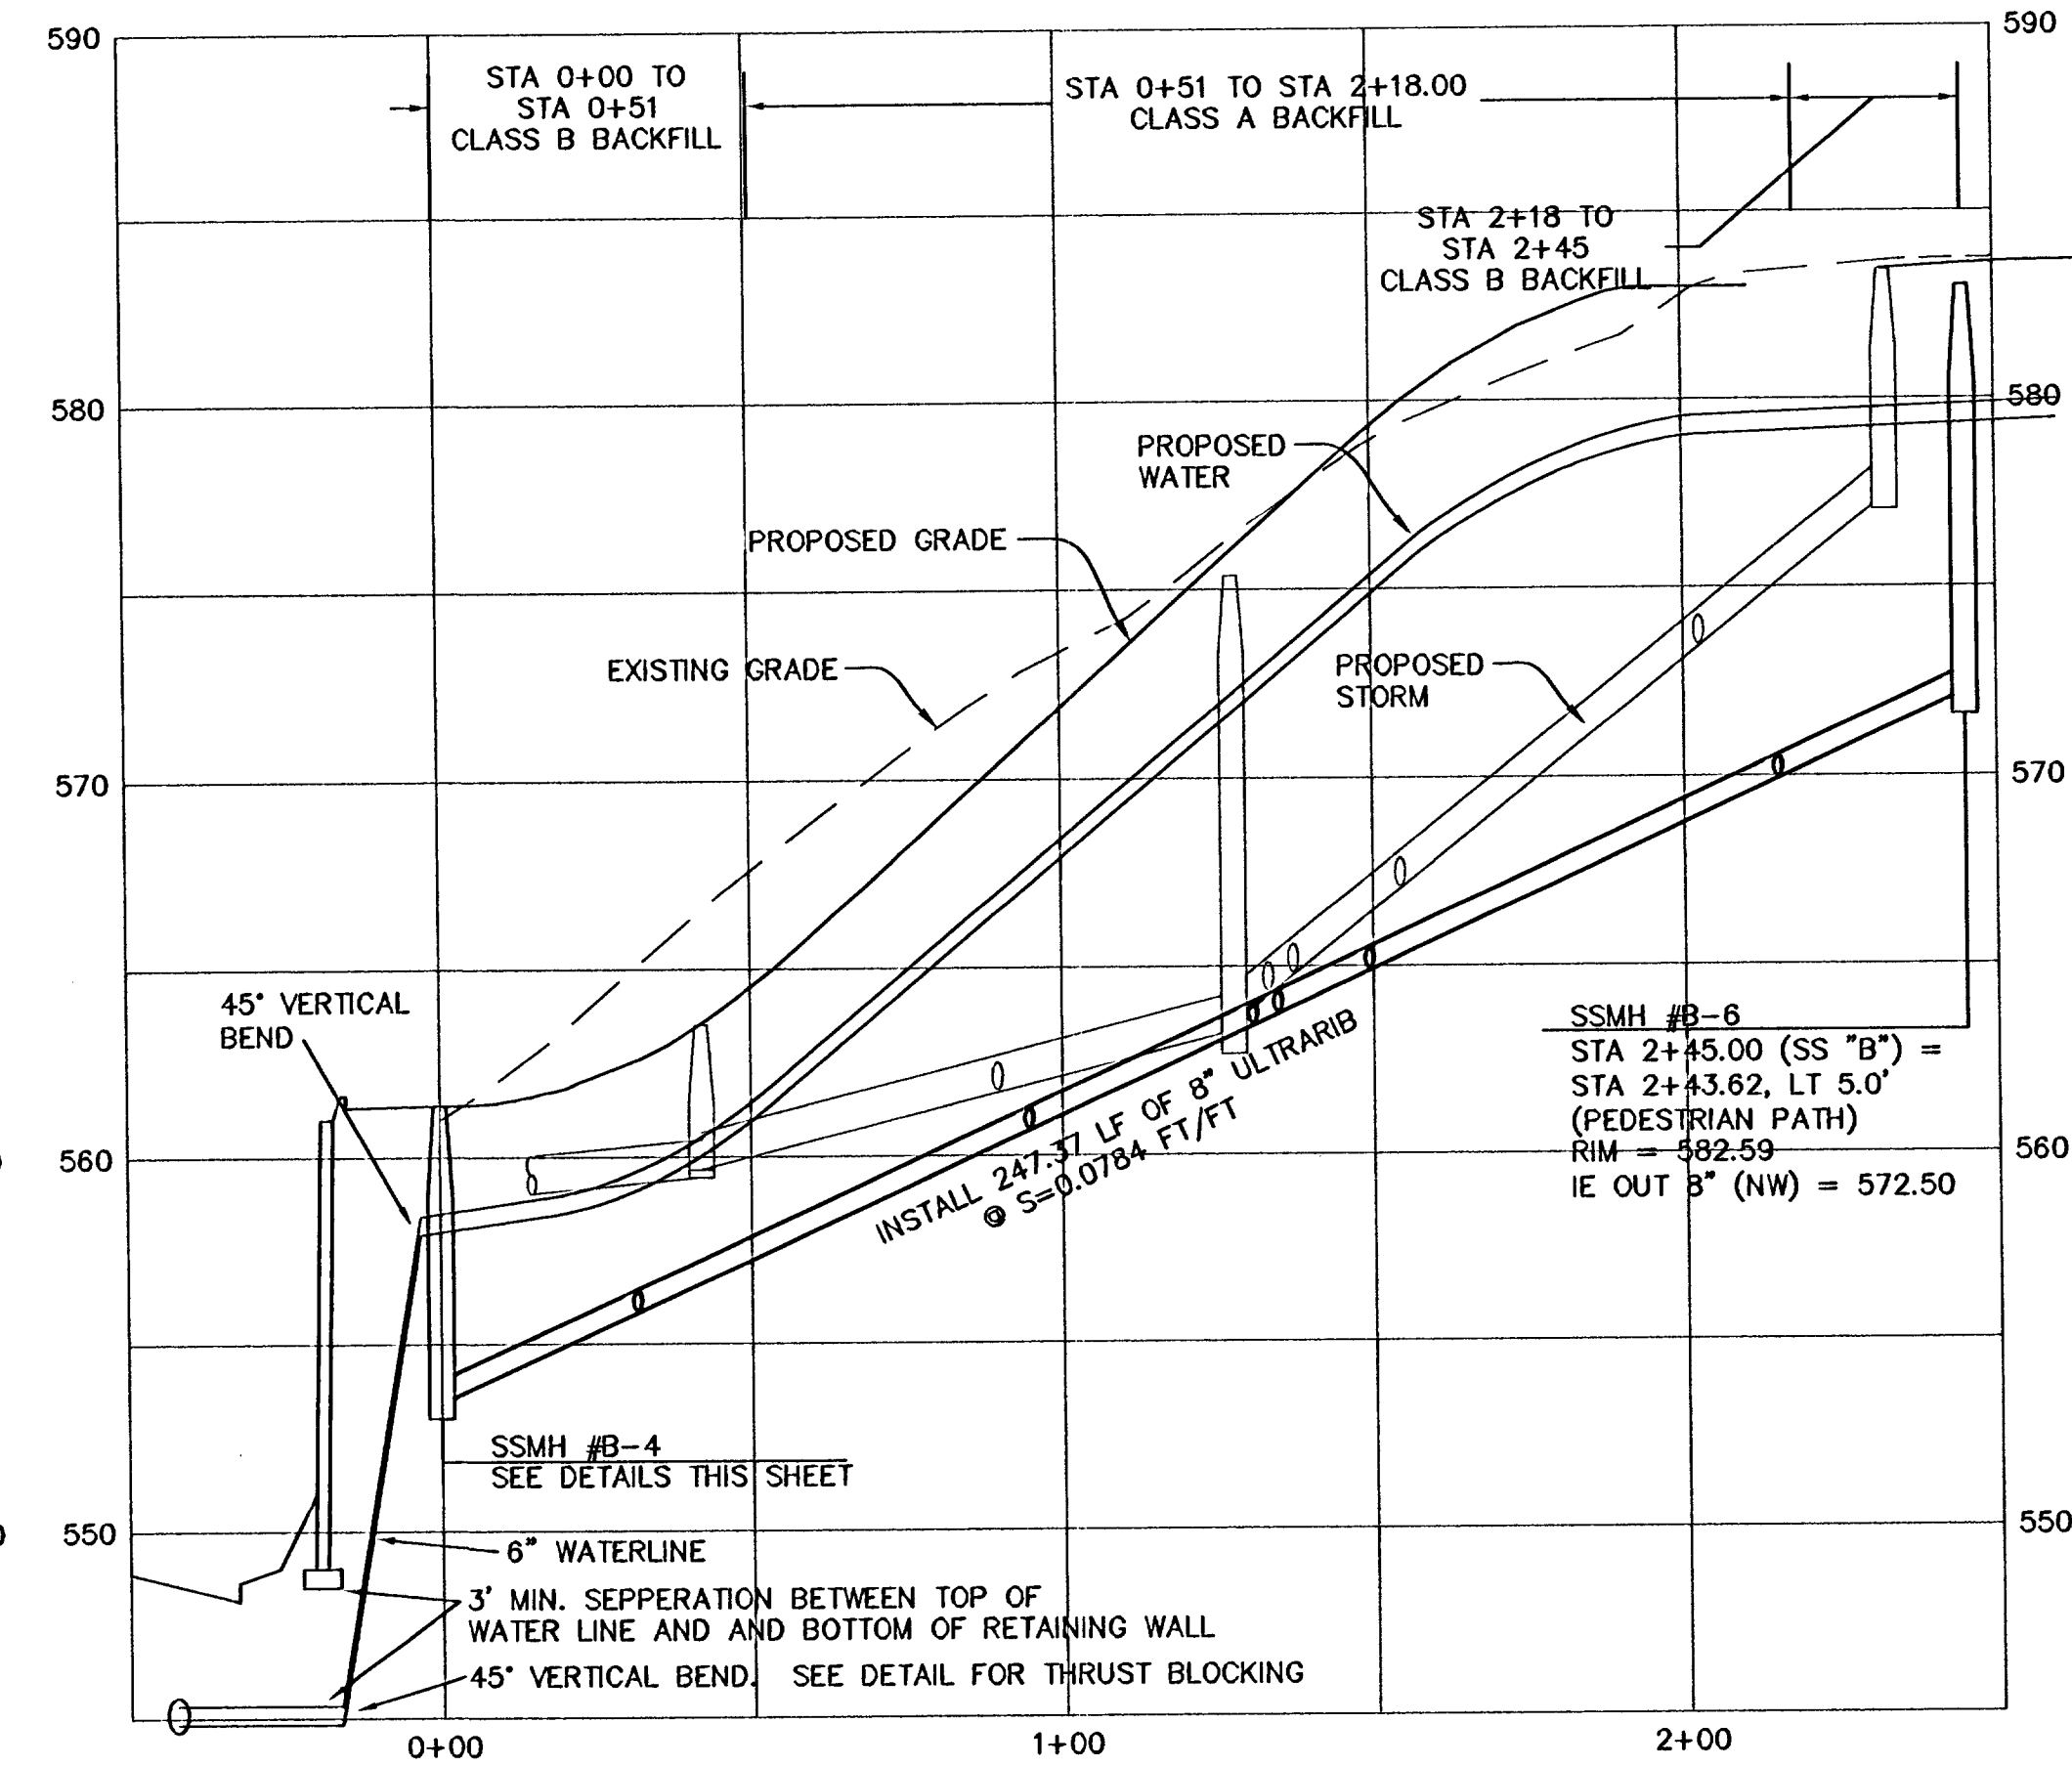

SANITARY SEWER LINE 'B' PROFILE
SCALE: 1"=30' HORIZ.
1"=5' VERT.

WEST LINN CASEFILE SUB05-03 / ZC05-05 / VAR05-03

ASBUILT CONSTRUCTION DOCUMENTS


SANITARY SEWER PROFILES
SIENNA'S ESTATES
City of West Linn, Clackamas County, Oregon

SAM L PAP
2799 LANCASTER STREET
WEST LINN, OREGON 97068
(503) 888-2254


ONE ENGINEERING
DESIGN/CONSTRUCTION
LANDSCAPE ARCHITECTURE
LANPACIFIC
5125 SW Macadam, Suite 140, Portland, Oregon 97239
503 | 238-2097 FAX: 503 | 238-2447
www.lanpacific.com

1-23-08
REGISTERED PROFESSIONAL
ENGINEER
35060
JULY 10, 2007
U. SCOTT EMMES

EXP. 12/31/09
**RECORD
DRAWING**
01/18/08
THESE RECORD DRAWINGS HAVE BEEN
PREPARED, IN PART, ON THE BASIS OF
INFORMATION COMPILED AND FURNISHED
BY THE CONTRACTOR, REVISED
CONSTRUCTION PLANS, AND FIELD
OBSERVATIONS DURING CONSTRUCTION.
DATE | 01/18/08
DRAWN | JSE
DESIGNED | JSE
CHECKED | RGN
PROJECT # | SLP04-001
SHEET TITLE
**SANITARY SEWER
PROFILES**
SHEET NUMBER
C015

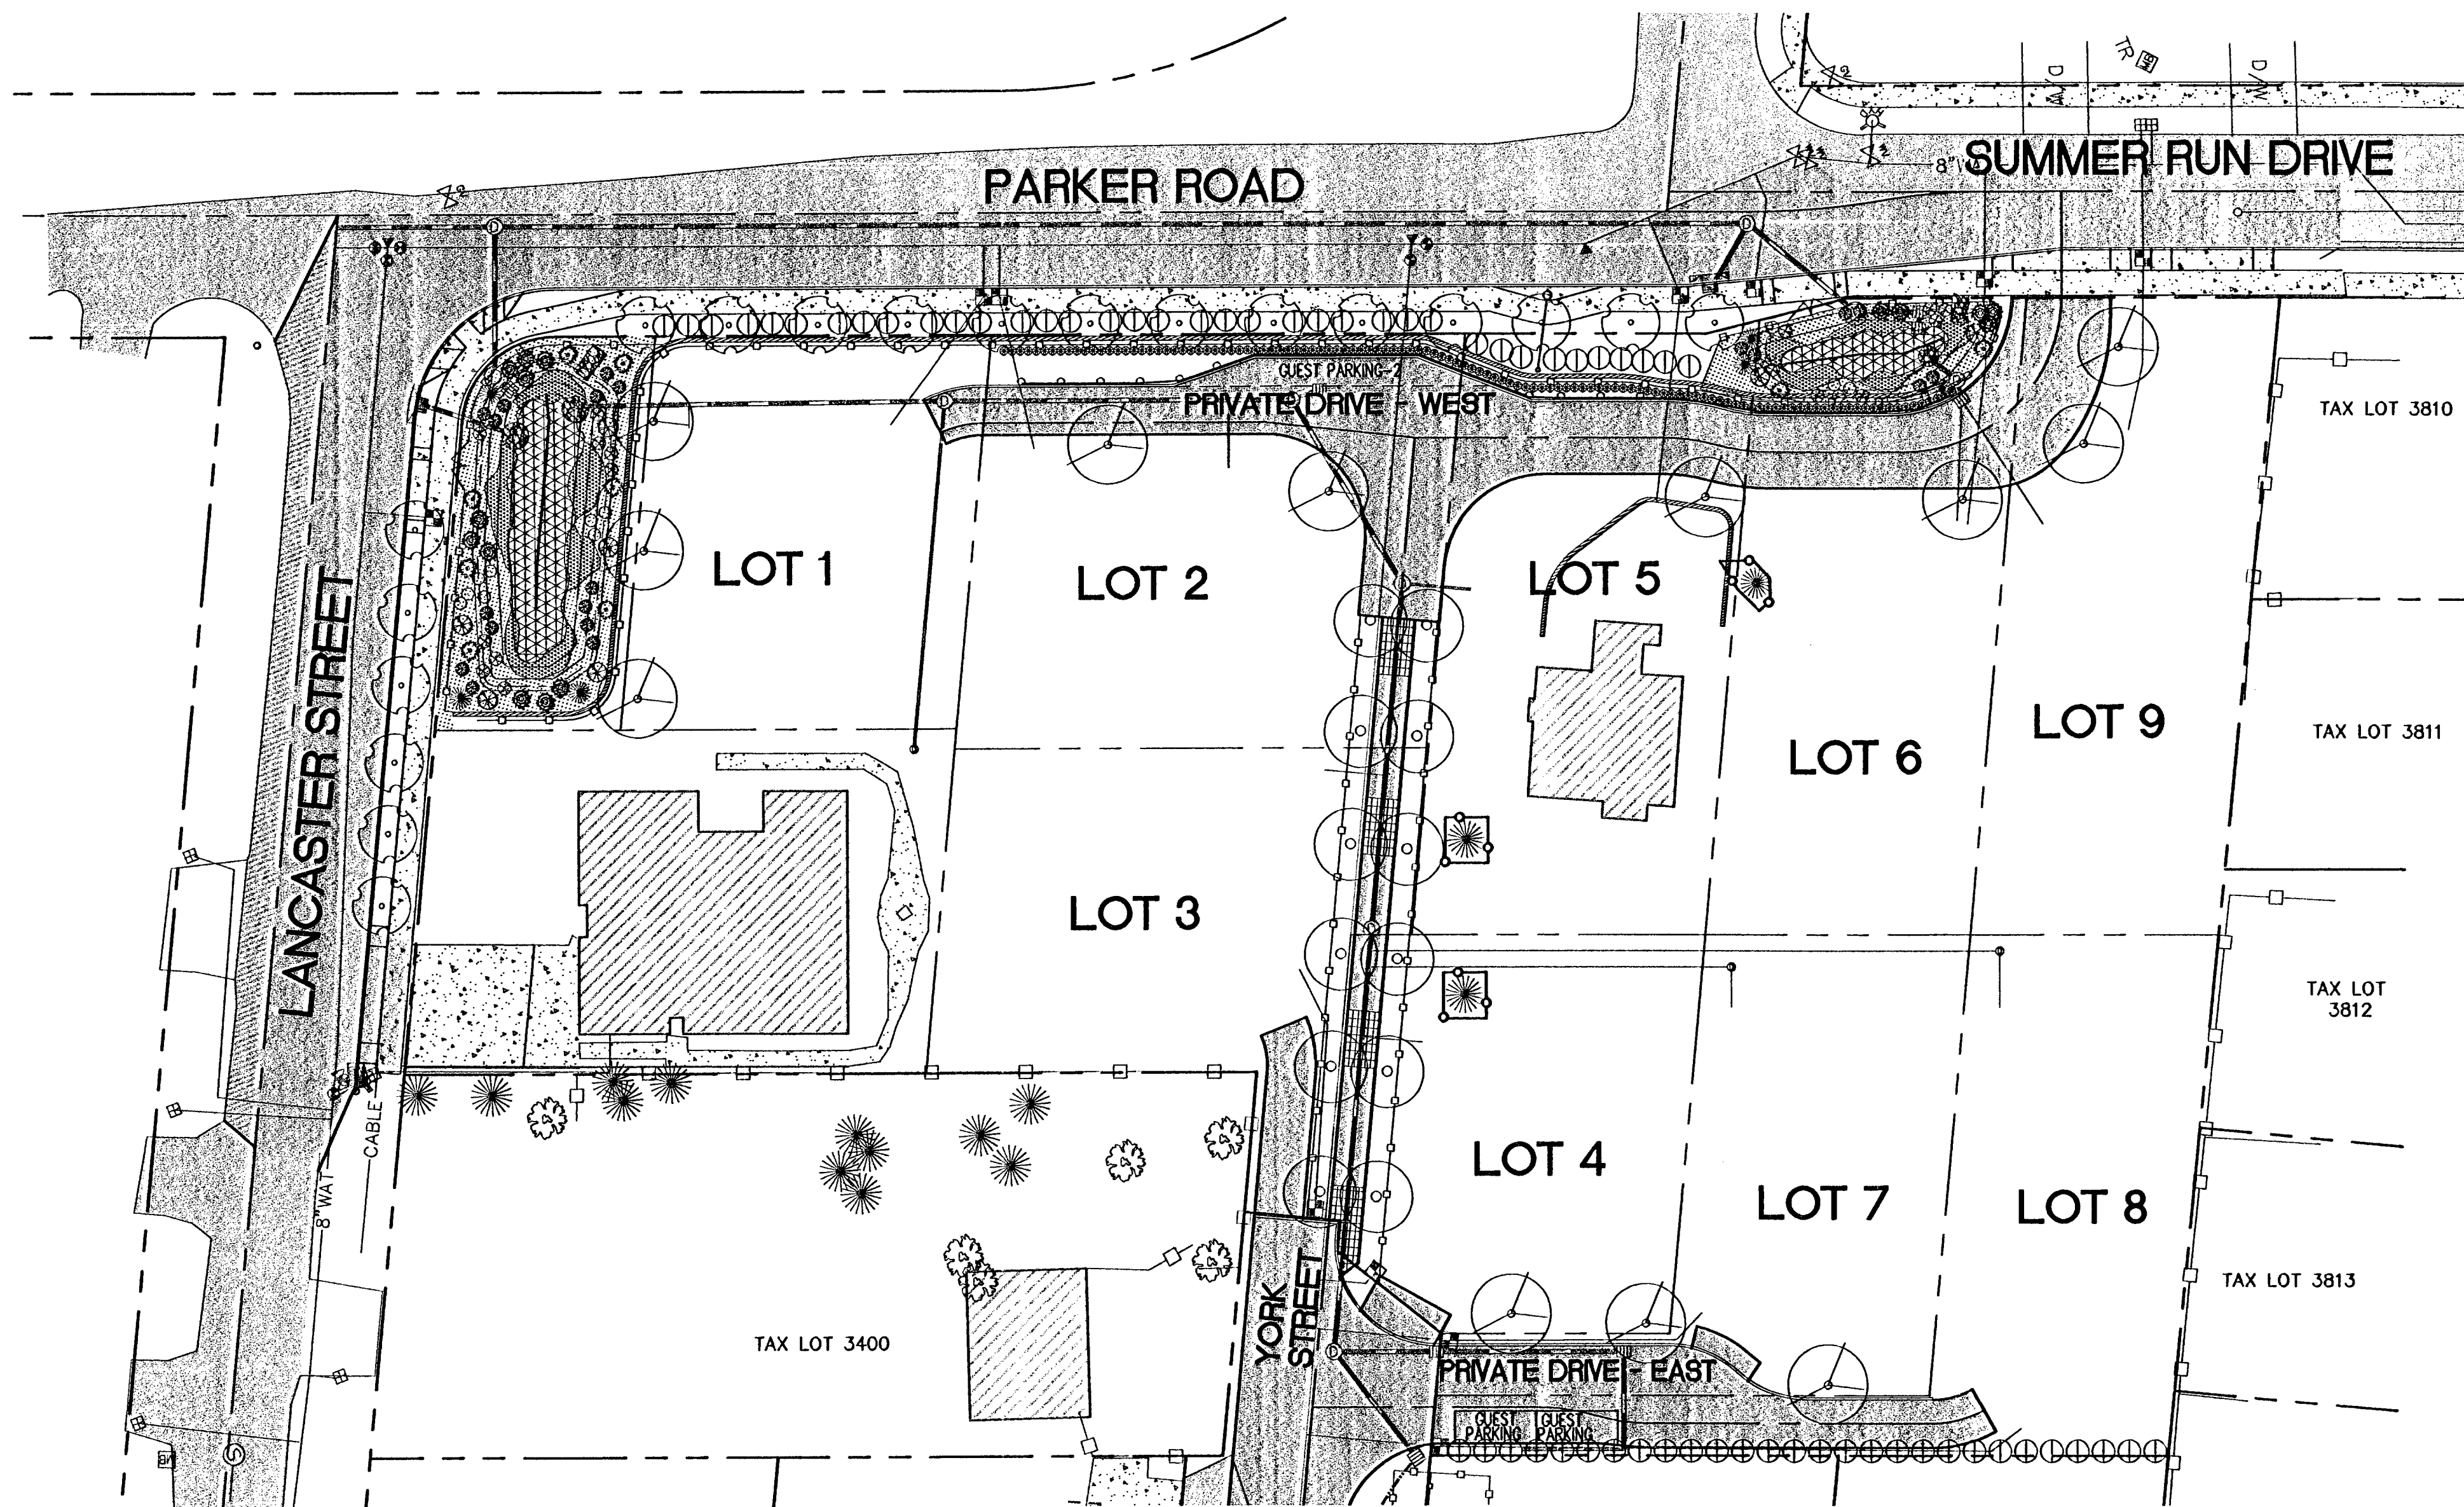

TREES ARE TO BE 2-INCH CALIPER AND IN B&B CONDITION UNLESS OTHERWISE NOTED. FENCING SHOULD BE COATED BLACK.

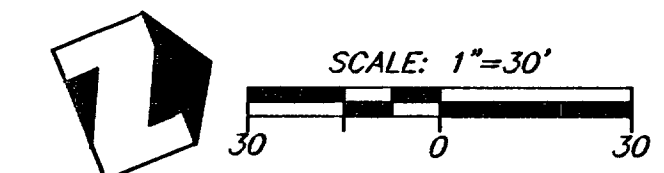

STREET TREE TABLE

SYMBOL	QTY	SCIENTIFIC NAME	COMMON NAME
	19	<i>Carpinus betulus</i> 'Columnaris'	COLUMNAR EUROPEAN HORNBEAM

MITIGATION TREE TABLE

SYMBOL	QTY	SCIENTIFIC NAME	COMMON NAME
	12	<i>Prunus serrulata</i> 'Shogetsu'	SHUGETSU FLOWERING CHERRY

LANDSCAPE/BUFFERING TREES TABLE

SYMBOL	QTY	SCIENTIFIC NAME	COMMON NAME
	119	'Cistus'	ROCK ROASE
	67	<i>Ligustrum japonicum</i> 'Texanum'	WAXLEAF PRIVET
	12	<i>Pyrus calleryana</i> 'Capital'	CAPITAL GALLERY PEAR

POND 'A'

WATER QUALITY/QUANTITY PLANTING TABLE

SYMBOL	QTY	SIZE	SPACING	BOTANICAL NAME	COMMON NAME	CONDITION
	14	1 gal.	3'-4' O.C. (as shown)	<i>Cornus stolonifera</i>	RED OSIER DOGWOOD	B & B
	8	1 gal.	6' O.C. (as shown)	<i>Ribes sanguineum</i>	RED FLOWERING CURRANT	B & B
	9	1 gal.	3'-6' O.C. (as shown)	<i>Mahonia aquifolium</i>	OREGON GRAPE	B & B
	7	8'	9' O.C. (as shown)	<i>Physocarpus capitatus</i>	PACIFIC NINEBARK	B & B
	5	8'	6' O.C. (as shown)	<i>Fraxinus latifolia</i>	OREGON ASH	B & B
	3	8'	12' O.C. (as shown)	<i>Pseudotsuga menziesii</i>	DOUGLAS FIR	B & B
	10	1 gal.	3'-4' O.C. (as shown)	<i>Gaultheria shallon</i>	SALAL	B & B

TREATMENT AREA HYDRO-SEED MIX

SYMBOL	QTY	SPACING	BOTANICAL NAME	COMMON NAME
	6,215 plugs (2" dia. x 8" plugs)	1'-2' on center 1'-2' on center 1'-2' on center	40% <i>Scirpus microcarpus</i> 30% <i>Juncus patens</i> 30% <i>Carex obnupta</i>	SMALL-FRUITED BULRUSH SPREADING RUSH SLOUGH SEDGE

MIDLAND HYDRO-SEED MIX

50% Slough Sedge
25% *Scirpus microcarpus*
25% *Scirpus microcarpus*
plant: 1 lbs per 9,700 s.f.

UPLAND HYDRO-SEED MIX

40% Dwarf Tall Fescue
30% Dwarf Perennial Rye
25% Red Fescue
5% Colonial Bentgrass
plant: 1 lbs per 1,500 s.f.

POND 'B'

WATER QUALITY/QUANTITY PLANTING TABLE

SYMBOL	QTY	SIZE	SPACING	BOTANICAL NAME	COMMON NAME	CONDITION
	6	1 gal.	3'-4' O.C. (as shown)	<i>Cornus stolonifera</i>	RED OSIER DOGWOOD	B & B
	5	1 gal.	6' O.C. (as shown)	<i>Ribes sanguineum</i>	RED FLOWERING CURRANT	B & B
	8	1 gal.	3'-6' O.C. (as shown)	<i>Mahonia aquifolium</i>	OREGON GRAPE	B & B
	2	8'	9' O.C. (as shown)	<i>Physocarpus capitatus</i>	PACIFIC NINEBARK	B & B
	2	8'	6' O.C. (as shown)	<i>Fraxinus latifolia</i>	OREGON ASH	B & B
	3	8'	12' O.C. (as shown)	<i>Pseudotsuga menziesii</i>	DOUGLAS FIR	B & B
	5	1 gal.	3'-4' O.C. (as shown)	<i>Gaultheria shallon</i>	SALAL	B & B

TREATMENT AREA HYDRO-SEED MIX


SYMBOL	QTY	SPACING	BOTANICAL NAME	COMMON NAME
	2,450 plugs (2" dia. x 8" plugs)	1'-2' on center 1'-2' on center 1'-2' on center	40% <i>Scirpus microcarpus</i> 30% <i>Juncus patens</i> 30% <i>Carex obnupta</i>	SMALL-FRUITED BULRUSH SPREADING RUSH SLOUGH SEDGE

MIDLAND HYDRO-SEED MIX



50% Slough Sedge
25% *Scirpus microcarpus*
25% *Scirpus microcarpus*
plant: 1 lbs per 9,700 s.f.

UPLAND HYDRO-SEED MIX


40% Dwarf Tall Fescue
30% Dwarf Perennial Rye
25% Red Fescue
5% Colonial Bentgrass
plant: 1 lbs per 1,500 s.f.

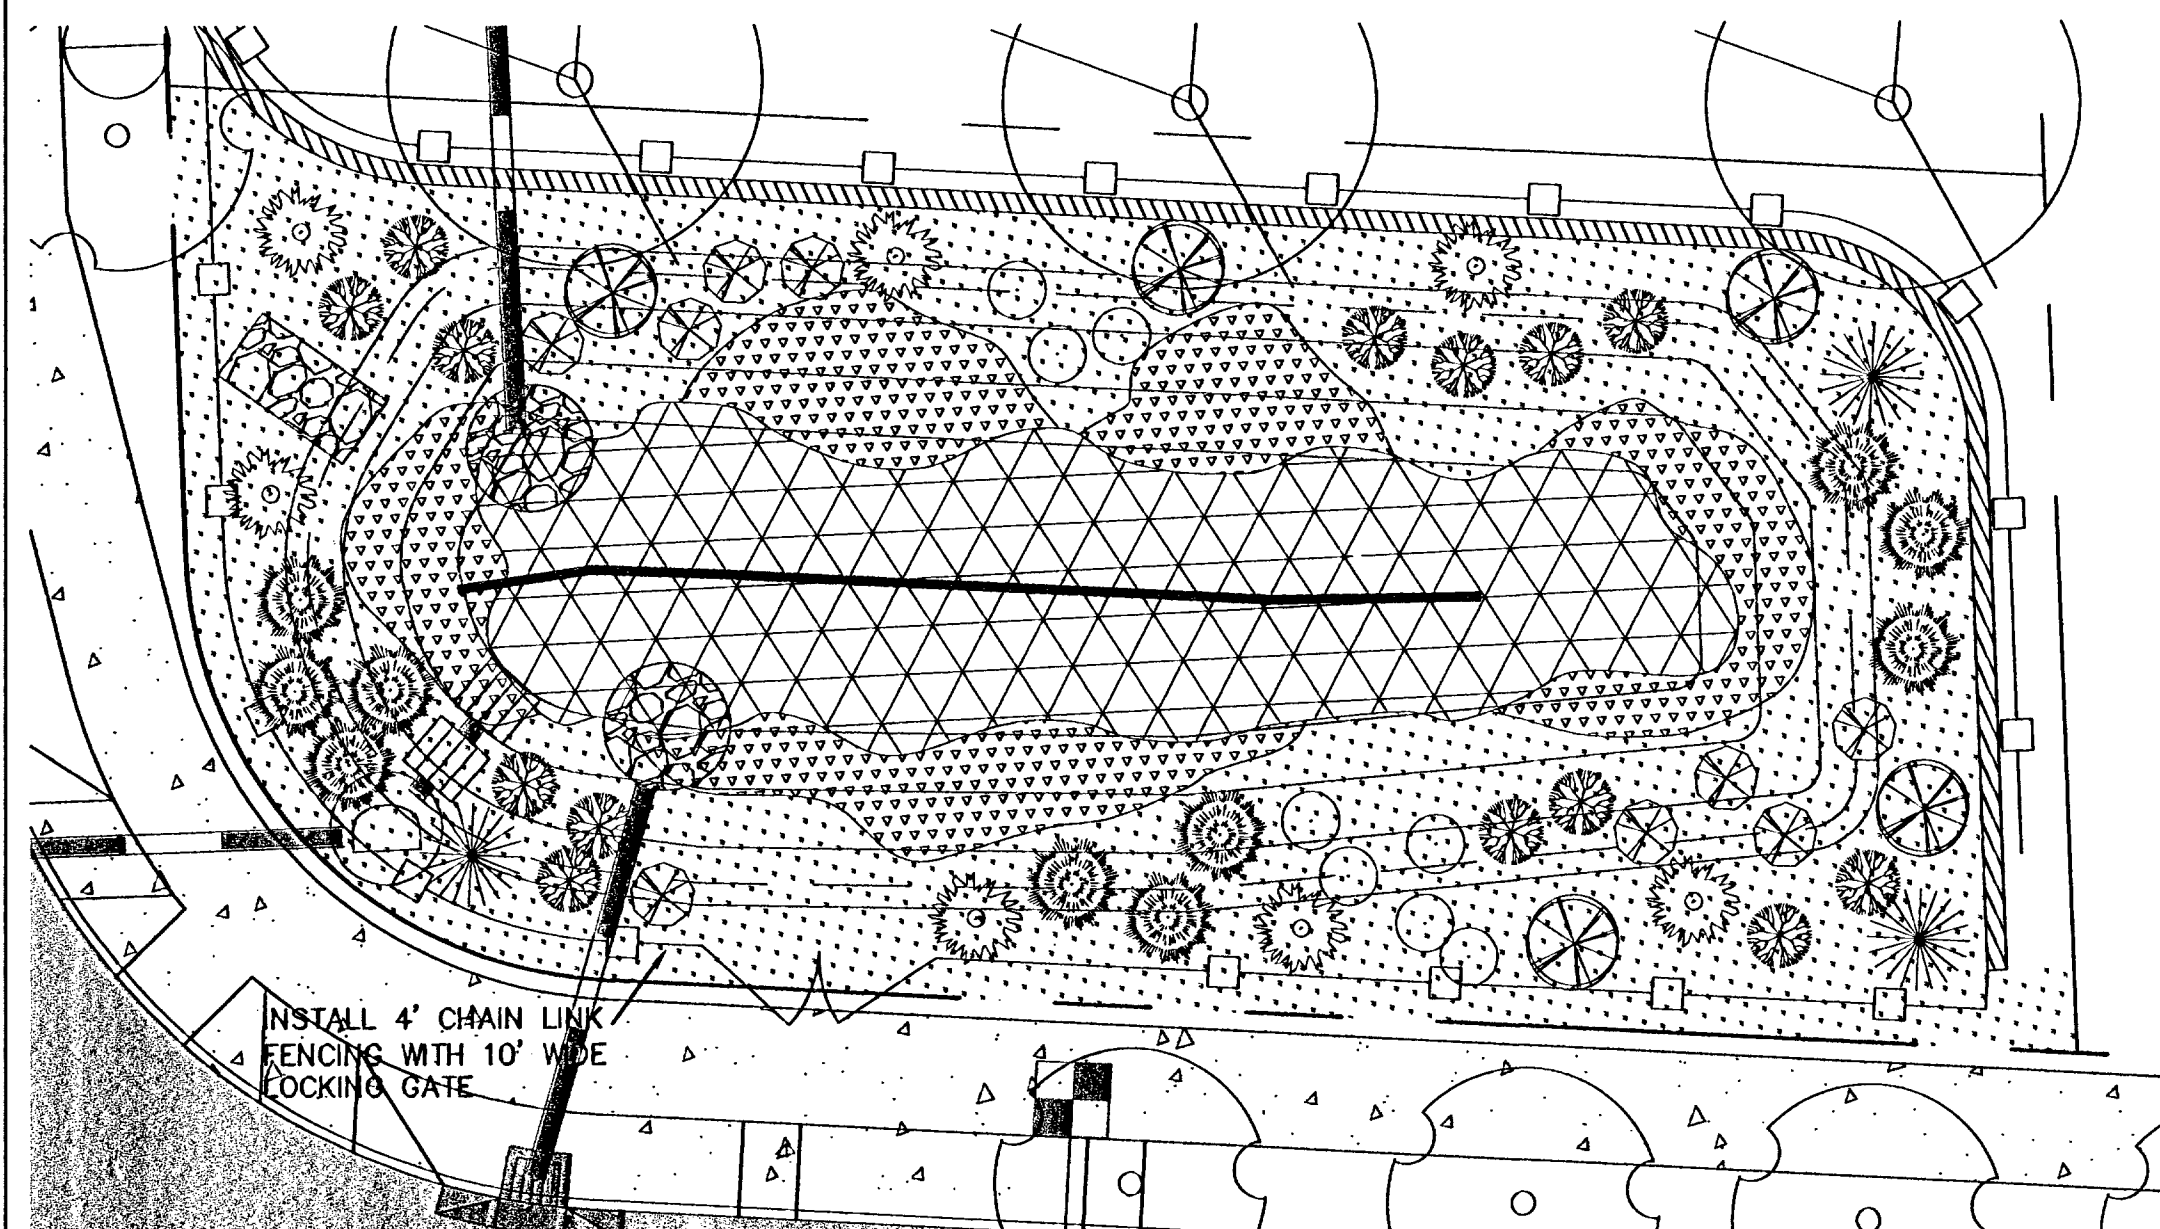

POND 'A' ENLARGEMENT

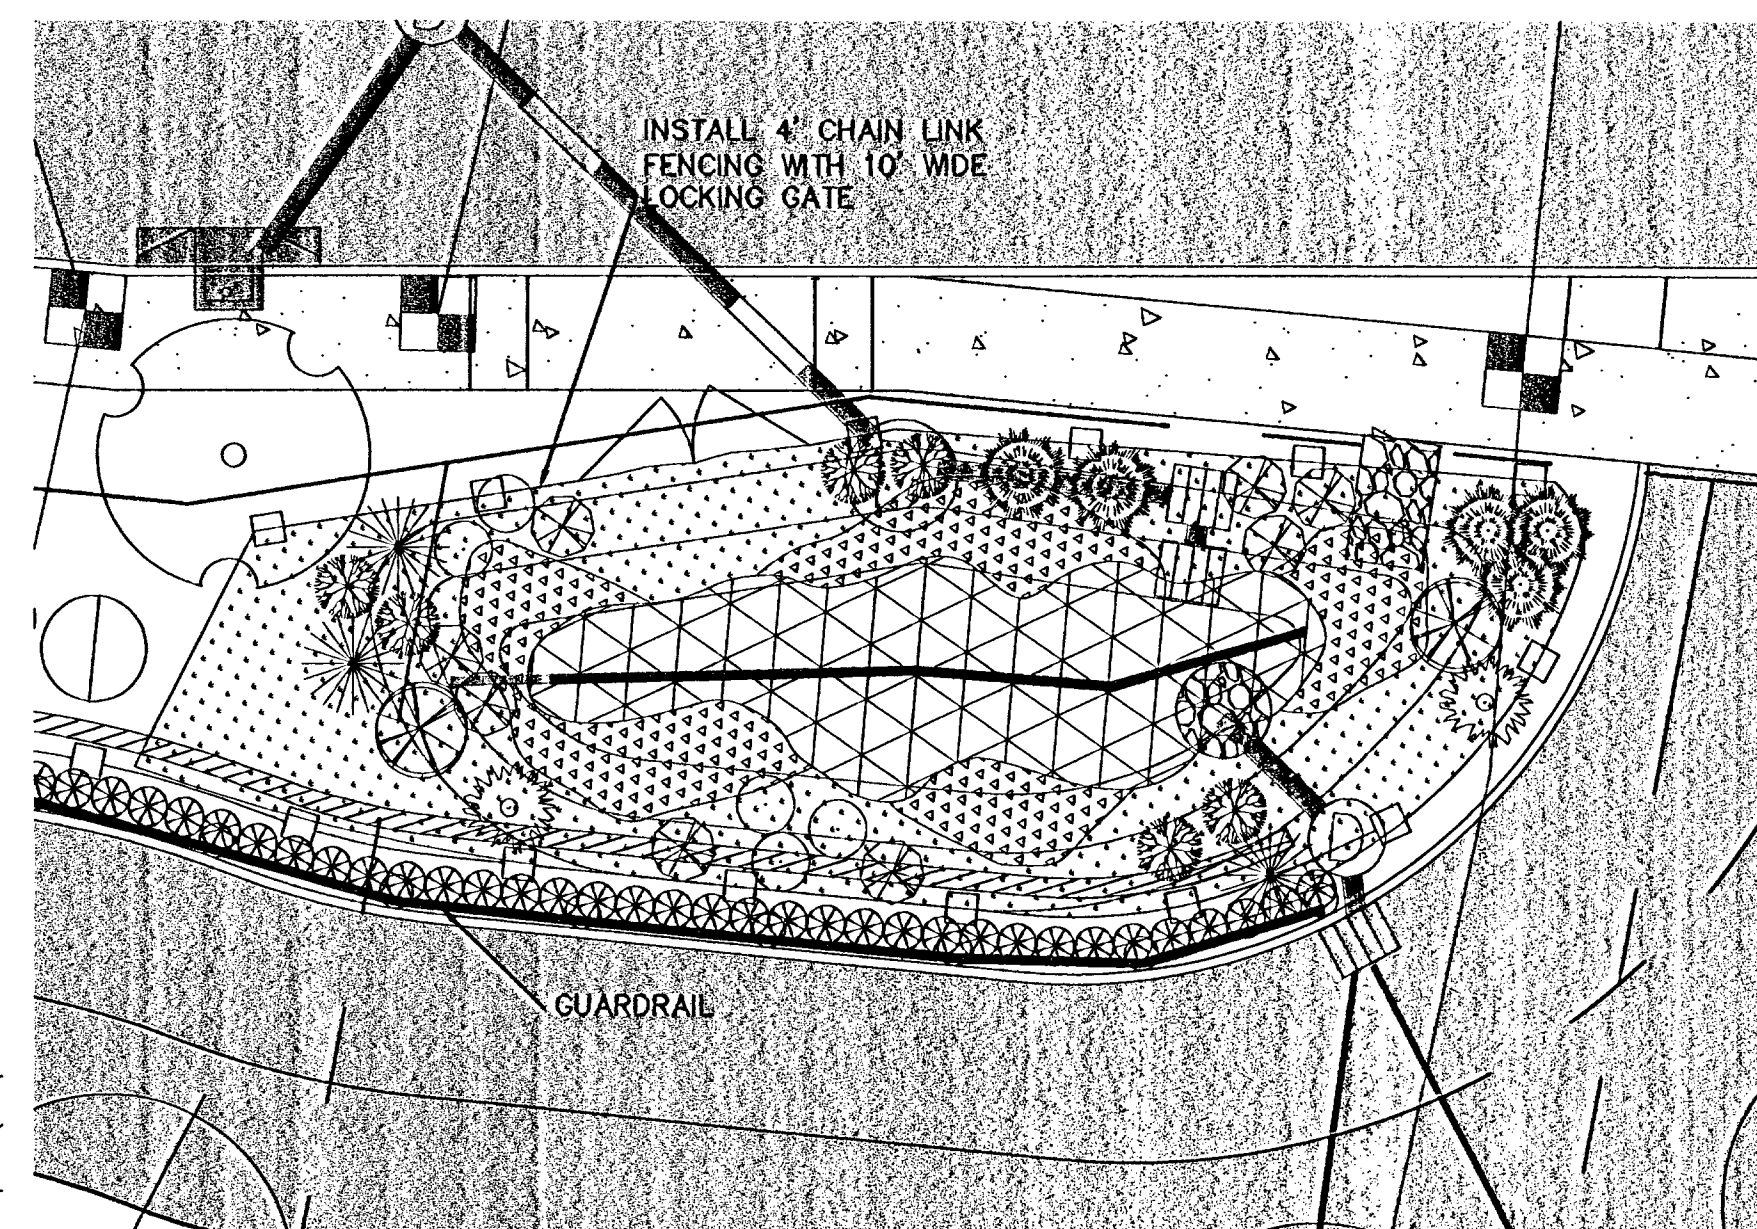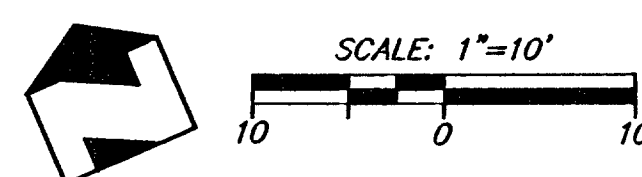

POND 'B' ENLARGEMENT

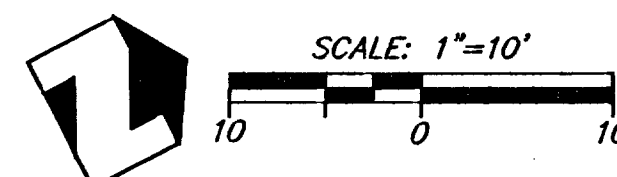

WEST LINN CASEFILE SUB05-03 / ZC05-05 / VAR05-03

LANDSCAPING PLAN

SIENNA'S ESTATES

City of West Linn, Clackamas County, Oregon

SAM L PAP

2799 LANCASTER STREET
WEST LINN, OREGON 97068
(503) 888-2254

CIVIL ENGINEERING
DESIGN/CONSTRUCT
CONSULTING
LANDSCAPE ARCHITECTURE
LANPACIFIC
5125 SW Macadam, Suite 140, Portland, Oregon 97239
TEL: 503 | 238-2097 FAX: 503 | 238-2447
www.lanpacific.com

REGISTERED PROFESSIONAL ENGINEER
LANDSCAPE ARCHITECT
U.S. SCOTT EMERY
EXP. 12/31/09

RECORD DRAWING
01/18/08

THESE RECORD DRAWINGS HAVE BEEN PREPARED, IN PART, ON THE BASIS OF INFORMATION COMPILED AND FURNISHED BY THE CONTRACTOR, REISED CONSTRUCTION PLANS, AND FIELD OBSERVATIONS DURING CONSTRUCTION.

DATE 01/18/08
DRAWN JSE
DESIGNED JSE
CHECKED RGN
PROJECT SLP04-001

SHEET TITLE
LANDSCAPING PLAN


SHEET NUMBER

C016

ASBUILT CONSTRUCTION DOCUMENTS




1. THE CONTRACTOR SHALL INSTALL PLANT MATERIALS USING TOPSOIL, WHICH CONSISTS OF ONE PART COMPOST AND TWO PARTS SANDY LOAM, AS INDICATED ON THE DETAILS.
2. ALL PLANTING AREAS SHALL RECEIVE A MINIMUM OF TWO INCHES OF MEDIUM, FINE AND NON-TOXIC BARK MULCH.
3. FERTILIZER SHALL BE STANDARD APPROVED BRAND, DELIVERED IN ORIGINAL CONTAINERS DRY AND FREE FLOWING BEARING GUARANTEED ANALYSIS OF THE MANUFACTURER. THE ORGANIC BASE SHALL BE 16-16-16.
4. COMPACT PREPARED SOIL MIX AND FLOAT LANDSCAPE AREAS TO PERIMETER ELEVATIONS REPRESENTED BY CURBS AND WALKS.
5. TOPSOIL SHALL BE FREE OF NOXIOUS WEEDS AND WEED SEEDS. CONTRACTOR SHALL GUARANTEE THAT WEEDS HAVE BEEN REMOVED PRIOR TO INSTALLATION.
6. ALL PLANTS SELECTED SHALL BE CONSISTENT WITH CURRENT AMERICAN NURSERYMEN'S STANDARDS. ANY PLANTS THAT ARE DISEASED, DEFORMED, ROOT BOUND, POORLY SHAPED AND DEFICIENT OF HEALTHY CHARACTERISTICS SHALL NOT BE ACCEPTED.
7. ALL PLANT MATERIAL SHALL BE WARRANTED FOR A PERIOD OF ONE YEAR AND SHALL BE IN A HEALTHY CONDITION AT THAT TIME. ALL PLANTS DEAD OR EXHIBITING UNHEALTHY CHARACTERISTICS SHALL BE REPLACED AT NO CHARGE TO THE OWNER.
8. ADJUST PLANTINGS AS NECESSARY TO KEEP SHRUBS AWAY FROM DOORS AND WINDOWS
9. VERIFY LOCATION OF ALL UTILITIES IN FIELD PRIOR TO COMMENCEMENT OF WORK.
10. NOTIFY LANDSCAPE ARCHITECT OF ANY AND ALL DISCREPANCIES IN EXISTING CONDITIONS OR THAT DIFFER FROM PLAN
11. CONTRACTOR TO PROVIDE PLANT QUANTITIES.

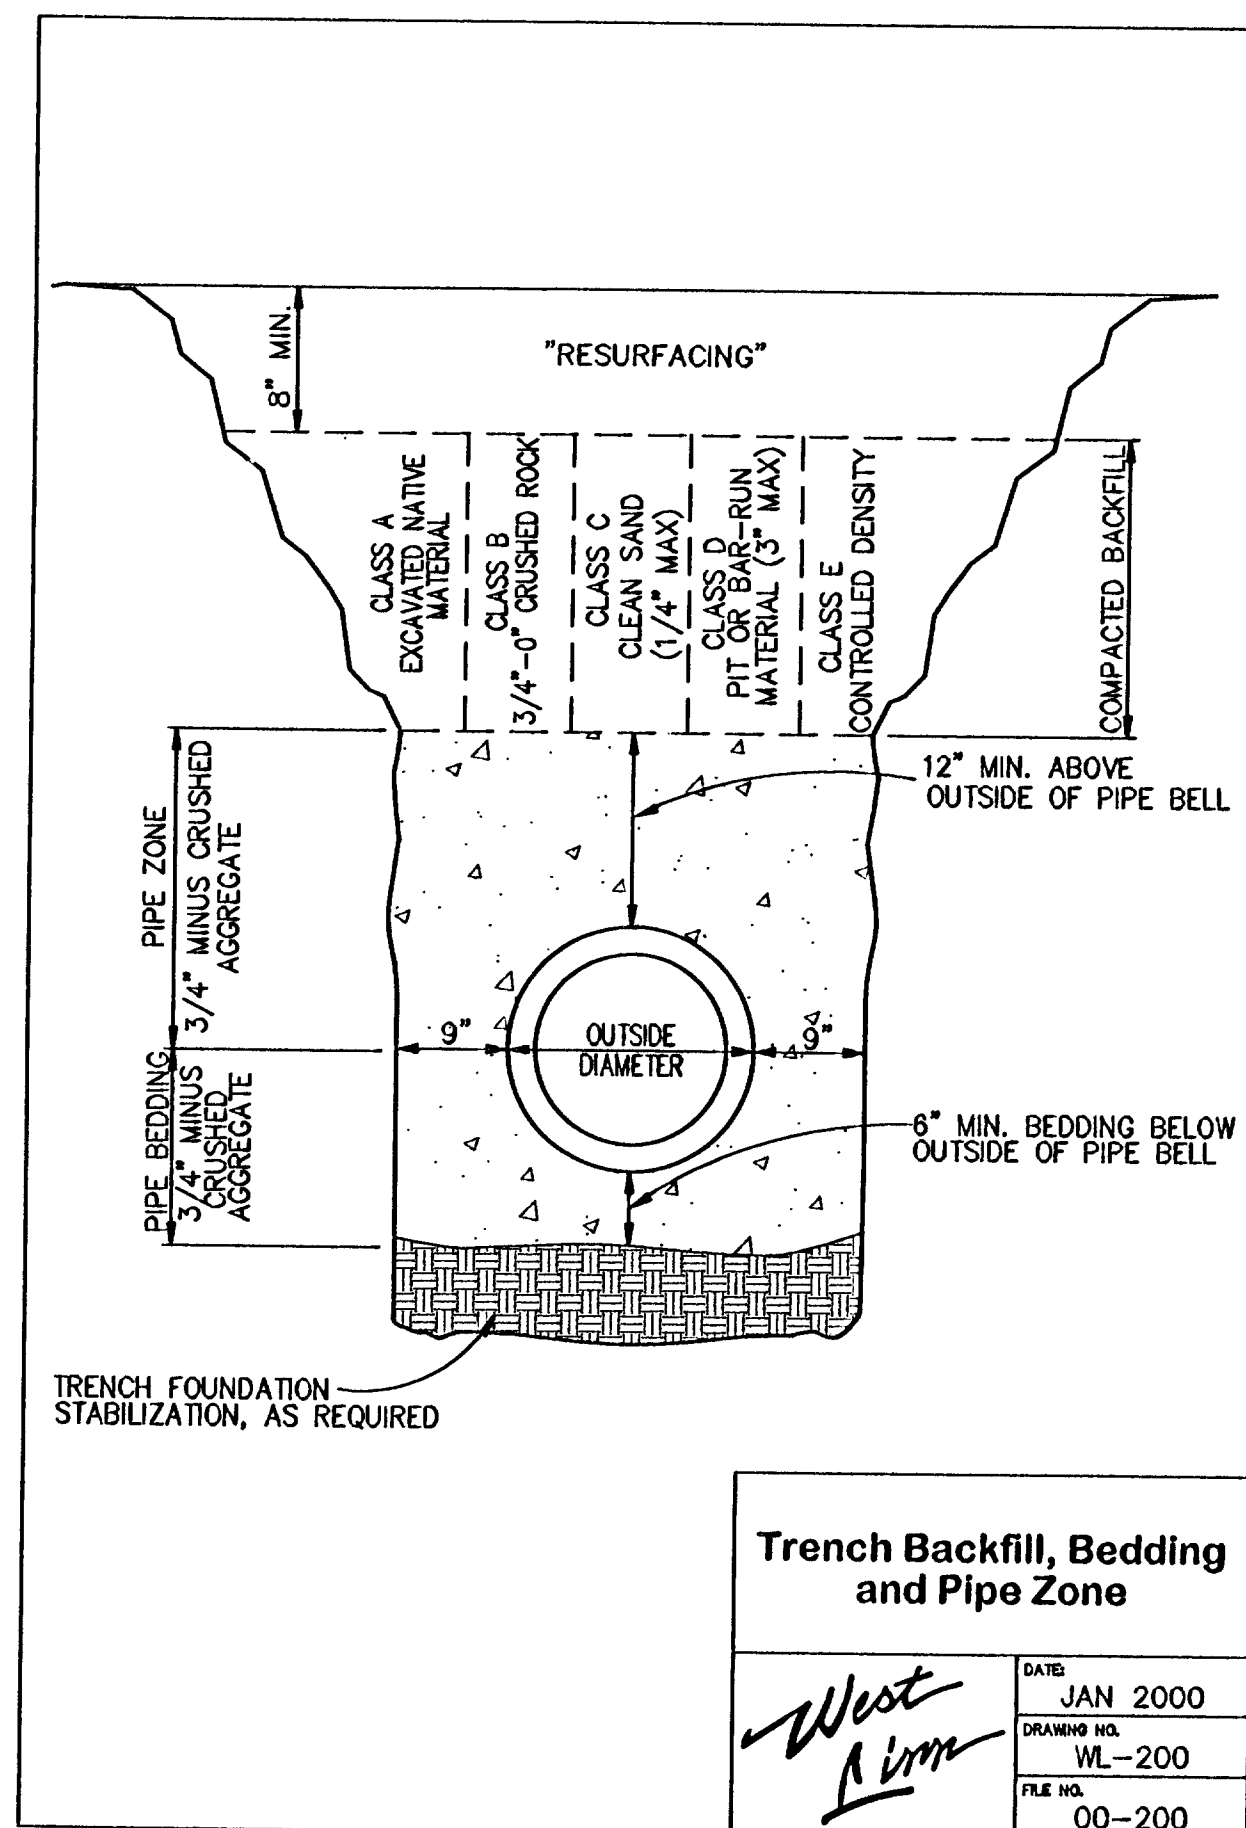

Trench Backfill, Bedding and Pipe Zone

DATE:	JAN 2000
DRAWING NO.:	WL-200
FILE NO.:	00-200


TRENCH BACKFILL, BEDDING AND PIPE ZONE DETAIL
NOT TO SCALE

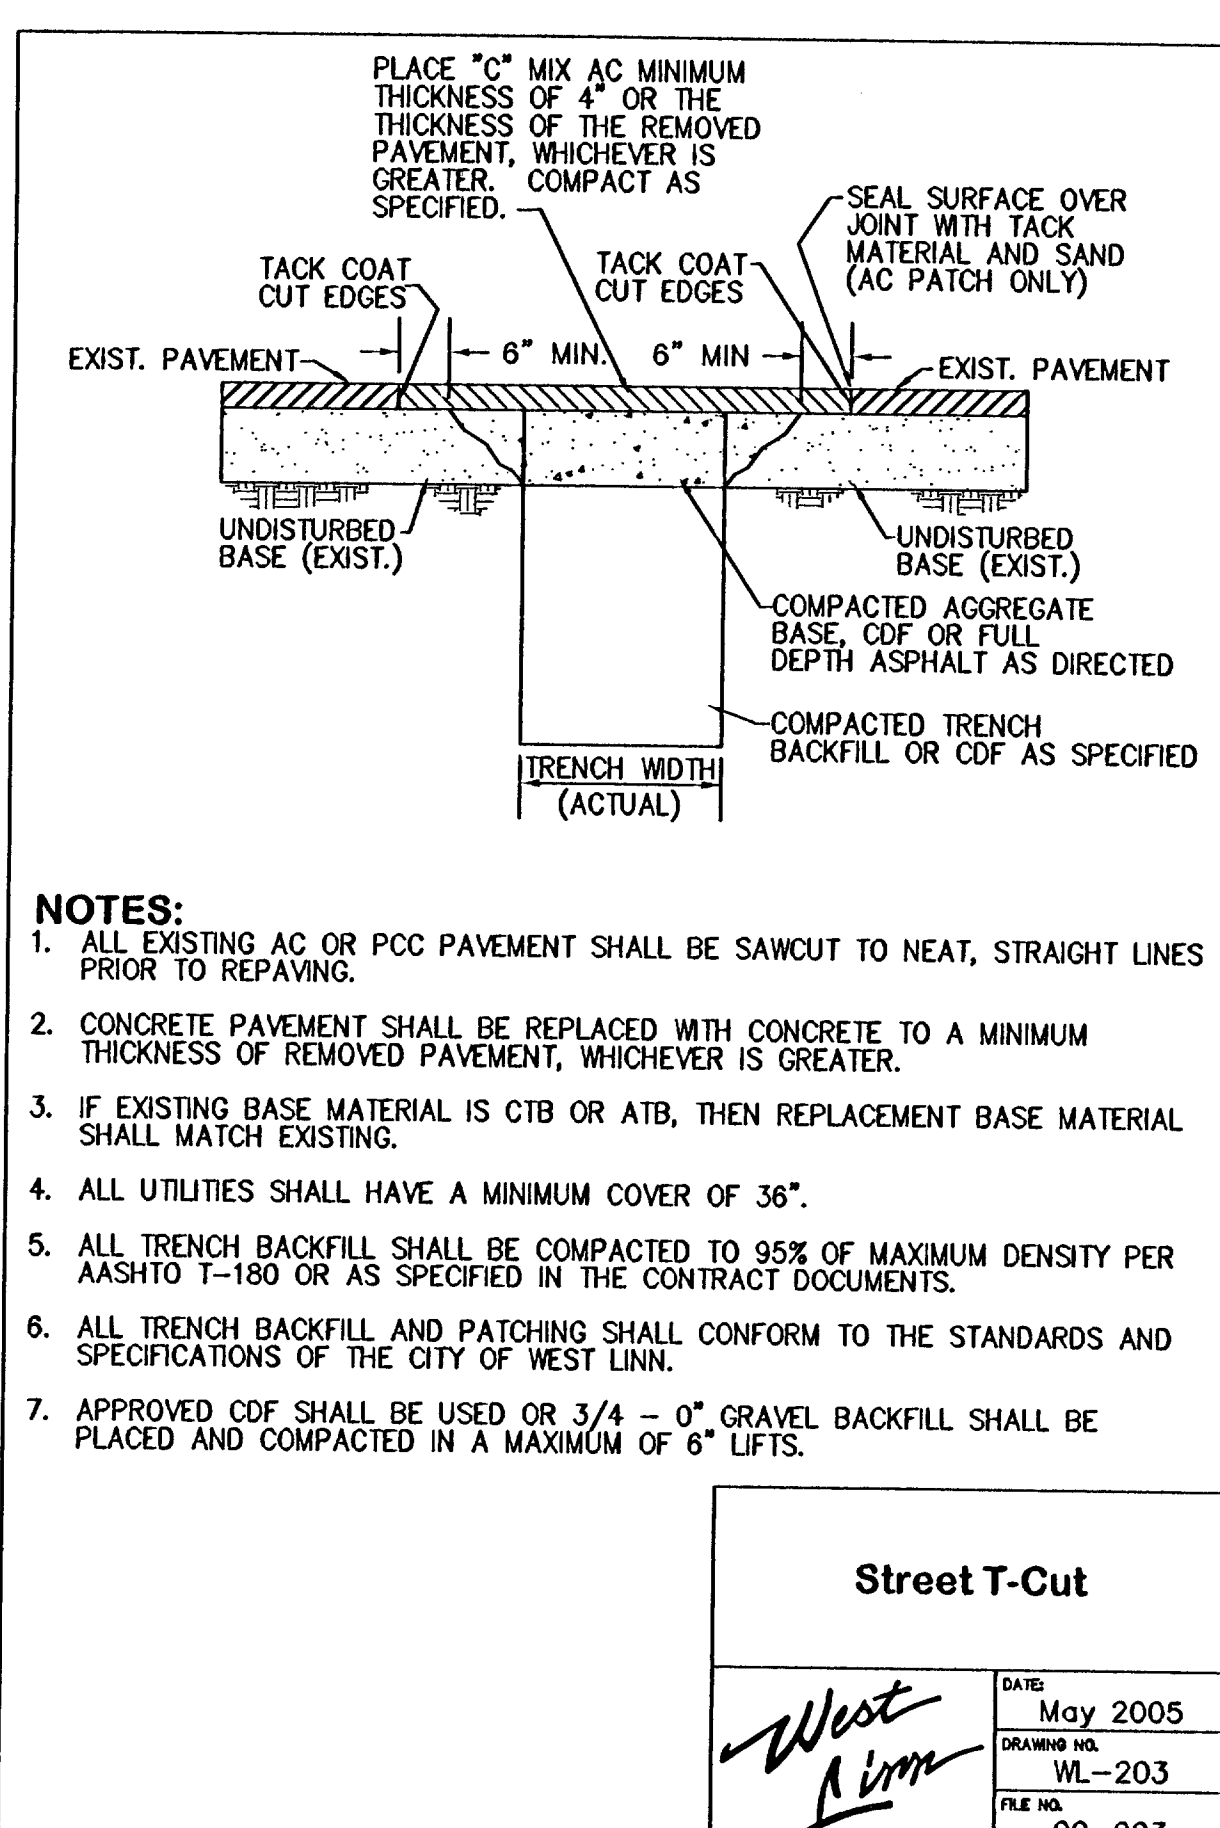

Street T-Cut

DATE:	MAY 2005
DRAWING NO.:	WL-203
FILE NO.:	00-203


STREET T-CUT DETAIL
NOT TO SCALE

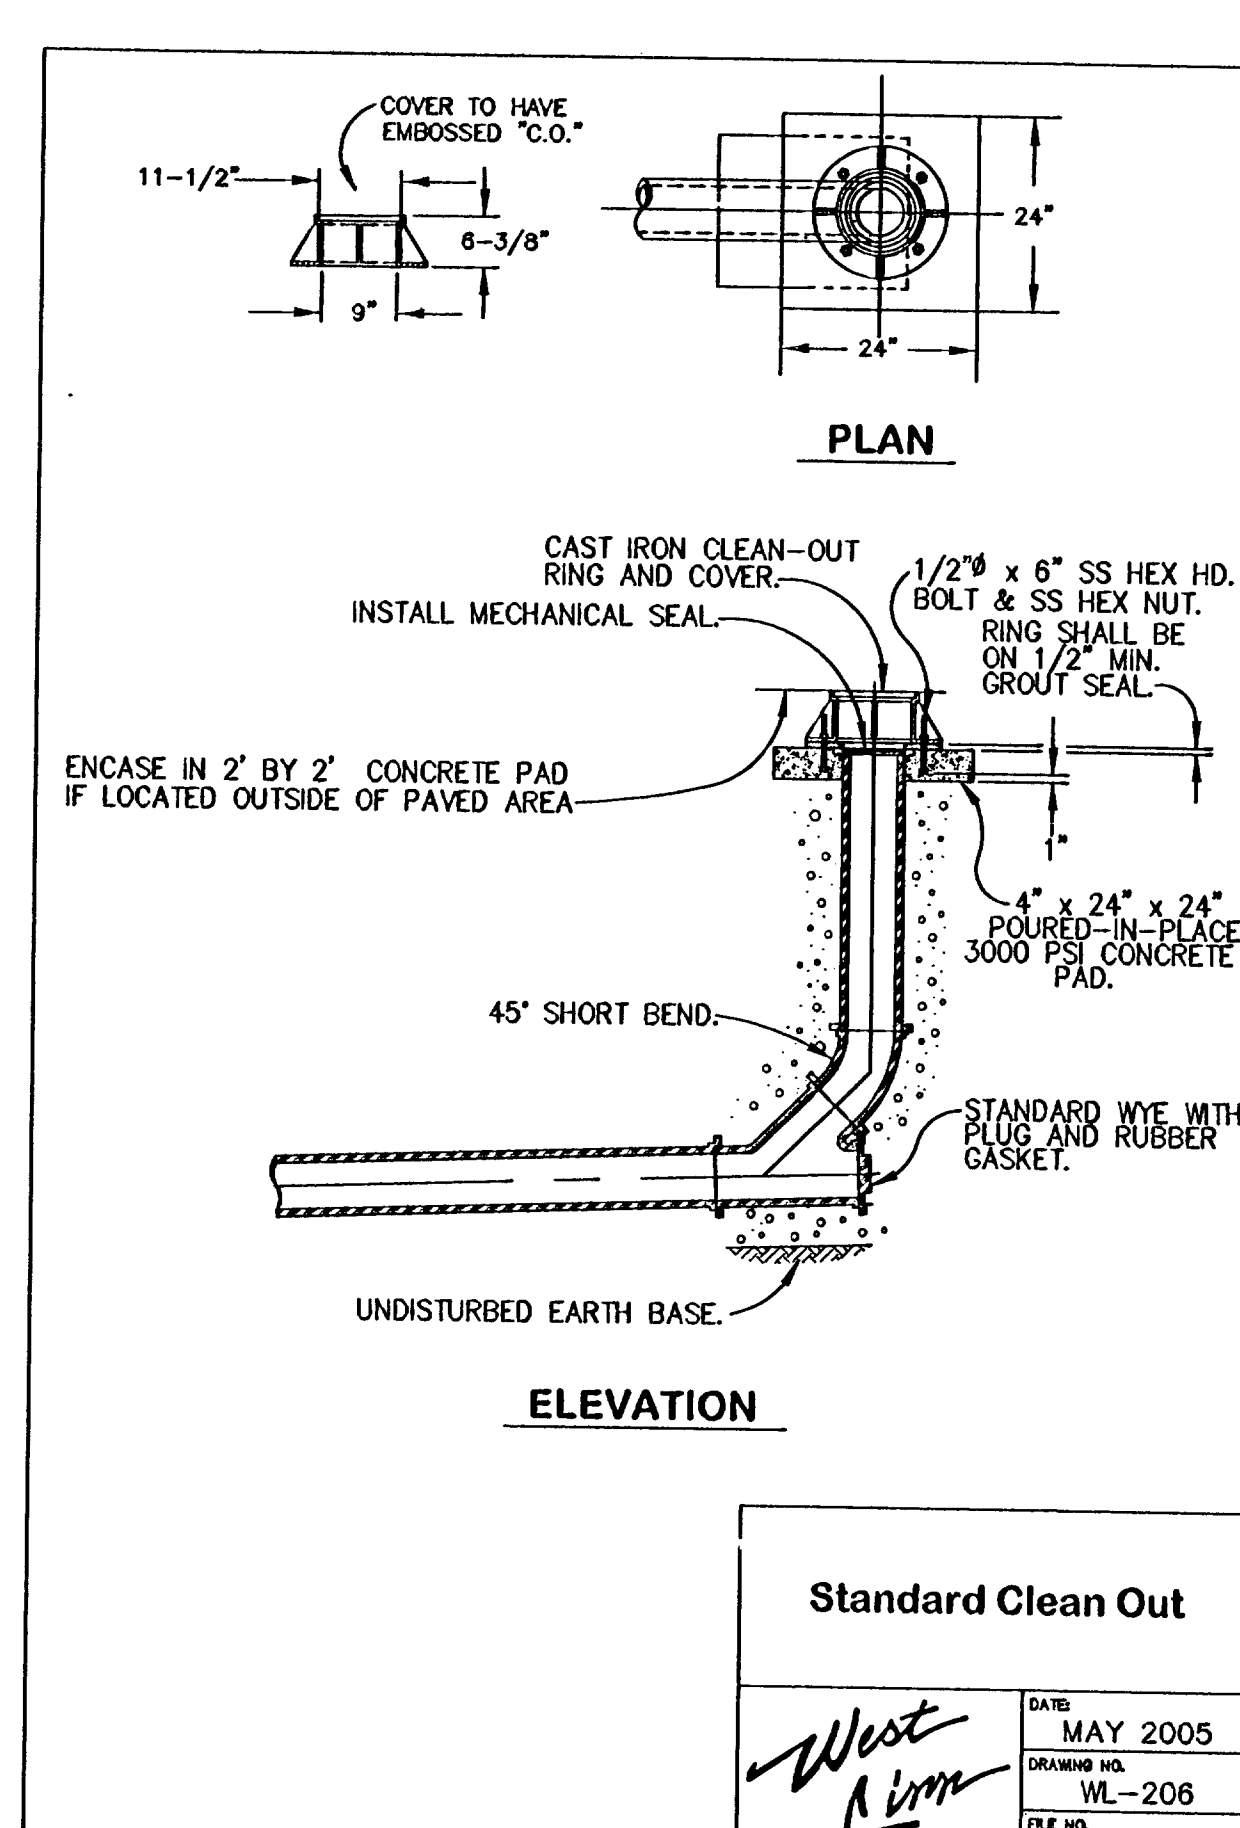

Standard Clean Out

DATE:	MAY 2005
DRAWING NO.:	WL-206
FILE NO.:	00-206


STANDARD CLEAN OUT
NOT TO SCALE

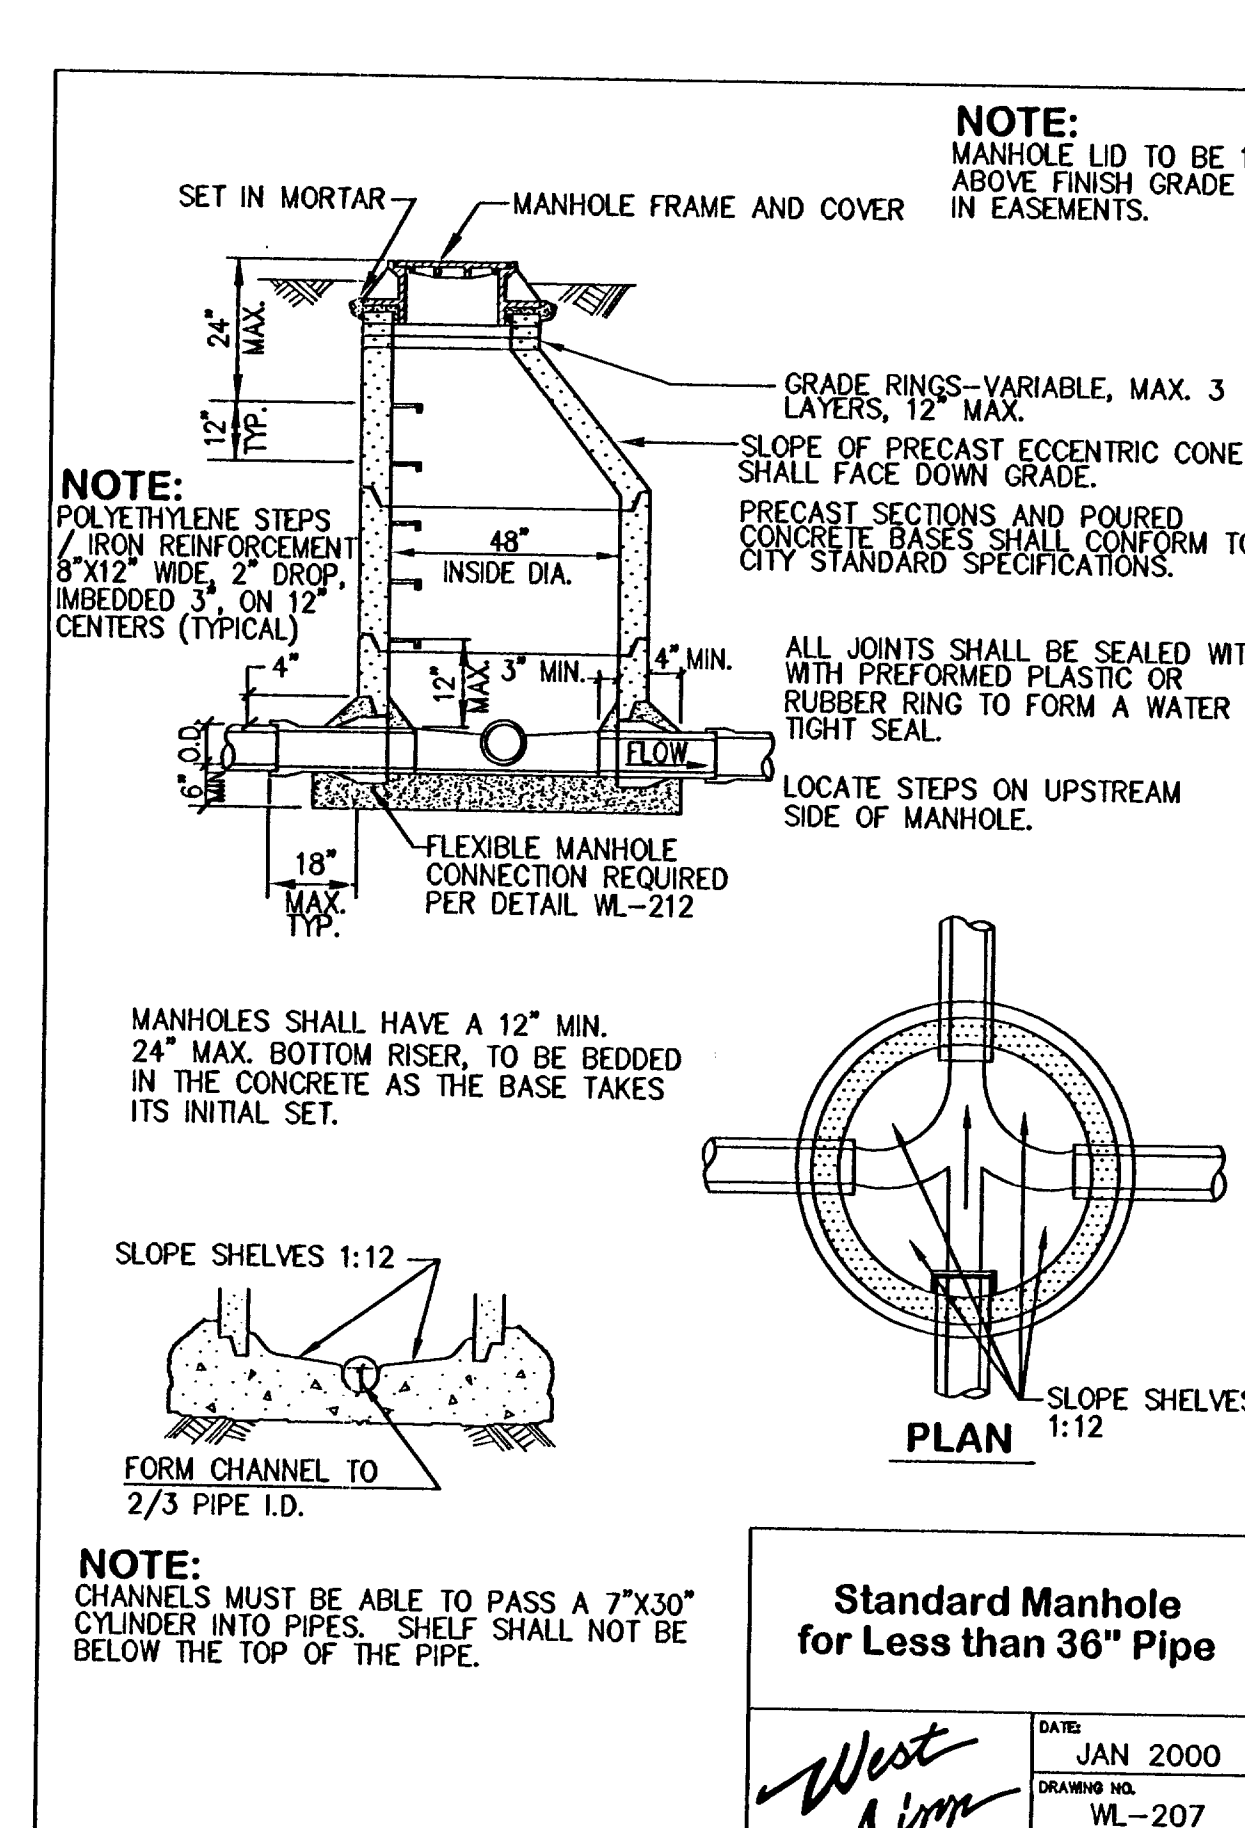

Standard Manhole for Less than 36\"/>

DATE:	JAN 2000
DRAWING NO.:	WL-207
FILE NO.:	00-207


STANDARD MANHOLE DETAIL
NOT TO SCALE

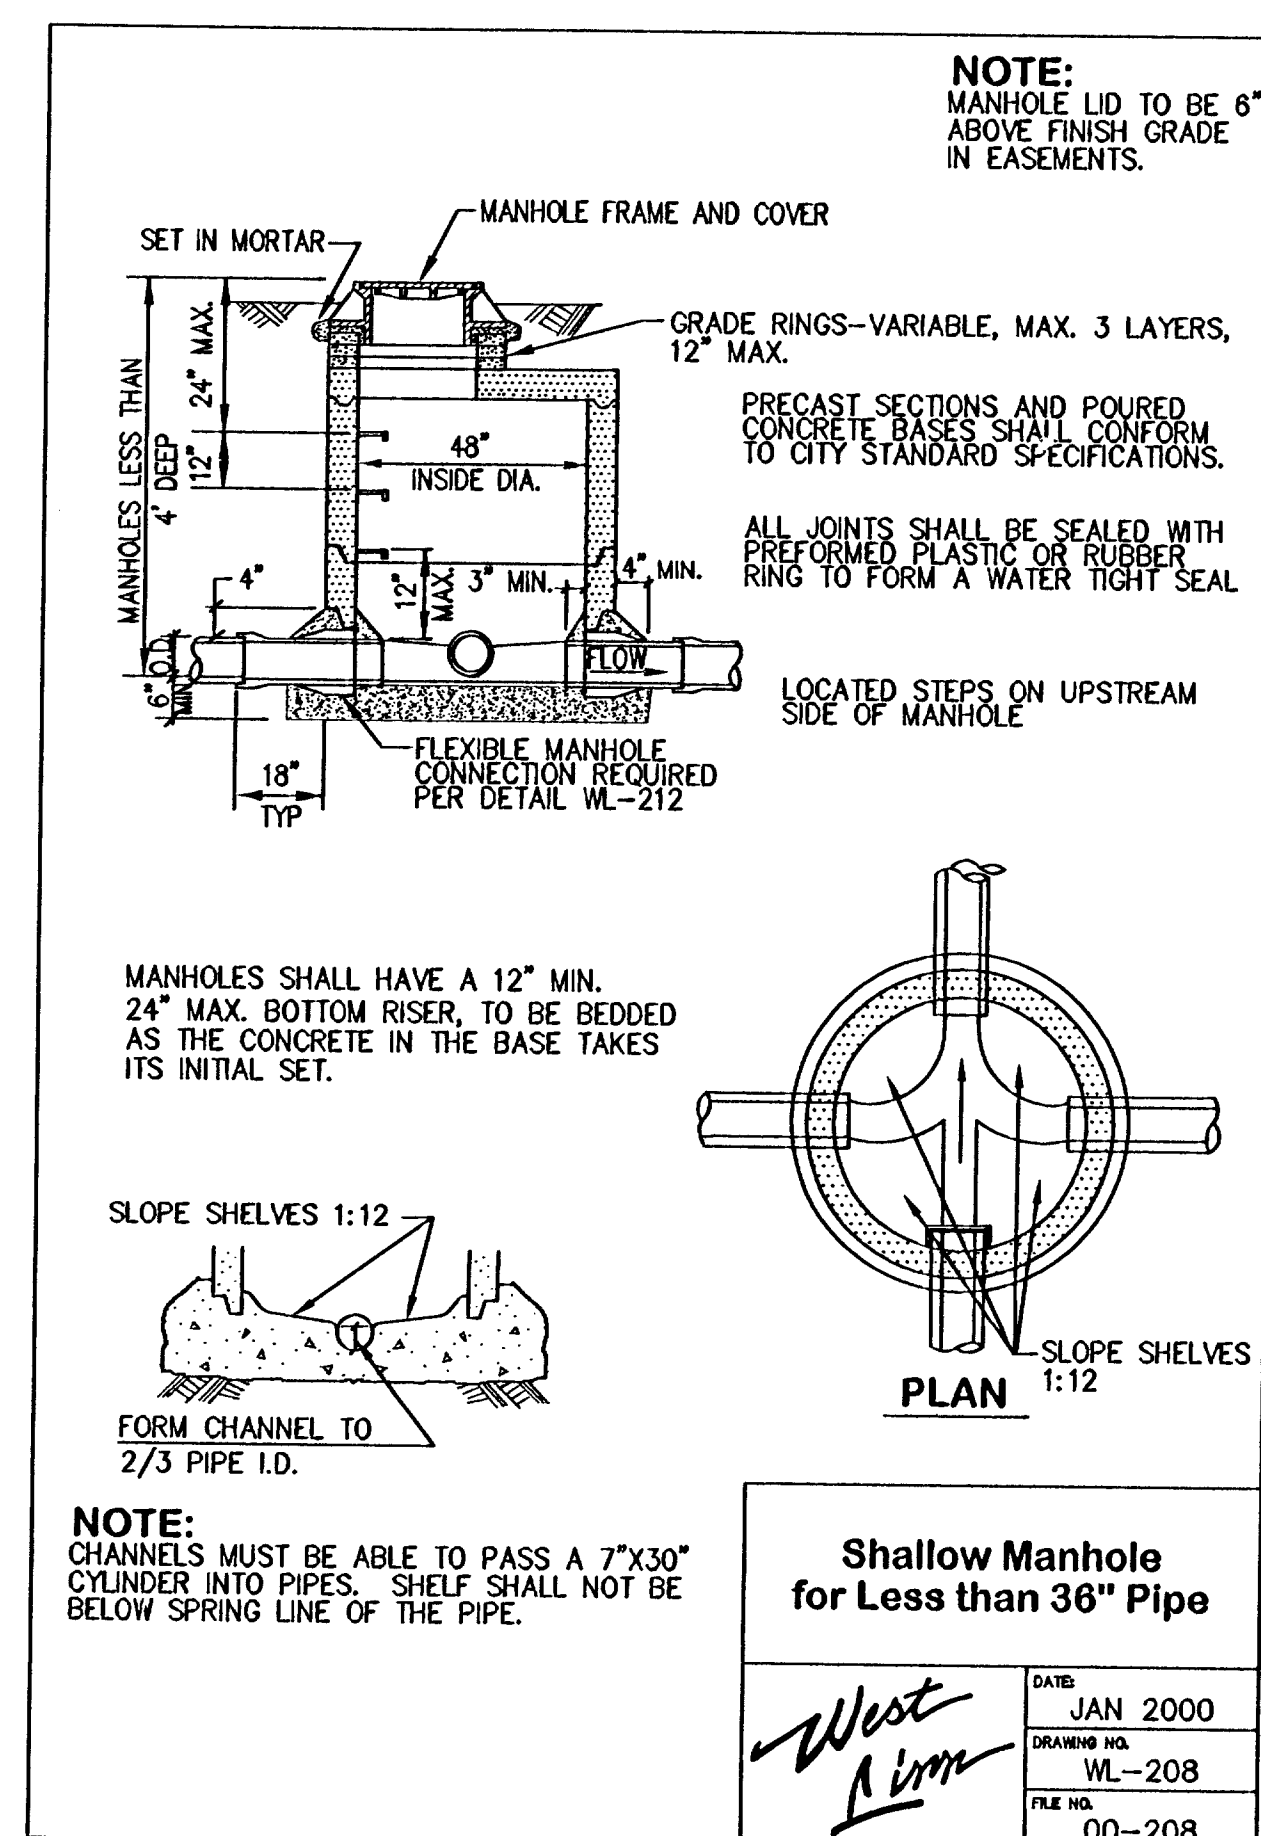

Shallow Manhole for Less than 36\"/>

DATE:	JAN 2000
DRAWING NO.:	WL-208
FILE NO.:	00-208


SHALLOW MANHOLE DETAIL
NOT TO SCALE

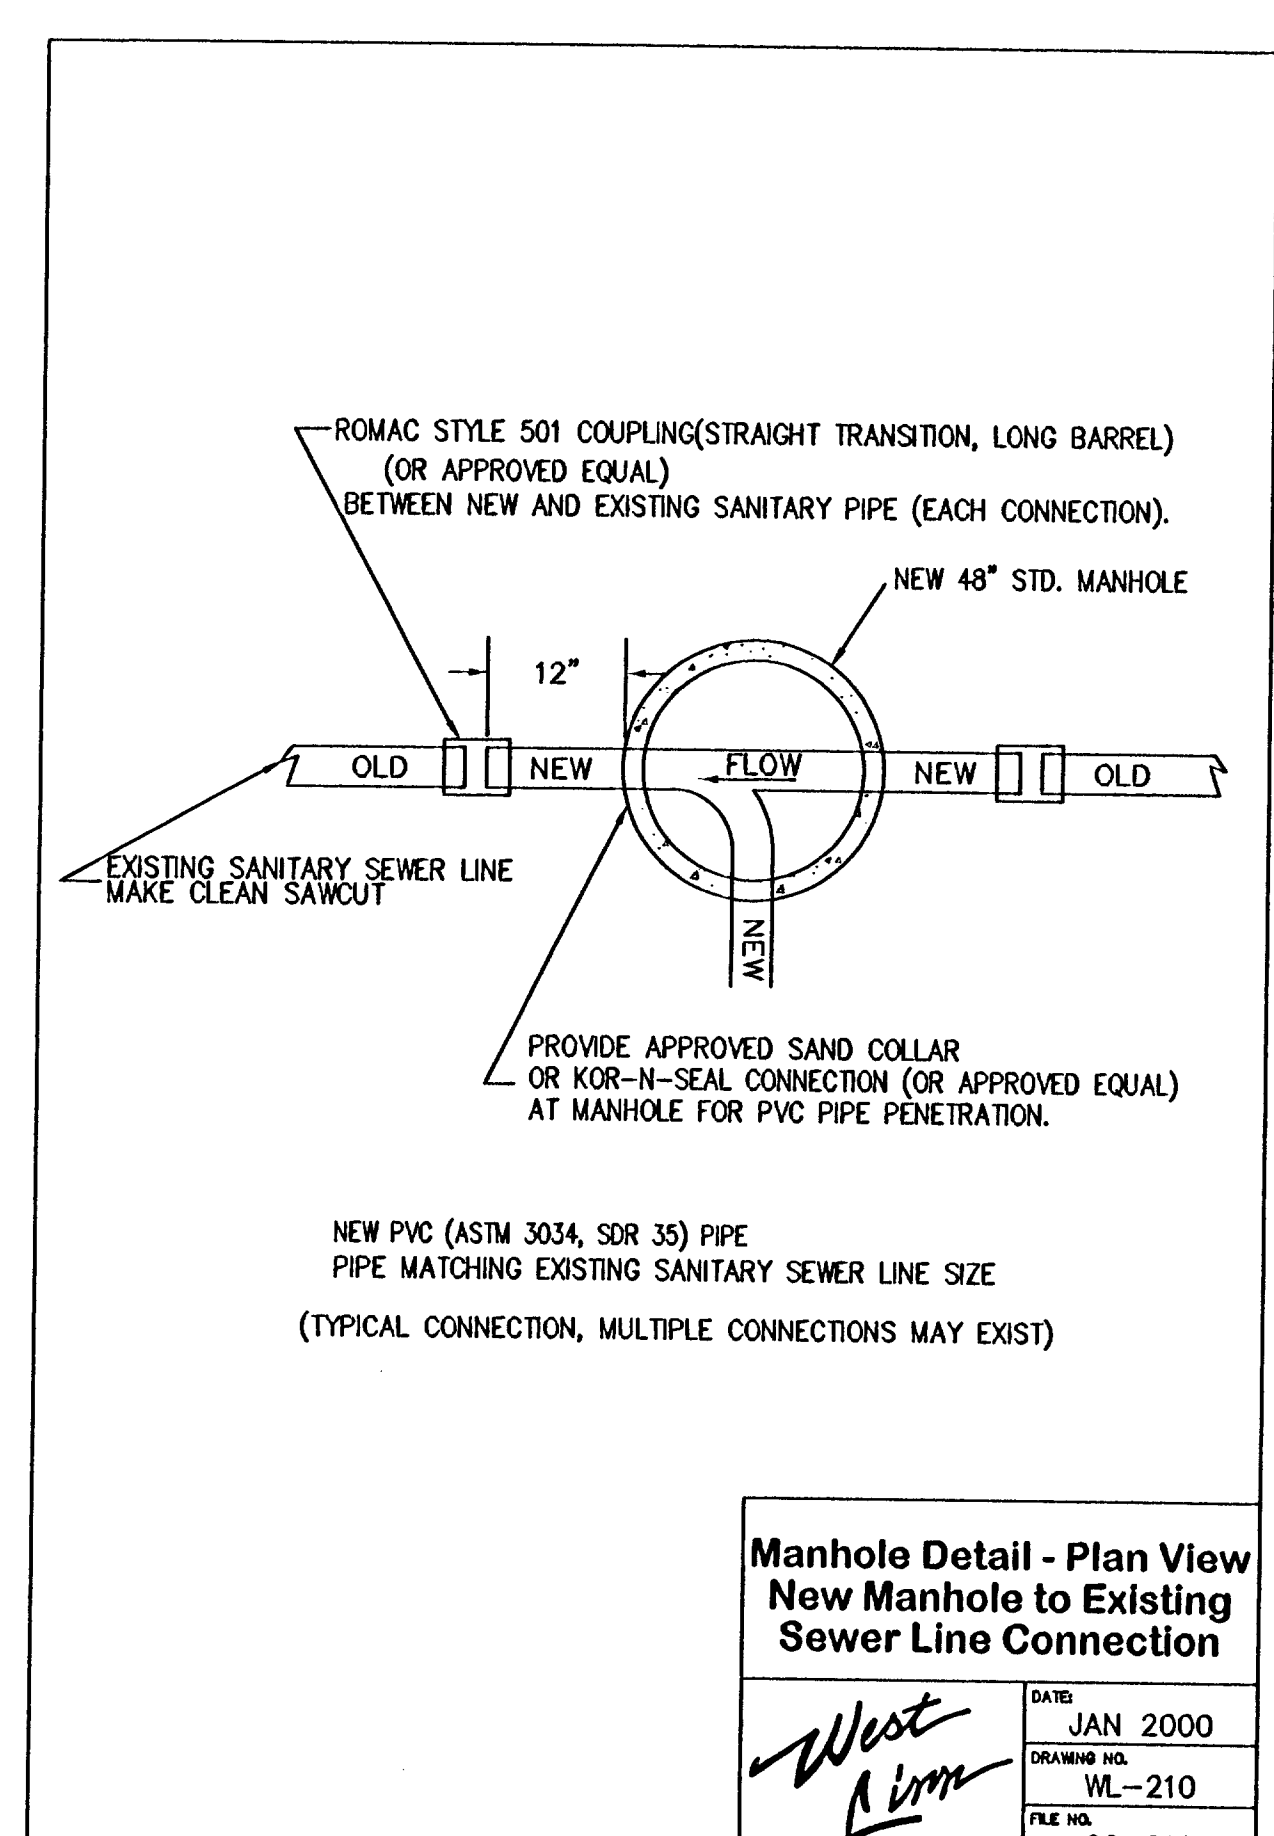

Manhole Detail - Plan View New Manhole to Existing Sewer Line Connection

DATE:	JAN 2000
DRAWING NO.:	WL-210
FILE NO.:	00-210


NEW MANHOLE IN EXISTING LINE DETAIL
NOT TO SCALE

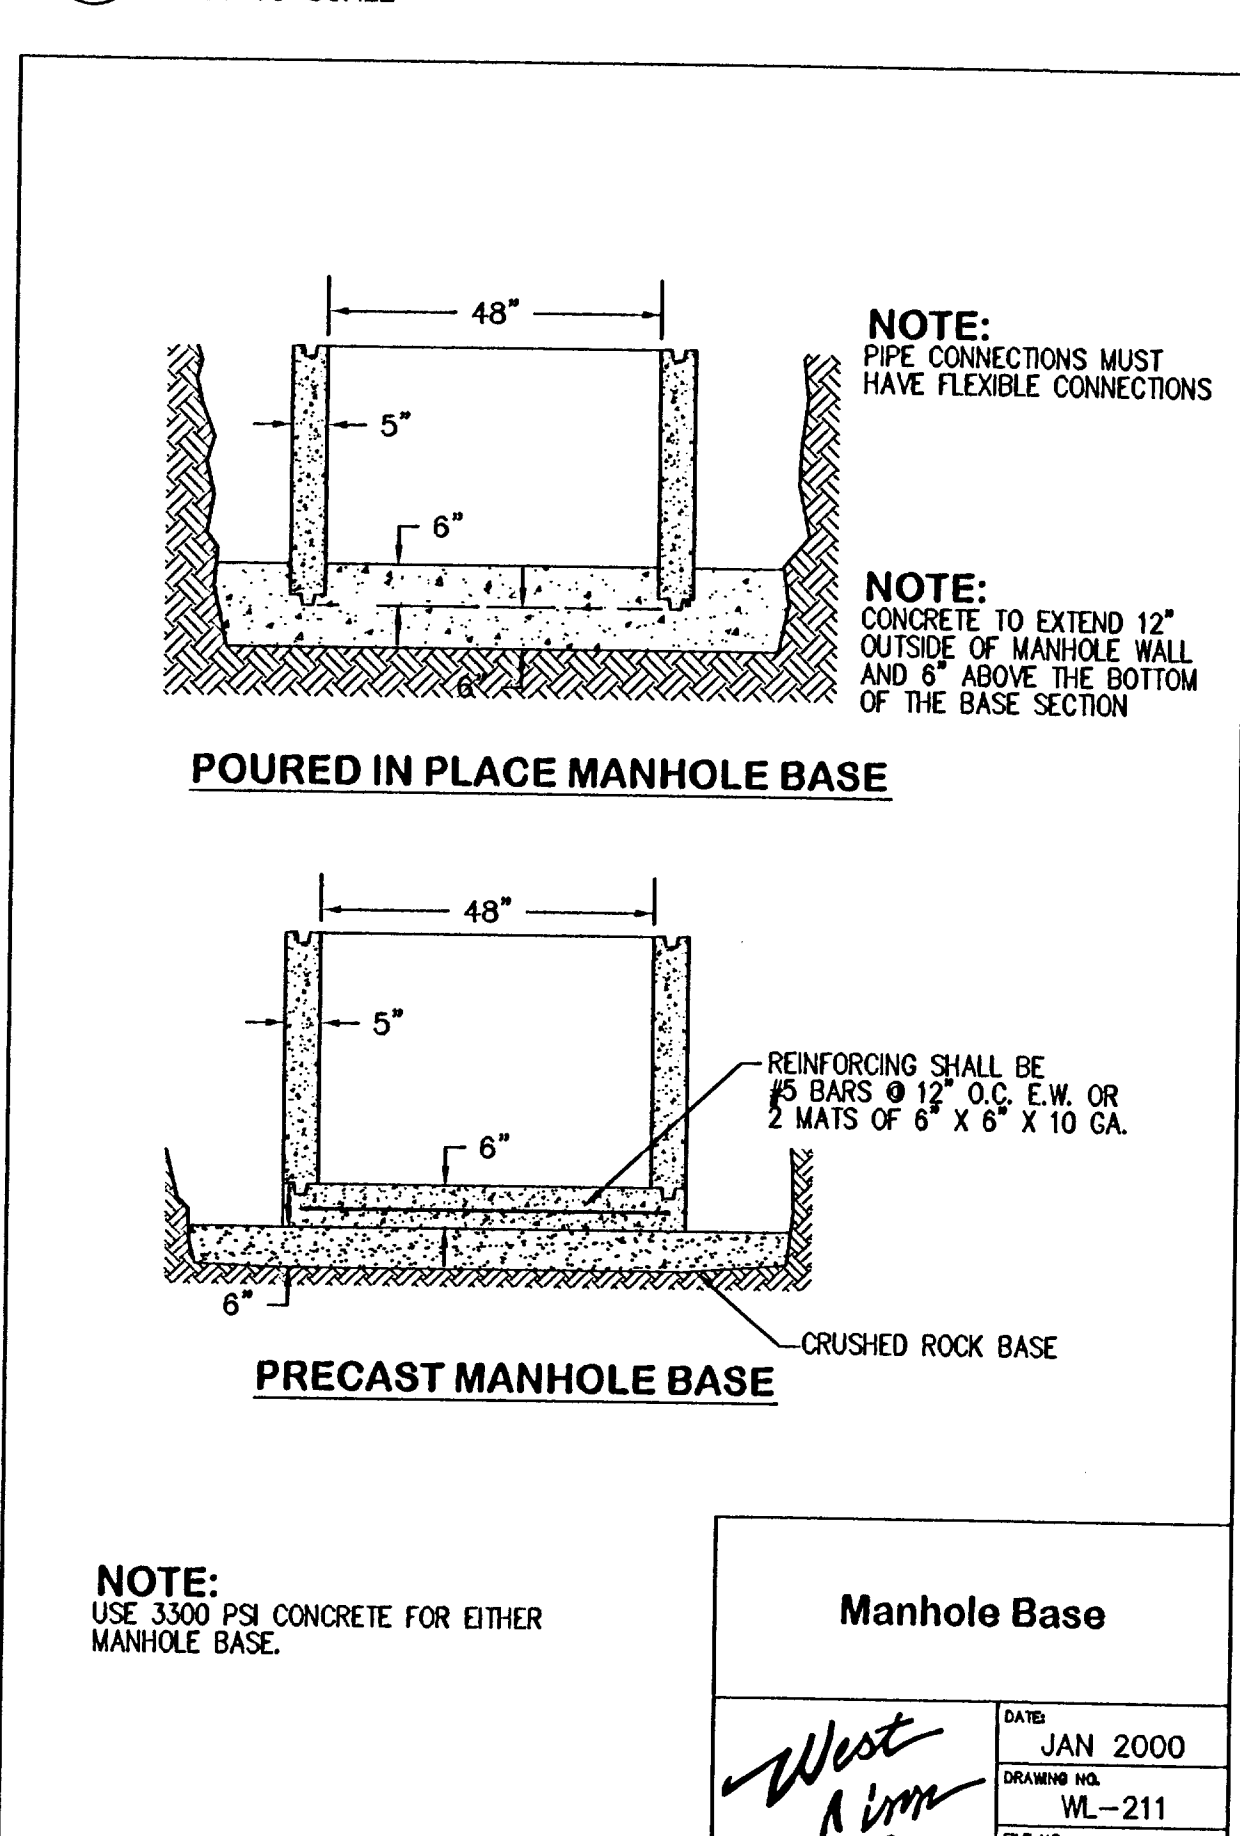

Manhole Base

DATE:	JAN 2000
DRAWING NO.:	WL-211
FILE NO.:	00-211

MANHOLE BASE DETAIL
NOT TO SCALE

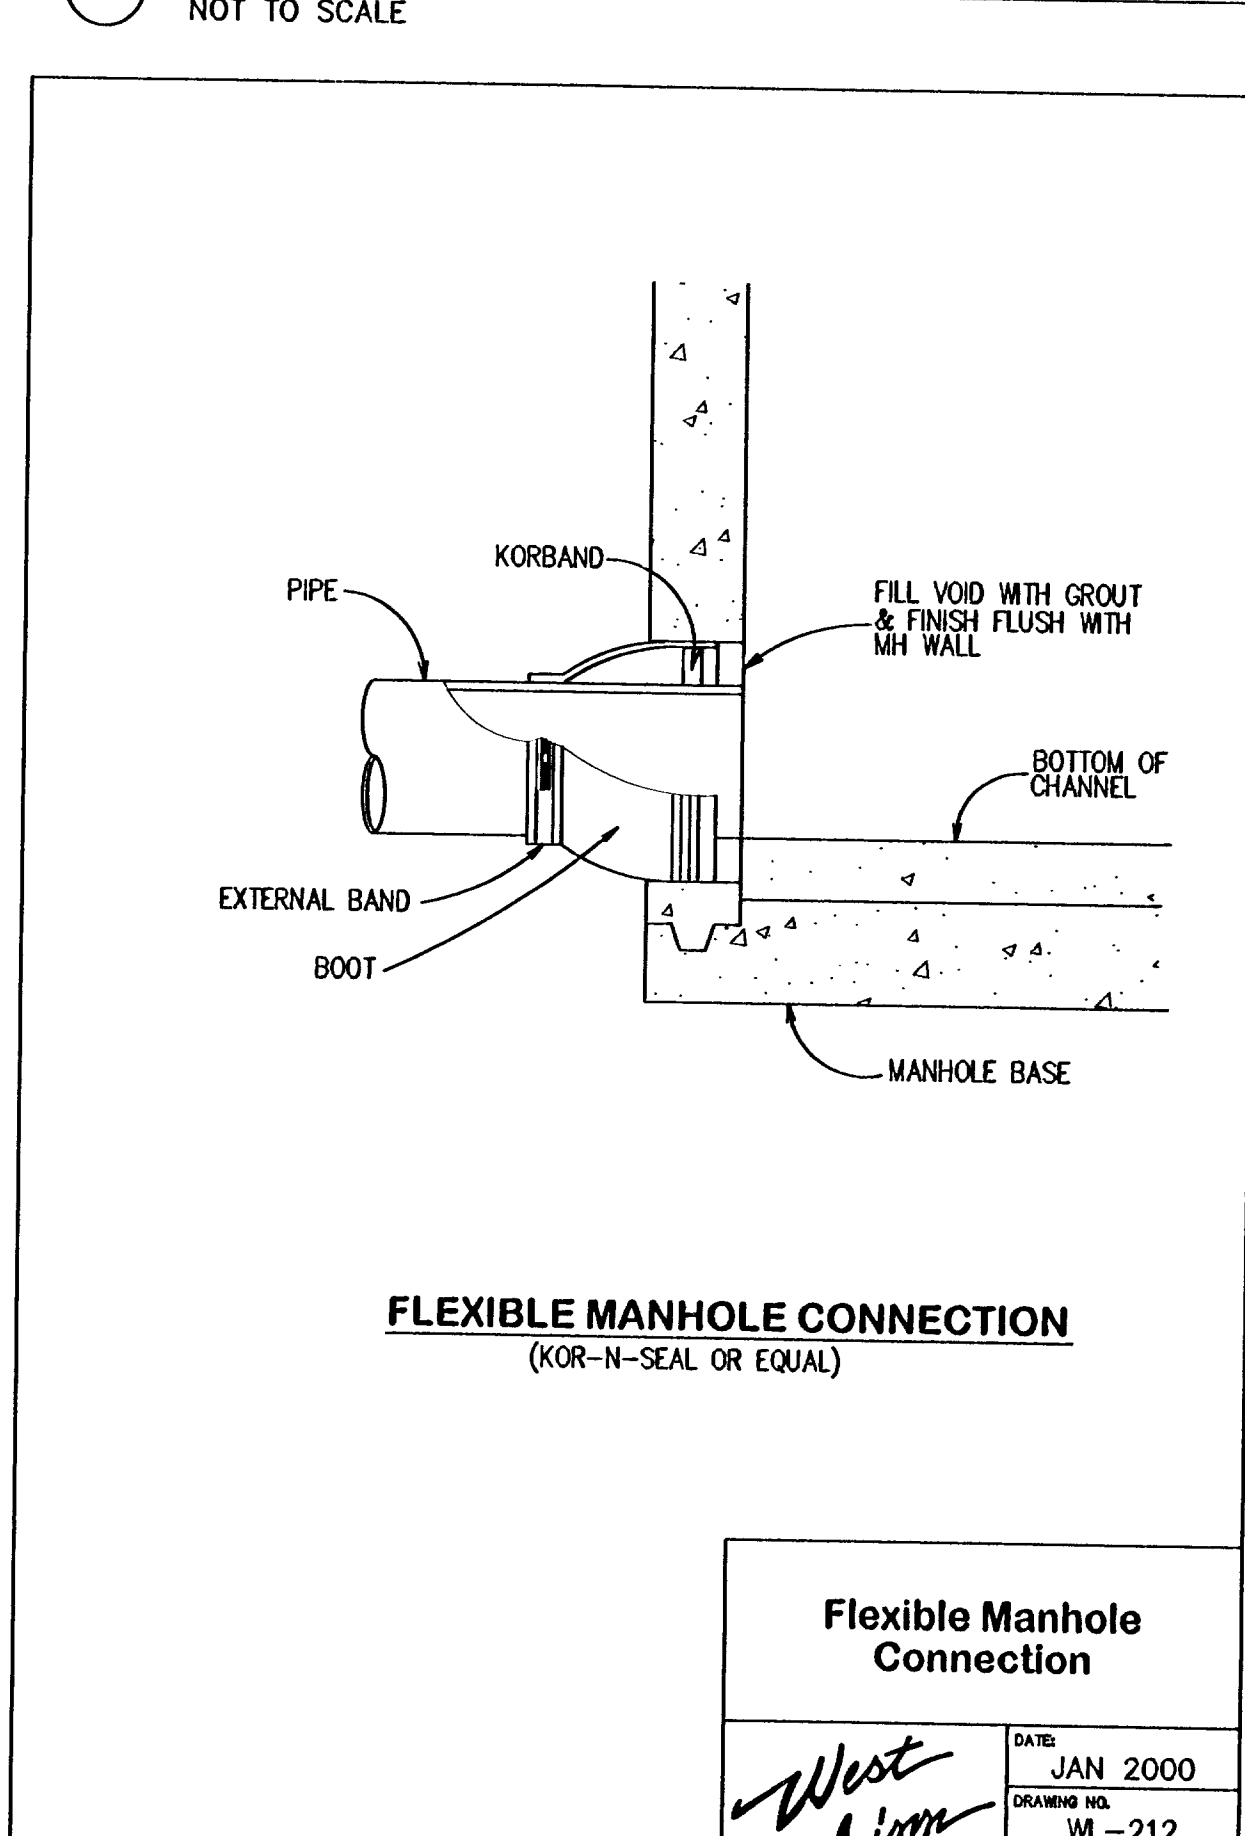

Flexible Manhole Connection

DATE:	JAN 2000
DRAWING NO.:	WL-212
FILE NO.:	00-212

FLEXIBLE MANHOLE CONNECTION DETAIL
NOT TO SCALE

WEST LINN CASEFILE SUB05-03 / ZC05-05 / VAR05-03

STANDARD DETAILS
SIENNA ESTATES
City of West Linn, Clackamas County, Oregon

SAM L PAP

2799 LANCASTER STREET
WEST LINN, OREGON 97068
(503) 888-2254

Civil Engineering
Development Consulting
Architecture
LANPACIFIC
5125 SW Meadham, Suite 140, Portland, Oregon 97239
(503) 238-2097 FAX: (503) 238-2447
www.lanpacific.com

1-23-08
REGISTERED PROFESSIONAL
ENGINEER
No. 060
JAN 10, 2008
J. SCOTT ELMERS
EXP. 12/31/09

RECORD DRAWING
1/18/08

THESE RECORD DRAWINGS HAVE BEEN PREPARED, IN PART, ON THE BASIS OF INFORMATION OBTAINED AND FURNISHED BY THE CONTRACTOR, REVISOR, CONSTRUCTION PLANS, AND FIELD OBSERVATIONS DURING CONSTRUCTION.


DATE | 1/18/08
DRAWN | JSE
DESIGNED | JSE
CHECKED | RGN
PROJECT # | SLP04-001

SHEET TITLE
STANDARD DETAILS

SHEET NUMBER

C018

CONSTRUCTION DOCUMENTS

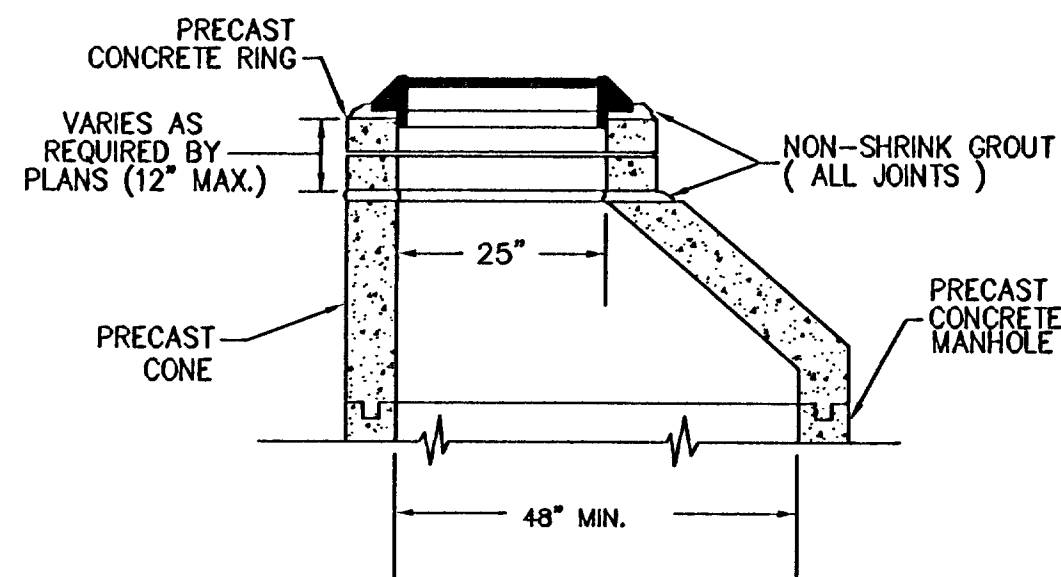


PRECAST RING EXTENSION
FOR TYPICAL MANHOLE

Precast Ring
Extension

DATE	JAN 2000
DRAWING NO.	WL-213
FILE NO.	00-213

PRECAST RING EXTENSION DETAIL
NOT TO SCALE

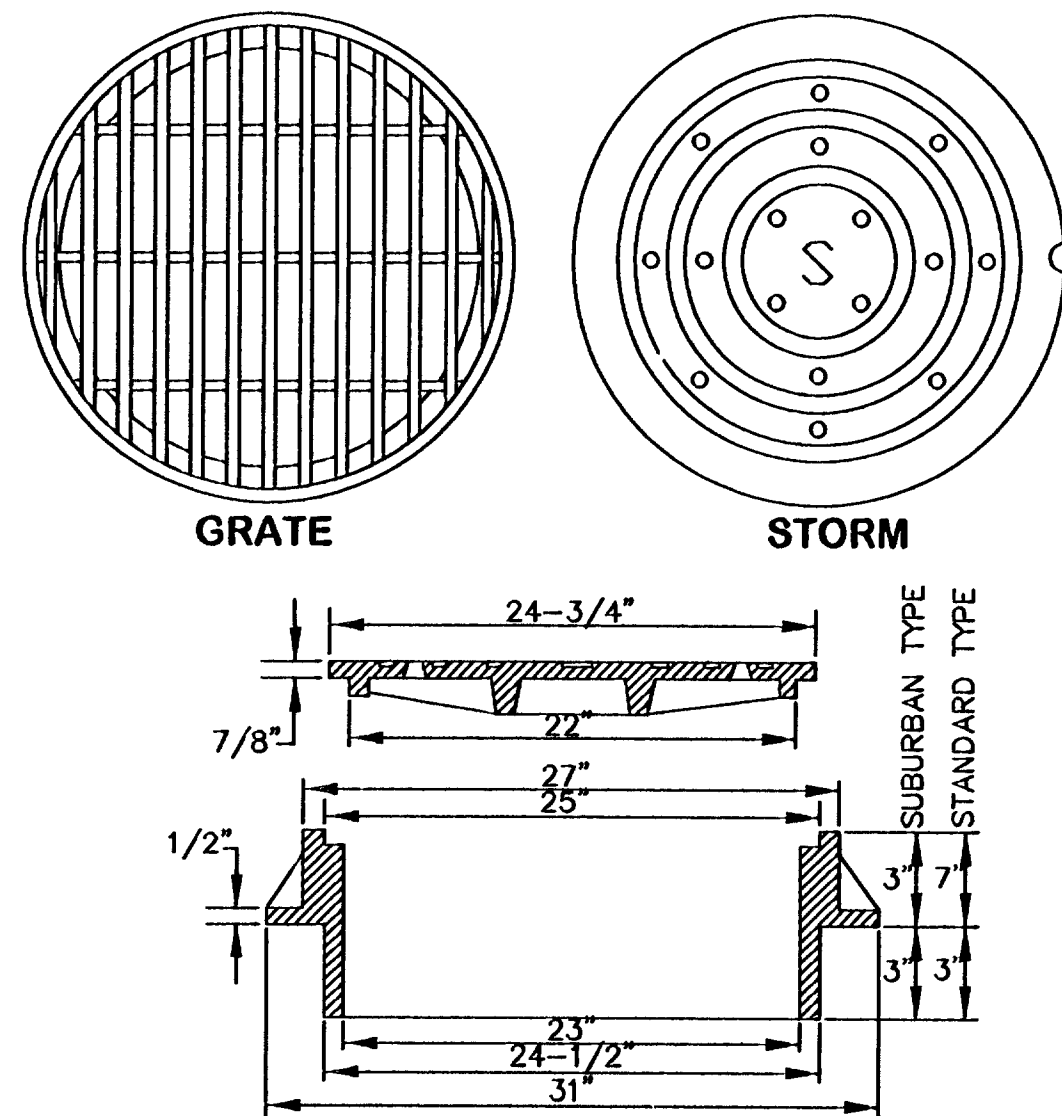

NOTES:


1. USE SUBURBAN TYPE ONLY IN NON-TRAFFIC AREAS, AND ONLY WITH APPROVAL BY THE CITY.
2. COVER AND FRAME SHALL BE GRAY CAST IRON ASTM A-48 CLASS 30.
3. COVER AND FRAME TO BE MACHINED TO A TRUE BEARING ALL AROUND.
4. NOTCH LID FOR LIFTING HOOK.
5. OPEN GRATES REQUIRE APPROVAL BY CITY, AND MUST BE BICYCLE SAFE IF USED IN TRAFFIC AREAS.

SUBURBAN AND STANDARD
MANHOLE FRAME AND COVER

Manhole Covers

DATE	JAN 2000
DRAWING NO.	WL-605
FILE NO.	00-605


MANHOLE COVERS DETAIL
NOT TO SCALE

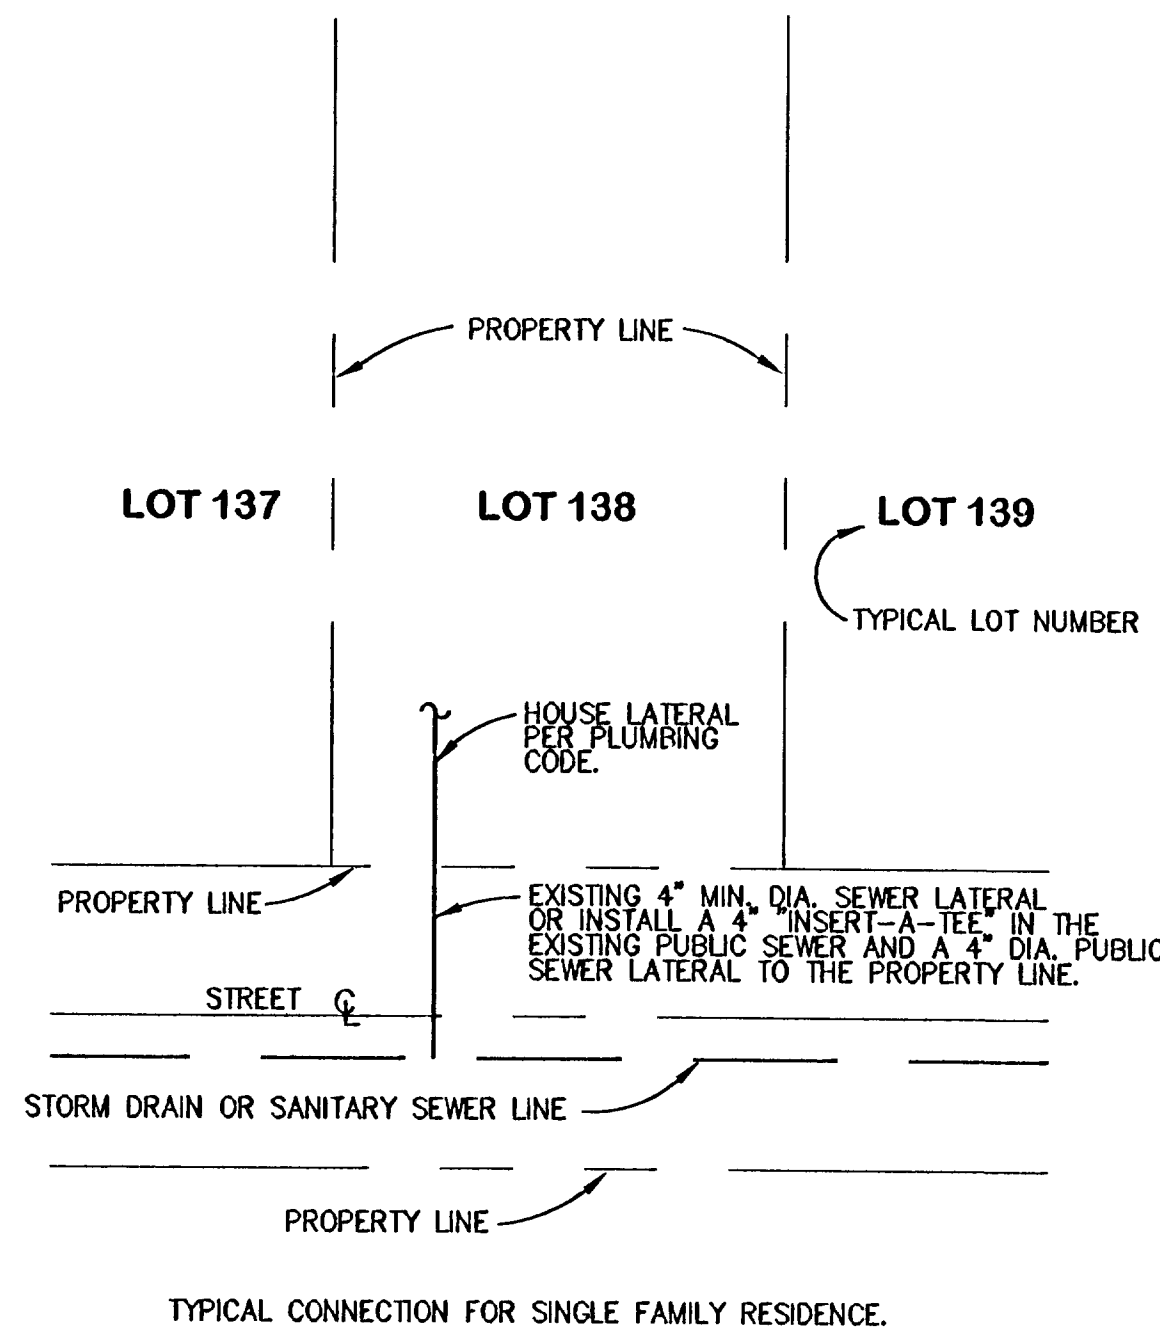

Sewer Connection
Single Family

DATE	JAN 2000
DRAWING NO.	WL-216
FILE NO.	00-216

SEWER CONNECTION DETAIL
NOT TO SCALE

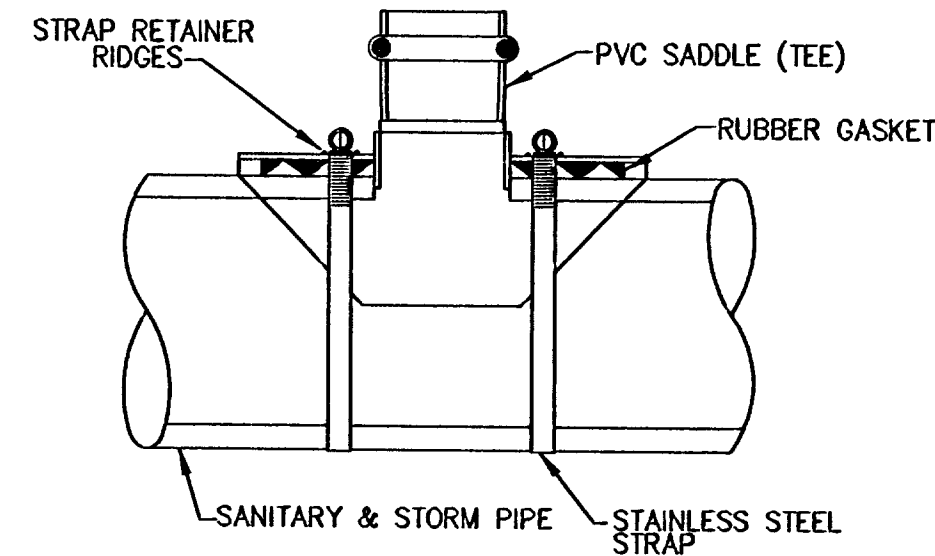


- * PVC SADDLE SHALL BE ASTM 3034 SDR35
- * PVC COMPOUNDS SHALL BE ASTM D1784 WITH CELL CLASS OF 12454-B/C OR 12364-C
- * ALL ELASTOMERIC SEALS (RUBBER GASKETS) SHALL BE ASTM F477
- * STAINLESS STEEL BANDS SHALL BE 300 SERIES, FULL 9/16" WIDTH BAND, 5/16" SHOULDERED HEX HEAD, SLOTTED SCREW AND IS CADMIUM PLATED, CARBON STEEL.
- * INSERTION HOLE SHALL BE CORE DRILLED.

PVC Gasketed Saddle

DATE	JAN 2000
DRAWING NO.	WL-217
FILE NO.	00-217


PVC GASKETED SADDLE DETAIL
NOT TO SCALE

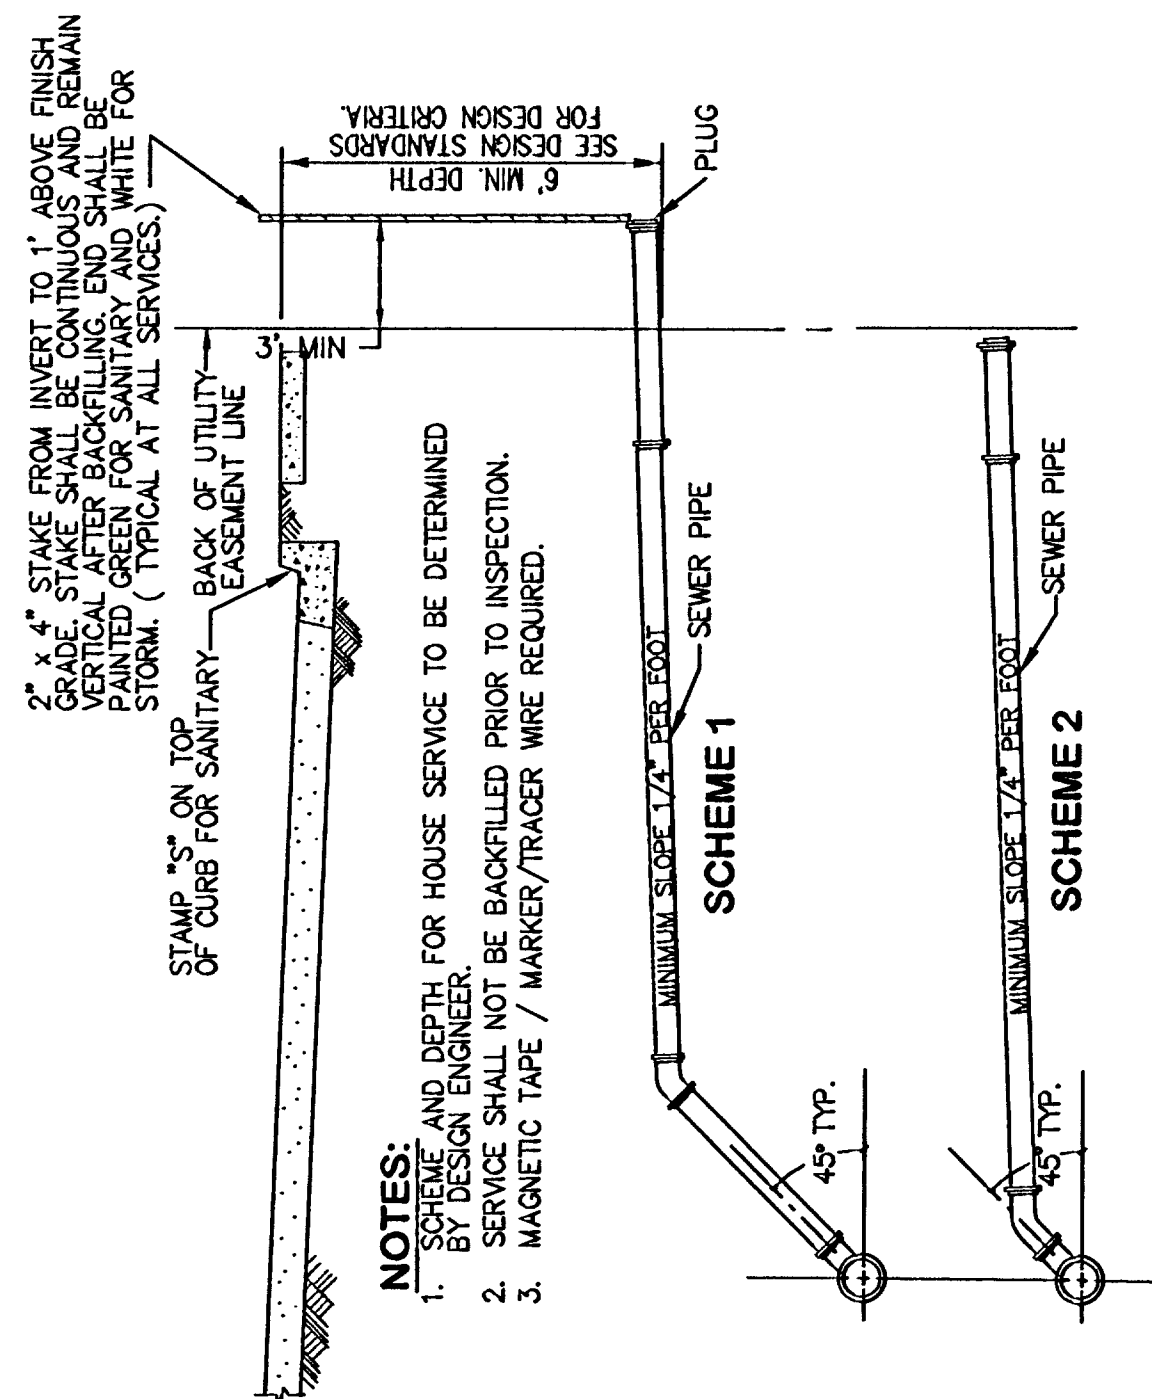

Service Branch

DATE	JAN 2000
DRAWING NO.	WL-218
FILE NO.	00-218


SERVICE BRANCH DETAIL
NOT TO SCALE

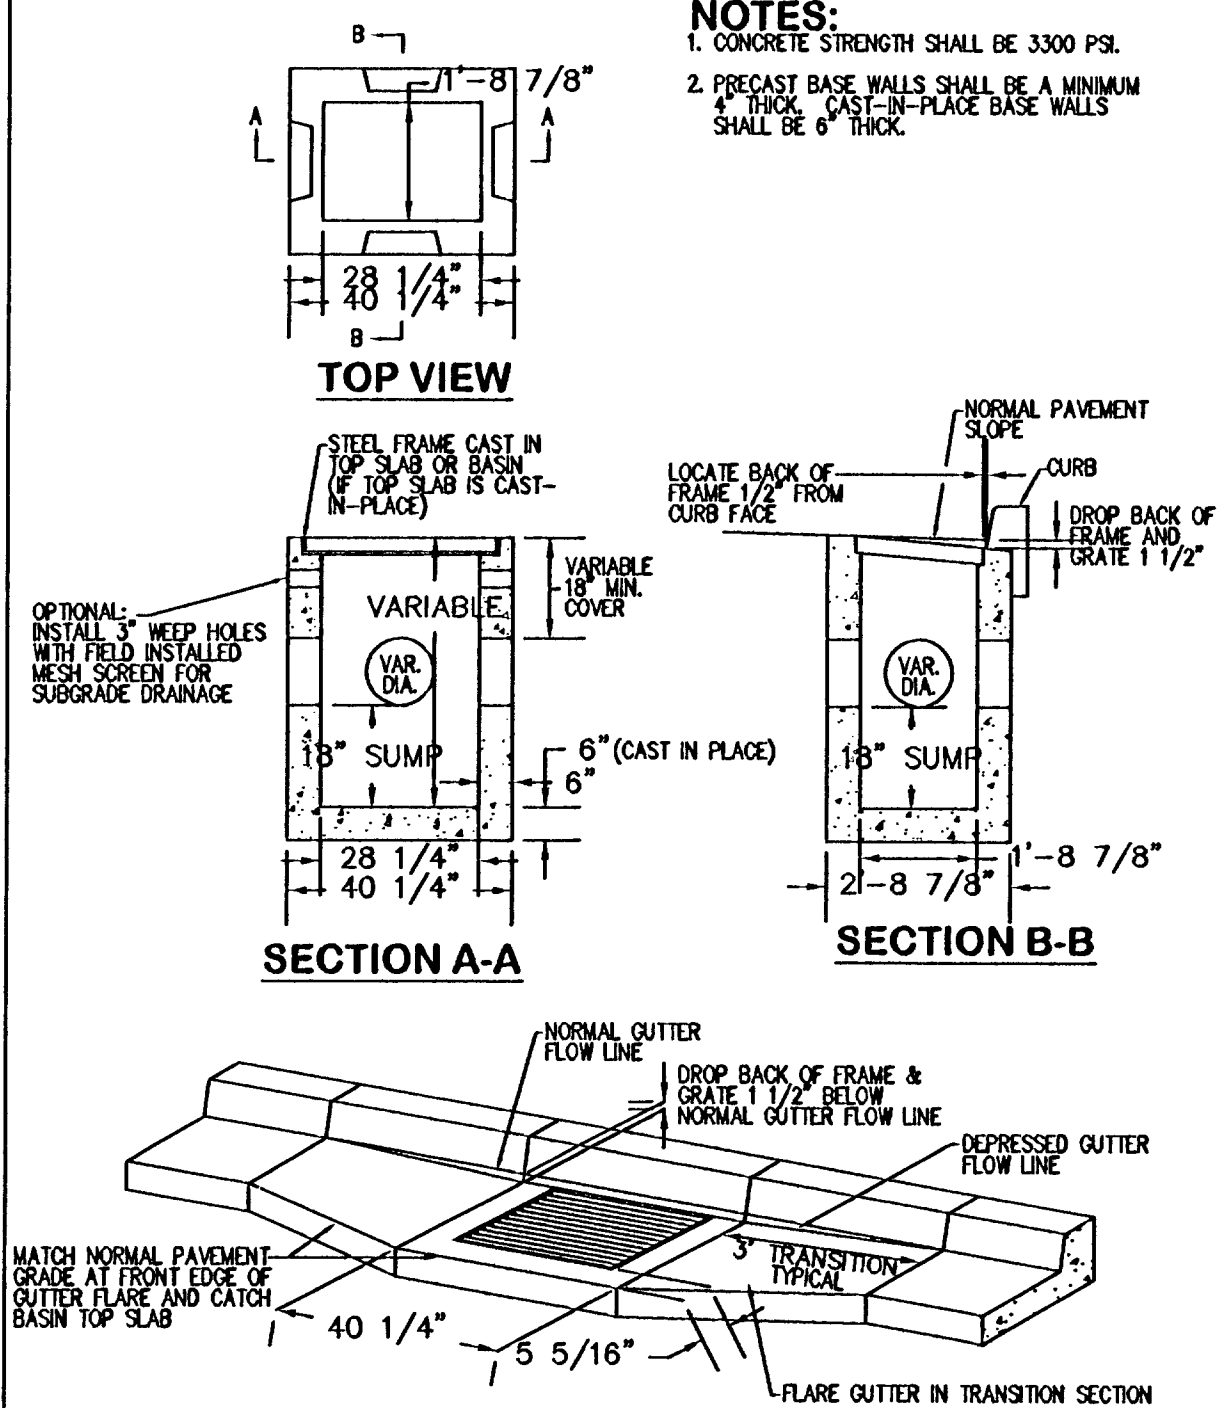

Type G-1 Catch Basin
with Sump

DATE	JAN 2000
DRAWING NO.	WL-602
FILE NO.	00-602


TYPE G-1 CATCH BASIN DETAIL
NOT TO SCALE

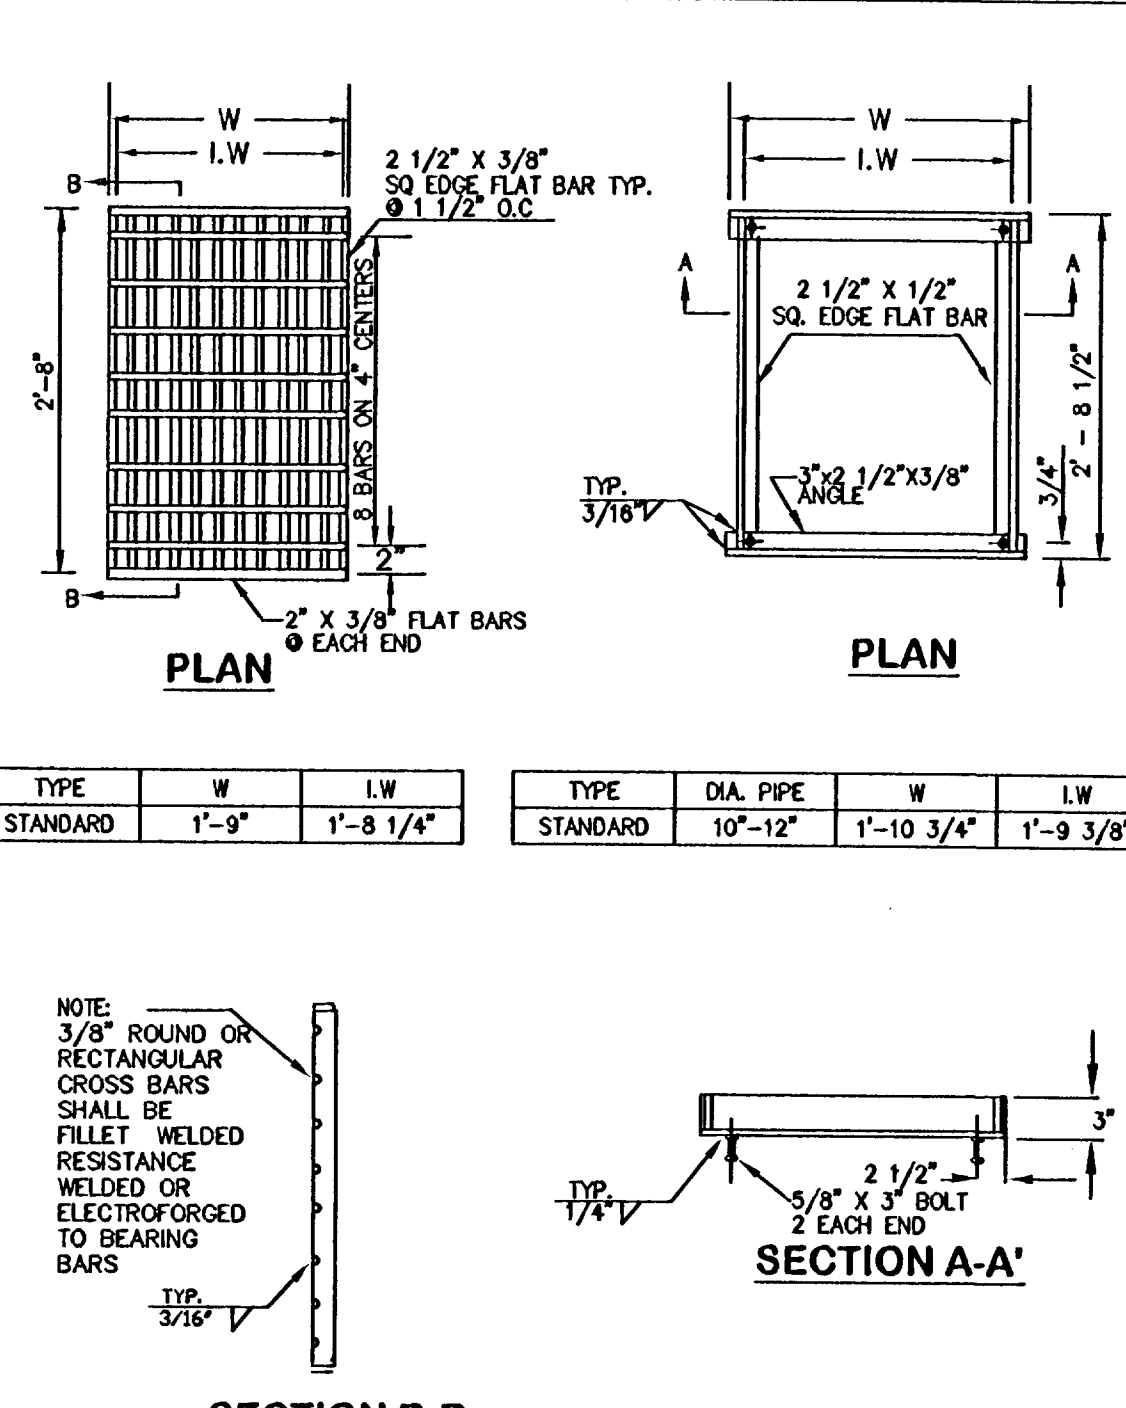

Frame and Grate
for Gutter & Curb Inlets

DATE	JAN 2000
DRAWING NO.	WL-602A
FILE NO.	00-602A


FRAME AND GRATE FOR CURB INLETS DETAIL
NOT TO SCALE

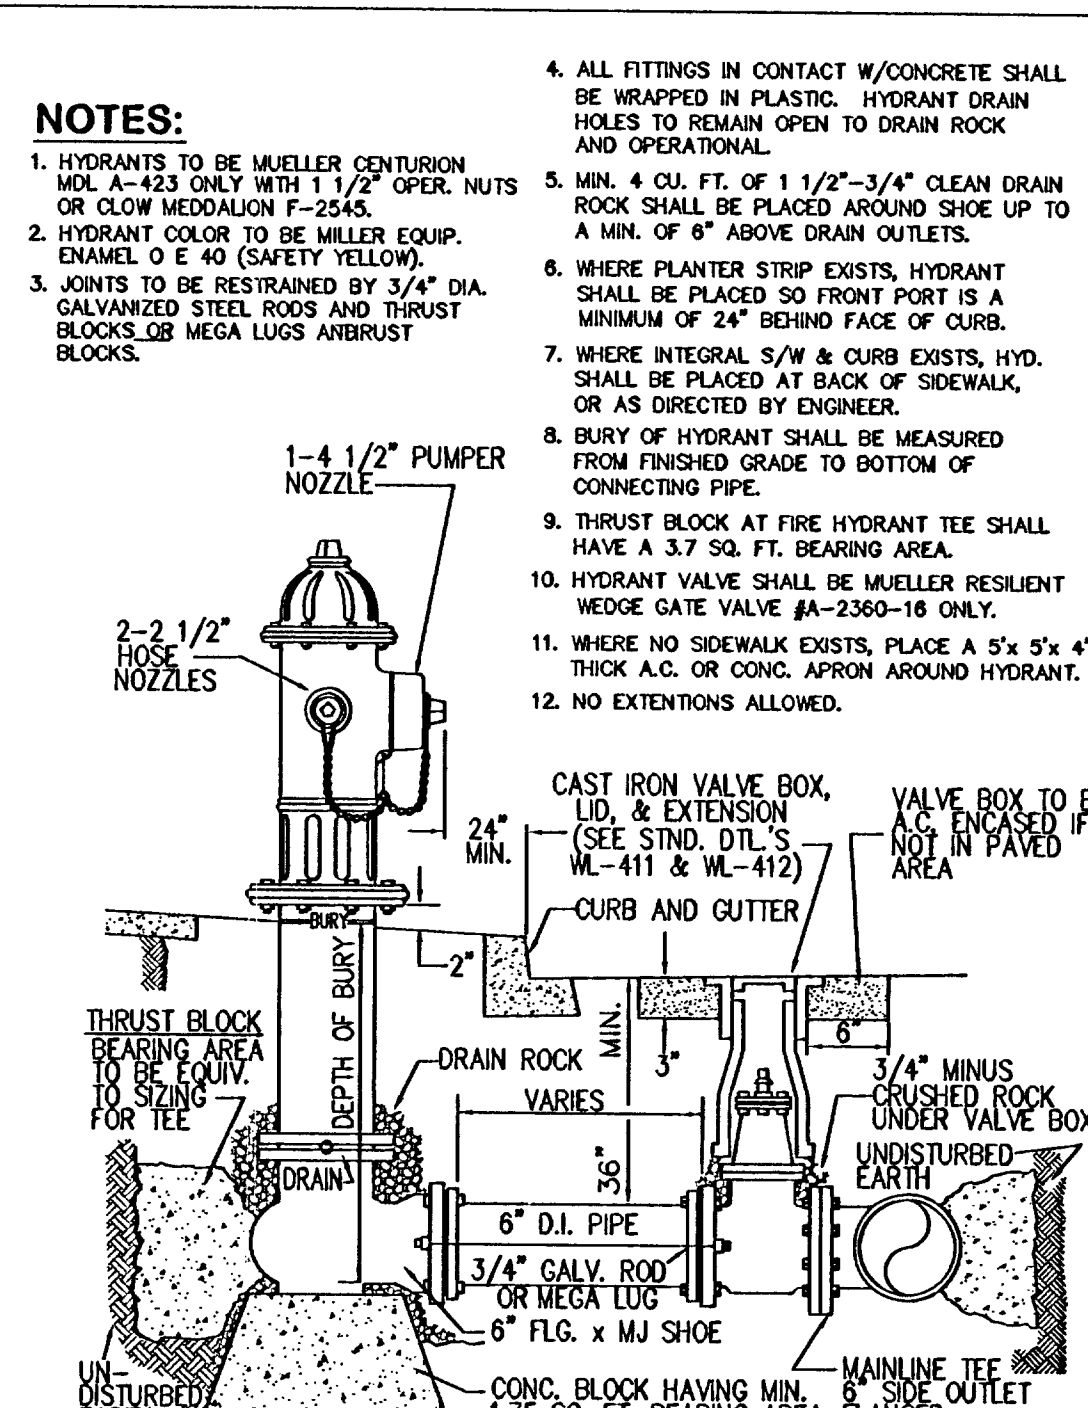


Standard Fire Hydrant
Assembly

DATE	JAN 2000
DRAWING NO.	WL-401
FILE NO.	00-401


STANDARD FIRE HYDRANT ASSEMBLY DETAIL
NOT TO SCALE

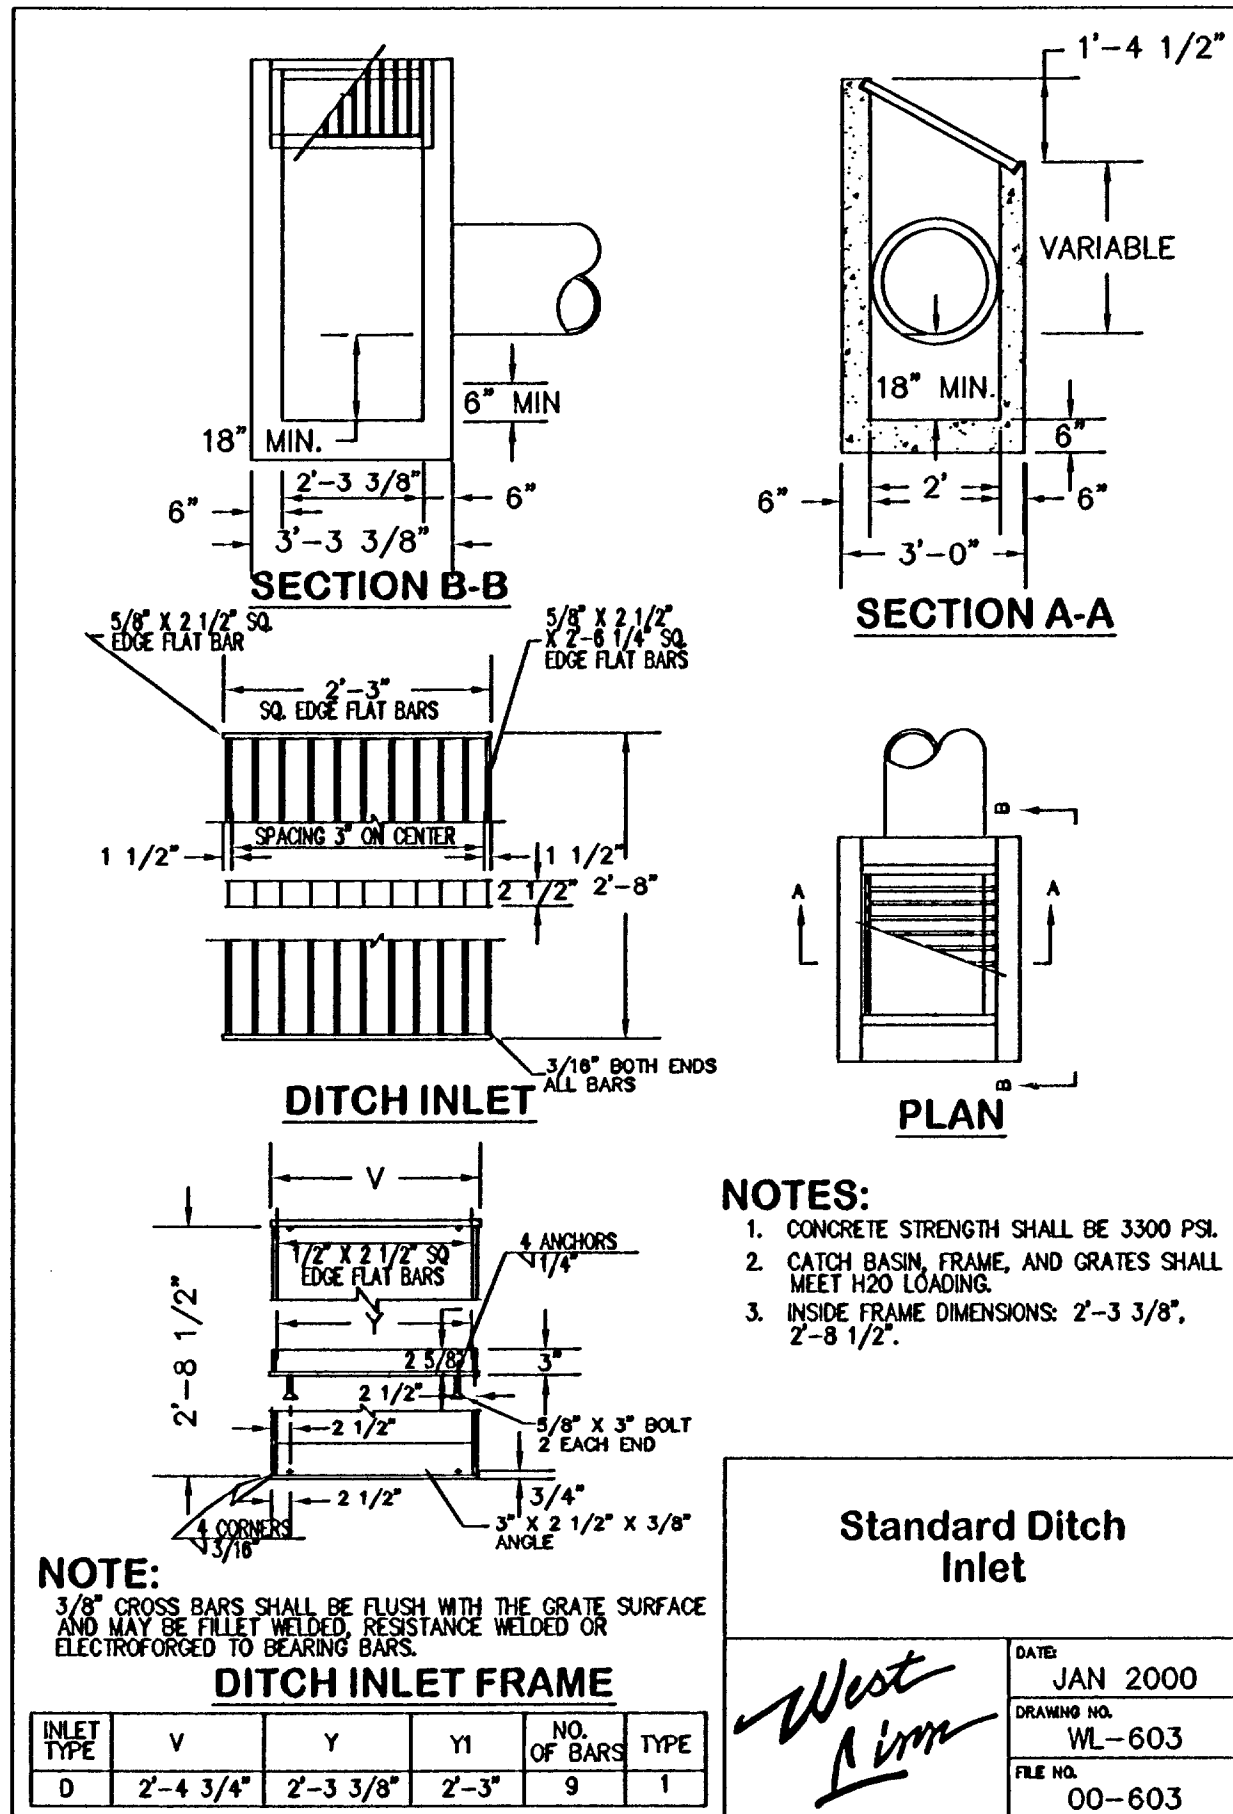


STANDARD DITCH INLET DETAIL
NOT TO SCALE

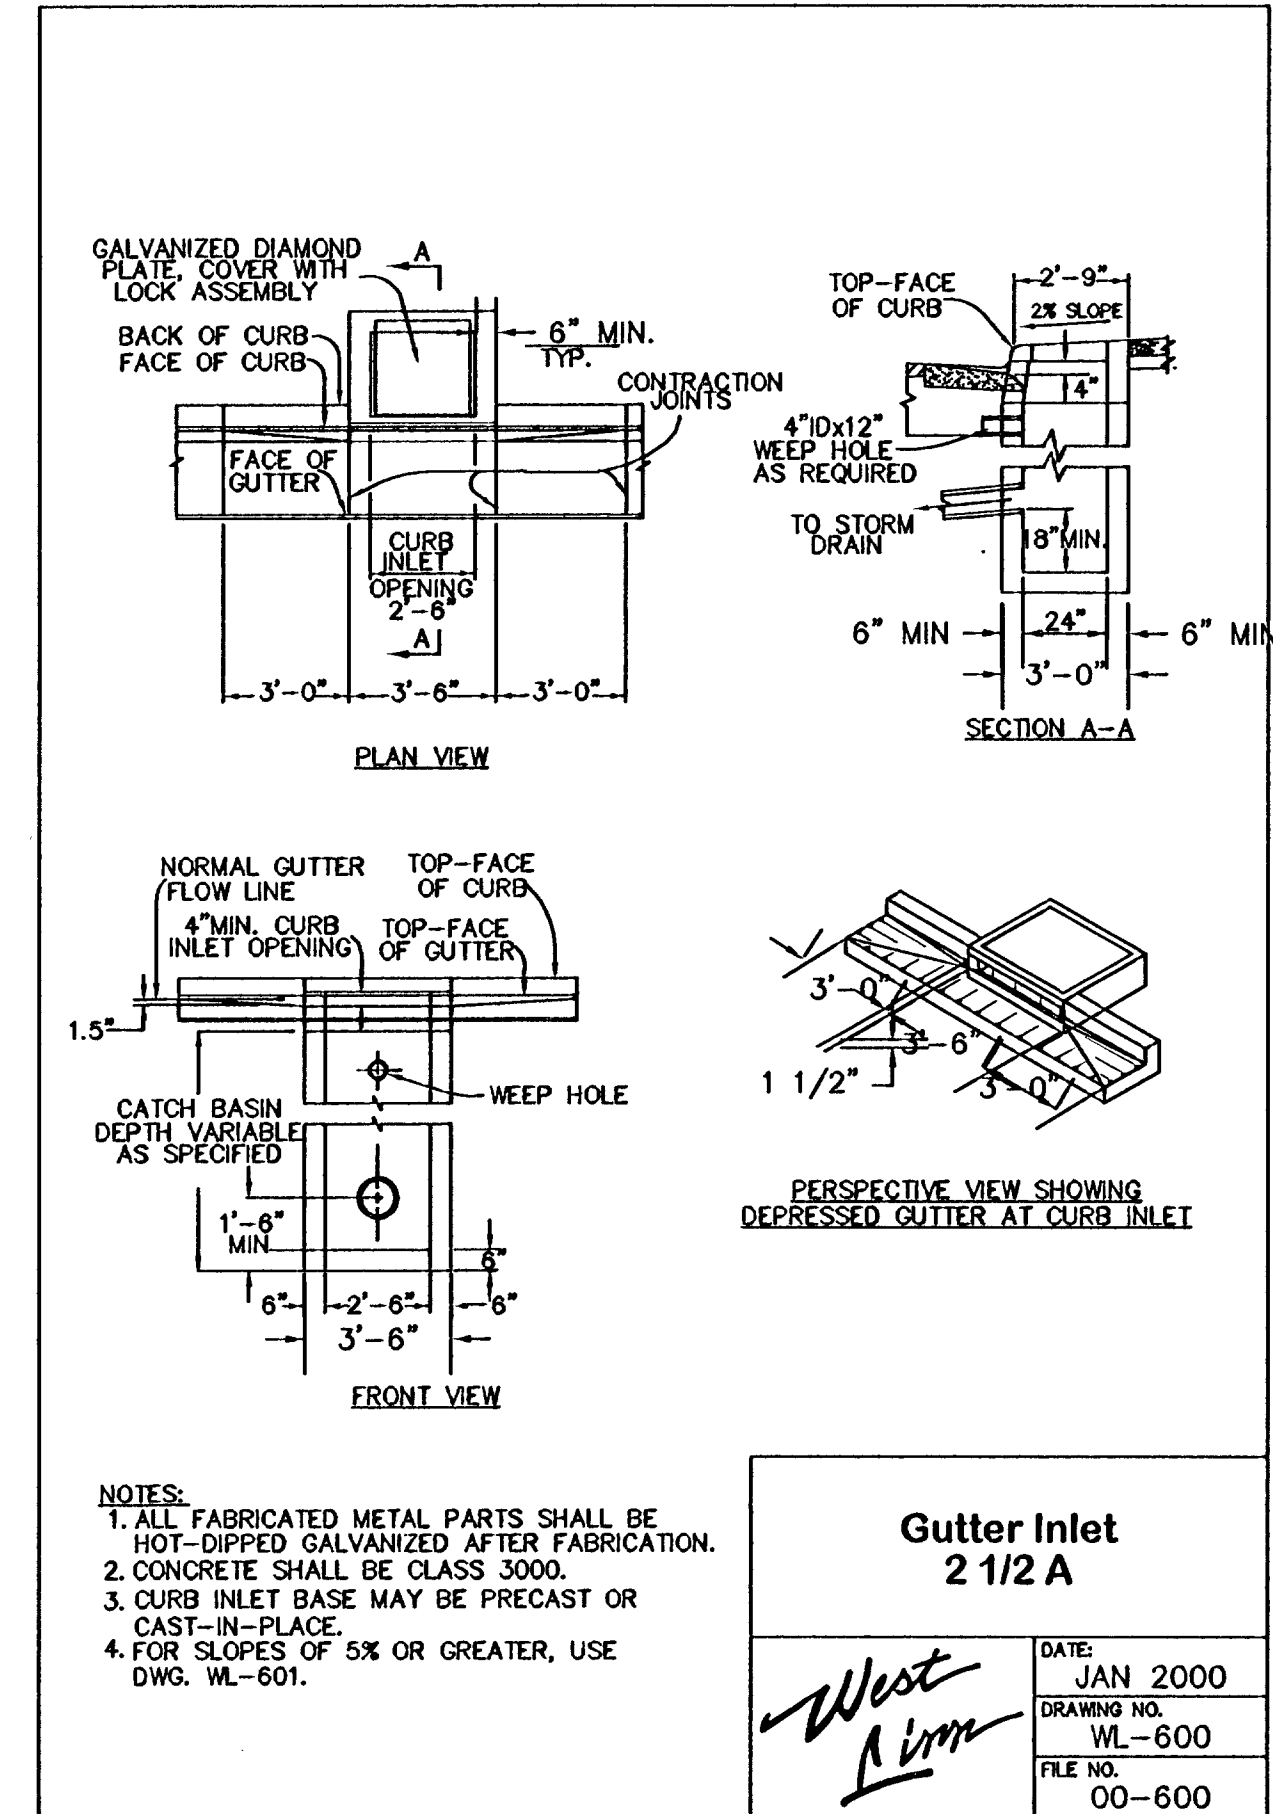


GUTTER INLET 2-1/2A DETAIL
NOT TO SCALE

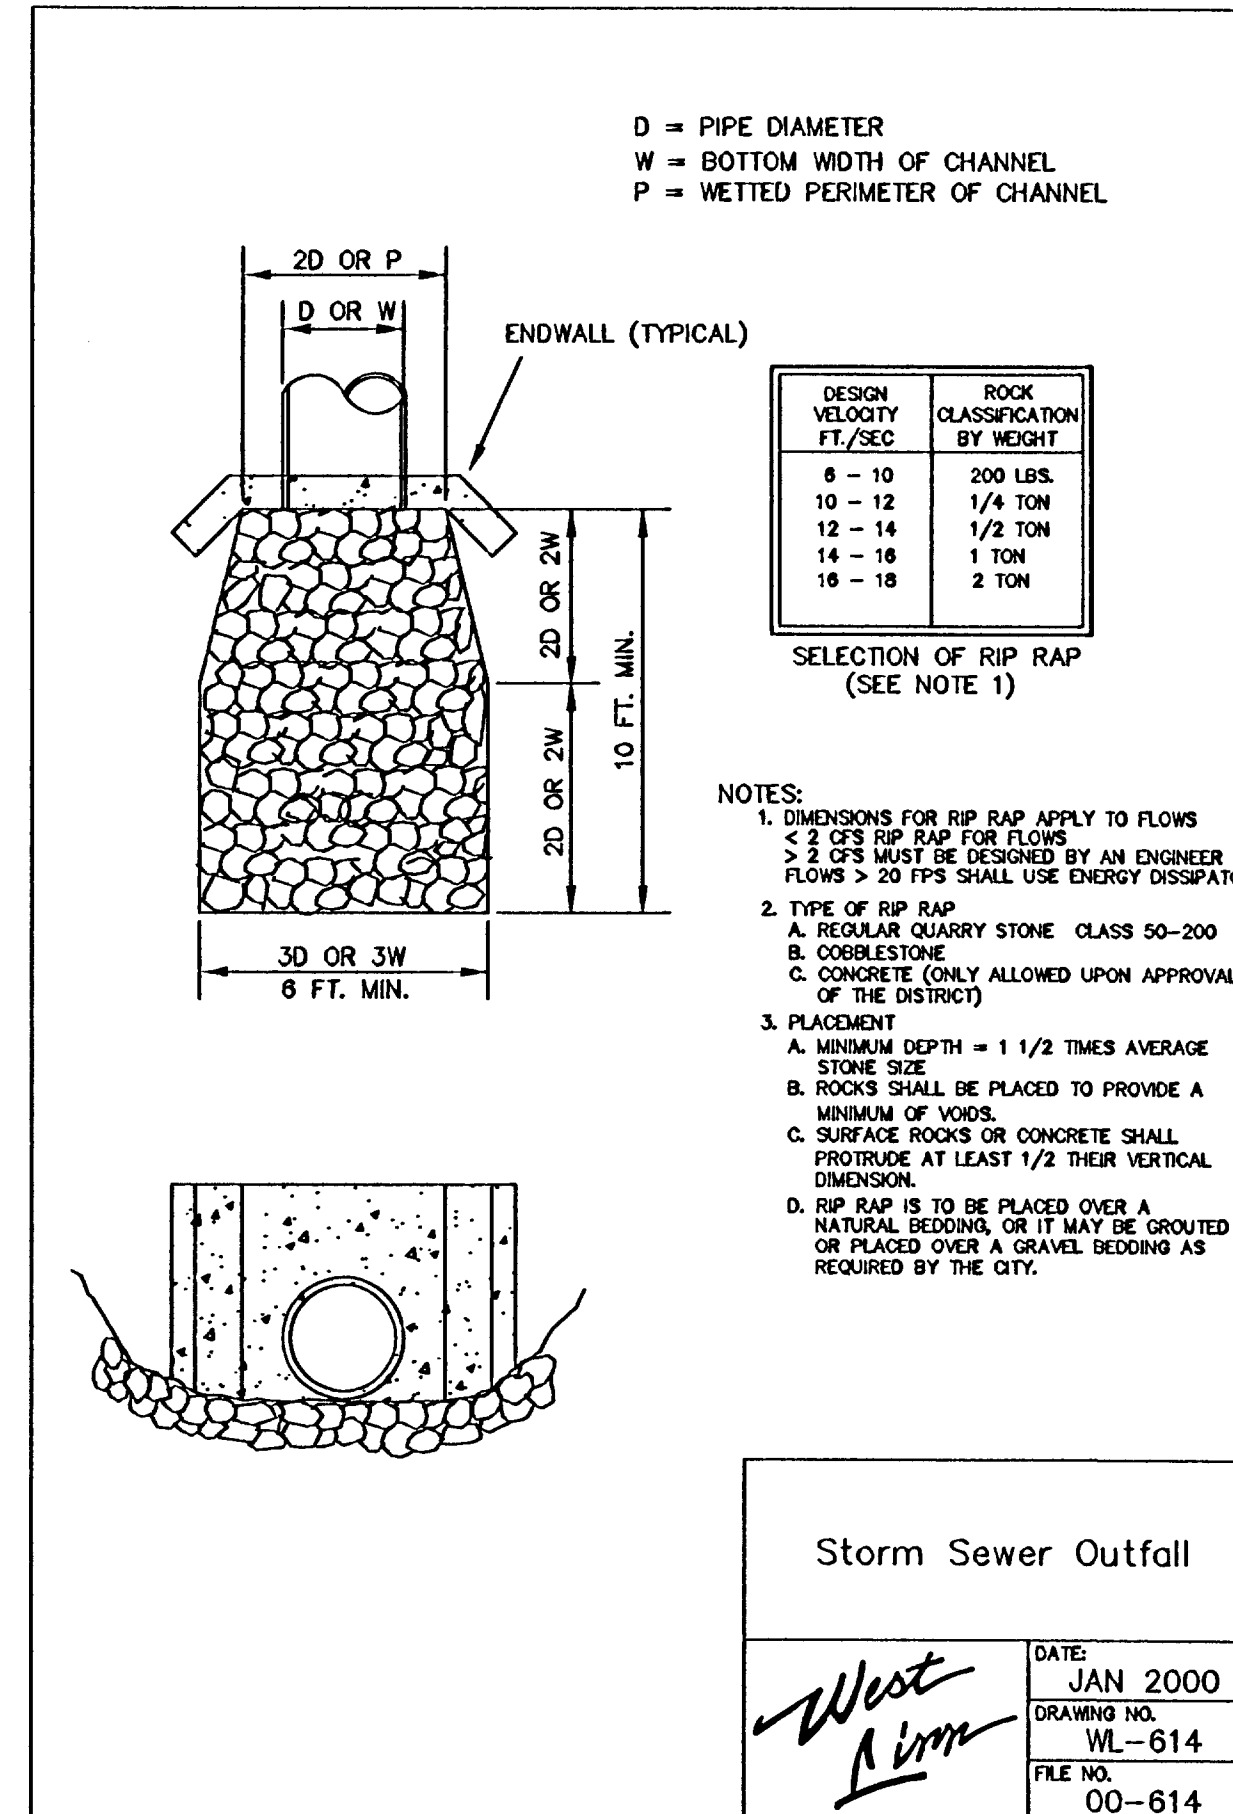


STORM OUTFALL
NOT TO SCALE

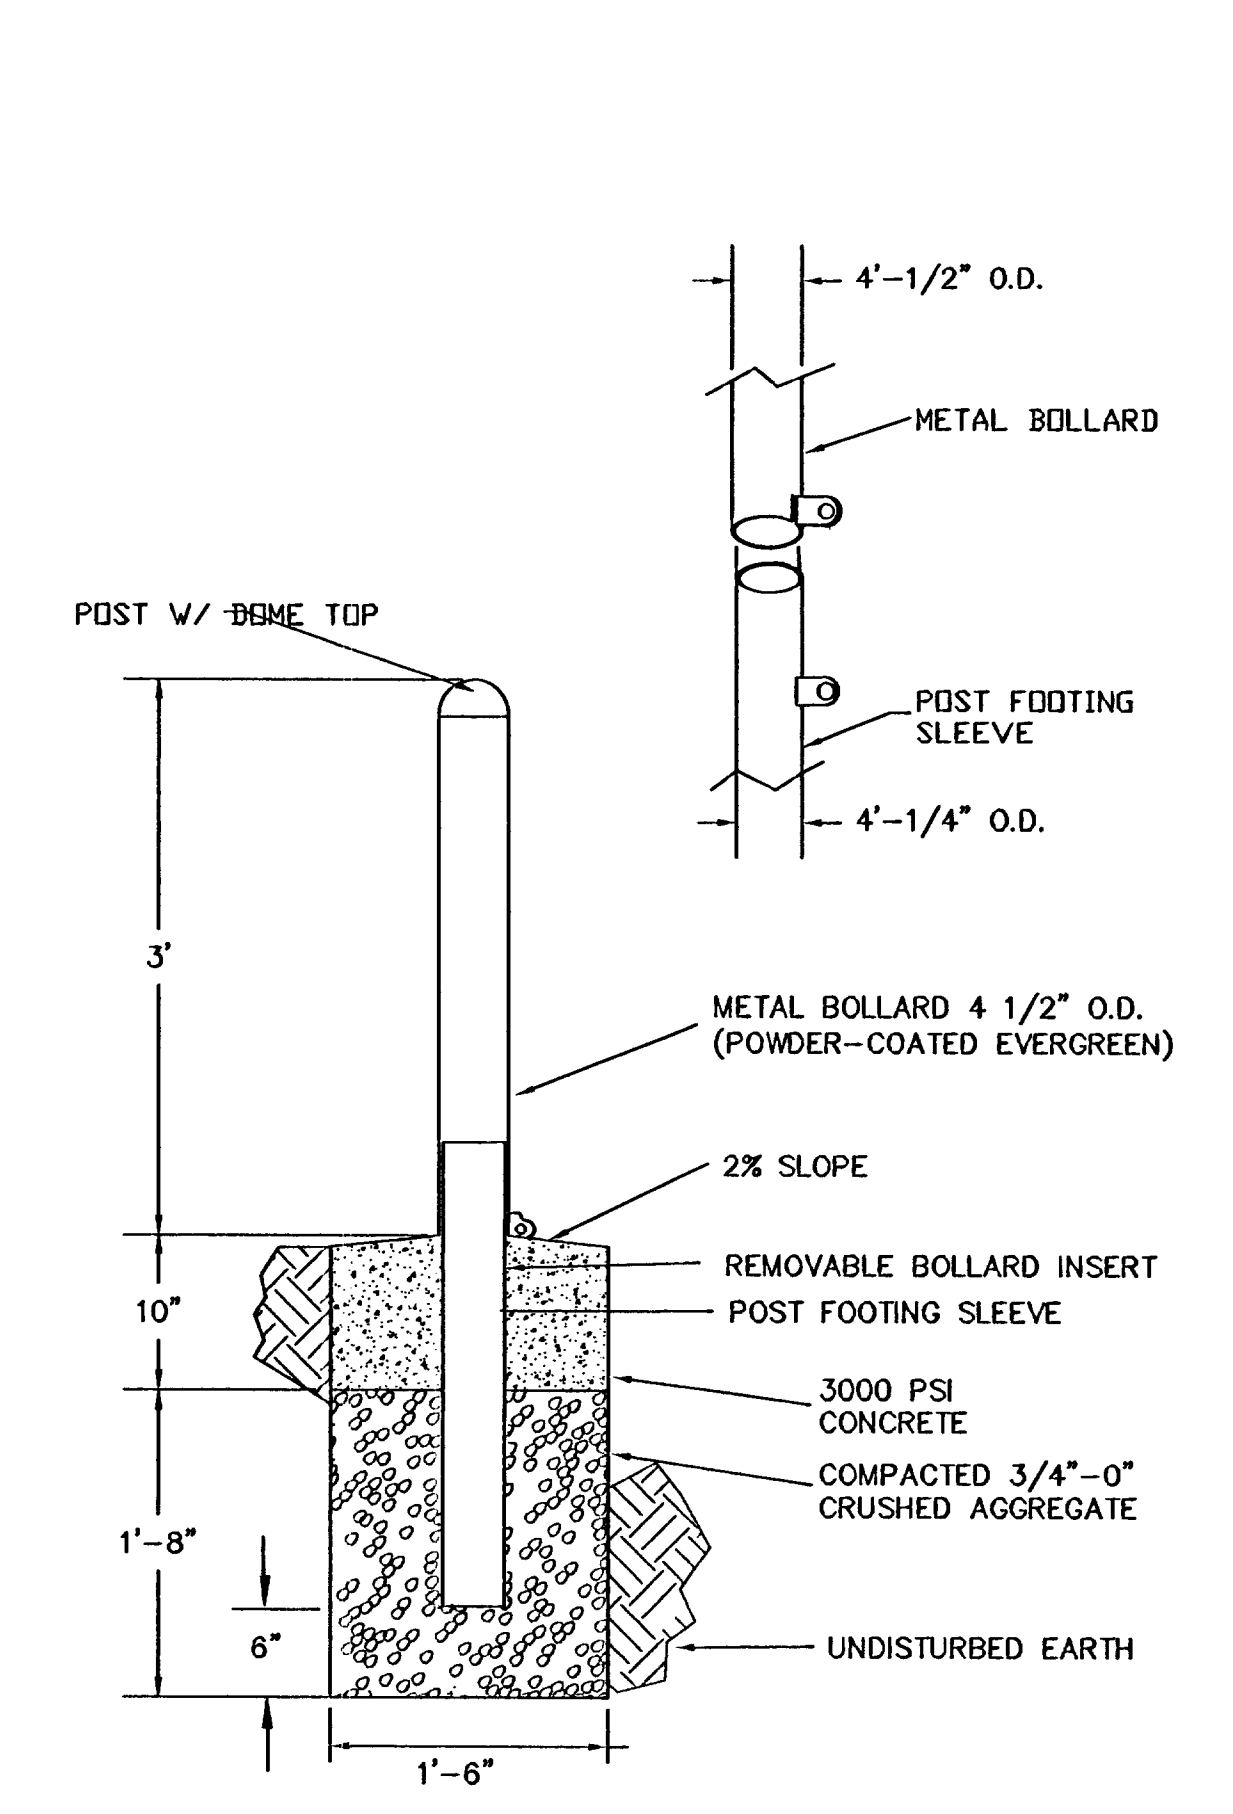


REMOVABLE BOLLARD
NOT TO SCALE

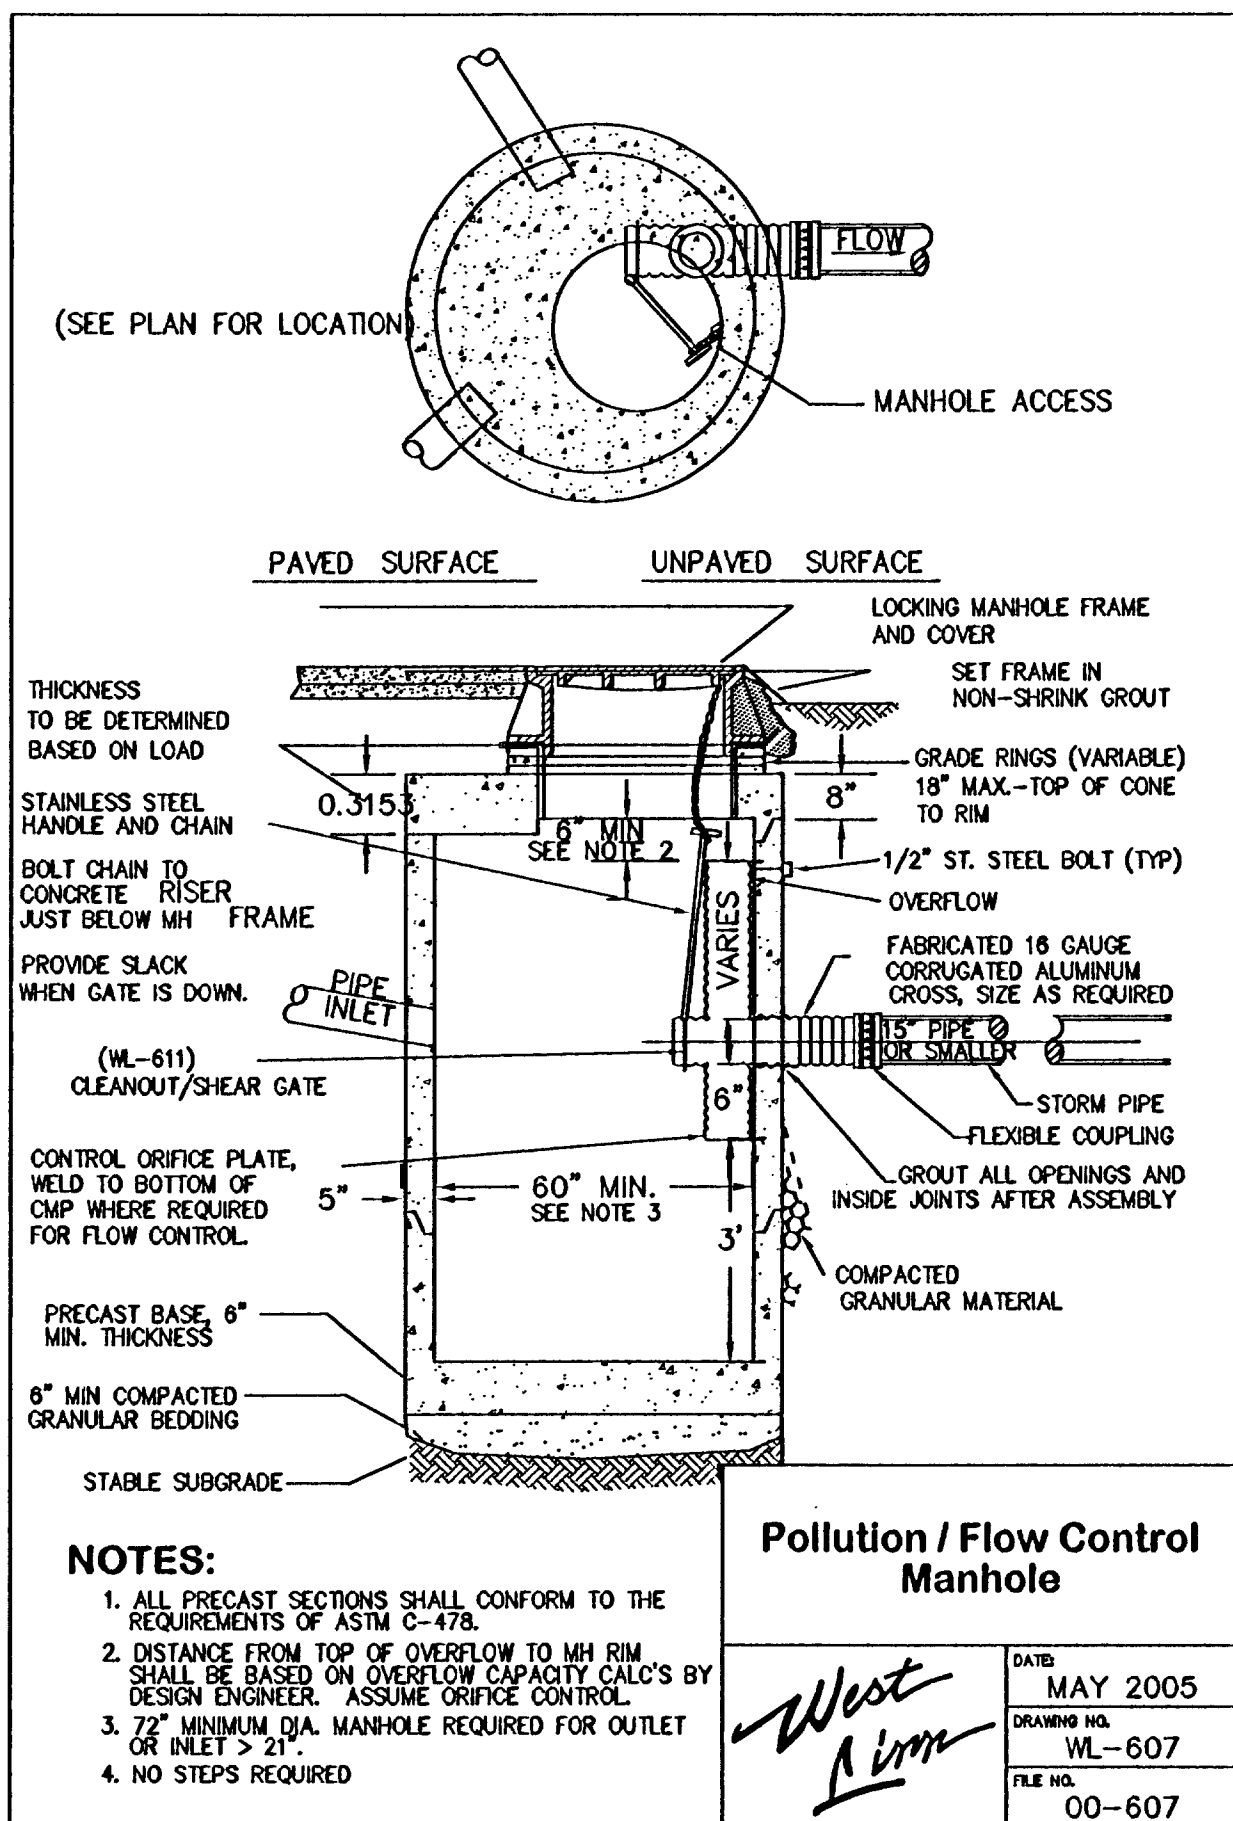


POLLUTION / FLOW CONTROL MANHOLE DETAIL
NOT TO SCALE

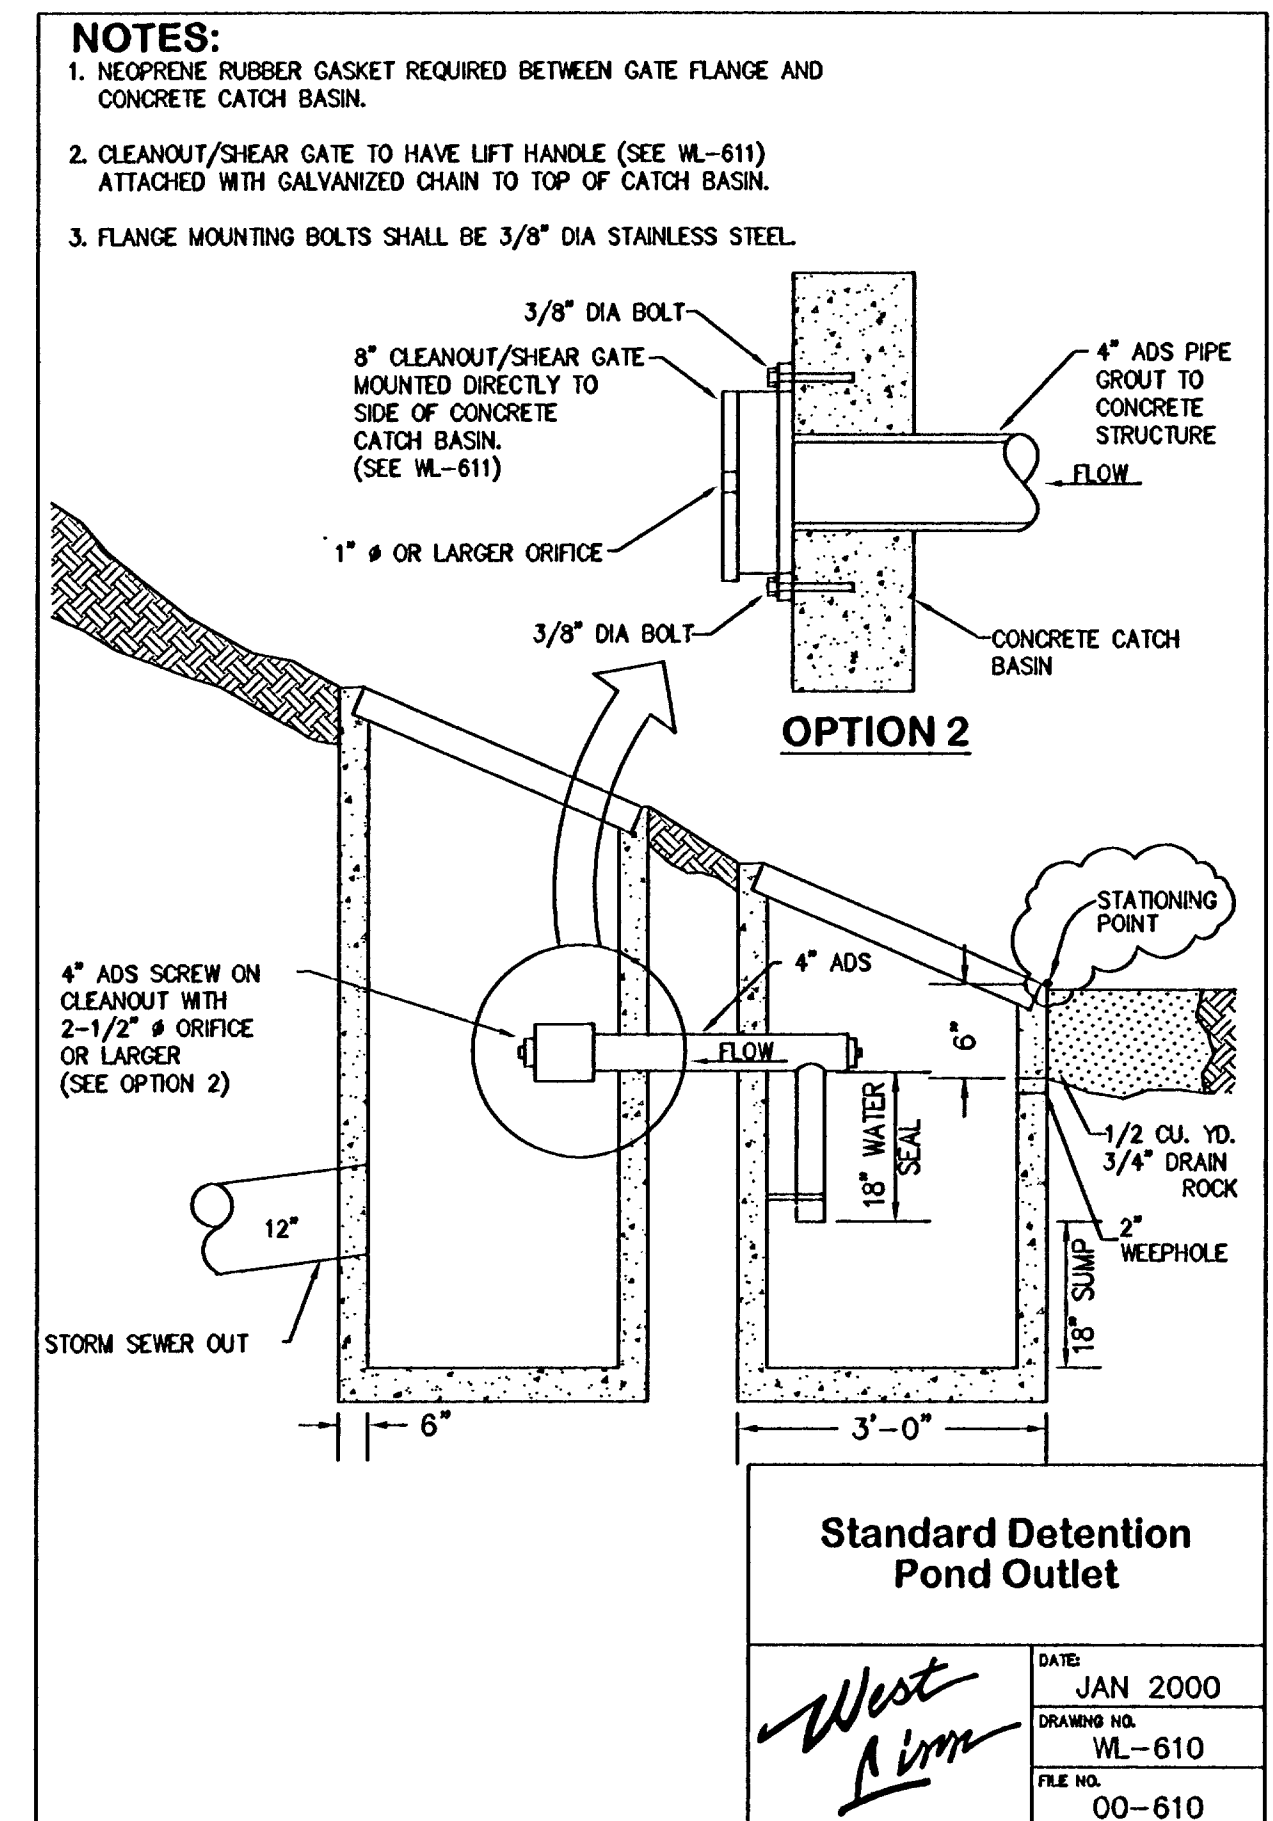

STANDARD DETENTION POND OUTLET DETAIL
NOT TO SCALE

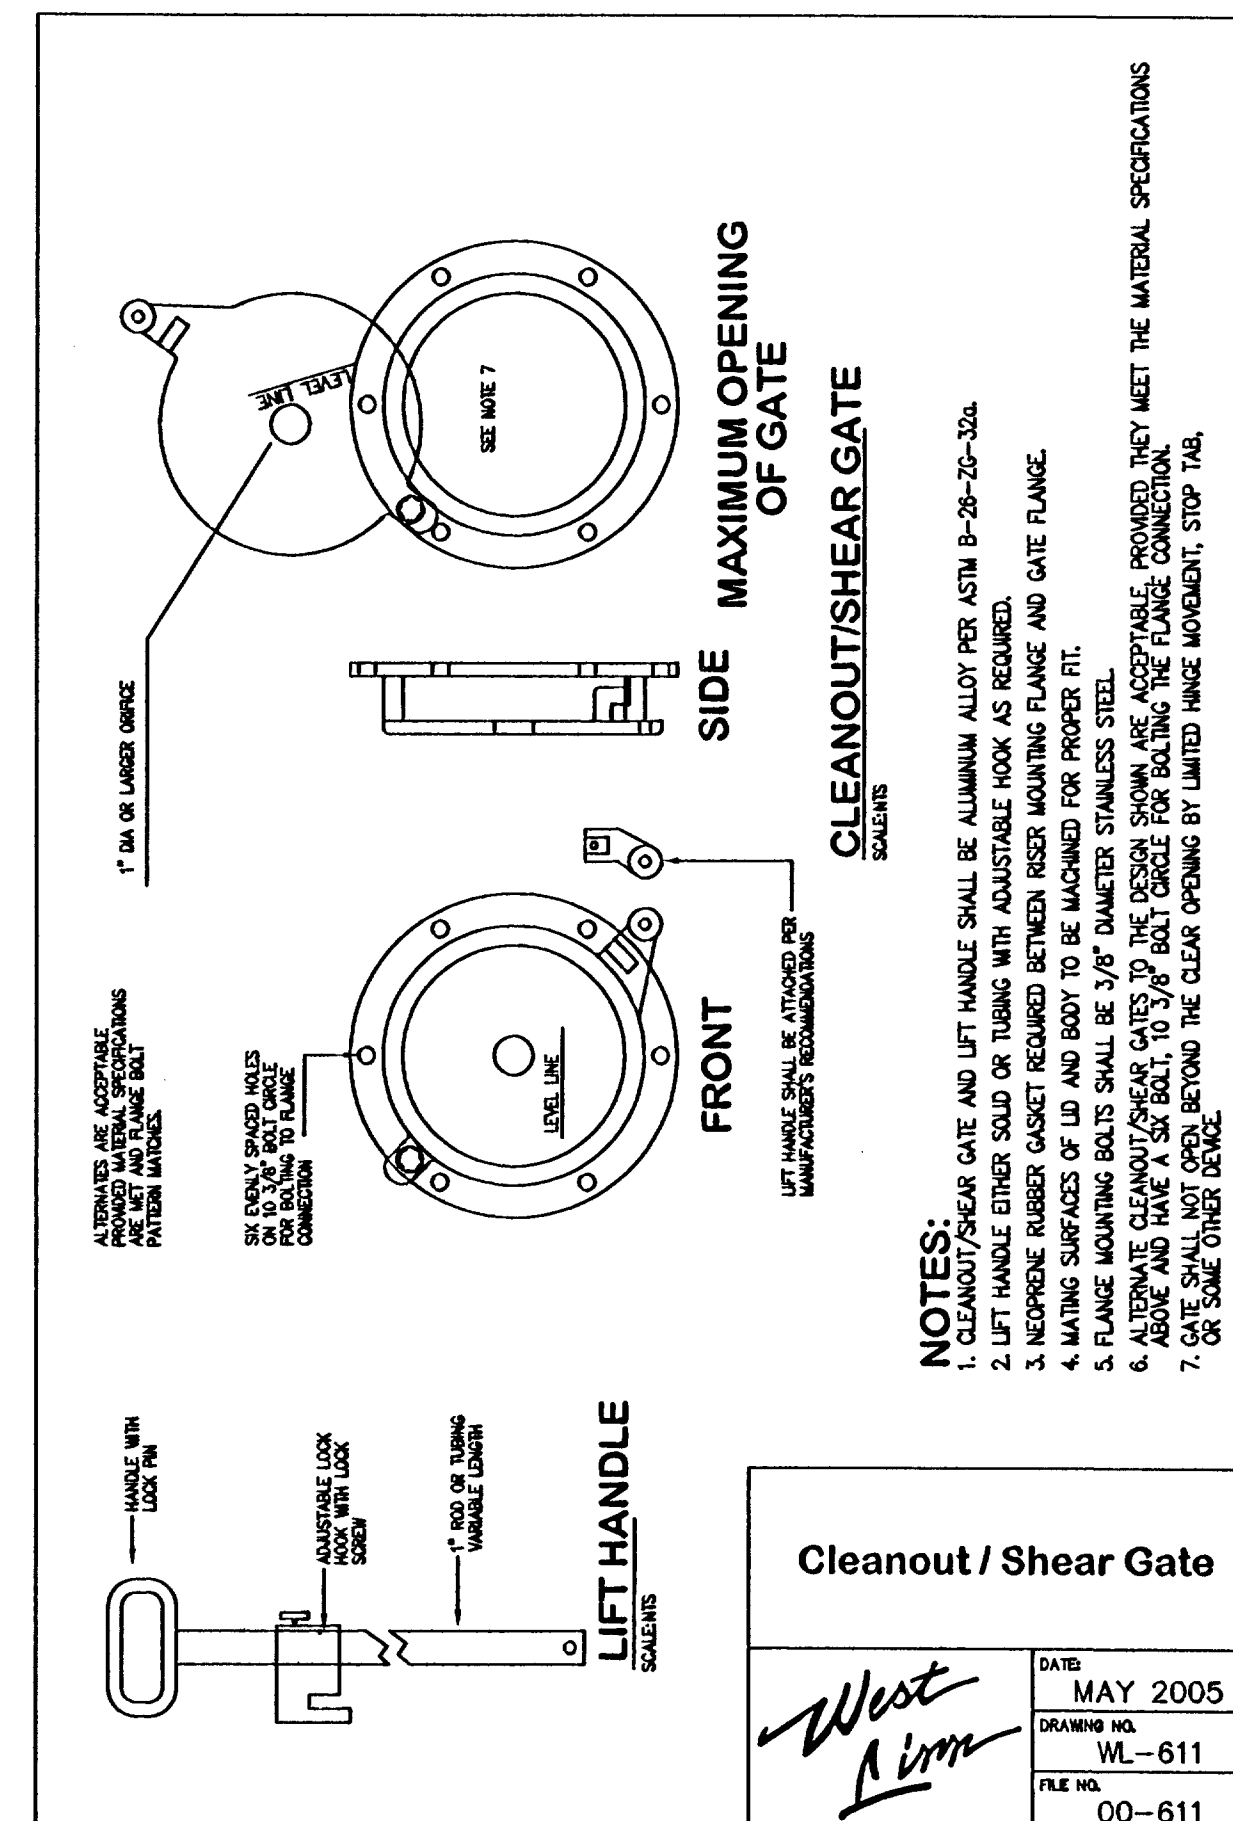

CLEANOUT/SHEAR GATE DETAIL
NOT TO SCALE

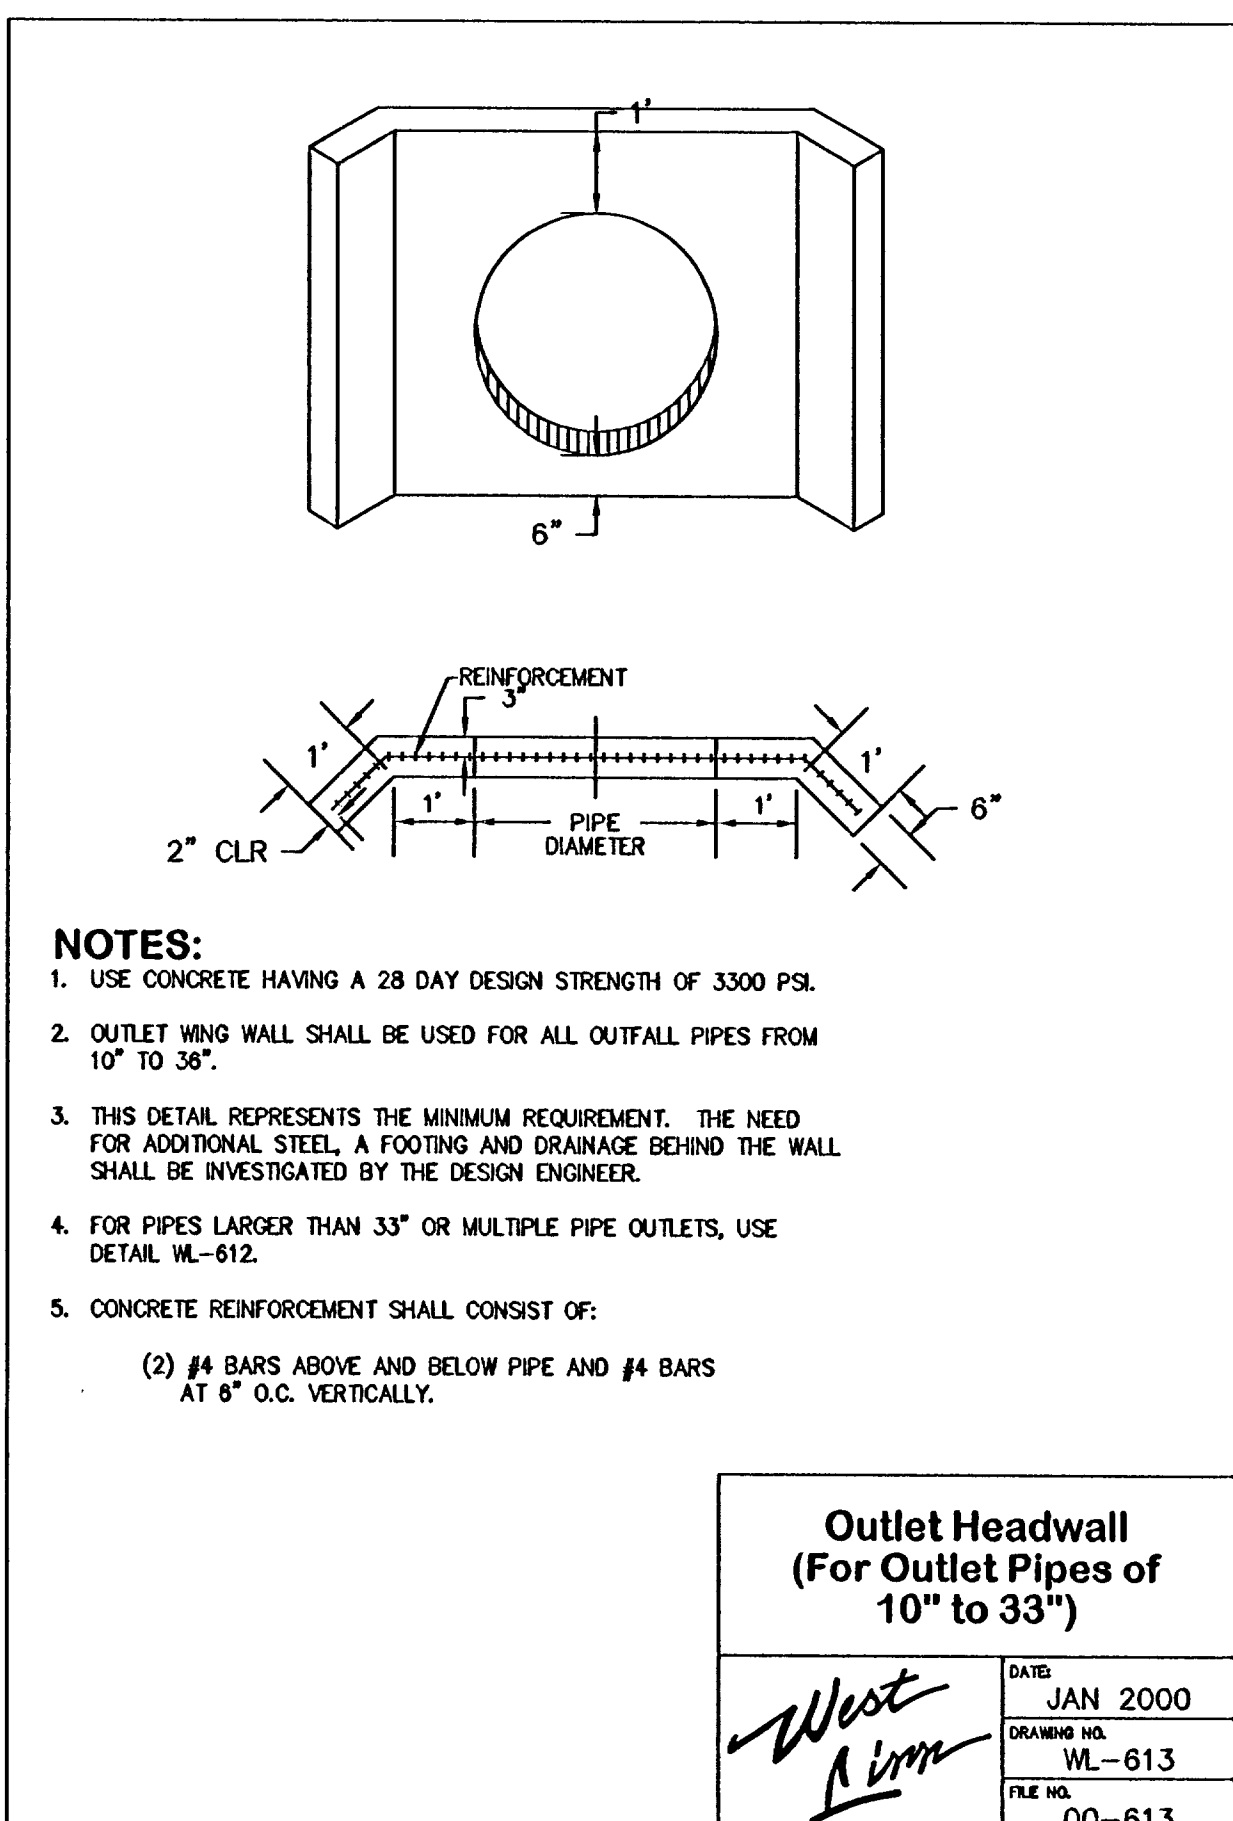

OUTLET HEADWALL DETAIL
NOT TO SCALE

WEST LINN CASEFILE SUB05-03 / ZC05-05 / VAR05-03

STANDARD DETAILS
SIENNA ESTATES
City of West Linn, Clackamas County, Oregon

SAM L PAP
2798 LANCASTER STREET
WEST LINN, OREGON 97068
(503) 888-2254

LANPACIFIC
5125 SW Macadam, Suite 140, Portland, Oregon 97239
503.723.2087 FAX 503.723.2447
www.lanpacific.com


REGISTERED PROFESSIONAL
LANDSCAPE ARCHITECT
JAN 10, 2001
EXP. 12/31/09

RECORD DRAWING
1/18/08
THESE RECORD DRAWINGS HAVE BEEN PREPARED, IN PART, ON THE BASIS OF INFORMATION COMPILED AND FURNISHED BY THE CONTRACTOR, REVISED CONSTRUCTION PLANS, AND FIELD OBSERVATIONS DURING CONSTRUCTION.


DATE: 1/18/08
DRAWN: JSE
DESIGNED: JSE
CHECKED: JCN
PROJECT: #1 SLP04-001
SHEET TITLE: STANDARD DETAILS

SHEET NUMBER
C020


CONSTRUCTION DOCUMENTS

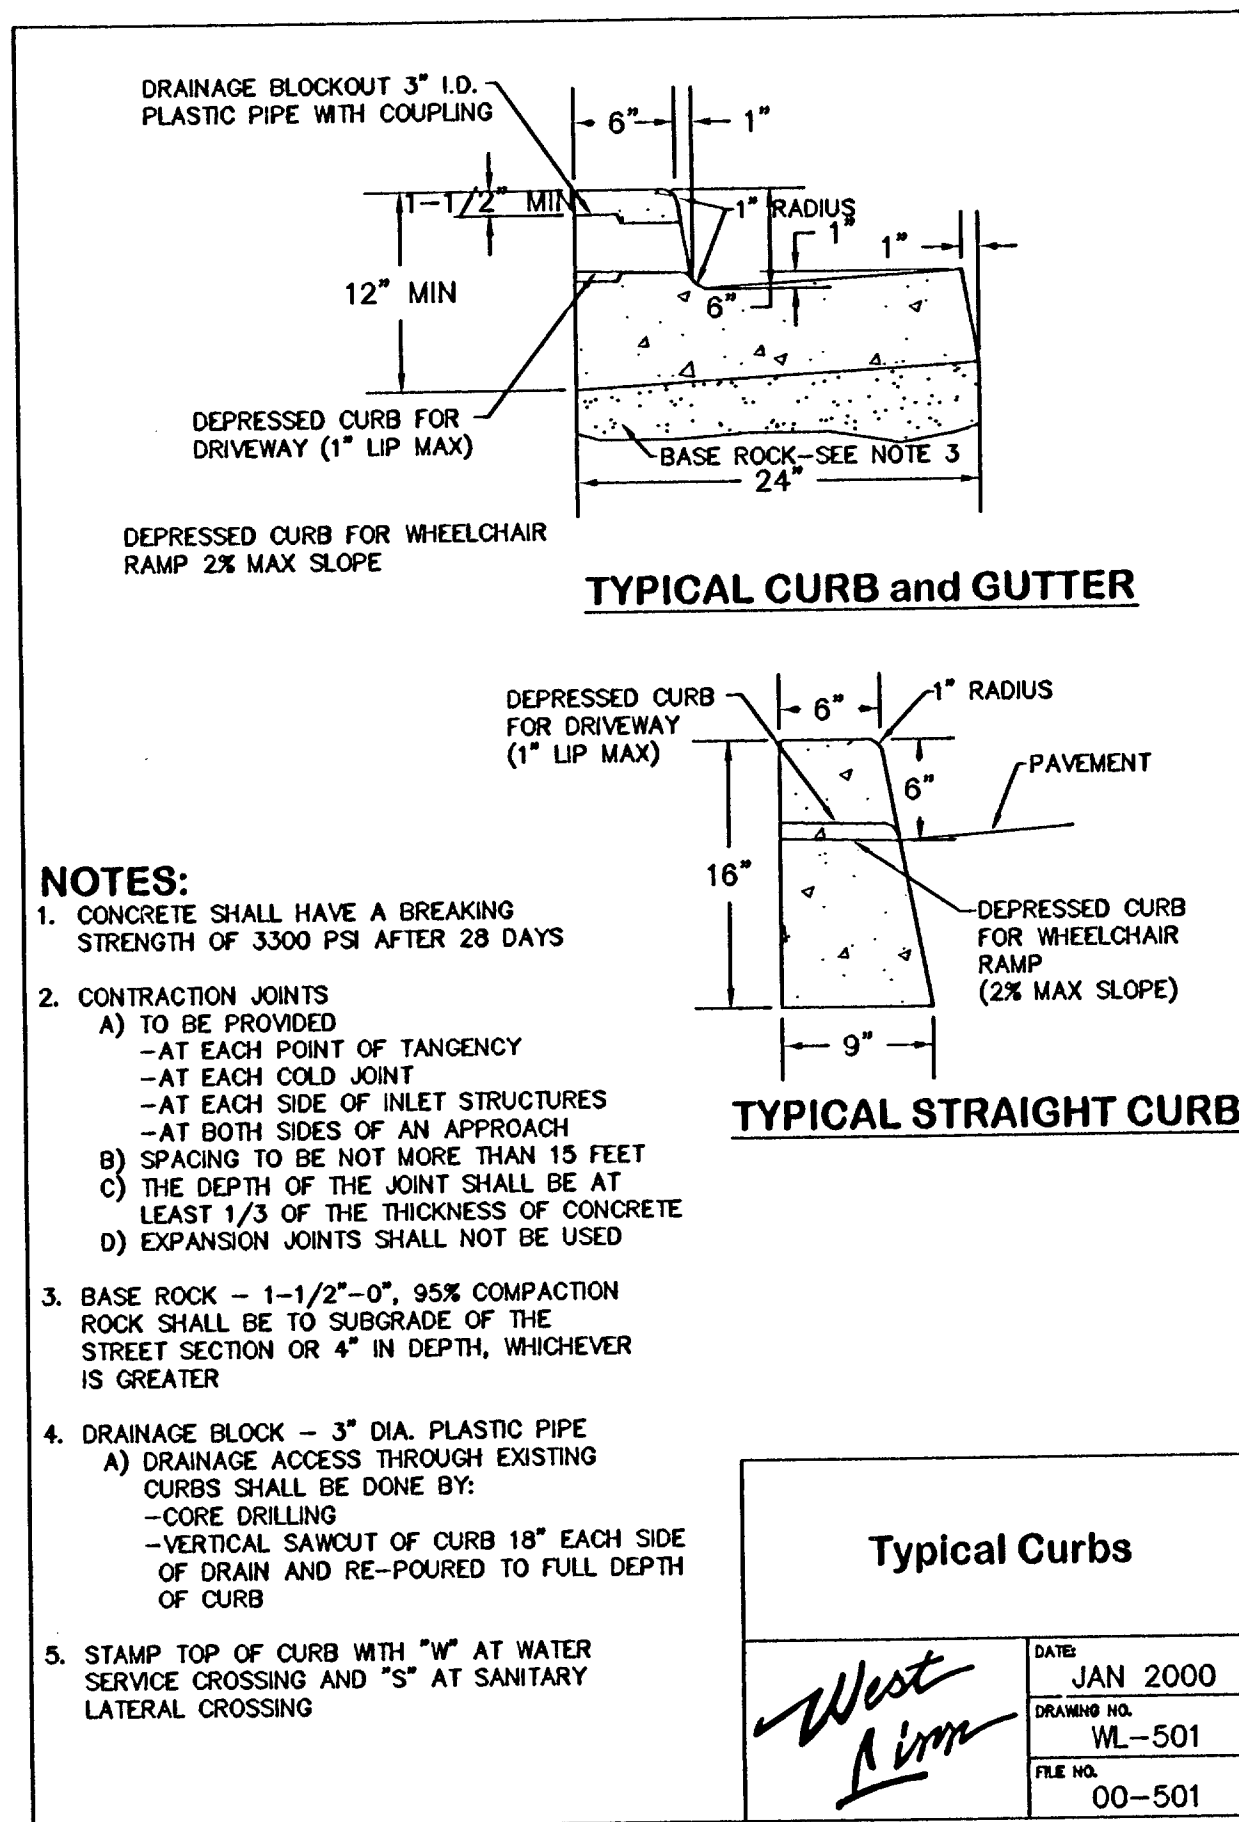

TYPICAL CURBS DETAIL
NOT TO SCALE

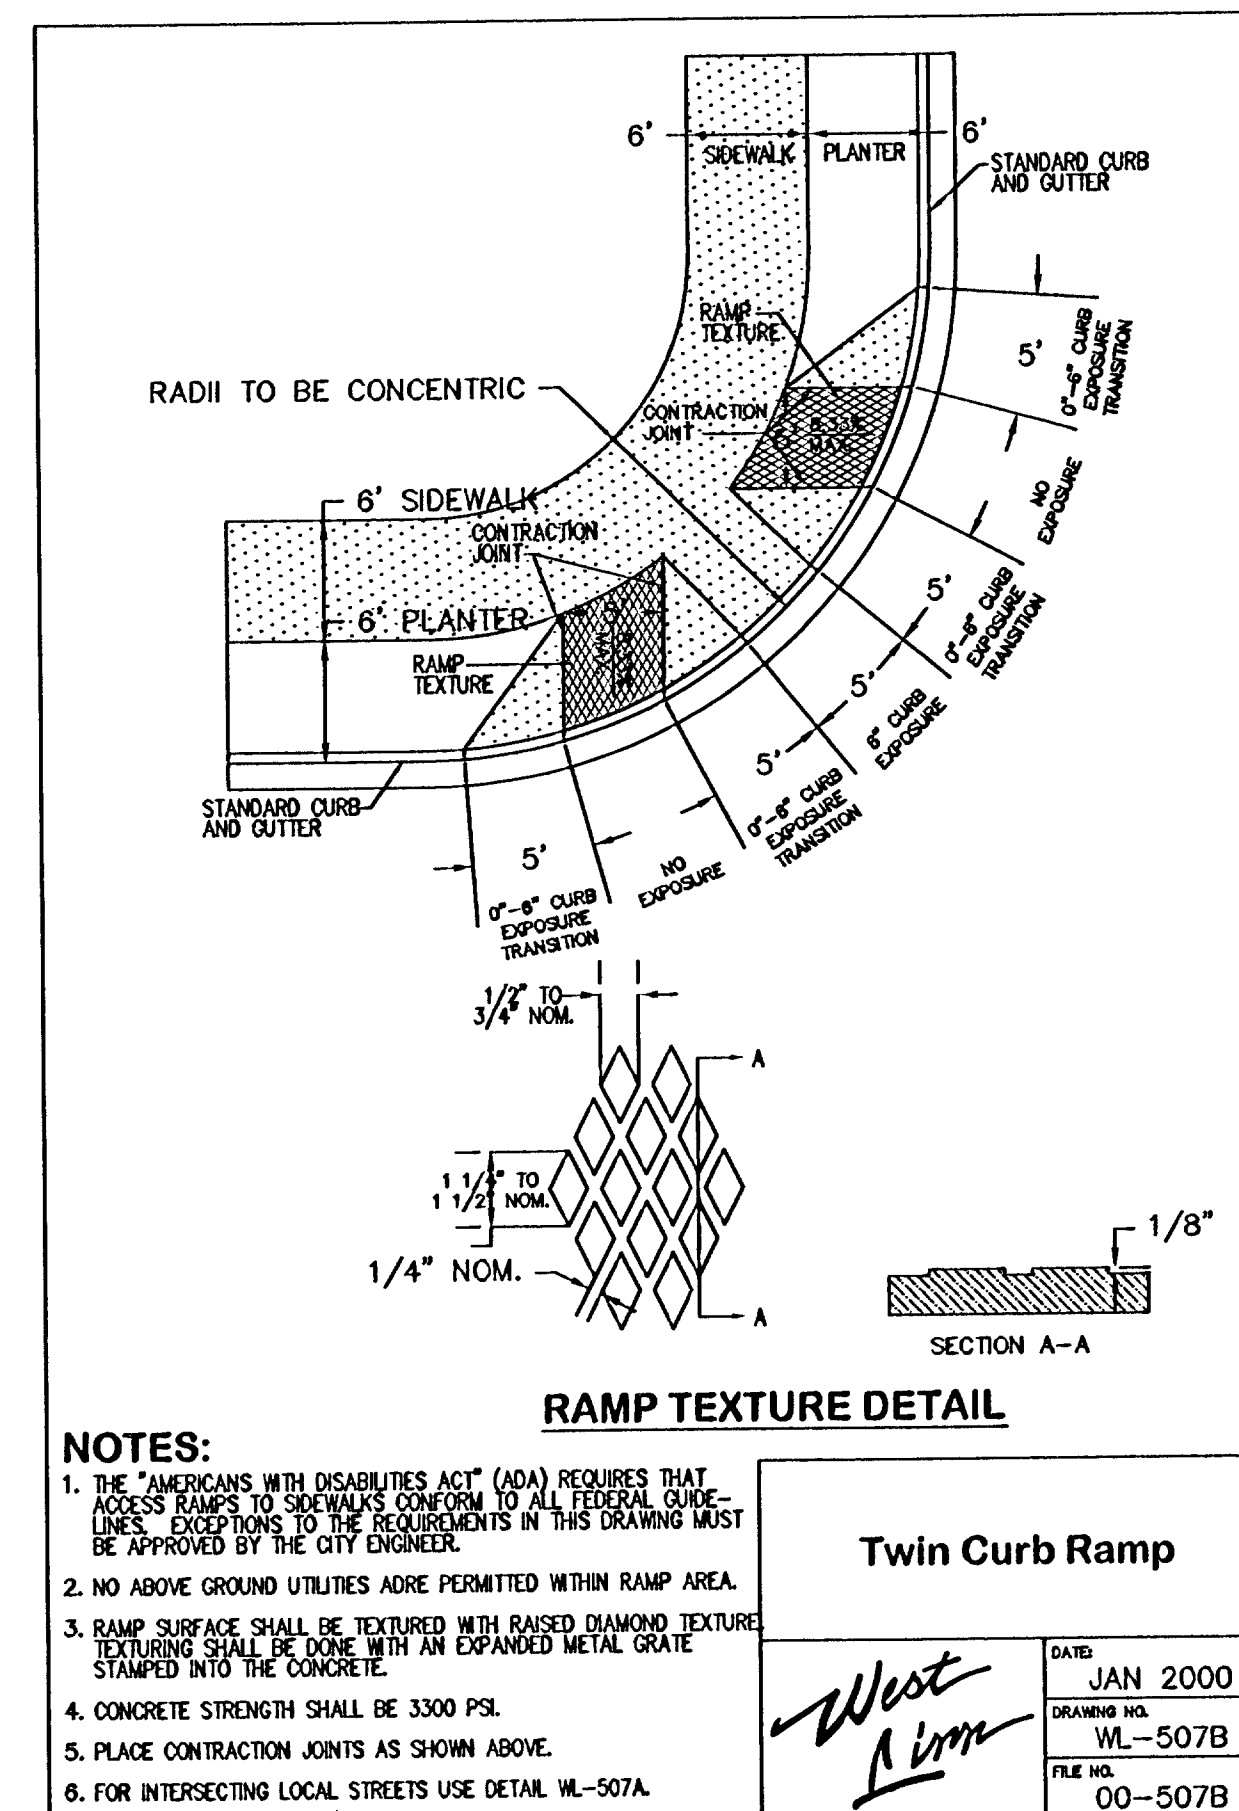


TWIN CURB RAMP DETAIL
NOT TO SCALE

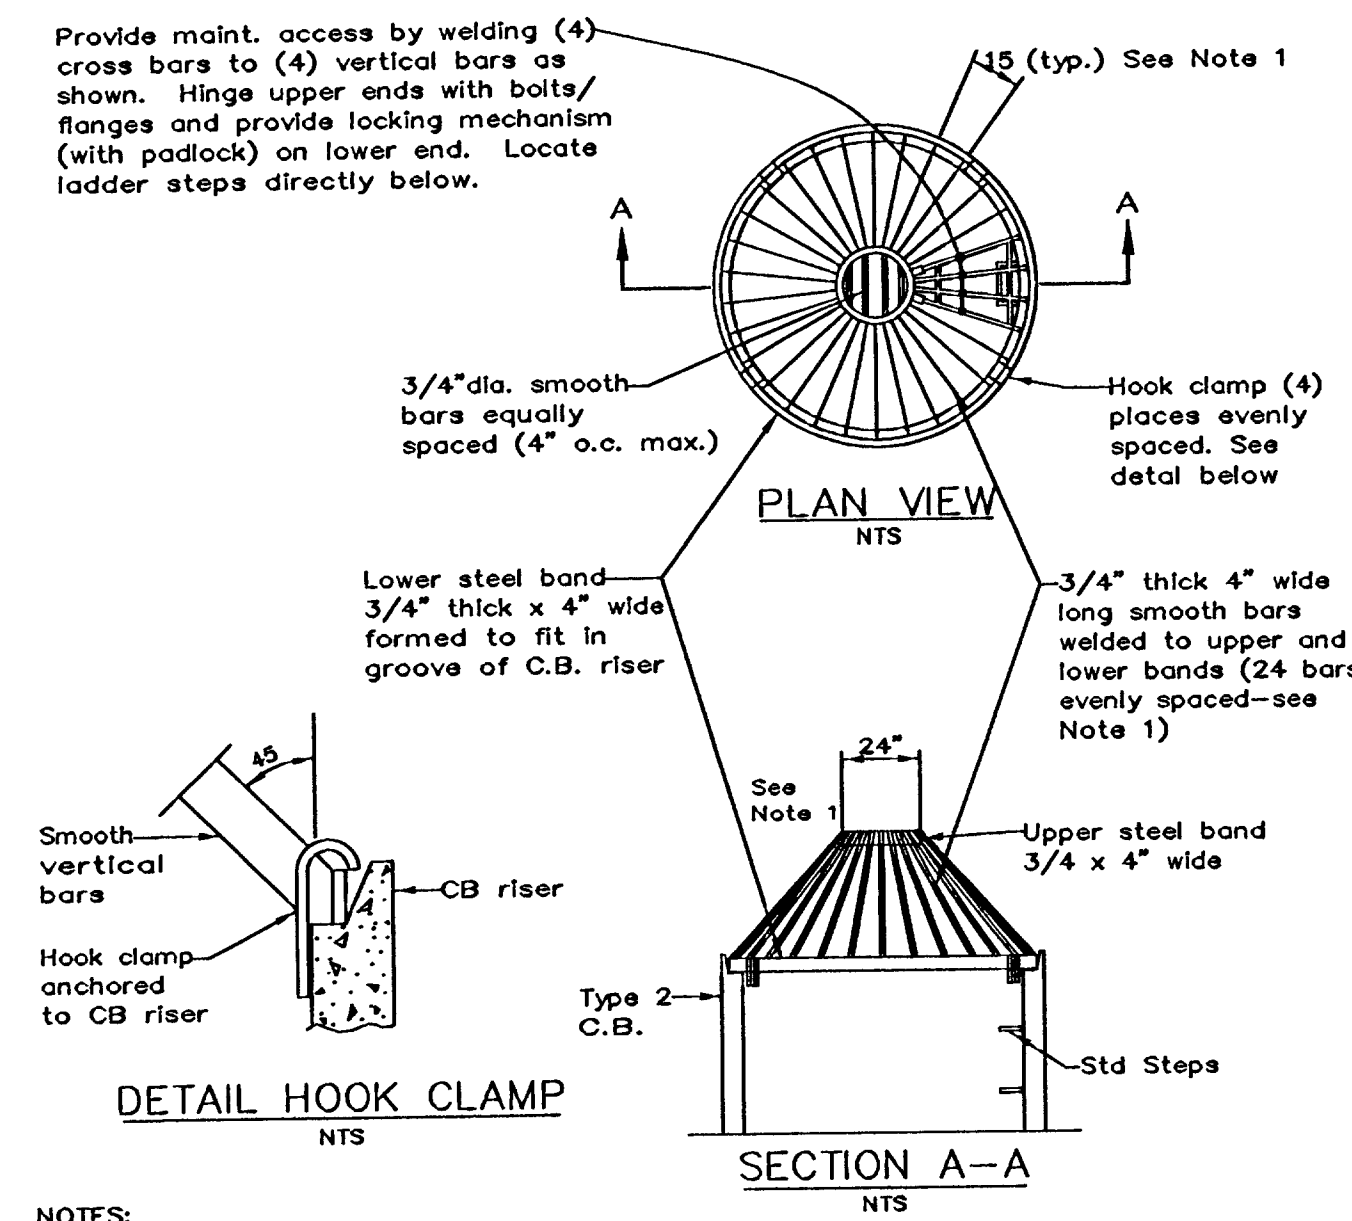


- NOTES:**
- Dimensions are for installation on 54" dia. C.B. For different dia. C.B.'s a dimensions to maintain 45 angle on "vertical" bars and 7" O.C. max. spacing of bars around lower steel band.
 - Metal parts: corrosion resistant.
 - This debris barrier is also recommended for use on the inlet to roadway cross-culverts with high potential for debris collection (except on Class 2 s


XX
NOT TO SCALE

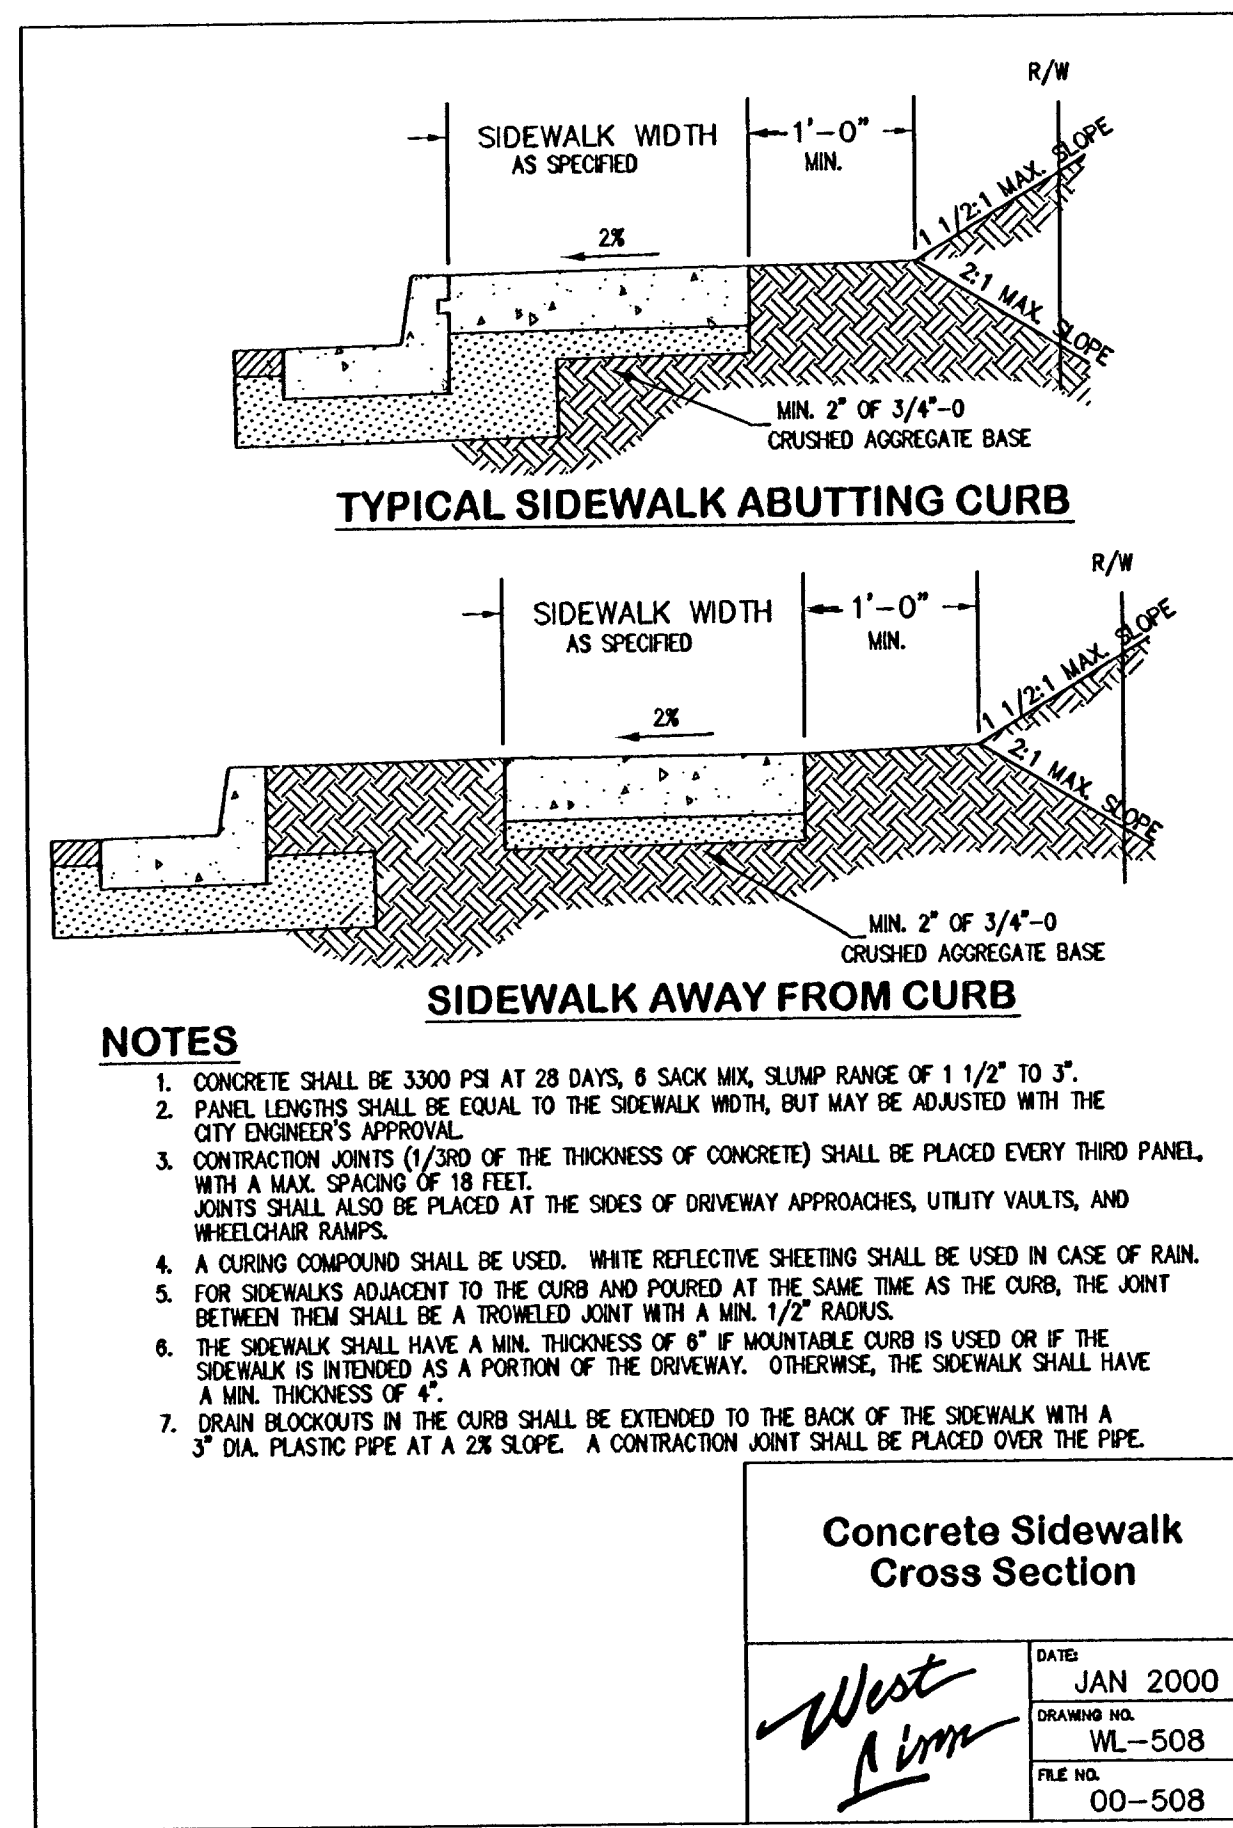


CONCRETE SIDEWALK CROSS SECTION DETAIL
NOT TO SCALE

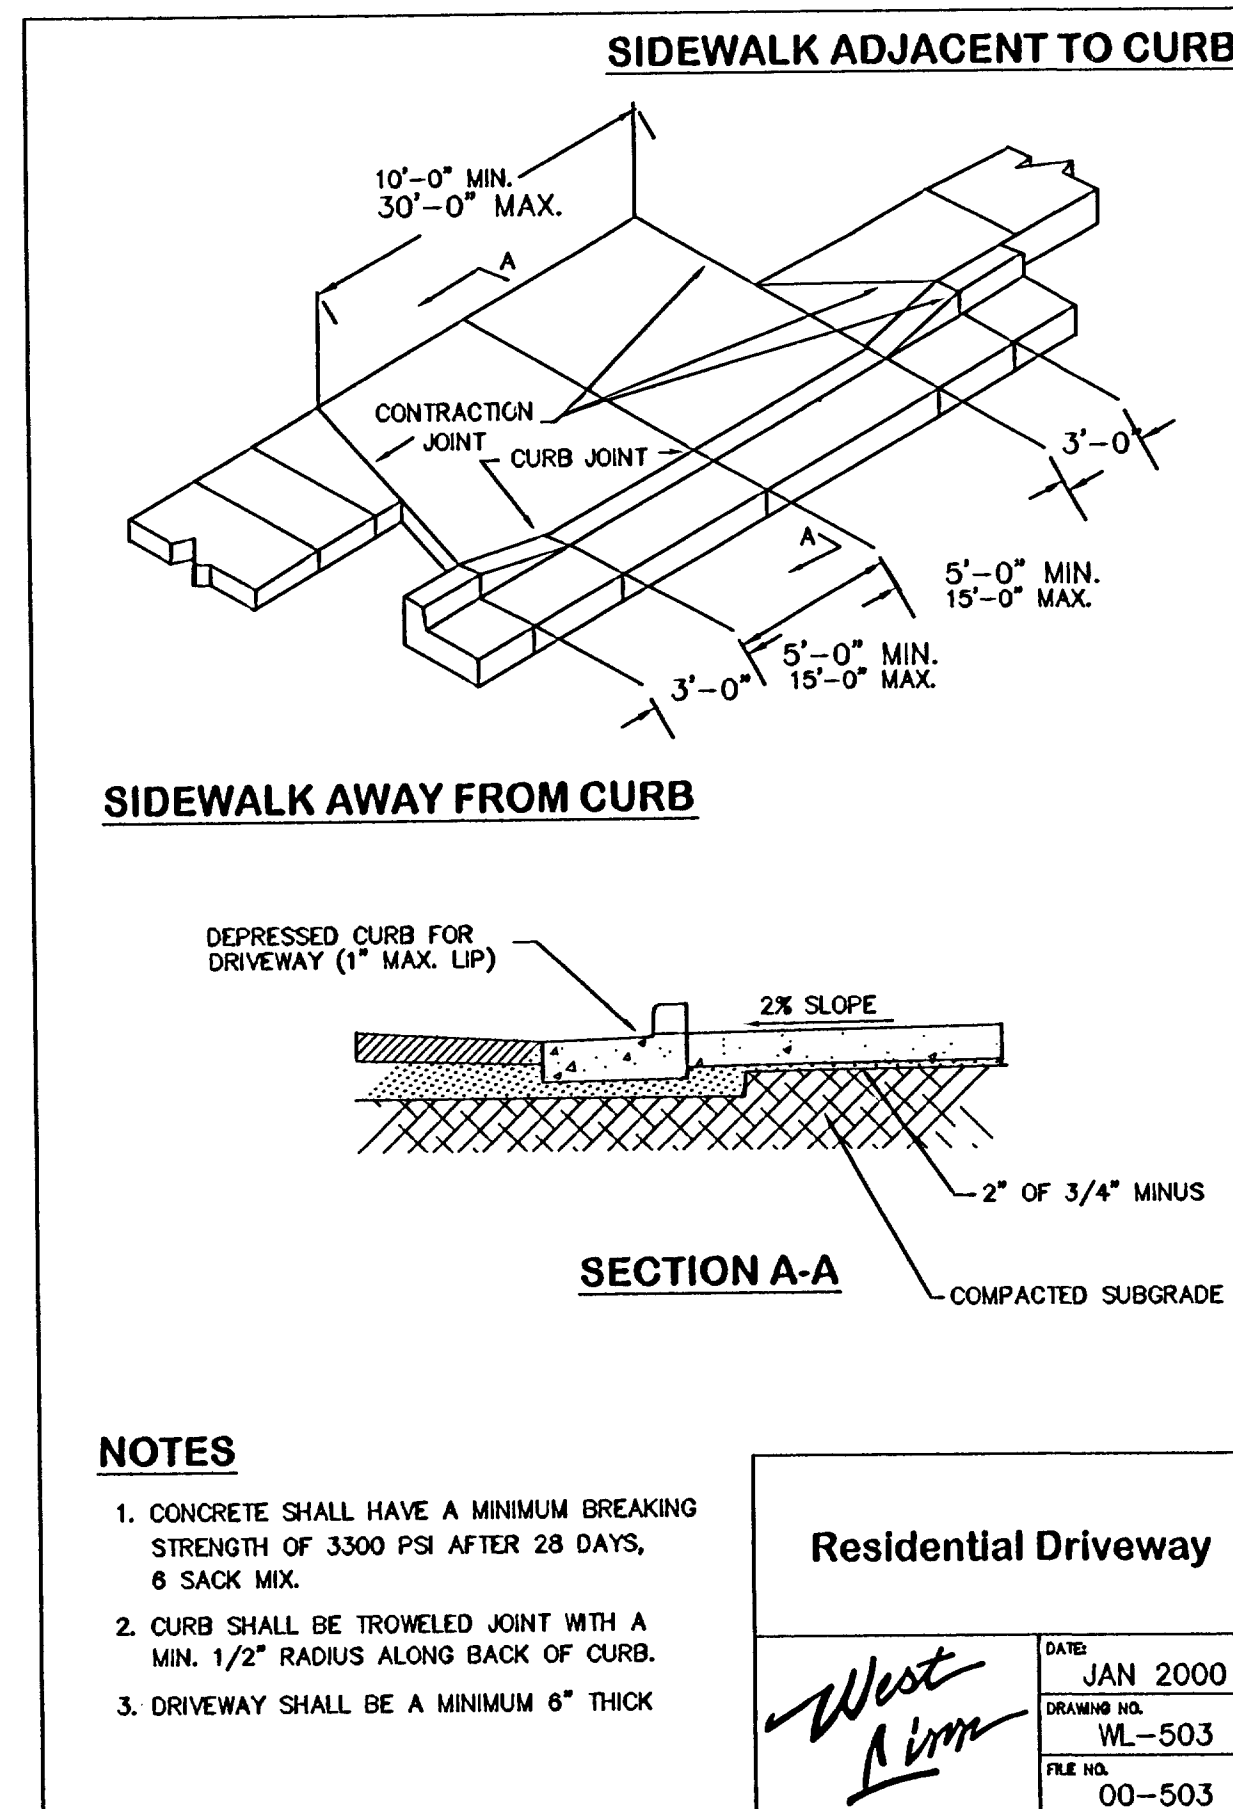


RESIDENTIAL DRIVEWAY DETAIL
NOT TO SCALE

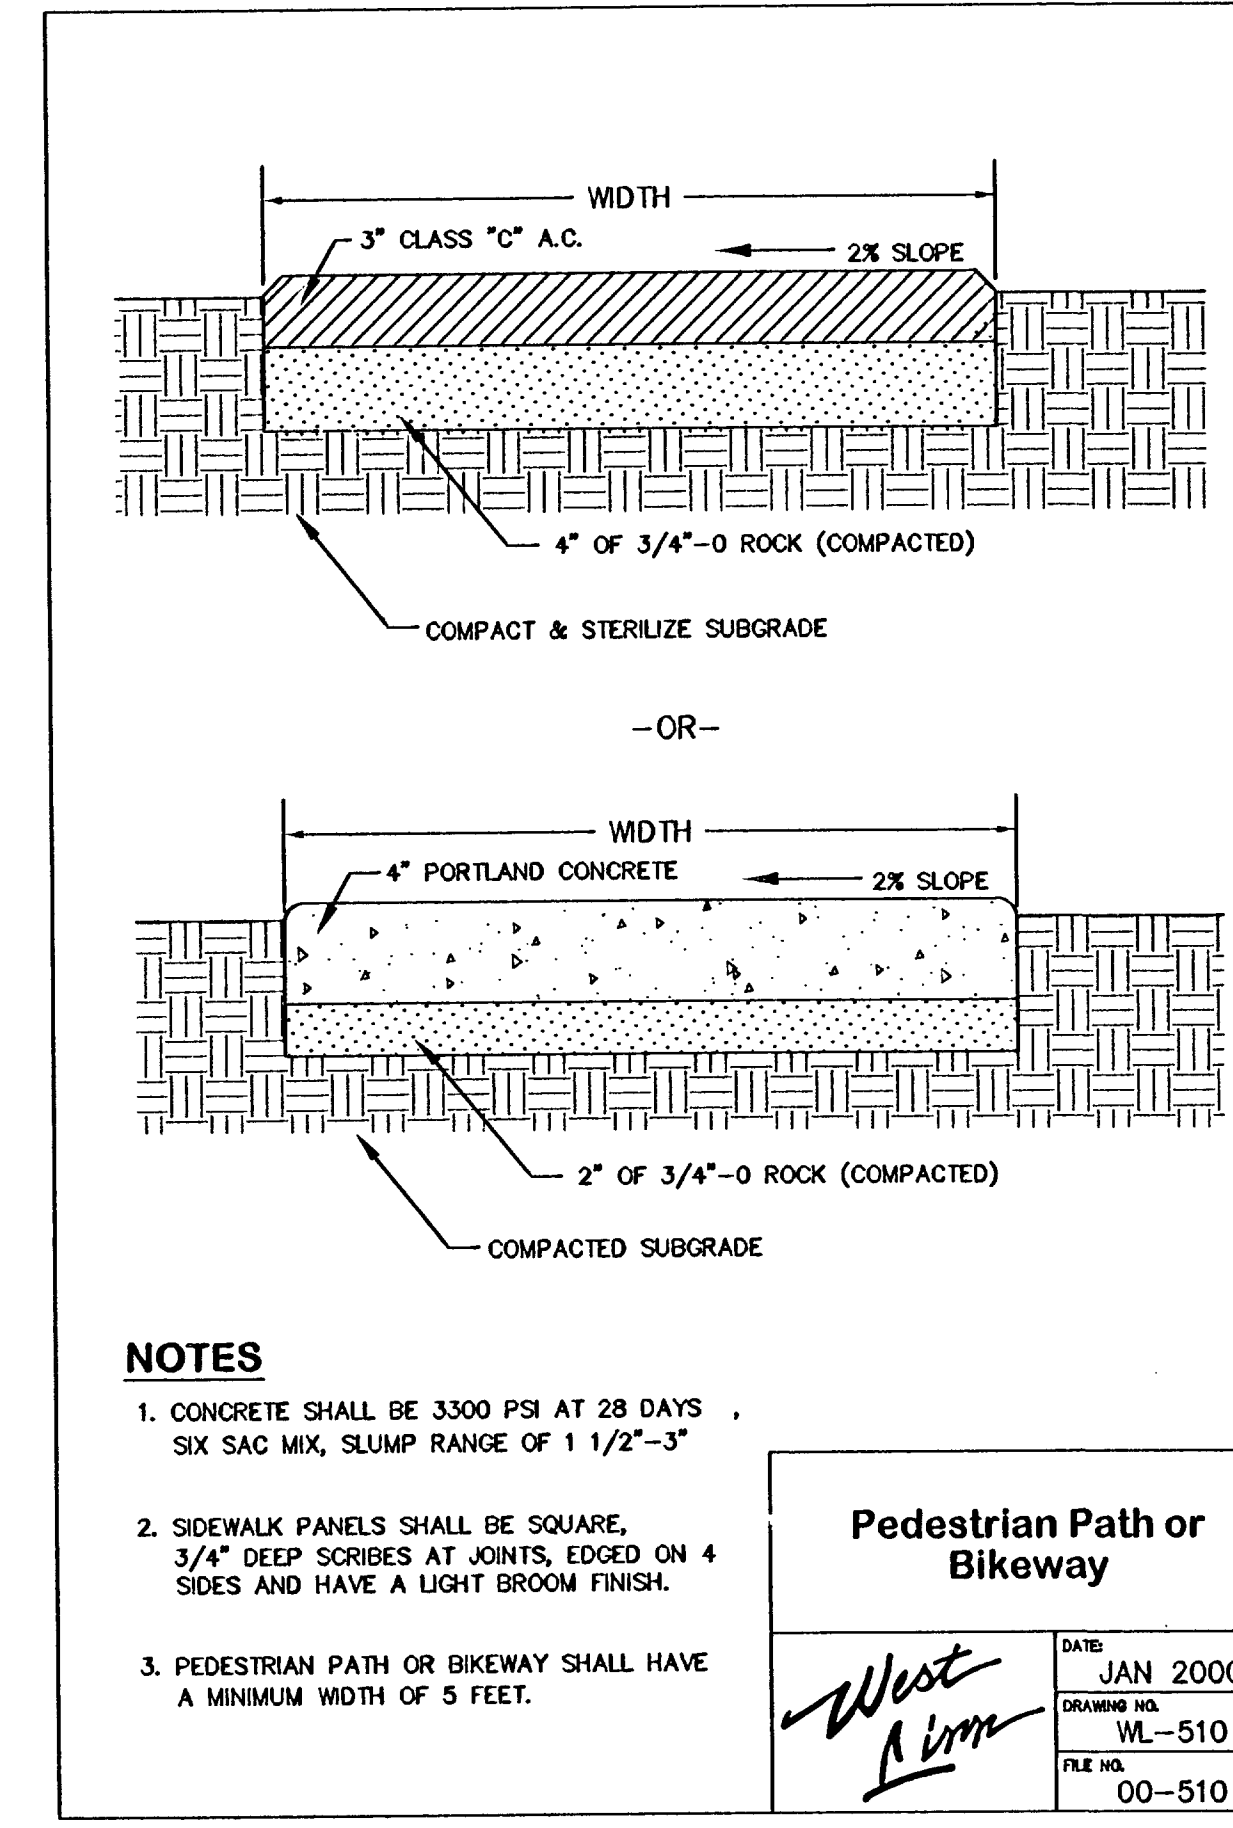

PEDESTRIAN PATH OR BIKEWAY DETAIL
NOT TO SCALE

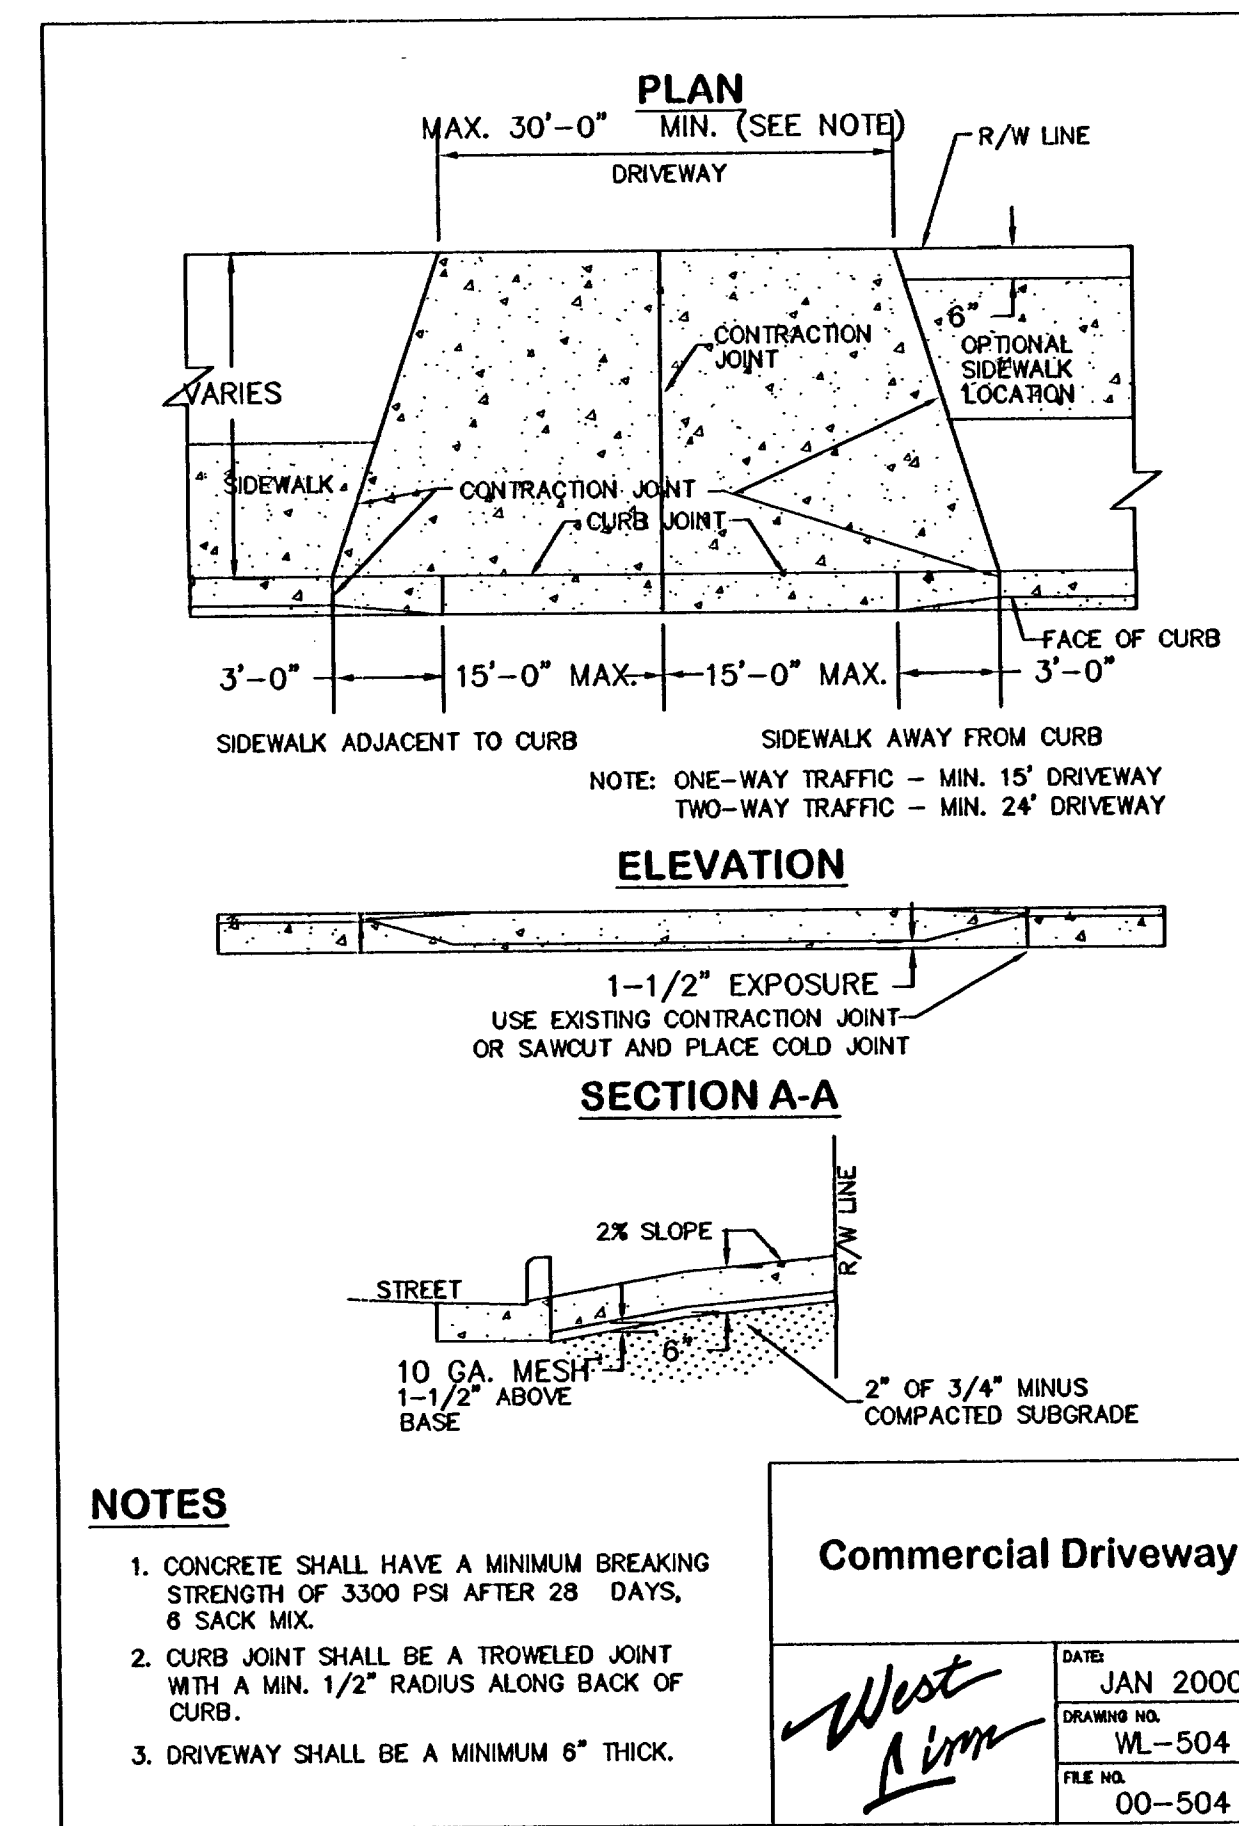

COMMERCIAL DRIVEWAY DETAIL
NOT TO SCALE

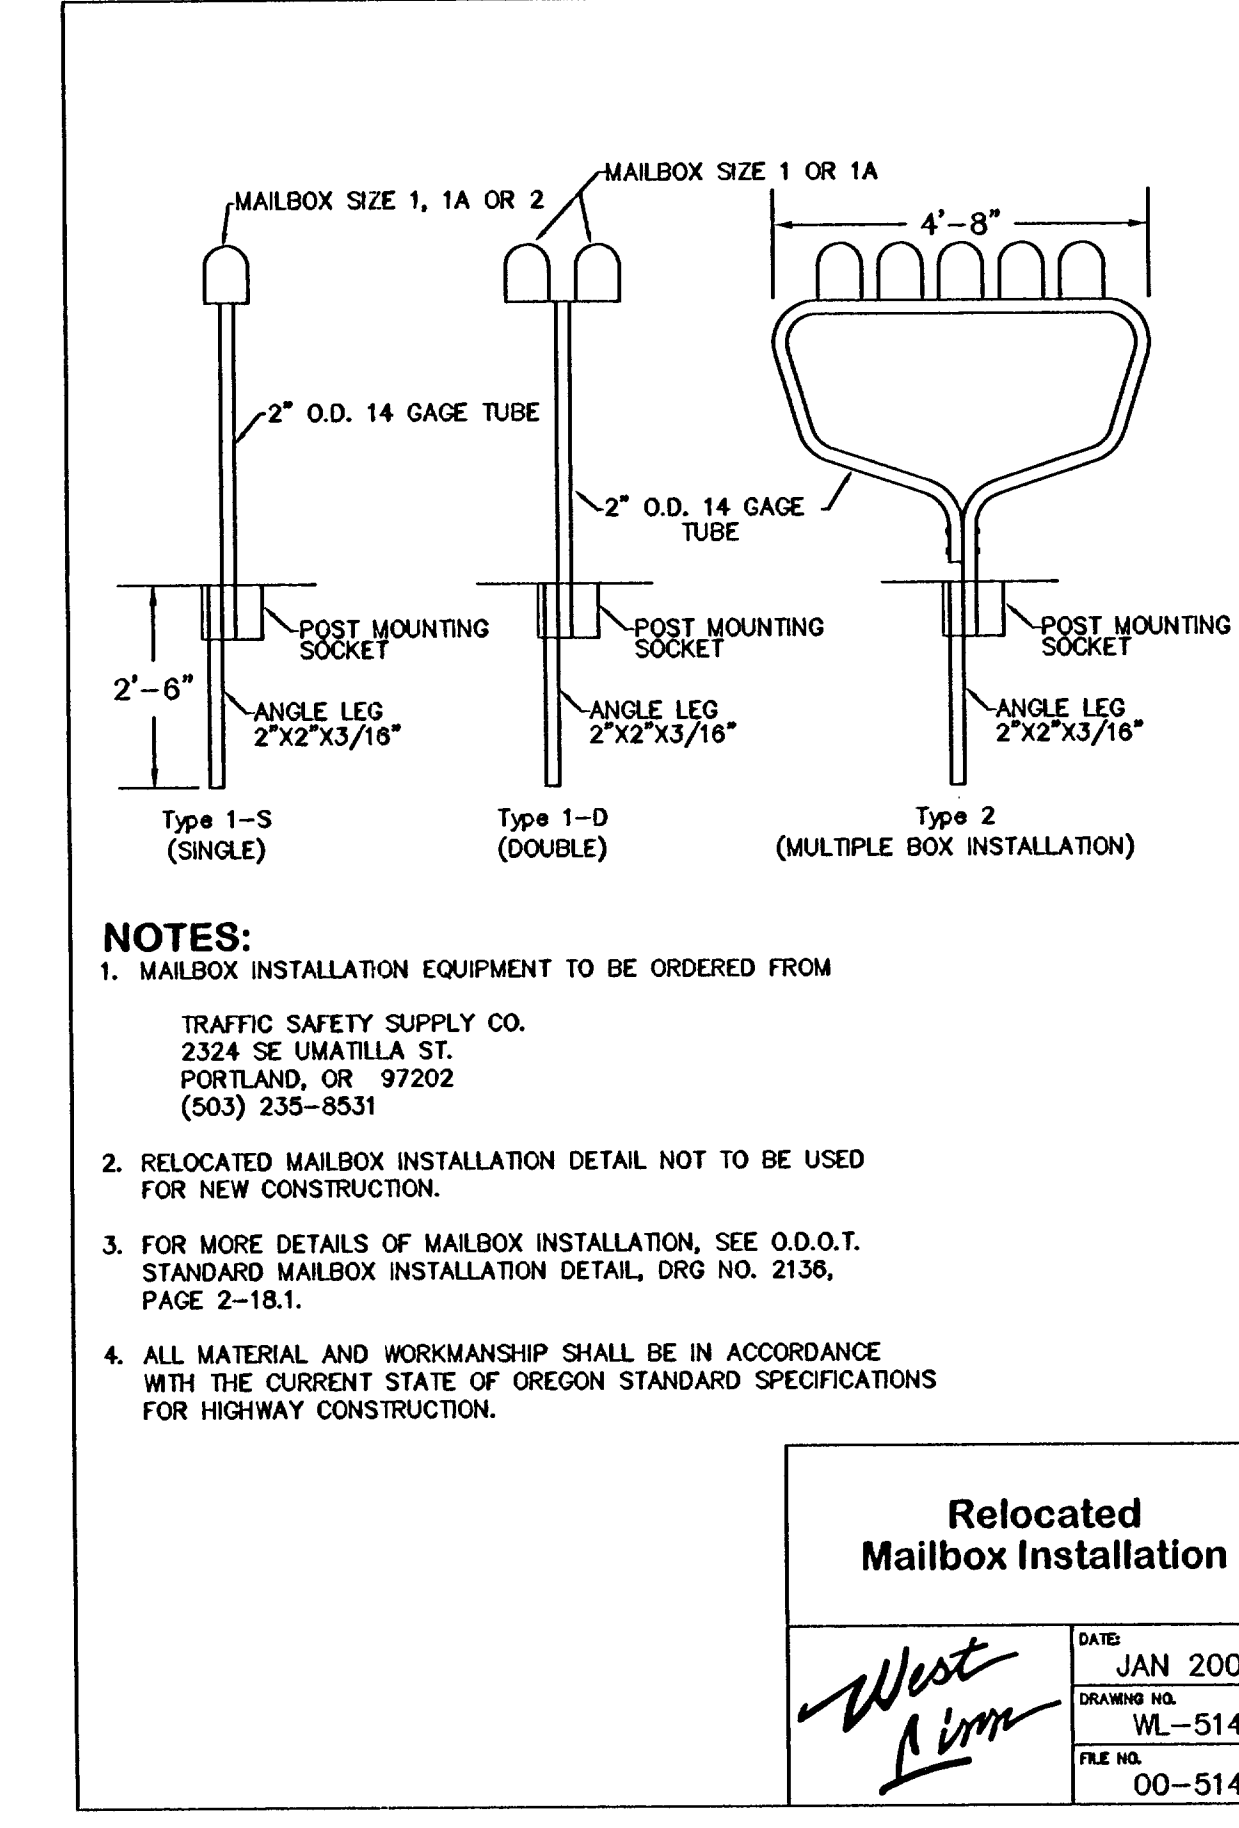

STANDARD 1" WATER SERVICE DETAIL
NOT TO SCALE
WEST LINN CASEFILE SUB05-03 / ZC05-05 / VAR05-03

CONSTRUCTION DOCUMENTS

STANDARD DETAILS
SIENNA ESTATES
City of West Linn, Clackamas County, Oregon

SAM L PAP
2799 LANCASTER STREET
WEST LINN, OREGON 97068
(503) 888-2254

LANPACIFIC
ENGINEERING
CONSULTING
ARCHITECTURE
5125 SW Macadam, Suite 140, Portland, Oregon 97239
TEL: 503 / 238-2097 FAX: 503 / 238-2447
www.lanpacific.com

REGISTERED PROFESSIONAL ENGINEER
No. 0000
EXPIRY 10, 2001
J. SCOTT EMES
EXP. 12/31/09

RECORD DRAWING
1/18/08
THESE RECORD DRAWINGS HAVE BEEN PREPARED, IN PART, ON THE BASIS OF INFORMATION COMPILED AND FURNISHED BY THE CONTRACTOR. REVISIONS TO CONSTRUCTION PLANS, AND FIELD OBSERVATIONS DURING CONSTRUCTION.

DATE: 1/18/08
DRAWN: JSE
DESIGNED: JSE
CHECKED: RGN
PROJECT: SLP04-001

SHEET TITLE
STANDARD DETAILS

SHEET NUMBER
C022