


# TAMARISK SUBDIVISION


WEST LINN, OREGON

As-Built 3-31-77




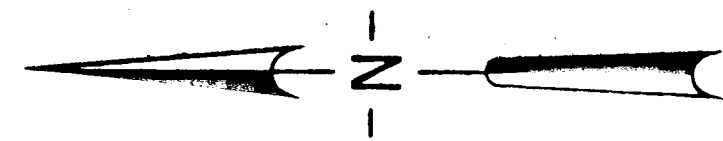

# GREEN HILLS ESTATES

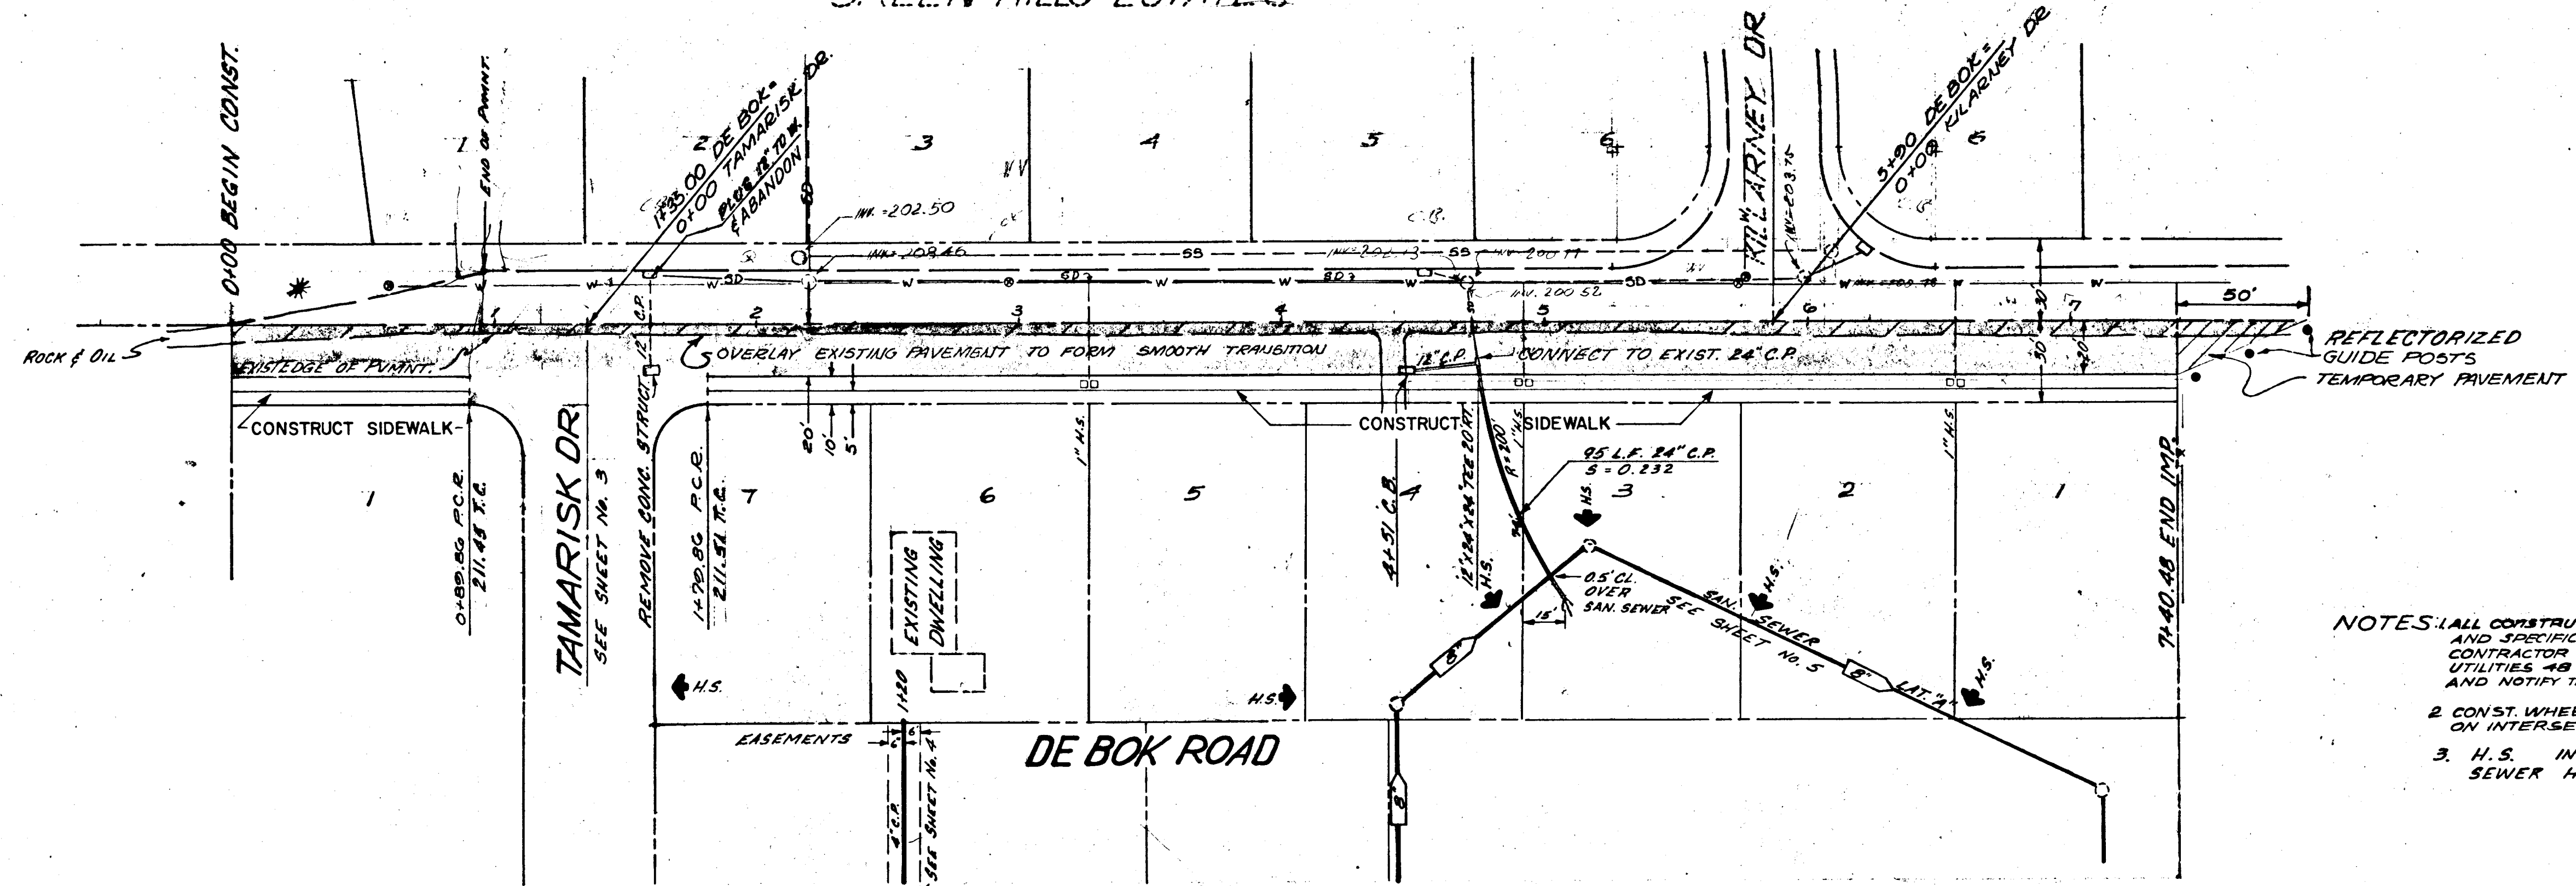

- NOTES: ALL CONSTRUCTION SHALL CONFORM TO THE STANDARDS AND SPECIFICATION OF THE CITY OF WEST LINN. CONTRACTOR SHALL VERIFY LOCATION OF ALL UTILITIES 48 HRS. PRIOR TO STARTING CONSTRUCTION AND NOTIFY THE ENGINEER OF ANY CONFLICTS.
2. CONST. WHEELCHAIR RAMPS AT MIDDLE OF CORNERS ON INTERSECTING STREETS (6 LOCATIONS).
3. H.S. INDICATES LOCATION OF SANITARY SEWER HOUSE SERVICE.

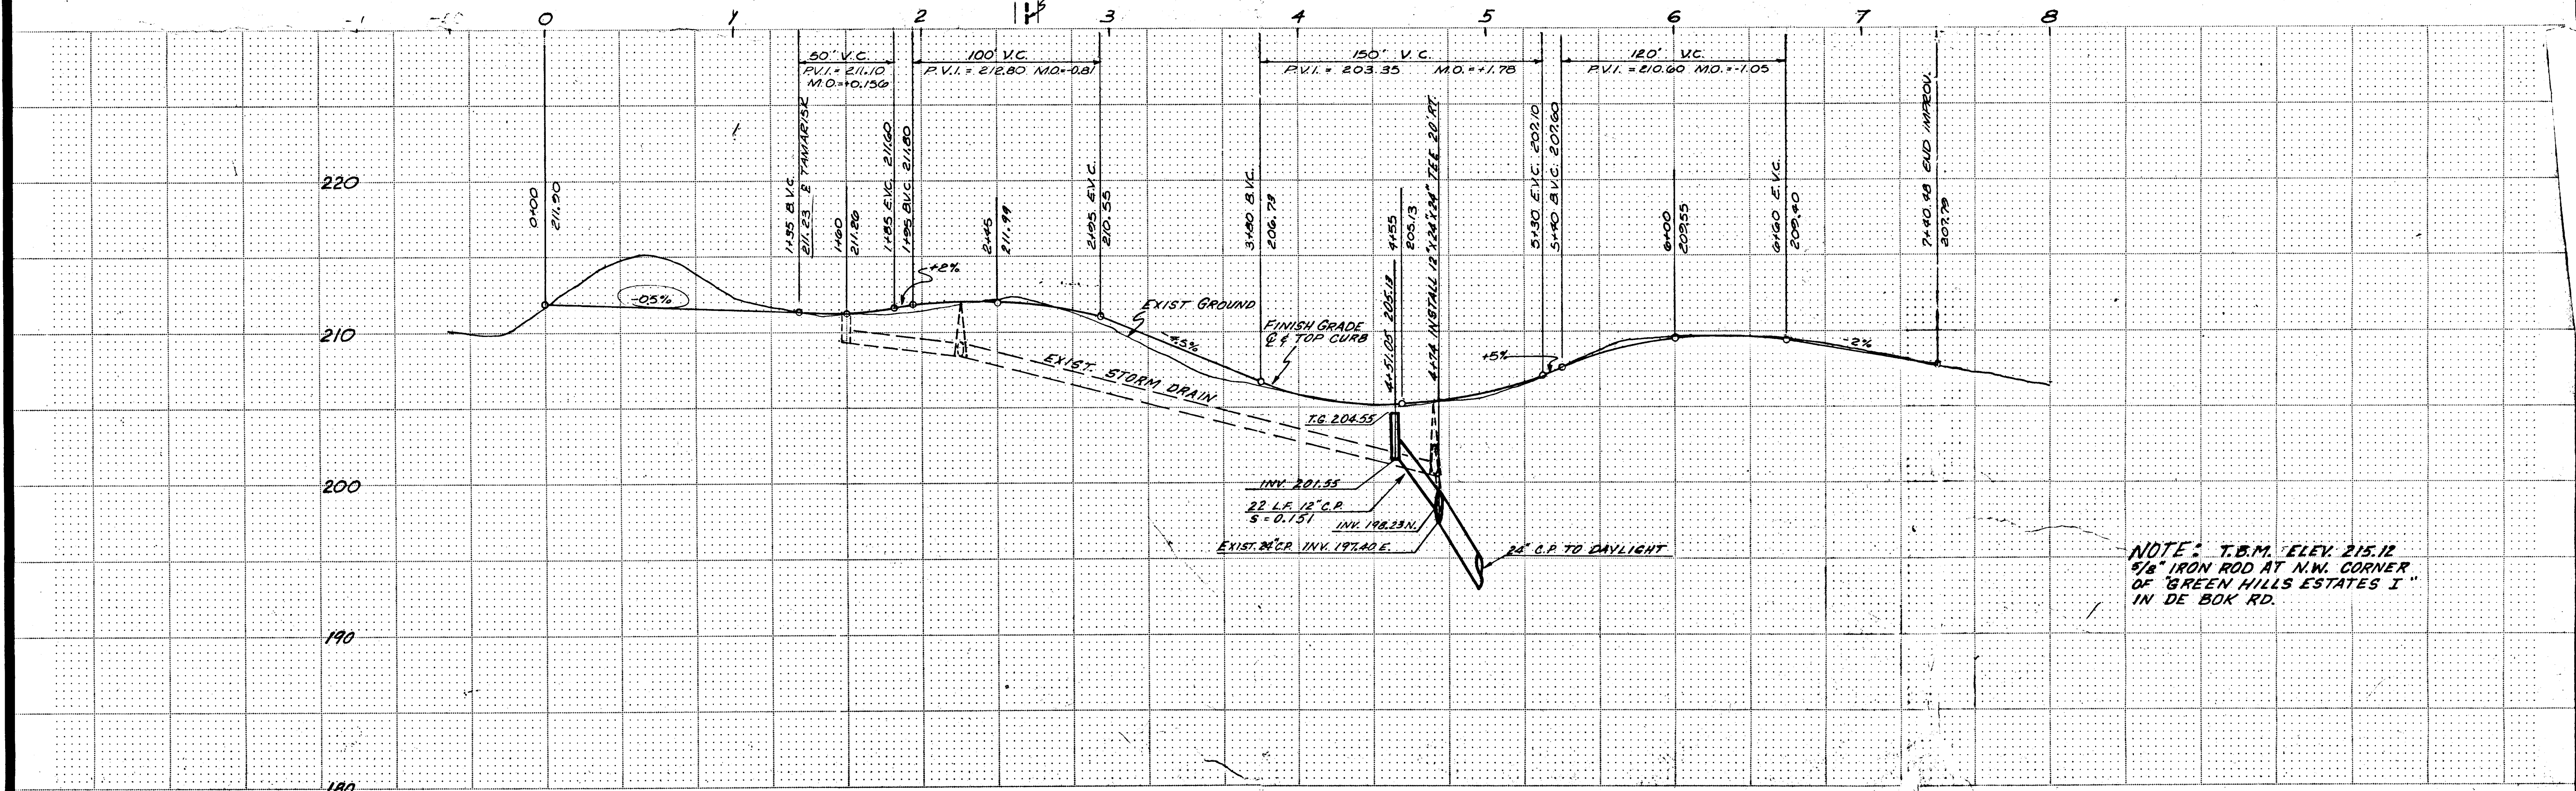

NOTE: T.B.M. ELEV. 215.12  
3/8" IRON ROD AT N.W. CORNER  
OF 'GREEN HILLS ESTATES I'  
IN DE BOK RD.

1	SAN. H.S. LOT 6, WTR. H.S. LOTS 8 & 9	8-27-76	J.A.W.	Designed T.M.
2	"As-Built"	3-31-77	J.A.W.	Drawn P.E.B.
				Checked W.W.H.
No.	Revisions	Date	By	

Approved  
Scale: H=1"=40'  
V=1"=5'  
Date: JUNE, 1976  
Parametrix, Inc.

CONSULTANTS IN ENGINEERING  
AND ENVIRONMENTAL SCIENCES  
Seattle  
Spokane  
Portland/Vancouver  
Eugene  
Tacoma

COMMONWEALTH PROPERTIES  
Beaverton, Oregon


Improvement Plans  
De Bok Road

TAMARISK  
SUBDIVISION  
West Linn, Oregon  
Job No. 56-101-02


REGISTERED PROFESSIONAL  
ENGINEER  
WILLIAM D. HALL  
No. 12,171  
STATE OF OREGON

Sheet  
2  
6



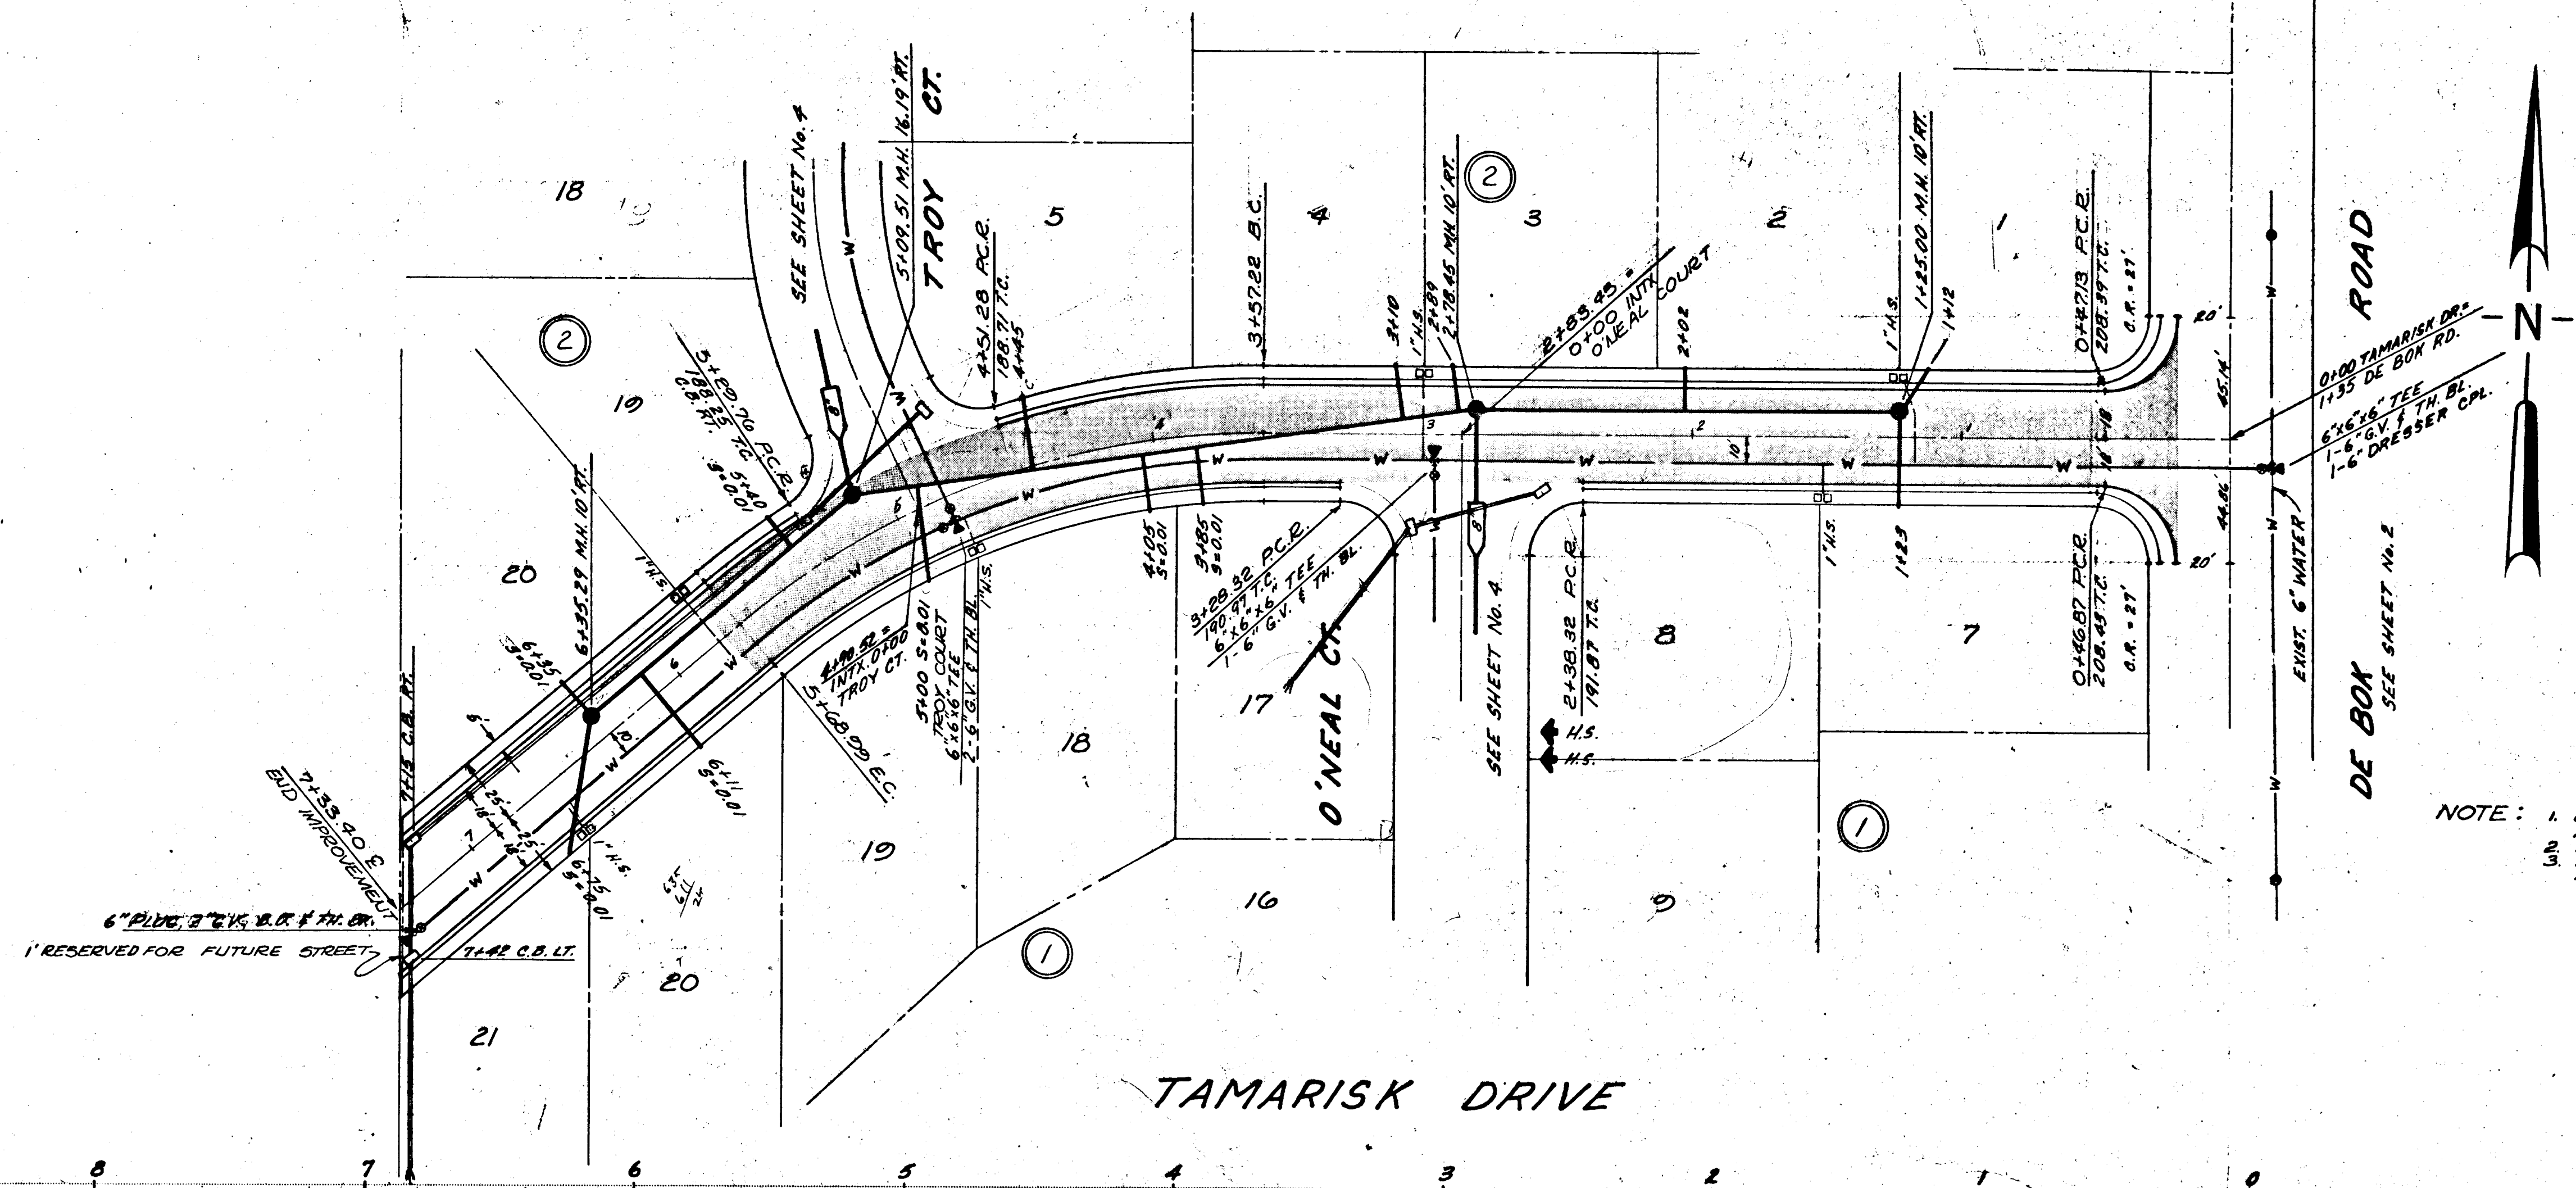

- NOTE:
1. DEFLECT 6" WATER LINE UNDER STORM LINES AT CROSSINGS.
  2. INSTALL 4" C.P. SAN. SEWER SERVICES.
  3. SAN. SEWER SERVICES SHALL HAVE 5' COVER AT CURB LINE UNLESS OTHERWISE SHOWN.

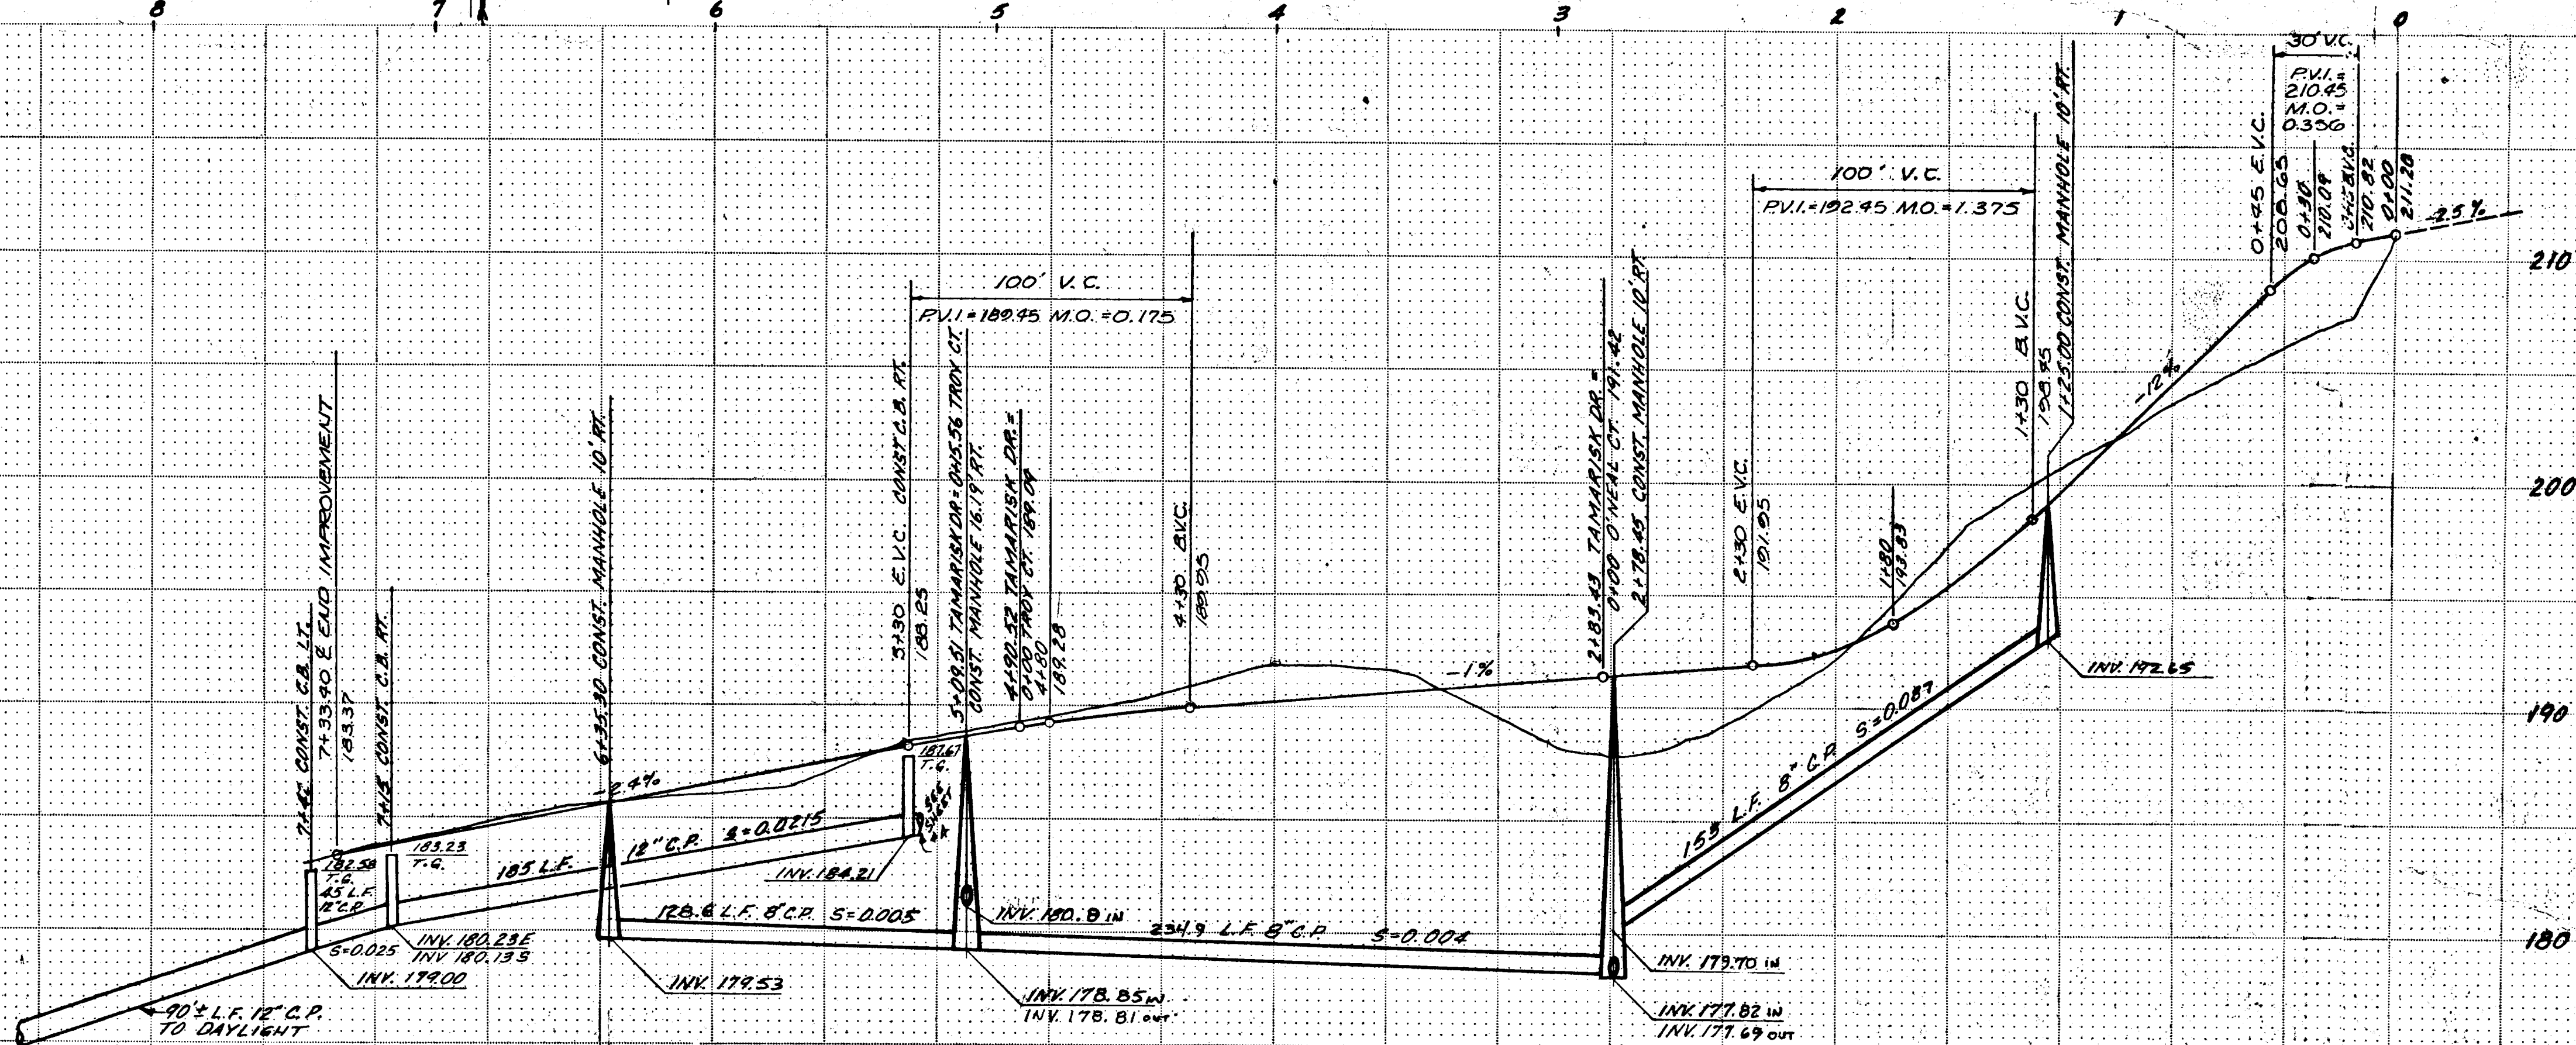

1	SAN. H.S. LOT 6, WATER H.S. LOTS 819	8-27-76	J.A.W.	Designed T.M.
2	AS-BUILT	3-31-77	J.A.W.	Drawn P.E.B. U.N. L.S.
No.	Revisions	Date	By	Checked W.W.H.

Approved  
 Scale HORIZ. 1"=40'  
 Scale VERT. 1"=5'  
 Date JUNE, 1976  
 Parametrix, Inc.

CONSULTANTS IN ENGINEERING  
 AND ENVIRONMENTAL SCIENCES  
 Seattle Spokane Portland Vancouver  
 Eugene Tacoma


COMMONWEALTH PROPERTIES  
 Beaverton, Oregon

Improvement Plans  
 Tamarisk Drive





TAMARISK  
 SUBDIVISION  
 West Linn, Oregon  
 Job No. 56-101-02 P.C.D.

REGISTERED PROFESSIONAL  
 ENGINEER  
 Vella W. H. H. H.  
 1976  
 1977  
 1978  
 32



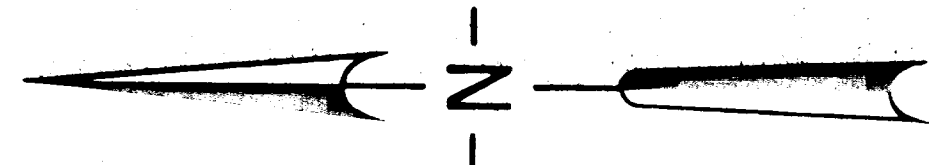

NOTE: WHEN RECONSTRUCTING MH 3-08-87, REMOVE INSIDE DROPS AND INSTALL SERVICE CONNECTIONS AS OUTSIDE DROPS OR AS STANDING CONNECTIONS.

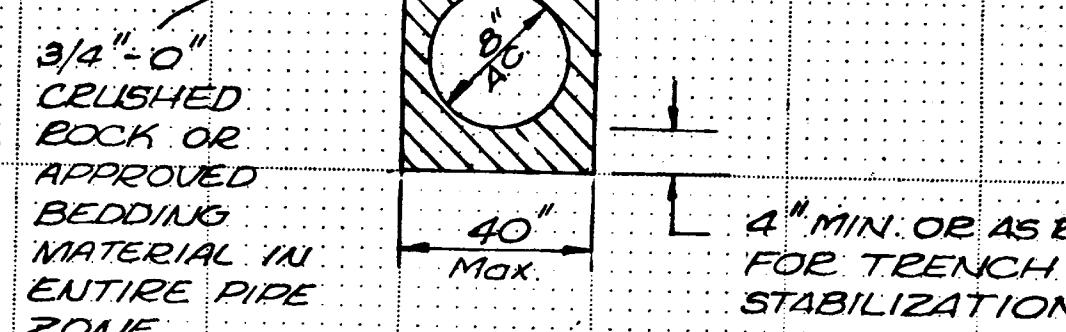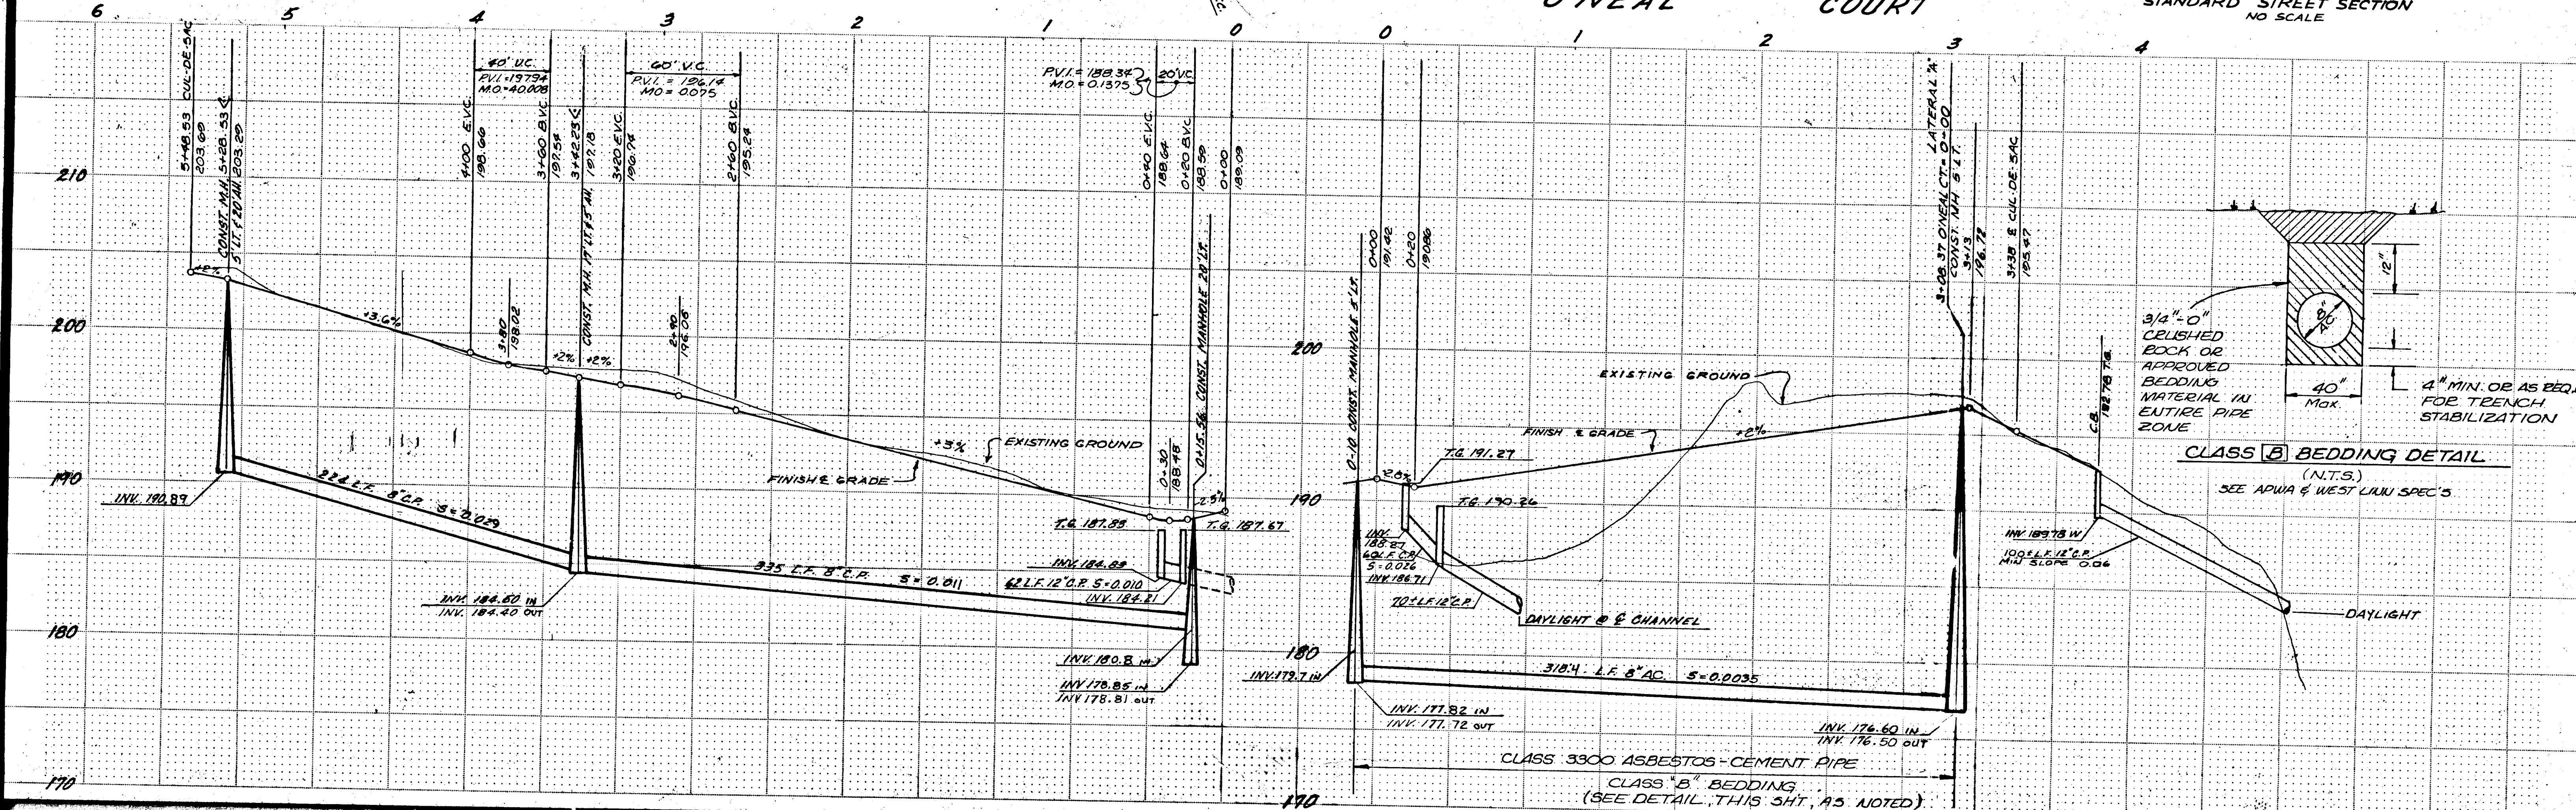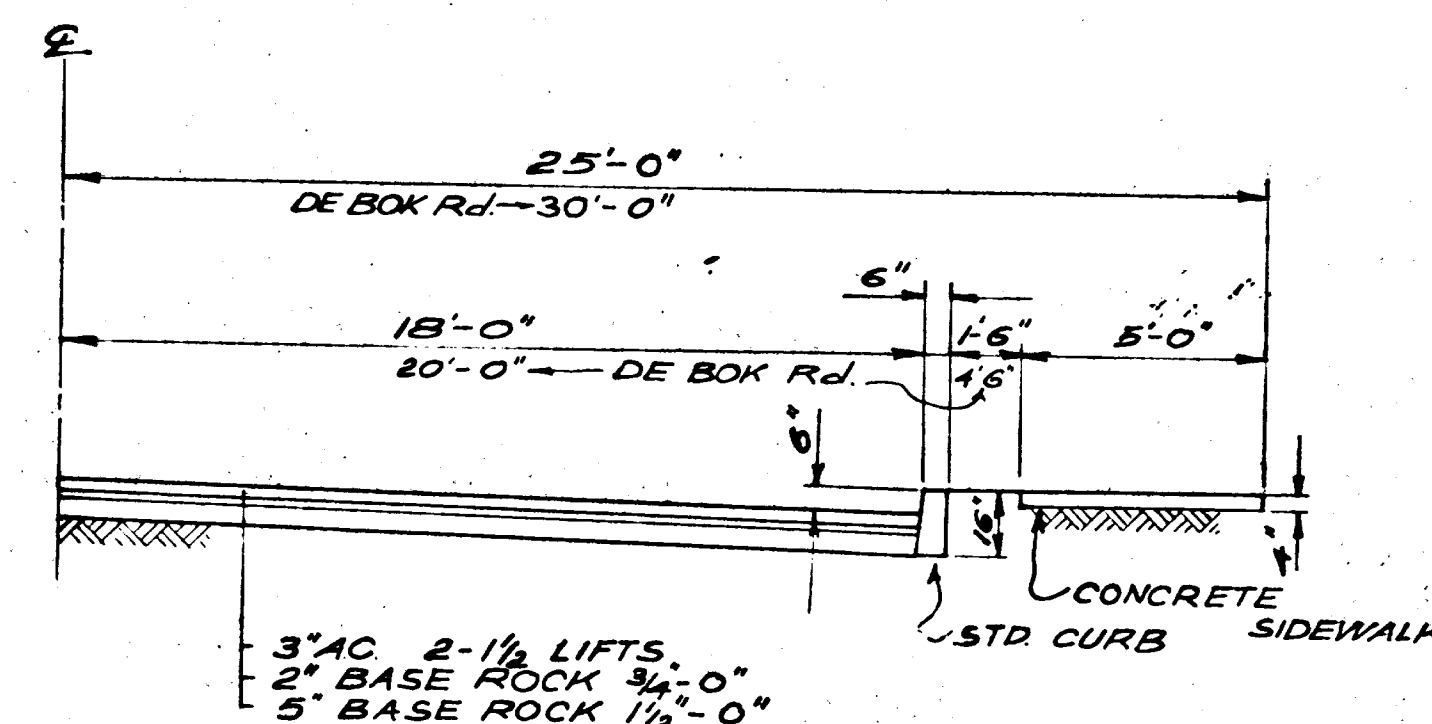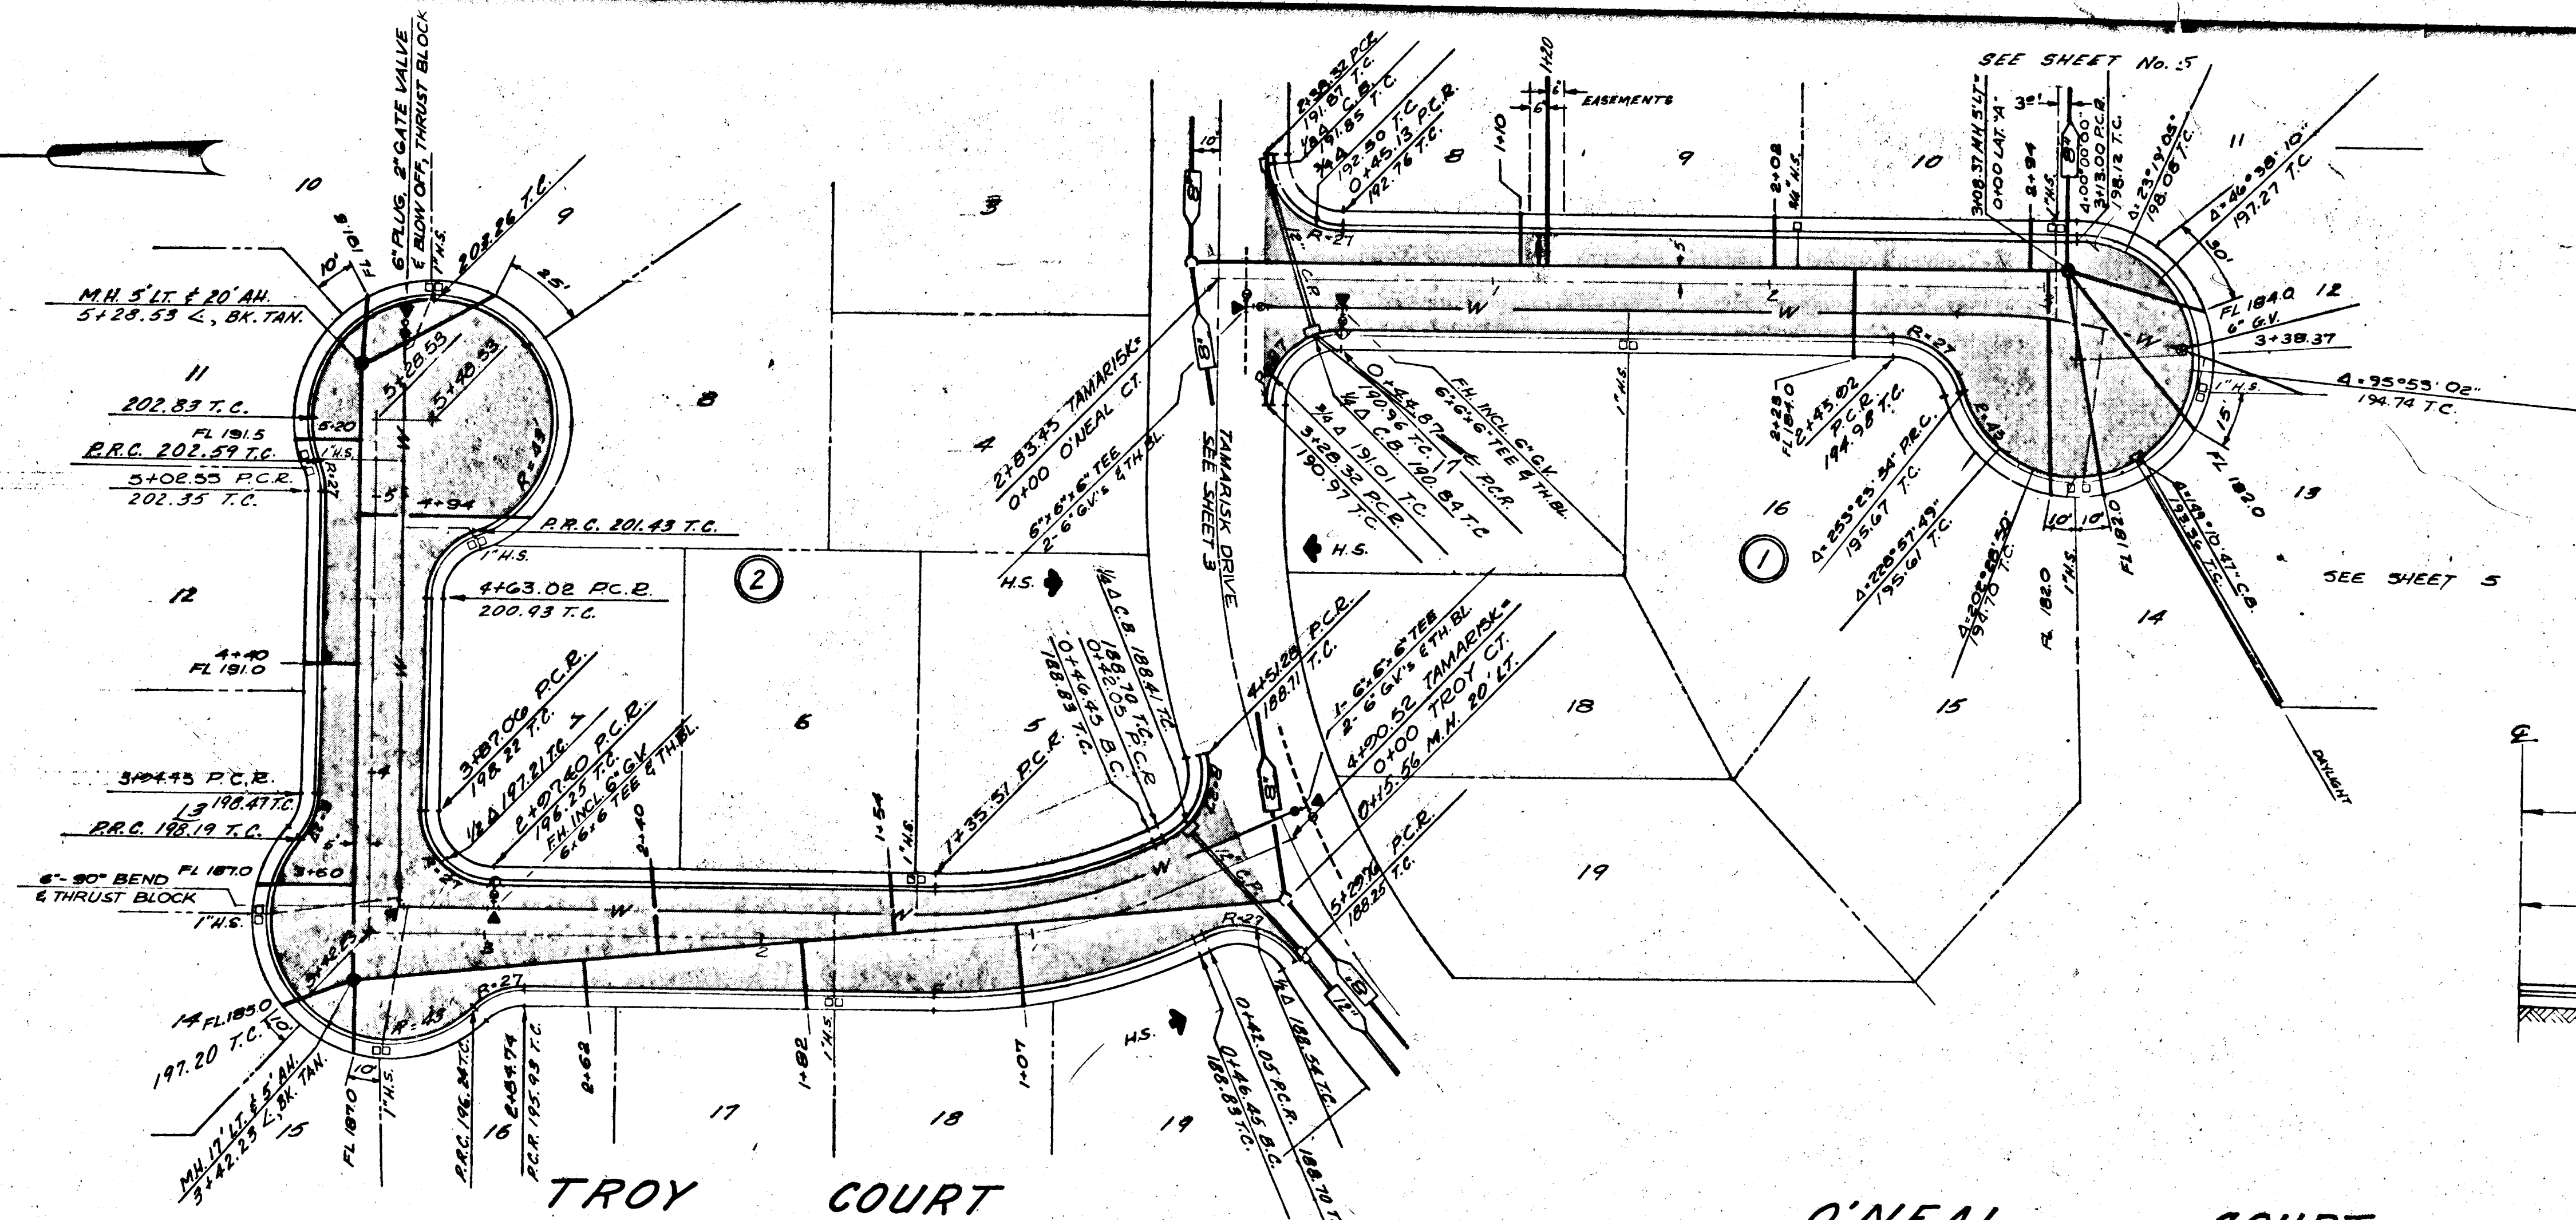

1	SAN. H.S. LOT 6, WTR. H.S. LOTS 8 & 9	8-27-76	J.A.W.	Designed T.M.
2	GRADES, C.B. LOC. O'NEAL COURT	9/9/76	J.A.W.	Drawn P.F.B.
3	PIPE & PROFILE O'NEAL CT RECONSTR.	7/6/77	B.N.	Drawn B.N.
4	AS-BUILT	9/18/77	B.N.	Drawn B.N.
No.	Revisions	Date	By	

Approved  
Scale: HORIZ. 1"=40'  
VERT. 1"=5'  
Date: JUNE, 1976  
Parametrix, Inc.

CONSULTANTS IN ENGINEERING  
AND ENVIRONMENTAL SCIENCES  
Seattle  
Spokane  
Portland  
Eugene  
Tacoma

COMMONWEALTH PROPERTIES  
Beaverton, Oregon

Improvement Plans  
Troy Ct. & O'Neal Ct.

TAMARISK  
SUBDIVISION  
West Linn, Oregon  
Job No. 56-101-02 P-20


REGISTERED PROFESSIONAL  
ENGINEER  
WILLIAM W. HEDGECOCK  
No. 17,156  
State of Oregon

Sheet  
4  
6



NOTE: WHEN RECONSTRUCTING MH 1+32.81 REMOVE INSIDE DROP & INSTALL SERVICE CONNECTIONS AS OUTSIDE DROPS OR AS STANDING CONNECTIONS.

- NOTES:
1. CONTRACTOR SHALL USE CARE TO AVOID UNNECESSARY DAMAGE TO EXISTING TREES, SHRUBBERY & VEGETATION.
  2. TREES SHALL BE SAVED UNLESS OTHERWISE SHOWN OR AS FIELD DIRECTED BY OWNERS REPRESENTATIVE.

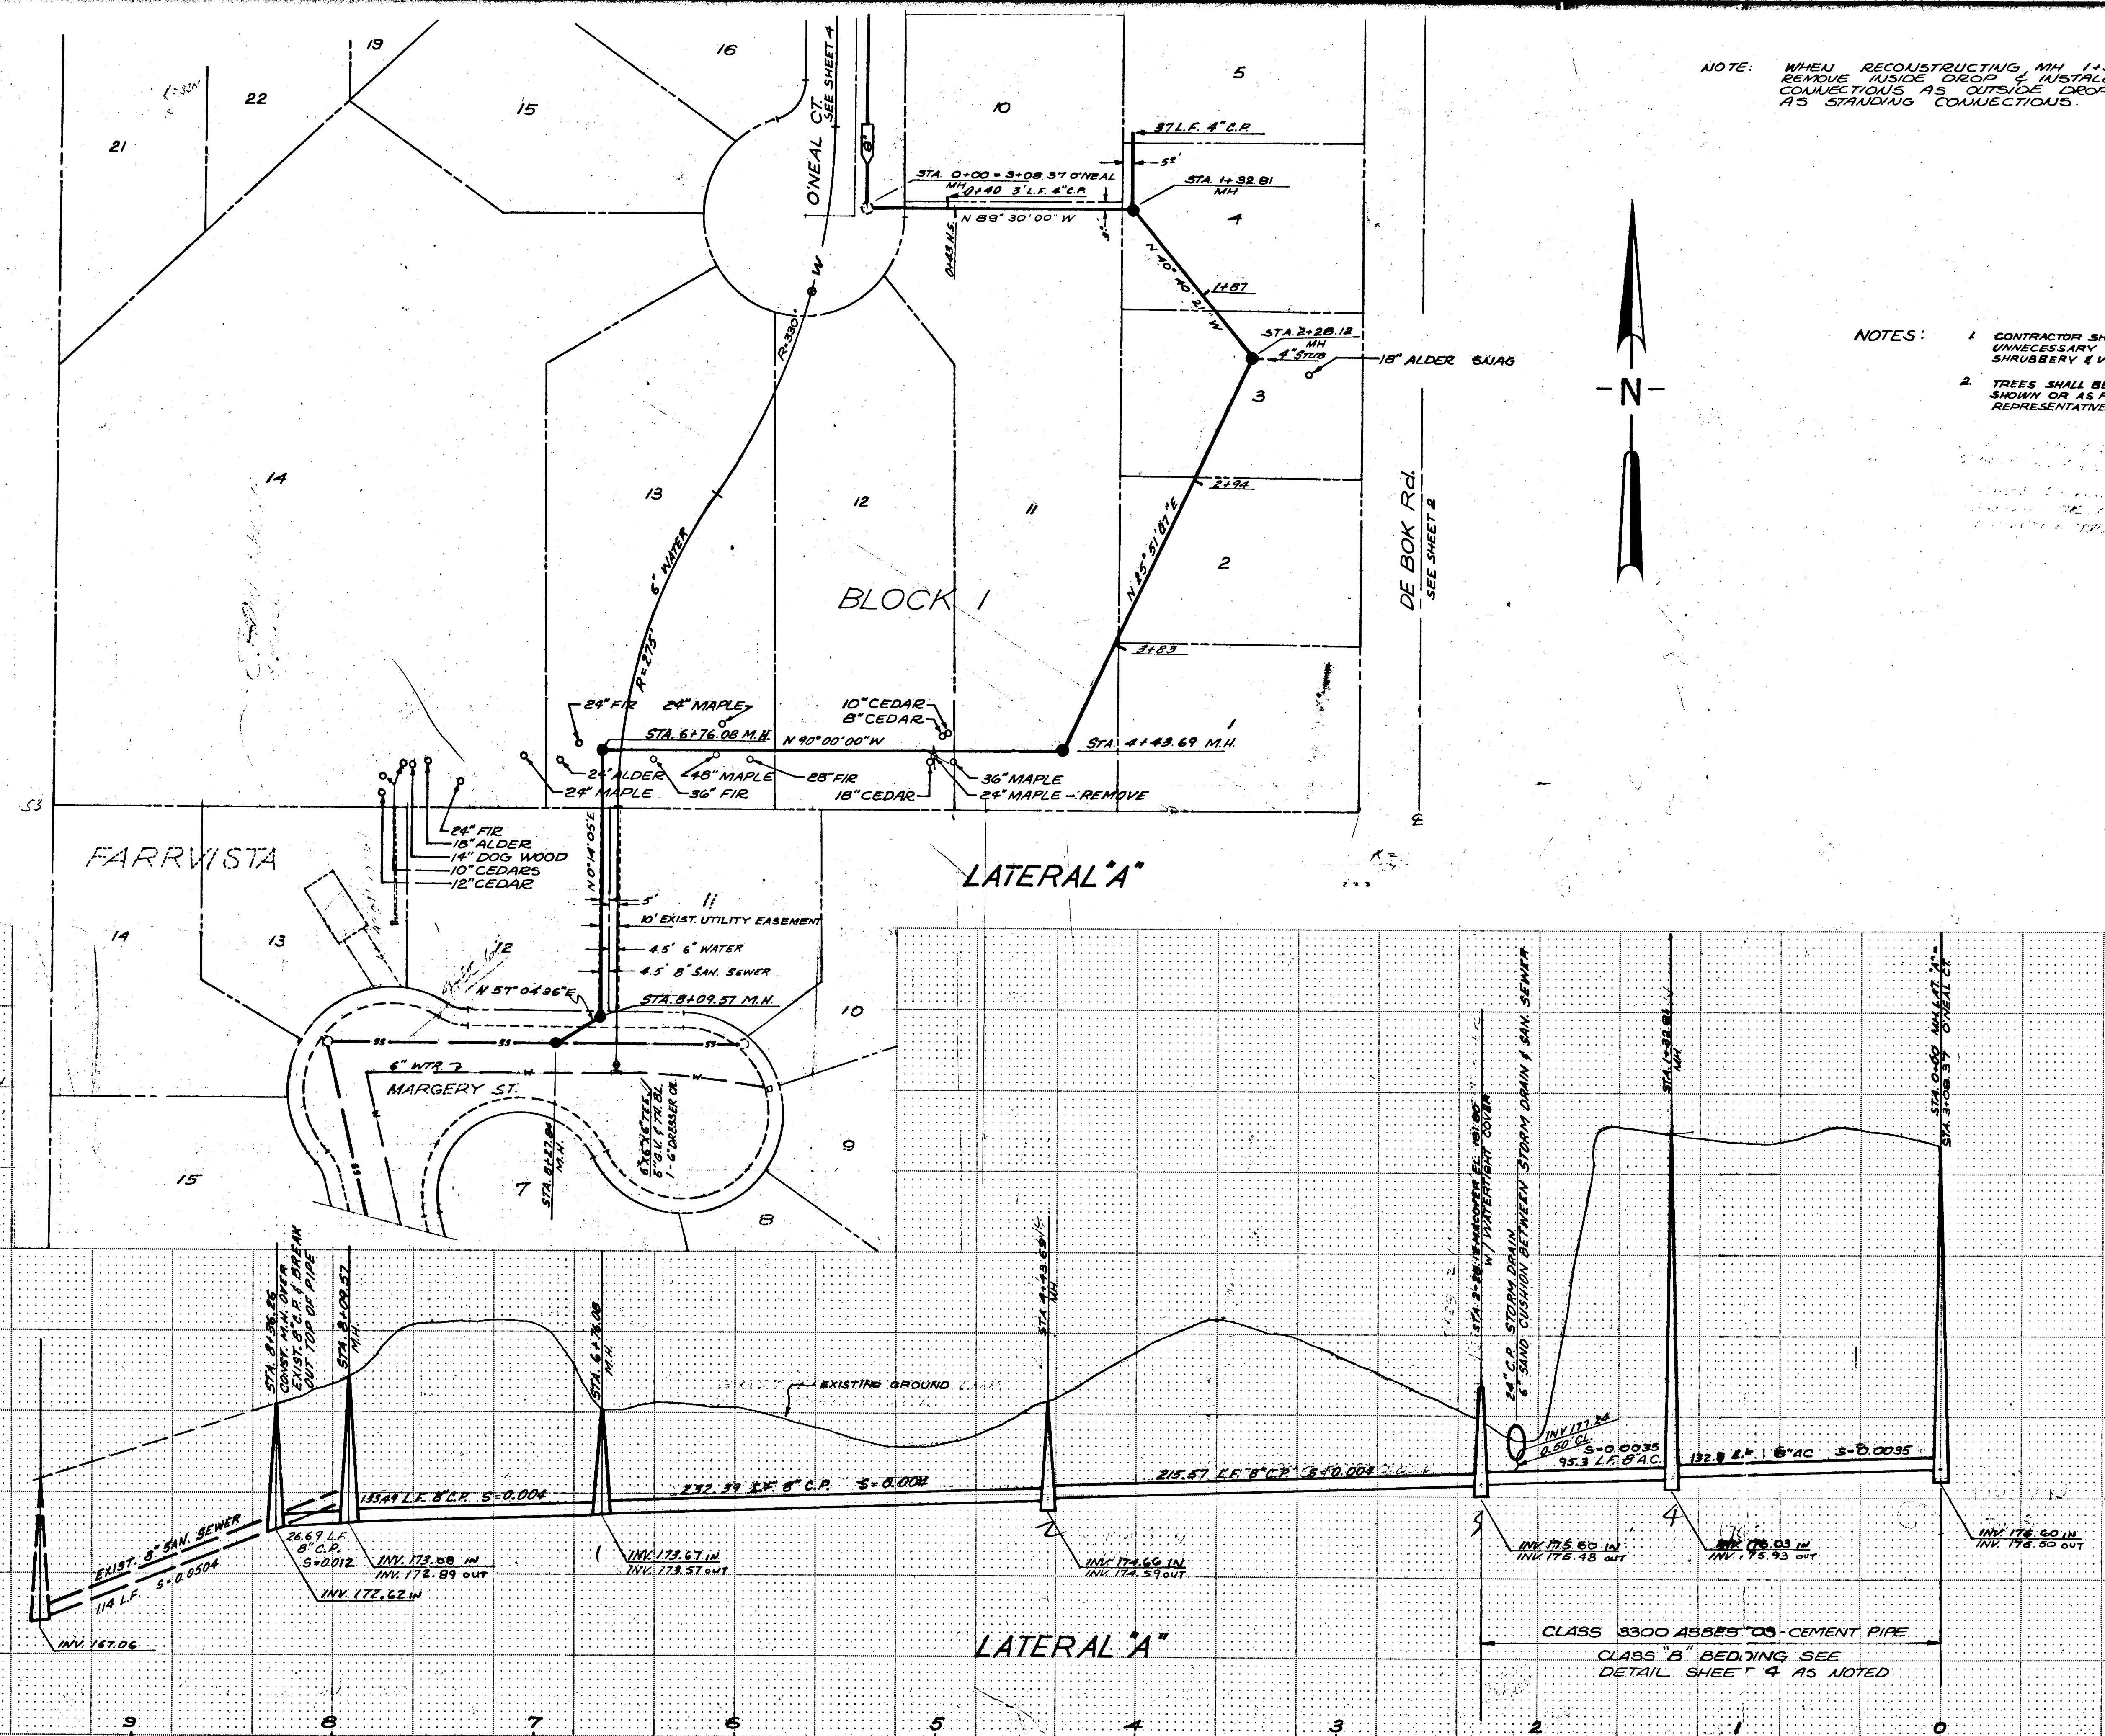

1	REVISED SAN SEWER LAT. A' & MARK	8/10/76	P.F.B.	Designed T.M.
2	PROFILE & PIPE 0+00-2+28 FOR BEDDING	7/6/77	B.N.	Drawn P.F.B.
3	AS-BUILTS	9/18/77	B.N.	Checked L.S. M.N.
No.	Revisions	Date	By	Checked N.W.H.

Approved  
 Scale 1"=40'  
 Date June, 1976  
 Parametrix, Inc.

CONSULTANTS IN ENGINEERING  
 AND ENVIRONMENTAL SCIENCES  
 Seattle  
 Spokane  
 Portland  
 Eugene  
 Tacoma

COMMONWEALTH PROPERTIES  
 Beaverton, Oregon



Sanitary Sewer Lat. "A"  
 & Water

TAMARISK  
 SUBDIVISION  
 West Linn, Oregon  
 Job No. 56-101-02 PC20

REGISTERED PROFESSIONAL ENGINEER  
 5024  
 WALTER W. JONES  
 CIVIL  
 OREGON  
 EXPIRATION DATE 12-15-81  
 SEATTLE W. HUFFMAN

Sheet  
 5  
 6



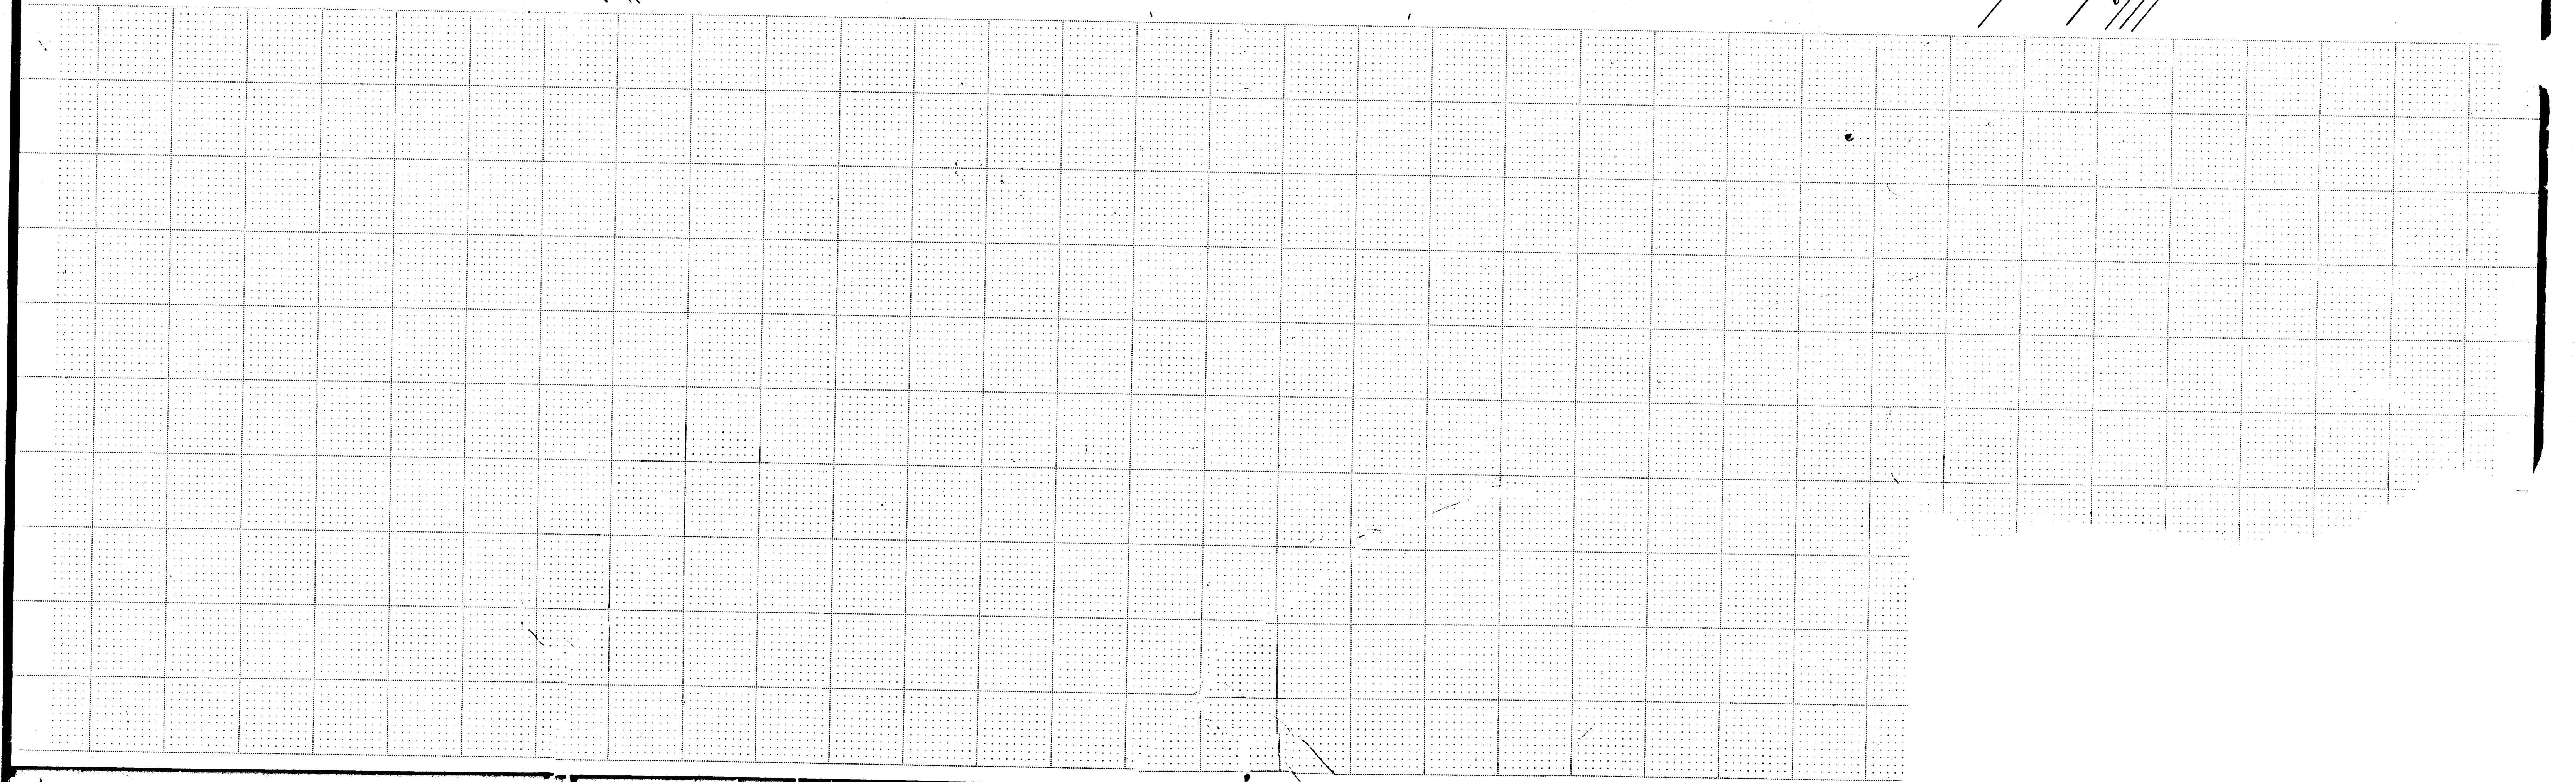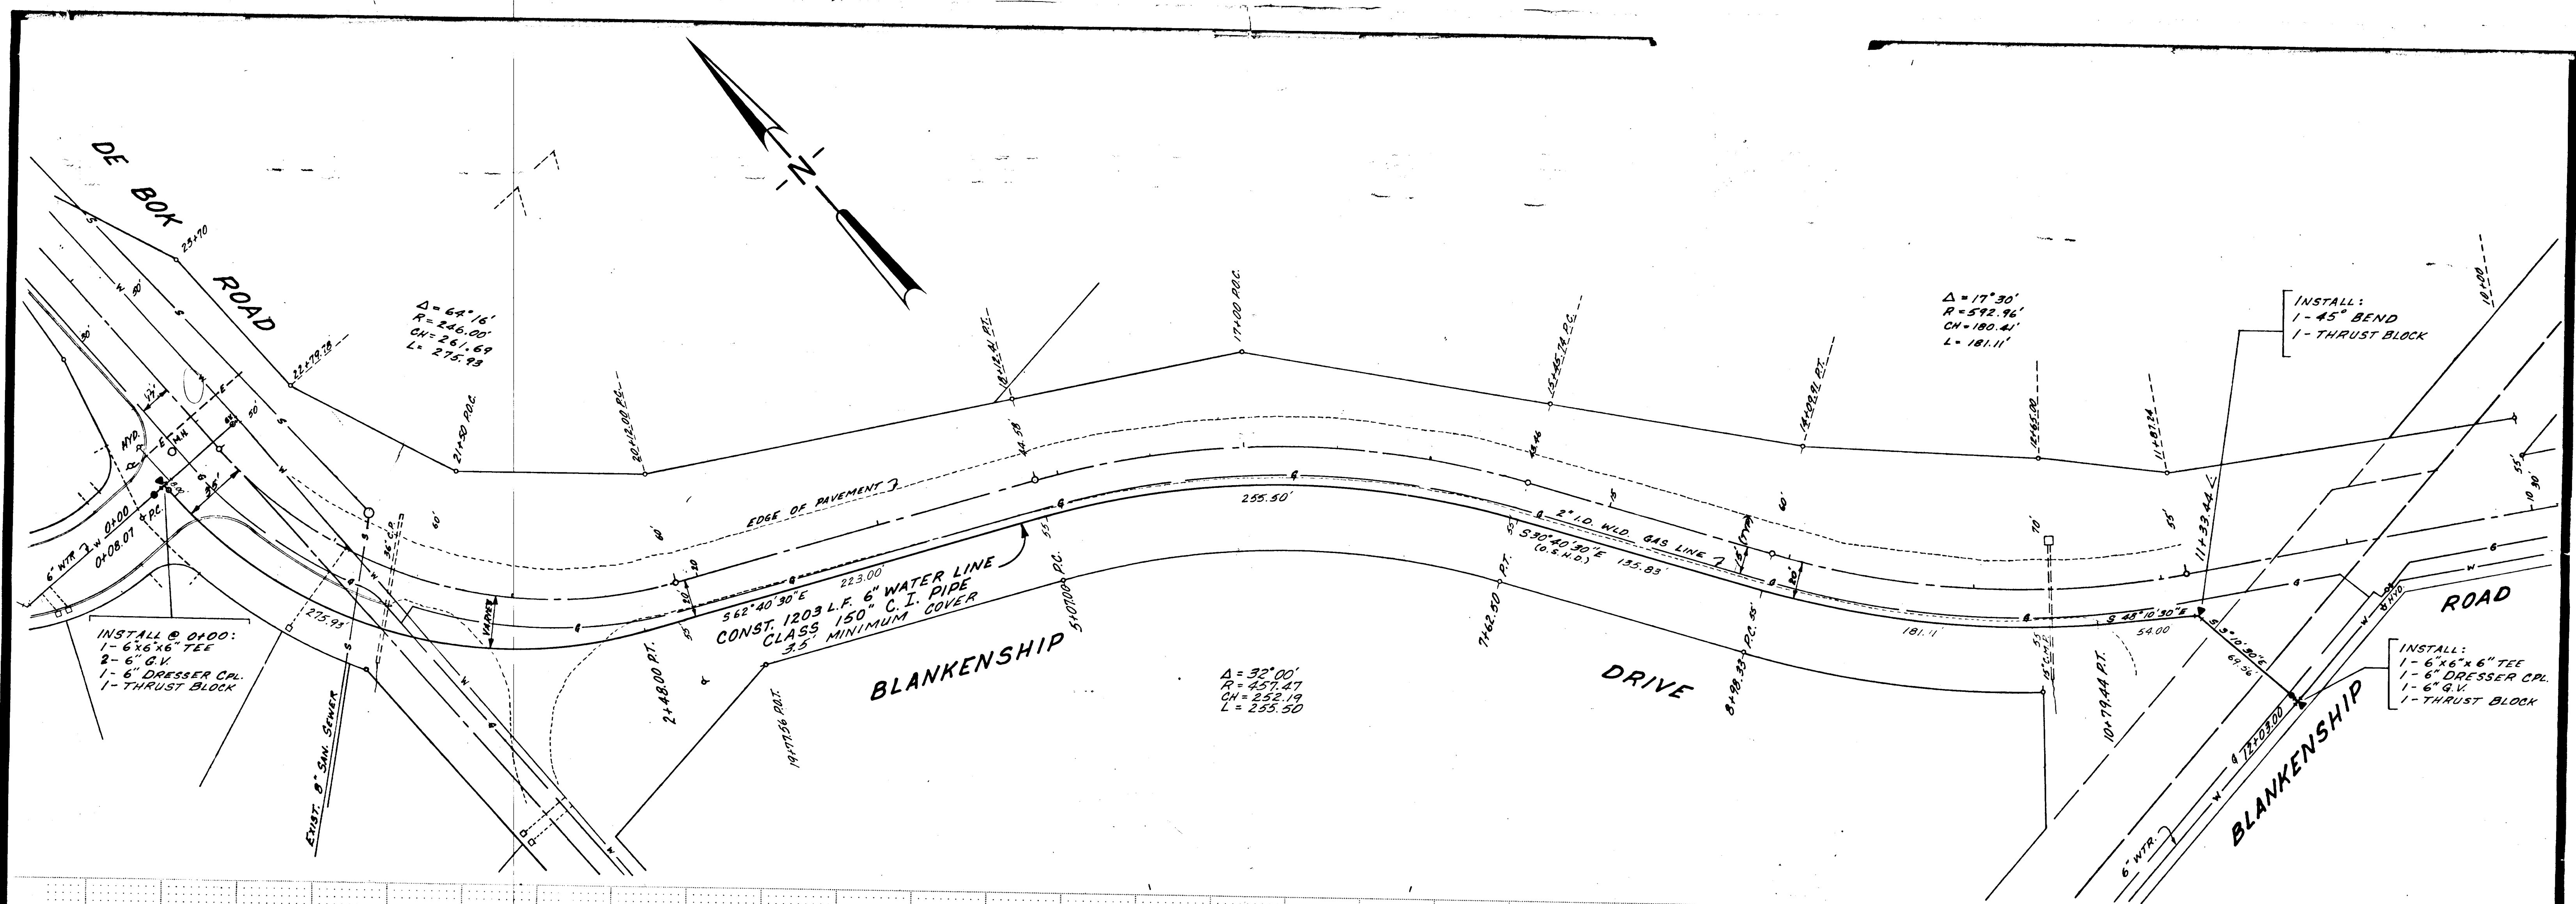

1 AS-BUILT		3-31-77	J.A.W.
Designed T.M.			
Drawn P.F.B.			
Checked W.W.H.			
No.	Revisions	Date	By

Approved  
 Scale Horiz. 1"=40' Date JUNE, 1976  
**Parametrix, Inc.**

**PARAMETRIX**  
 CONSULTANTS IN ENGINEERING  
 AND ENVIRONMENTAL SCIENCE  
 Seattle  
 Spokane  
 Portland  
 Eugene  
 Tacoma


**COMMONWEALTH PROPERTIES**  
 Beaverton, Oregon



## **Second Scan**

**This As-Built was scanned twice due to illegibility issues of the original scan.**



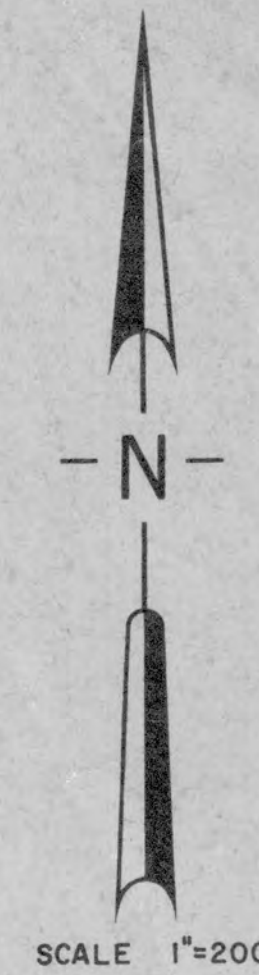

# TAMARISK SUBDIVISION


WEST LINN, OREGON

As-Built 3-31-77








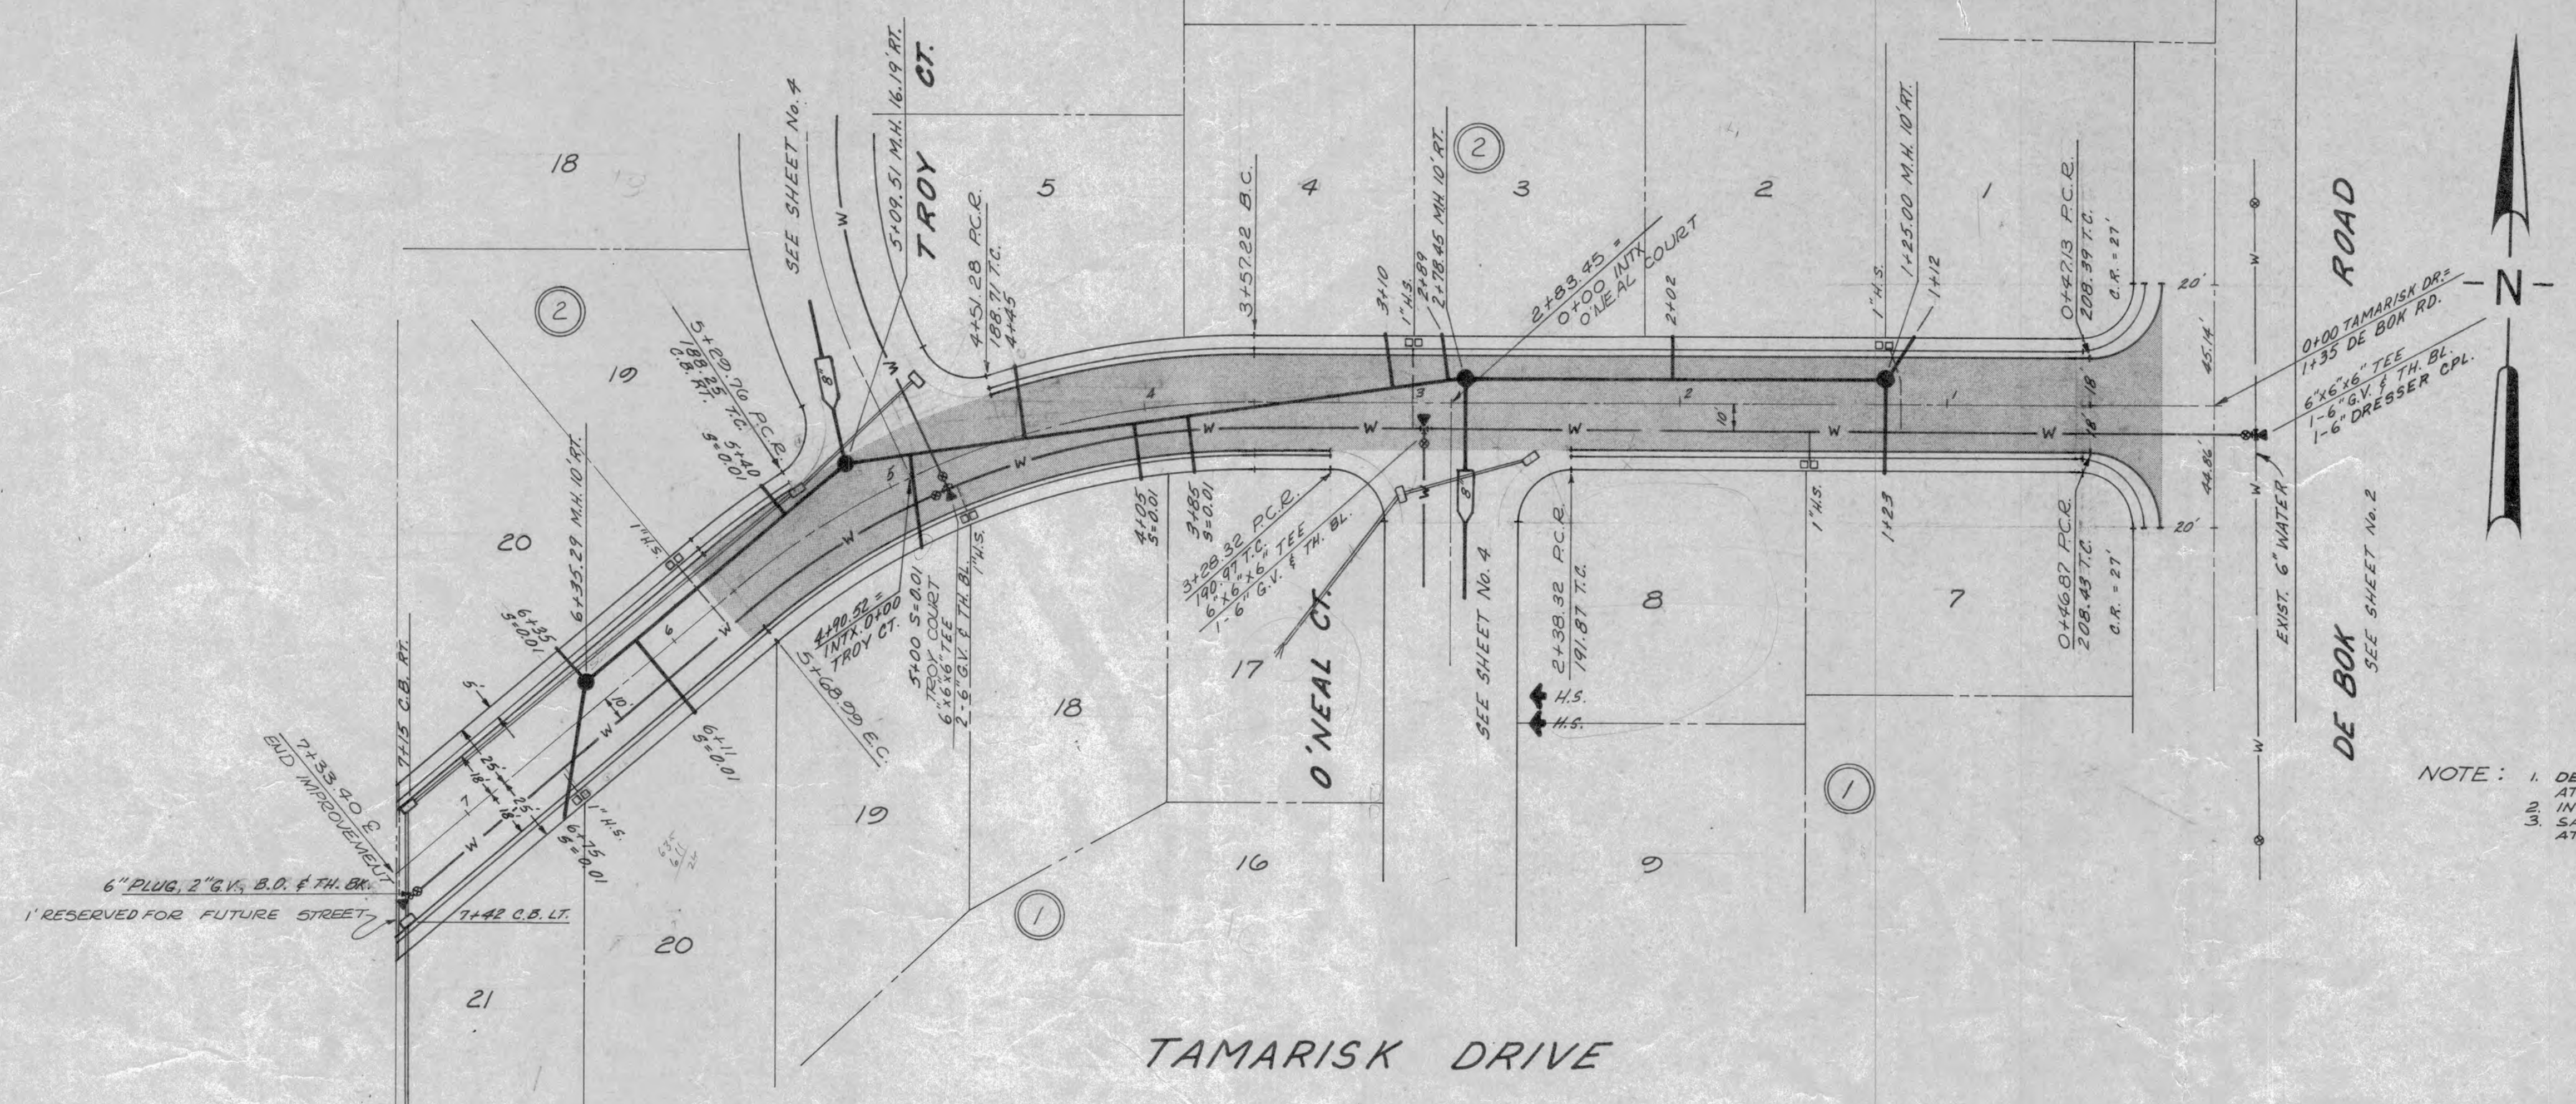

- NOTE:
1. DEFLECT 6" WATER LINE UNDER STORM LINES AT CROSSINGS.
  2. INSTALL 4" C.P. SAN. SEWER SERVICES.
  3. SAN. SEWER SERVICES SHALL HAVE 5' COVER AT CURB LINE UNLESS OTHERWISE SHOWN.

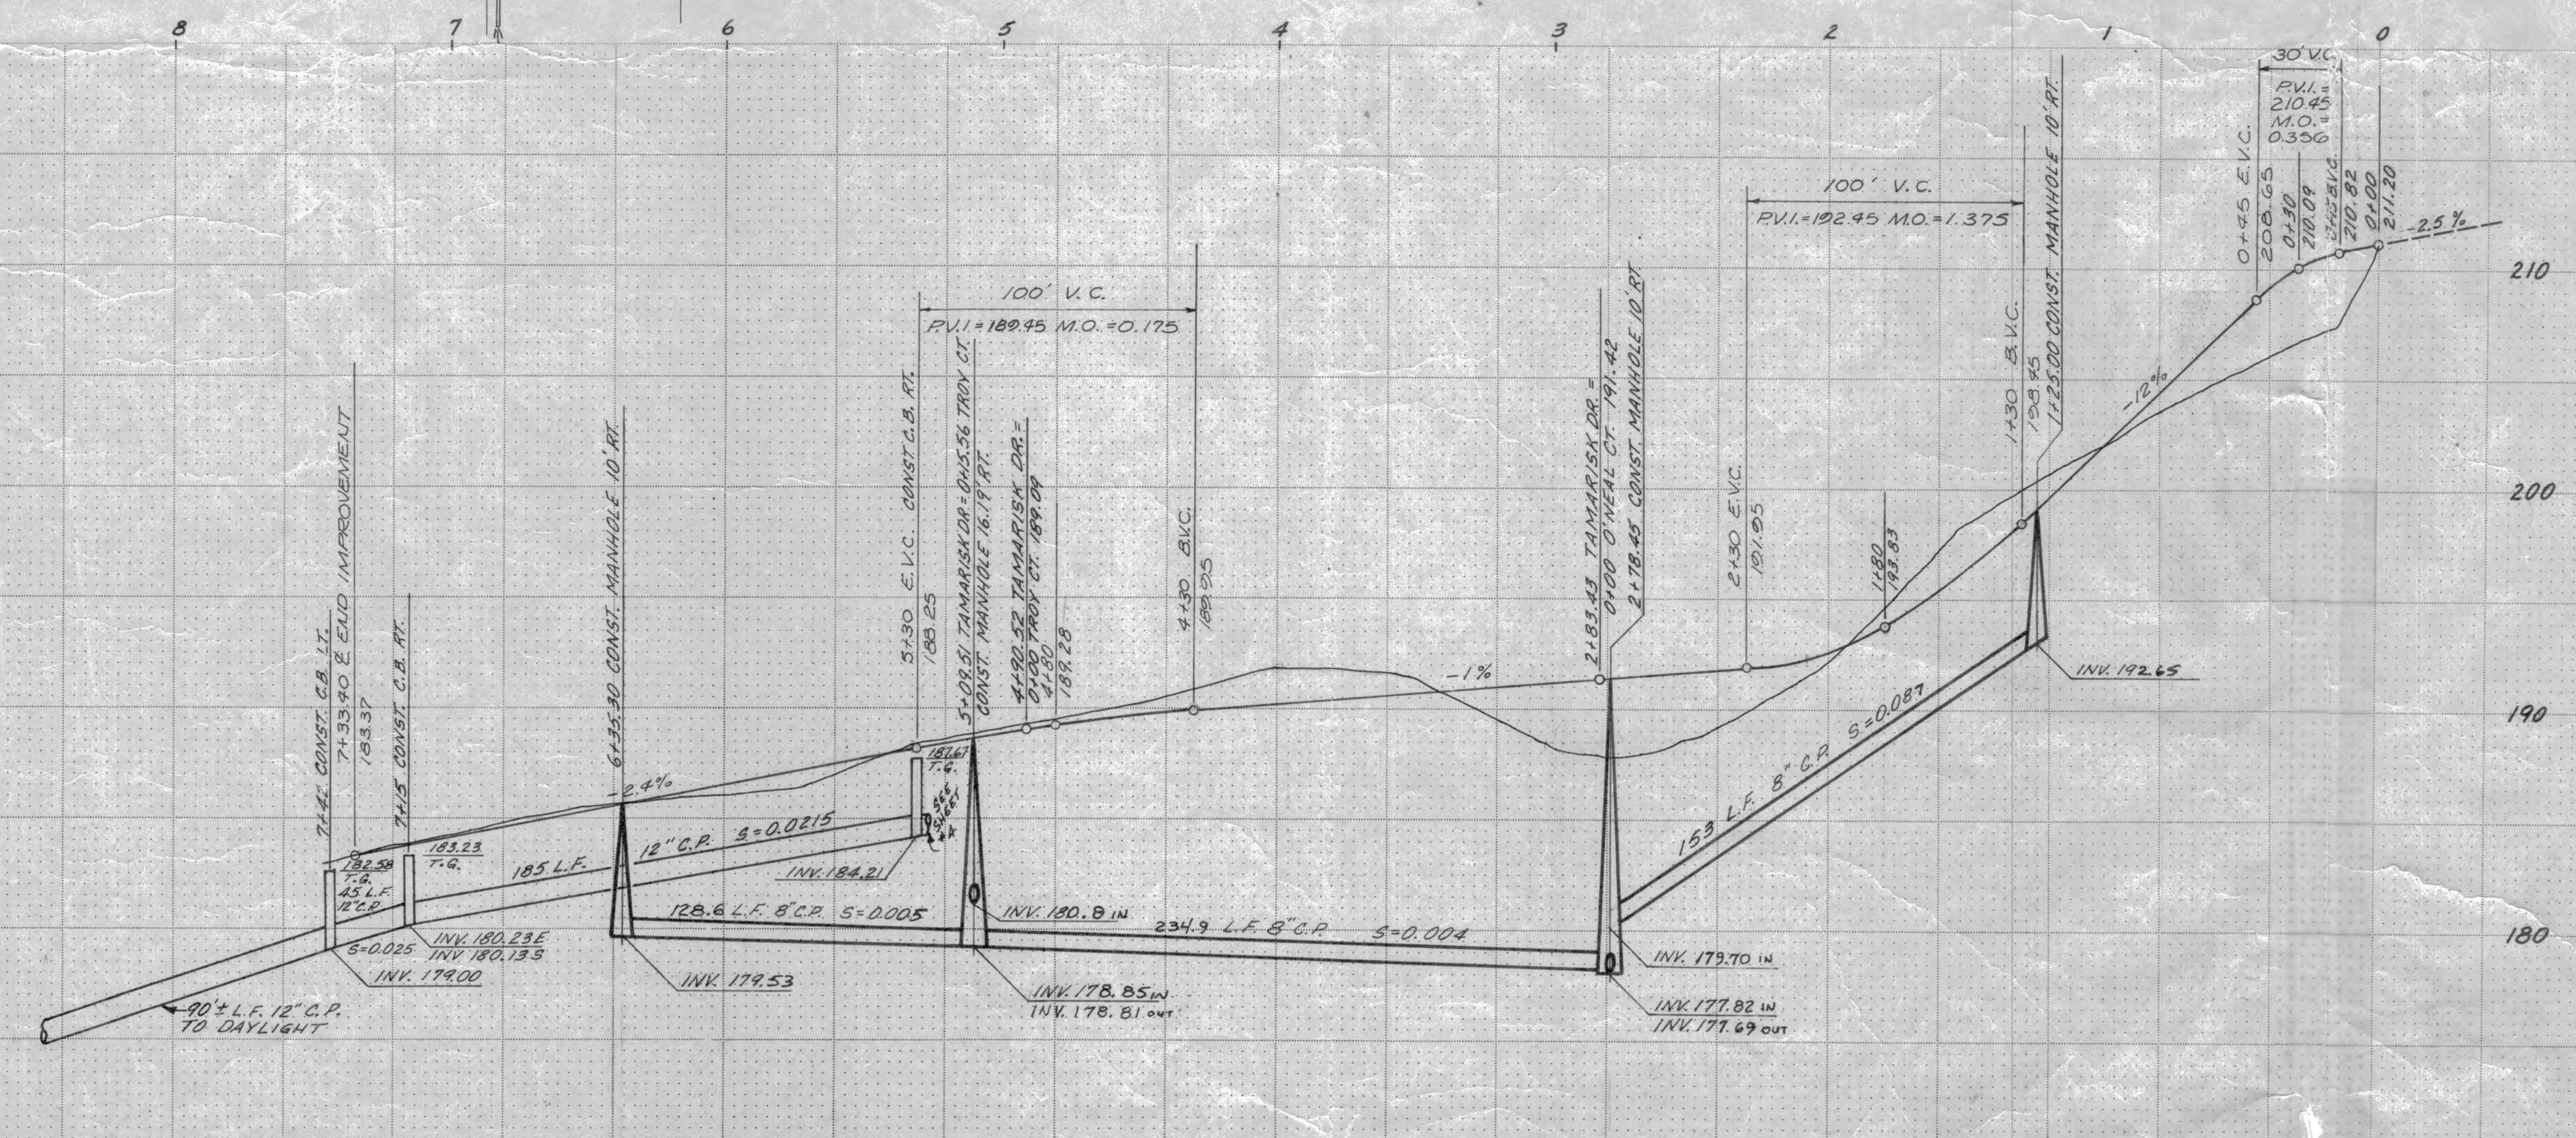

1	SAN. H.S. LOT 6, WATER H.S. LOTS 8 & 9	8-27-76	J.A.W.	Designed T.M.
2	AS-BUILT	3-31-77	J.H.W.	Drawn R.F.B. J.H.W. L.S.
No.	Revisions	Date	By	Checked W.W.H.

Approved  
HORIZ. 1"=40'  
Scale VERT. 1"=5'  
Date JUNE, 1976  
**Parametrix, Inc.**

**CONSULTANTS IN ENGINEERING AND ENVIRONMENTAL SCIENCES**  
Seattle  
Spokane  
Portland-Vancouver  
Eugene  
Tacoma

**COMMONWEALTH PROPERTIES**  
Beaverton, Oregon


**Improvement Plans**  
Tamarisk Drive

**TAMARISK SUBDIVISION**  
West Linn, Oregon  
Job No. 56-101-02 PC 20



REGISTERED PROFESSIONAL ENGINEER  
William W. Fisher  
JULY 13, 1973  
STATE OF OREGON

Sheet  
3  
6





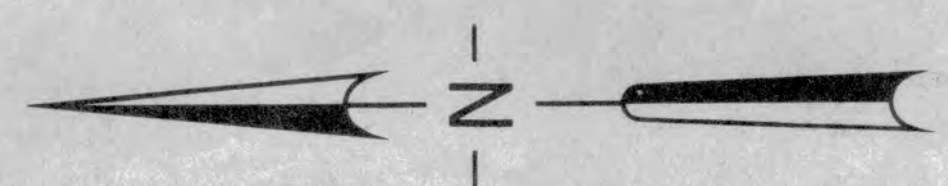

NOTE: WHEN RECONSTRUCTING MH 3-08.37, REMOVE INSIDE DROPS AND INSTALL SERVICE CONNECTIONS AS OUTSIDE DROPS OR AS STANDING CONNECTIONS.

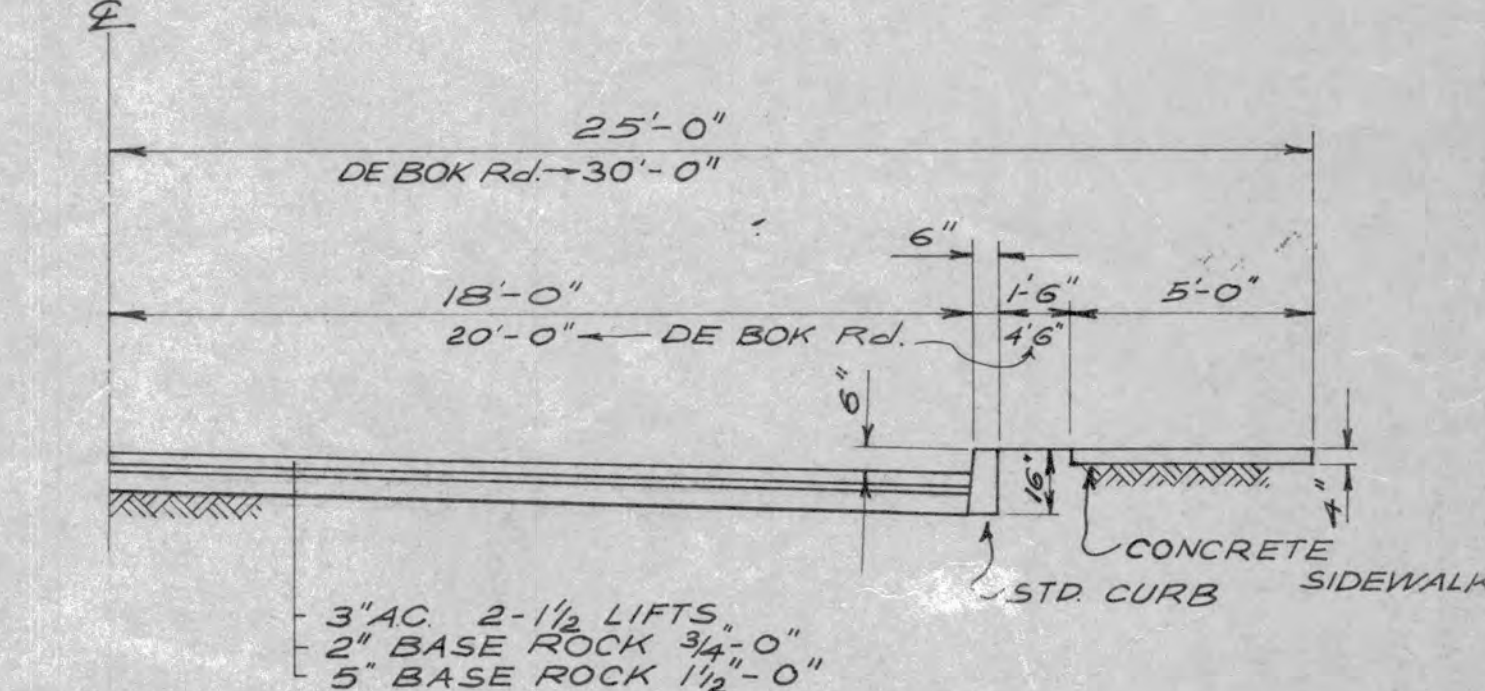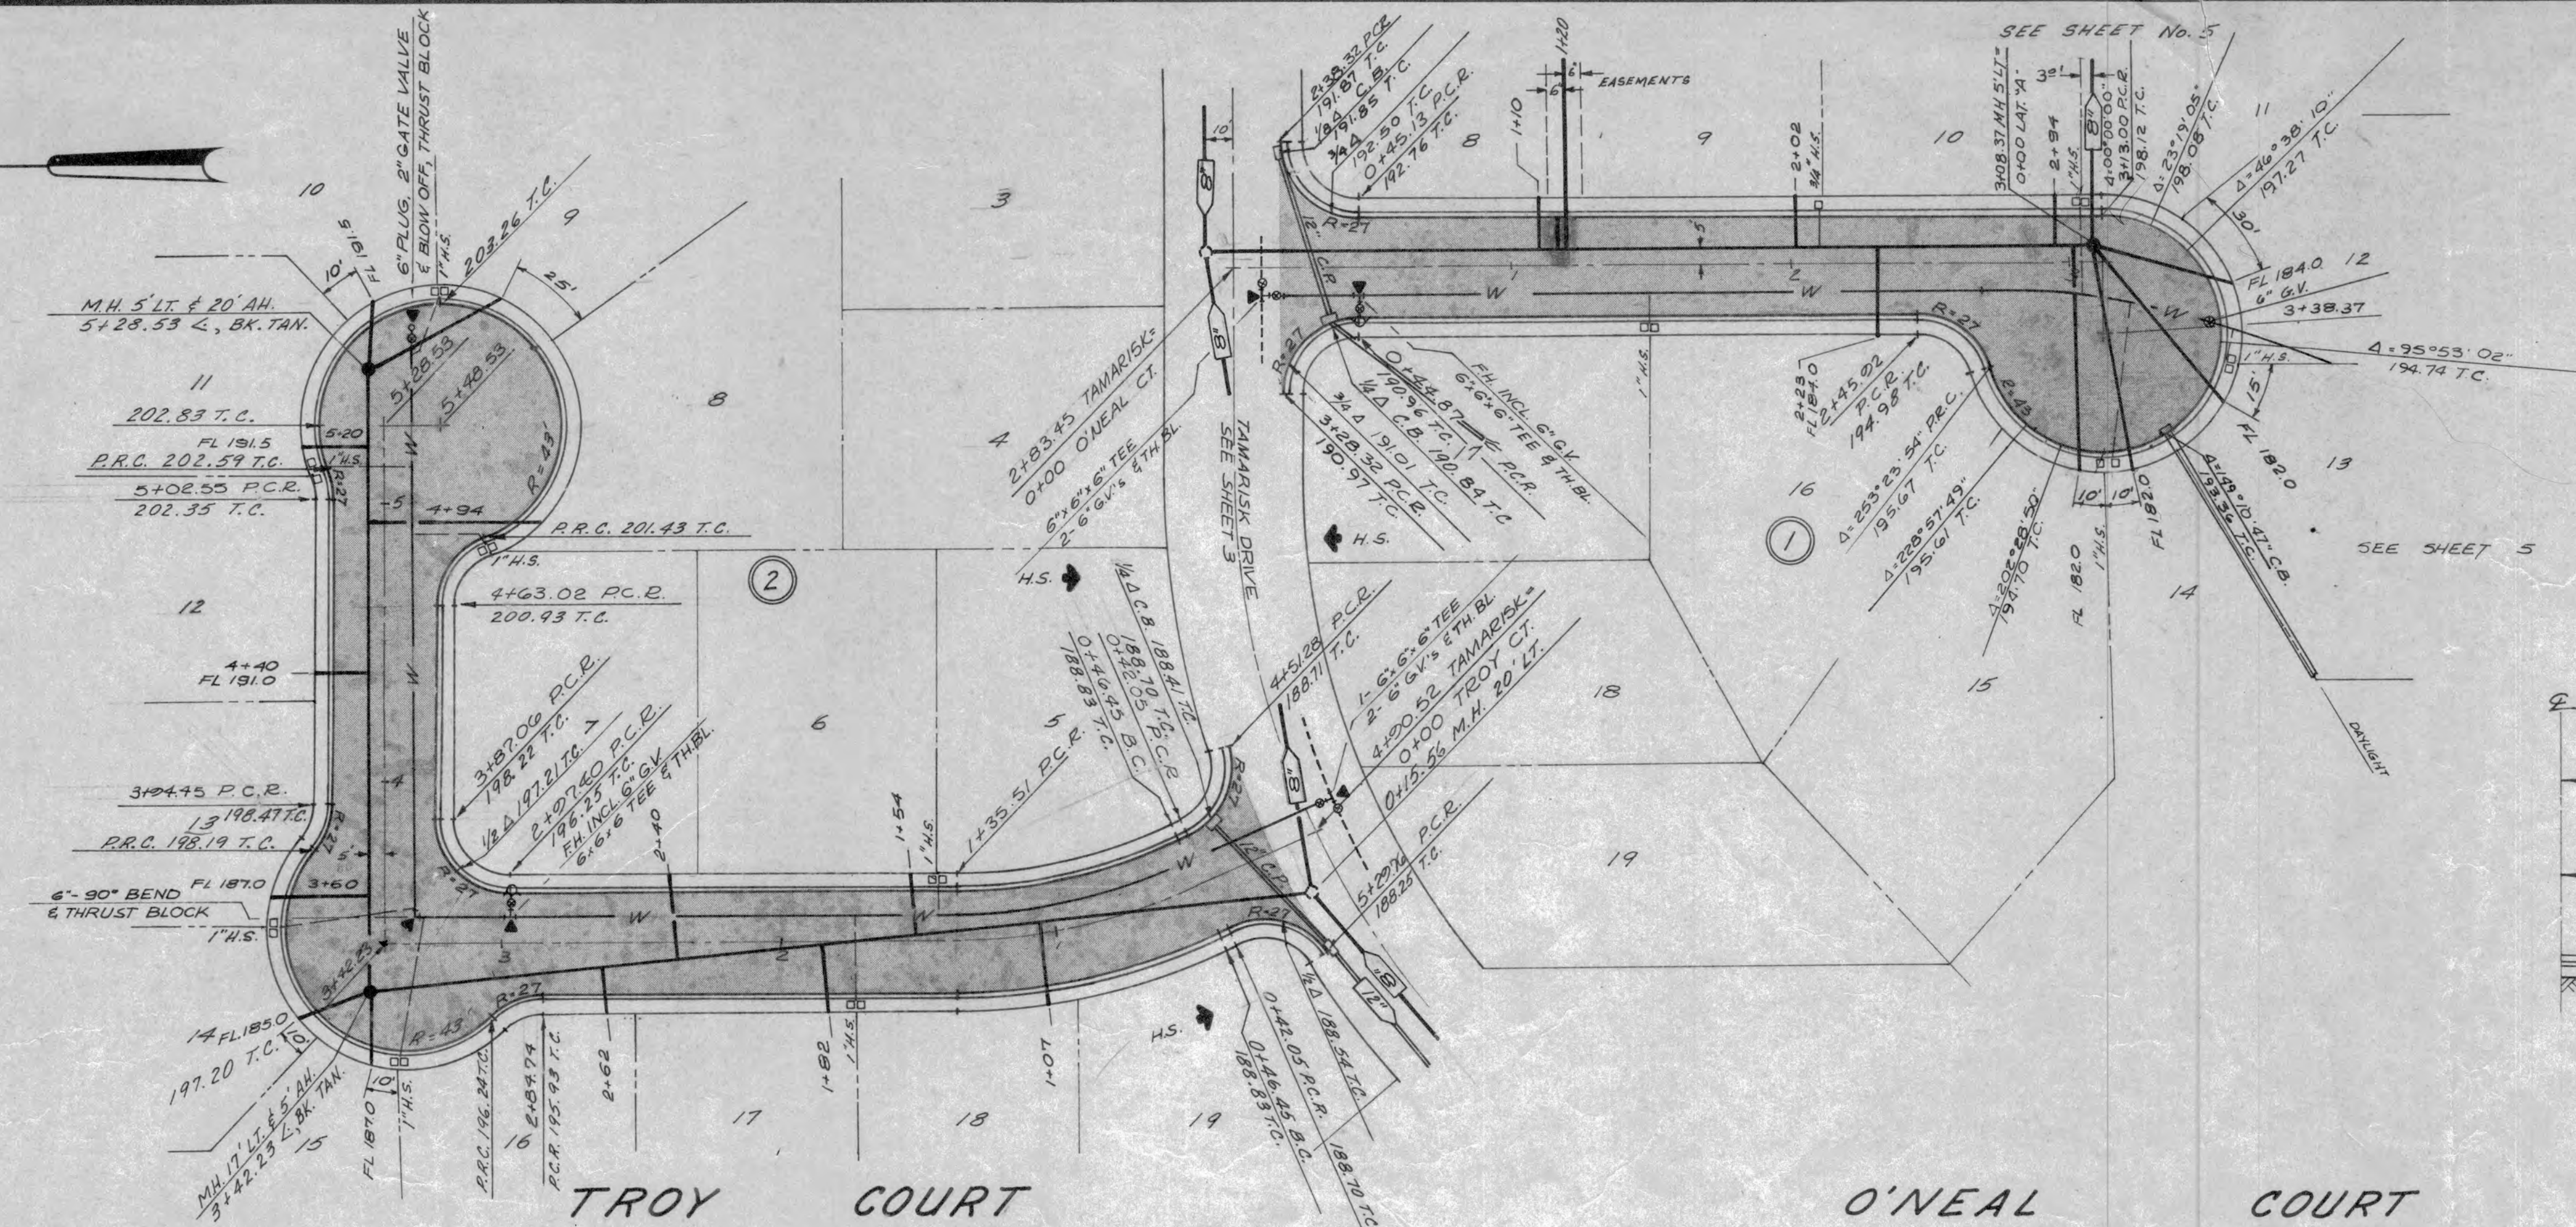

STANDARD STREET SECTION  
NO SCALE

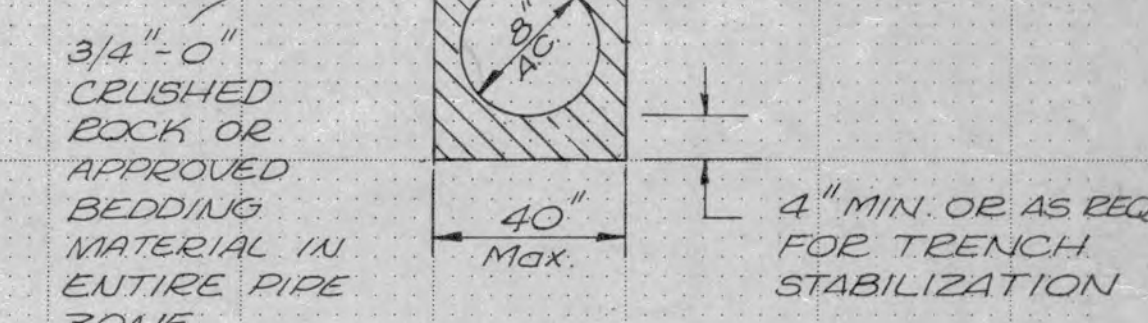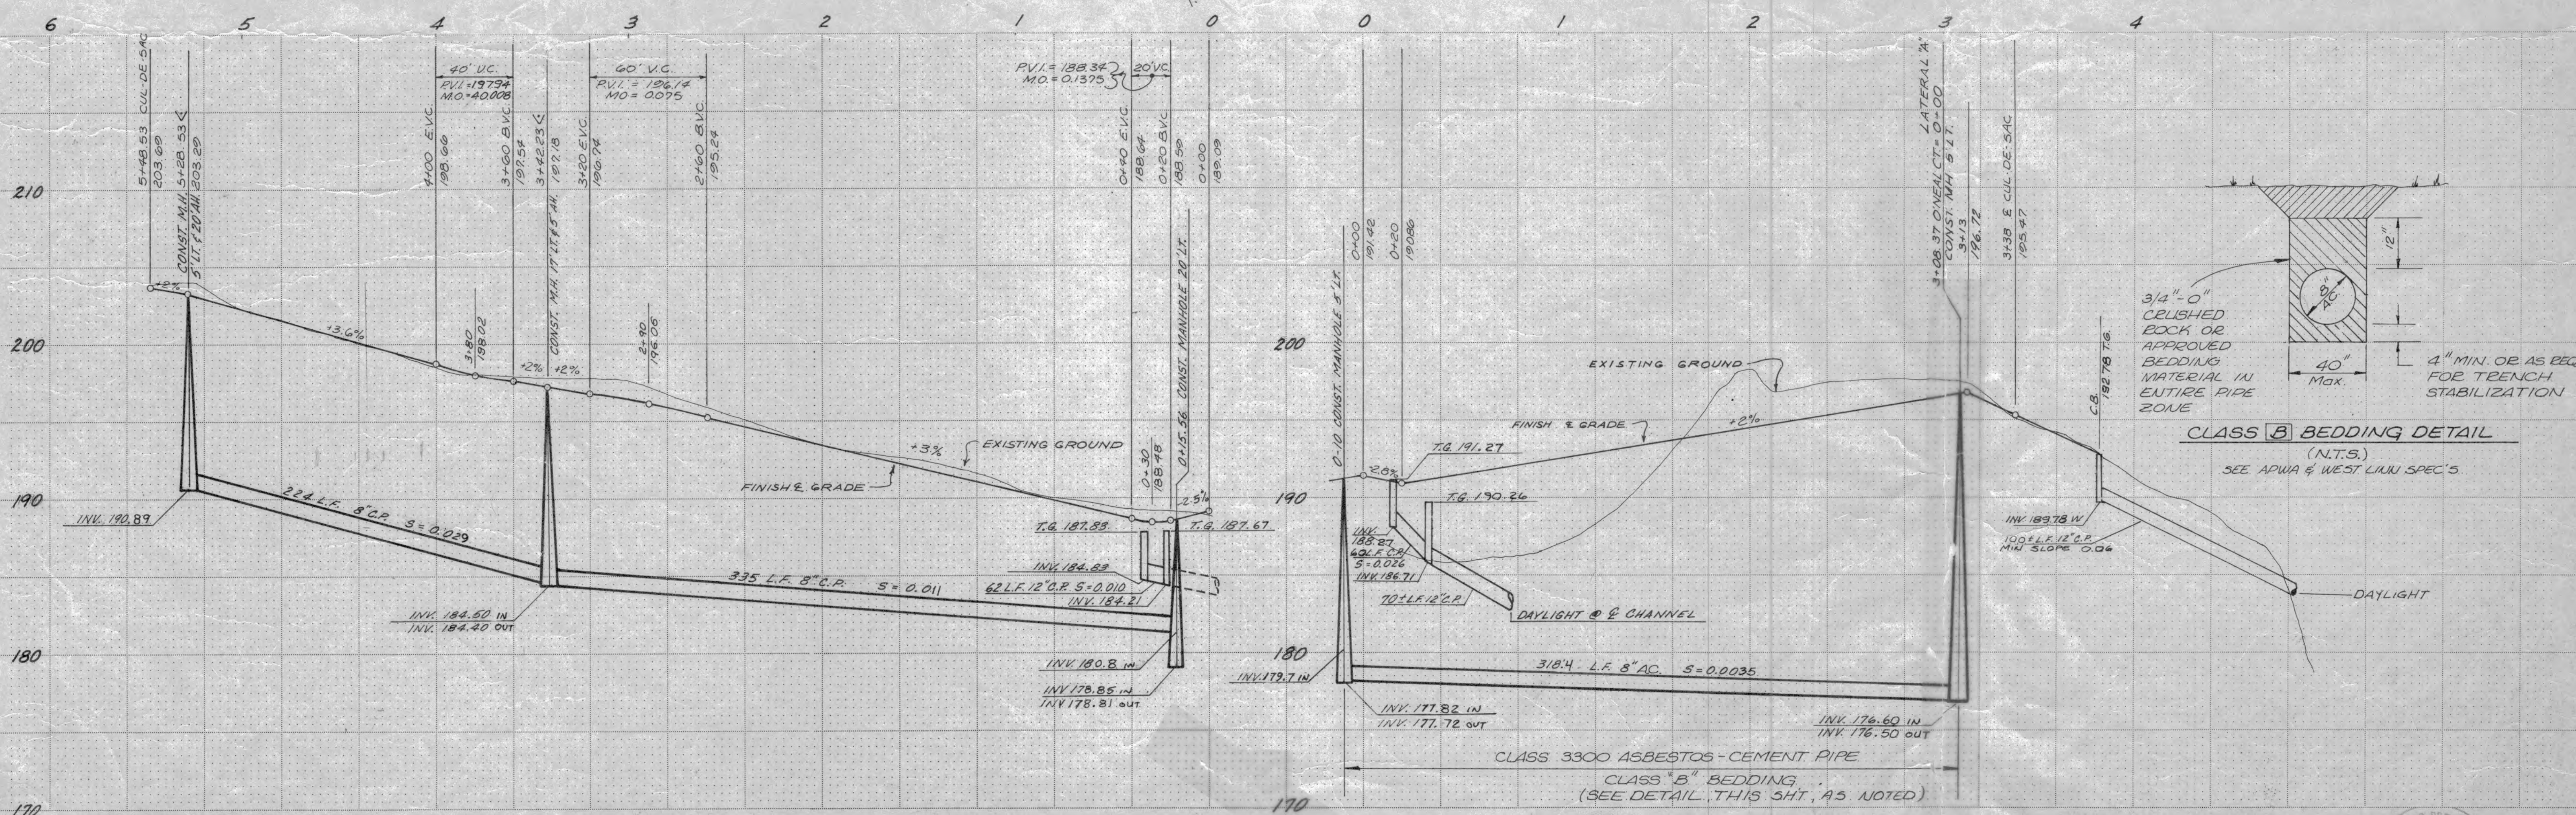

CLASS B BEDDING DETAIL  
(N.T.S.)  
SEE ADWA & WEST LINN SPEC'S.

1	SAN. H.S. LOT 6, WTR. H.S. LOTS 8 & 9	8-27-76	J.A.W.
2	GRADES, C.B. LOC. O'NEAL COURT	9/9/76	J.A.W.
3	PIPE & PROFILE O'NEAL CT RECONSTR.	7/6/77	B.N.
4	AS-BUILT	9/18/77	B.N.
No.	Revisions	Date	By

Designed T.M.  
Approved  
Scale HORIZ. 1"=40'  
VERT. 1"=5'  
Date JUNE, 1976  
Parametrix, Inc.

CONSULTANTS IN ENGINEERING  
AND ENVIRONMENTAL SCIENCES  
Seattle  
Spokane  
Portland-Vancouver  
Eugene  
Tacoma

COMMONWEALTH PROPERTIES  
Beaverton, Oregon

Improvement Plans  
Troy Ct. & O'Neal Ct.





TAMARISK  
SUBDIVISION  
West Linn, Oregon  
Job No. 56-101-02

7-22-76



NOTE: WHEN RECONSTRUCTING, MH 1+32.81 REMOVE INSIDE DROP & INSTALL SERVICE CONNECTIONS AS OUTSIDE DROPS OR AS STANDING CONNECTIONS.

- NOTES:
1. CONTRACTOR SHALL USE CARE TO AVOID UNNECESSARY DAMAGE TO EXISTING TREES, SHRUBBERY & VEGETATION.
  2. TREES SHALL BE SAVED UNLESS OTHERWISE SHOWN OR AS FIELD DIRECTED BY OWNERS REPRESENTATIVE

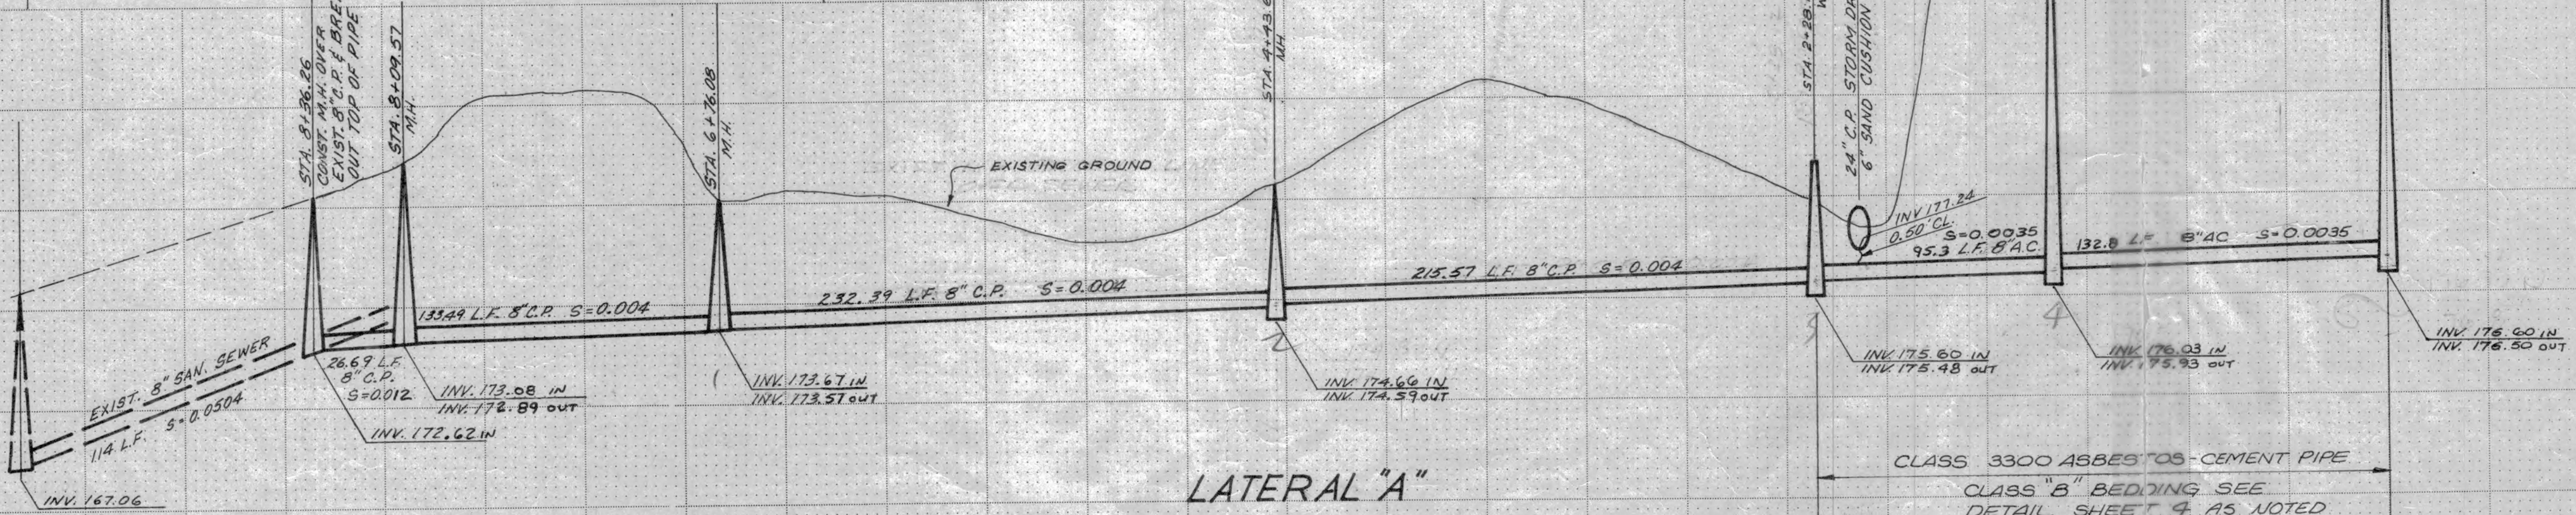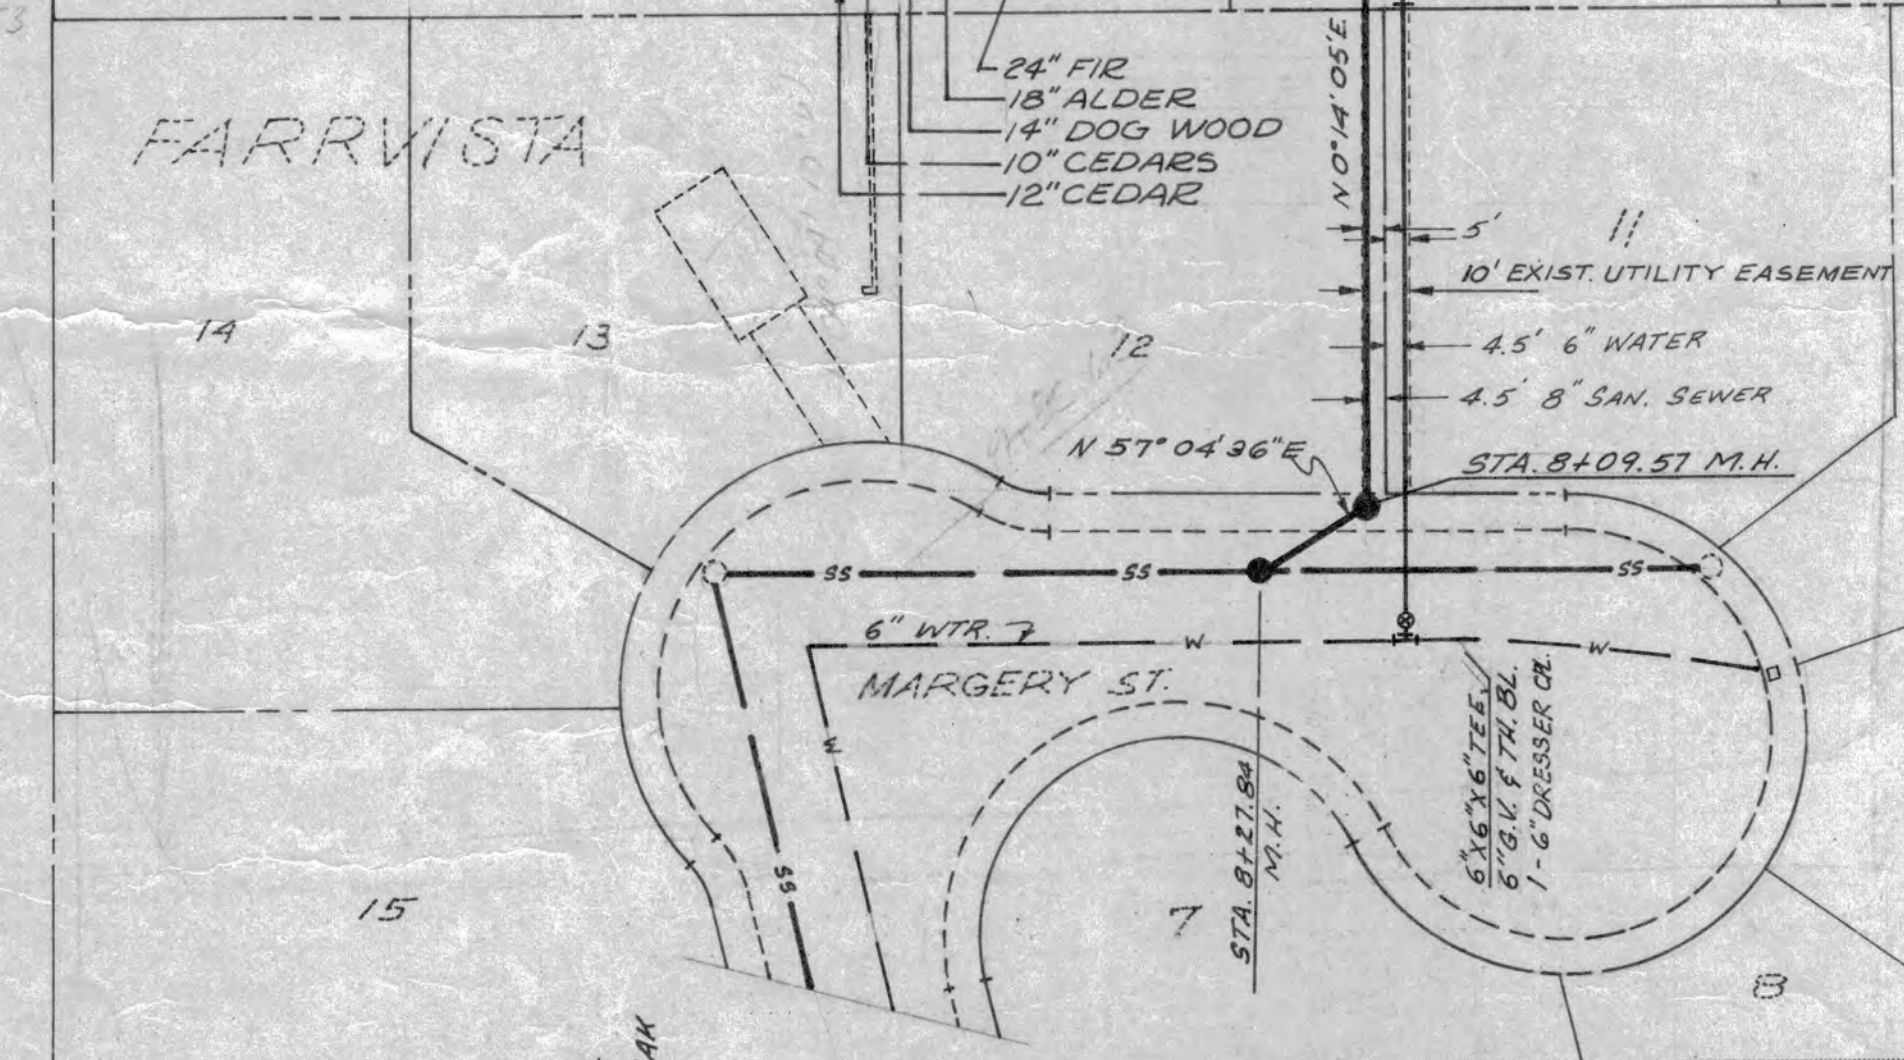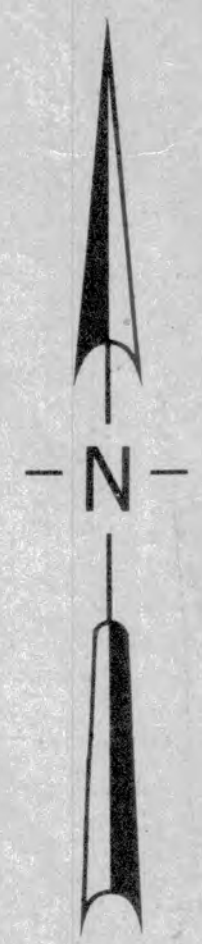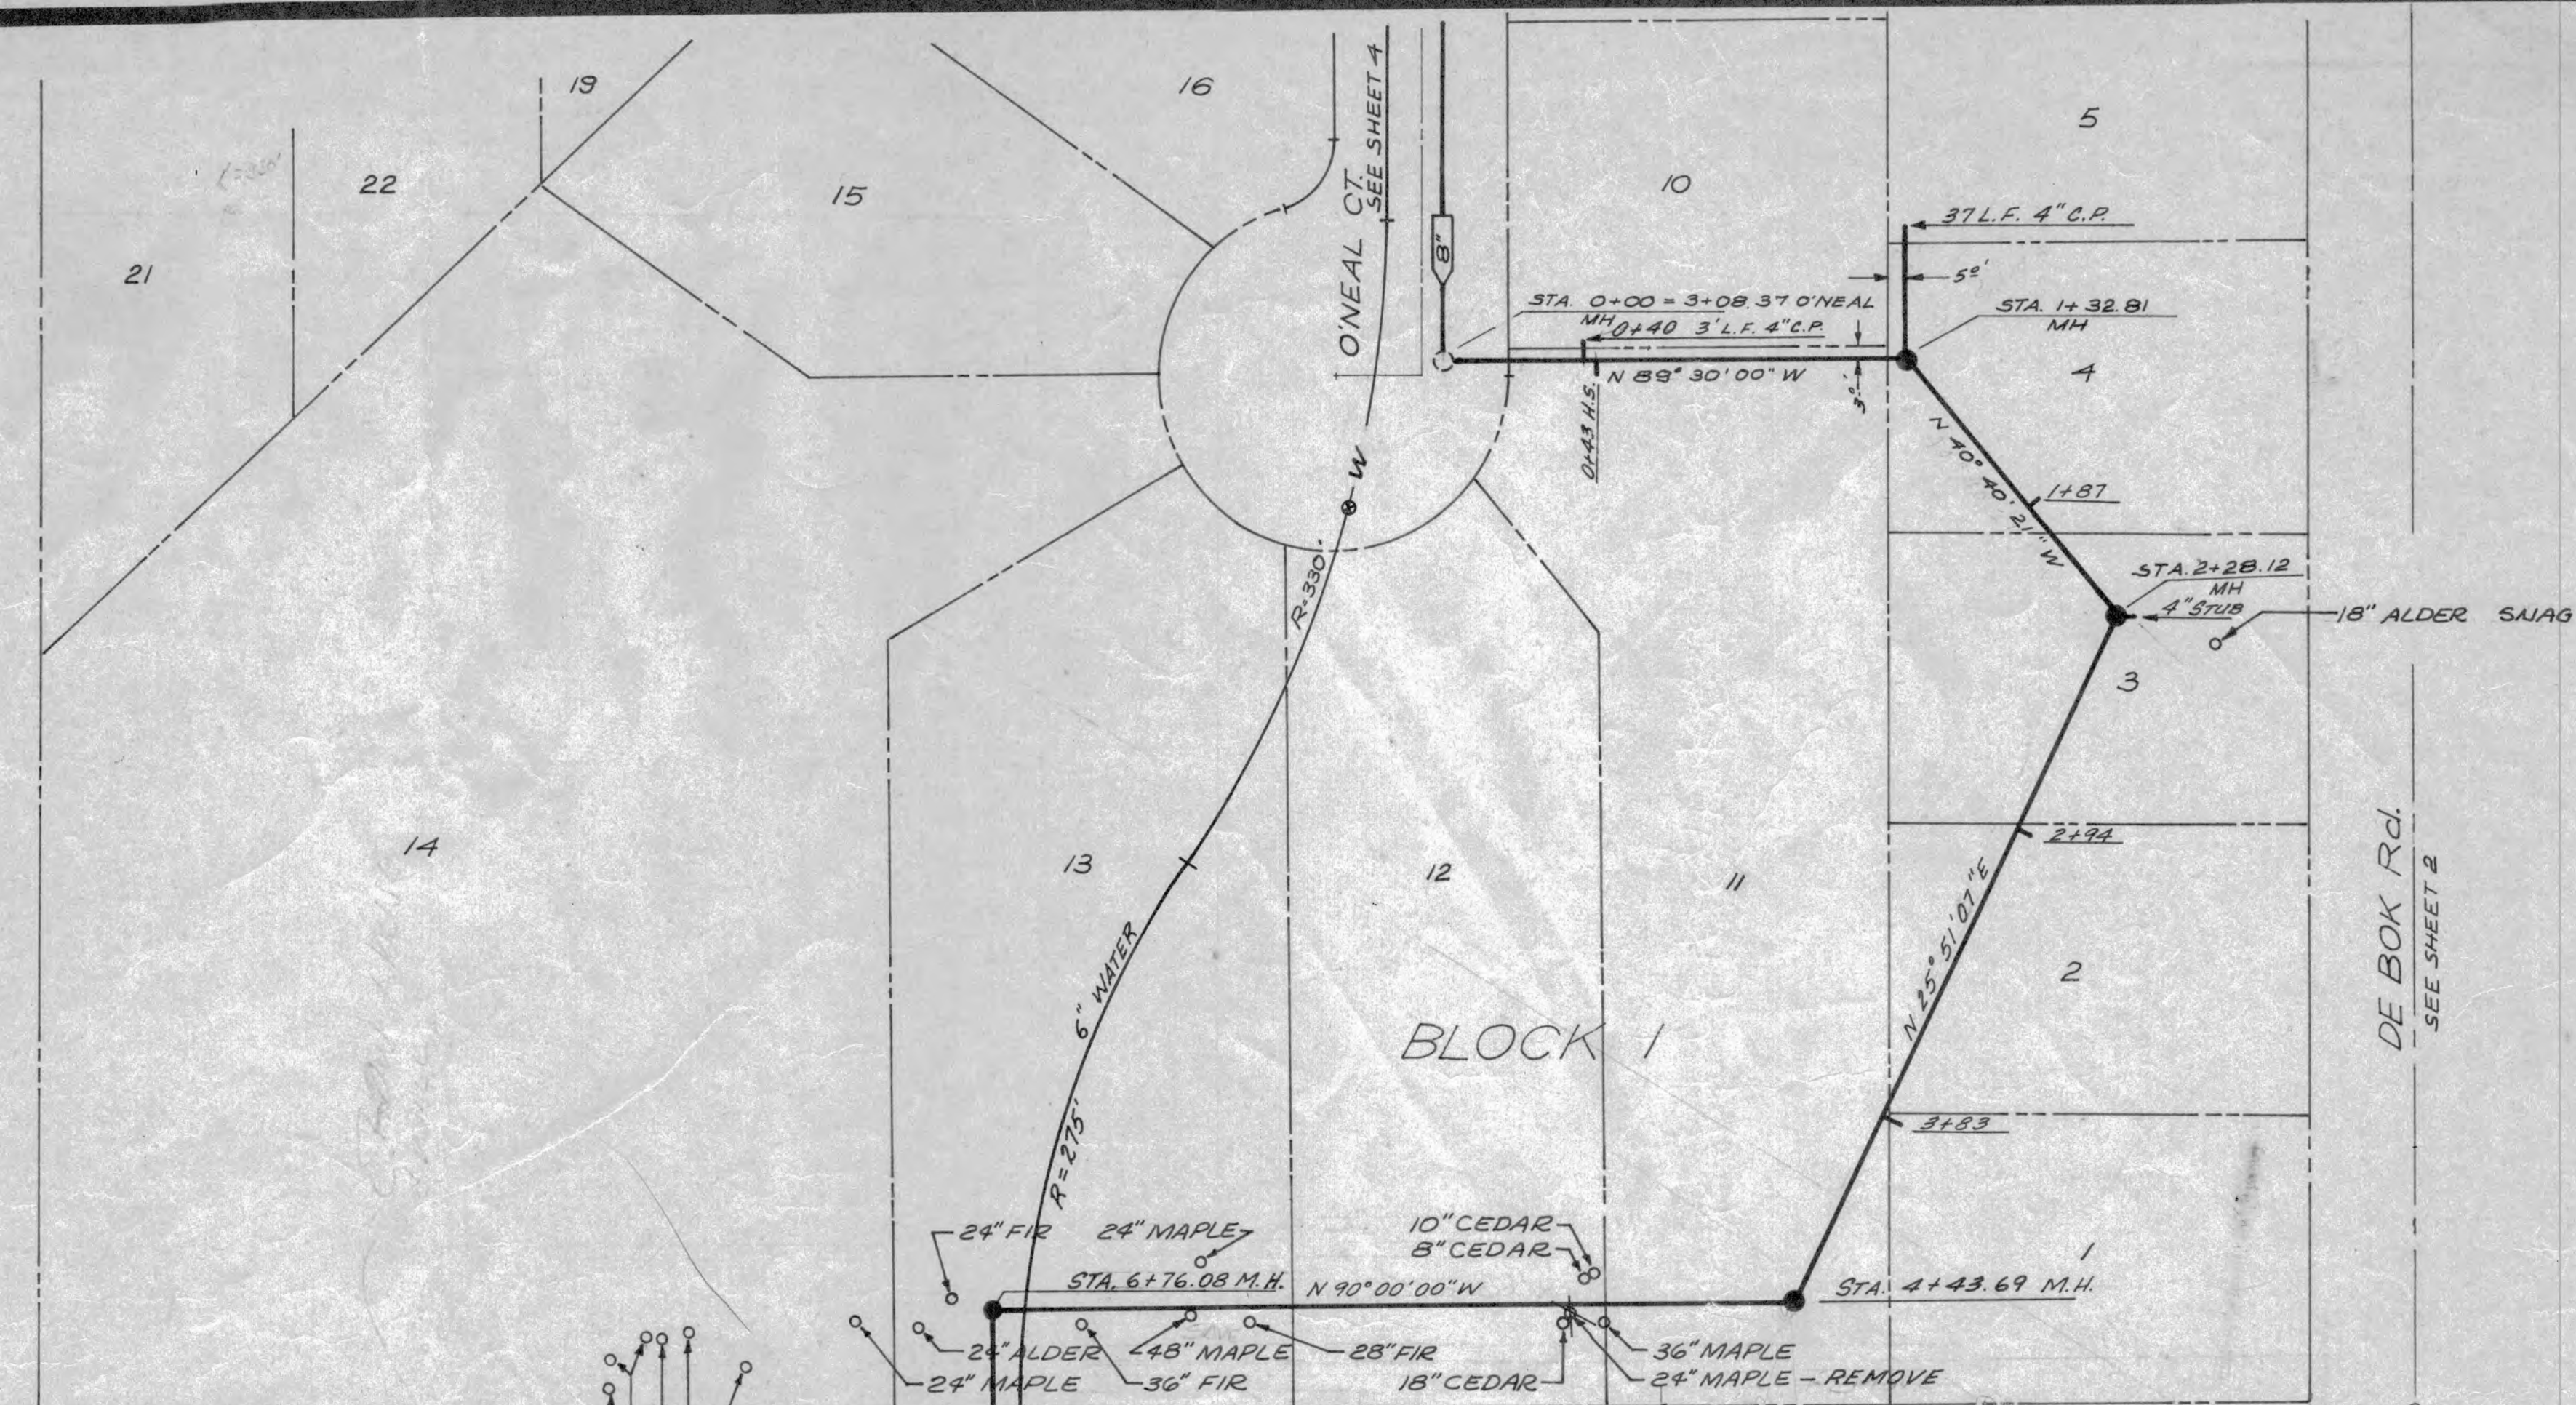

1	REVISED SAN. SEWER LAT. 'A' & WATER	8/10/76	P.F.B.	Designed T.M.
2	PROFILE & PIPE 0+00-2+28 FOR RECONSTR	7/16/77	B.N.	Drawn P.F.B.
3	AS-BUILTS	9/18/77	B.N.	Checked L.S. U.H.
No.	Revisions	Date	By	Checked W.W.H.

Approved  
HORIZ. 1"=40'  
Scale VERT. 1"=5'  
Date JUNE, 1976  
Parametrix, Inc.

CONSULTANTS IN ENGINEERING  
AND ENVIRONMENTAL SCIENCES  
Seattle  
Spokane  
Portland-Vancouver  
Eugene  
Tacoma

COMMONWEALTH PROPERTIES  
Beaverton, Oregon

Sanitary Sewer Lat. 'A'  
& Water

TAMARISK  
SUBDIVISION  
West Linn, Oregon  
Job No. 56-101-02  
P.C.D.

