

XREF LIST
=====

Ltscale: 100

Resolved

D579MAP


D579X001

GENERAL NOTES

1. ALL CONSTRUCTION SHALL BE IN ACCORDANCE WITH THE "CITY OF WEST LINN STREET/UTILITY DESIGN AND CONSTRUCTION STANDARDS", DATED MAY 22, 2000 AND OAR'S CHAPTER 333. ALL STREET, STORM SEWER AND SANITARY SEWER CONSTRUCTION THAT IS NOT ADDRESSED IN THE CITY'S STANDARDS SHALL BE IN ACCORDANCE WITH APWA STANDARDS. ALL WATER SYSTEM CONSTRUCTION THAT IS NOT ADDRESSED IN THE CITY'S STANDARDS SHALL BE IN ACCORDANCE WITH AWWA STANDARDS. CONTRACTOR TO OBTAIN A COPY OF THE GEOTECHNICAL REPORT PREPARED FOR THIS PROJECT PRIOR TO CONSTRUCTION.
2. PRIOR TO ANY CONSTRUCTION, LOCATIONS OF EXISTING UTILITIES SHALL BE VERIFIED BY THE CONTRACTOR. WHEN ACTUAL CONDITIONS DIFFER FROM THOSE SHOWN ON THE PLANS, THE CONTRACTOR SHALL NOTIFY THE ENGINEER PRIOR TO PROCEEDING WITH CONSTRUCTION.
3. ORGANIC AND NON-DESIRABLE MATERIALS SHALL BE REMOVED FROM THE CONSTRUCTION AREA AS DIRECTED BY THE GEOTECHNICAL ENGINEER.
4. ALL FILL AREAS SHALL BE STRIPPED OF ORGANIC MATERIAL. FILL WILL BE PLACED IN 6-INCH LAYERS AND COMPACTED TO 95 PERCENT RELATIVE MAXIMUM DENSITY ACCORDING TO AASHTO T-180 STANDARDS. LANDSCAPE AREAS SHALL BE COMPACTED TO 90 PERCENT. THE CONTRACTOR SHALL PROVIDE COMPACTION TESTING, ONE FOR EVERY 10,000 SQUARE FEET OF AREA AND FOR EVERY 2 LAYERS OR 16" AND EVERY 100 LINEAR FEET OF FILL PLACED. COMPACTION REPORTS FROM A NATIONALLY ACCREDITED TESTING LAB SHALL BE SUPPLIED TO THE ENGINEER. A COPY OF THE REPORTS SHALL BE GIVEN TO THE CITY.
5. CONTRACTOR SHALL LEAVE ALL AREAS OF THE PROJECT FREE OF DEBRIS AND UNUSED CONSTRUCTION MATERIALS.
 - a. AREAS TO BE LANDSCAPED SHALL BE SMOOTHED AND LEFT TO THE GRADES INDICATED ON THE GRADING PLAN, PLUS OR MINUS 0.1 FOOT.
 - b. ALL DISTURBED AREAS NOT TO BE LANDSCAPED SHALL BE SEEDED PER EROSION CONTROL NOTES ON SHEET C2.1 TO PREVENT EROSION.
 - c. ALL EXCESS/EXTRA MATERIAL SHALL BE REMOVED FROM THE SITE.
6. ANY CHANGES FROM THE APPROVED PLANS SHALL BE REQUESTED BY THE CONTRACTOR IN WRITING. THE DESIGN ENGINEER AND THE CITY OF WEST LINN'S PROJECT ENGINEER MUST APPROVE THE CHANGE PRIOR TO ITS IMPLEMENTATION. COMPLEXITY OF MODIFICATION WILL DETERMINE IF REVISED PLANS ARE REQUIRED.
7. CITY OF WEST LINN DETAILS SHALL BE USED AT LOCATIONS AS SPECIFIED IN THE PLANS, SEE DETAIL SHEETS.
8. DURING CONSTRUCTION, ALL EROSION CONTROL MEASURES SHALL CONFORM TO CLACKAMAS COUNTY EROSION CONTROL STANDARDS AND WILL BE STRICTLY ENFORCED.
9. IN CASE OF A DISCREPANCY BETWEEN THE DRAWINGS AND THE FIGURES WRITTEN THEREON, THE FIGURES SHALL BE DEEMED TO GOVERN.
10. THE OWNER WILL SUPPLY ONE SET OF STAKES FOR EACH CONSTRUCTION OPERATION AS DESCRIBED IN THE CONTRACT DOCUMENTS AND SPECIFICATIONS. THE CONTRACTOR SHALL DESIGNATE A REPRESENTATIVE OR REPRESENTATIVES WHO ARE AUTHORIZED TO REQUEST STAKES. STAKING REQUESTS FROM AUTHORIZED REPRESENTATIVE SHALL BE MADE TO DAVE LIDEN AT OTAK (503-699-2401) AT LEAST 48 HOURS IN ADVANCE OF THE NEED FOR SAID STAKES. ONLY REQUESTS FROM AUTHORIZED REPRESENTATIVES WILL BE HONORED. ANY RE-STAKING WILL BE DONE AT THE EXPENSE OF THE CONTRACTOR.
11. THE DESIGN ENGINEER WILL PROVIDE THE CITY OF WEST LINN A LETTER INDICATING THAT ALL IMPROVEMENTS WERE CONSTRUCTED IN ACCORDANCE WITH THE DESIGN PLANS AND SPECIFICATIONS.
12. WEEK DAY WORK HOURS ARE 7:00 AM TO 6:00 PM; SATURDAY, SUNDAY AND HOLIDAY WORK HOURS ARE LIMITED TO 9:00 AM TO 6:00 PM.
13. THE CITY OF WEST LINN SHALL BE PRESENT WHEN TESTING IS PERFORMED AND SUPPLIED WITH A COPY OF TEST RESULTS. ALL FACILITIES WILL BE ACCEPTED BY THE CITY PRIOR TO CONNECTION TO EXISTING SYSTEMS.
14. ALL FEES FOR STREET TREES SHALL BE PAID TO THE CITY OF WEST LINN PARKS AND RECREATION DEPT.
15. NO BUILDING PERMITS SHALL BE ISSUED UNTIL ALL REQUIRED IMPROVEMENTS HAVE BEEN DEEMED SUBSTANTIALLY COMPLETE.
16. THE CONTRACTOR SHALL REMOVE ALL SOFT OR OTHERWISE UNSUITABLE MATERIAL AT SUBGRADE AND REPLACE WITH APPROVED MATERIAL AT THE DIRECTION OF THE PROJECT GEOTECHNICAL ENGINEER. THE CONTRACTOR SHALL COMPACT TO A LINE ONE FOOT BEHIND THE CURB.
17. FINAL SUBGRADE PROOF-ROLL WITH 10 CY TRUCK LOADED WITH ROCK IS REQUIRED PRIOR TO PLACING AGGREGATE BASE.
18. FINAL BASE ROCK PROOF ROLL WITH 10 CY TRUCK LOADED WITH ROCK IS REQUIRED PRIOR TO PAVING. BASE ROCK TO BE COMPACTED TO 95 PERCENT RELATIVE MAXIMUM DENSITY ACCORDING TO AASHTO T-180 STANDARDS.
19. PLEASE NOTE CITY OF WEST LINN STANDARD CONSTRUCTION SPECIFICATION SECTION 505.03.11 FOR WEATHER RELATED LIMITATIONS ON THE PLACEMENT OF ASPHALTIC CONCRETE.
20. THE DENSITY OF THE COMPACTED BASE LIFT OF AC SHALL BE AT LEAST 92% OF RICE IN CONFORMANCE WITH AASHTO T209 AS MODIFIED BY THE OREGON STATE HIGHWAY DEPARTMENT.
21. THE DENSITY OF THE COMPACTED TOP LIFT OF AC SHALL BE AT LEAST 92% OF RICE IN CONFORMANCE WITH AASHTO T209 AS MODIFIED BY THE OREGON STATE HIGHWAY DEPARTMENT.
22. DENSITY TESTS WILL BE REQUIRED PER CITY OF WEST LINN STANDARD CONSTRUCTION SPECIFICATIONS. COPIES OF ALL REPORTS ARE TO BE SUPPLIED TO THE CITY INSPECTOR AND DESIGN ENGINEER.
23. CONTRACTOR SHALL SUBMIT SCHEDULE DETAILING SEQUENCE OF CONSTRUCTION PRIOR TO THE PRE-CONSTRUCTION MEETING. CONTRACTOR SHALL SUBMIT TRAFFIC CONTROL PLAN DETAILING THE CLOSURE OF BEACON HILL LANE / CT. AND THE DETOUR ROUTE IN CONFORMANCE WITH THE CURRENT MANUAL OF UNIFORM TRAFFIC CONTROL DEVICES TO OTAK, INC. AND THE CITY OF WEST LINN FOR APPROVAL PRIOR TO THE PRE-CONSTRUCTION MEETING. CITY MUST APPROVE TRAFFIC CONTROL PLAN AND CONTROLS MUST BE IN PLACE PRIOR TO BEGINNING CONSTRUCTION. ALL EXISTING SIGNS SHALL BE RESET AFTER CONSTRUCTION.
24. TRANSITION ZONE BOUNDARIES TO BE STAKED AND APPROVED PRIOR TO ANY CLEARING AND GRADING TO THE SITE.

BENCH MARK

ELEVATION DATUM IS BASED ON AN ALUMINUM CAP AT THE CENTERLINE INTERSECTION OF BEACON HILL DRIVE AND BEACON HILL COURT. ELEVATION = 476.40.

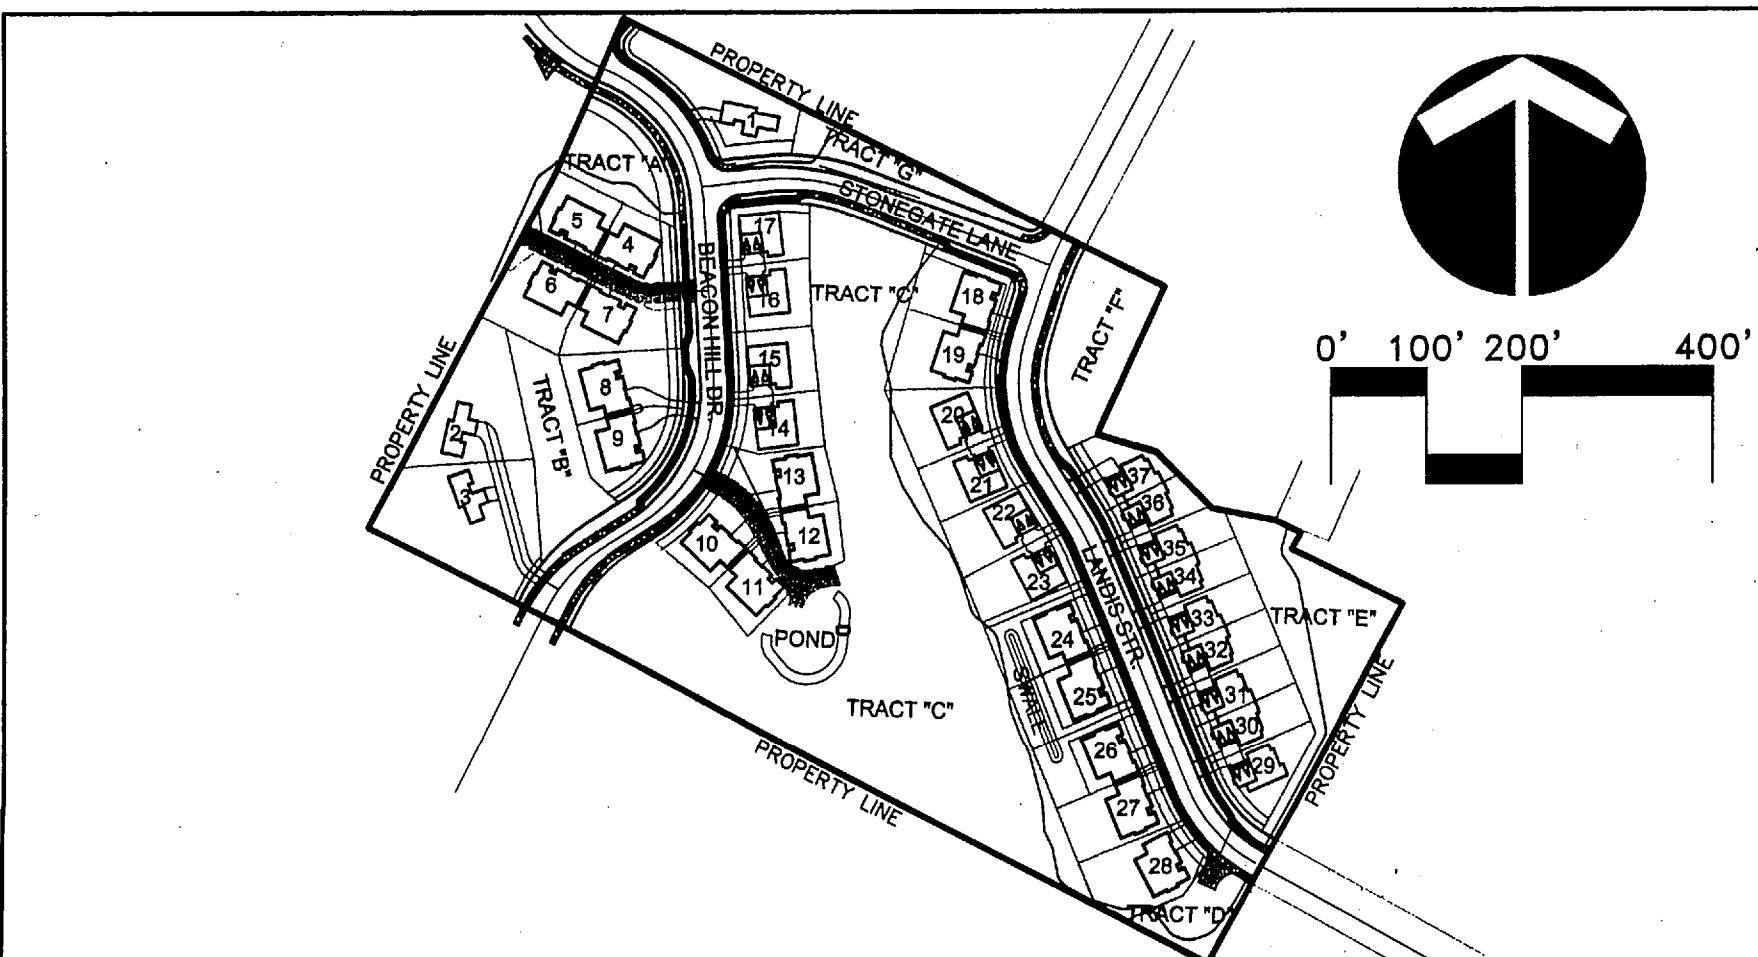

PROJECT MAP

SCALE AS SHOWN


PUBLIC IMPROVEMENT PLANS TANNER'S STONEGATE WEST LINN, OREGON

STORM DRAIN AND SANITARY SEWER NOTES:

1. MANHOLE CONSTRUCTION SHALL BE IN ACCORDANCE WITH THE CITY OF WEST LINN'S PUBLIC WORKS STANDARDS. MANHOLES SHALL CONFORM TO ASTM C-478.
2. TRENCH BEDDING, PIPE ZONE AND BACKFILL IN PAVED AREAS WILL BE 3/4-INCH MINUS CRUSHED AGGREGATE COMPACTED TO 95 PERCENT RELATIVE MAXIMUM DENSITY, AASHTO T-180. UNPAVED AREAS OUTSIDE ROW TO BE CLASS A NATIVE BACKFILL MATERIAL (SEE WEST LINN DETAIL WL-200 ON SHEET C5.1) UNLESS OTHERWISE NOTED. CLASS A NATIVE BACKFILL TO BE COMPACTED TO A MINIMUM OF 95 PERCENT OF THE MAXIMUM DRY DENSITY, AASHTO T-180.
3. ALL PUBLIC STORM DRAINS SHALL BE CONSTRUCTED WITH PVC D 3034, AS SPECIFIED IN DIVISION SIX - STORM DRAIN TECHNICAL REQUIREMENTS, OF THE WEST LINN PUBLIC WORKS STANDARD CONSTRUCTION SPECIFICATIONS. UNLESS NOTED OTHERWISE ON PLANS.
4. ALL PUBLIC SANITARY SEWERS SHALL BE CONSTRUCTED WITH PVC D3034 PIPE PIPE AS SPECIFIED IN DIVISION THREE - SANITARY SEWER TECHNICAL REQUIREMENTS, OF THE WEST LINN PUBLIC WORKS STANDARD CONSTRUCTION SPECIFICATIONS, UNLESS NOTED OTHERWISE ON PLANS.
5. PRIOR TO ACCEPTANCE, ALL PUBLIC SANITARY SEWERS SHALL BE TV, PRESSURE, AND DEFLECTION TESTED IN ACCORDANCE WITH THE CITY OF WEST LINN'S REQUIREMENTS. ALL PUBLIC STORM SEWERS SHALL BE TV AND DEFLECTION TESTED.
6. THE DETENTION FACILITIES NEED TO BE TESTED FOR LEAKAGE.
7. WATER TIGHT PLUGS SHALL BE INSTALLED IN THE ENDS OF SANITARY AND STORM LATERALS AND A 2" X 4" WOOD MARKER PLACED AT THE LATERAL END FROM PIPE INVERT TO AT LEAST 36" ABOVE THE FINISH GRADE. THE 2" X 4" TOP SHALL BE PAINTED (GREEN FOR SANITARY) AND (WHITE FOR STORM) AND MARKED WITH THE DEPTH OF THE LATERAL MEASURED FROM THE FINISHED GROUND ELEVATION TO THE INVERT OF PIPE AT THE TIME THE CURBS ARE POURED, AN (S FOR SANITARY) AND (SD FOR STORM) SHALL BE STAMPED IN THE TOP OF THE CURB AT EACH POINT A LATERAL CROSSES BENEATH THE CURBLINE.
8. ALL SANITARY SEWER MANHOLES SHALL BE VACUUM TESTED.
9. EXISTING SANITARY SEWER LINE TO BE RELOCATED BEFORE SITE IS GRADED.
10. CONSTRUCTION NOTES FOR STORM AND SANITARY SEWERS ARE ON SHEET C3.0 AND C4.0 RESPECTIVELY.

WATER NOTES:

- W1. ALL WATER PIPE AND FITTINGS SHALL BE DUCTILE IRON CLASS 52 AND CONFORM TO STANDARD CITY SPECIFICATIONS AND DETAILS. ALL WATER SERVICE LINES TO BE TYPE K COPPER PIPE PER CITY OF WEST LINN SPECIFICATIONS.
- W2. WATERLINES SHALL BE PRESSURE TESTED FOLLOWING COMPLETION. PRESSURE TESTS SHALL BE IN ACCORDANCE TO THE CITY OF WEST LINN'S STANDARDS WITH A MINIMUM TEST PRESSURE OF 180 PSI. WHEN THE PRESSURE TEST IS PERFORMED, THE TEST PRESSURE OF 180 PSI SHALL STABILIZE BEFORE THE TEST BEGINS. SERVICE LINES WILL ALSO BE TESTED TO THE METER LOCATION.
- W3. PRIOR TO BEING PLACED INTO SERVICE, THE WATERLINE SHALL BE FLUSHED, STERILIZED AND FLUSHED AGAIN ALL IN ACCORDANCE WITH STANDARD METHODS OF THE HEALTH DIVISION, DEPARTMENT OF HUMAN RESOURCES, STATE OF OREGON.
- W4. PRIOR TO CONNECTION TO EXISTING WATERLINE, A SAMPLE SHALL BE TAKEN AND TESTED FOR BACTERIOLOGICAL QUALITY. RESULTS MUST BE WITHIN STANDARDS OF THE STATE OF OREGON.
- W5. CONCRETE THRUST BLOCKING SHALL BE PROVIDED AT ALL WATERLINE FITTINGS AS REQUIRED BY CITY STANDARDS. BLOCKING SHALL BE 3000 PSI CONCRETE PLACED AGAINST UNDISTURBED EARTH AND CLEAR OF JOINT ACCESSORIES. BEARING AREA OF THRUST BLOCK SHALL BE COMPUTED ON THE BASIS OF ALLOWABLE SOIL BEARING PRESSURE. ALL PIPE FITTINGS IN CONTACT WITH CONCRETE SHALL BE WRAPPED IN PLASTIC.
- W6. MINIMUM COVER OVER WATERLINES IS TO BE 36" AS MEASURED FROM FINISH GRADE TO TOP OF PIPE. MINIMUM VERTICAL SEPARATION BETWEEN WATERLINE AND SANITARY SEWER AT A CROSSING IS 18". SANITARY SEWER AT WATERLINE CROSSINGS WITH LESS THAN THE MINIMUM VERTICAL SEPARATION SHALL BE CONSTRUCTED OF DUCTILE IRON PIPE WITH WATERTIGHT JOINTS. IN SUCH CASES THE 18-FOOT LENGTH OF SANITARY SEWER SHALL BE CENTERED AT THE CROSSING.
- W7. ALL WATER SERVICES SHALL BE SEPARATED BY A MINIMUM HORIZONTAL DISTANCE OF 2' AT THE MAINLINE.
- W8. FIRE HYDRANT ASSEMBLIES TO BE MUELLER CENTURION A-423 OR CLOW MEDALLION F-2545 AND ARE TO BE INSTALLED PER CITY OF WEST LINN STANDARD SPECIFICATIONS AND DETAILS.
- W9. TRENCH BEDDING, PIPE ZONE AND BACKFILL IN PAVED AREAS WILL BE 3/4-INCH MINUS CRUSHED AGGREGATE COMPACTED TO 95 PERCENT RELATIVE MAXIMUM DENSITY, AASHTO T-180. UNPAVED AREAS OUTSIDE ROW TO BE CLASS A NATIVE BACKFILL MATERIAL (SEE WEST LINN DETAIL WL-200 ON SHEET SC-12) UNLESS OTHERWISE NOTED. CLASS A NATIVE BACKFILL TO BE COMPACTED TO A MINIMUM OF 95 PERCENT OF THE MAXIMUM DRY DENSITY, AASHTO T-180.
- W10. ALL WATERLINE PRESSURE AND CHLORINATION TESTING SHALL BE PERFORMED WITH THE CITY PRESENT.
- W11. CONSTRUCTION NOTES FOR WATERLINE ARE ON SHEET C4.0.

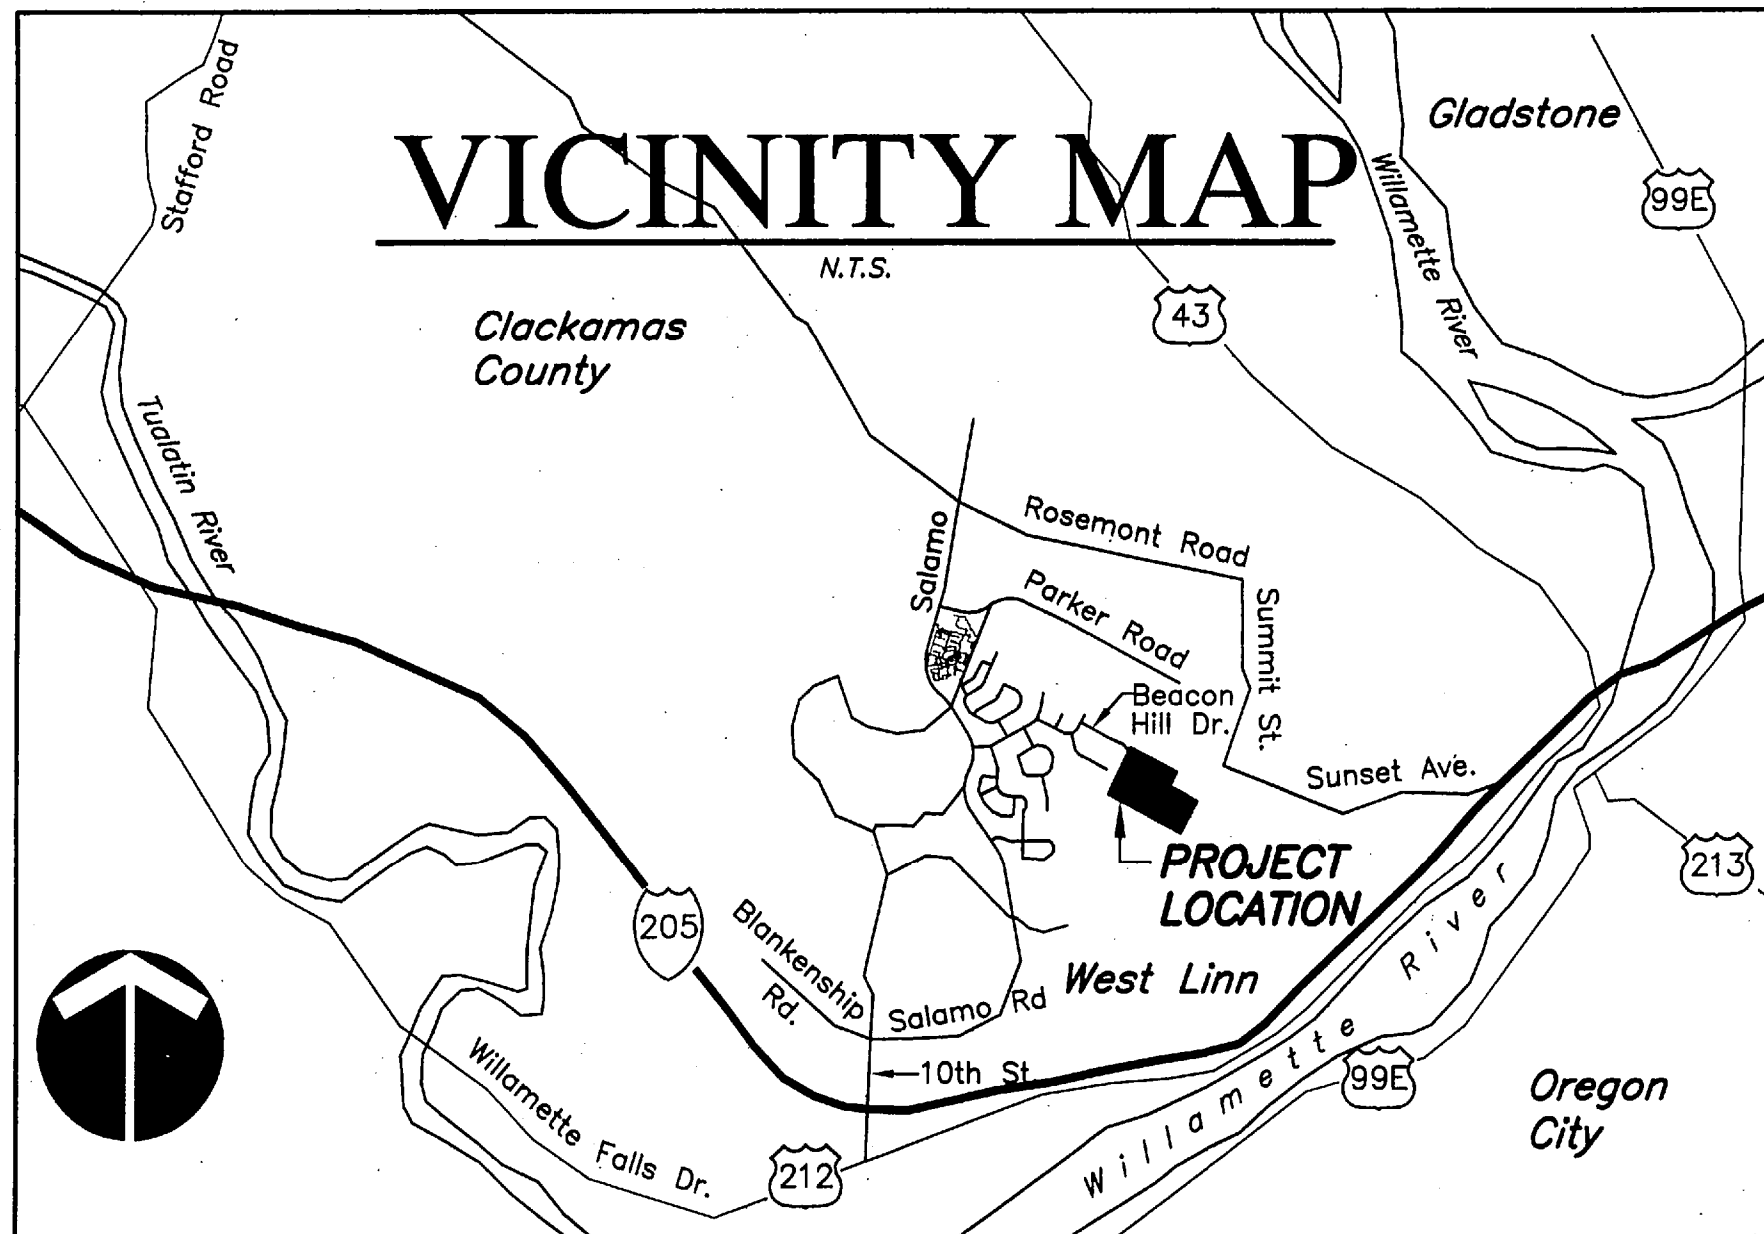

SHEET INDEX

C1.0	COVER SHEET, PROJECT MAP, VICINITY MAP, PROJECT TEAM
C1.1	CONDITIONS OF APPROVAL
C1.2	TYPICAL STREET SECTIONS
C1.3	COMPOSITE UTILITY PLAN
C1.4	PLAT PLAN
C2.0	GRADING AND EROSION CONTROL PLAN
C2.1	EROSION CONTROL NOTES AND DETAILS
C2.2	TREE PRESERVATION PLAN
C2.3	CLEARING LIMIT PLAN
S-1A	RETAINING WALL PLAN
S-1B	RETAINING WALL PROFILES
S-2	RETAINING WALL PLAN AND PROFILES
S-3	STRUCTURAL DETAILS AND SPECS.
S-4	STRUCTURAL DETAILS AND SPECS.
S-5	RETAINING WALL'S TABLES AND SPECS.
S-6	STRUCTURAL DETAILS AND SPECS.
S-7	STRUCTURAL DETAILS AND SPECS.
N-WALL	INTERMEDIATE RETAINING WALL

C3.0A	STREET PLAN
C3.1	STREET AND STORM DRAIN PROFILES
C3.2	STREET AND STORM DRAIN PROFILES
C3.3	STREAM CROSSING PLAN AND PROFILE
C3.4A	DETENTION FACILITY PLAN AND PROFILES
C3.4B	LANDSCAPING PLAN
C3.5	PUBLIC OFFSITE TRAIL PLAN AND PROFILES
C3.6	PUBLIC OFFSITE TRAIL DETAILS
C3.7	DRIVEWAY AND ACCESS ROAD PLAN AND PROFILES
C3.8	SOAKAGE TRENCHES AND PRIVATE STORM DRAIN PLAN
C3.9	SIGNAGE PLAN AND STREET TREE PLAN
C4.0	SANITARY SEWER AND WATER PLAN
C4.1	WATERLINE PROFILES
C4.2	SANITARY SEWER AND WATERLINE PROFILES
C5.0	DETAILS
C5.1	DETAILS
C5.2	DETAILS
C5.3	DETAILS
C5.4	DETAILS
C5.5	DETAILS

OWNER/APPLICANT

Name: Norway Development
Contact: Dan Maloney
Phone: (503) 656-7000
Fax: (503) 656-0686

CIVIL ENGINEER/SURVEYOR

Name: Otak Incorporated
Contact: Adnan Hadad, P.E.
Phone: (503) 635-3618
Fax: (503) 635-5395

GEOTECHNICAL ENGINEER

Name: Geotechnical Resources, Inc.
Contact: Gene Tupper, P.E.
Phone: (503) 641-3478
Fax: (503) 644-8034

PLANNING AND DESIGN

Name: Ken Catlett
Contact:
Phone: (503) 654-0180
Fax:

STRUCTURAL ENGINEERING

Name: David A. Hall
Contact:
Phone: (503) 231-8727
Fax: (503) 231-8726

GOVERNING JURISDICTION

Name: City of West Linn
Contact: Engineering Division
Phone: (503) 722-5500
Fax: (503) 656-4106

LOCATING EXISTING UTILITIES

--- 48 HOUR NOTICE REQUIRED PRIOR TO EXCAVATION ---

ONE CALL SYSTEM (GENERAL TELEPHONE, NORTHWEST NATURAL GAS, U.S. WEST, U.S. SPRINT)	(503) 246-6699
PORTLAND GENERAL ELECTRIC	(503) 643-5454, EXT. 312, 313, 314
TCI CABLE TELEVISION	243-7491
REPAIR EMERGENCIES	
NORTHWEST NATURAL GAS	(503) 226-4211, EXT. 4413
CITY OF WEST LINN WATER OPERATIONS SANITARY SEWER OPERATIONS	(503) 656-3535

THE CONTRACTOR, IN LOCATING AND PROTECTING UNDERGROUND UTILITIES, MUST COMPLY WITH THE REGULATIONS OF O.R.S. 757.541 TO 757.571

ATTENTION EXCAVATORS: Oregon law requires you to follow rules adopted by the Oregon Utility Notification Center. Those rules are set forth in OAR 952-001-0010 through OAR 952-001-0090. You may obtain copies of these rules from the Center by calling (503) 232-1987. If you have any questions about the rules, you may contact the call Center. YOU MUST NOTIFY THE CENTER AT LEAST 2 BUSINESS DAYS, BUT NOT MORE THAN 10 BUSINESS DAYS, BEFORE COMMENCING AN EXCAVATION. CALL (503) 246-6699.

08/21/2001

Date


AAH/BLW/JAH

Designed

AAH/BLW/JAH

Drawn

Checked By Date

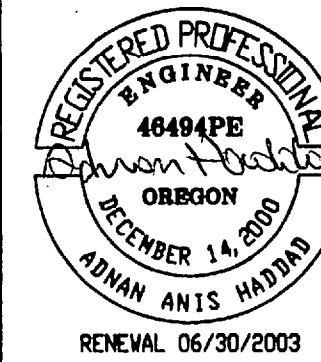

NORWAY DEVELOPMENT

P.O. Box 387
Oregon City, Oregon 97045
PHONE: (503) 656-7000
FAX: (503) 656-0686

Tanner's Stonegate

001001
CITY OF WEST LINN, OREGON

COVER SHEET



Incorporated

17355 SW Boones Ferry Road
Lake Oswego, OR 97035-5217
Phone: (503) 635-3618
FAX: (503) 635-5396

10579

Project No.

D579C1-0

File No.

C1.0

Sheet No.


Copyright 2001 ©

XREF LIST
Ltscole: 1
Resolved
0579PRELIM
0579X001
0579X190
0579X230

CONDITIONS OF APPROVAL

- Based upon staff findings attached, the Planning Director finds that the approval criteria have been met and this application shall be approved with the following conditions:
- Lots 6 and 7 shall be eliminated on the Final Plat. The area of lots 6 and 7 shall be added to adjacent open space tracts. Unless the area identified as proposed lot 5 is approved as a lot pursuant to condition of approval 2 before a final plat is filed that includes that area, lot 5 shall be eliminated from the Final Plat and its area shall be identified as an open space tract or merged with an adjoining open space tract.
 - Tree preservation easements shall be placed on those trees which are not within open space tracts as shown on the 'Saved Trees Plan' sheet submitted by the applicant on July 21, 1999, as modified by the detailed plans for lots 2, 3, and 4 submitted at the October 25, 1999 hearing; provided trees on Lot 1 are not required to be included in the tree preservation easement. Where required, tree preservation easements shall include the area within the drip line plus a 10-foot radius from the outer edge of the drip line.
 - The applicant may remove trees 2101A, 2101B, 2101, and 1850B if the applicant demonstrates, through at least a Type II process, that these trees must be removed to allow construction of LANDIS Street and that 'all reasonable grading plans have been considered and cannot work.'
 - If the Planning Director concludes trees 2101A, 2101B, 2101, and 1850B can be removed as provided above, the Planning Director may approve the creation of proposed lot 5 provided the applicant also proposes a specific building envelope for that complies with applicable standards of the City Code as part of the Type II review required above, and the lot is approved subject to a condition that prohibits construction outside of the approved building envelope except to the extent otherwise permitted by law.
 - If lot 5 is permitted as provided above, it may be included in any phase of subdivision or may be a phase unto itself.
 - Lot 1 shall be developed within the footprint as shown on the applicant's submittal of September 14, 1999 entitled 'Lot 1.' Lots 2, 3, and 4 shall be developed within the footprints as shown in the applicant's submittal of October 25, 1999 entitled 'Sleepy Hollow Town Homes Detached House Studies Lots 3 through 7' and in compliance applicable setback requirements. The applicant shall file with the Final Plat a map delineating those footprints on the lots and shall file with the deeds to the property a restriction prohibiting development outside the envelope unless approved in advance by the City of West Linn.
 - The individual building footprints shown on the site plan may be modified to allow for a 20 foot deep garage driveway from the edge of the street right of way or private lane. Other modifications to the building footprints may be approved through at least a Type II process.
 - Beacon Hill shall be designed with a paved width of 28 feet, with on-street parking on one side of the roadway as approved by the City Engineer.
 - STONEGATE LANE shall have on-street parking allowed on the side of the roadway as approved by The City Engineer except at the Tanner Creek crossing, where no on-street parking shall be allowed.
 - LANDIS Street shall have on-street parking allowed on one side of the roadway as approved by the City Engineer.
 - The final street design plans for LANDIS Street shall eliminate the sidewalk and planter strip on the northern side of the roadway to the east of Lot 25.
 - The final street design plans for STONEGATE LANE shall show a 24 foot pavement width for the bridge section, show a single four foot wide sidewalk on the one side of the street (with no planter strip on the bridge section) between Beacon Hill Drive and LANDIS Street, and eliminate the sidewalk and planter strip on the other side of the roadway between Beacon Hill Drive and LANDIS Street. However, the small portion of the west side of LANDIS Street north of STONEGATE LANE shall have a sidewalk from the intersection to the northern boundary.
 - LANDIS Street shall be realigned so that the eastern edge of the right of way at the northerly property boundary is 93 feet from the eastern property line.
 - The applicant shall either 1) prepare final street design plans and then construct Beacon Hill Drive to meet acceptable AASHTO standards for 'K' Values (related to the length of a road curve and its horizontal grade), or 2) provide a traffic control plan for Beacon Hill Drive which reduces traffic speeds in order to justify a lower 'K' value than the AASHTO standard to the satisfaction of the City Engineer.
 - The looped private drives serving Lots 38-43 around the 'plaza' shall be constructed with a minimum paved width of 20 feet and minimum curve radius of 25 feet in order to meet fire safety standards.
 - A temporary turnaround at the east end of LANDIS Street shall be constructed which conforms to Tualatin Valley Fire and Rescue District standards.
 - The applicant shall design and construct an irrigation system for the two entryway median islands and Tract 'C' during construction of required public improvements to the satisfaction of the City Engineer.
 - The final design plans for Beacon Hill Drive shall show modify the two entryway median islands if necessary to allow passage of the West Linn-Wilsonville School District buses to the satisfaction of the City Engineer.
 - Final improvement plans shall show the storm detention ponds for the project located entirely outside of the drainageway and drainageway transition areas. Alternative storm detention facilities for the eastern half of the project (Phase 2), such as detention tanks located under LANDIS Street, may be necessary.
 - The applicant shall stub the water system serving the eastern half of the project (Phase 2) to the east boundary of the site. The applicant shall provide a 'blow-off' parallel pipe and/or similar designs approved by the City Engineer to ensure adequate water quality is available to the site. The proposed water system design shall be shown on the final construction plans for the Phase 2.
 - Prior to approval of final plans, the applicant shall provide water system designs and supporting modeling calculations sufficient to demonstrate to the satisfaction of the City Engineer that adequate fire flows will be provided to the site.
 - Private storm drainage facilities shall be required for all lots on the downhill side of Beacon Hill Drive and LANDIS Street, and their design shall be approved by the City Engineer prior to issuance of a grading permit.
 - The applicant shall construct an all weather road to provide access for the maintenance of the storm water detention facilities located outside of the public right of way if any. The design of this maintenance access road shall be approved by the City Engineer prior to the issuance of a grading permit.

- The sanitary sewer line from Cascade Summit shall be re-routed and put back service before any other grading activity occurs on the site.
- The applicant shall provide evidence that the U.S. Army Corps of Engineers and Division of State Lands have approved the crossing of STONEGATE LANE over Tanner Creek, the crossing of Beacon Hill Drive over the western tributary to Tanner Creek, and the intrusion of any utility lines within wetland areas.
- The culvert for the western tributary of Tanner Creek as where Beacon Hill passed over it shall be designed as an arched, or bottomless, culvert, to the satisfaction of the City Engineer.
- The applicant shall provide calculations proving that both the Tanner Creek and Tanner Creek tributary road culverts are designed and sized for a 100 year storm event, to the satisfaction of the City Engineer.
- The applicants' surveyor shall place temporary wooden stakes along transition boundaries at 30 to 50-foot intervals and at all boundary direction changes. A fee \$25 shall be paid by the applicant to the City for each permanent 'Protection Zone' stake that is required. The applicant is responsible for placing the temporary stakes and paying the fee for the 'Permanent Zone' stakes prior to any clearing grading of the site.
- Regarding tree preservation:
 - Chain link fencing shall be installed at the dripline for all trees with any site work, or near any construction area. 'Site work areas' and 'near any construction areas' shall be defined as any area that could receive dirt debris, or have the ground traversed with equipment or have the natural grade modified.
 - Only if such fence placement at the dripline is unfeasible, fencing installed out of the root zone and in manner that prohibits any contact with the tree trunk.
 - The City Arborist shall inspect and approve all on-site tree protection measures, and tree pruning, including placement of protection fences prior to the start of site work. It is the applicants' responsibility to contact the City Arborist and arrange for this approval to take place. No permits from the Engineering, Planning, or Building Departments shall be issued without approval from the City Arborist regarding tree protection measures, and regarding proposed tree pruning of 'trees to remain' on the site.
 - All tree protection measures shall remain in place and fully function the entire time that site work and construction is taking place.
- For all trails required to provide connectivity between streets and trails on site, the grade of the pedestrian pathways shall generally not exceed 12%, short sections (no longer than 50 feet, not constituting more than 20% of the linear length of the trails) can have a maximum 15% grade. Any greater grades must be accommodated through the use of stairs. Trails required for connectivity are the following: 1) between the western boundary of the property and Beacon Hill Drive, 2) between Beacon Hill Drive and LANDIS Street, 3) between LANDIS Street and Reed Street, and 4) between STONEGATE LANE and the northern property boundary. The design and precise location of the pedestrian pathways shall be approved by the City Planning Director prior to issuance of a grading permit. The pathways shall avoid damaging significant trees to the satisfaction of the City Arborist.
- The following trails shall have a surface with a minimum width of six feet: 1) between the western boundary of the property and Beacon Hill Drive, 2) between Beacon Hill Drive and LANDIS Street, 3) between LANDIS Street and Reed Street, and 4) between STONEGATE LANE and the northern property boundary.
- The trail north from LANDIS Street shall connect to the Reed Street right of way. Design of this trail segment shall be approved by the city Planning Director prior to issuance of a grading permit.
- The trail section between the western boundary of the property and Beacon Hill Drive shall be paved with asphalt or concrete. The trails located between Beacon Hill Drive and LANDIS Street within the Tanner Creek area shall be unpaved except for a wooden footbridge crossing of Tanner Creek with footings in the upland area. The individual trails to 'feature areas' within the site shall be unpaved. The trail connecting LANDIS Street and Reed Street shall be paved with asphalt or concrete.
- The applicant shall either dedicate all open space tracts to the City of West Linn or provide evidence to the satisfaction of the Planning Director that all open space tracts shall be owned and maintained by a homeowner's association or non-profit conservancy and preserved in their natural state with a conservation easement. If the latter option is chosen, the trail between the western boundary of the project and Beacon Hill Drive, the trail between Beacon Hill Drive and LANDIS Street, the trail between LANDIS Street and Reed Street, and the trail from STONEGATE LANE to the northern property boundary shall be contained within a 20 foot wide public easement.
- No grading shall be allowed within the drainageway transition areas except as necessary for road and utility construction.
- The applicant shall submit an erosion control plan and narrative that is consistent with the 'Erosion Prevention and Sediment Control Plans Technical Guidance Handbook' prepared by Clackamas County Department of Utilities (August 1994). The plan shall be submitted with the public improvement plans and building plans and must be approved by the City Engineer and City Building Official prior to site work.
- The applicant shall submit a plan for removal of invasive and non-indigenous plant species from the drainageway and drainageway transition areas and shall complete the plan prior to occupancy of any residences. Removal of invasive species from the natural drainageway shall not occur on or between the months of November through March. The applicant shall notify the Parks Department prior to spraying and planting the drainageway in order to get approval of herbicides. The applicant shall not replant during summer months when survival rate is low due to little irrigation.
- The applicant shall submit a plan for landscaping of the 'Feature Plaza' in Tract 'C' to be approved by the City Planning Director prior to issuance of a grading permit.
- Development of Phase 1 (that portion of the project west of Tanner Creek) requires completion of all improvements west of Tanner Creek natural drainageway, and all improvements within the natural drainageway which are necessary for the provisions of utility services to Phase 1. Development of Phase 2 (that portion of the project east of Tanner Creek) will require all remaining improvements to be completed.

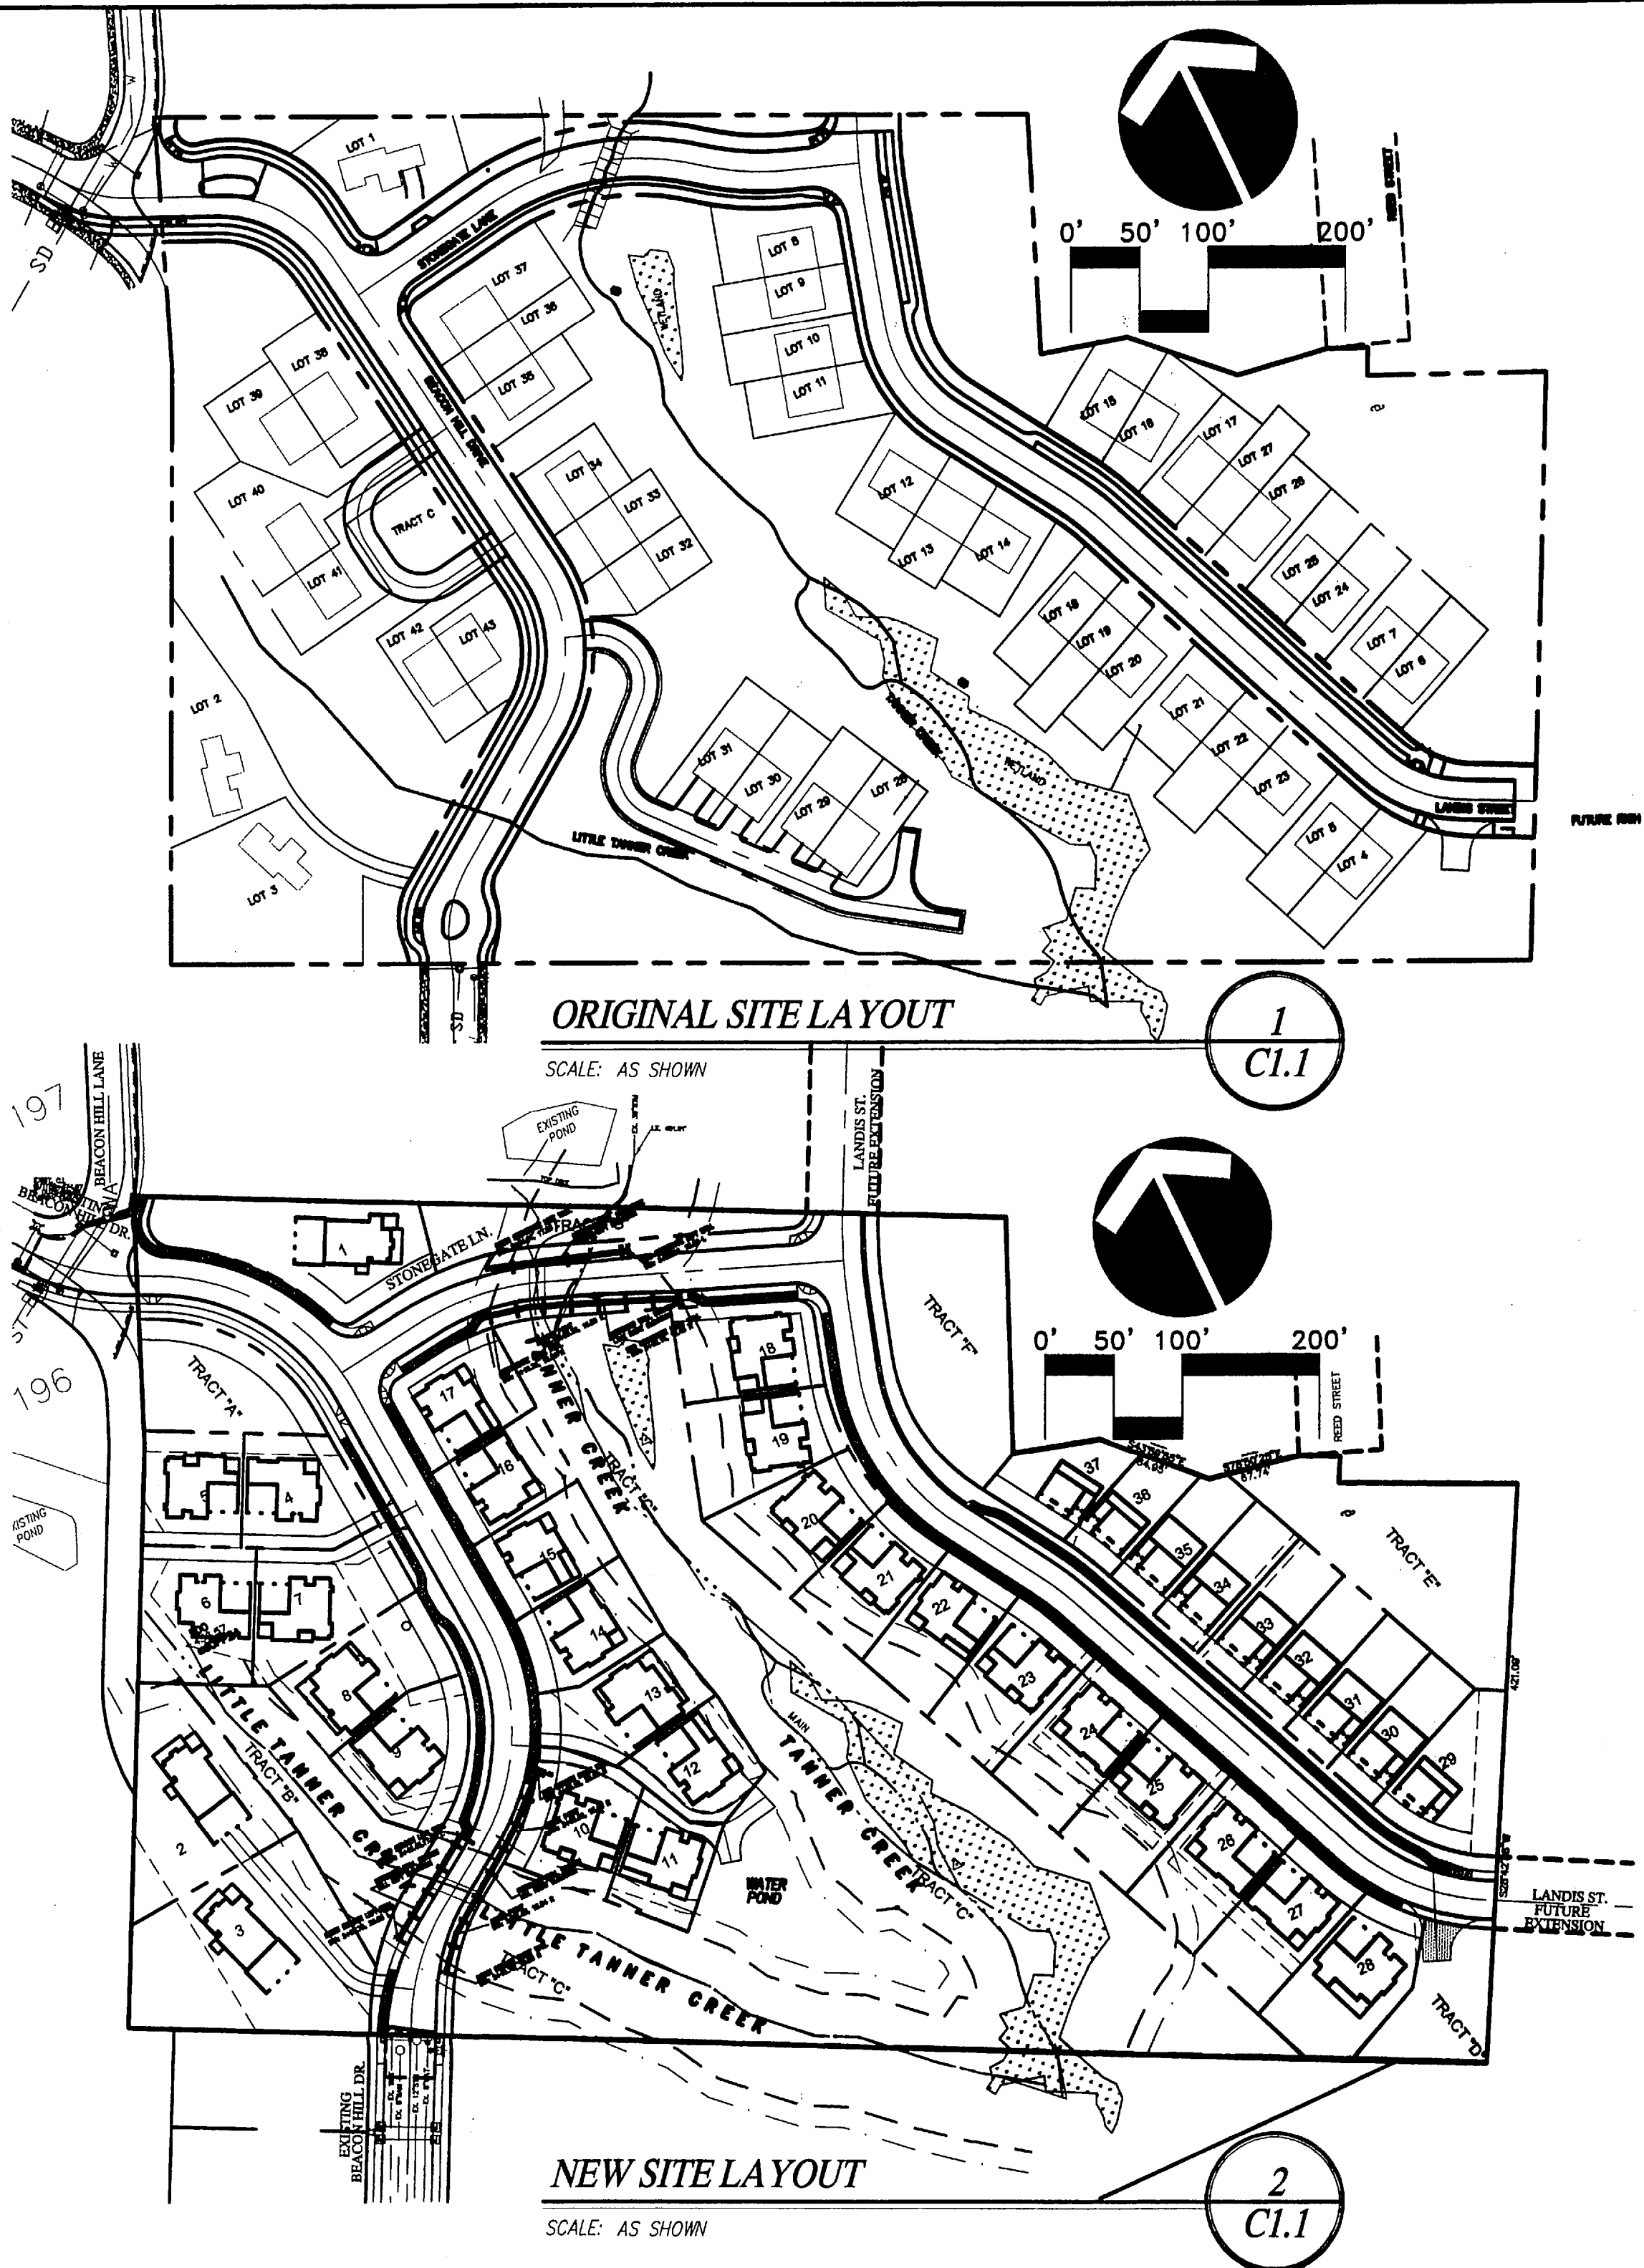

LOT NUMBER REVISIONS									
OLD LOT #	NEW LOT #	OLD LOT #	NEW LOT #	OLD LOT #	NEW LOT #	OLD LOT #	NEW LOT #	OLD LOT #	NEW LOT #
1	1	11	19	21	25	31	10	41	8
2	2	12	20	22	26	32	13	42	9
3	3	13	21	23	27	33	14	43	9
4	28	14	22, 23	24	31	34	15		
5	27, 28	15	37	25	32	35	16		
6	29	16	36	26	33	36	16		
7	30	17	35	27	34	37	17		
8	18	18	22	28	NONE	38	4		
9	18	19	23	29	12	39	5		
10	19	20	24	30	10	40	6,7		

NOTE: CONDITIONS OF APPROVAL REFERENCE THE ORIGINAL SITE LAYOUT AND OLD LOT NUMBERS. THIS TABLE CROSS REFERENCES THE GENERAL AREA OF THE OLD LOT NUMBERS WITH THE NEW LOT NUMBERS OF THE PROPOSED DEVELOPMENT.

08/21/2001
Date
AAH/BLW/JAH
Designed
AAH/BLW/JAH
Drawn
Checked By Date

REVISIONS
BY
DATE
NO.

APPROVED PROFESSIONAL
ENGINEER
46404PE
OREGON
JULIAN ANIS HAYDON
RENEWAL 06/30/2003

NORWAY DEVELOPMENT
P.O. Box 387
Oregon City, Oregon 97045
PHONE: (503) 656-7000
FAX: (503) 656-0686









Tanner's Stonegate
CITY OF WEST LINN, OREGON
CONDITIONS OF APPROVAL

otak
Incorporated
17355 SW Boones Ferry Road
Lake Oswego, OR 97035-5217
Phone: (503) 656-5616
FAX: (503) 656-5366

10579
Project No.
D579C1-1
File No.
C1.1
Sheet No.
Copyright 2001 ©

AS BUILTS

XREF LIST
Ltscale: 40
Resolved
D579X001

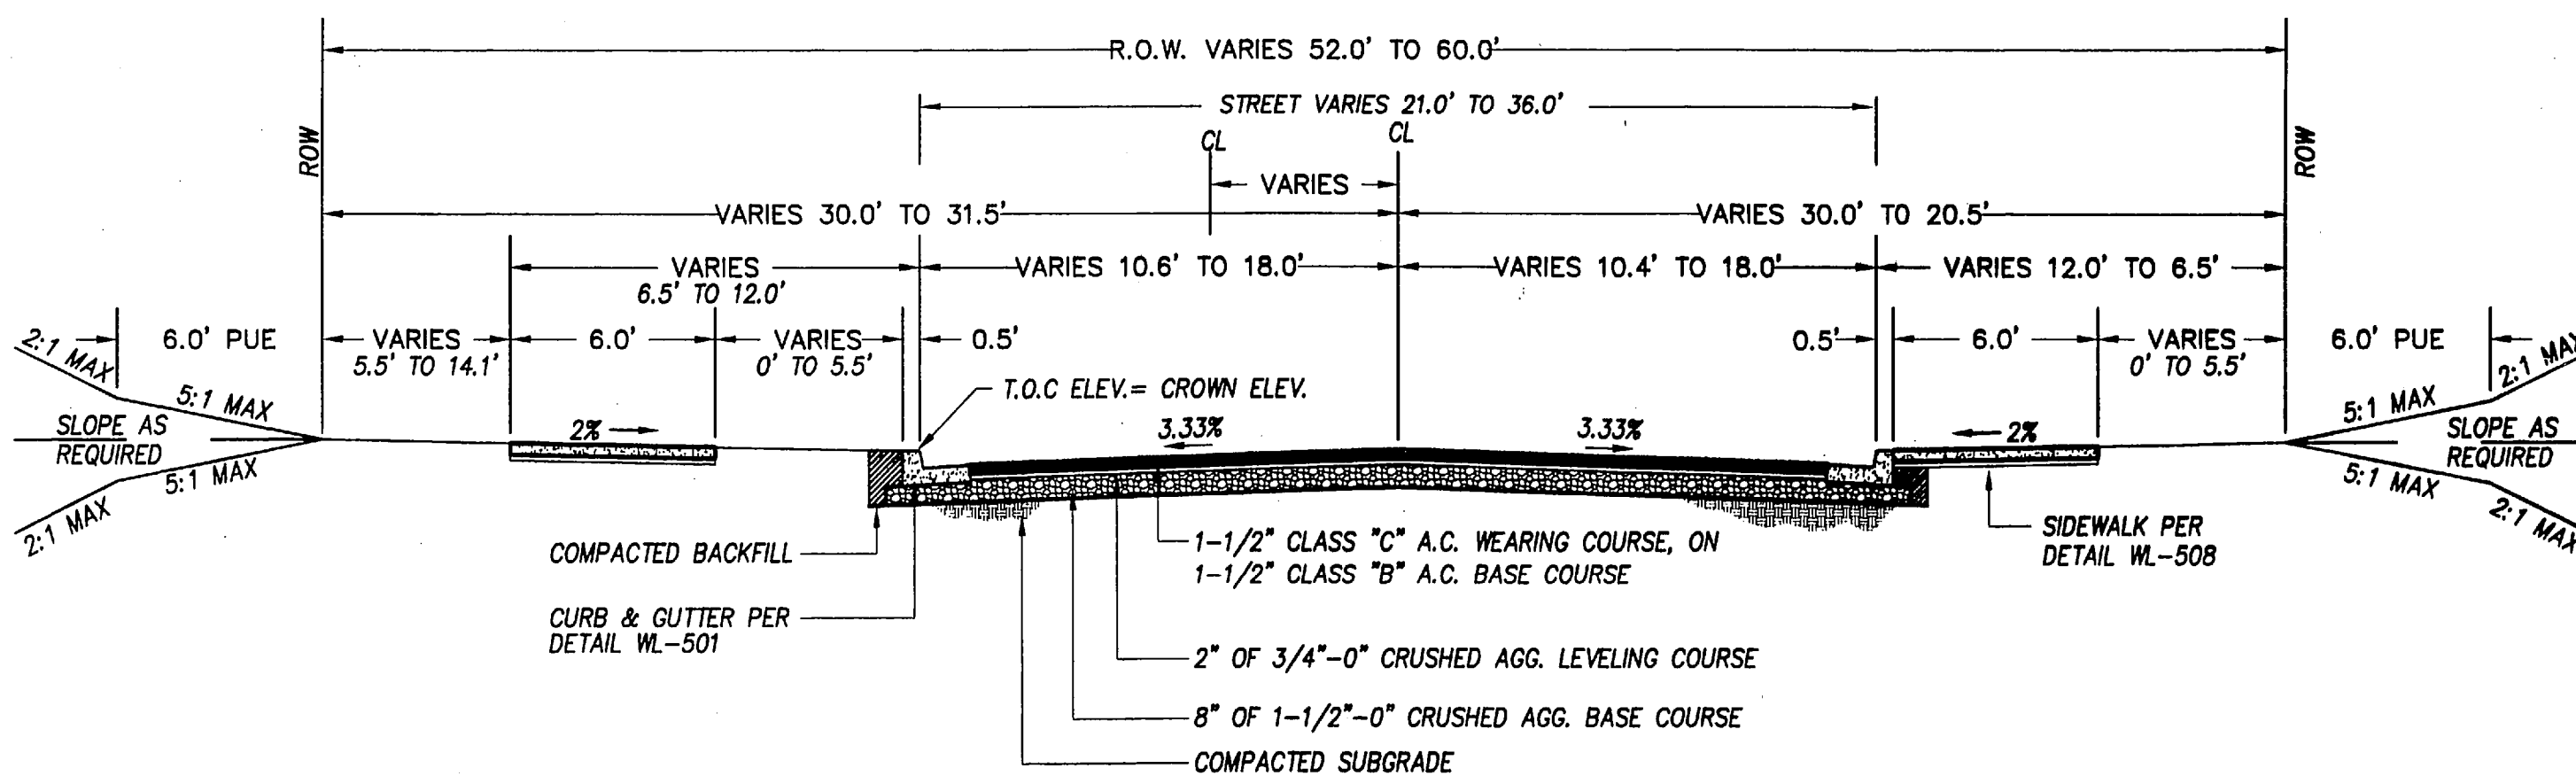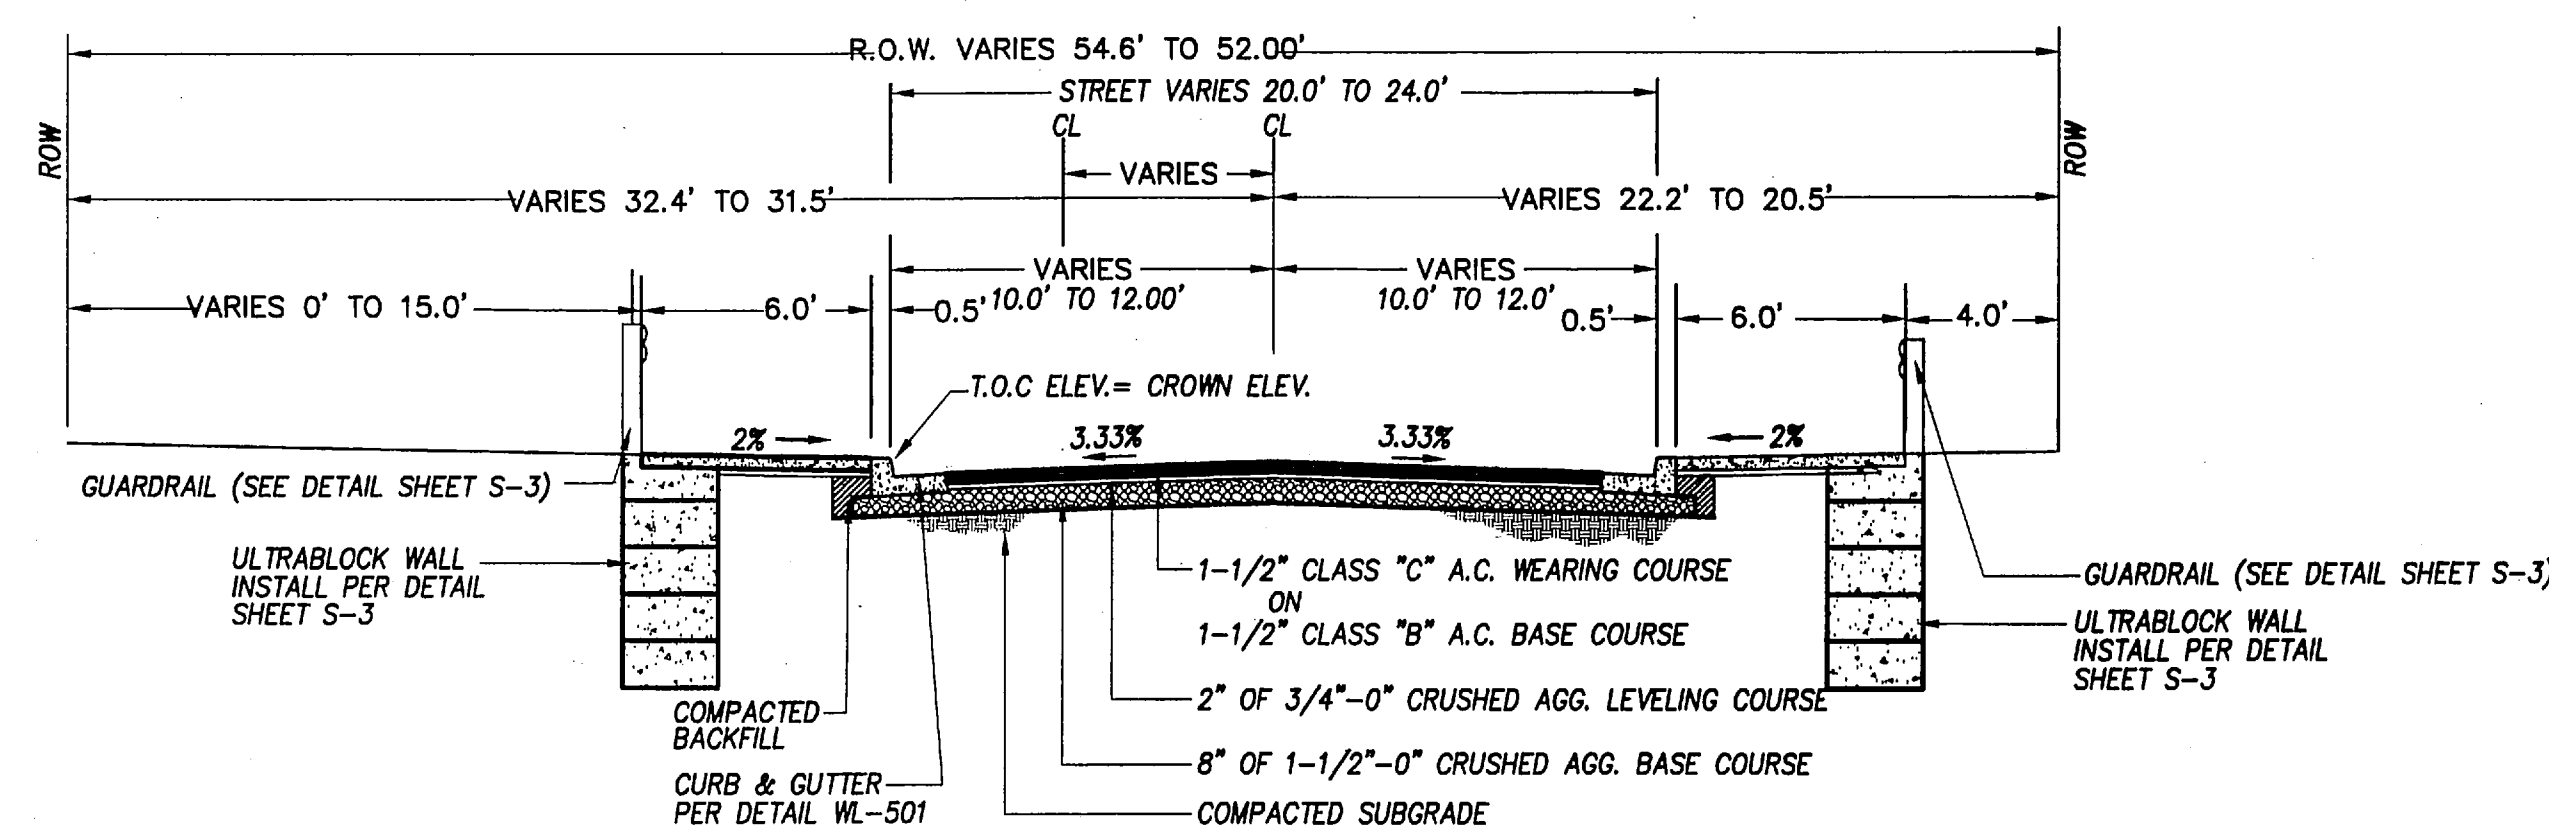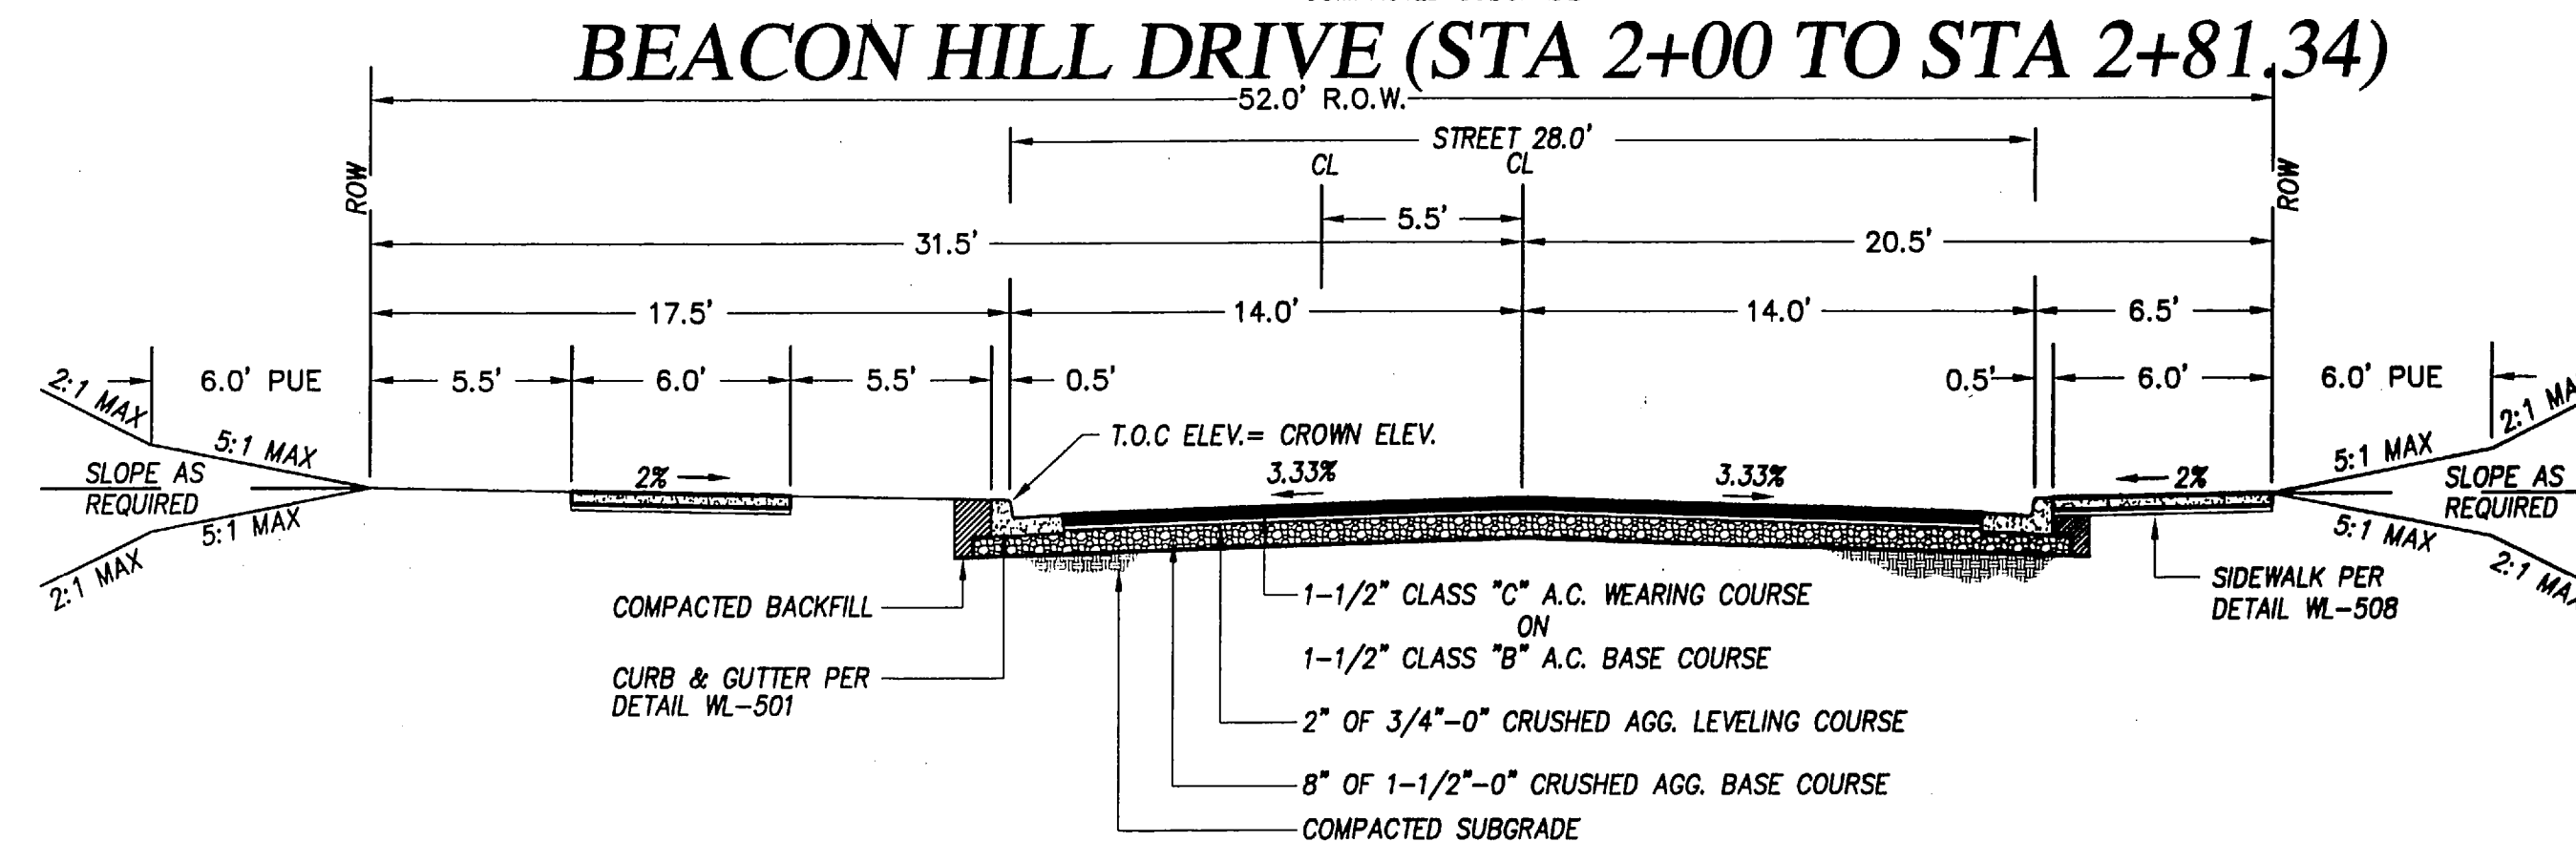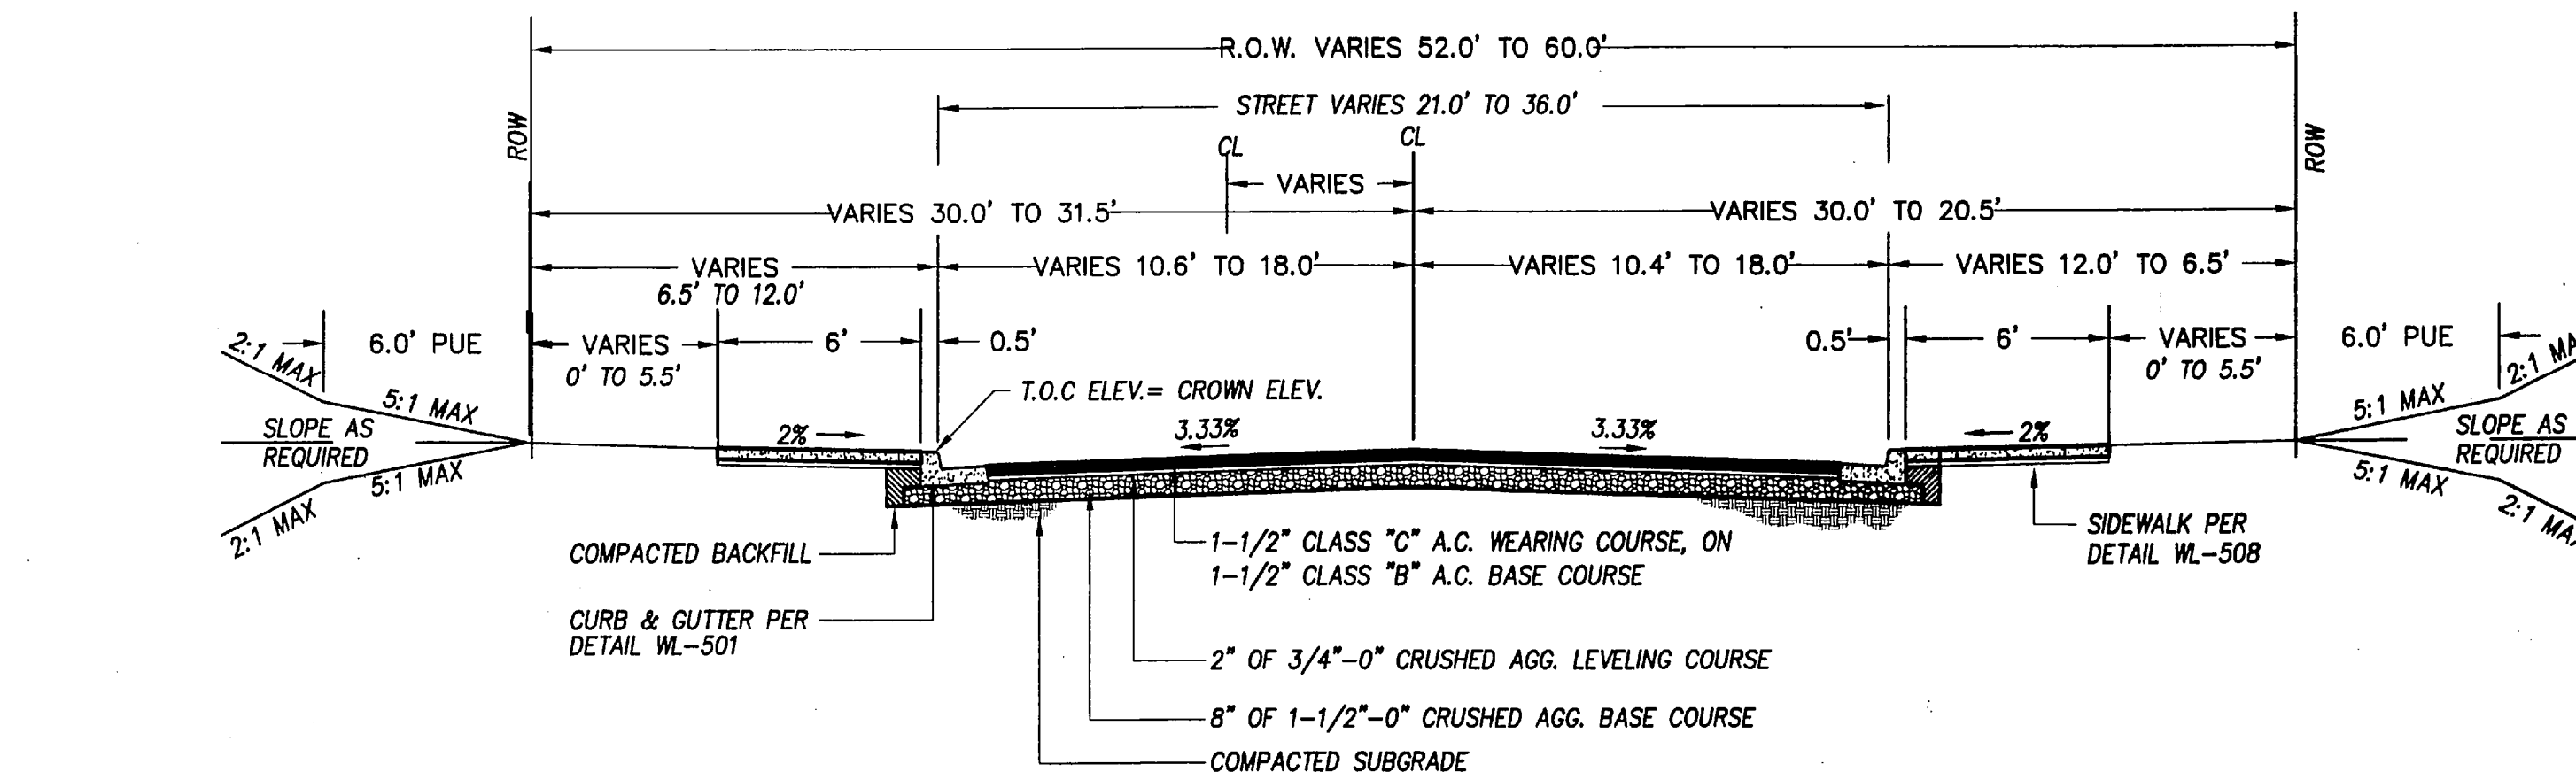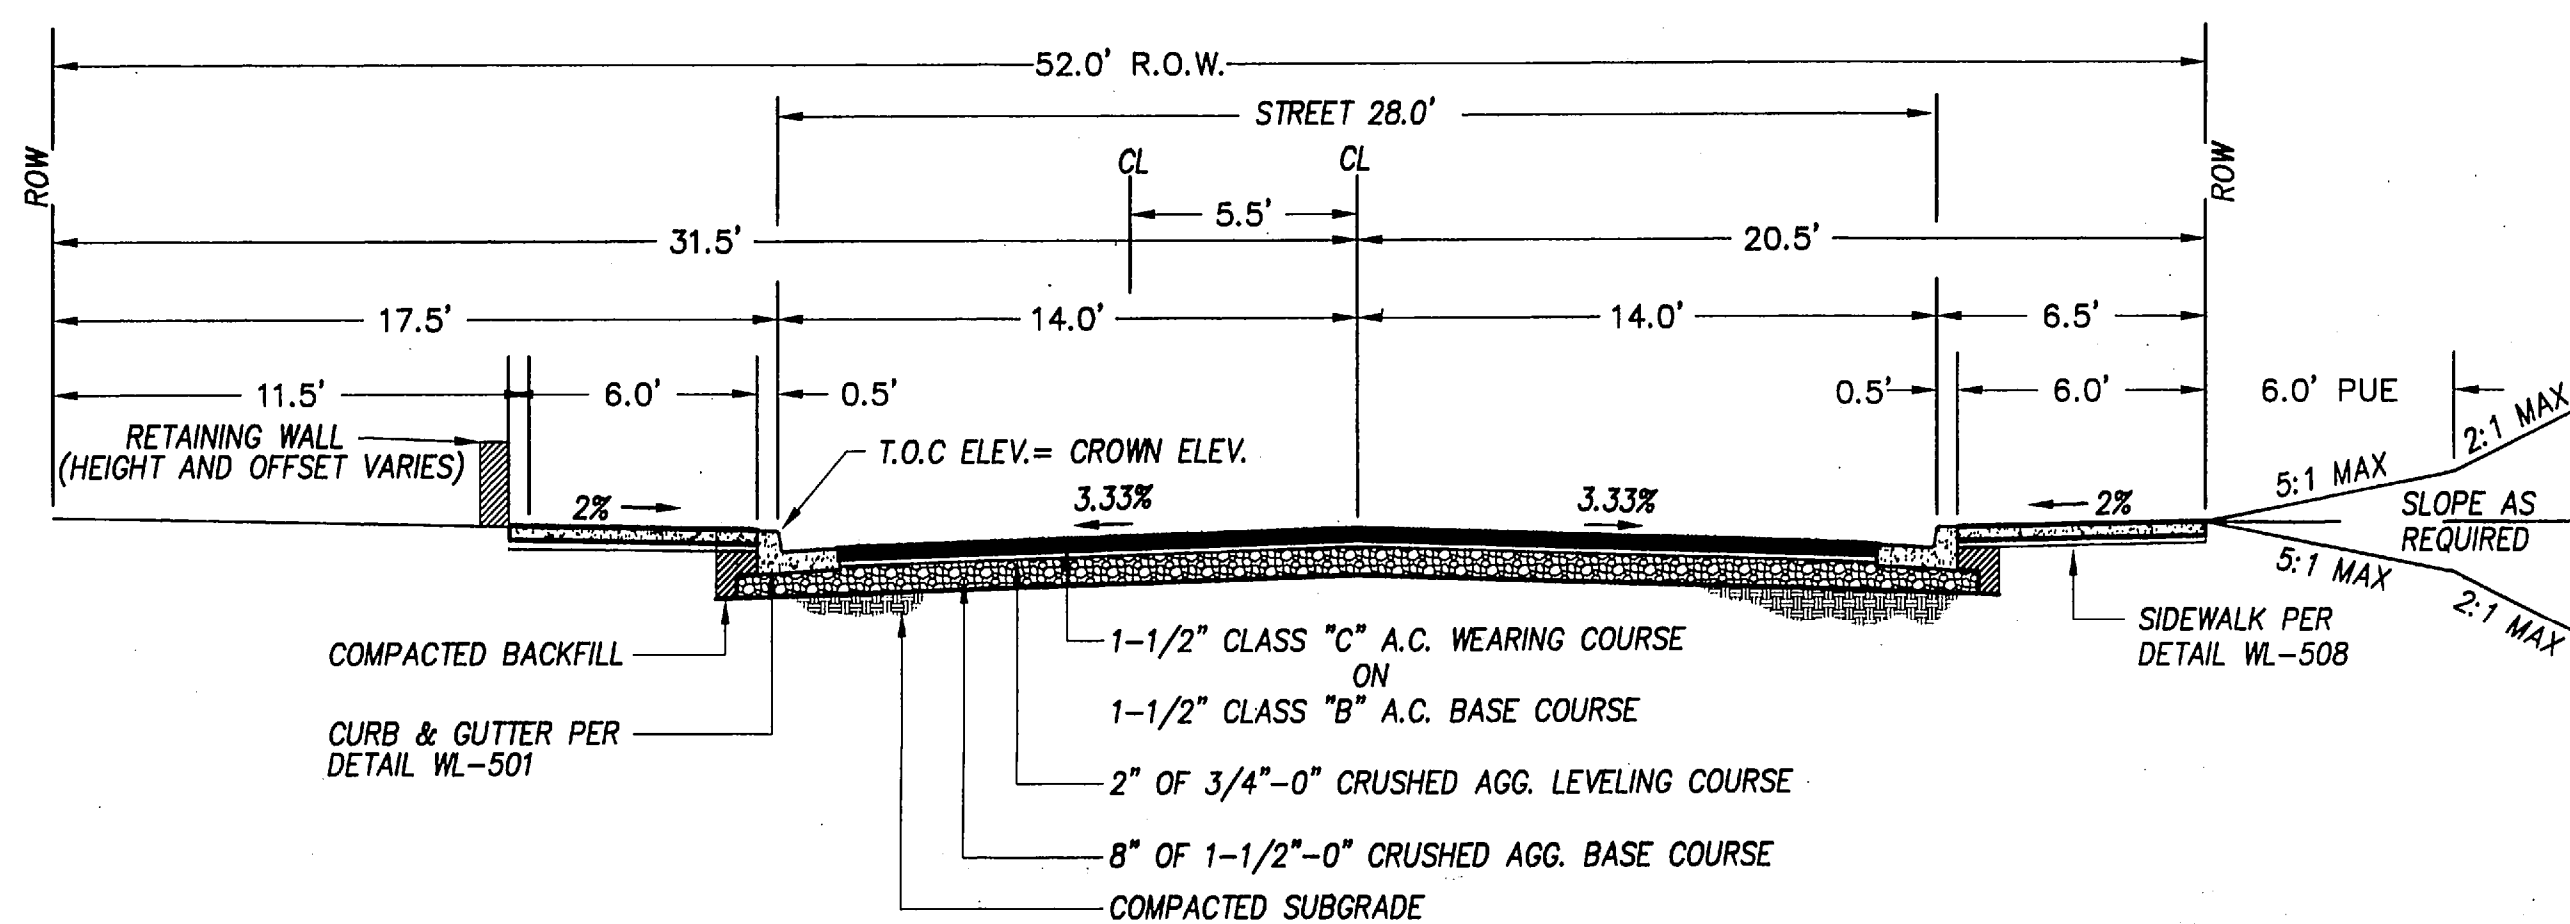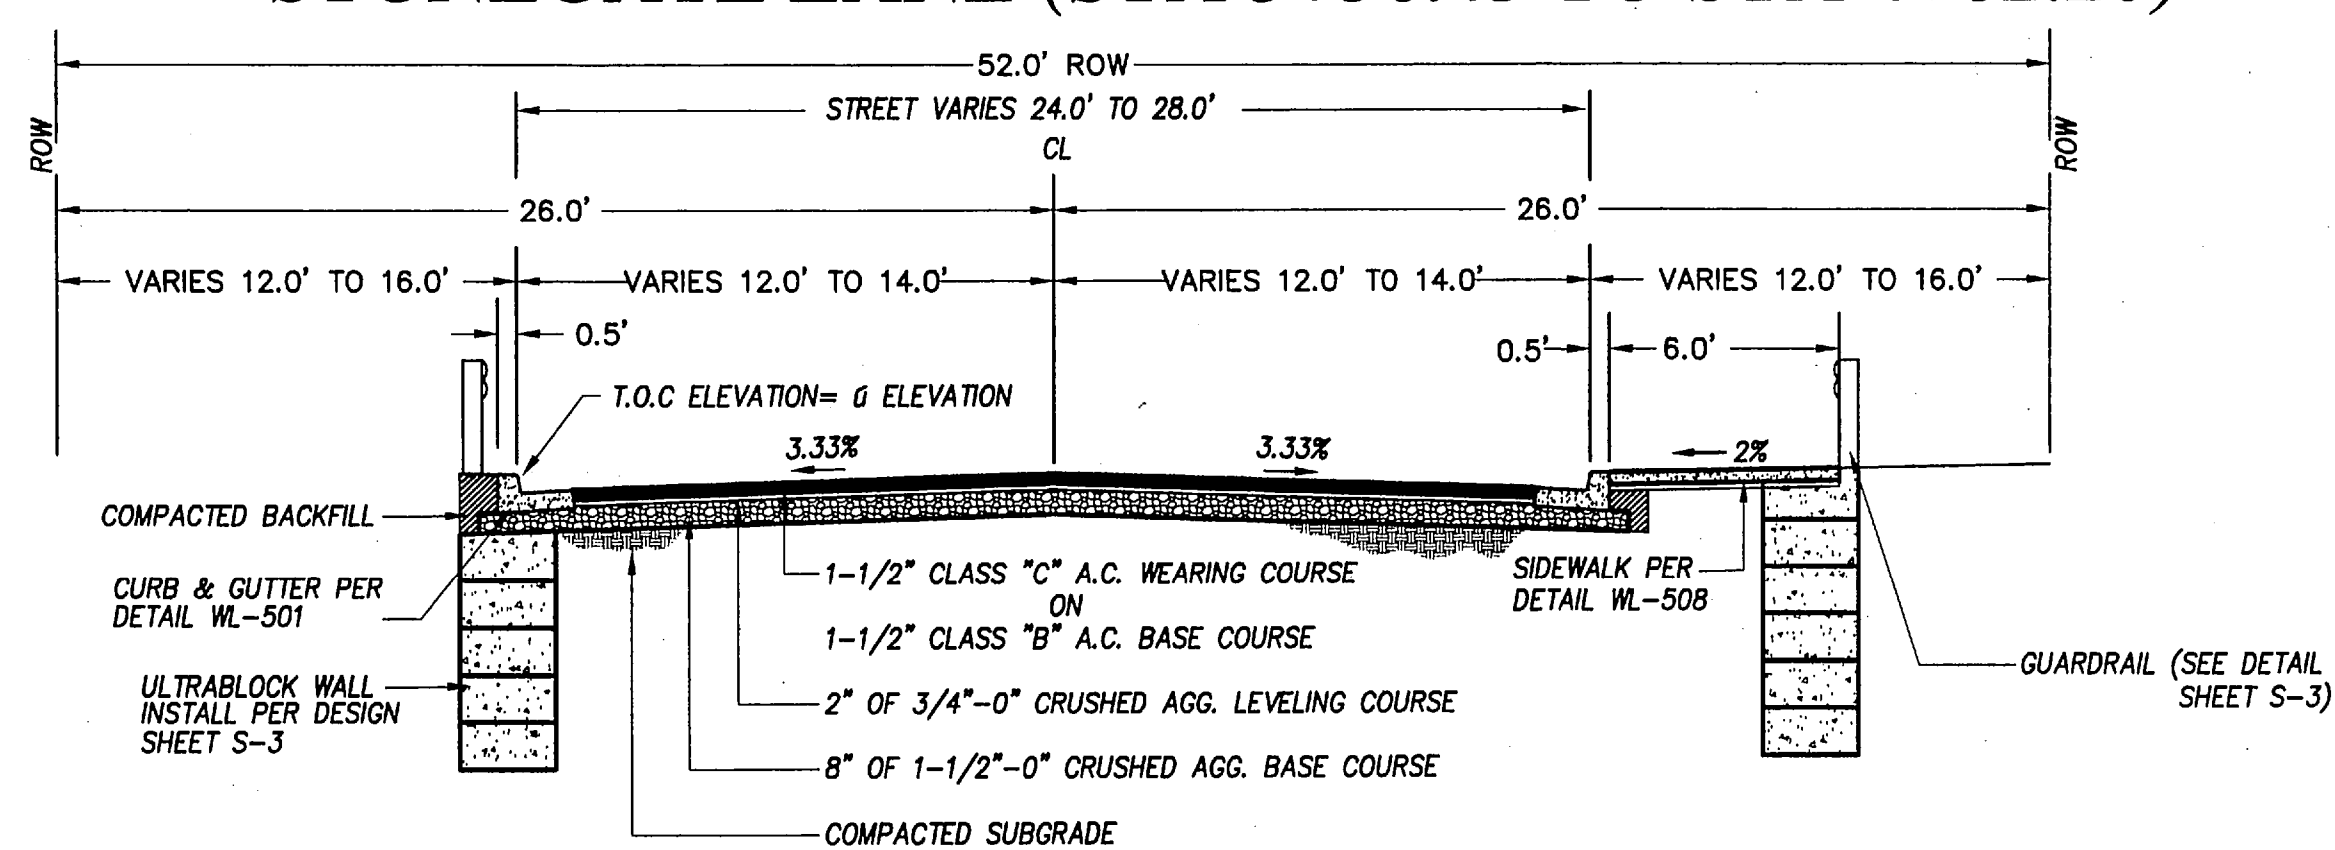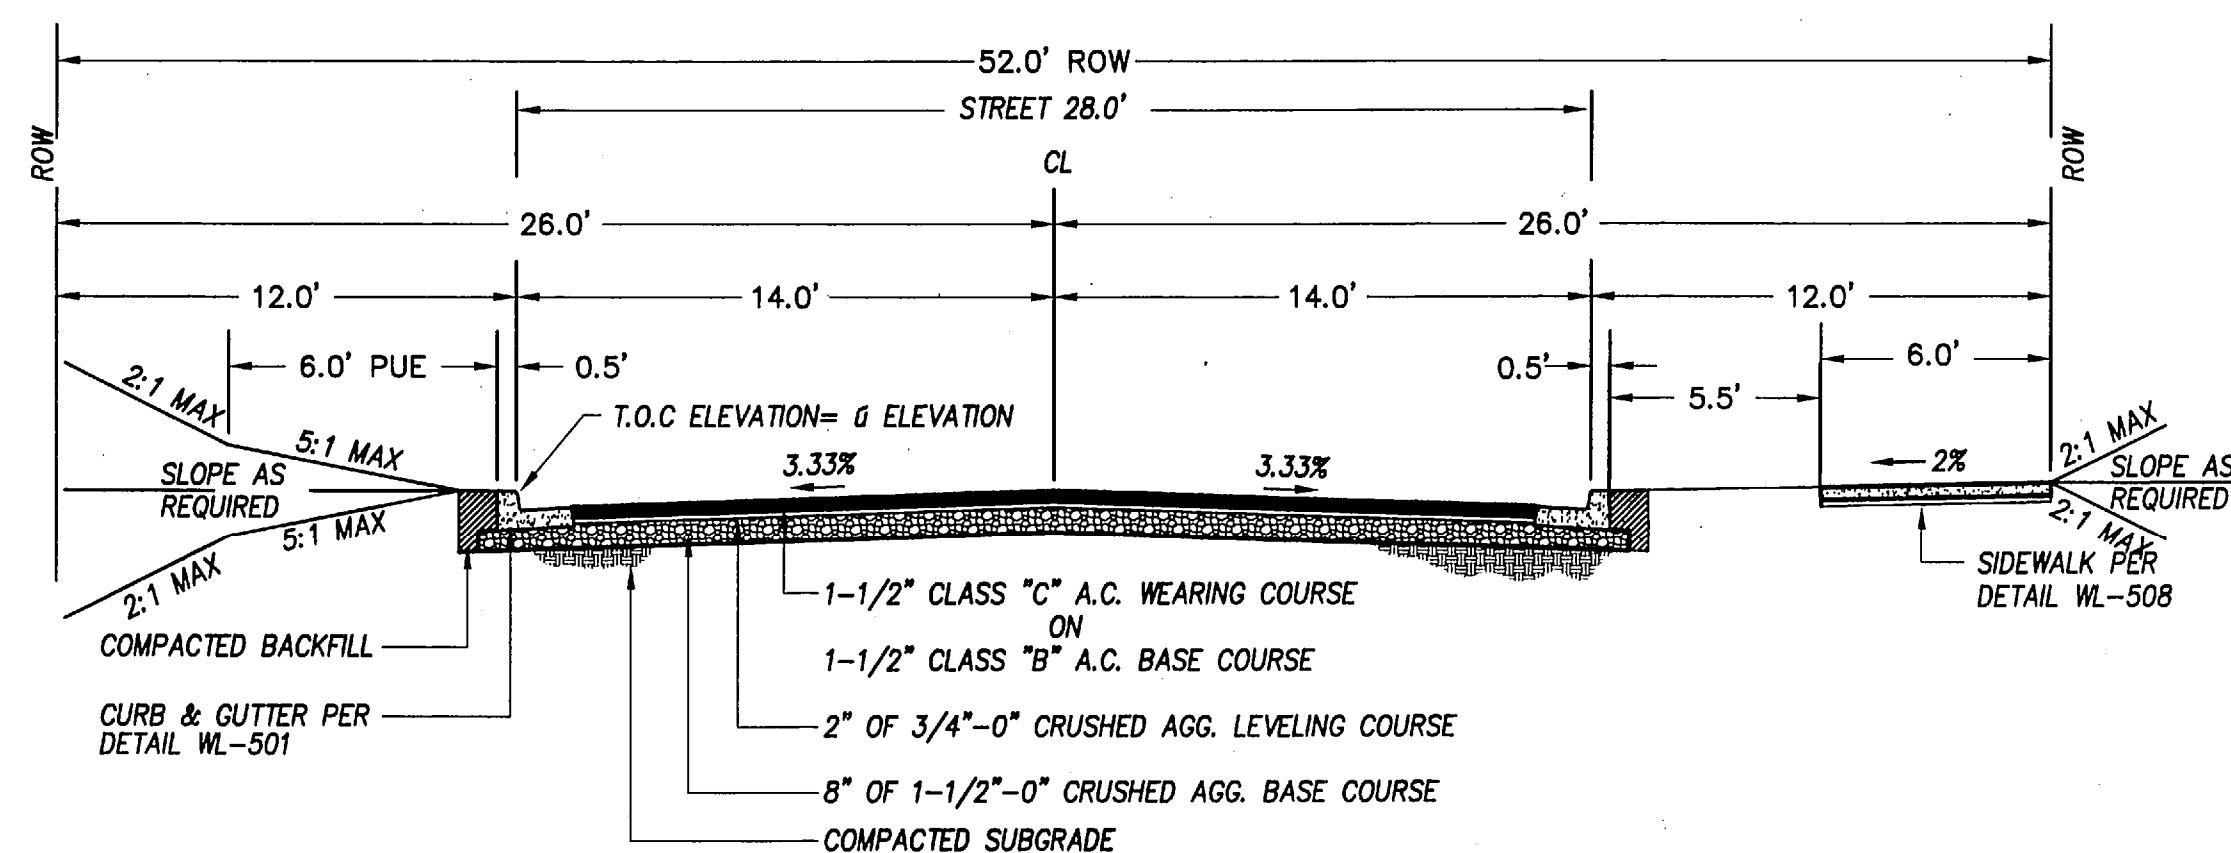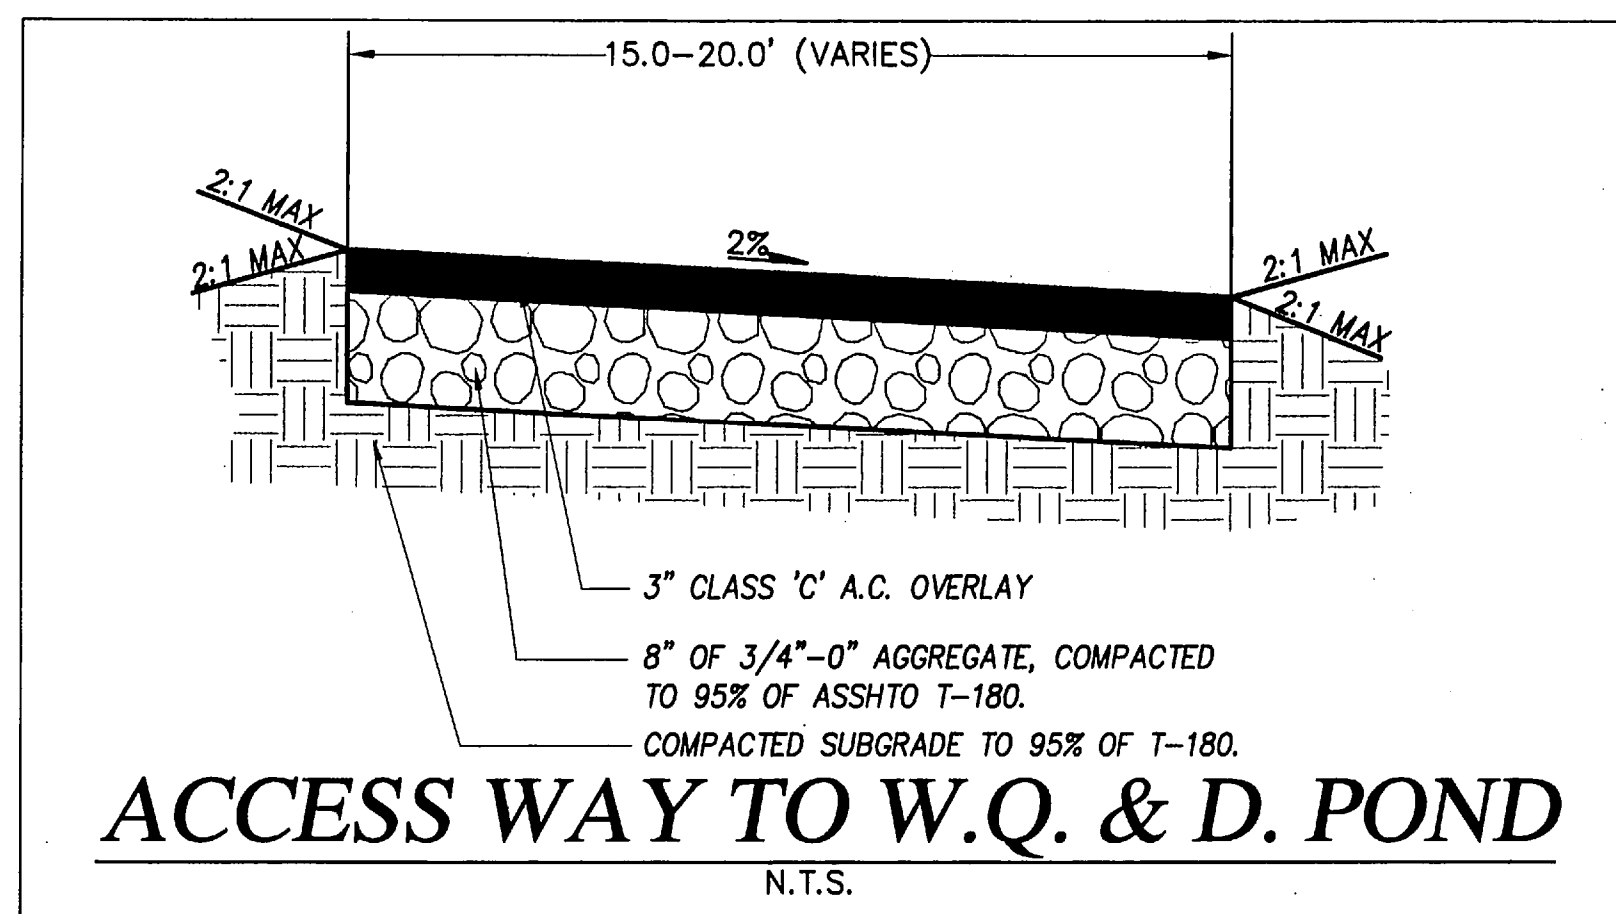

08/21/2001
Date
AAH/BLW/JAH
Designed
AAH/BLW/JAH
Drawn
Checked By Date
REVISIONS
BY APPD.
DATE
NO.

NORWAY DEVELOPMENT
P.O. Box 387
Oregon City, Oregon 97045
PHONE: (503) 656-7000
FAX: (503) 656-0886


Tanner's Stonegate
CITY OF WEST LINN, OREGON
TYPICAL STREET SECTIONS

oak
Incorporated

17355 SW Boones Ferry Road
Lake Oswego, OR 97035-5217
Phone: (503) 635-3818
FAX: (503) 635-5395

AS BUILTS

10579
Project No.
D579C1-2
File No.
C1.2
Sheet No.
Copyright 2001

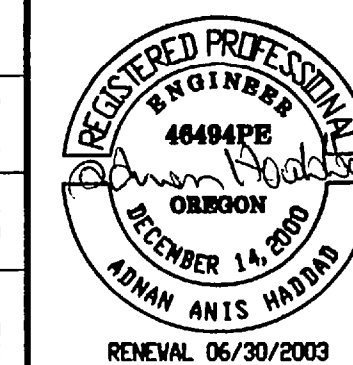














LEGEND

RIGHT-OF-WAY LINE
 FUTURE RIGHT-OF-WAY LINE
 PROPERTY LINE
 LOT LINE
 EASEMENT LINE
 TRANSITION ZONE LINE
 BUILDING SETBACK LINE
 STREET CENTERLINE
 TRAIL

EXISTING UTILITIES

— ST —	STORM LINE
— WA —	WATER LINE
— SA —	SANITARY LINE
///	SAN LINE TO BE ABANDONED IN PLACE
⊗	SANITARY MANHOLE
⊙	STORM MANHOLE
⊕	STORM INLET
⊖	WATER METER
⊗	FIRE HYDRANT
⊙	WATER VALVE
☆	STREET LIGHT
— X —	EXISTING FENCE

PROPOSED UTILITIES

	SS	SANITARY LINE
		SANITARY MANHOLE
	SD	STORM LINE
		STORM DETENTION PIPE
	SD	STORM MANHOLE
		STORM INLET
		WATER LINE
		FIRE HYDRANT ASSEMBLY
		WATER METER WITH CORP. STOP AT WATER MAIN
		WATER VALVE
		WATER BLOW-OFF ASSEMBLY
		WATER AIR-RELEASE ASSEMBLY
		STREET LIGHT

MITIGATION MEASURES

-THE STREAM/WETLAND RESTORATION AND ENHANCEMENTS SHALL BE CONSTRUCTED PRIOR TO OR CONCURRENTLY WITH THE SEWER LINE PROJECT.

-THE STREAM CHANNEL RECONSTRUCTION AREAS SHALL BE PLANTED WITH THE SPECIES OF NATIVE PLANTS AND NUMBERS SPECIFIED IN THE CONSTRUCTION MITIGATION TABLE PAGE 6 AND AS DEPICTED ON FIGURE 6.

-AREAS OF STREAM DISTURBANCE SHALL BE SEEDED OR PLANTED WITH GRASS AND/OR LEGUMES. ALL EXPOSED SOILS SHALL BE STABILIZED IMMEDIATELY AFTER PROJECT'S COMPLETION IN ORDER TO PREVENT EROSION AND SEDIMENTATION ENTERING STREAM SYSTEM.

Riparian Enhancement: 0.18-acre

Black cottonwood, red alder, Pacific willow,
Pacific ninebark, beaked hazelnut,
clustered rose, red fescue, blue wildrye.

Wetland Enhancement: 0.02-ac

Red alder, Pacific willow, Pacific
E WALL ninebark, red-osier dogwood, red
fescue.

TANNER STONEGATE
WEST LINN, OREGON
STREET LIGHTING LEGE

PROPOSED PUBLIC STREET LIGHT: 30-foot, bronze round, tapered, direct bury, fiberglass light pole, with a 150Watt, 240Volt, HPS, "Cobra" style luminaire, mounted on an 6-foot aluminum mastarm, 25-feet above the roadway.

QTY REQUIRED: Three (2) lights.

PROPOSED PUBLIC STREET LIGHT: 30-foot, bronze round, tapered, direct bury, fiberglass light pole, with a 100Watt, 240Volt, HPS, "Shoe box" style luminaire, mounted on an 8-inch mastarm, 25-feet above the roadway.

QTY REQUIRED: Eleven (12) lights.

PROPOSED PRIVATE STREET LIGHT: Same as above but on the private drives. Requires private street light controller, PVC conduit wire & permit.


QTY REQUIRED: Two (2) lights.

Street light electrical design by:
R.J. Rouse Electric, Inc.
19450 SW Cipole Rd., Ste 107
Tualatin, OR 97062
(503) 612-0840, FAX: (503) 612-0891
All per IES, PGE and Municipal street
lighting specifications.

NOTES REGARDING THE ABANDONMENT OF THE EXISTING SANITARY LINE :

- ① PLUG EXISTING I.E. OUT (S.E.)
- ② EXISTING SANITARY LINE TO BE REMOVED WHEREVER IT WILL RUN UNDER A STRUCTURE, AND THE REMAINING TO BE FILLED WITH CDF.
- ③ EXISTING SANITARY MH TO BE FILLED WITH CONCRETE, AFTER REMOVING MIN. 3' FROM THE TOP.
- ④ PLUG EXISTING I.E. IN (W.)

XREF LIST
Ltscale: 1
Resolved
D579X001
D579X190
D579X230
D579X430
TRAILS

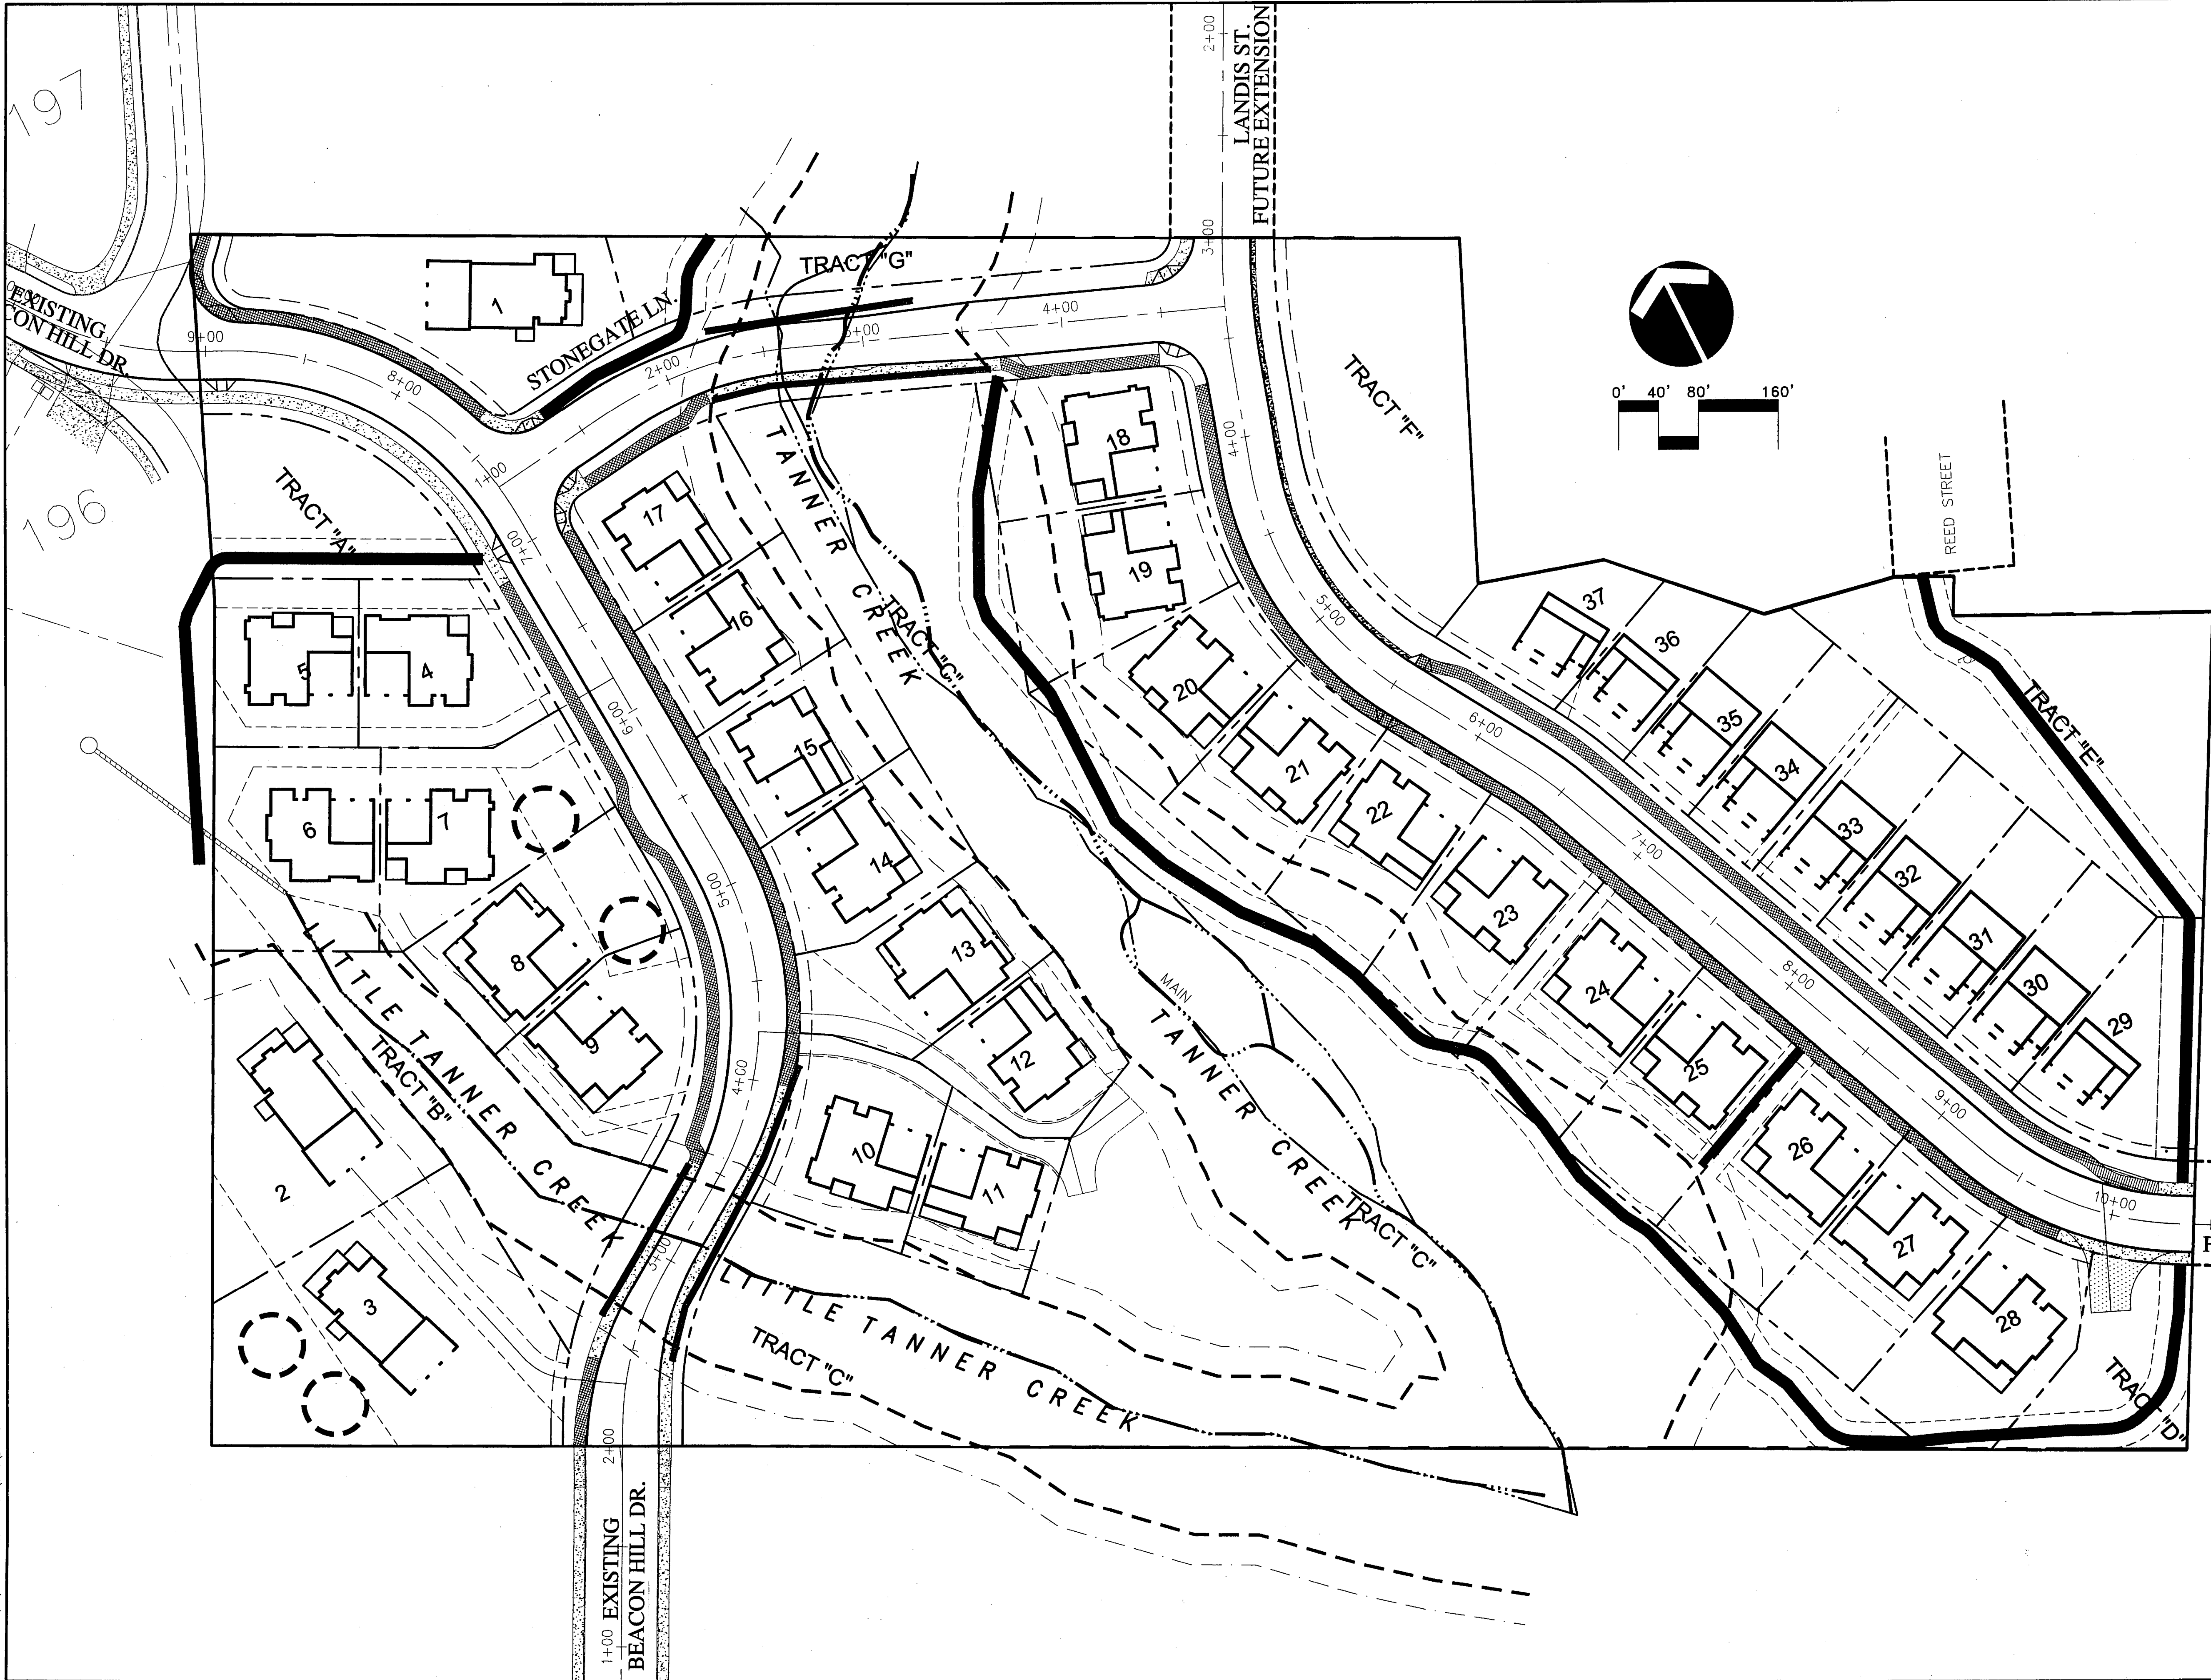

L: ADMANH 11/11/02 7:26am -> R: DWS D579C1-4.DWG

08/21/2001

Date


AAH/BLW/JAH

Designed

AAH/BLW/JAH

Drawn

Checked By Date

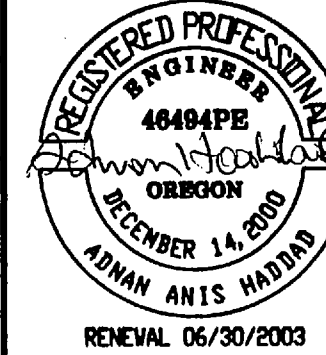

NORWAY DEVELOPMENT
P.O. Box 387
Oregon City, Oregon 97045
PHONE: (503) 656-7000
FAX: (503) 656-0686

Tanner's Stonegate
CITY OF WEST LINN, OREGON
PLAT PLAN

otak
Incorporated
17355 SW Boones Ferry Road
Lake Oswego, OR 97035-6217
Phone: (503) 635-3818
FAX: (503) 635-5395

AS BUILTS

10579

Project No.

D579C1-4


File No.

C1.4

Sheet No.

Copyright 2001

XREF LIST
Ltscale: 1
Resolved
D579X001
D579X190
D579X230
D579X400
D579X430
D579X600
TRAILS

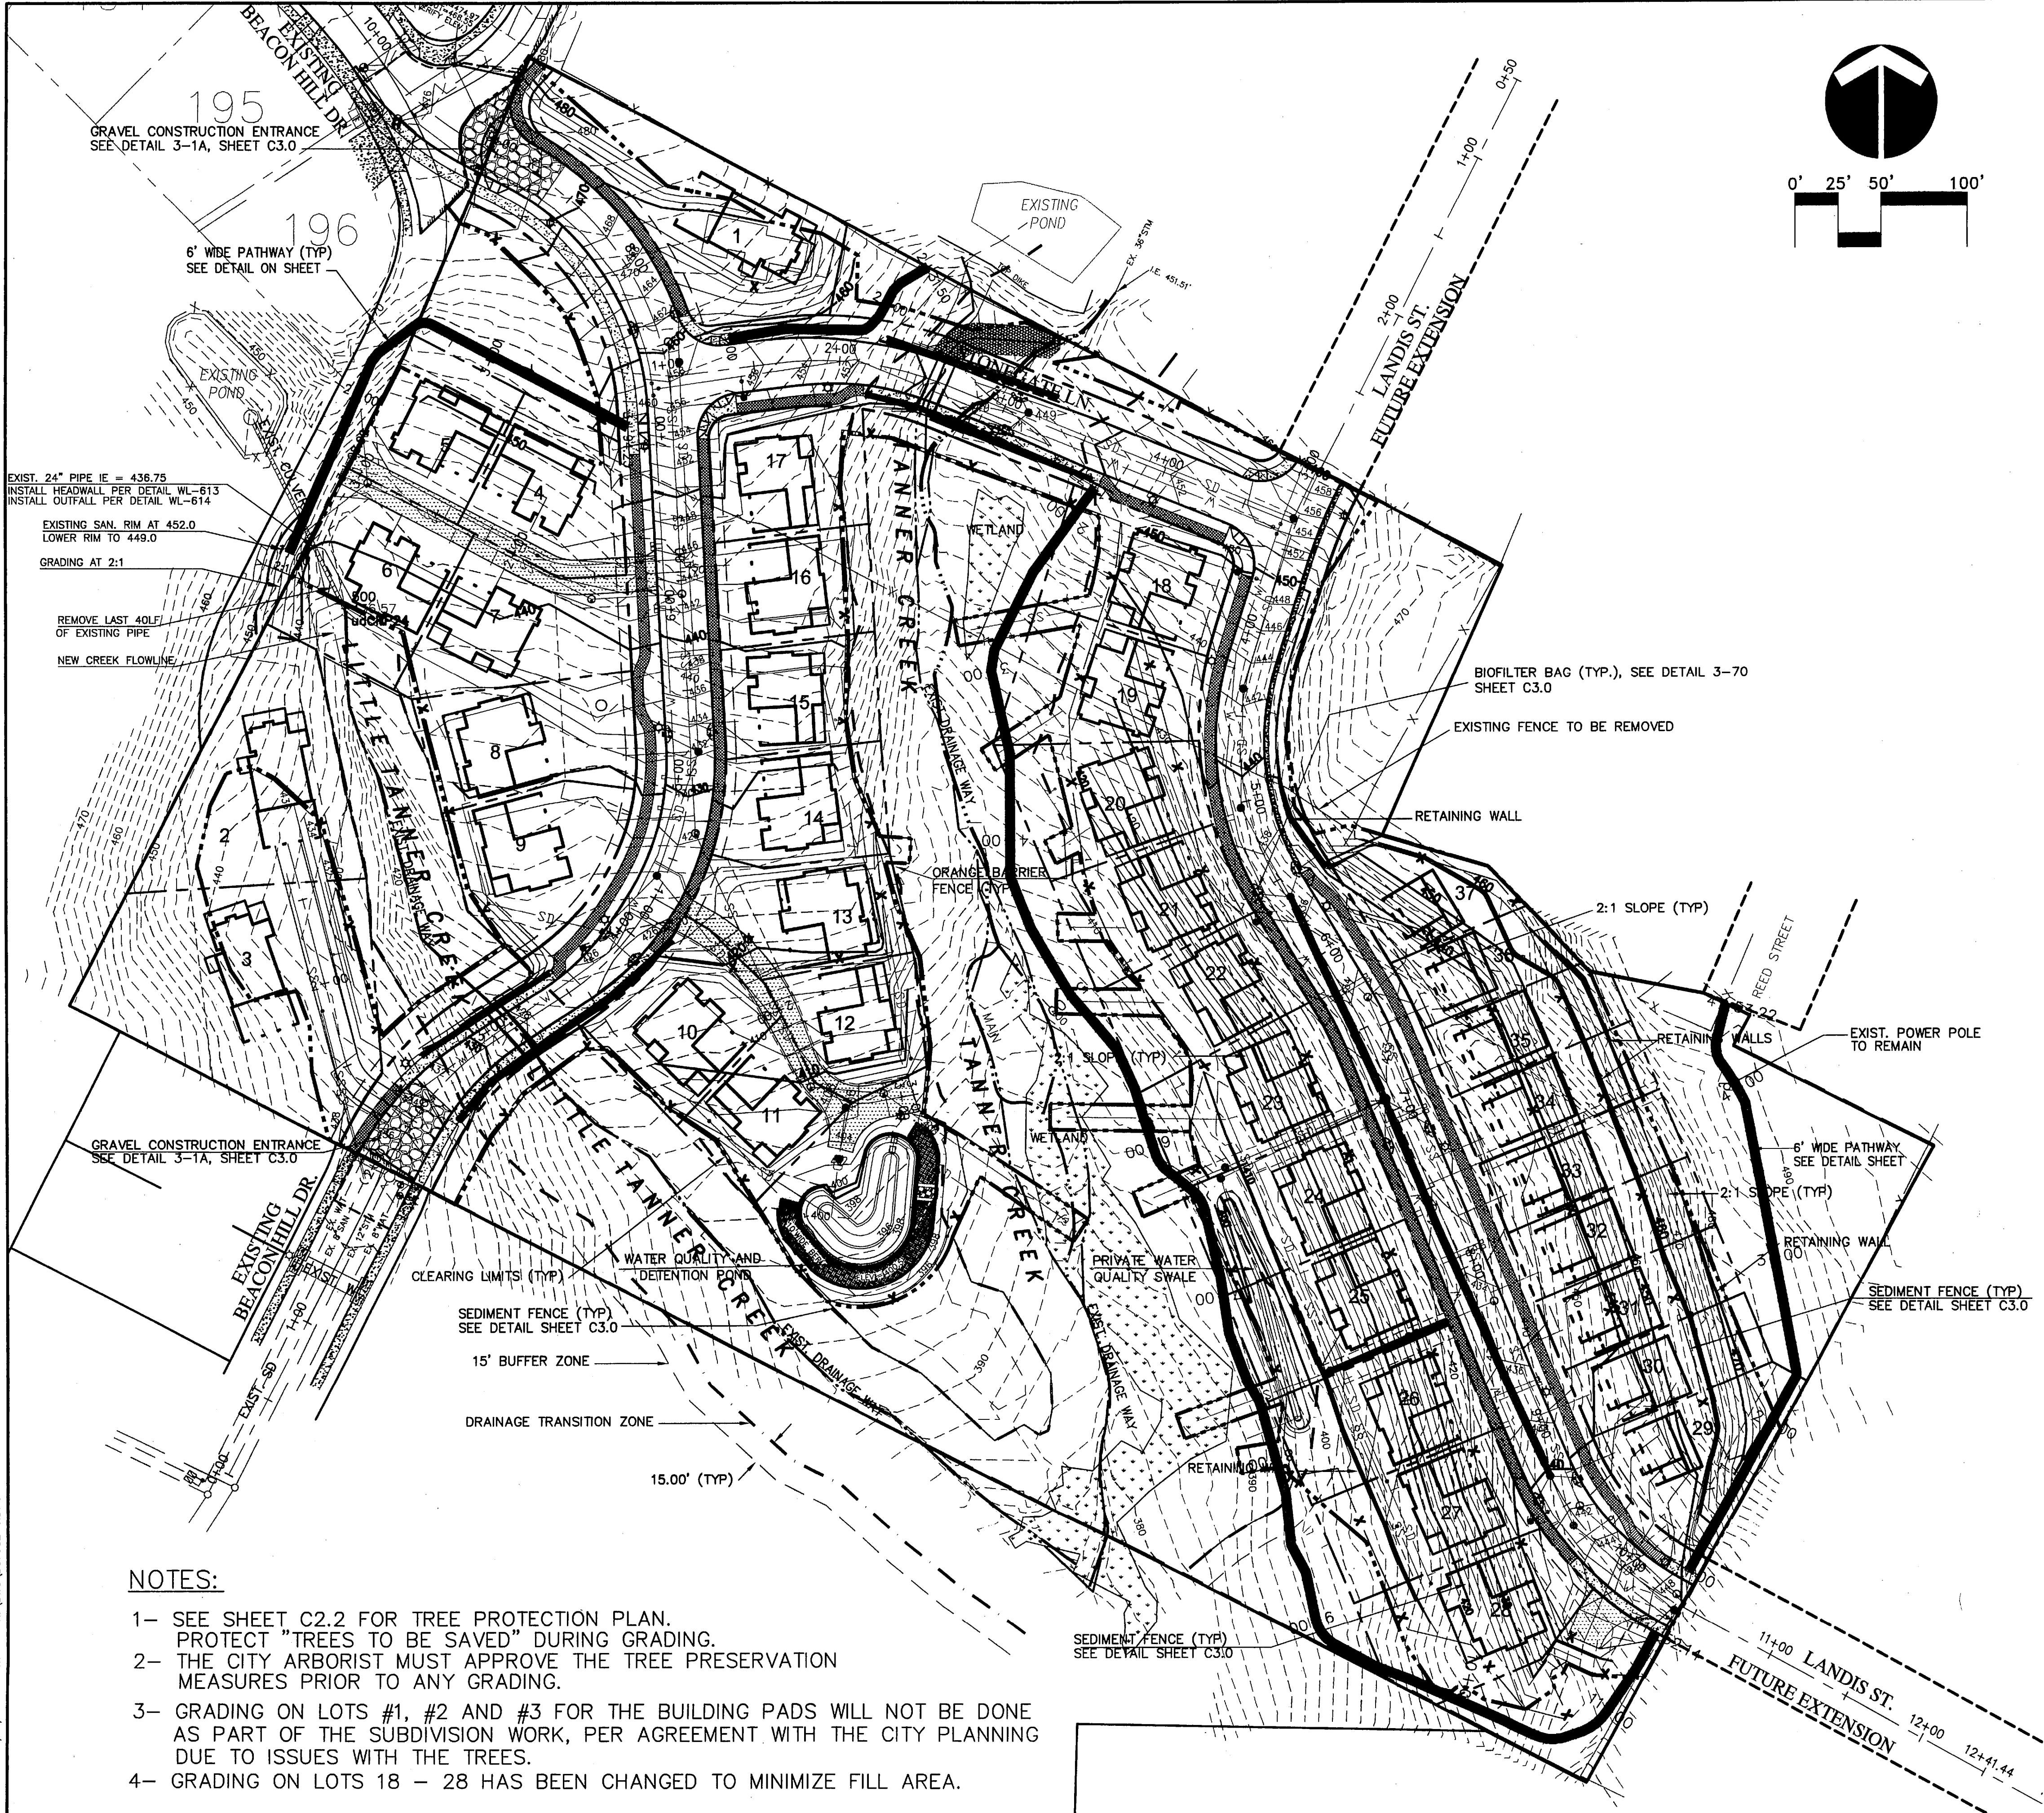


GRADING LEGEND

- 400 --- EXISTING 10' CONTOUR
- 398 --- EXISTING 5' CONTOUR
- 400 --- PROPOSED 10' CONTOUR
- 398 --- PROPOSED 2' CONTOUR
- X --- PROPOSED CLEARING LIMITS
- X --- PROPOSED SEDIMENT FENCE
- X --- ORANGE FENCE (ALONG TRANSITION ZONE)
- X --- PROPOSED CONSTRUCTION FENCE
- X --- PROPOSED CONSTRUCTION ENTRANCE
- X --- CURB INLET WITH SEDIMENT PROTECTION

BUILDING NUMBER	MINIMUM F.F. ELEV.
1	469.00
2	437.00
3	437.00
4	448.00
5	448.00
6	440.00
7	440.00
8	430.00
9	428.00
10	410.00
11	408.00
12	414.00
13	420.00
14	428.00
15	436.00
16	444.00
17	448.00
18	444.00
19	440.00
20	436.00
21	436.00
22	433.00
23	431.00
24	433.00
25	433.00
26	434.00
27	436.00
28	440.00
29	446.00
30	440.00
31	440.00
32	438.00
33	438.00
34	436.00
35	436.00
36	438.00
37	438.00

NOTES:

- SEE SHEET C2.2 FOR TREE PROTECTION PLAN. PROTECT "TREES TO BE SAVED" DURING GRADING.
- THE CITY ARBORIST MUST APPROVE THE TREE PRESERVATION MEASURES PRIOR TO ANY GRADING.
- GRADING ON LOTS #1, #2 AND #3 FOR THE BUILDING PADS WILL NOT BE DONE AS PART OF THE SUBDIVISION WORK, PER AGREEMENT WITH THE CITY PLANNING DUE TO ISSUES WITH THE TREES.
- GRADING ON LOTS 18 - 28 HAS BEEN CHANGED TO MINIMIZE FILL AREA.

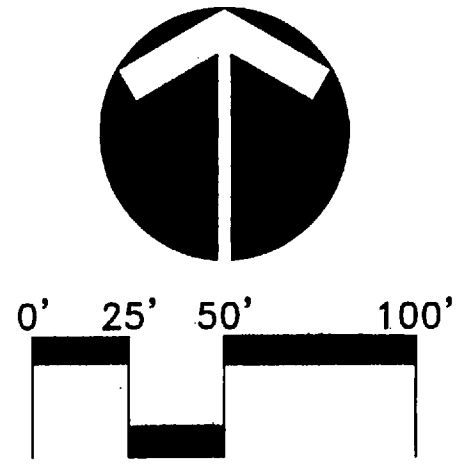

08/21/2001

Date
AAH/BLW/JAH

Designed
AAH/BLW/JAH

Drawn

Checked By Date

REVISIONS

NO. DATE BY APPD.

DATE

NO.

REGISTERED PROFESSIONAL ENGINEER
46494PE
Oregon
RENEWAL 06/30/2003

NORWAY DEVELOPMENT

P.O. Box 387
Oregon City, Oregon 97045
PHONE: (503) 656-7000
FAX: (503) 656-0686

Tanner's Stonegate

CITY OF WEST LINN, OREGON

GRADING AND EROSION CONTROL PLAN

otak

Incorporated

17355 SW Boones Ferry Road
Lake Oswego, OR 97035-5217
Phone: (503) 635-3618
FAX: (503) 635-5395

AS BUILTS

10579





Project No.
D579C2-0

File No.
C2.0

Sheet No.
Copyright 2001

EROSION CONTROL NOTES

1. Owner or designated person shall be responsible for proper installation and maintenance of all erosion and sediment control measures, in accordance with local, State, and Federal regulations.
2. The implementation of these ESC plans and construction, maintenance, replacement, and upgrading of these ESC facilities is the responsibility of the contractor until all construction is completed and approved by the local jurisdiction, and vegetation/landscaping is established. The developer shall be responsible for maintenance after the project is approved until the lots are sold.
3. The boundaries of the clearing limits shown on this plan shall be clearly marked in the field prior to construction. During the construction period, no disturbance beyond the clearing limits shall be permitted. The markings shall be maintained by the applicant/contractor for the duration of construction.
4. The ESC facilities shown on this plan must be constructed in conjunction with all clearing and grading activities, and in such a manner as to insure that sediment and sediment laden water does not enter the drainage system, roadways, or violate applicable water standards.
5. The ESC facilities shown on this plan are minimum requirements for anticipated site conditions. During construction period, these ESC facilities shall be upgraded as needed for unexpected storm events and to ensure that sediment and sediment laden water does not leave the site.
6. The ESC facilities shall be inspected daily by the applicant/contractor and maintained as necessary to ensure their continued functioning.
7. At no time shall sediment be allowed to accumulate more than 1/3 the barrier height. All catch basins and conveyance lines shall be cleaned prior to paving. The cleaning operations shall not flush sediment-laden water into the downstream system.
8. Stabilized gravel entrances shall be installed at the beginning of construction and maintained for the duration of the project. Additional measures may be required to insure that all paved areas are kept clean for the duration of the project.
9. Storm drain inlets, basins, and area drains shall be protected until pavement surfaces are completed and/or vegetation is re-established.
10. Pavement surfaces and vegetation are to be placed as rapidly as possible.
11. Seeding shall be performed no later than September 1 for each phase of construction.
12. If there are exposed soils or soils not fully established from October 1st through April 30th, the wet weather erosion prevention measures will be in effect. See the Erosion Prevention and Sediment Control Planning and Design Manual (Chapter 4) for requirements.
13. The developer shall remove ESC measures when vegetation is fully established.

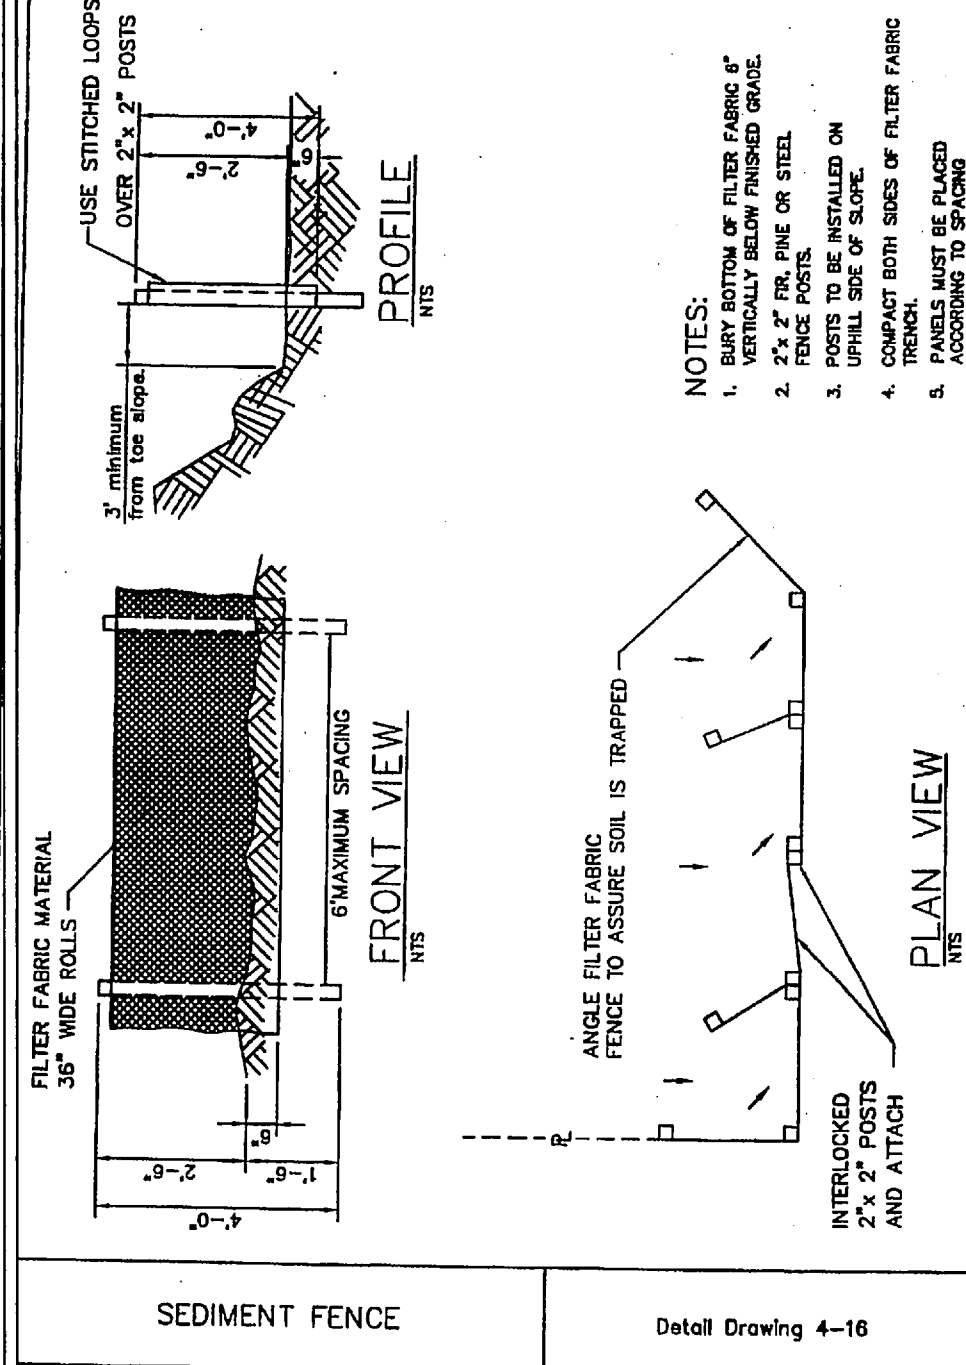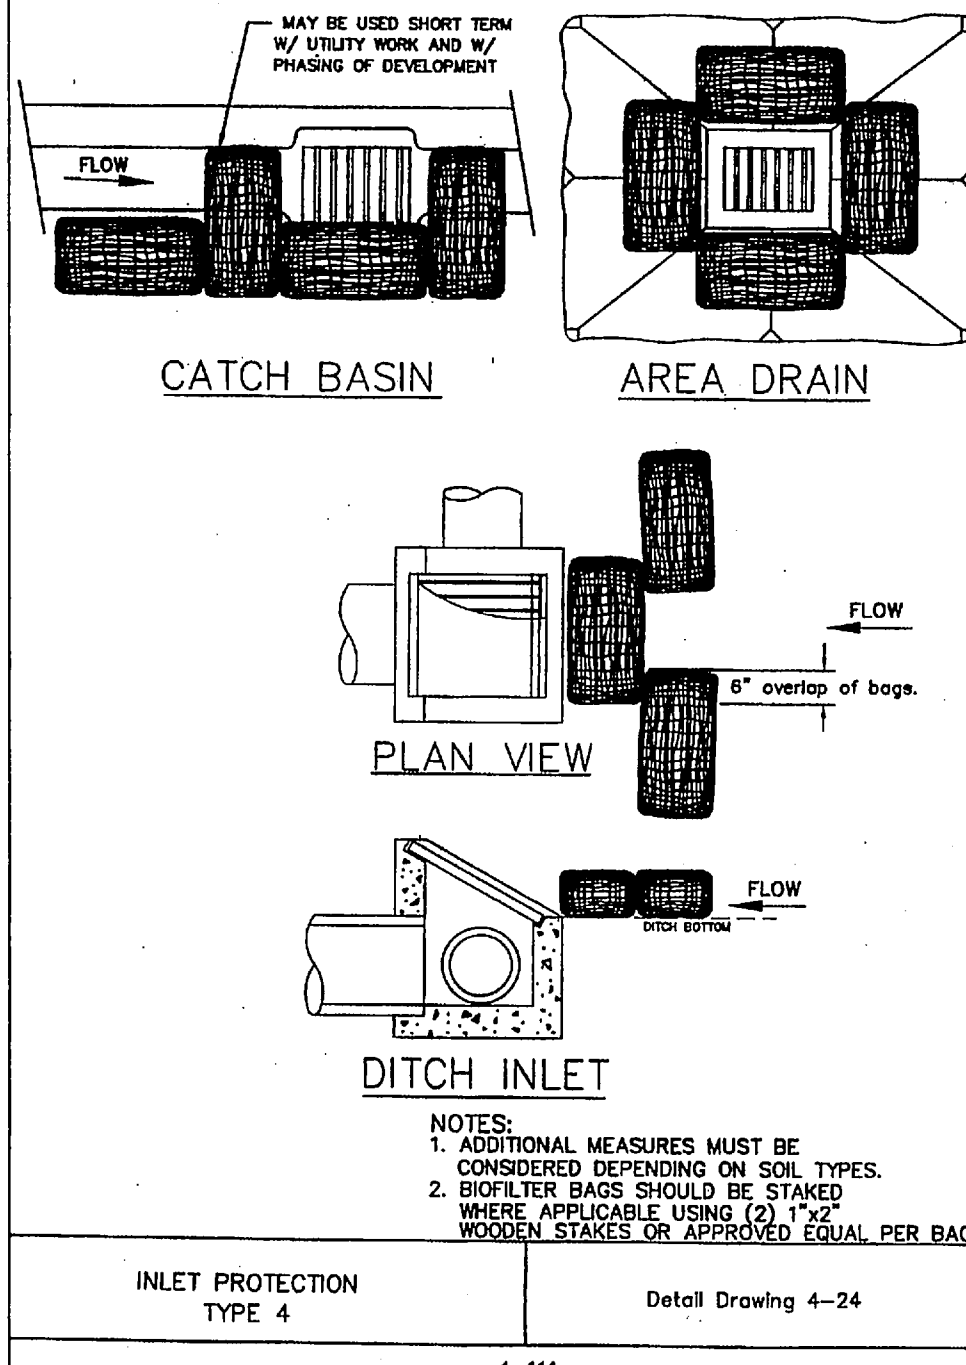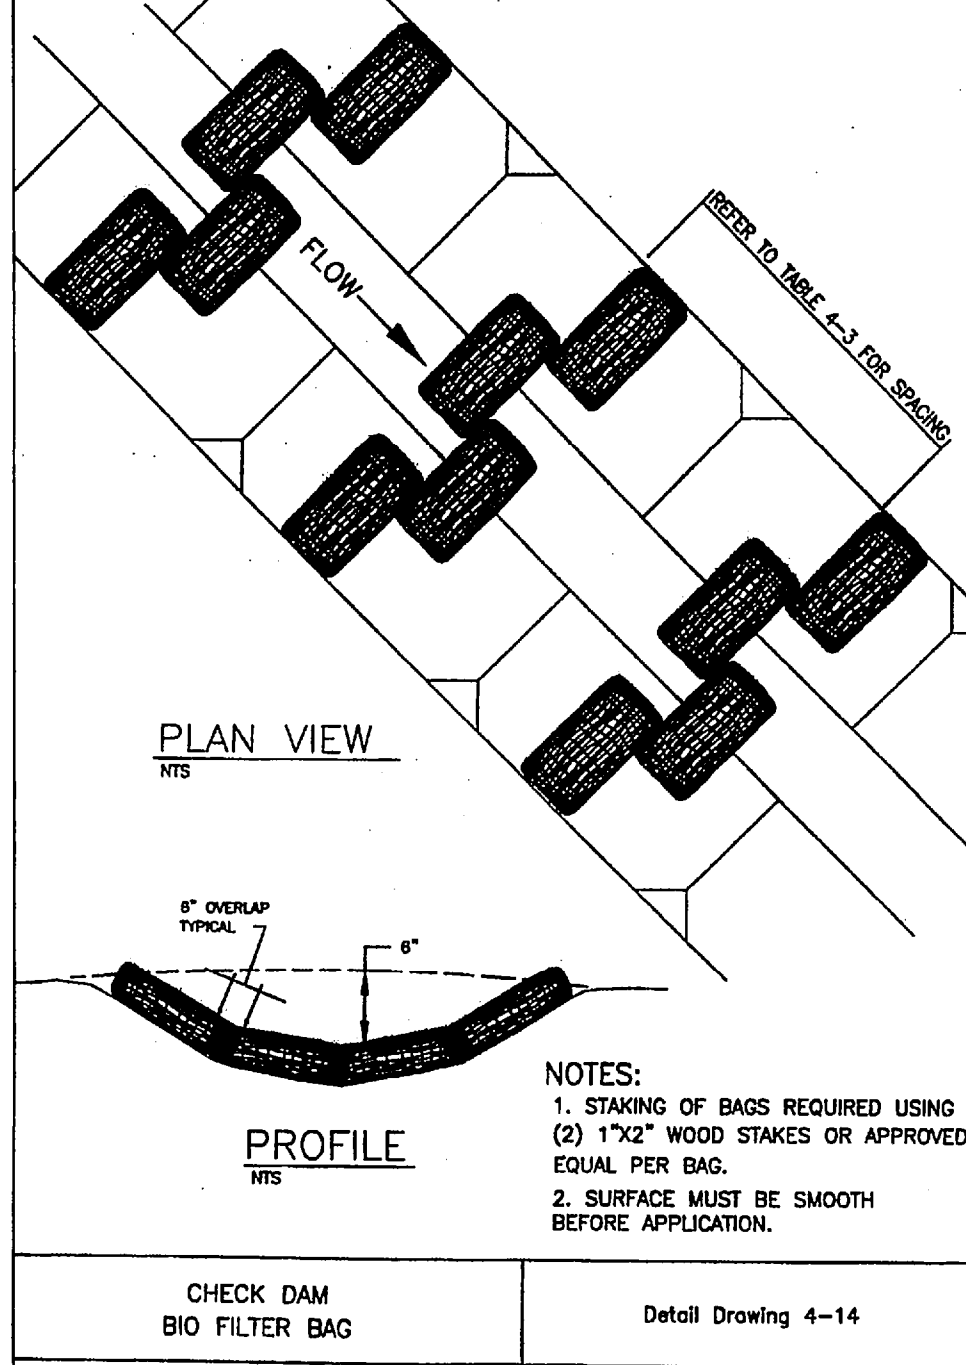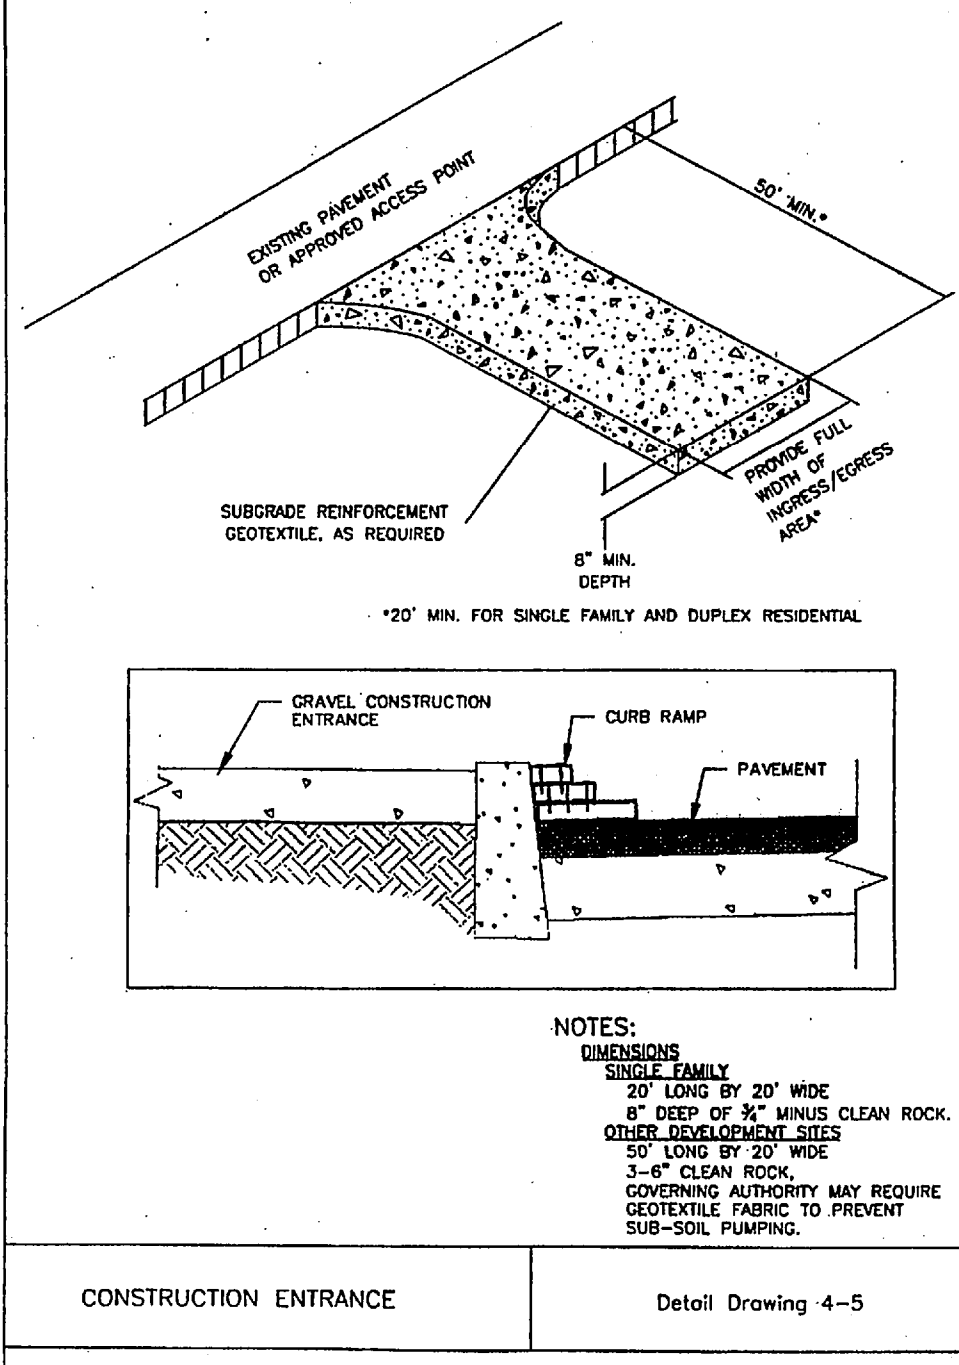

EROSION CONTROL AND POLLUTION CONTROL MEASURES

EROSION CONTROL MEASURES FOR DISTURBED AREAS:

ALL DISTURBED SLOPES GREATER THAN 3:1 THAT HAVE BEEN GRADED AND COMPACTED PRIOR TO OCTOBER 1ST SHALL BE HYDROSEEDING USING THE FOLLOWING SPECIFICATIONS:

SEEDING SHALL NOT BE DONE DURING WINDY WEATHER OR WHEN THE GROUND IS FROZEN, EXCESSIVELY WET OR OTHERWISE UNTILLABLE.

SEED MAY BE SOWN BY THE FOLLOWING METHOD:

HYDROSEED WHICH UTILIZES WATER AS THE CARRYING AGENT, AND MAINTAINS CONTINUOUS AGITATION THROUGH PADDLE BLADES. IT SHALL HAVE AN OPERATING CAPACITY SUFFICIENT TO AGITATE, SUSPEND, AND MIX INTO A HOMOGENEOUS SLURRY THE SPECIFIED AMOUNT OF SEED AND WATER OR OTHER MATERIAL. DISTRIBUTION AND DISCHARGE LINES SHALL BE LARGE ENOUGH TO PREVENT STOPPAGE AND SHALL BE EQUIPPED WITH A SET OF HYDRAULIC DISCHARGE SPRAY NOZZLES WHICH WILL PROVIDE A UNIFORM DISTRIBUTION OF THE SLURRY.

GRASS SHALL BE SEED AT THE RATE OF NOT LESS THAN ONE HUNDRED THIRTY (130) POUNDS PER ACRE. SEED MIX SHALL INCLUDE:

STATE HIGHWAY ROADSIDE SEEDING MIX.

FERTILIZER SHALL BE APPLIED AT THE RATE OF 300 POUNDS PER ACRE.

NITROGEN - 22%

PHOSPHORIC ACID - 16%

SOLUBLE POTASH - 8%

WOOD CELLULOSE FIBER SHALL BE APPLIED AT THE RATE OF ONE AND ONE (1-1/2) TONS PER ACRE.

THE EXACT TIME FOR SEEDING WILL BE DETERMINED BY ACTUAL WEATHER CONDITIONS. THE NORMAL SATISFACTORY PERIOD FOR SEEDING SHALL BE CONSIDERED BETWEEN MARCH 1 TO JUNE 1 AND SEPTEMBER 1 TO OCTOBER 1 UNLESS OTHERWISE AUTHORIZED BY THE OWNER EXCEPT THAT CONTRACTOR MAY PERFORM SEEDING OPERATIONS FROM JUNE 1 TO SEPTEMBER 1 PROVIDED THAT HE WATERS THE NEW GRASS TO THE SATISFACTION OF THE OWNER. WHEN DELAYS IN OPERATIONS CARRY THE WORK BEYOND THE MOST FAVORABLE PLANTING SEASON, OR WHEN WEATHER CONDITIONS ARE SUCH THAT SATISFACTORY RESULTS ARE NOT LIKELY TO BE OBTAINED FOR ANY STAGE OF THE SEEDING OPERATIONS, THE CONTRACTOR WILL STOP THE WORK AND IT SHALL BE RESUMED ONLY WHEN THE DESIRED RESULTS ARE LIKELY TO BE OBTAINED. IF OPERATIONS EXTEND PAST OCTOBER 1 ALTERNATE HAY PLACEMENT AND SPRING SEEDING SHALL BE SUBSTITUTED.

THE CONTRACTOR SHALL PROTECT ALL SEEDING AREAS FROM EROSION UNTIL FINAL INSPECTION AND ACCEPTANCE HAS BEEN MADE. AREAS DAMAGED BY EROSION SHALL BE REPAIRED BY THE CONTRACTOR AT HIS OWN EXPENSE.

ALL DISTURBED AREAS WITH SLOPES LESS THAN 3:1 THAT HAVE BEEN GRADED AND COMPACTED SHALL BE SEED PRIOR TO OCTOBER 1, WITH THE SAME SEED AND FERTILIZER MIX AS USED IN HYDROSEEDING AND SPREAD EVENLY OVER THE SITE.

ALL DISTURBED AREAS NOT GRADED AND COMPACTED PRIOR TO OCTOBER 1, SHALL BE SEED WITH 200 LBS PER ACRE OF HIGHWAY MIX AND SPREAD WITH A HAY MULCH LAYER 1 1/2" TO 2" THICK.

EROSION CONTROL PROTECTION SHALL BE CONSIDERED COMPLETE AND SUCCESSFUL WHEN A GRASS MAT HAS BEEN ESTABLISHED.

ADDITIONAL TEMPORARY EROSION CONTROL (DURING CONSTRUCTION)

HAY BALES WILL BE PLACED AT THE TOP OF ALL MAJOR FILL SLOPES WHEN NECESSARY, TO PREVENT SILT FROM WASHING INTO EXISTING DRAINAGE WAYS. (SILTATION BARRIER).

TEMPORARY DITCHES WILL BE CONSTRUCTED AS NECESSARY TO ASSURE DRAINAGE IS CHanneled TO THE FACILITIES BEING PROVIDED.

IF CONSTRUCTION TAKES PLACE DURING RAINY SEASON, HAY BALES AND "MIRAFI" 140 S FABRIC WILL BE REQUIRED AT ALL STORM DRAINAGE INLETS UNTIL ROCKING OF STRETCH IS COMPLETED AND DISTURBED SLOPES STABILIZED BY HYDROSEEDING.

EROSION CONTROL MATRIX

EROSION MEASURES	1	2	3	4	5	6	7	8	9	10	11	12	13	14
GRAVEL CONSTRUCTION ENTRANCE														
SEDIMENT FENCE/BARRIER AT TIDE OF DISTURBED AREA OR STOCKPILE														
SIDEWALK SUBGRADE GRAVEL BARRIER (SITE SLOPES TO STREET AT 13% GRADE) ALTERNATE TO #1														
UNDISTURBED BUFFER AT TIDE OF DISTURBED AREAS (ALTERNATE TO #2) (SITE SLOPES <2%)														
SEDIMENT FENCE OR BARRIER INSTALLED ON CONTOURS (SPACING) AROUND ACTIVE WORK AREAS														
TEMP. INTERCEPTOR DITCHES/SWALES AROUND ACTIVE WORK AREAS														
CHECK DAMS														
STORM DRAIN INLET PROTECTION BARRIER														
6-MIL PLASTIC SHEET COVER														
2'- MIN. STRAW MULCH COVER														
ESTABLISH GRASS														
EROSION BLANKETS WITH ANCHORS														
SEDIMENT TRAP OR POND														
RE-ESTABLISH VEGETATION OR LANDSCAPE PRIOR TO REMOVAL OF EROSION CONTROL MEASURES														
SINGLE FAMILY/ DUPLEX RESIDENTIAL														
SLOPE <2%	X	X												
SLOPE >2%		X												
STOCK PILES														
COMMERCIAL, SUBDIVISION														
LARGE SITE CONSTRUCTION														
SITE SLOPE <2%	X	X												
SITE SLOPE <10%	X	X												
SITE SLOPE <15%	X	X												
SITE SLOPE <20%	X	X												
SITE SLOPE <30%	X	X												
SITE SLOPE <50%	X	X												
STOCK PILE SLOPE >50%	X	X												
UTILITIES CONSTRUCTION														
CATCH BASIN DRAINAGE														
DITCH DRAINAGE														
STOCK PILES														
DITCHES/SWALES (CONSTRUCTION/PROTECTION)														
KEY: X = BASE MEASURE														
A = ALTERNATE TO BASE MEASURE INDICATED IN PARENTHESIS														
# = OPTIONAL BASE MEASURE CAN USE AS APPLICABLE														
* = SUPPLEMENTAL WET WEATHER MEASURE (NOVEMBER 1-APRIL 30) (SEEDING PRIOR TO SEPTEMBER 1)														
□ = ALTERNATE WET WEATHER MEASURE TO *														

08/21/2001

Date


AAH/BLW/JAH

Designed

AAH/BLW/JAH

Drawn

Checked By Date

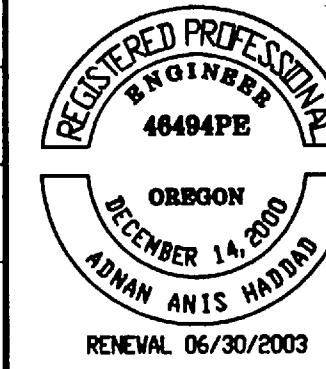

NORWAY DEVELOPMENT

P.O. Box 387
Oregon City, Oregon 97045
PHONE: (503) 656-7000
FAX: (503) 656-0686

Tanner's Stonegate

CITY OF WEST LINN, OREGON

EROSION CONTROL NOTES AND DETAILS



17355 SW Boones Ferry Road
Lake Oswego, OR 97035-5217
Phone: (503) 636-5816
FAX: (503) 636-5395

10579

Project No.

D579C2-1


File No.

C2.1

Sheet No.

Copyright 2001

XREF LIST
Ltscale: 1
Resolved
D579X001
D579X190
D579X230
D579X400
D579X430
D579X600

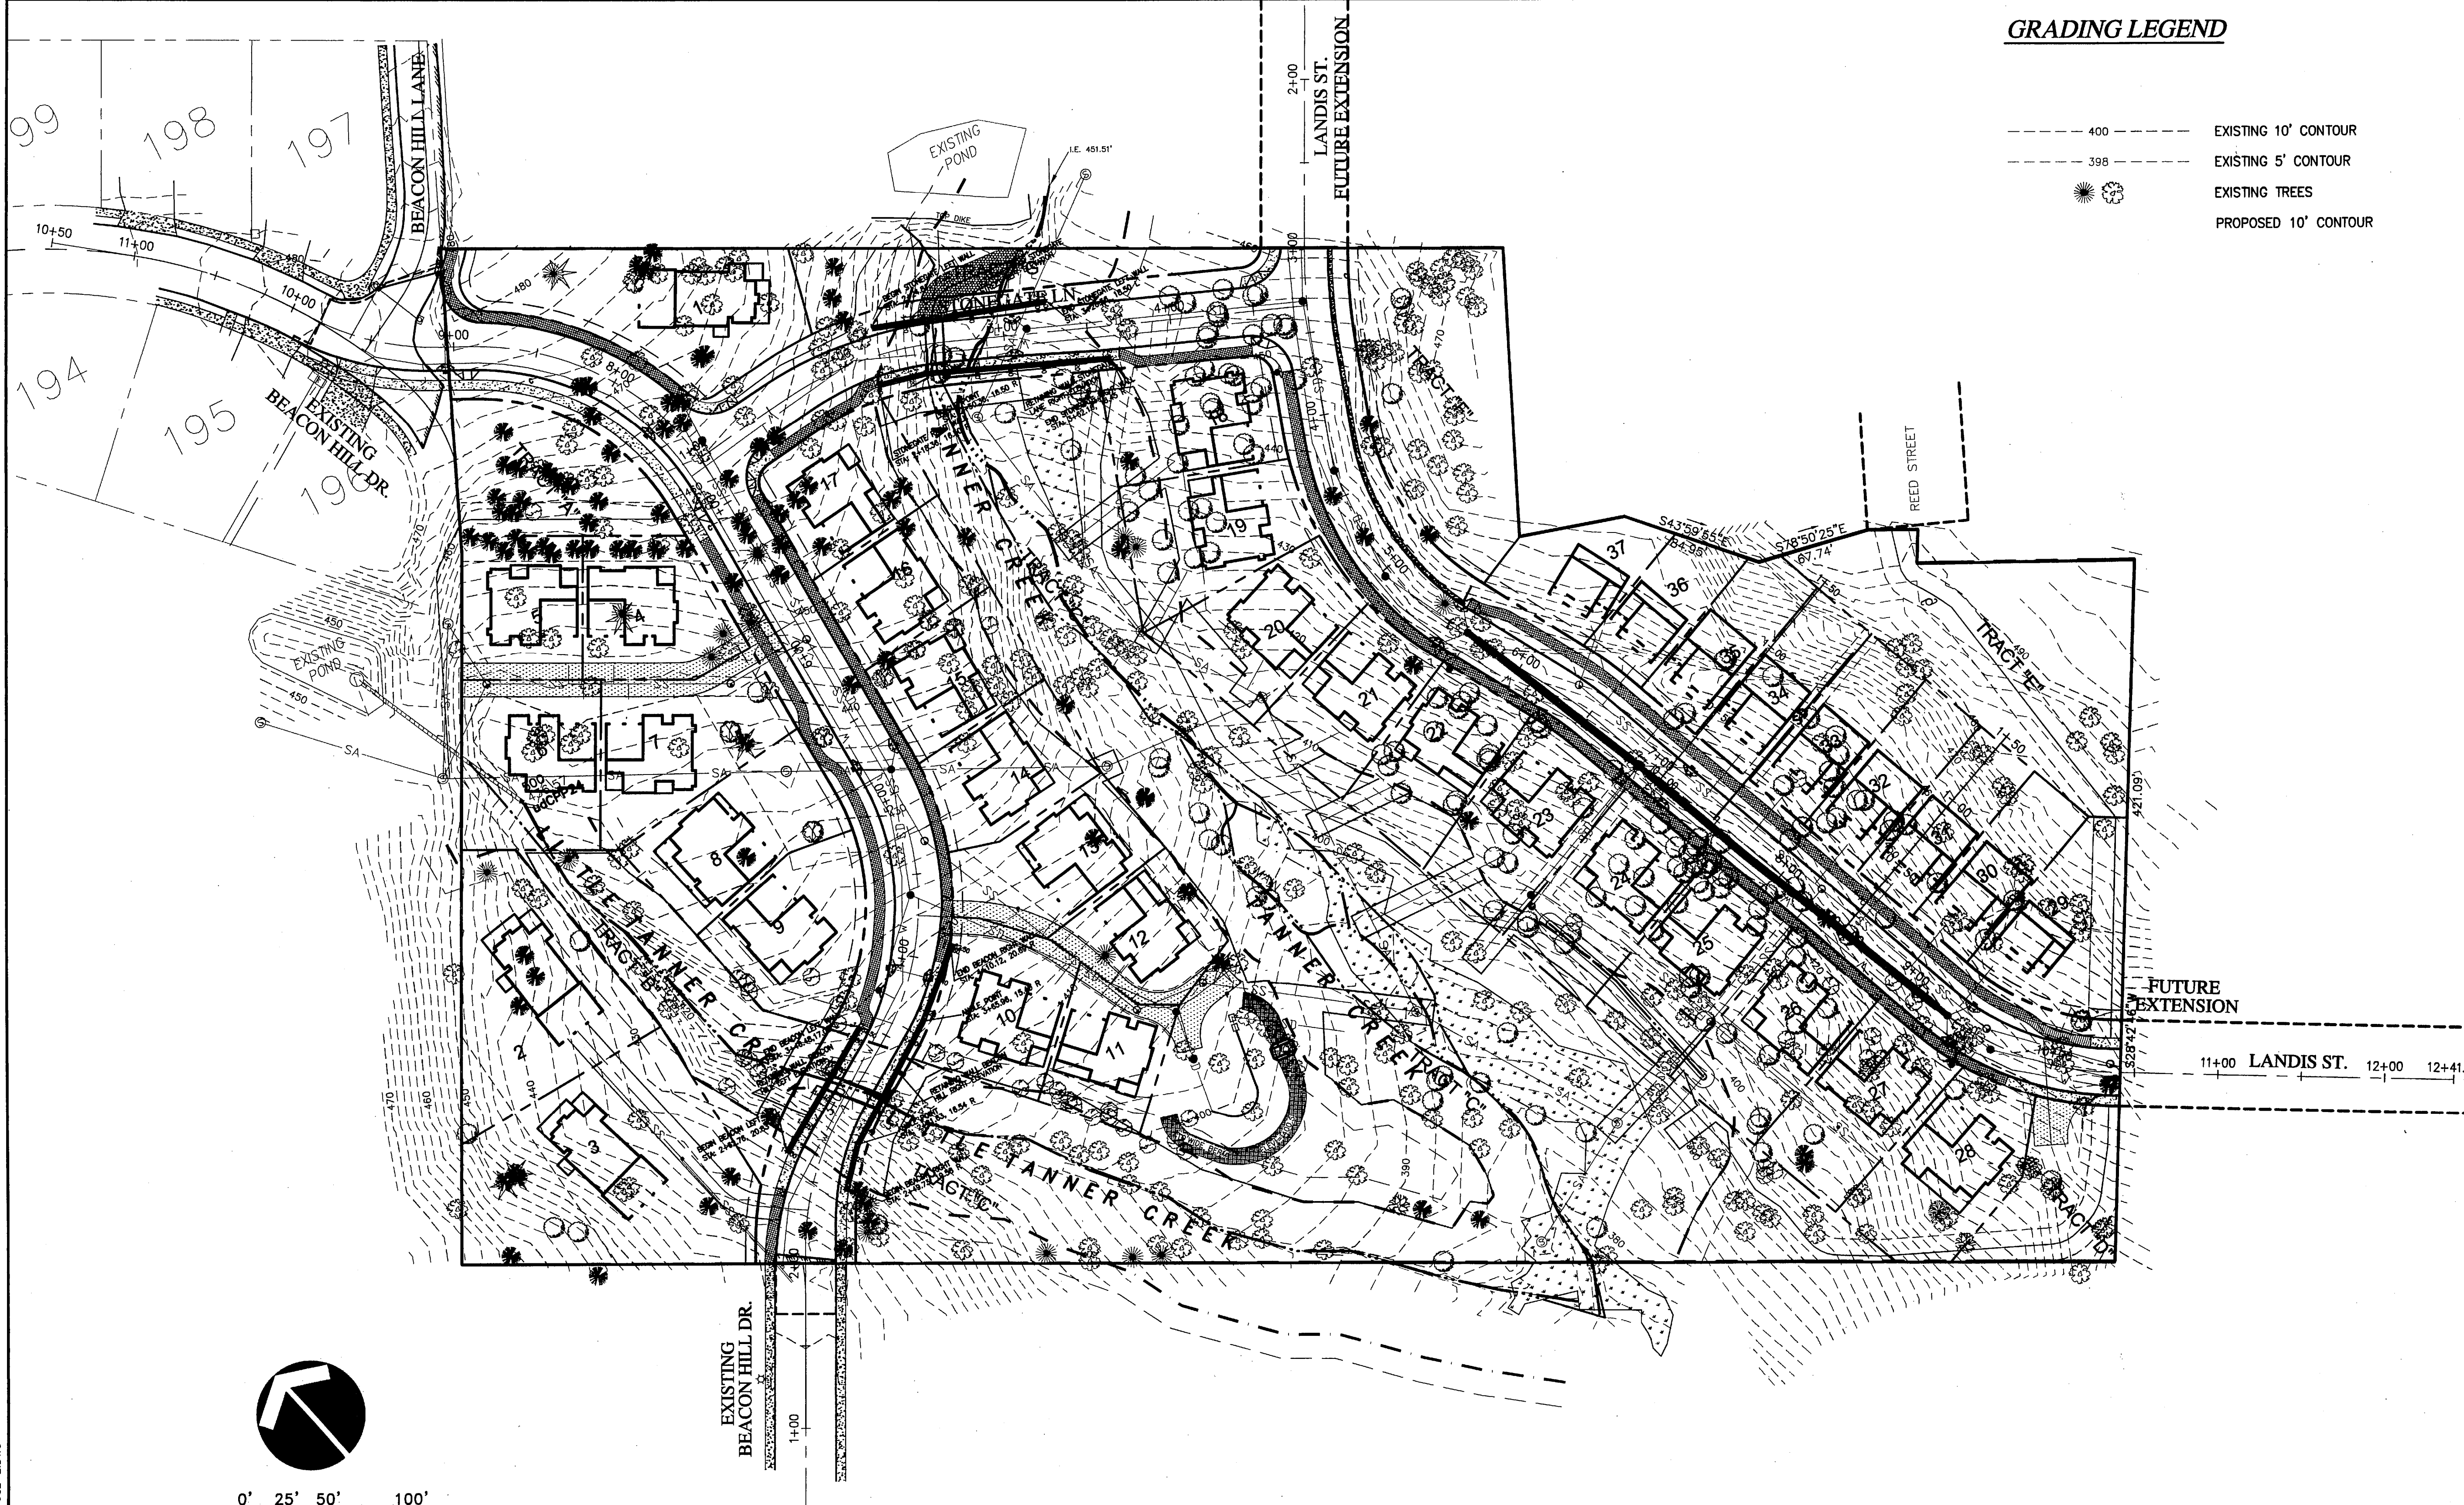

GRADING LEGEND

---	400	---	EXISTING 10' CONTOUR
---	398	---	EXISTING 5' CONTOUR
★		○	EXISTING TREES
○			PROPOSED 10' CONTOUR

NOTE:

1- THE CITY ARBORIST MUST APPROVE THE TREE PRESERVATION MEASURES PRIOR TO ANY GRADING.

2- A PLAN FOR REMOVAL OF INVASIVE AND NON-INDIGINOUS PLANTS IN THE DRAINAGE WAY AND TRANSITION ZONE AND A PLANTINGS PLAN IN THE SAME AREA MUST BE SUBMITTED AND COMPLETED PRIOR TO OCCUPANCY OF ANY RESIDENCES.

08/21/2001
Date
AAH/BLW/JAH
Designed
AAH/BLW/JAH
Drawn
Checked By Date

REGISTERED PROFESSIONAL
ENGINEER
48404PE
OREGON
JANUARY 14, 2000
ADAM ANIS HAYDON
RENEWAL 06/30/2003

NORWAY DEVELOPMENT
P.O. Box 387
Oregon City, Oregon 97045
PHONE: (503) 656-7000
FAX: (503) 656-0686


Tanner's Stonegate
CITY OF WEST LINN, OREGON
TREE PRESERVATION PLAN

otak
Incorporated
17355 SW Boones Ferry Road
Lake Oswego, OR 97035-5217
Phone: (503) 635-3818
FAX: (503) 635-5395

AS BUILTS

10579
Project No.
D579C2-2
File No.
C2.2
Sheet No.
Copyright 2001 ©

XREF LIST
Ltscale: 1
Resolved
D579X001
D579X190
D579X230
D579X400
D579X430
D579X600

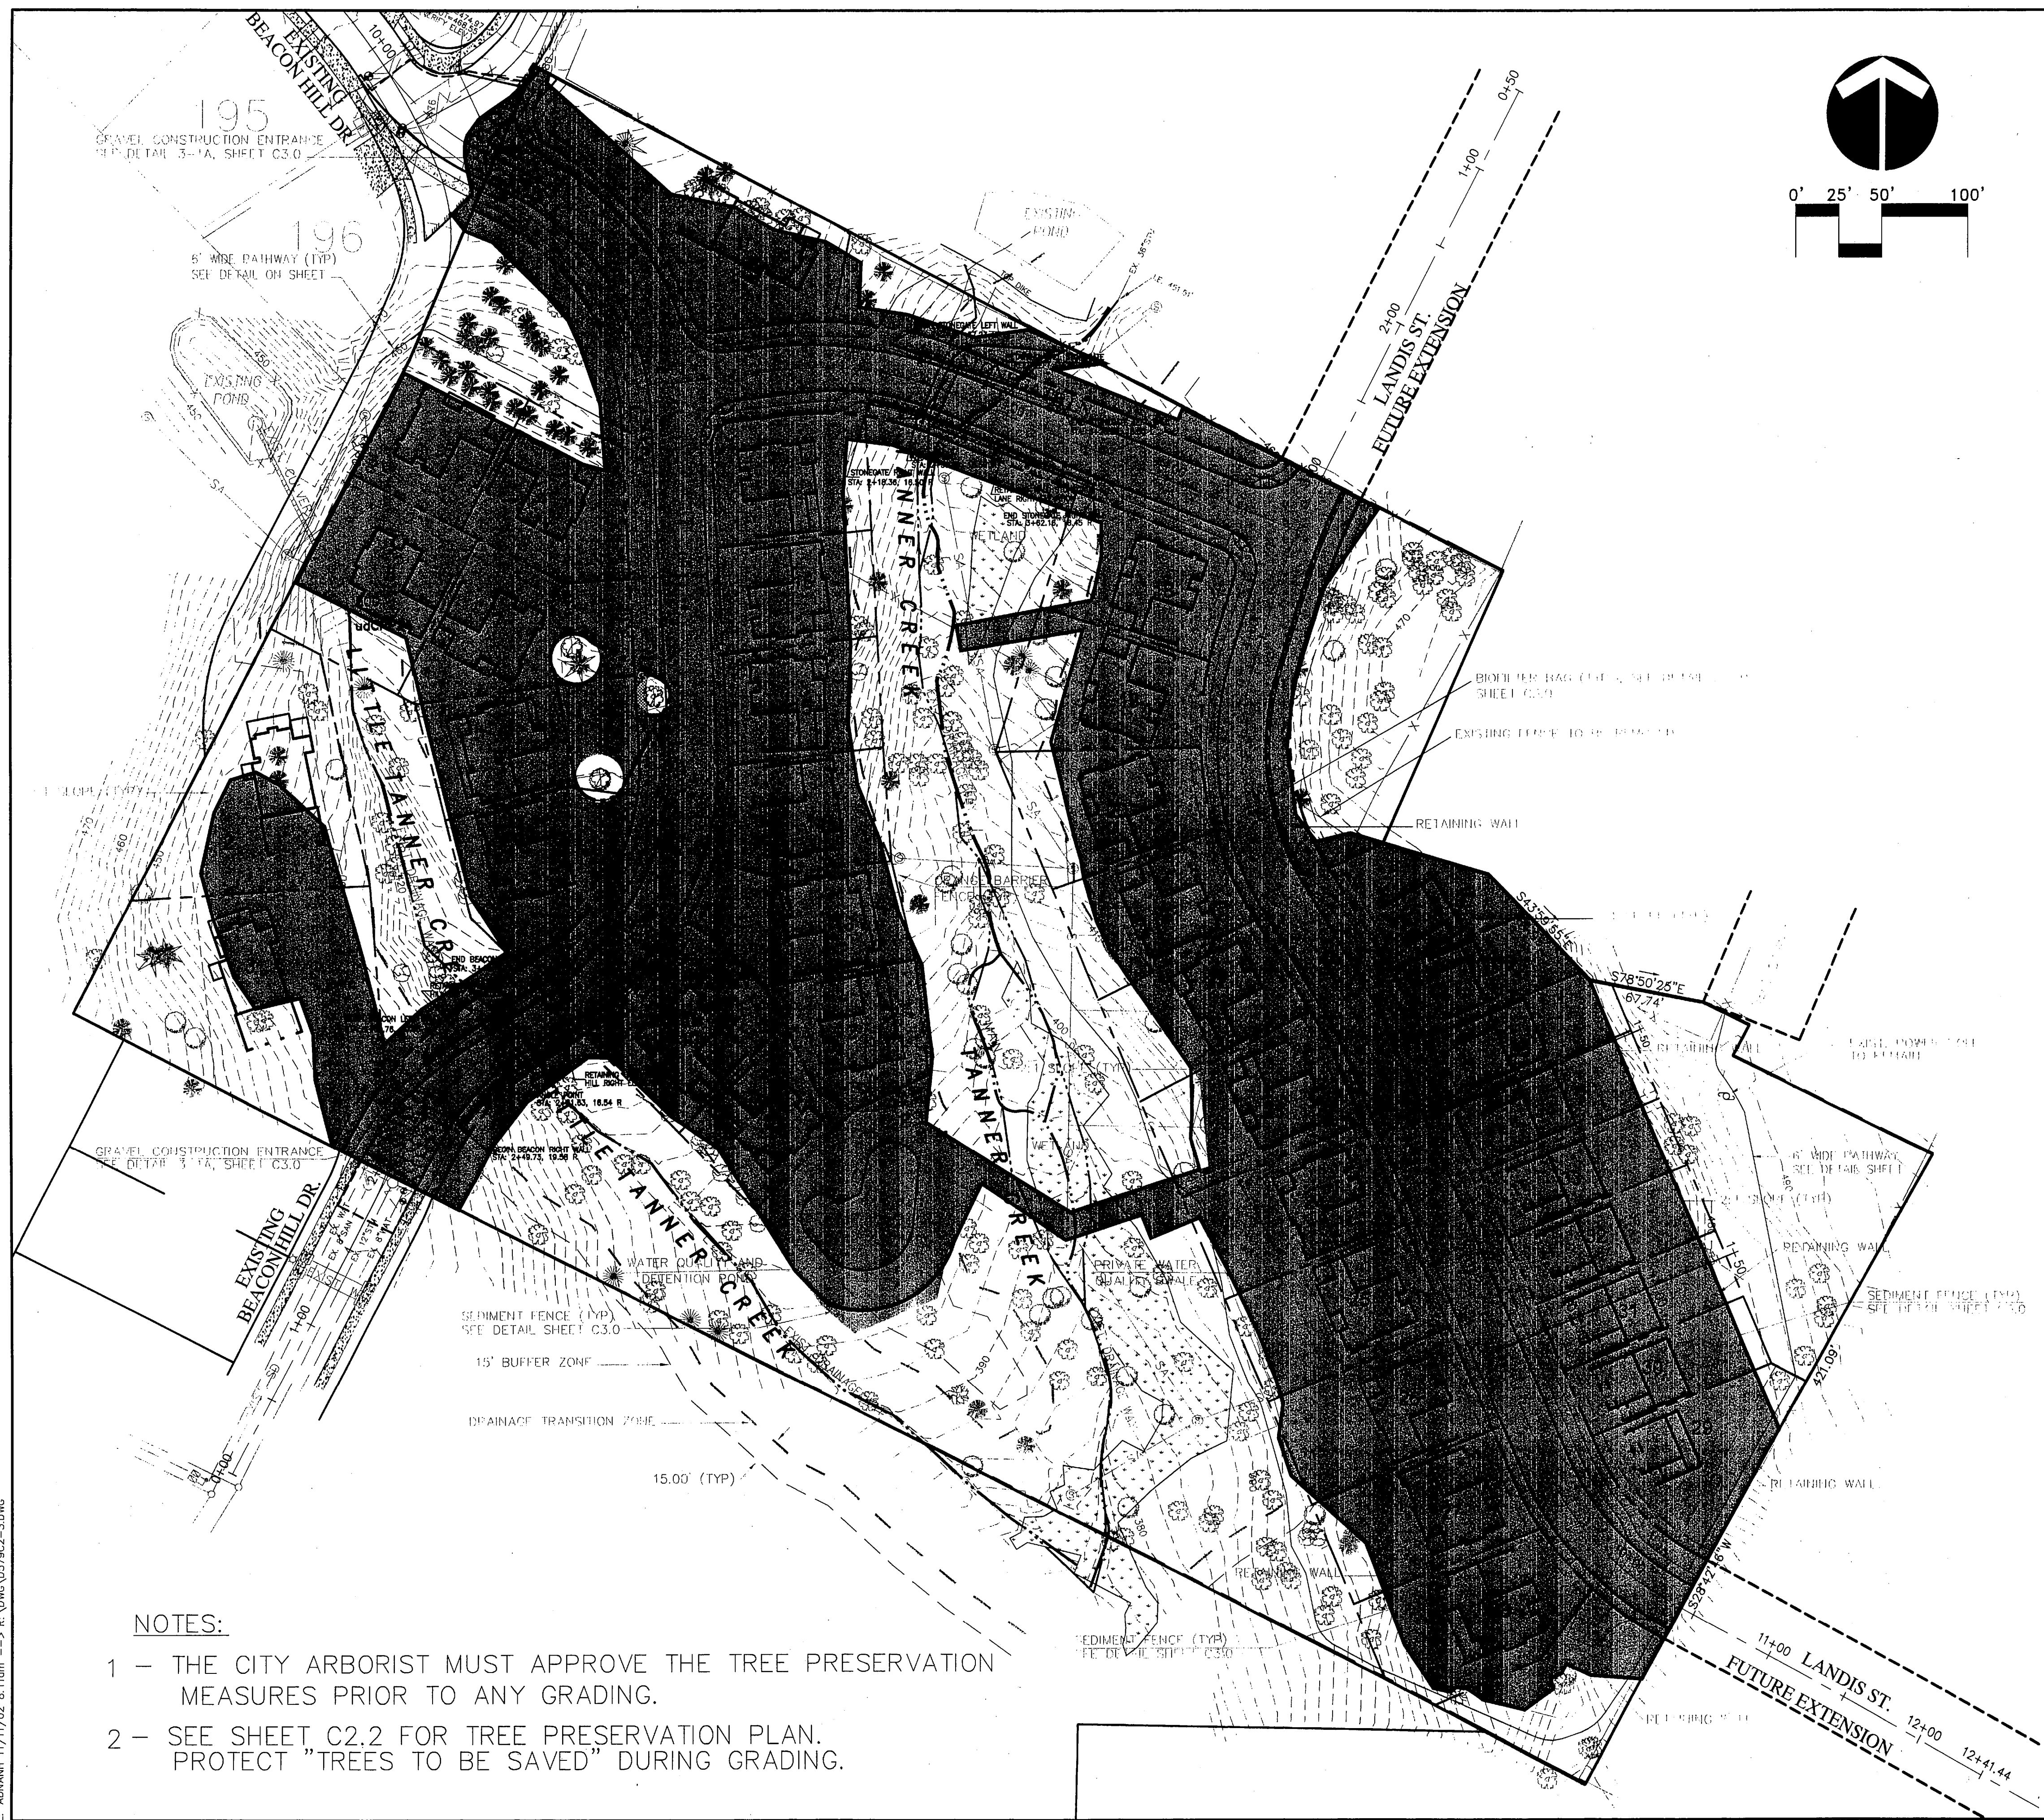

GRADING LEGEND			
---	400	---	EXISTING 10' CONTOUR
---	398	---	EXISTING 5' CONTOUR
---	398	---	EXISTING TREES
---	400	---	PROPOSED 10' CONTOUR
---	398	---	PROPOSED 2' CONTOUR
---	X	---	PROPOSED CLEARING LIMITS
---	X	---	PROPOSED SEDIMENT FENCE
---	X	---	ORANGE FENCE (ALONG TRANSITION ZONE)
---	X	---	PROPOSED CONSTRUCTION FENCE
---	X	---	PROPOSED CONSTRUCTION ENTRANCE
---	X	---	CHAINLINK FENCE

08/21/2001
Date
AAH/BLW/JAH
Designed
AAH/BLW/JAH
Drawn
Checked By Date

REVISIONS

BY

DATE

NO.

APPROVED

REGISTERED PROFESSIONAL ENGINEER
46494PE
OREGON
JANUARY 14, 2000
RENEWAL 06/30/2003
JIMMY ANTS HAYWARD

NORWAY DEVELOPMENT

P.O. Box 387
Oregon City, Oregon 97045
PHONE: (503) 656-7000
FAX: (503) 656-0666

AS BUILT

Tanner's Stonegate
CITY OF WEST LINN, OREGON
CLEARING LIMIT PLAN

otak
Incorporated

17355 SW Boones Ferry Road
Lake Oswego, OR 97035-5217
Phone: (503) 635-3618
FAX: (503) 635-5395


10579
Project No.
D579C2-3
File No.
C2.3
Sheet No.

Copyright 2001 ©

- NOTES:
- 1 - THE CITY ARBORIST MUST APPROVE THE TREE PRESERVATION MEASURES PRIOR TO ANY GRADING.
 - 2 - SEE SHEET C2.2 FOR TREE PRESERVATION PLAN. PROTECT "TREES TO BE SAVED" DURING GRADING.

L: ADNAH 11/11/02 8:11am --> R: \DWG\0579C2-3.DWG

XREF LIST
Ltscale: 1
Resolved
D579X001
D579X190
D579X230
D579X600
TRAILS

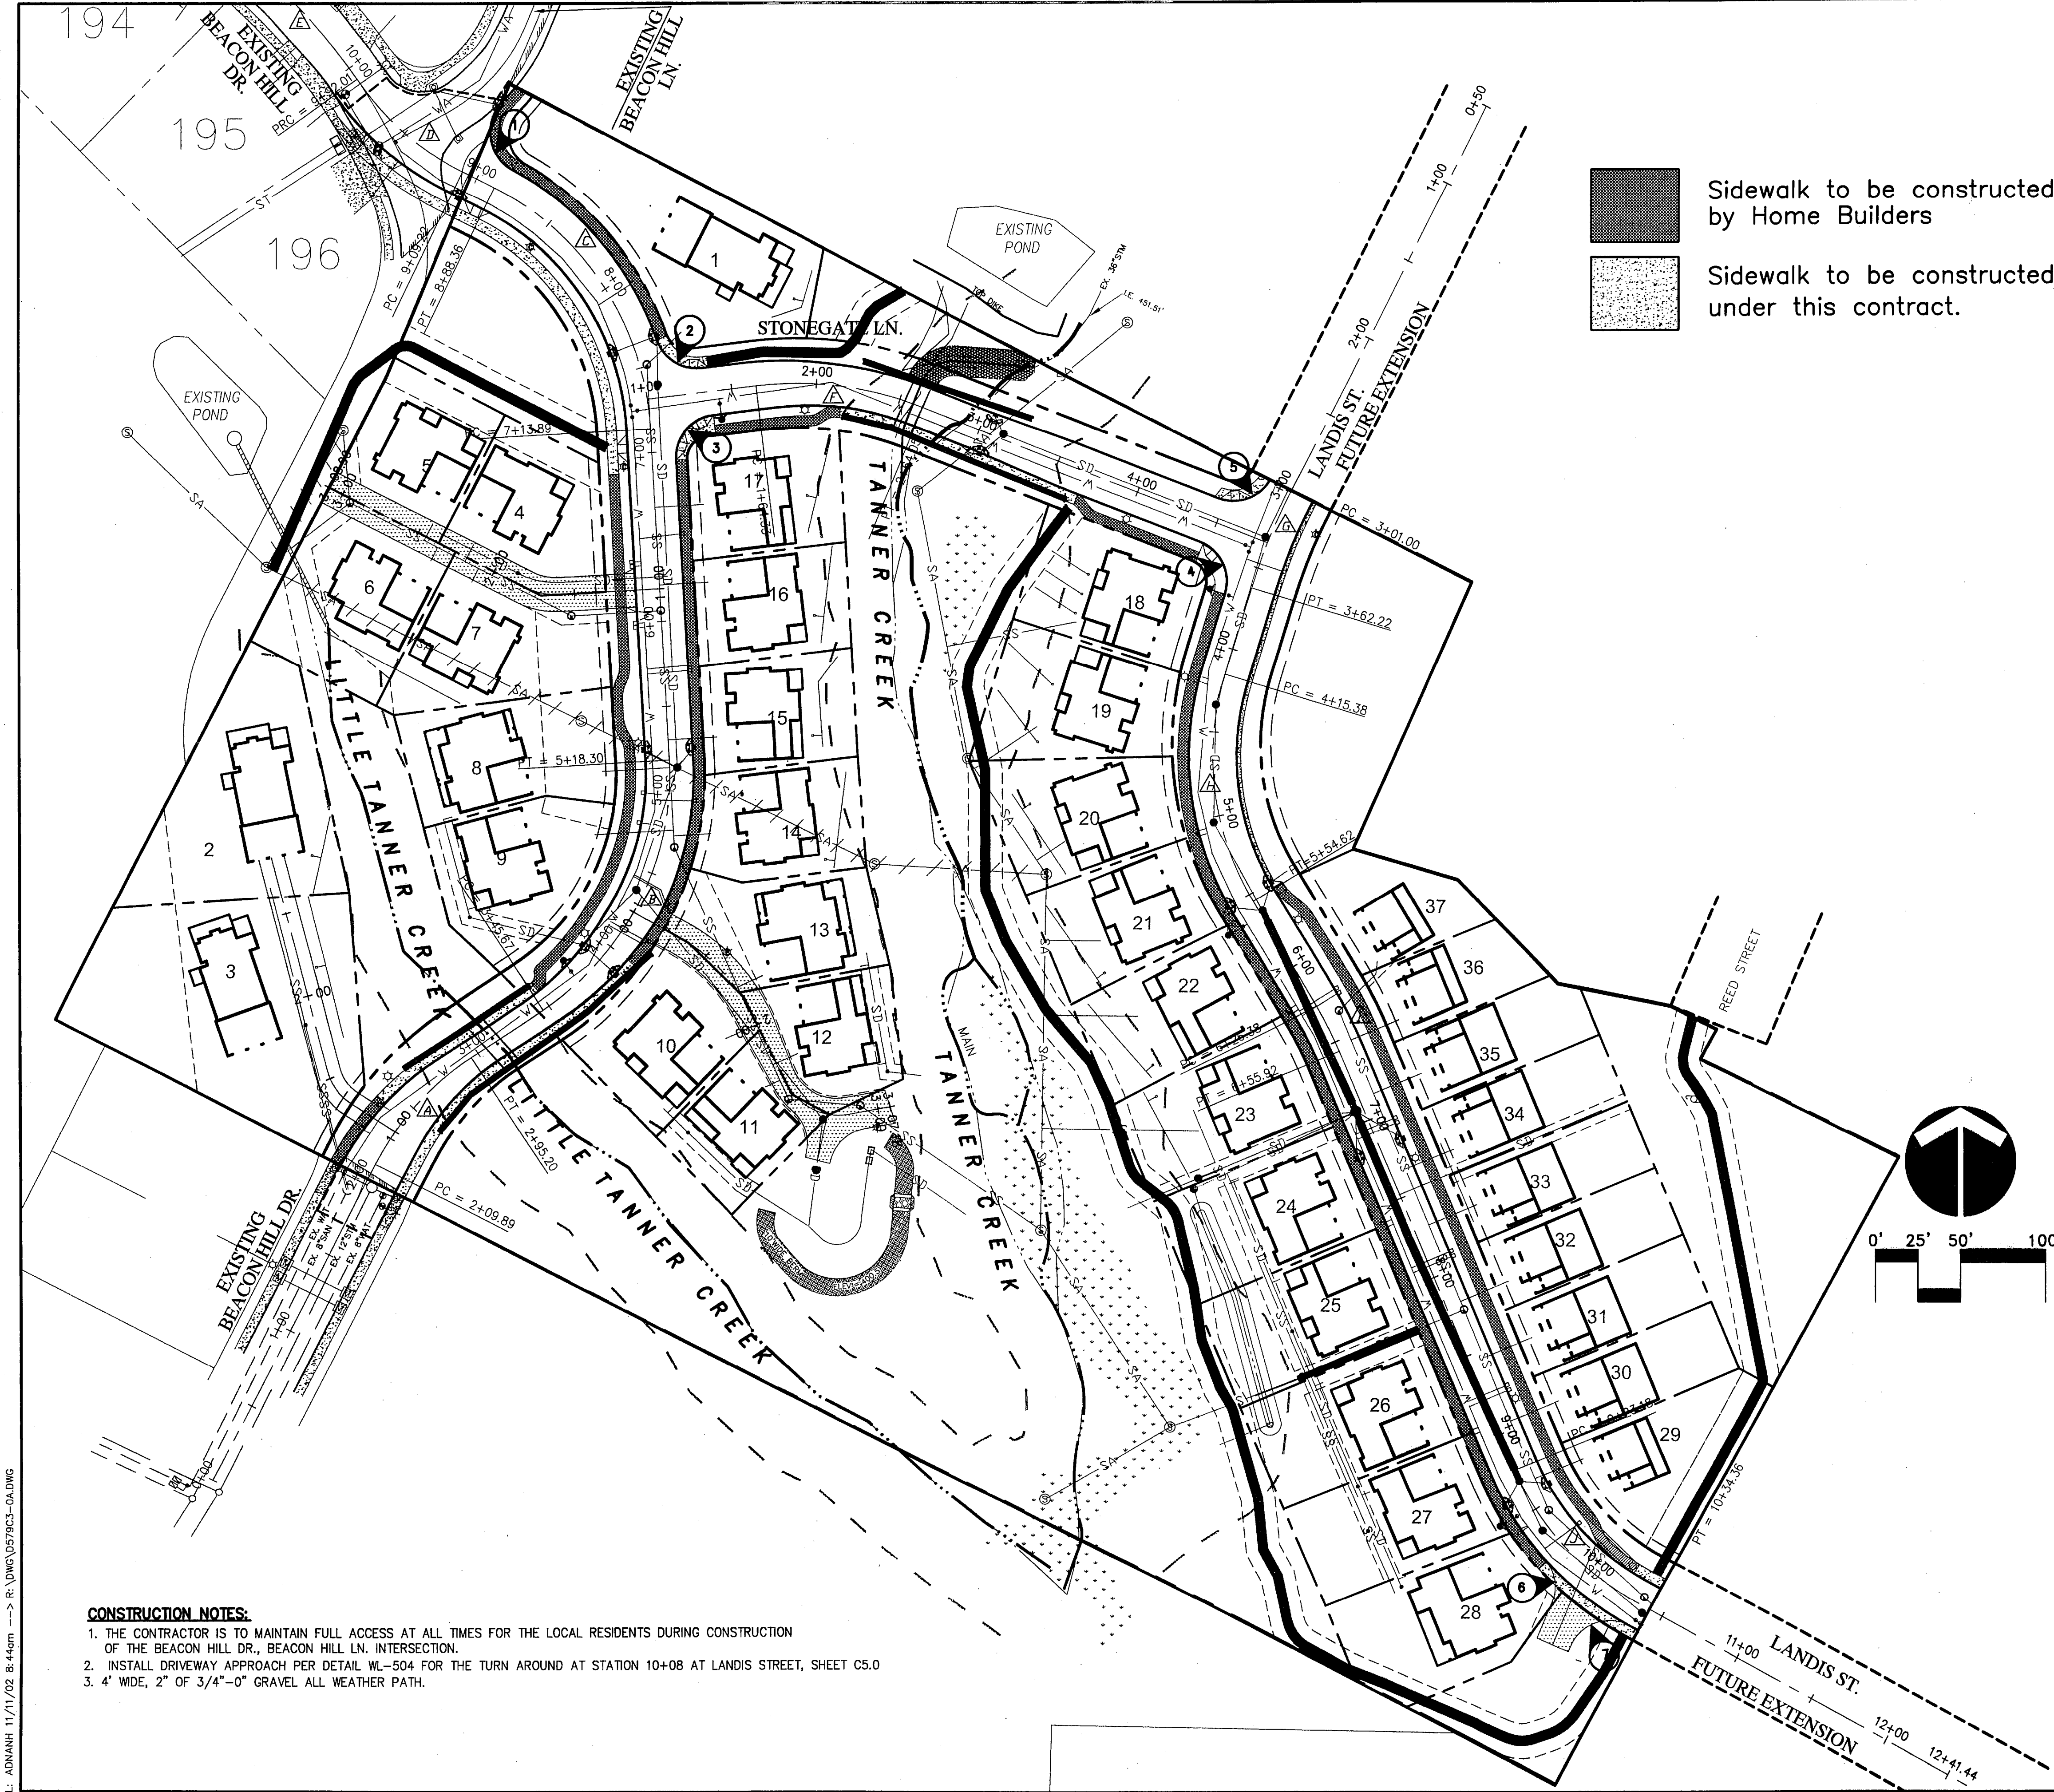

LEGEND

---	RIGHT-OF-WAY LINE
---	FUTURE RIGHT-OF-WAY LINE
---	PROPERTY LINE
---	LOT LINE
---	EASEMENT LINE
---	TRANSITION ZONE LINE
---	BUILDING SETBACK LINE
---	STREET CENTERLINE
---	TRAIL

---	STORM LINE
---	WATER LINE
---	SANITARY LINE
---	SAN LINE TO BE ABANDONED IN PLACE
---	SANITARY MANHOLE
---	STORM MANHOLE
---	STORM INLET
---	WATER METER
---	FIRE HYDRANT
---	WATER VALVE
---	STREET LIGHT
---	EXISTING FENCE

---	SANITARY LINE
---	SANITARY MANHOLE
---	STORM LINE
---	STORM DETENTION PIPE
---	STORM MANHOLE
---	STORM INLET
---	WATER LINE
---	FIRE HYDRANT ASSEMBLY
---	WATER METER WITH CORP. STOP AT WATER MAIN
---	WATER VALVE
---	WATER BLOW-OFF ASSEMBLY

CURB RETURN DATA

BCR STA: 8+83.59, 14.00' RT BEACON HILL	T.D.C.	472.82
$\Delta = 107^{\circ}48'07''$	1/4 Δ	473.64
R = 25.00'	1/2 Δ	474.48
L = 47.04'	3/4 Δ	475.42
ECR STA: 9+06.04, 47.24' RT BEACON HILL		476.50

BCR STA: 1+33.89, 14.00' L STONEGATE	T.D.C.	457.16
$\Delta = 76^{\circ}57'49''$	1/4 Δ	457.94
R = 25.00'	1/2 Δ	459.28
L = 33.58'	3/4 Δ	460.77
ECR STA: 7+61.97, 14.00' RT BEACON HILL		462.02

BCR STA: 6+94.89, 14.00' RT BEACON HILL	T.D.C.	453.97
$\Delta = 86^{\circ}20'30''$	1/4 Δ	453.16
R = 25.00'	1/2 Δ	456.26
L = 37.67'	3/4 Δ	456.98
HIGH POINT 76'12'12"		457.09
ECR STA: 1+37.52, 14.00' RT STONEGATE		456.99

BCR STA: 4+45.08, 14.00' RT STONEGATE	T.D.C.	453.76
$\Delta = 85^{\circ}25'30''$	1/4 Δ	453.21
R = 25.00'	1/2 Δ	452.30
L = 37.27'	3/4 Δ	451.16
ECR STA: 3+70.22, 14.00' RT LANDIS		449.96

BCR STA: 3+00.01, 14.00' RT LANDIS	T.D.C.	460.14
$\Delta = 82^{\circ}03'26''$	1/4 Δ	458.45
R = 25.00'	1/2 Δ	456.43
L = 35.80'	3/4 Δ	454.68
ECR STA: 4+45.16, 14.00' LT STONEGATE		453.77

BCR STA: 9+76.50, 14.00' RT LANDIS	T.D.C.	443.99
$\Delta = 64^{\circ}15'36''$	1/4 Δ	444.53
R = 25.00'	1/2 Δ	444.91
HIGH POINT 48'00'50"		445.05
L = 28.04'	3/4 Δ	445.05
ECR STA: 9+95.65, 29.45' RT LANDIS		444.88

BCR STA: 10+15.75, 42.78' RT LANDIS	T.D.C.	446.32
$\Delta = 95^{\circ}38'45''$	1/4 Δ	446.90
R = 25.00'	1/2 Δ	447.60
L = 41.73'	3/4 Δ	448.40
ECR STA: 10+35.85, 14.00' RT LANDIS		449.30

CL CURVE DATA

CURVE	LENGTH	RADIUS	DELTA
1	85.32	165.00	29°37'32"
2	172.63	165.00	59°56'43"
3	174.47	165.00	60°35'04"
4	82.79	165.00	28°44'57"
5	107.99	330.00	18°45'00"
6	99.72	200.00	28°34'05"
7	61.22	350.00	10°01'19"
8	139.23	165.00	48°20'54"
9	29.54	200.00	08°27'41"
10	111.19	165.00	38°36'32"

08/21/2001
Date
AAH/BLW/JAH
Designed
AAH/BLW/JAH
Drawn
Checked By Date

REVISIONS
BY
DATE
NO.

REGISTERED PROFESSIONAL ENGINEER
44494PE
JANUARY 14, 2000
ADAM ANIS HADWIN
RENEWAL 06/30/2003

NORWAY DEVELOPMENT
P.O. Box 387
Oregon City, Oregon 97045
PHONE: (503) 656-7000
FAX: (503) 656-0686

Tanner's Stonegate
CITY OF WEST LINN, OREGON
STREET PLAN

otak
Incorporated
17355 SW Boones Ferry Road
Lake Oswego, OR 97035-5217
Phone: (503) 635-3616
FAX: (503) 635-5385

10579
Project No.
D579C3-0A
File No.
C3.0A
Sheet No.
Copyright 2001

AS BUILTS

XREF LIST
Ltscale: 1
Resolved
D579X001
D579X190
D579X230
D579X400
D579X600

REVISED NOV 20,01

LEGEND

RIGHT-OF-WAY LINE
FUTURE RIGHT-OF-WAY LINE
PROPERTY LINE
LOT LINE
EASEMENT LINE
TRANSITION ZONE LINE
BUILDING SETBACK LINE
STREET CENTERLINE
TRAIL

EXISTING UTILITIES

ST STORM LINE
WA WATER LINE
SA SANITARY LINE
SA SAN LINE TO BE ABANDONED IN PLACE
SM SANITARY MANHOLE
SM STORM MANHOLE
SI STORM INLET
WM WATER METER
FH FIRE HYDRANT
WV WATER VALVE
SL STREET LIGHT
EF EXISTING FENCE

PROPOSED UTILITIES

SS SANITARY LINE
SM SANITARY MANHOLE
SD STORM LINE
SD STORM DETENTION PIPE
SM STORM MANHOLE
SI STORM INLET
WL WATER LINE
FHA FIRE HYDRANT ASSEMBLY
WMA WATER METER WITH CORP. STOP AT WATER MAIN
WV WATER VALVE
WBO WATER BLOW-OFF ASSEMBLY

CURB INLET DATA

A3A STA: 3+89.90 12.72' LT
TO FACE OF CURB (BEACON)
TOC: 426.00
IE IN: 420.00
IE OUT: 419.30
45.48 LF 12" PVC
S= 0.0336
USE DETAIL WL-601

A3B STA: 3+89.90 12.13' LT
TO FACE OF CURB (BEACON)
TOC: 425.95
IE OUT: 421.40
26.86 LF 10" PVC
S= 0.0521
USE DETAIL WL-601

A4A STA: 5+25.00 14.00' LT
TO FACE OF CURB (BEACON)
TOC: 433.56
IE OUT: 428.01
22.03 LF 10" STM
S= 0.1266
USE DETAIL WL-601

A4B STA: 5+25.00 14.00' RT
TO FACE OF CURB (BEACON)
TOC: 437.25
IE OUT: 433.20
19.16 LF 10" STM
S= 0.1597
USE DETAIL WL-601

A5A STA: 7+64.00 14.00' LT
TO FACE OF CURB (BEACON)
TOC: 462.50
IE OUT: 458.55
30.00 LF 10" STM
S= 0.000
USE DETAIL WL-601

A5B STA: 7+64.00 14.00' RT
TO FACE OF CURB (BEACON)
TOC: 462.34
IE IN: 458.61
IE OUT: 457.47
28.89 LF 12" STM
S= 0.1616
USE DETAIL WL-601

B3A STA: 7+18.00 14.00' RT
TO FACE OF CURB (LANDIS)
TOC: 432.84
IE OUT: 428.21
29.02 LF 10" STM
S= 0.0138
USE DETAIL WL-601

B3B STA: 7+18.00 14.00' LT
TO FACE OF CURB (LANDIS)
TOC: 432.84
IE OUT: 428.14
29.48 LF 10" STM
S= 0.0790
USE DETAIL WL-601

B4A STA: 9+40.02 14.00' RT
TO FACE OF CURB (LANDIS)
TOC: 440.97
IE OUT: 436.60
16.44 LF 10" STM
S= 0.1582
USE DETAIL WL-601

B4B STA: 9+39.99 14.00' LT
TO FACE OF CURB (LANDIS)
TOC: 441.10
IE OUT: 436.70
16.78 LF 10" STM
S= 0.1609
USE DETAIL WL-601

C1A STA: 5+49.99 14.00' RT
TO FACE OF CURB (LANDIS)
TOC: 437.30
IE OUT: 432.14
19.99 LF 10" STM
S= 0.0935
USE DETAIL WL-600

C1B STA: 5+49.98 14.00' LT
TO FACE OF CURB (LANDIS)
TOC: 437.25
IE OUT: 433.20
19.16 LF 10" STM
S= 0.1597
USE DETAIL WL-600

C5A STA: 3+05.35 12.19' RT
TO FACE OF CURB (STONEGATE)
TOC: 449.18
IE OUT: 444.60
17.48 LF 10" STM
S= 0.0423
USE DETAIL WL-601

C5B STA: 3+05.35 12.19' LT
TO FACE OF CURB (STONEGATE)
TOC: 448.73
IE OUT: 444.43
12.62 LF 10" STM
S= 0.0452
USE DETAIL WL-601

D3A STA: 9+05.79 44.35' RT
TO FACE OF CURB (ECR 1 BEACON HILL)
TOC: 476.30
IE IN: 469.51
IE OUT: 469.33
40.23 LF 10" STM
S= 0.0070
USE DETAIL WL-600

D3B STA: 9+05.10 14.00' LT
TO FACE OF CURB (BEACON)
TOC: 474.02
IE OUT: 471.00
58.19 LF 10" STM
S= 0.0255
USE DETAIL WL-601

CONSTRUCTION NOTES:

- LOT 4 AND LOTS 29 THRU 37 MUST DRAIN THROUGH CURB WEEP HOLES, SEE DETAIL WL-501, SHEET C5.0.
- THE REMAINING LOTS SHALL DRAIN THROUGH PRIVATE STORM LATERALS AND SOAKAGE TRENCHES AS SHOWN ON SHEET C3.8
- MANHOLE RIM ELEVATION ARE SHOWN FOR INFORMATIONAL PURPOSES ONLY, THE CONTRACTOR SHALL SET RIM ELEVATION TO MATCH TOP OF FINISH GRADE IN THE FIELD.
- ALL STORM DRAIN MANHOLE LOCATIONS ARE BASED ON BOTH STREET AND STORM DRAIN STATIONING, UNLESS OTHERWISE NOTED ON THE PLAN.
- SEE SHEET S-1B FOR WALL DRAIN SYSTEMS EXTENTIONS AND CONNECTIONS.

08/21/2001

Date

Designed

AAH/BLW/JAH

Drawn

AAH/BLW/JAH

Checked By Date

REVISIONS

BY APPD.

DATE

NO.

REVISIONS

BY APPD.

DATE

NO.





REVISIONS

BY APPD.

DATE

NO.

XREF LIST
Ltscale: 1
Resolved
D579MAP
D579X001
D579X630
D579X900

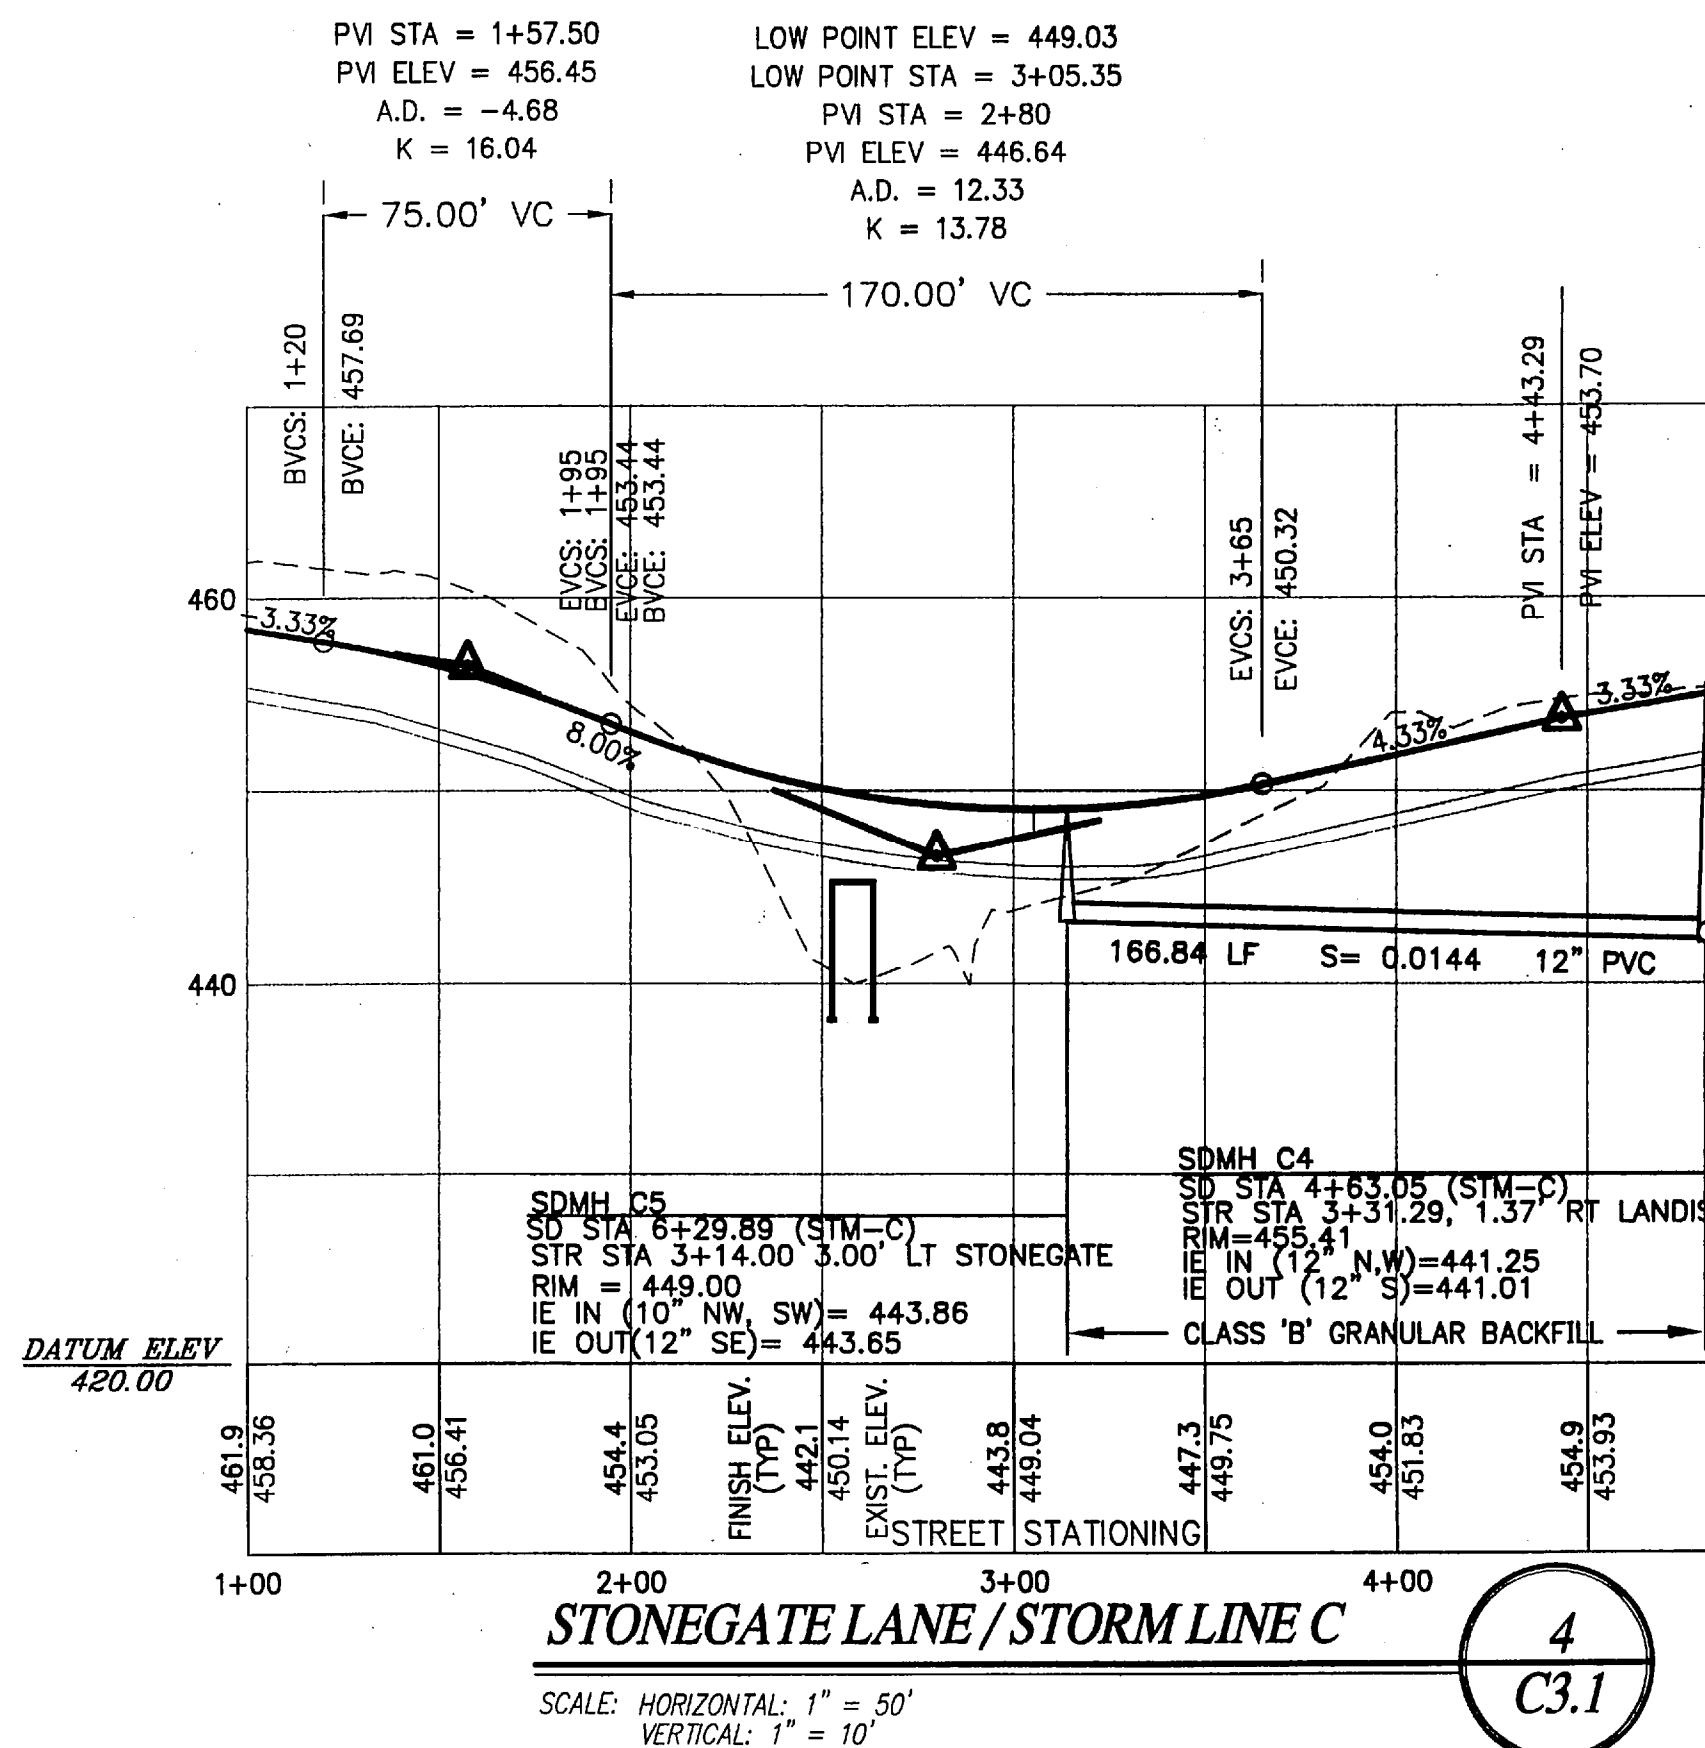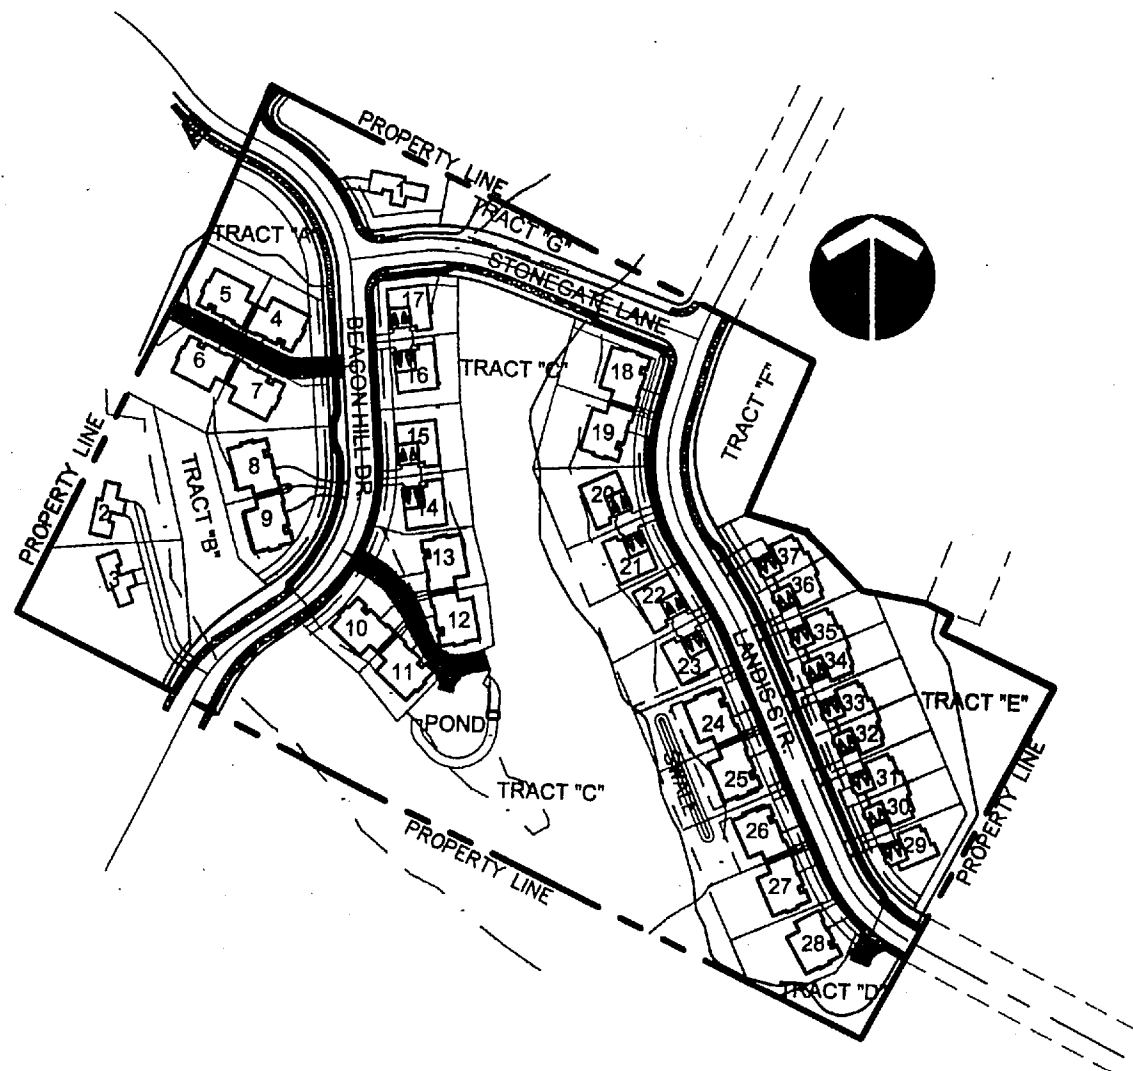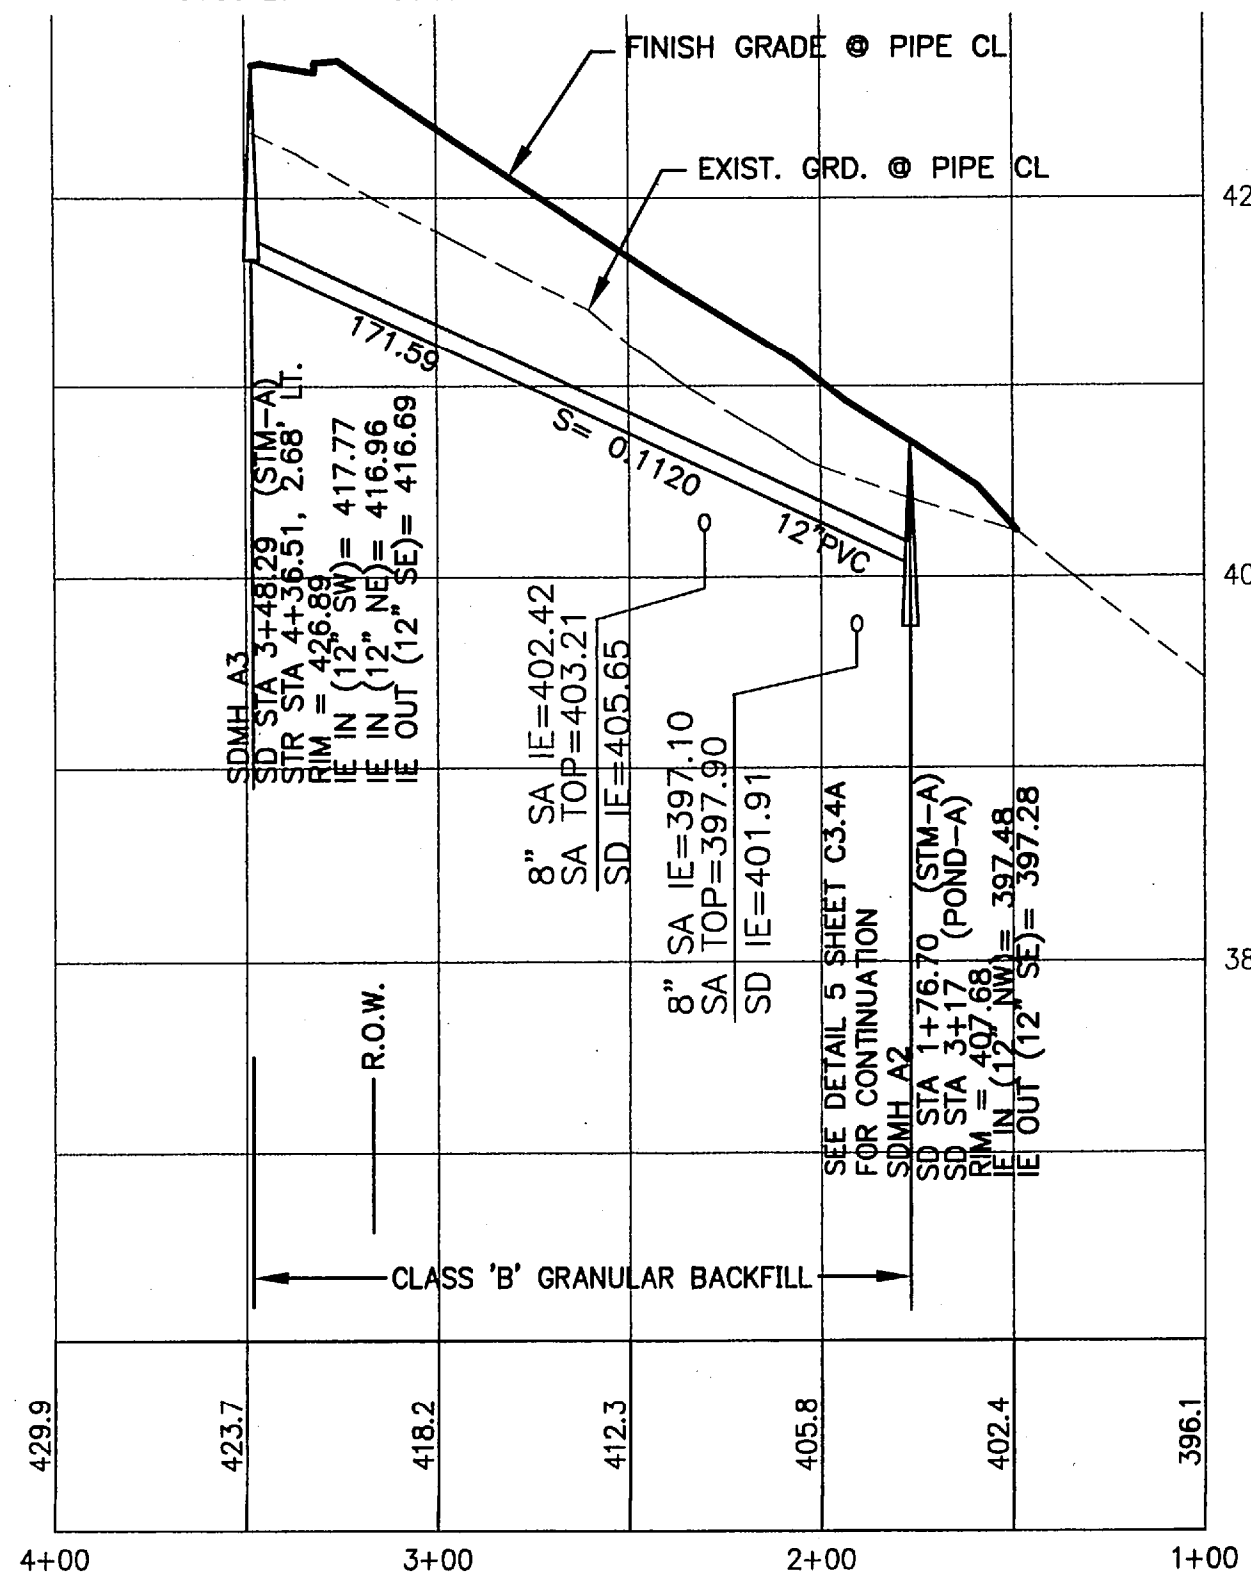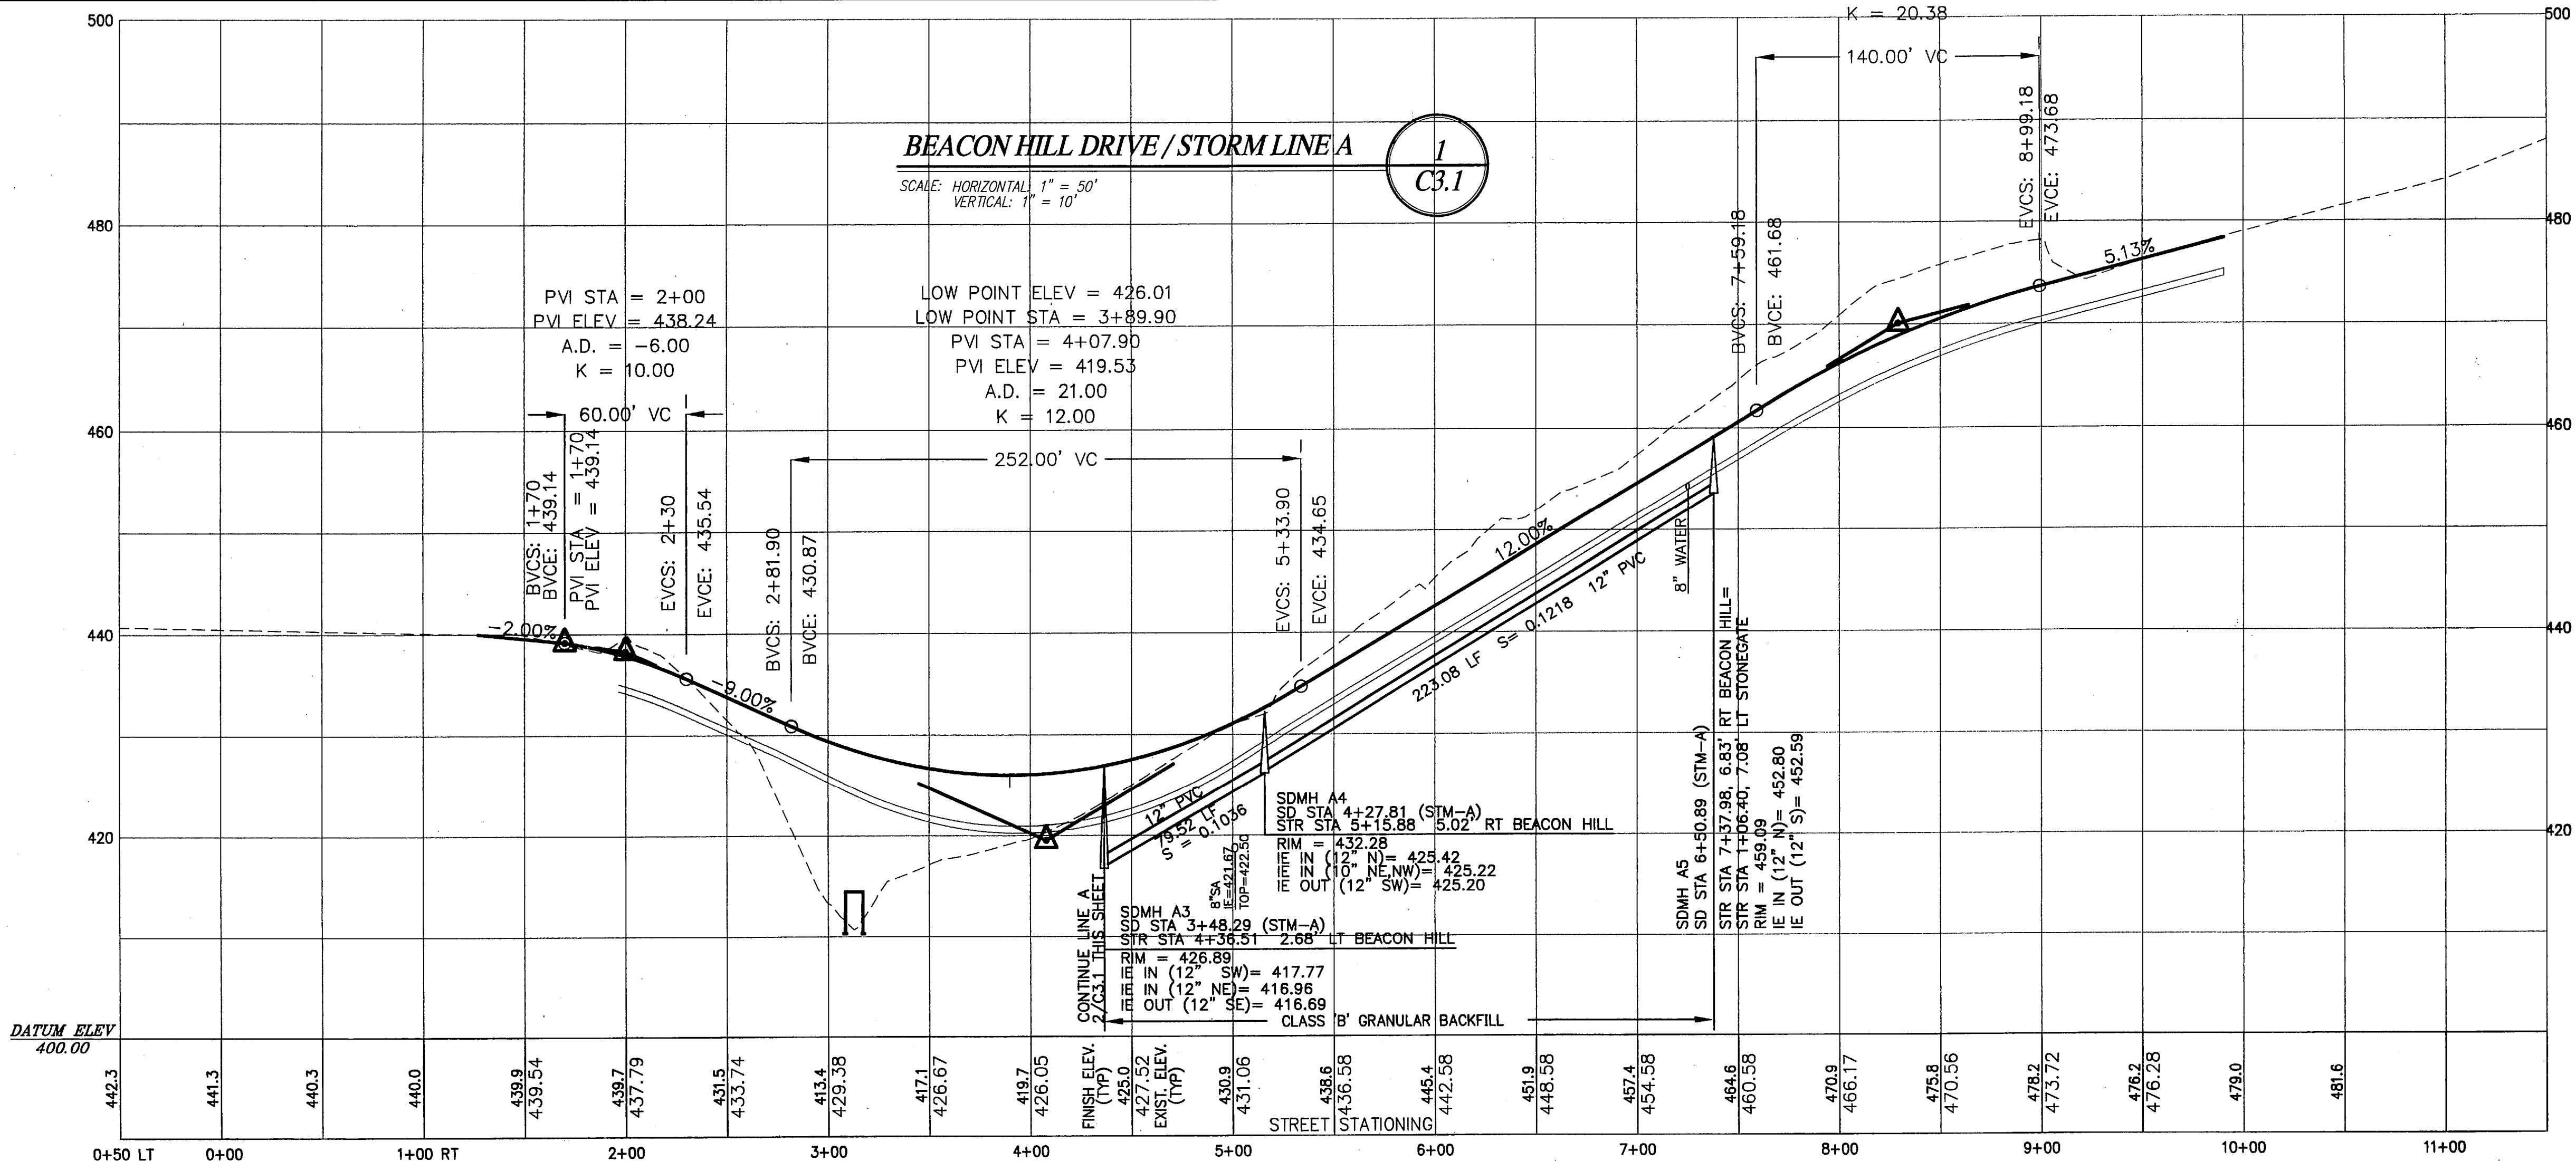

08/21/2001
Date
AAH/BLW/JAH
Designed
AAH/BLW/JAH
Drawn
Checked By Date

REVISIONS

BY APPD. DATE NO.

REGISTERED PROFESSIONAL ENGINEER
40404PE
JUDAN ANIS HADAD
RENEWAL 06/30/2003

NORWAY DEVELOPMENT
P.O. Box 387
Oregon City, Oregon 97045
PHONE: (503) 656-7000
FAX: (503) 656-0686

Tanner's Stonegate
CITY OF WEST LINN, OREGON
STREET AND STORM PROFILES

otak
Incorporated
17355 SW Boones Ferry Road
Lake Oswego, OR 97035-8217
Phone: (503) 635-3818
FAX: (503) 635-6396

AS BUILTS


10579
Project No.
D579C3-1
File No.
C3.1
Sheet No.
Copyright 2001

XREF LIST
Ltscale: 1
Resolved
D579MAP
D579X001
D579X400
D579X430
D579X610
D579X630
D579X900

LANDIS STREET PROFILE

SCALE: HORIZONTAL: 1" = 50'
VERTICAL: 1" = 10'


1
C3.2

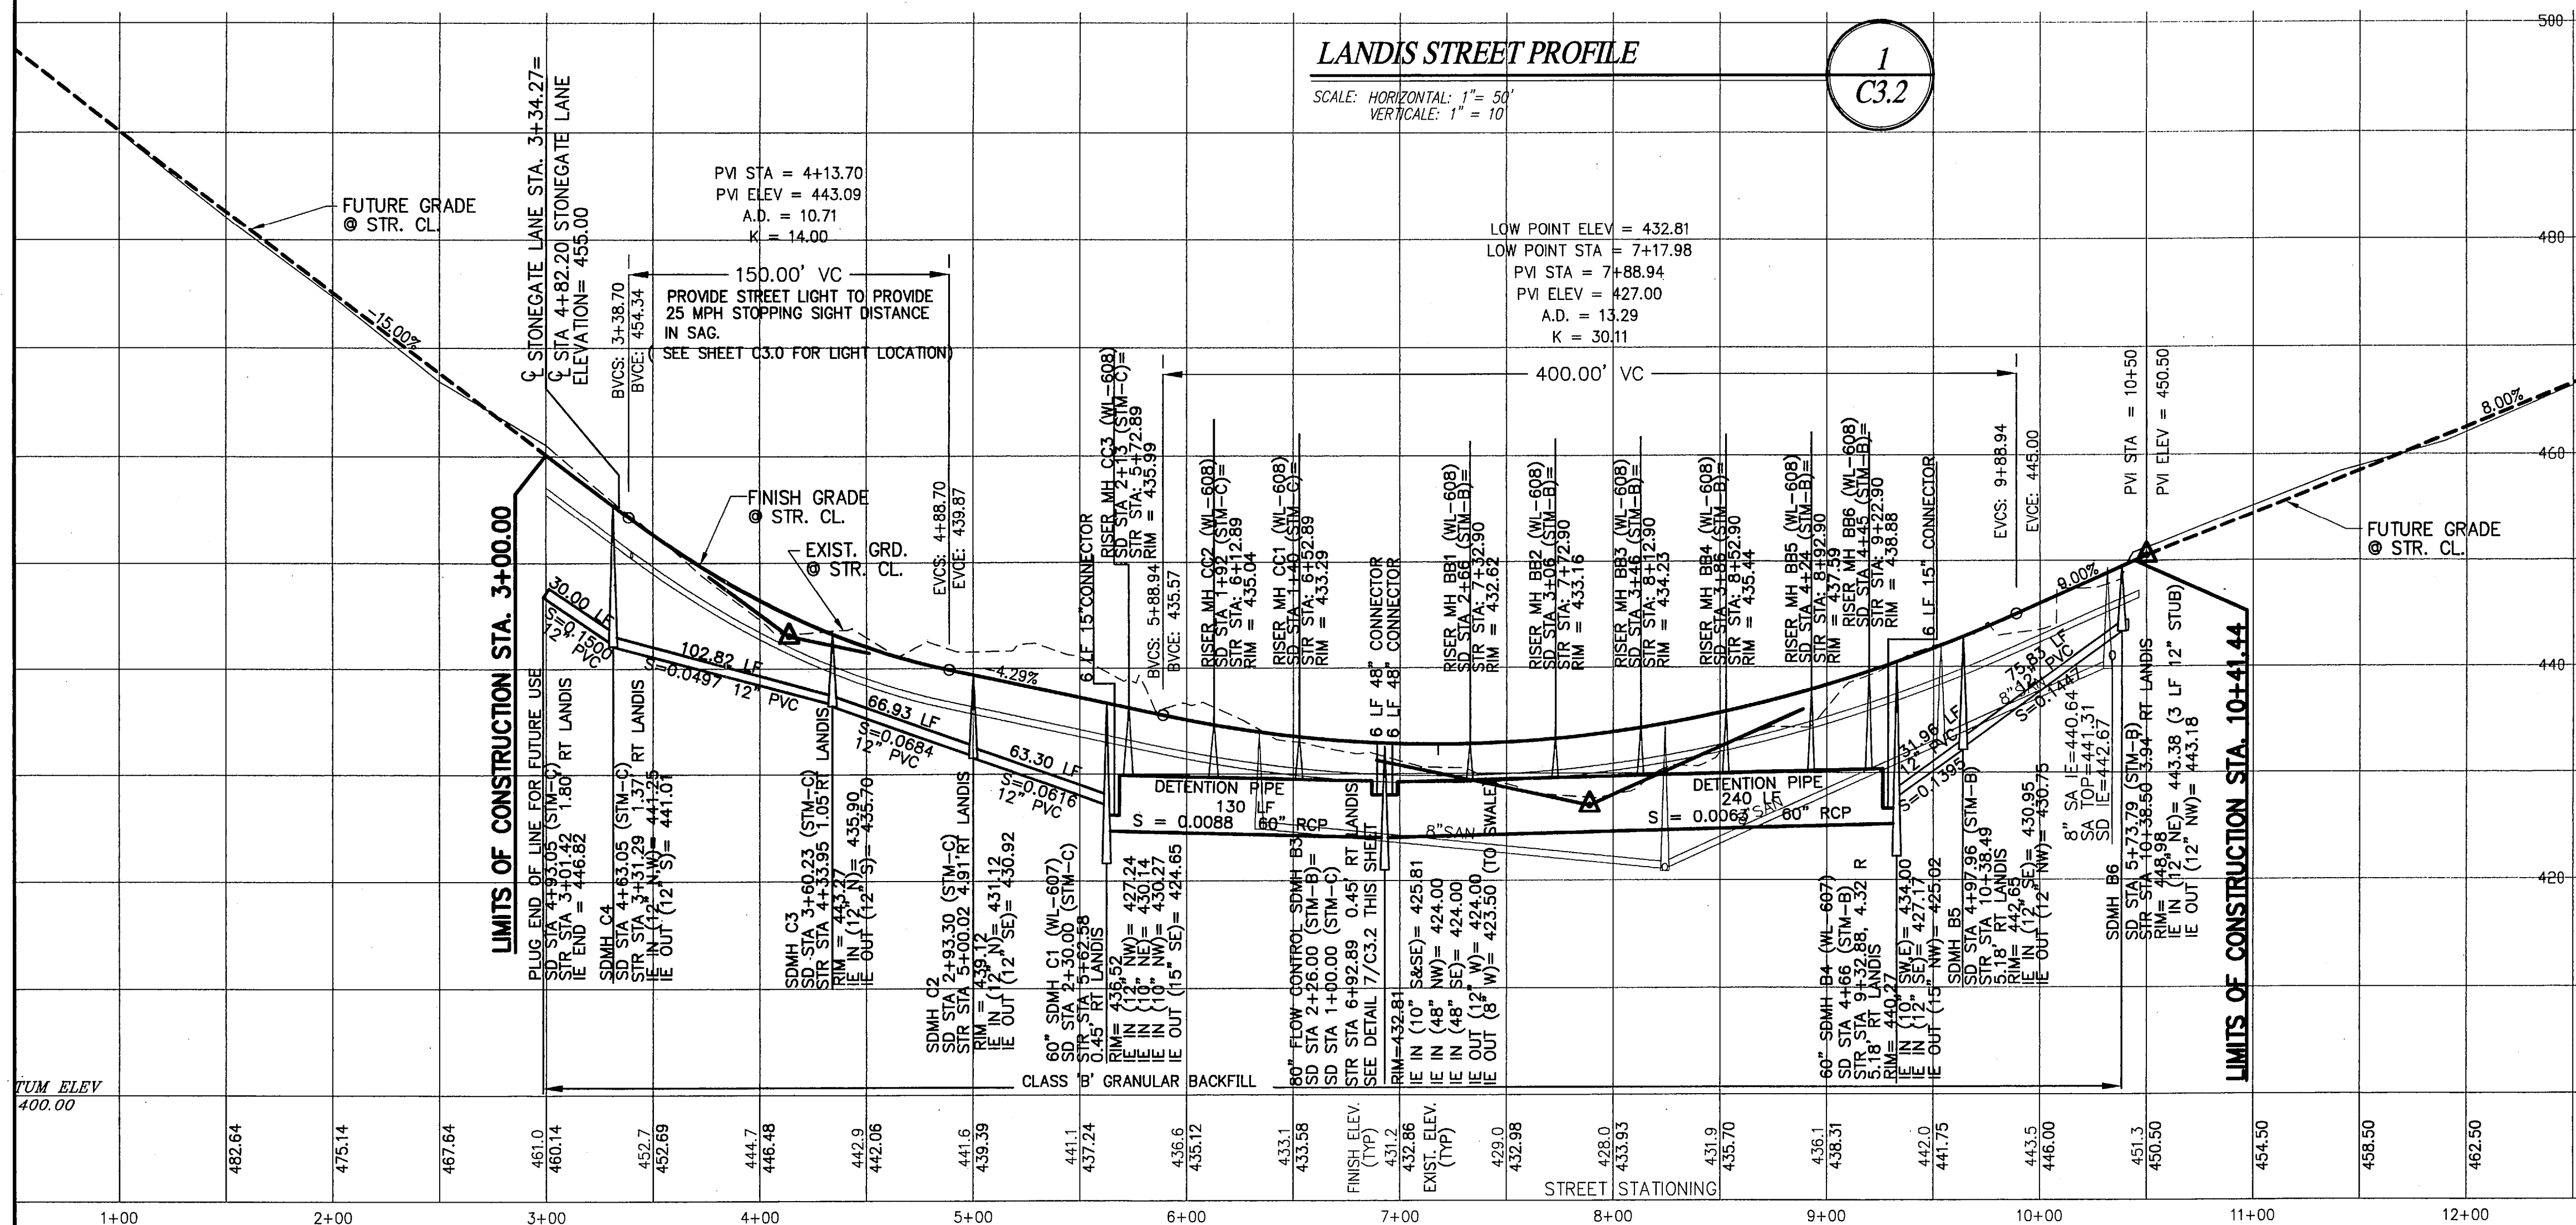

STORM LINE B

SCALE: HORIZONTAL: 1" = 50'
VERTICAL: 1" = 10'


2
C3.2

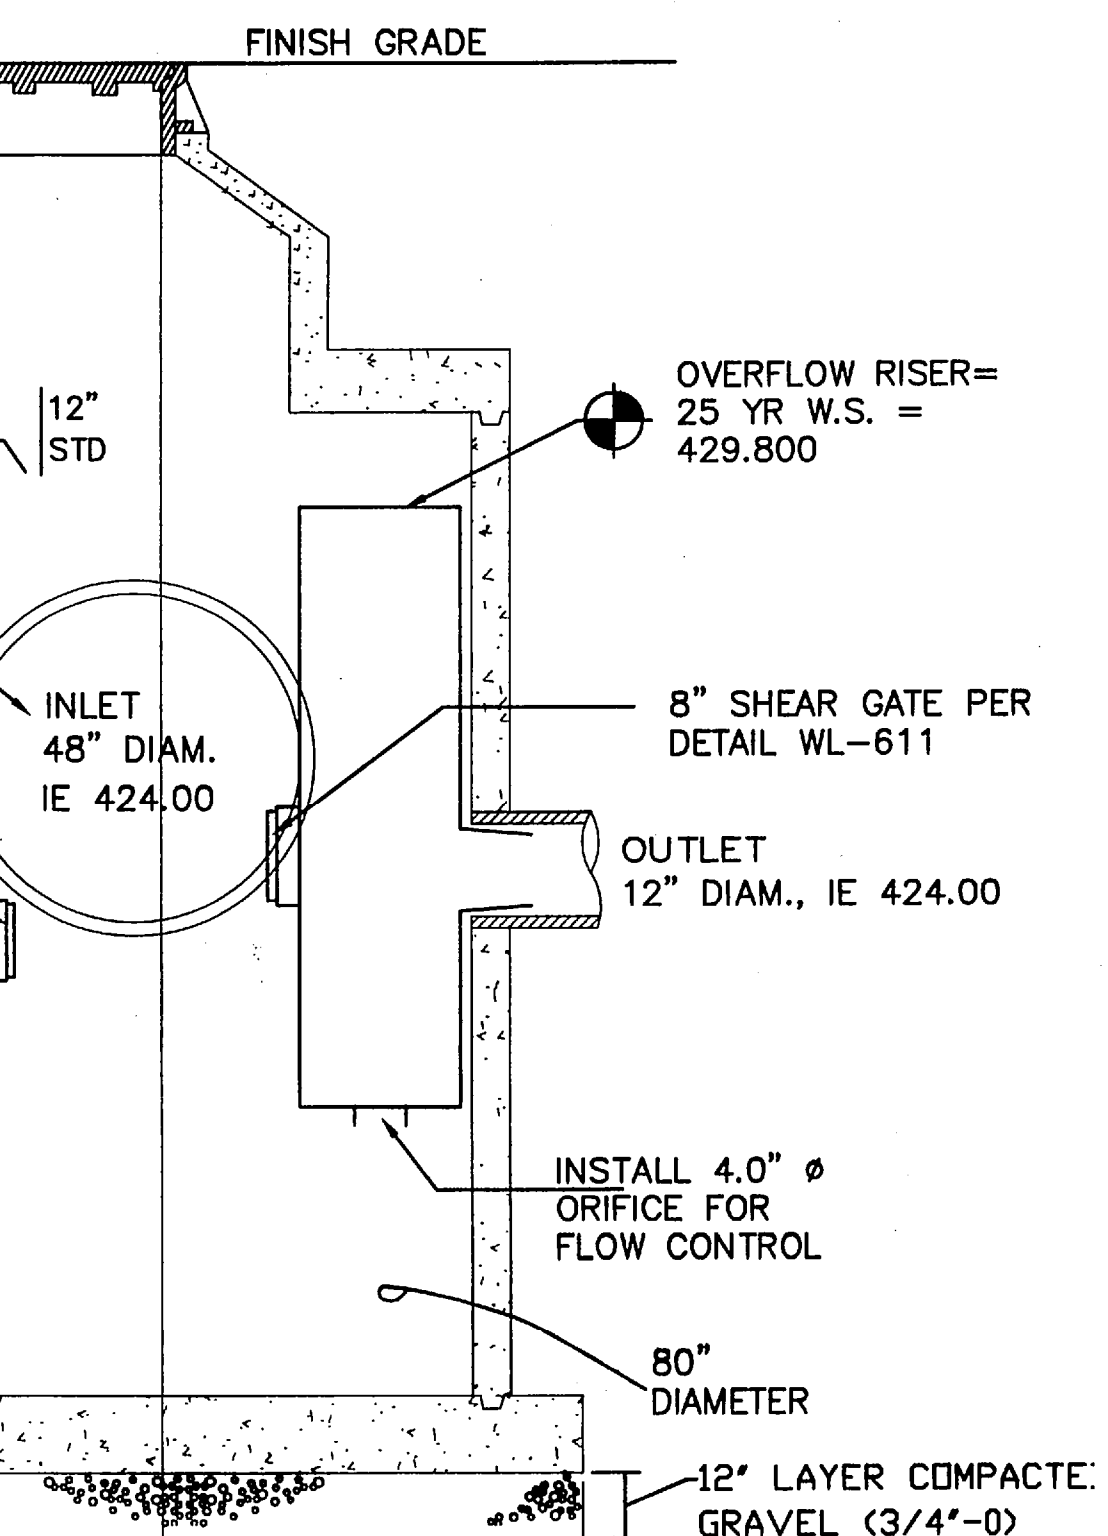

FLOW CONTROL MH-SDMH B-3

SCALE: 1"=4'H

7
C3.2

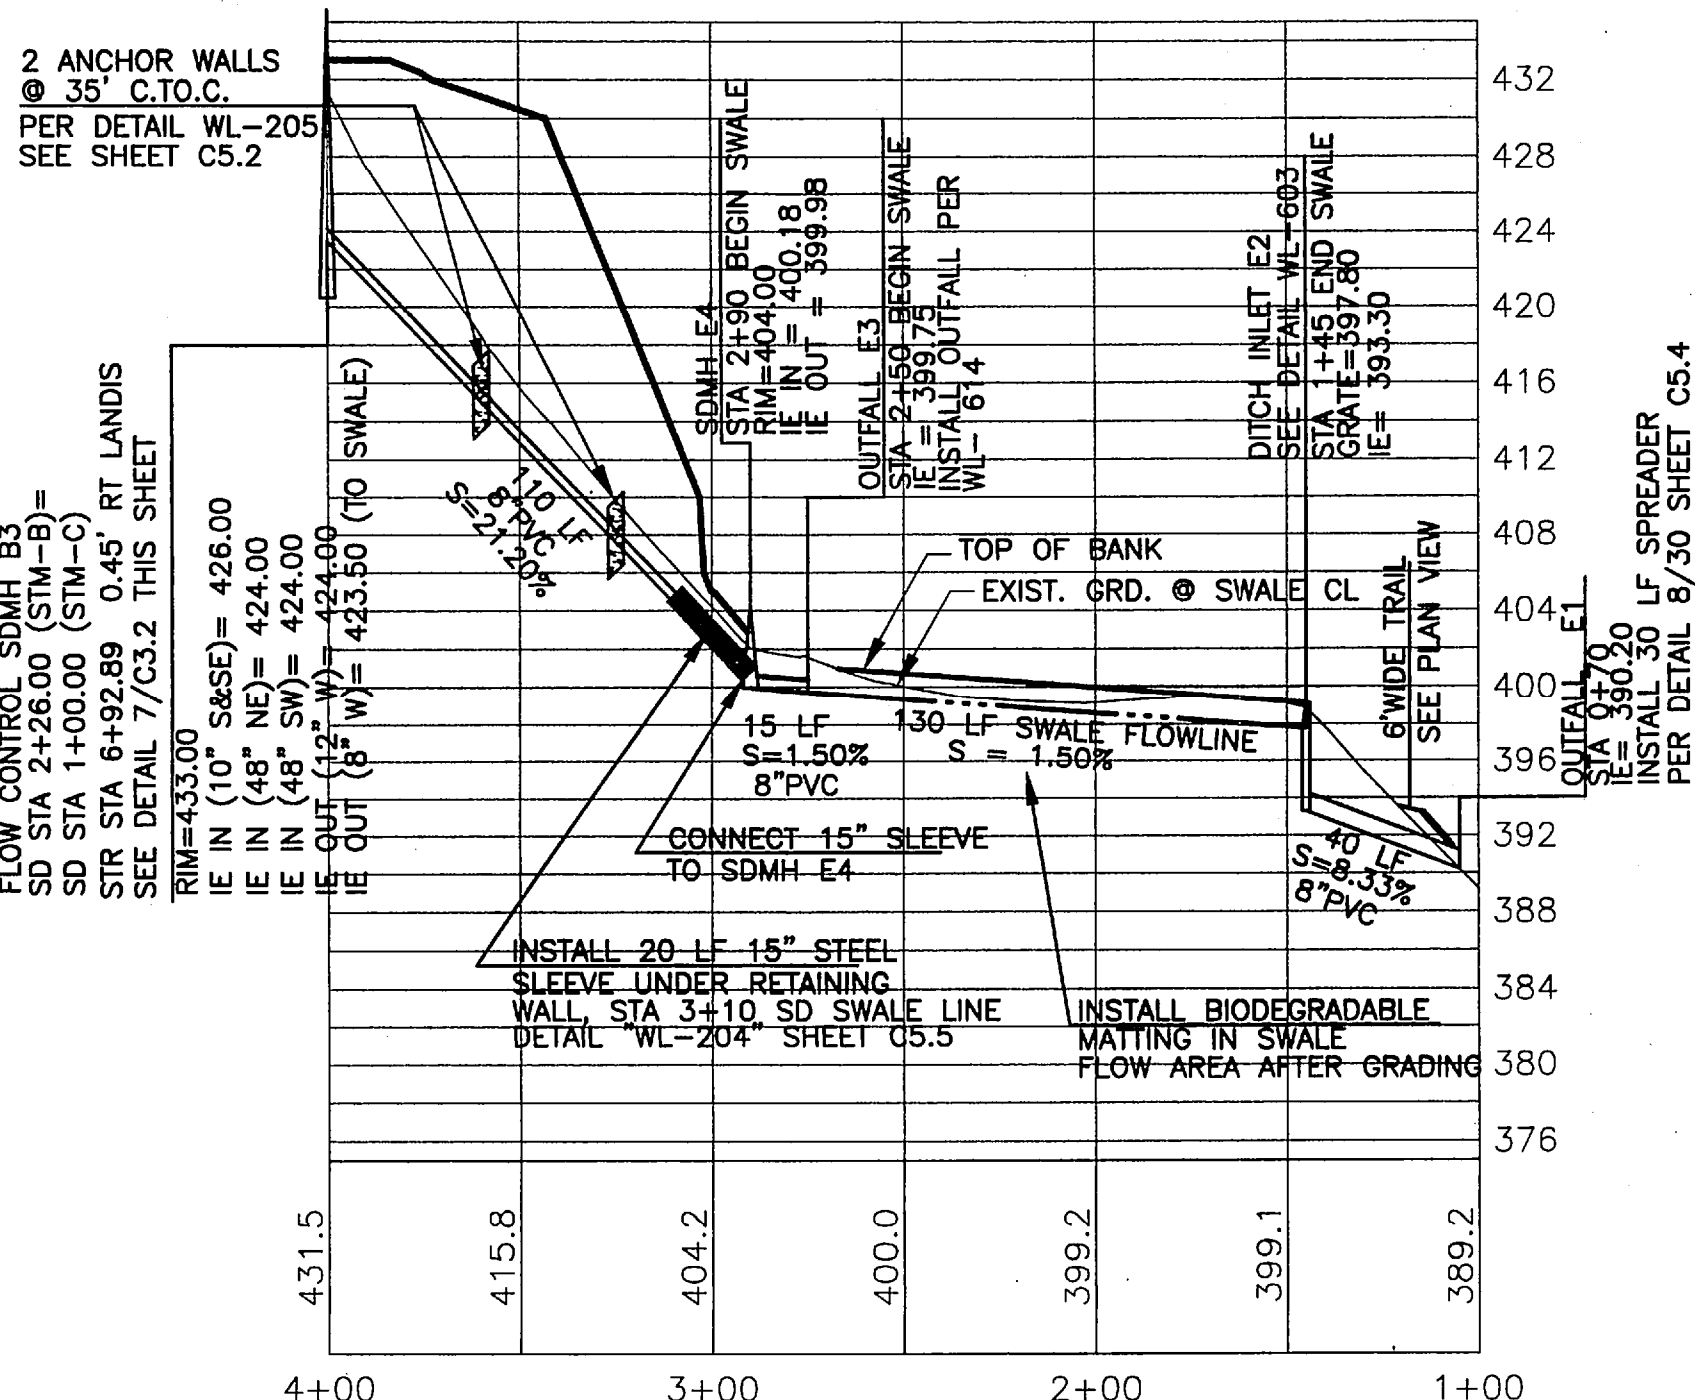

WATER QUALITY SWALE PROFILE


SCALE: HORIZONTAL: 1" = 50'
VERTICAL: 1" = 10'

3
C3.2

SWALE CROSS SECTION

SCALE: HORIZONTAL: 1" = 50'
VERTICAL: 1" = 10'

4
C3.2

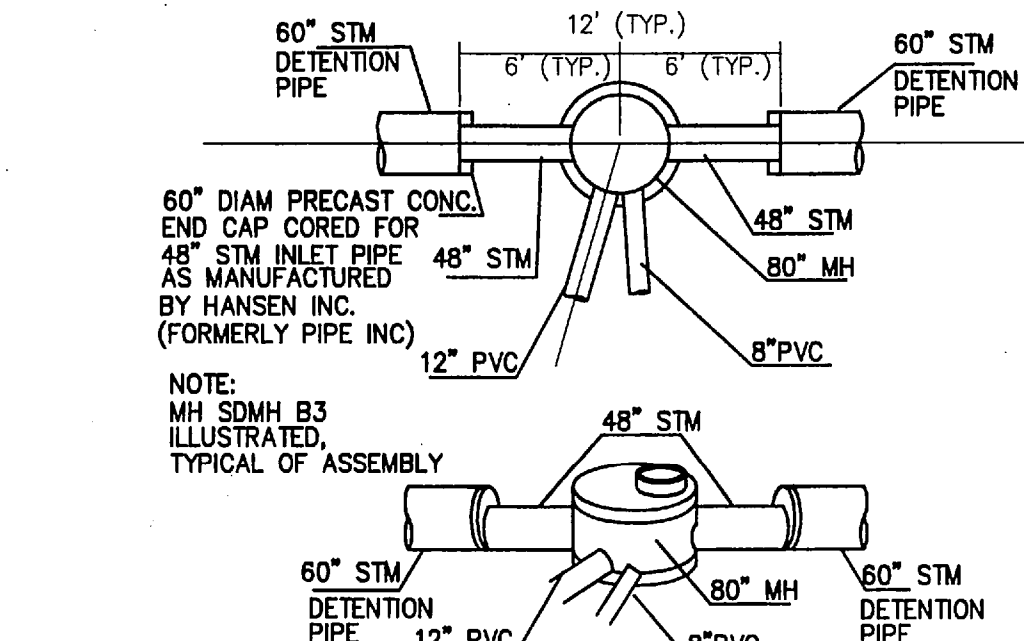

DETENTION PIPE END CAP

SCALE: N.T.S.

5
C3.2

WATER QUALITY SWALE SHALL BE SEEDED
IN ACCORDANCE WITH CITY OF PORTLAND B.E.S.
MANUAL, SEPTEMBER 2000:
HOBBS AND HOPKINS, PRO-TIME 840, NATIVE,
BIO-FILTER MIX (OR APPROVED ALTERNATE):

BLUE WILDRYE	47.0%
NATIVE RED FESCUE	40.0%
TUFTED HAIRGRASS	10.0%
WESTERN MANNAGRASS	2.0%
AMERICAN SLOUGHGRASS	1.0%

SWALE PLANTING NOTE

SCALE: N.T.S.

6
C3.2

08/21/2001

Date

AAH/BLW/JAH

Designed

AAH/BLW/JAH

Drawn

Checked By Date

REVISIONS

NO.

DATE

BY

APPD.

NO.

DATE

BY

APPD.


NO.

DATE

BY

APPD.

XREF LIST
Ltscale: 1
Resolved
D579X001
D579X190
D579X230
D579X400
D579X430
D579X600
D579X630

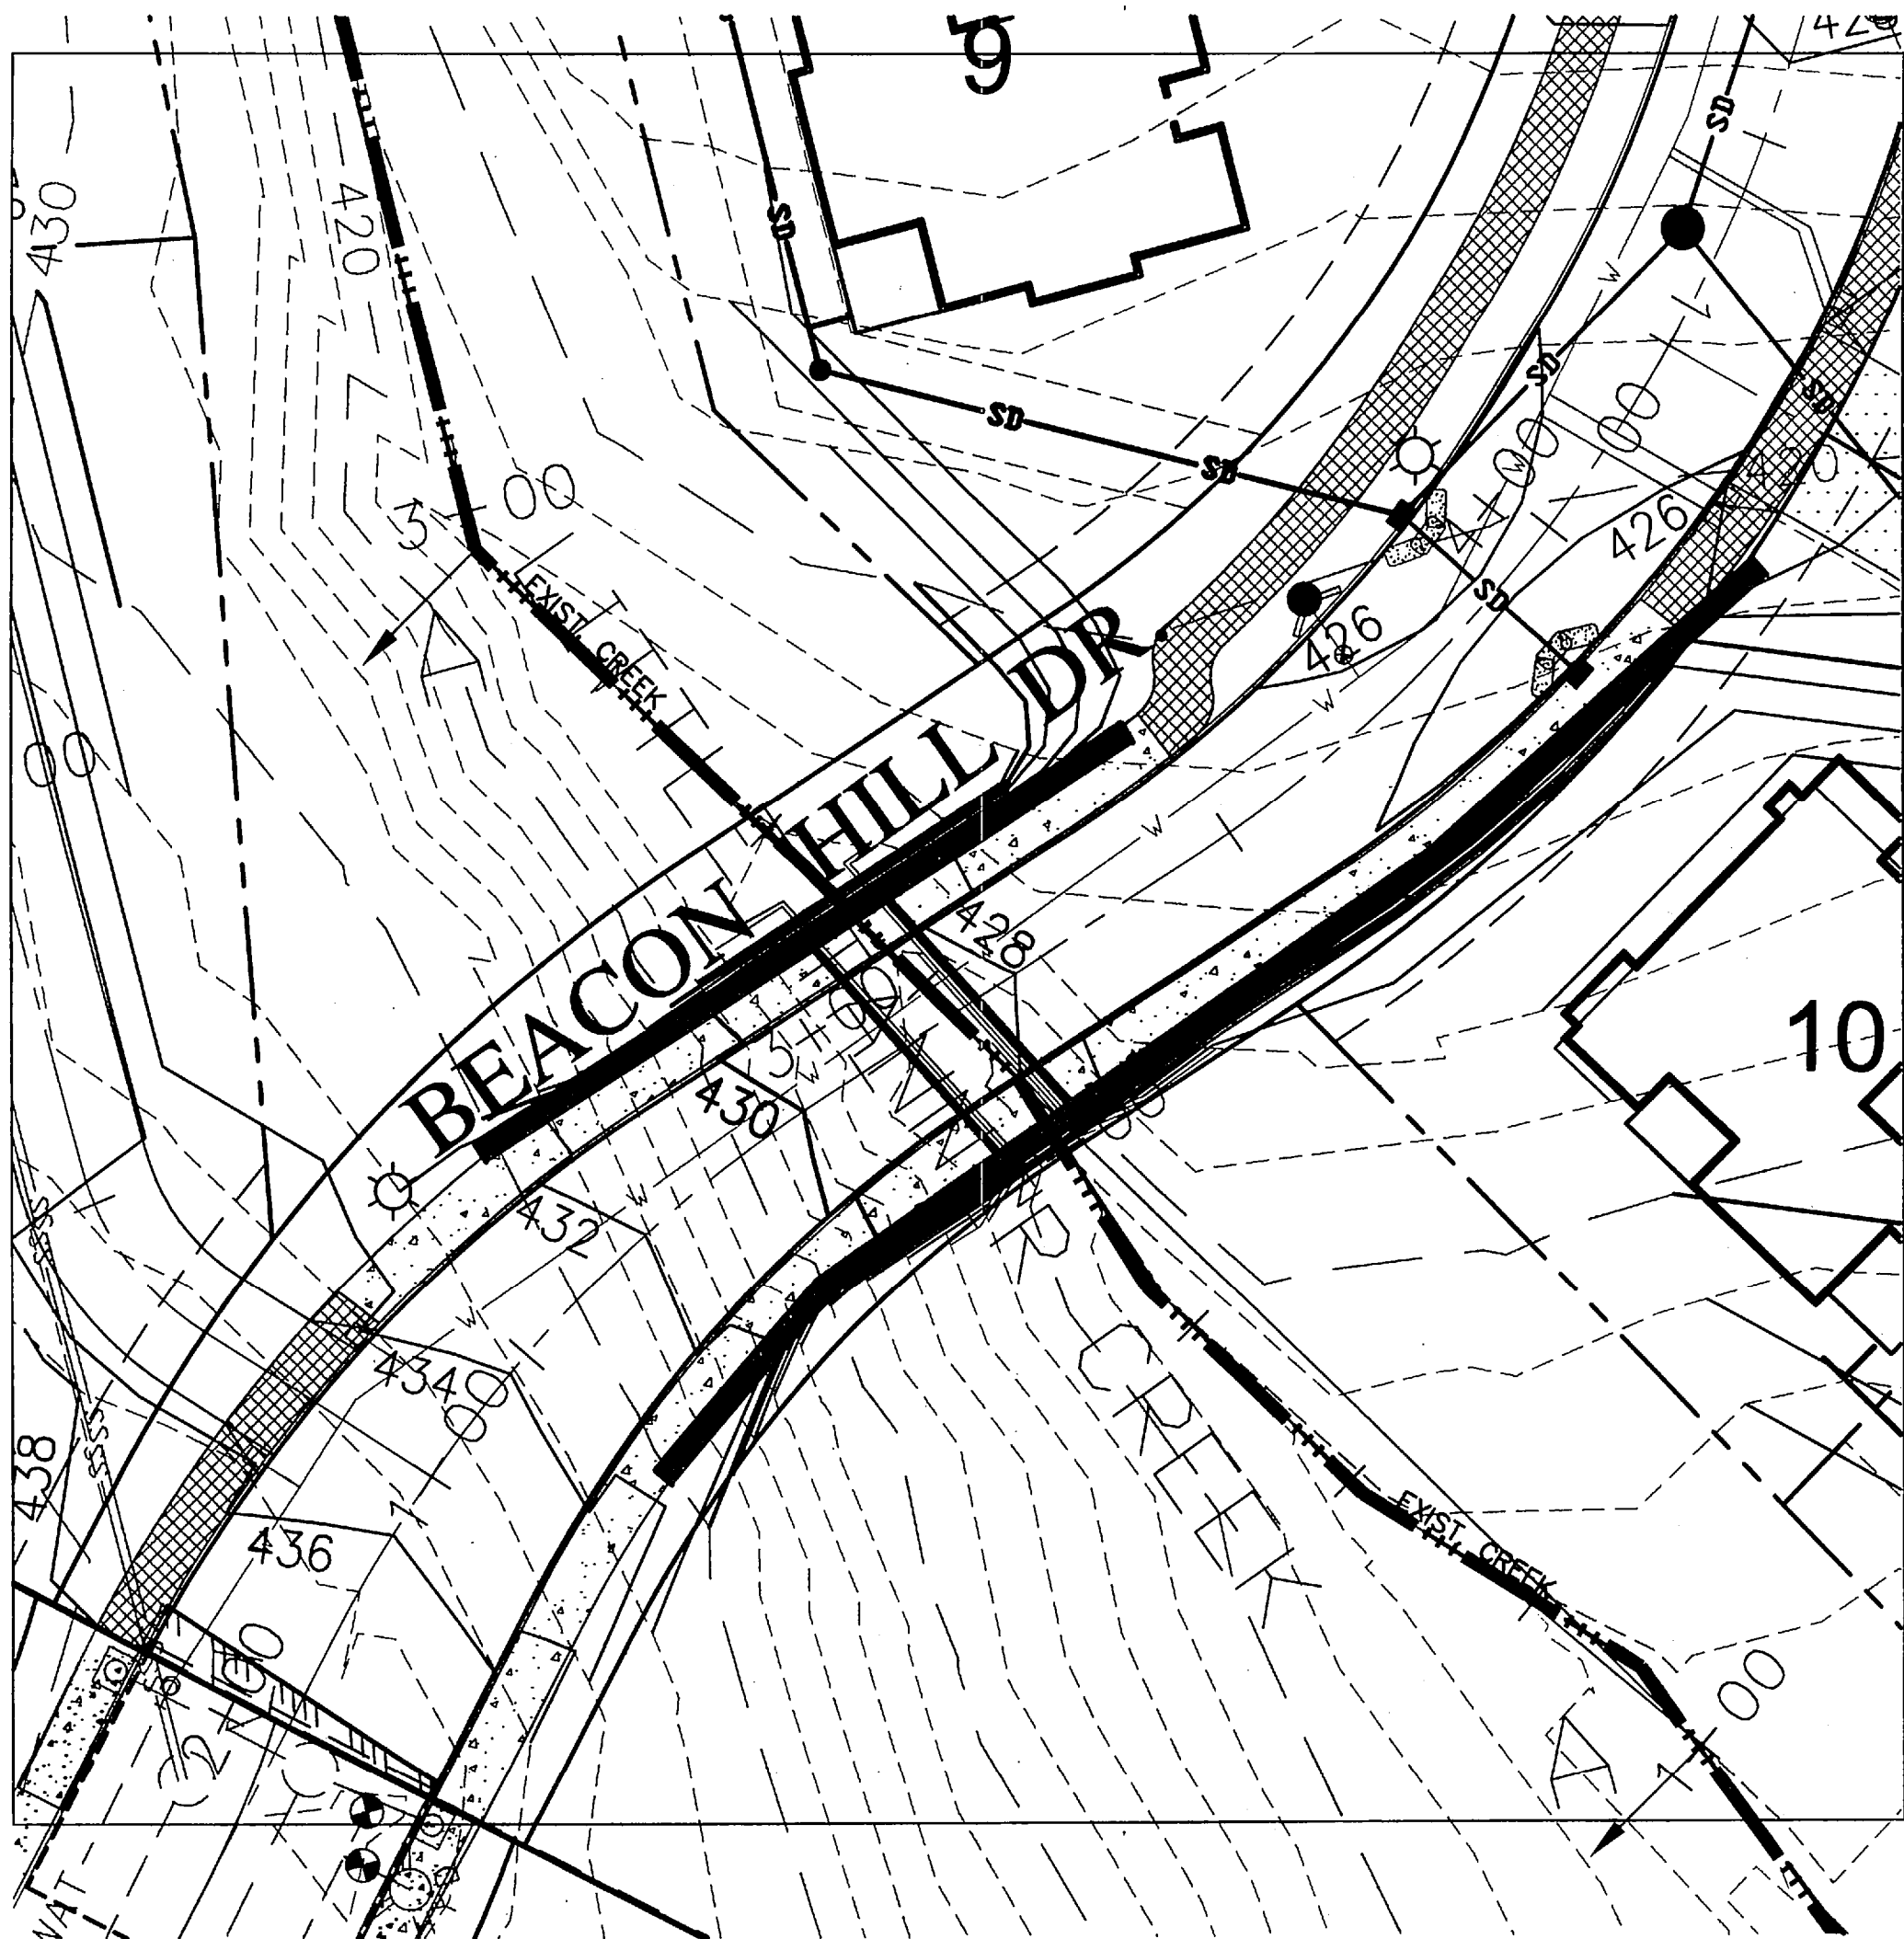


LITTLE TANNER CREEK CROSSING

SCALE: AS SHOWN

1
C3.3

CULVERTS NOTE:


THE BOTTOM OF THE CULVERTS SHALL BE CONSTRUCTED TO FISH AND WILDLIFE STANDARDS AND SHALL BE INSPECTED AND ACCEPTED BY FISH & WILDLIFE.

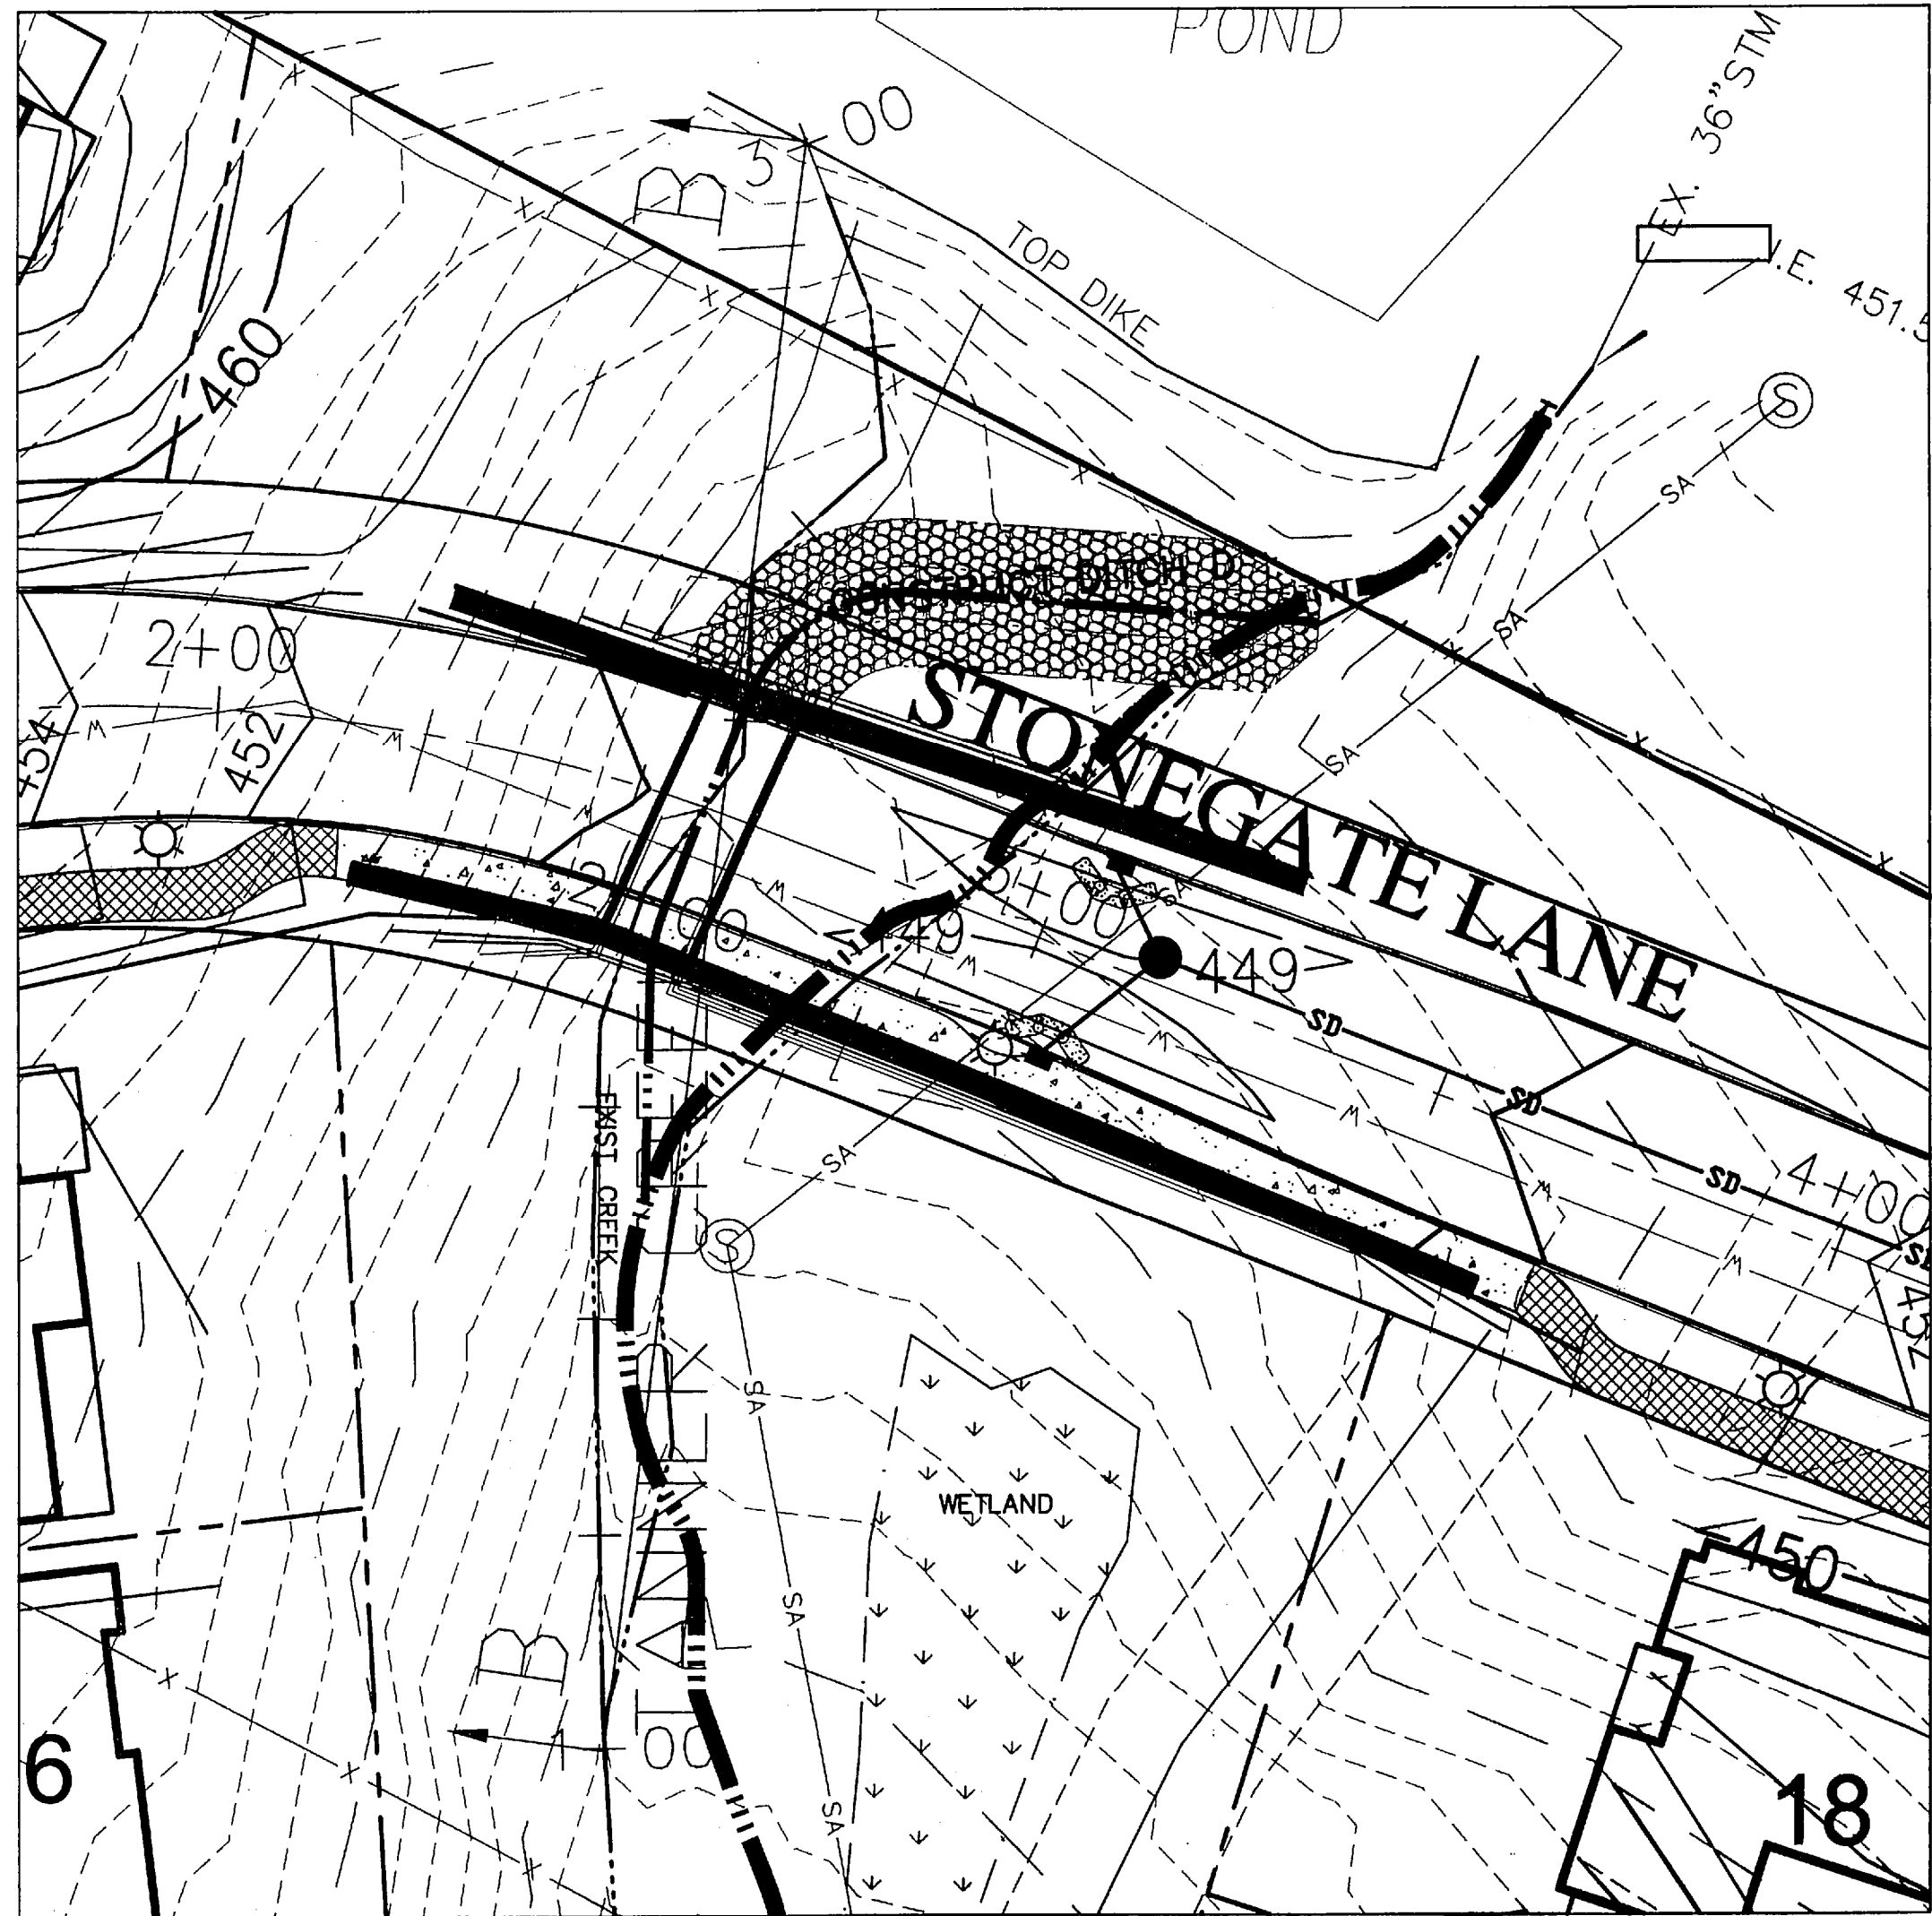

TANNER CREEK CROSSING PLAN

SCALE: AS SHOWN


2
C3.3

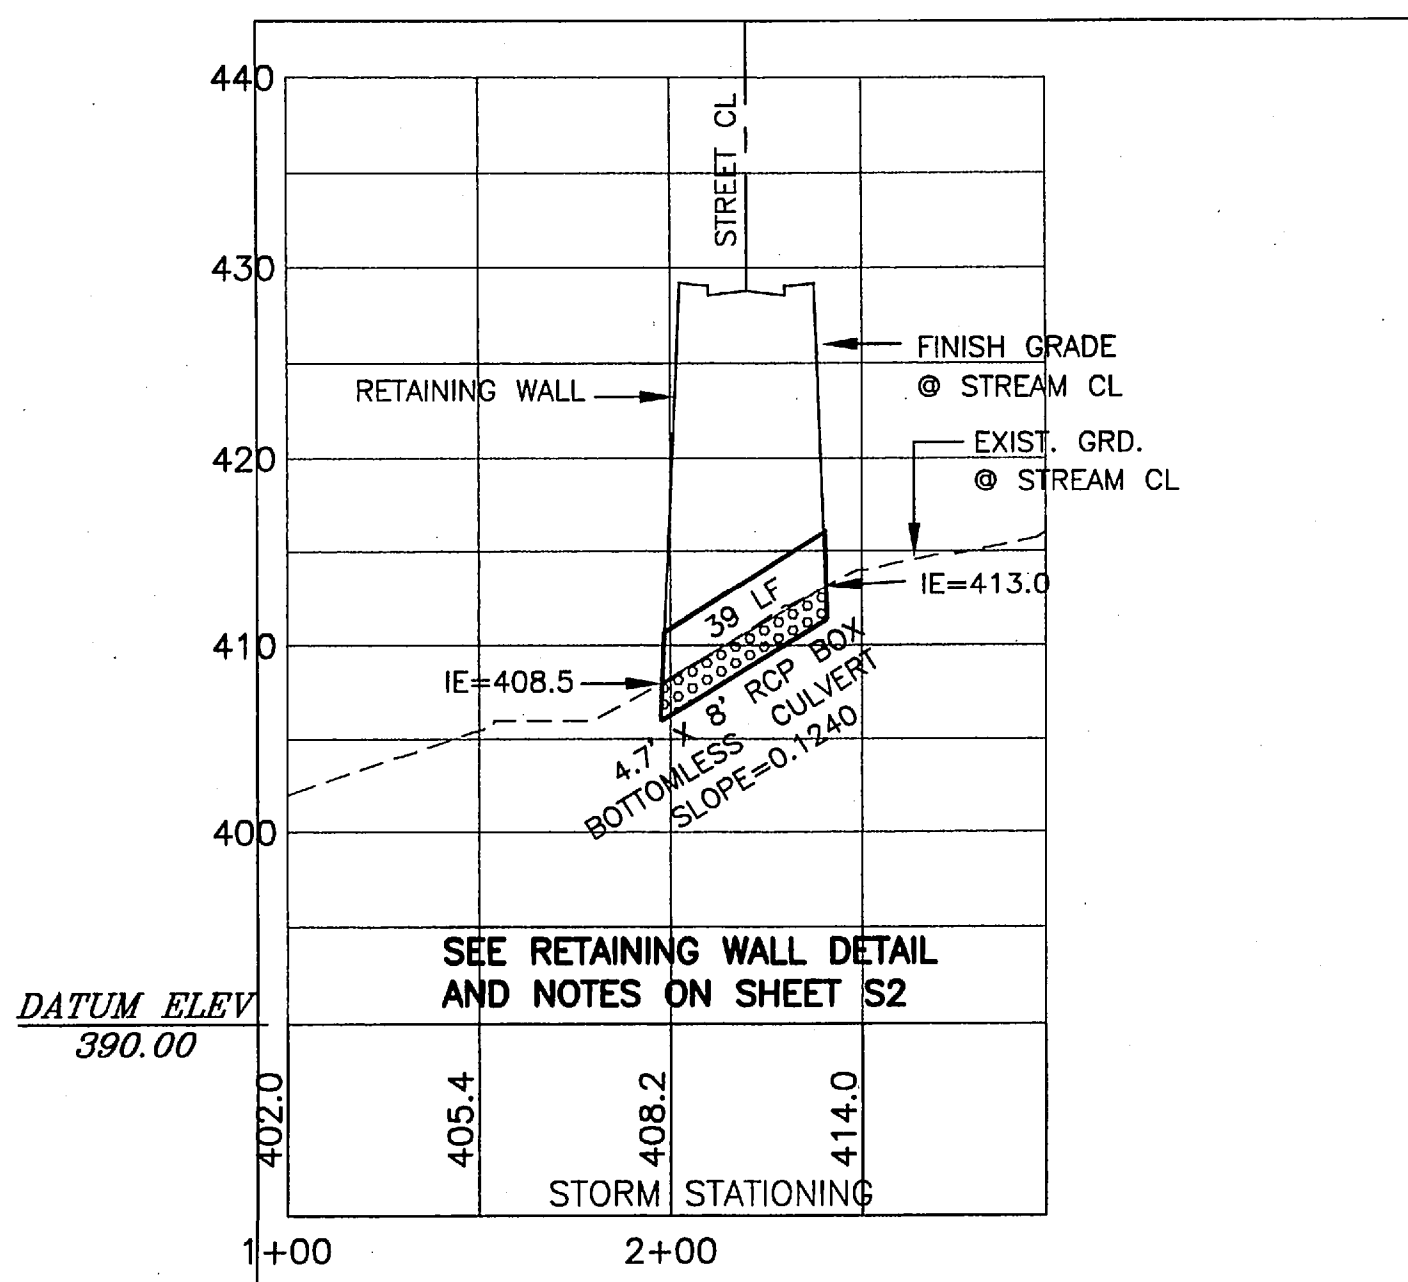

LITTLE TANNER CREEK SECTION A-A

SCALE: HORIZONTAL 1" = 50'
VERTICAL 1" = 10'


3
C3.3

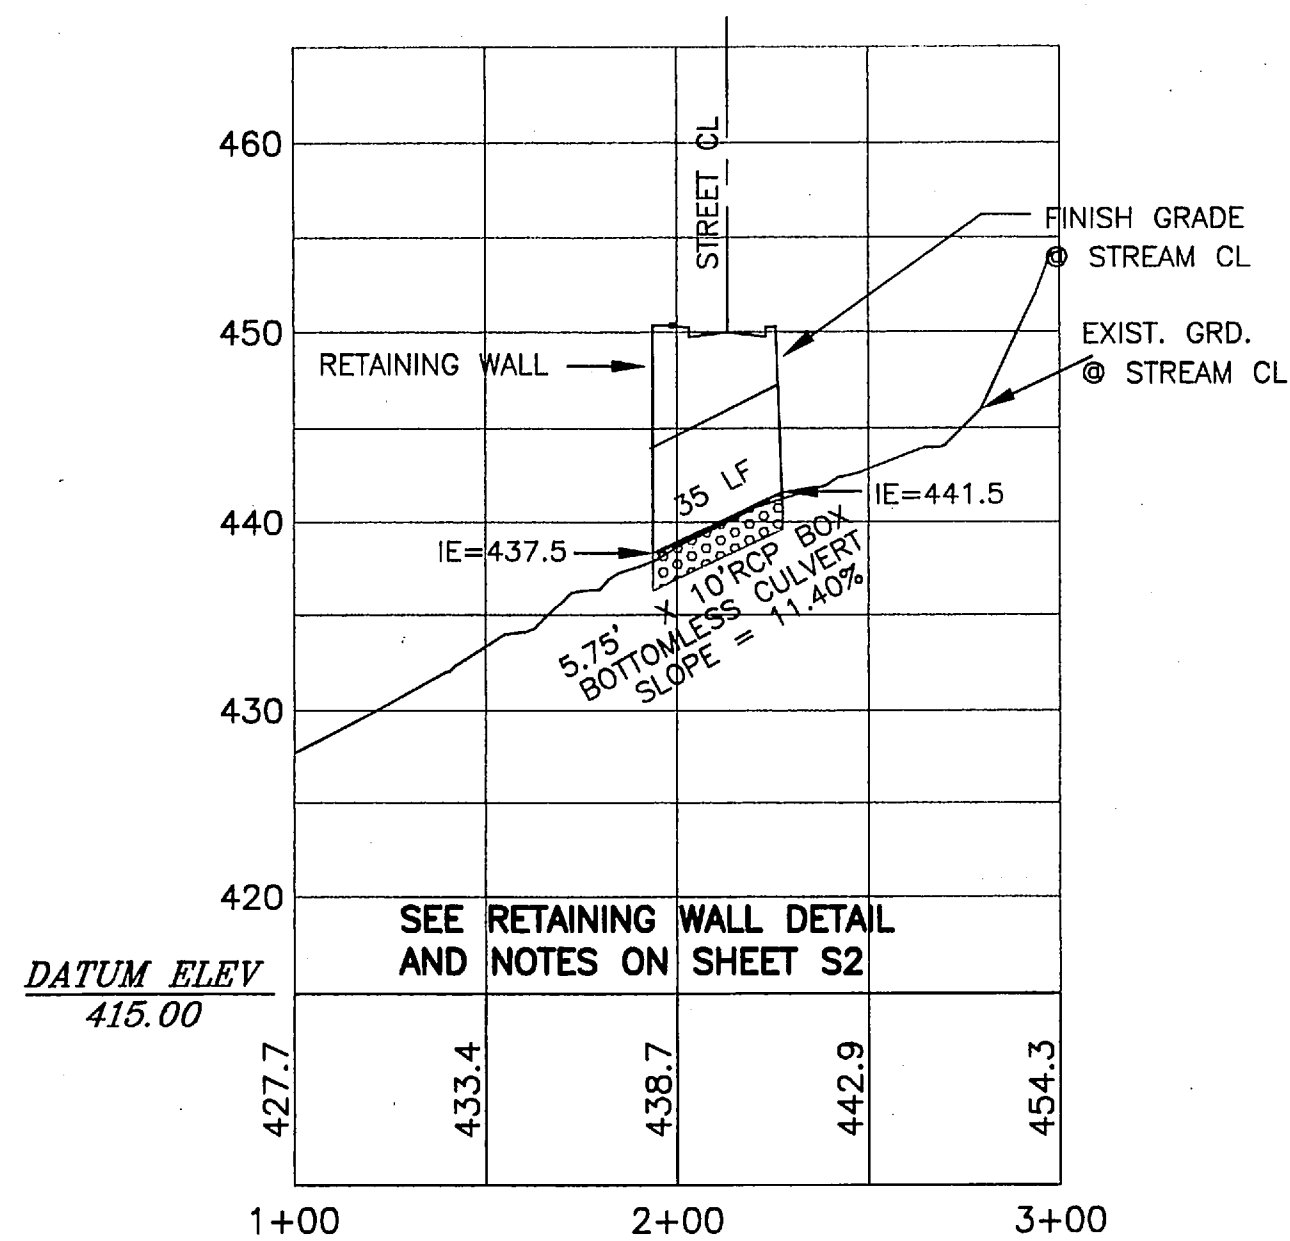

TANNER CREEK SECTION B-B

SCALE: HORIZONTAL 1" = 50'
VERTICAL 1" = 10'


4
C3.3

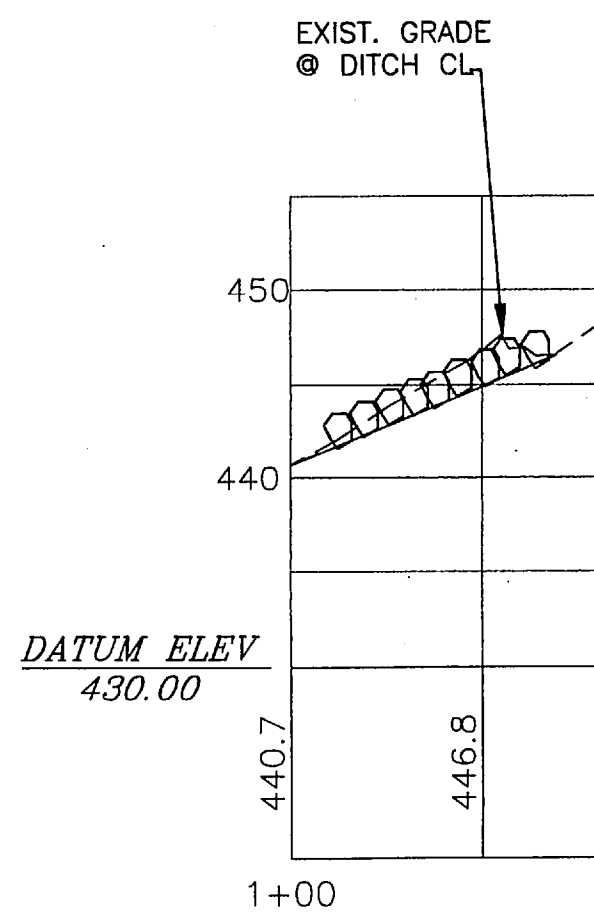

DITCH D PROFILE

SCALE: HORIZONTAL 1" = 50'
VERTICAL 1" = 10'

5
C3.3

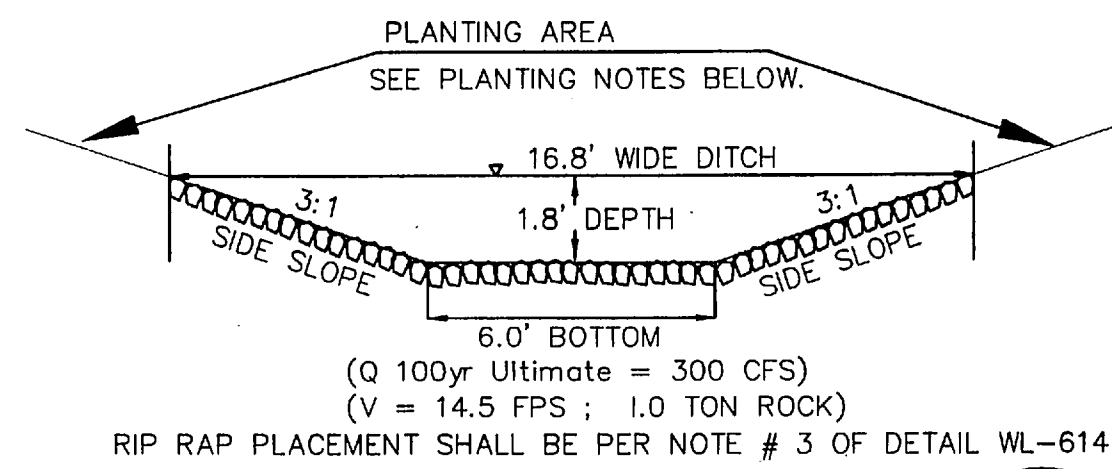

DITCH D CROSS SECTION

SCALE: HORIZONTAL 1" = 4'
VERTICAL 1" = 4'

6
C3.3

NOTES:

ALL PLANTING AREAS WILL BE WATERED UNTIL THE PLANTS HAVE ESTABLISHED.

PLANTING POCKET BACKFILL WILL INCLUDE 25% LEAF COMPOST MIXED WITH NATIVE TOPSOIL.

ALL PLANTING AREAS WILL BE TOP-DRESSED WITH A 2" LAYER OF MEDIUM BARK MULCH.

SEE SHEET C3.4B FOR PLANTING LISTS, SHRUB PLANTING AND TREE STAKING DETAILS.

08/21/2001
Date
AAH/BLW/JAH
Designed
AAH/BLW/JAH
Drawn
Checked By Date
REVISIONS
NO. DATE BY APPD.
PROFESSIONAL ENGINEER
46494PE
OREGON
JANUARY 14, 2003
ADAM ANIS HAYDA
RENEWAL 06/30/2003

NORWAY DEVELOPMENT
P.O. Box 387
Oregon City, Oregon 97045
PHONE: (503) 656-7000
FAX: (503) 656-0686

Tanner's Stonegate
CITY OF WEST LINN, OREGON
STREAM CROSSING PLAN AND PROFILE

Incorporated
17955 SW Boones Ferry Road
Lake Oswego, OR 97035-5217
Phone: (503) 635-3618
FAX: (503) 635-5395


10579
Project No.
D579C3-3
File No.
C3.3
Sheet No.
Copyright 2001

AS BUILTS


```


=====
XREF LIST
=====
Ltscale: 1
-----
Resolved
-----
D579X001
D579X190
D579X230
D579X400
D579X430
D579X600
D579X630

```

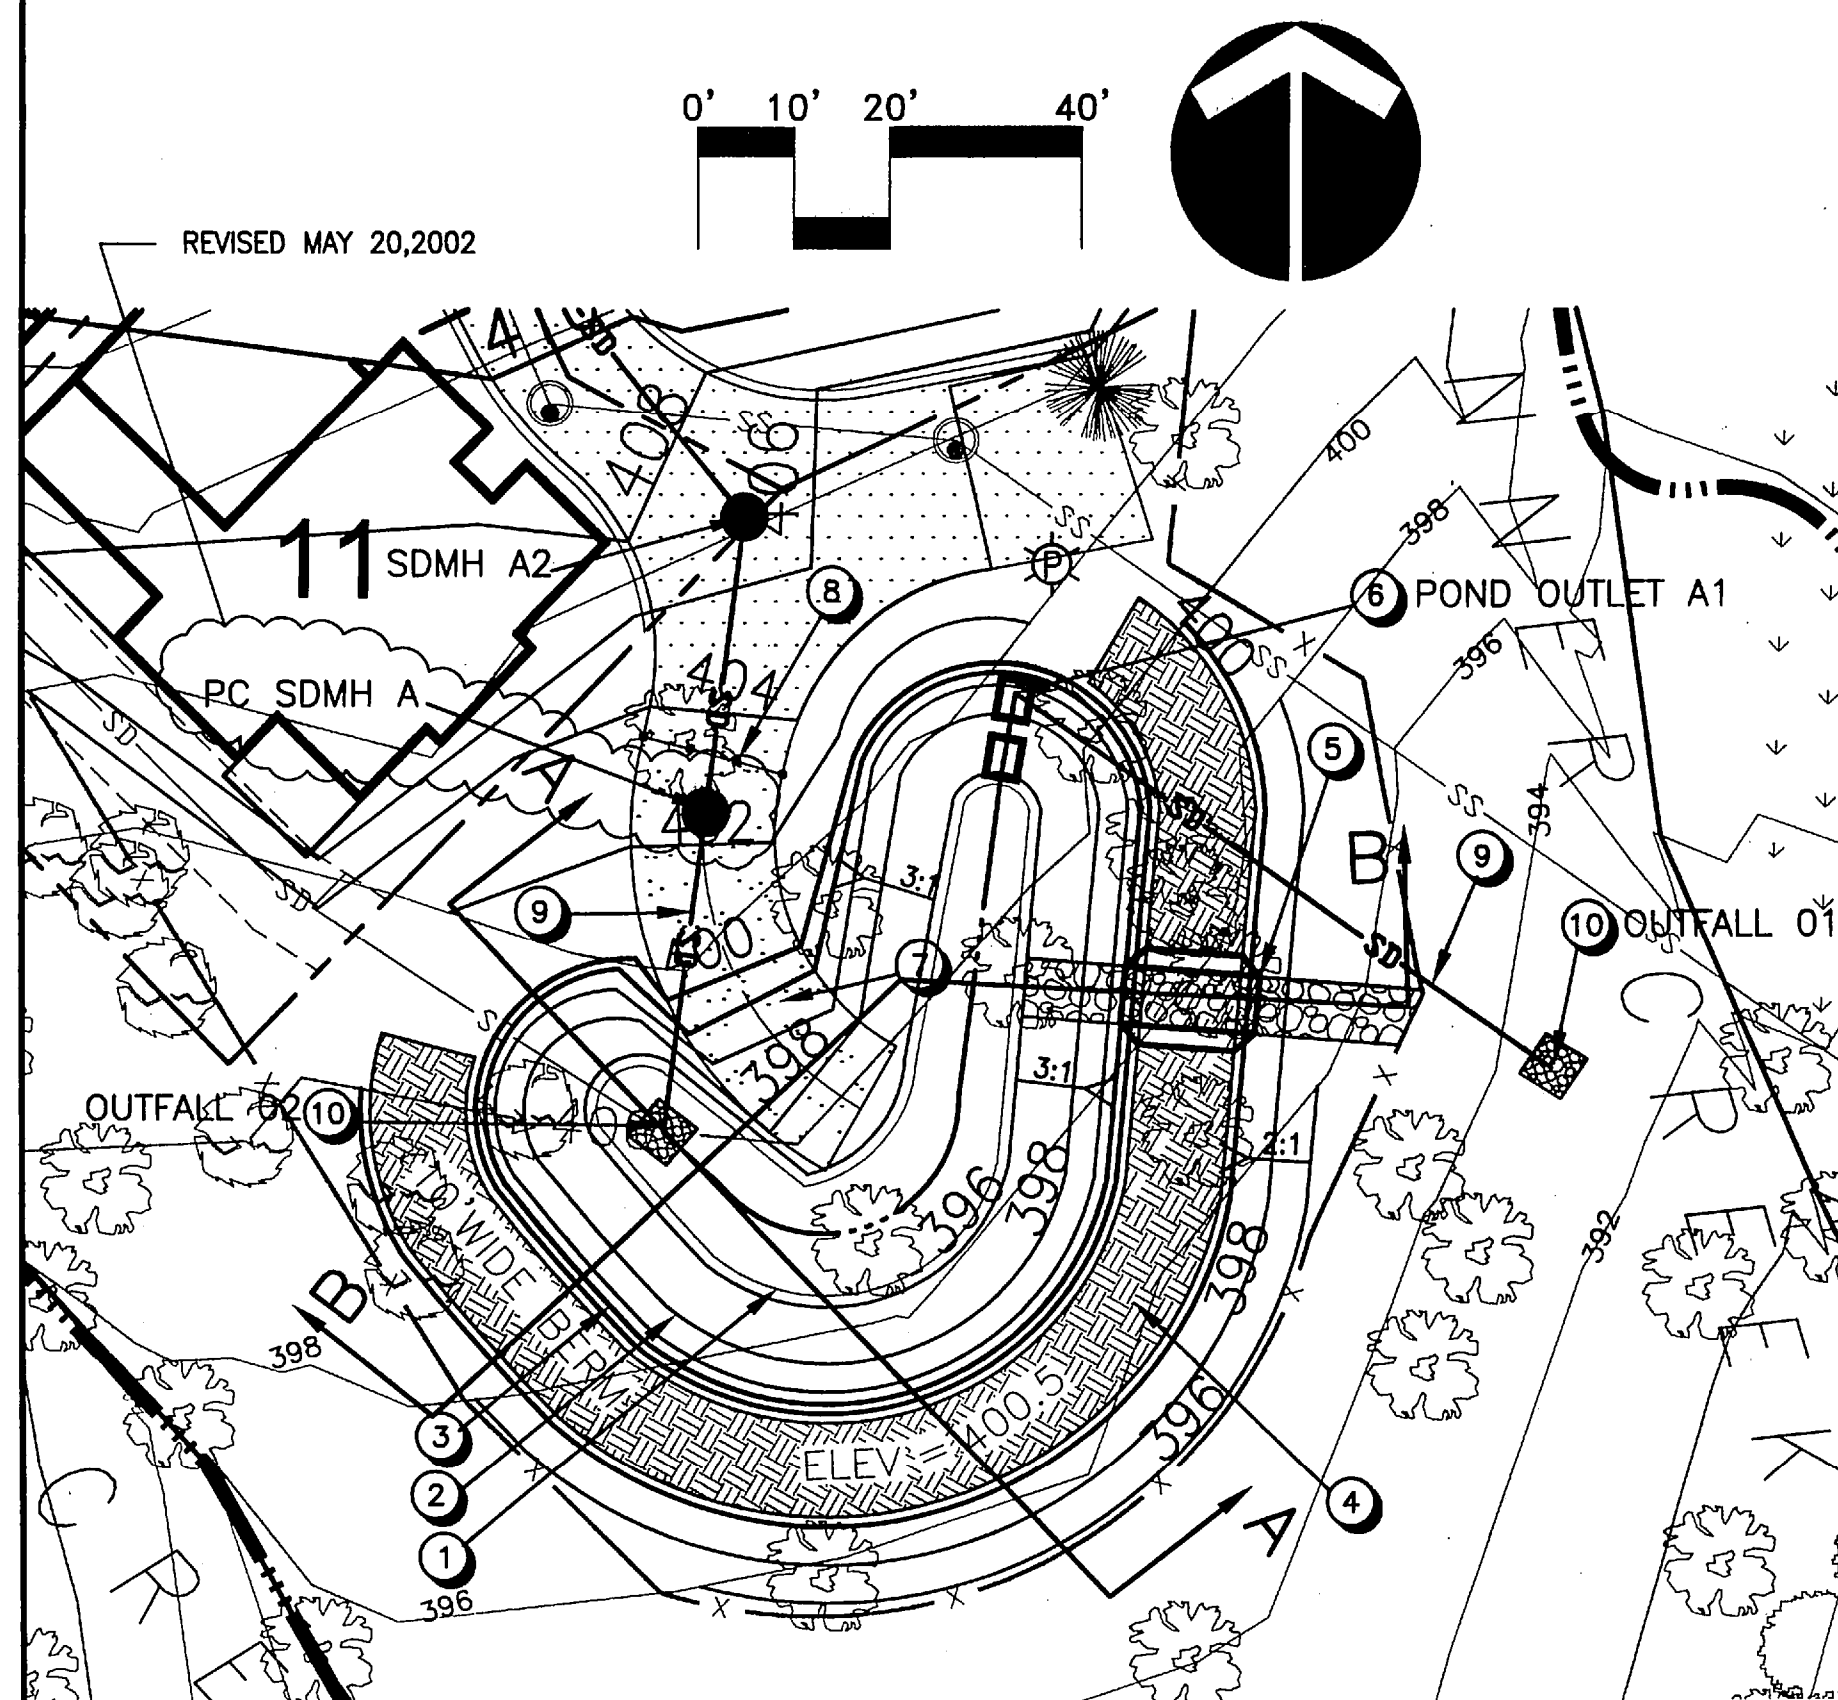

WATER QUALITY & DETENTION POND

SCALE: 1"=20'H

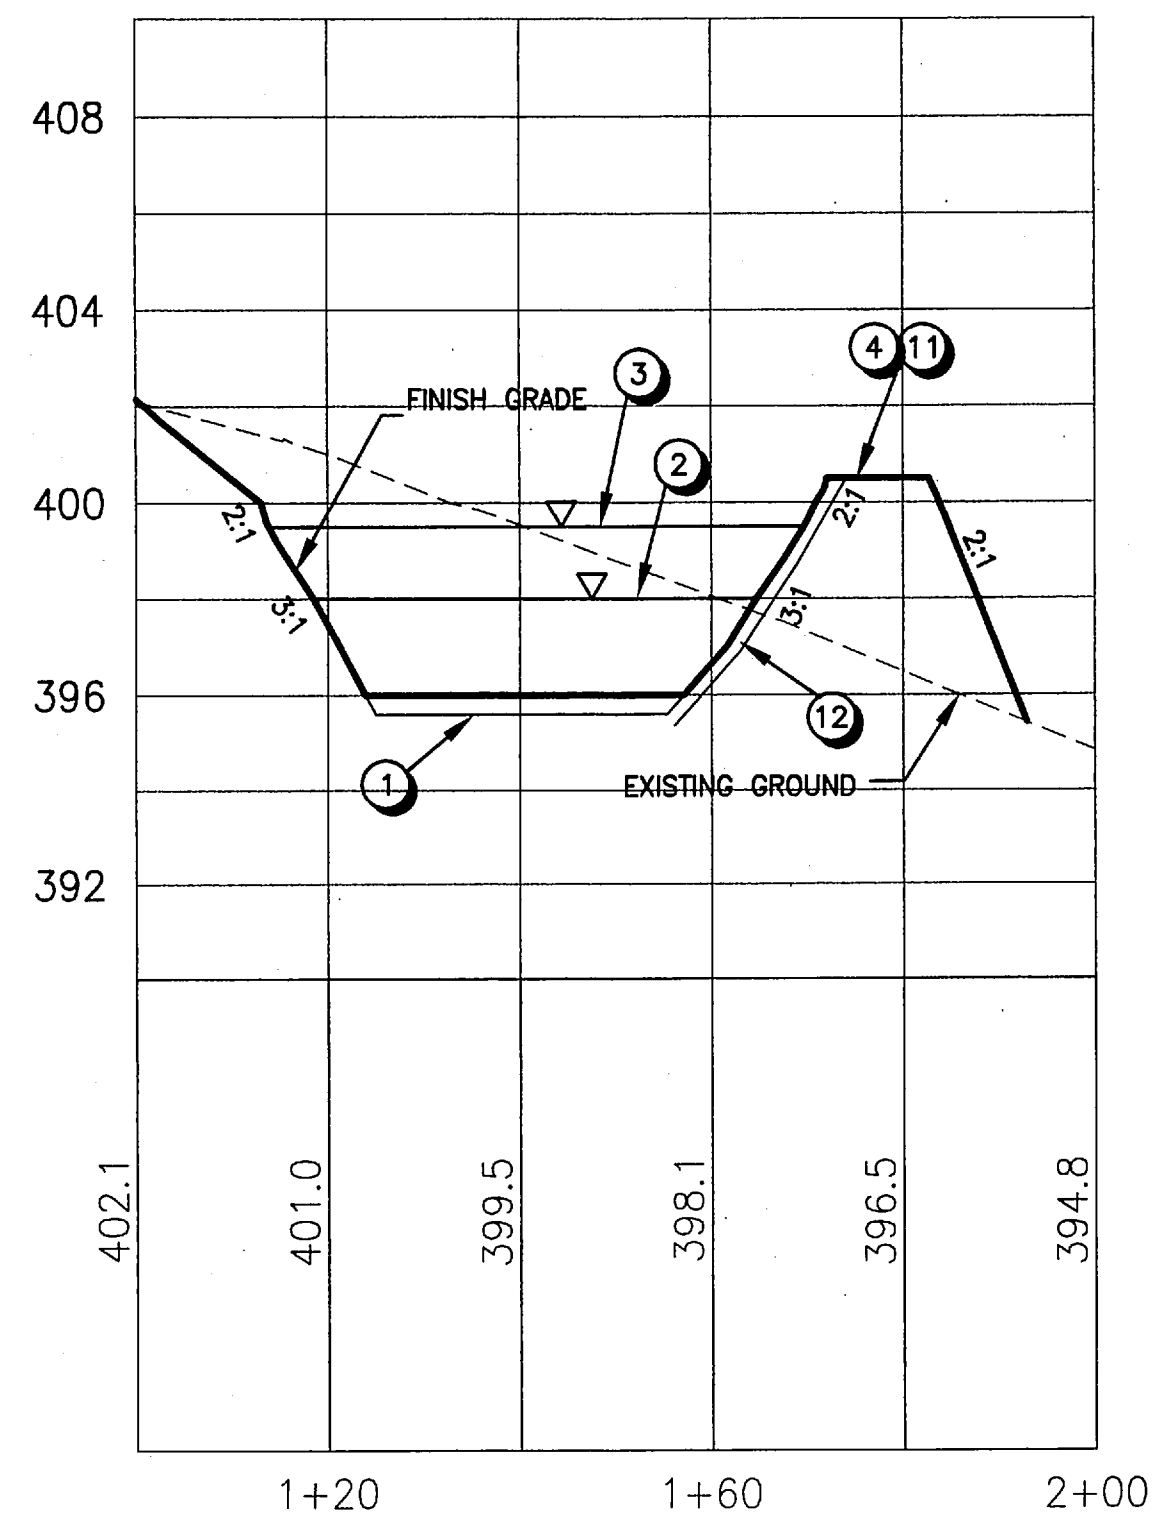

CROSS SECTION A-A

SCALE: $1''=20'H$
 $1''=2'V$




- ① ACTUAL BOTTOM ELEVATION=395.6 (0.4' OF PERMANENT POOL)
BOTTOM W.Q. TREATMENT LEVEL = 396.0
- ② WATER QUALITY SURFACE ELEVATION=398.00 (VOLUME=3125 CF)
- ③ 25 YEAR WATER DETENTION SURFACE ELEVATION=399.50 (VOLUME=4180 CF)
- ④ 10'WIDE BERM WITH 2" OF 3/4"-0" GRAVEL FOR ALL WEATHER ACCESS ELEVATION=400.5
- ⑤ EMERGENCY OVERFLOW WEIR (SEE DETAIL 4/C3.4)
(RIP-RAP ALL DRAINAGE SPILLWAY AS SHOWN ON PLAN PER WL-614, SHEET C5.3.
- ⑥ POND OUTLET A1 (DETAIL WL-610 SHEET C5.5)
- ⑦ ALL WEATHER ACCESS ROAD INTO POND AT 7:1 SLOPE.
15' WIDE, 10" OF 3/4"-0" AGGREGATE COMPACTED
- ⑧ INSTALL 4 BOLLARDS (METAL POST) 2 FIXED BOLLARDS ON ROAD SIDES ,
AND 2 REMOVABLE BOLLARDS EQUALLY LOCATED BETWEEN THE FIXED BOLLARDS.
- ⑨ SEE SD POND A PROFILE DETAIL 5/C3.4 THIS SHEET
- ⑩ INSTALL CLASS 100 RIP-RAP PAD PER WL-613 & WL-614 SHEET C5.3
- ⑪ CONSTRUCT BERMS IN ACCORDANCE GENERAL NOTES, PROJECT DOCUMENTS
AND THE RECOMMENDATIONS OF GEOTECHNICAL ENGINEER
- ⑫ INSTALL LINER.

NOTES:


1. PROVIDE MINIMUM OF 6" OF TOP SOIL ON EXPOSED POND SURFACES
2. APPLY BIO-FILTER SEED MIX AT RATE OF 5 LB/ 1000 SF
(HOBBS AND HOPKINS, PRO-TIME 710, BIO-FILTER MIX FOR WATER AND SHADY AREAS)

PR8820 PERRENIAL RYEGRASS	<i>LOLIUM PERENNE</i>	60.0%
CINDY CREEPING RED FESCUE	<i>FESTICA RUBRA</i>	"CINDY" 20.0%
REDTOP BENTGRASS	<i>AGROSTIS ALBA</i>	5.0%
HIGHLAND COLONIAL BENTGRASS	<i>AGROSTIS TENUIUS</i>	5.0%
SABRE ROUGH BLUEGRASS	<i>POA TRIVIALIS</i>	"SABRE" 5.0%
SHAMROCK CLOVER	<i>TRIFOLIUM DUBIUM</i>	5.0%

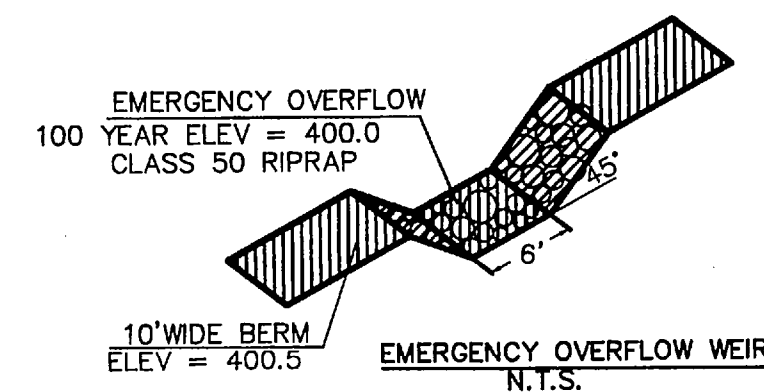



EMERGENCY OVERFLOW WEIR

SCALE: NTS

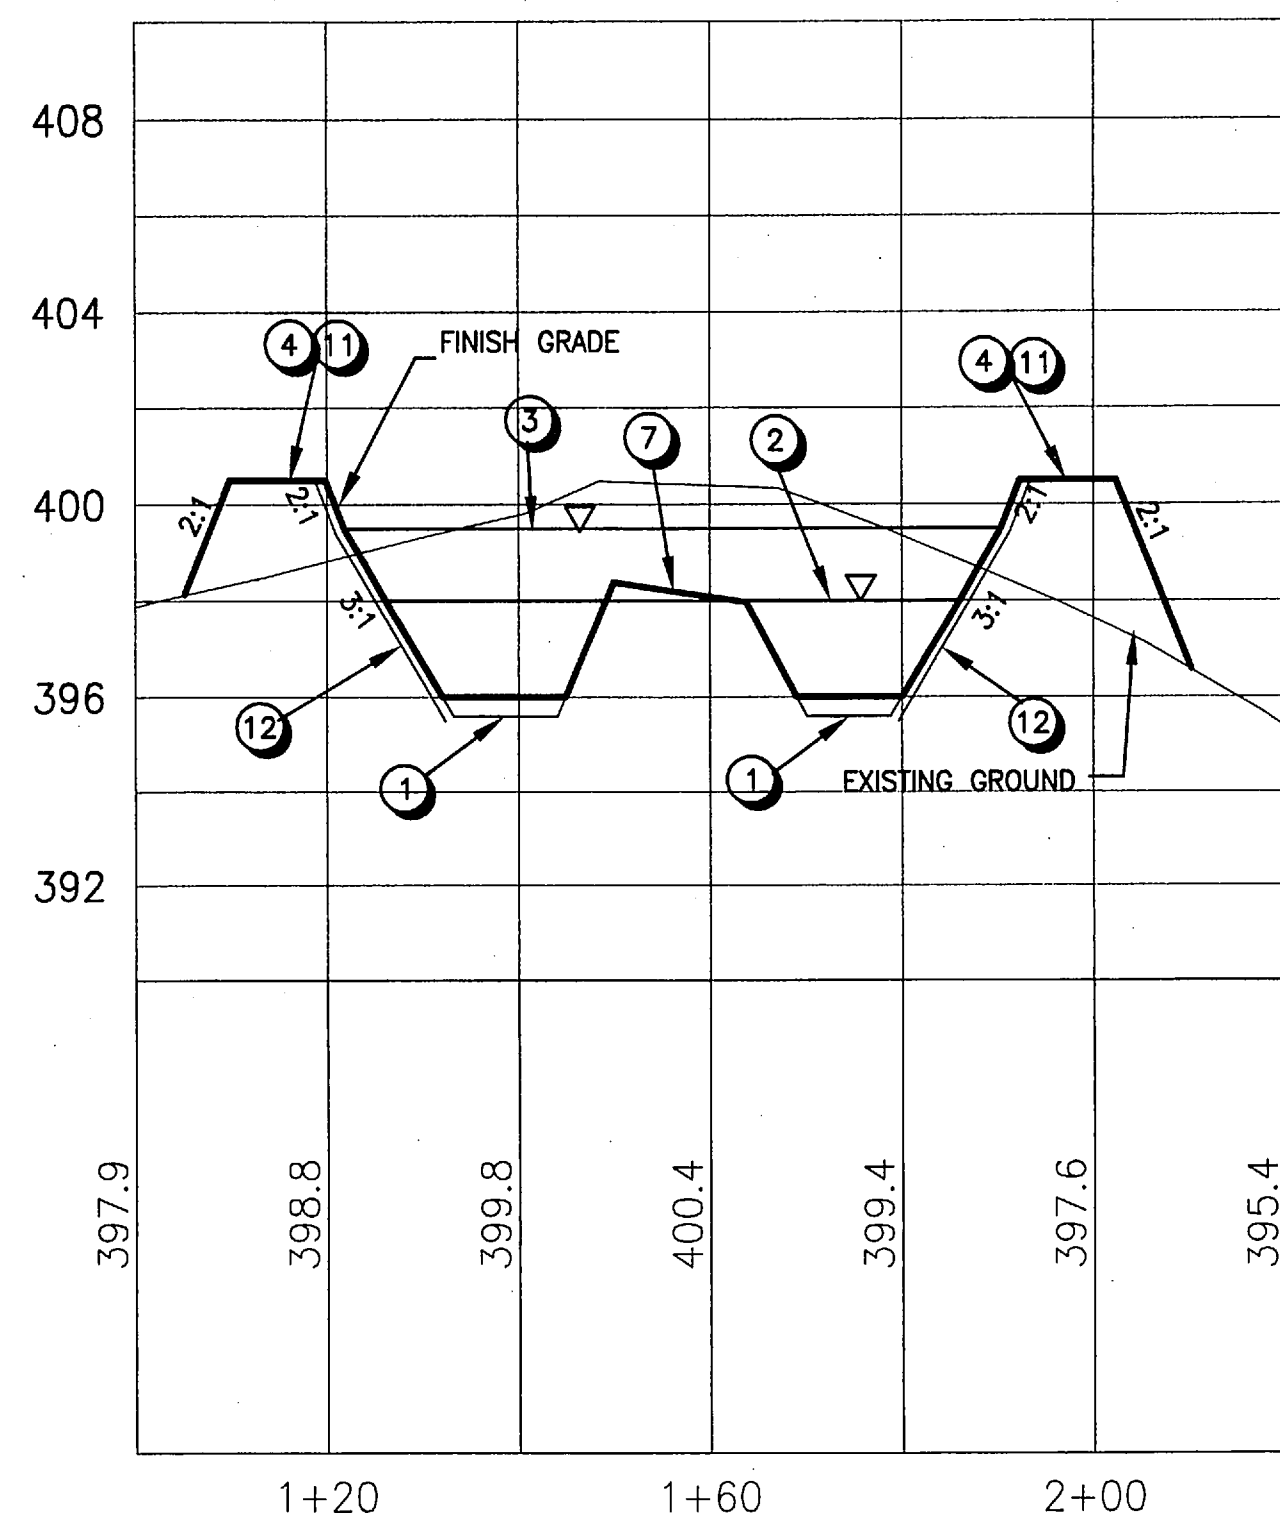


CROSS SECTION B-B

SCALE: $1''=20'H$
 $1''=2'V$

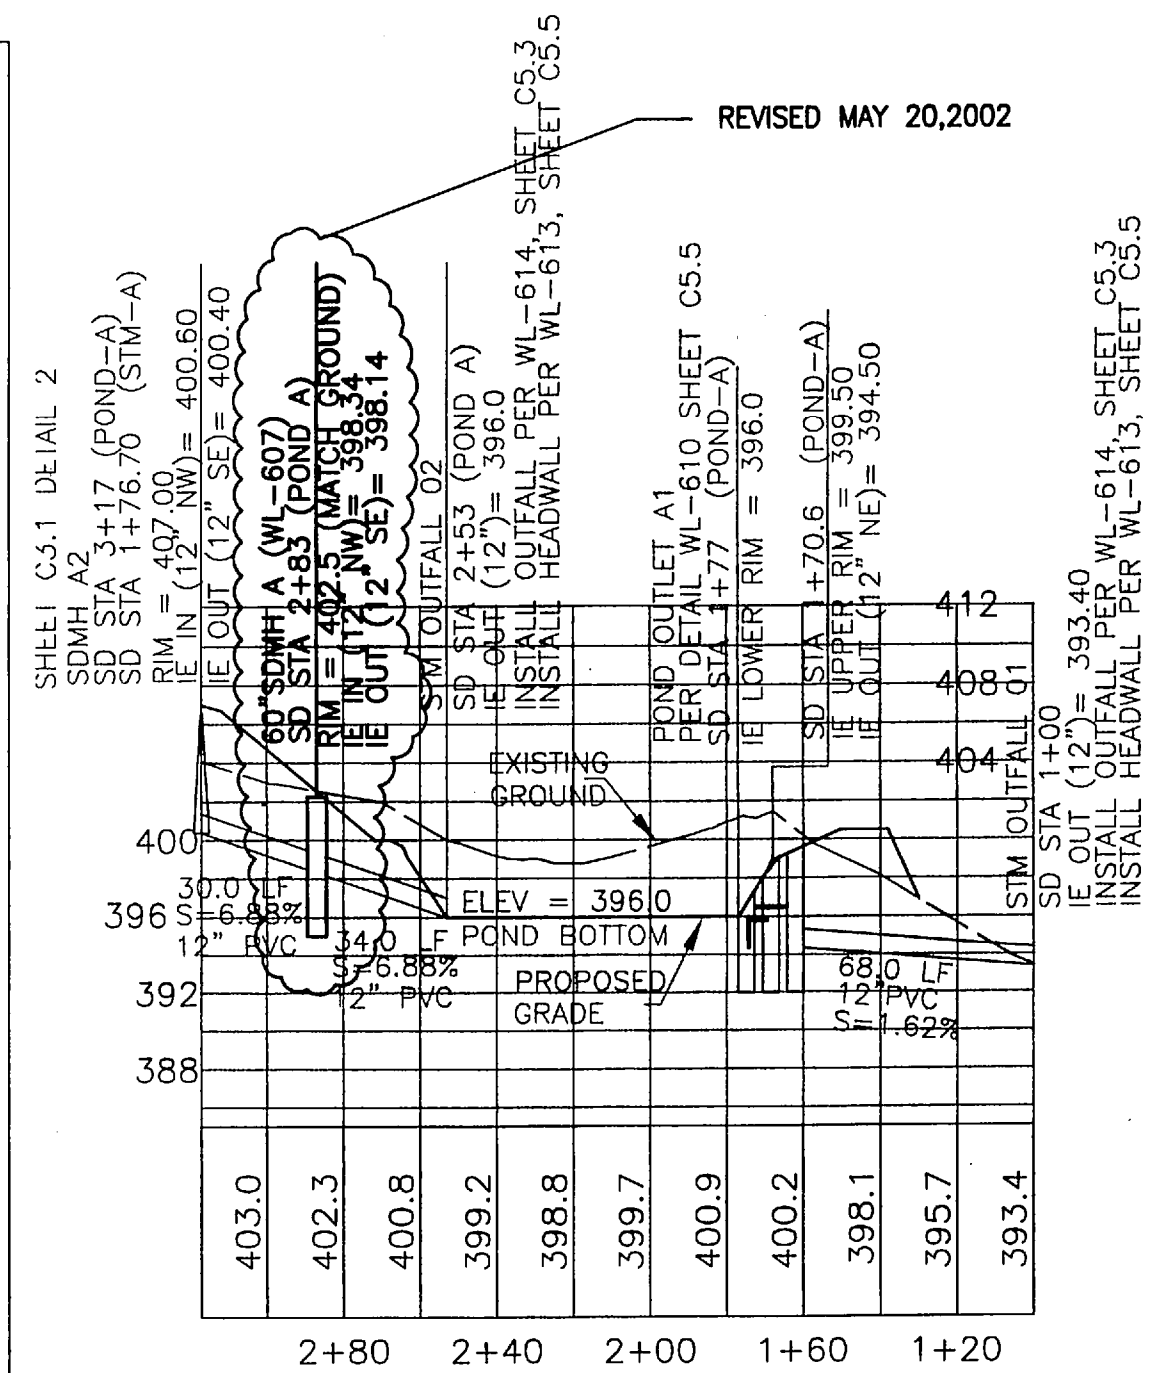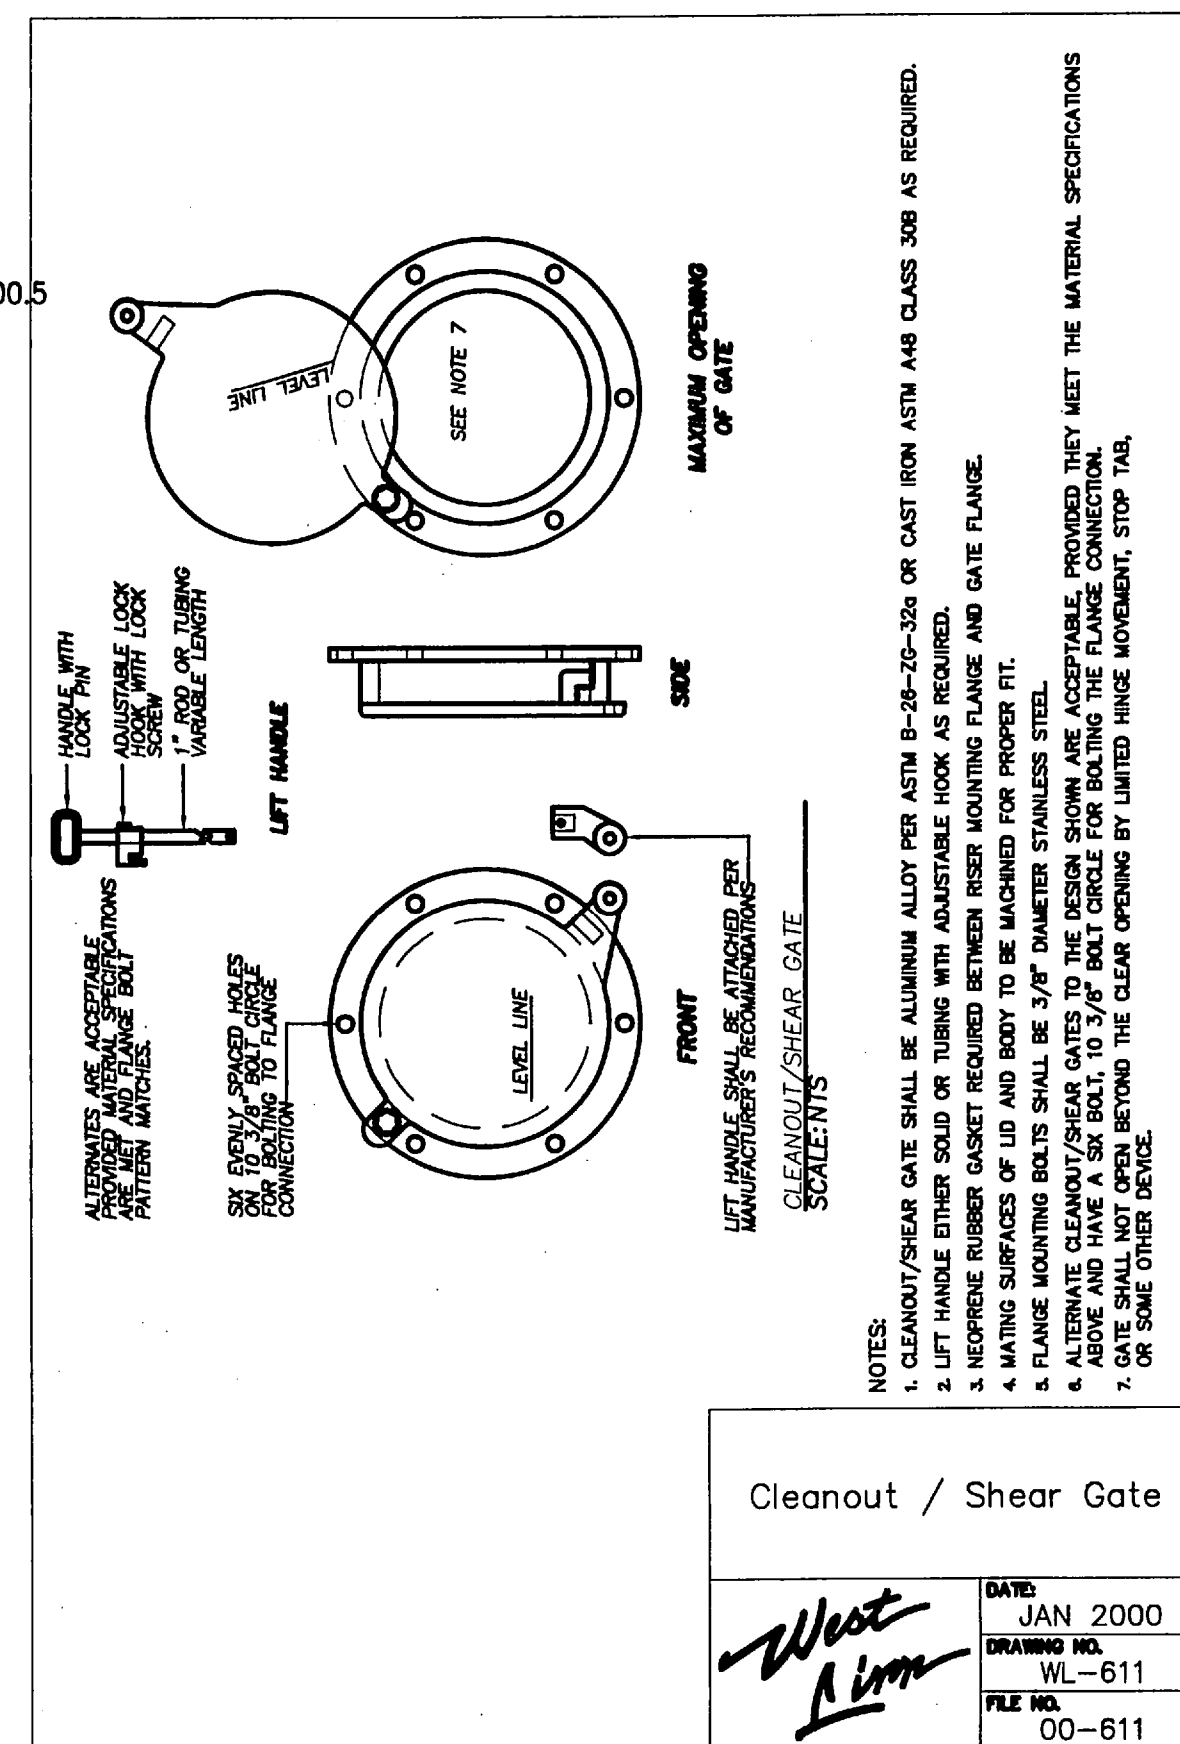

SD POND A PROFILE

SCALE: $1''=50'H$
 $1''=10'V$

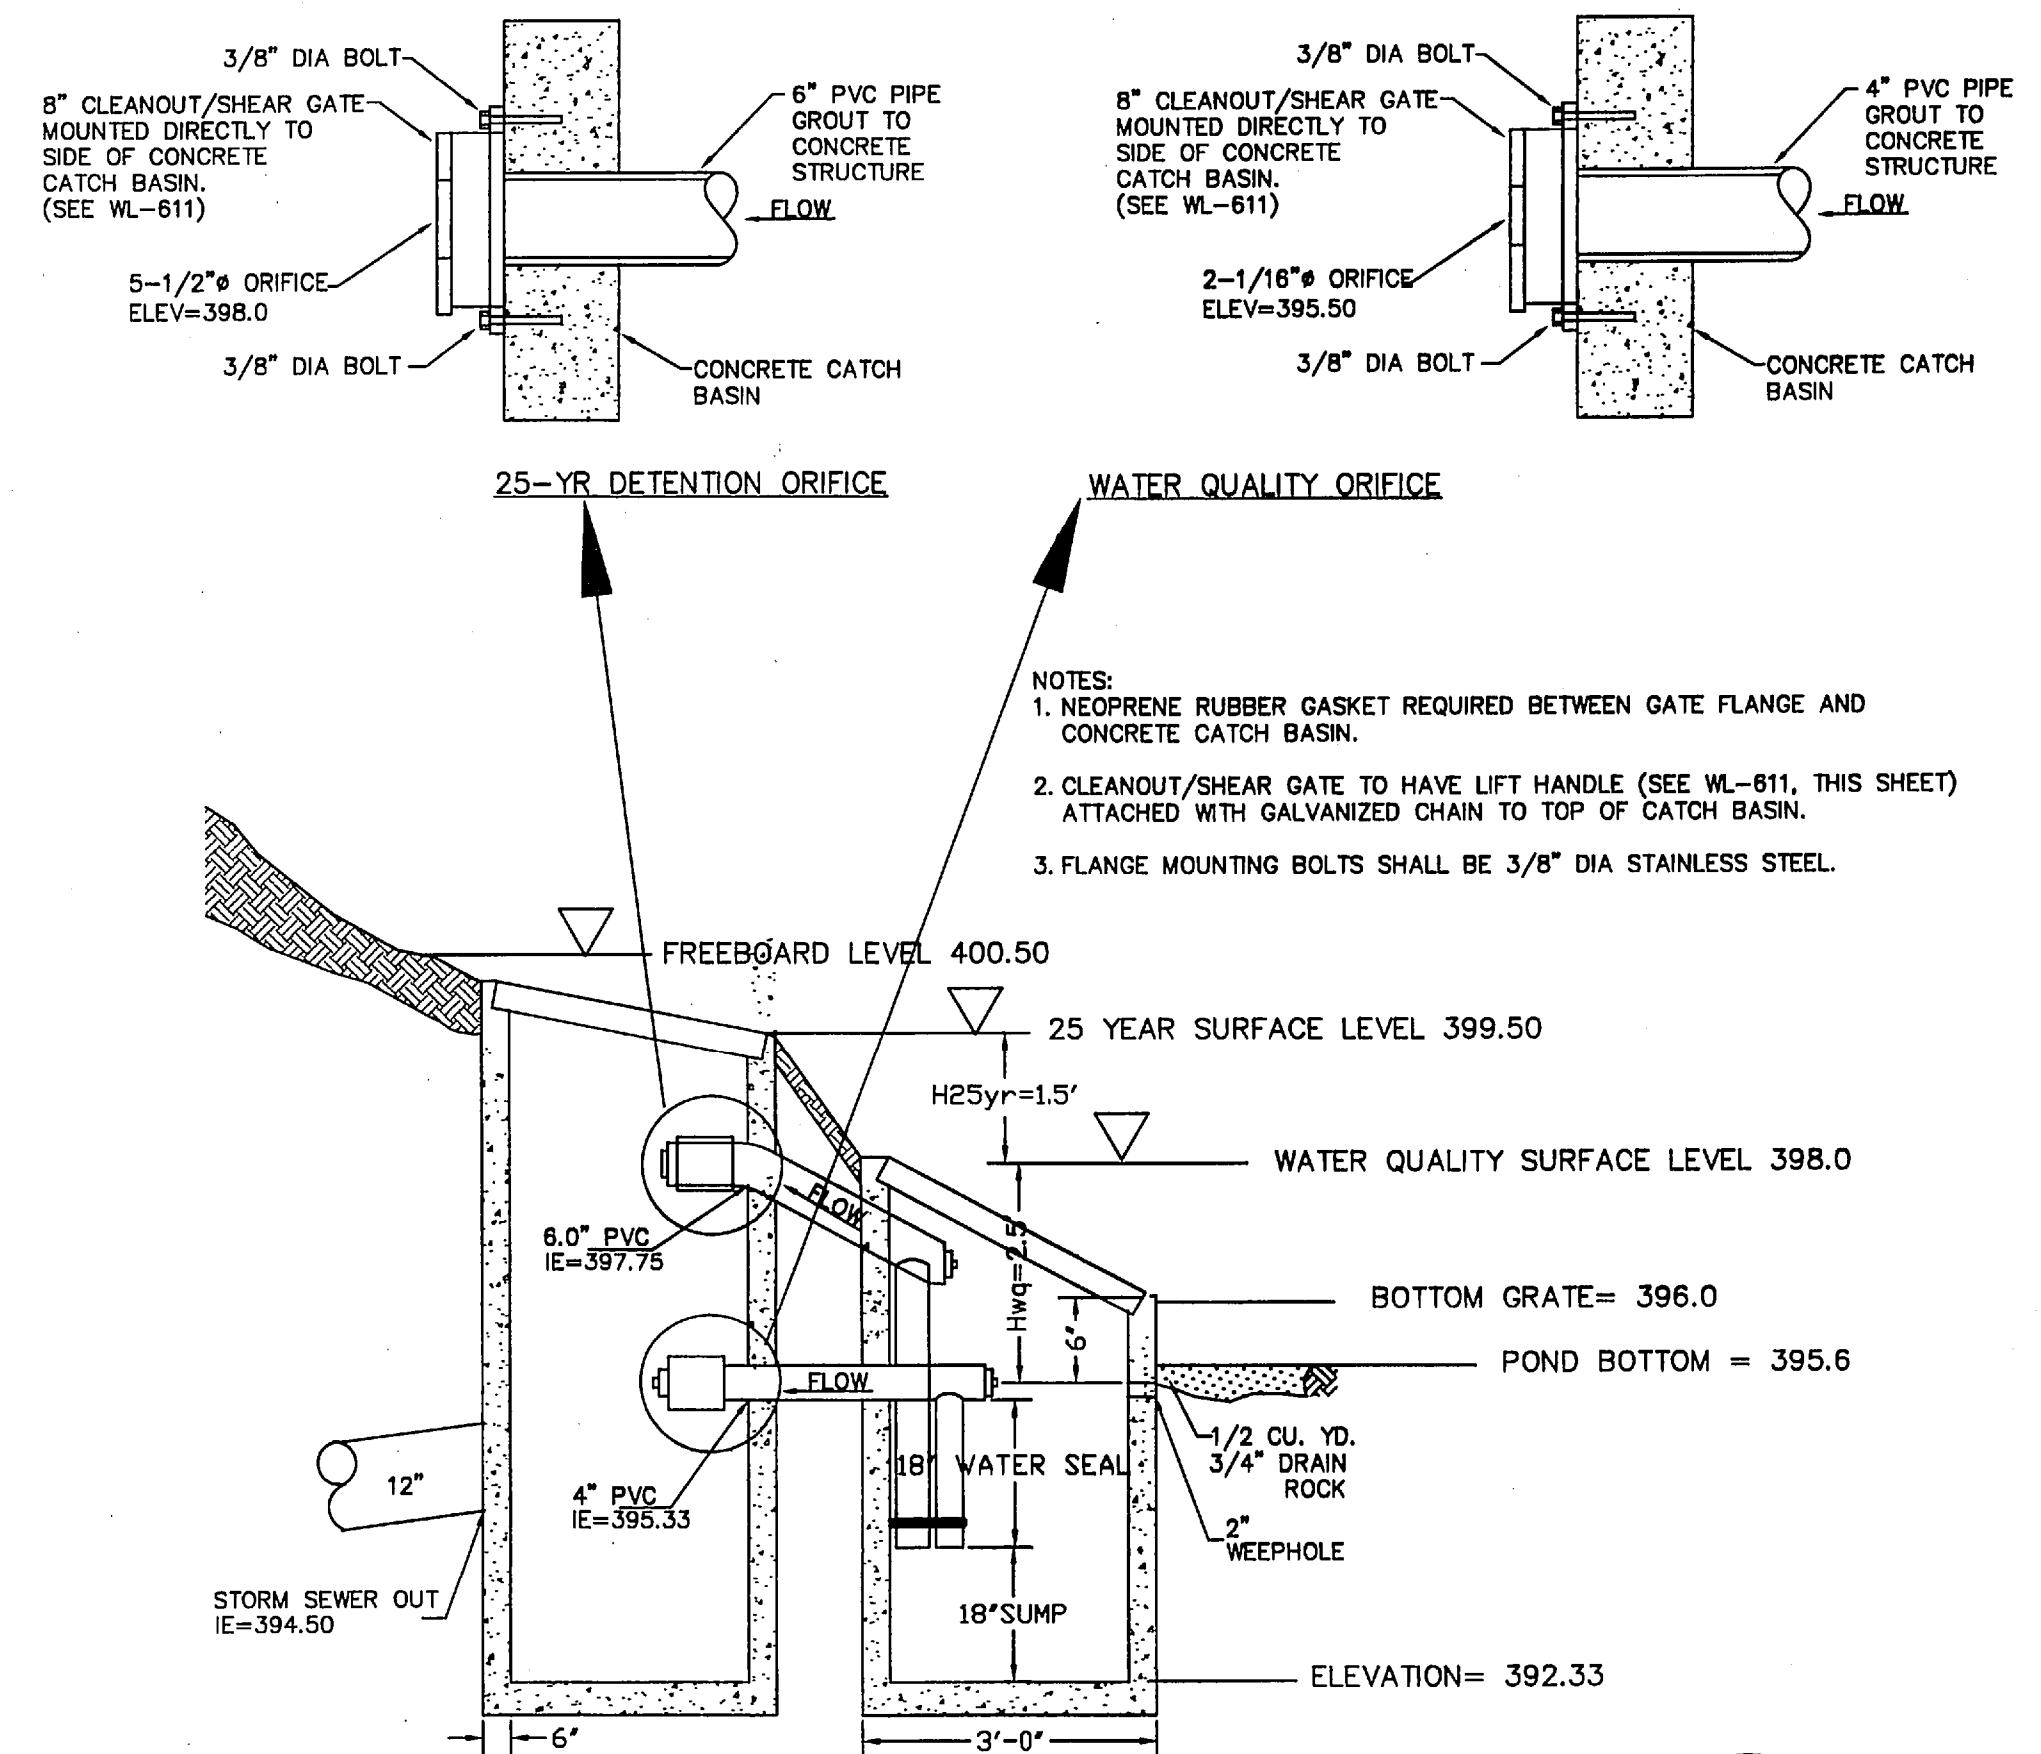

MODIFIED POND OUTLET (WL-610) # A1

SCALE: NTS

REVISÉ 11-13-01


08/21/2001

Date 11/11/11

Designed

AAH/BLW/JAH

Checked By Date

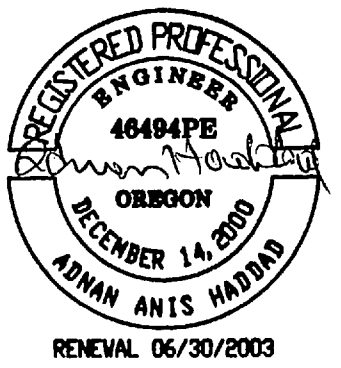

RENEWAL 06/30/2003

NORWAY DEVELOPMENT
P.O.Box 387

**P.O.Box 387
Oregon City, Oregon 97045
PHONE: (503) 656-7000
FAX: (503) 656-0686**

Tanner's Stonegate

CITY OF WEST LINN, OREGON

DETENTION FACILITY PLAN AND PROFILES



Incorporated

17355 SW Boones Ferry Road
Lake Oswego, OR 97035-5217
Phone: (503) 835-3618
FAX: (503) 835-5395

10579

Project No.

D579C3-4A

File No.



C3.4A

Sheet No.

Copyright 2001 ©


ADNANH 11/11/02 8:59am --> R:\DWG\DWG\579C3-4A.DWG

XREF LIST
Ltscale: 1
Resolved
D579X001
D579X190
D579X230
D579X400
D579X430
D579X600

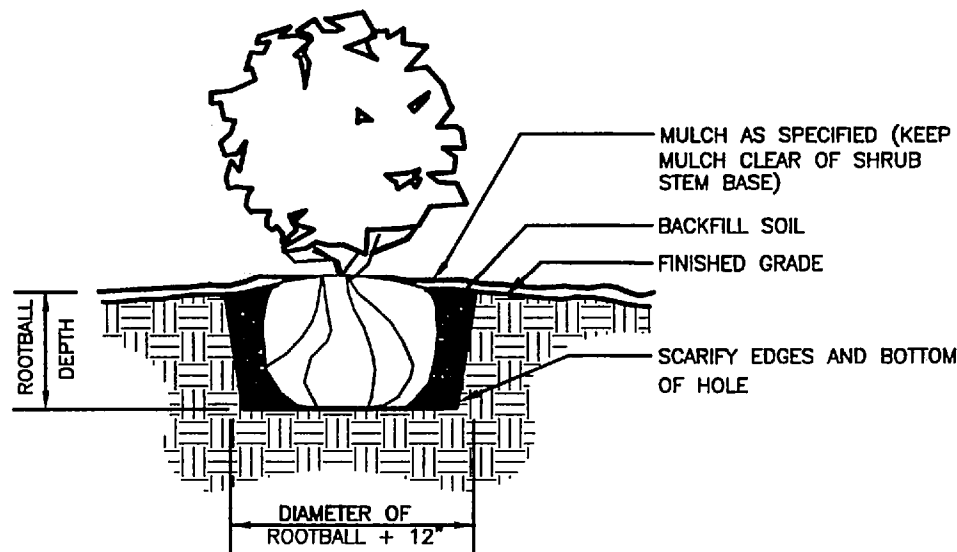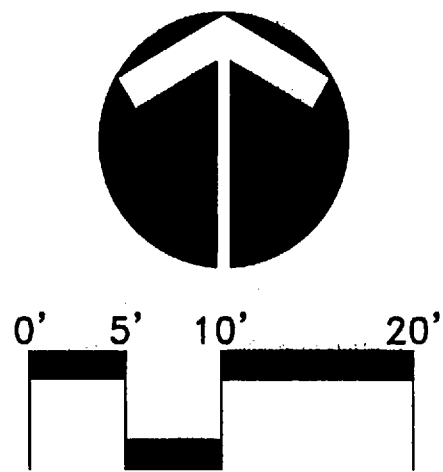

1 SHRUB PLANTING DETAIL
NOT TO SCALE

NOTE: STAKE ALL EVERGREEN TREES 8' AND SHORTER AND DECIDUOUS TREES LESS THAN 4' CALIPER. DO NOT STAKE VINE MAPLES. TREES 1 1/2' CALIPER AND LESS SHALL BE STAKED WITH A SINGLE WOOD STAKE UNLESS OTHERWISE SPECIFIED.

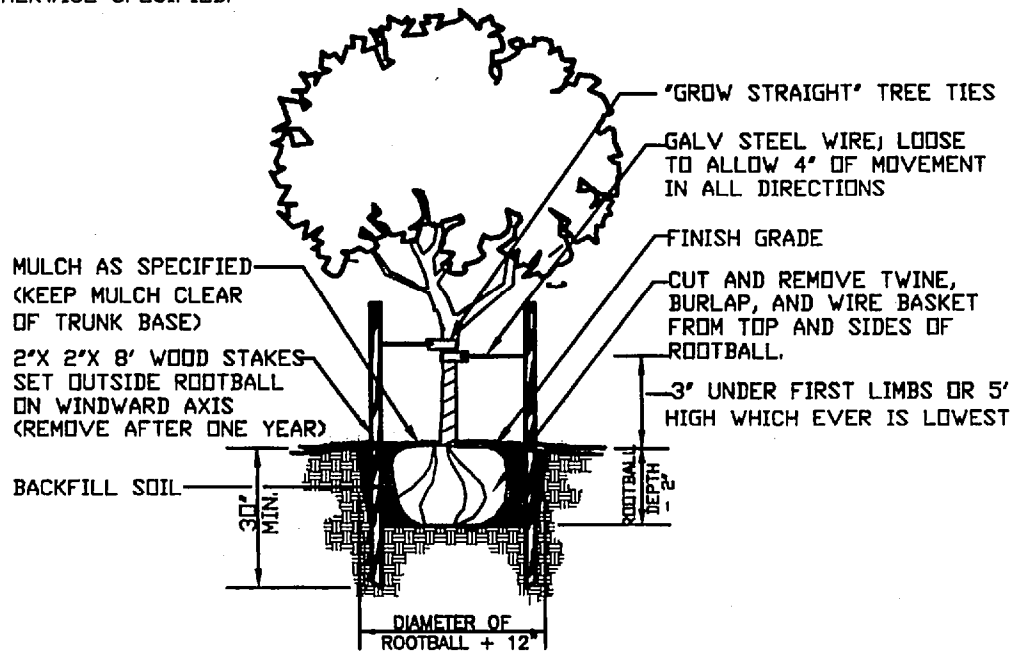


2 TREE STAKING DETAIL
NOT TO SCALE

PLANT LIST FOR POND AREA:

SYMBOL	COMMON/BOTANICAL NAMES, SIZE AND CONDITION
4	DOUGLAS FIR / PSEUDOTSUGA MENZIESII 6' TALL AND 12' TALL, B&B
5	THUJA PLICATA / WESTERN RED CEDAR 7-8' TALL
50	RED OSIER DOGWOOD / CORNUS STOLONIFERA 15" TO 18", CONTAINER/B&B
1	DOUGLAS HAWTHORN / CRATAEGUS DOUGLASII 5' TO 6' TALL, BRANCHED
30	WESTERN SPIRAEA / SPIRAEA DOUGLASII 15" TO 18" CONTAINER
131	RED FLOWERING CURRANT / RIBES SANQUINEUM 15" TO 18", CONTAINER
77	OREGON GRAPE / MAHONIA AQUIFOLIUM 15" TO 18", CONTAINER
1	OREGON ASH / FRAXINUS LATIFOLIA 6' - 8' TALL, B&B


PLANTING NOTES FOR POND AREA

- USE PRO-TIME 710 FOR THE SEED MIX IN WATER QUALITY AREA (398 LEVEL) OF THE POND.

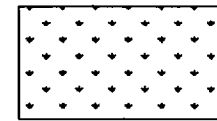


ABOVE THE WATER QUALITY ELEVATION APPLY BIO-FILTER SEED MIX AT RATE OF 5 LB/ 1000 SF:

PR8820 PERENNIAL RYEGRASS LOLIUM PERENNE 60.0%
CINDY CREEPING RED FESCUE FESTICA RUBRA "CINDY" 20.0%
REDTOP BENTGRASS AGROSTIS ALBA 5.0%
HIGHLAND COLONIAL BENTGRASS AGROSTIS TENIUS 5.0%
SABRE ROUGH BLUEGRASS POA TRIVIALIS "SABRE" 5.0%
SHAMROCK CLOVER TRIFOLIUM DUBIUM 5.0%

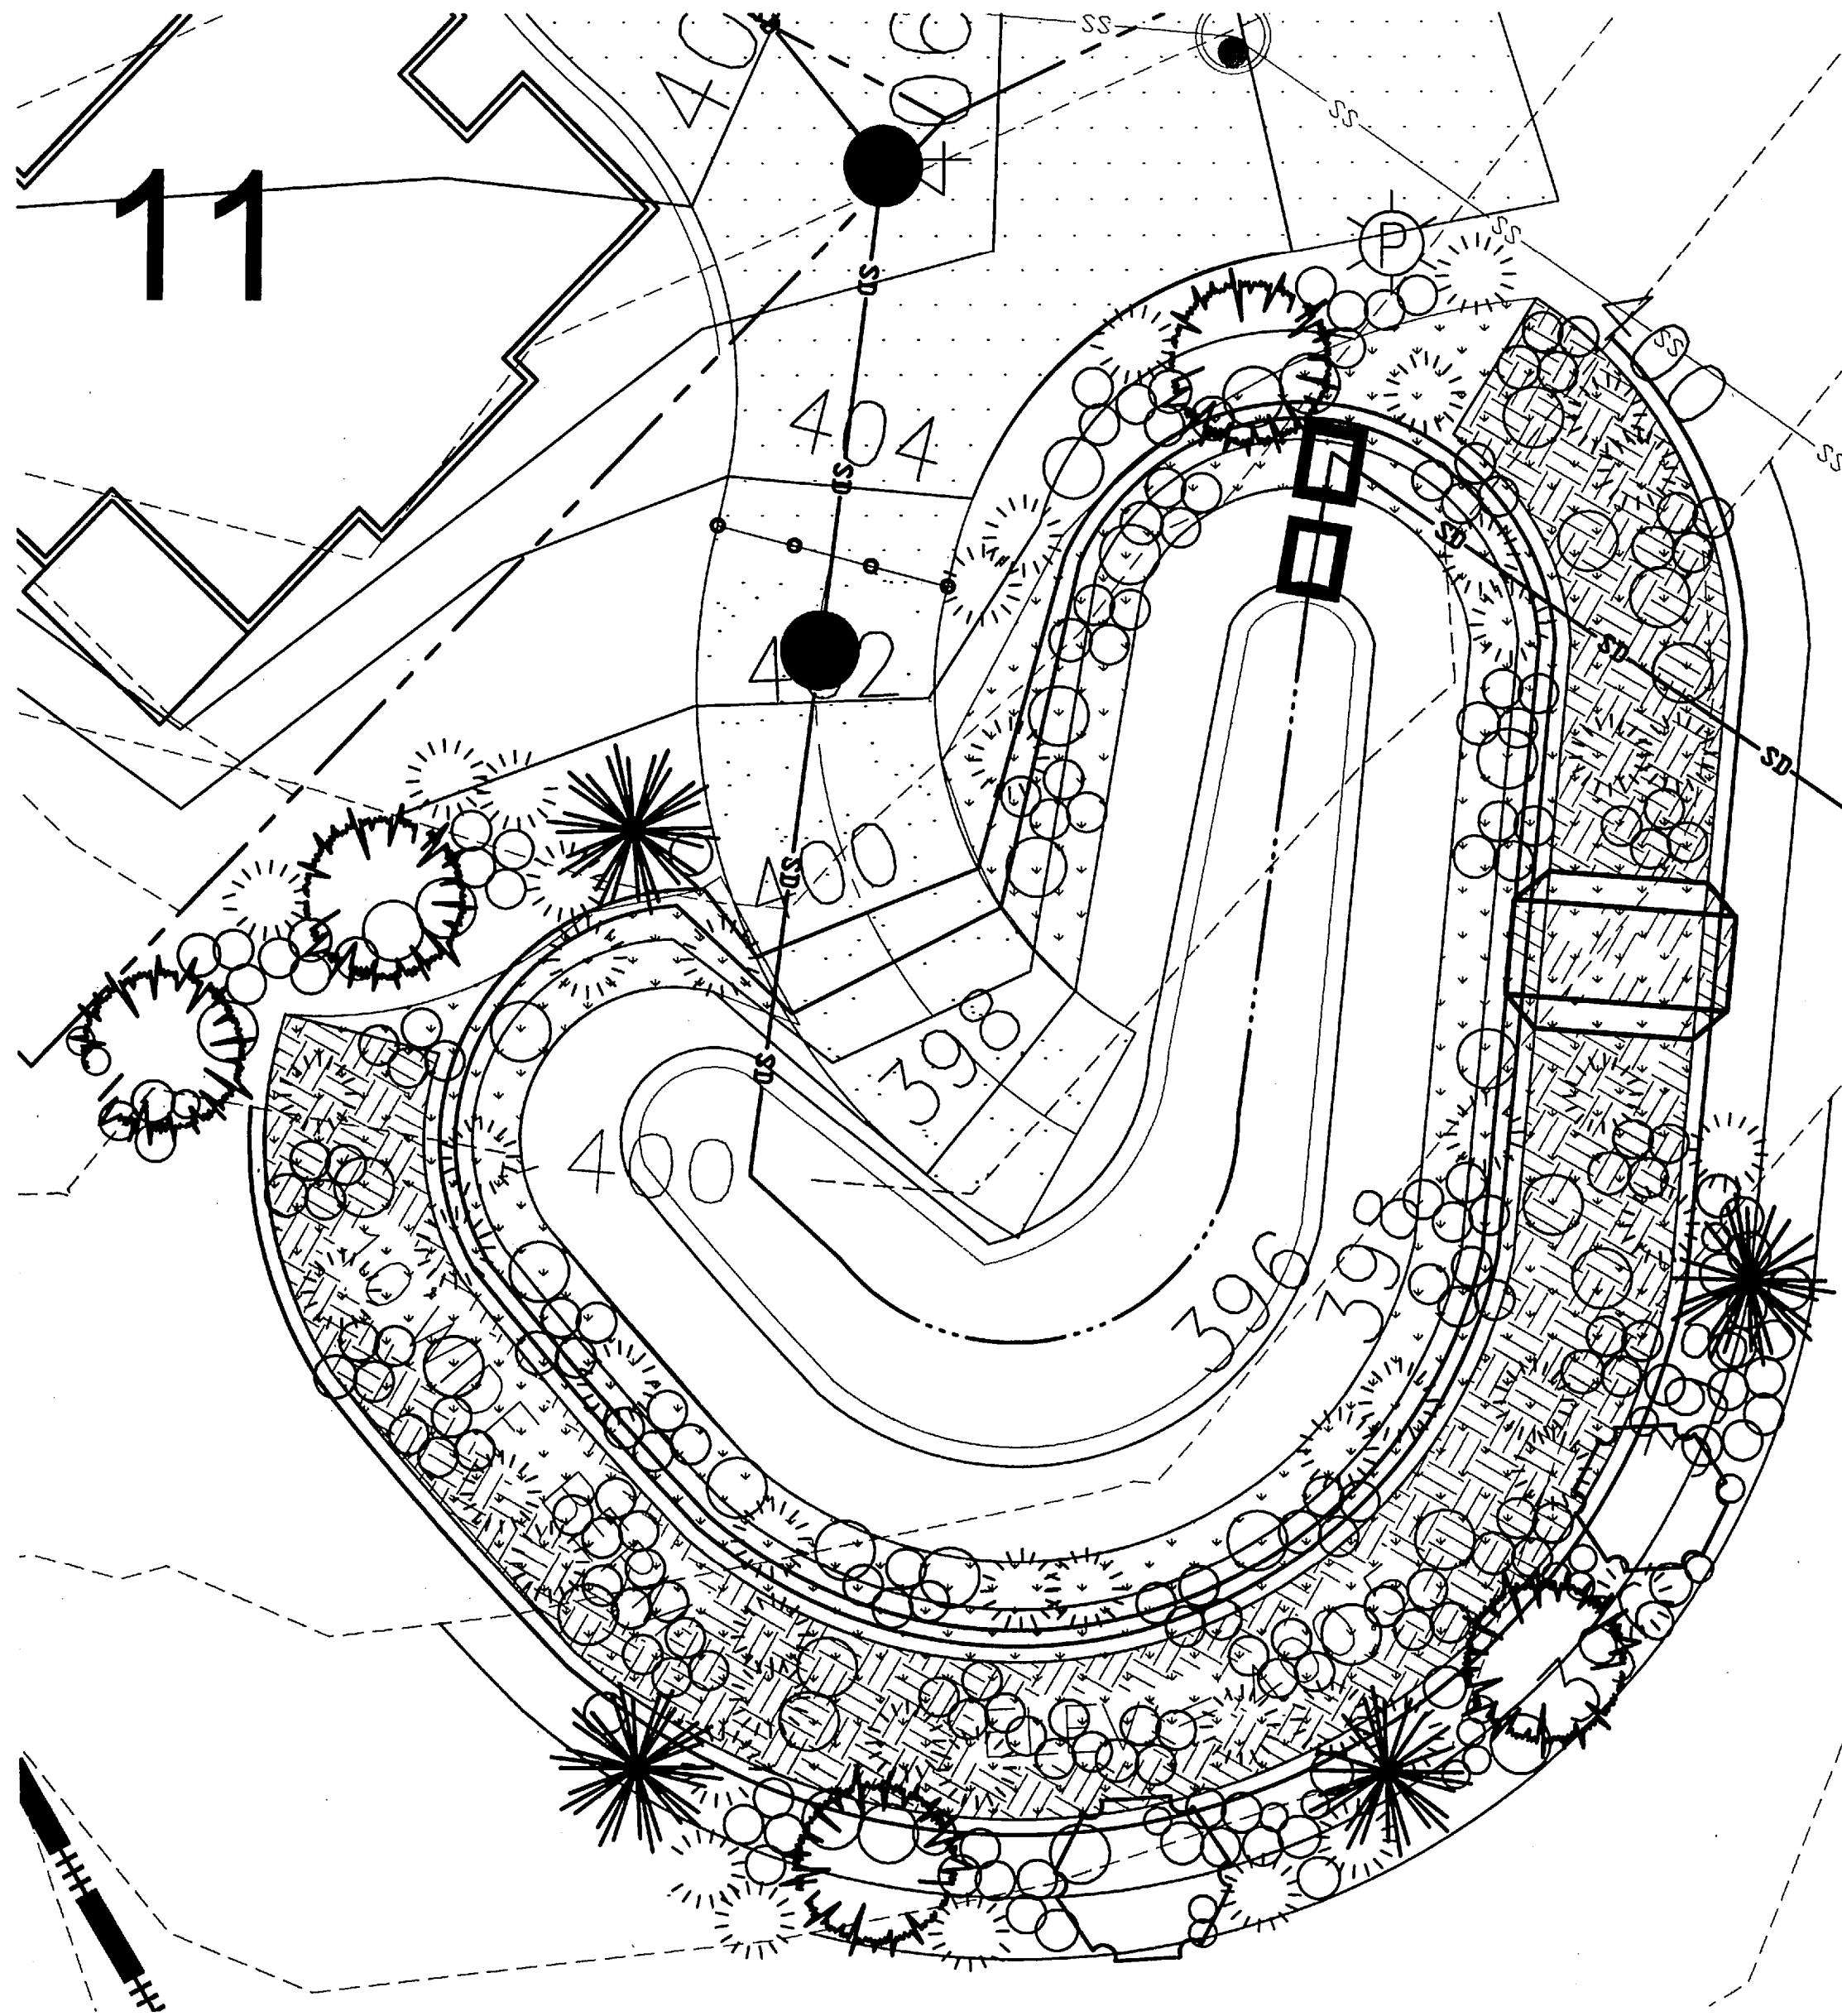


PLANTING LIST FOR TEMPORARY CREEK CHANNEL:

COMMON NAME	SCIENTIFIC NAME	CONTAINER SIZE	SPACING	QUANTITY	SYMBOL
BLACK COTTONWOOD	POPULUS TRICHOCARPE	2 TO 5 GAL	25 FT	20 EACH	PT
RED ALDER	ALNUS RUBRE	2 TO 5 GAL	25 FT	20 EACH	AR
BIGLEAF MAPLE	ACAR MACROPHYLLUM	2 TO 5 GAL	20 FT	10 EACH	AM
PACIFIC WILLOW	SALIX LASIANDRA	CUTTINGS	5 FT	20 EACH	SL
PIPER'S WILLOW	SALIX PIPERLI	CUTTINGS	5 FT	40 EACH	SP
BEAKED HAZELNUT	CORYLUS CORNUTA	1 TO 2 GAL	20 FT	30 EACH	CC

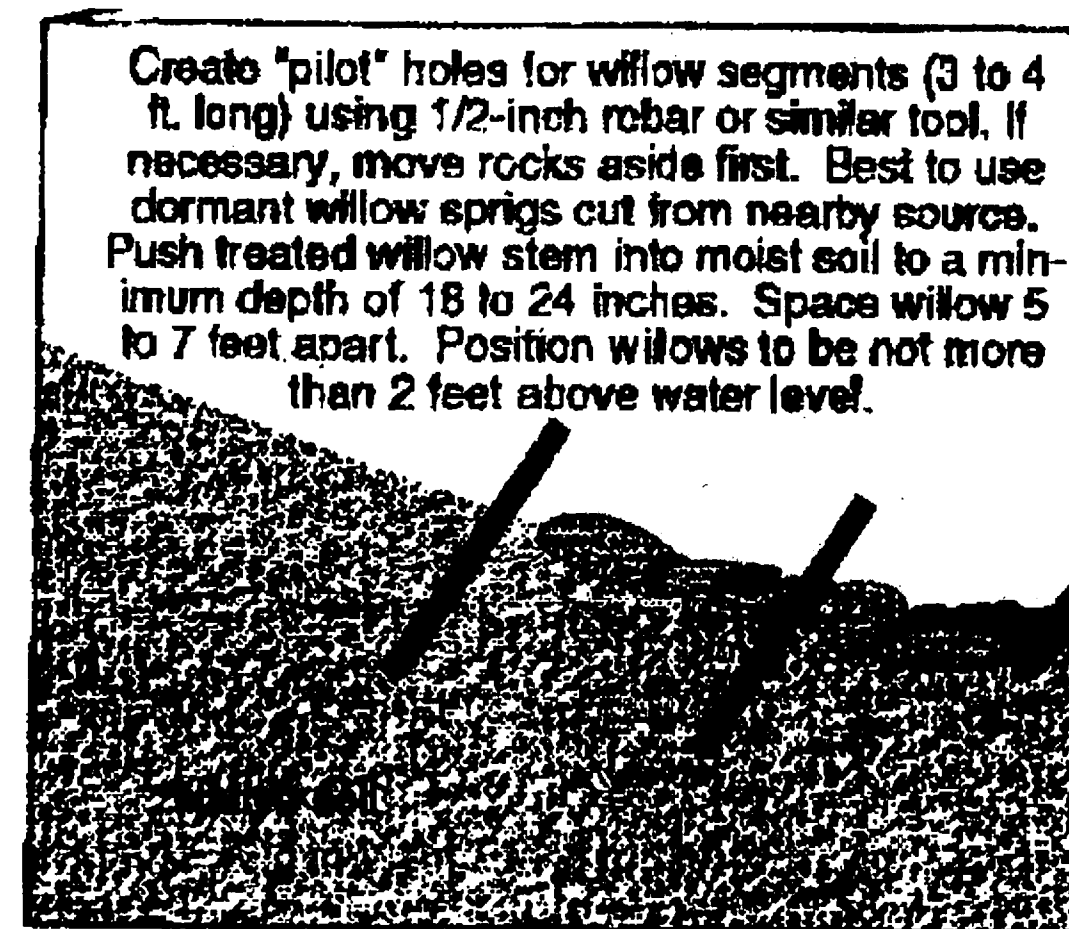

TYPICAL WILLOW STAKING DETAIL

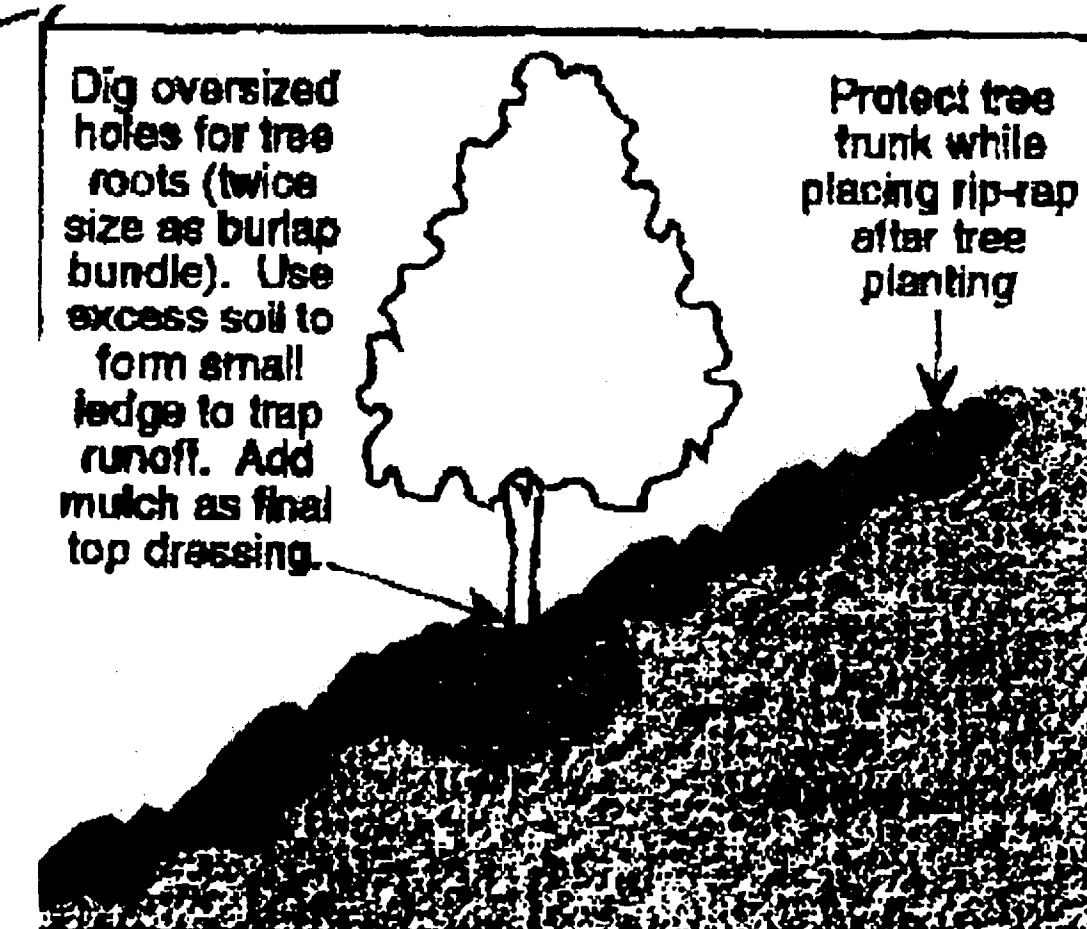

TYPICAL JOINT PLANTING DETAIL

GENERAL PLANTING NOTES:

ALL PLANTING AREAS WILL BE WATERED UNTIL THE PLANTS HAVE ESTABLISHED.

PLANTING POCKET BACKFILL WILL INCLUDE 25% LEAF COMPOST MIXED WITH NATIVE TOPSOIL.

ALL PLANTING AREAS WILL BE TOP-DRESSED WITH A 2" LAYER OF MEDIUM BARK MULCH.

WHEN PLANTING PROVIDE IDENTIFICATION OF PLANTING SPECIES.

08/21/2001

Date

AAH/BLW/JAH

Designed

AAH/BLW/JAH

Drawn

Checked By

Date

REVISIONS

APPD.

BY

DATE

NO.

RENEWAL 06/30/2003

RENEWAL 06/30/2003



RENEWAL 06/30/2003

RENEWAL 06/30/2003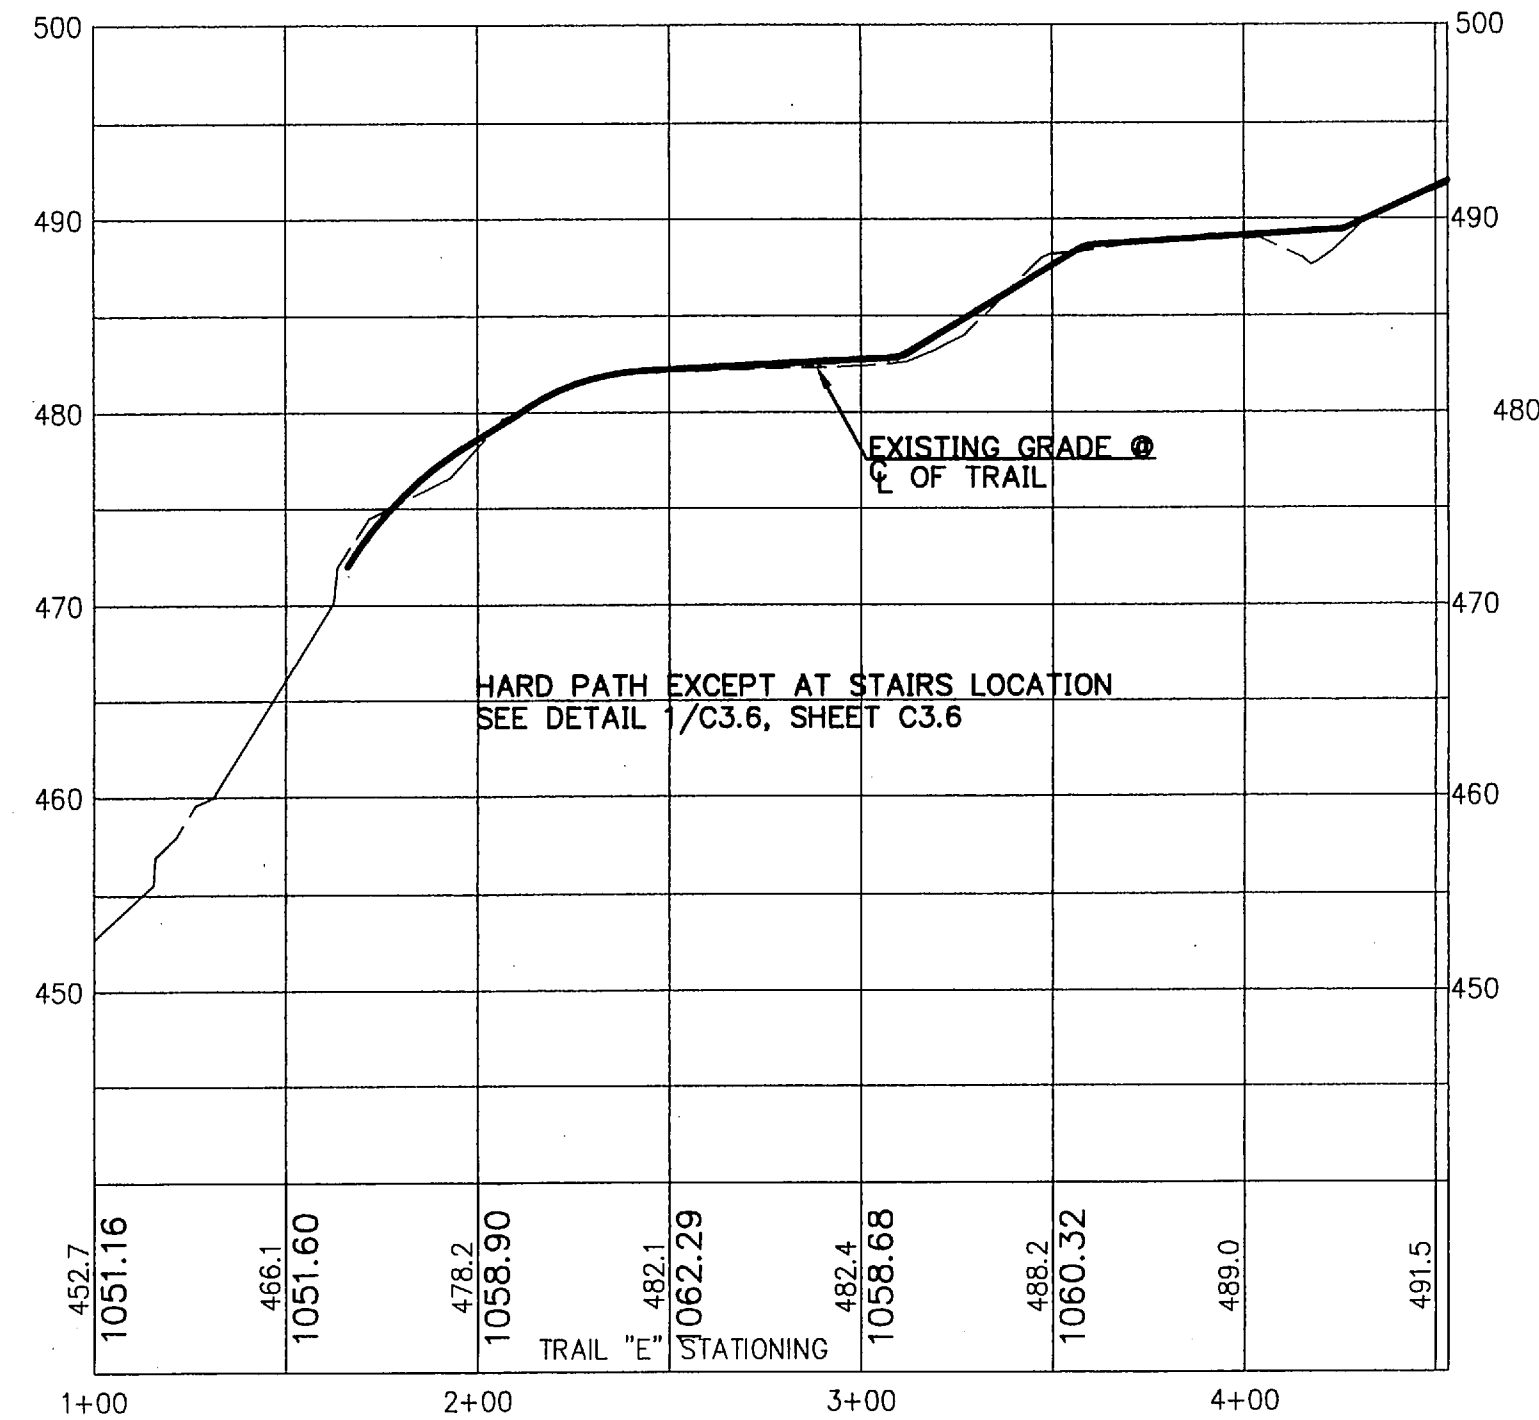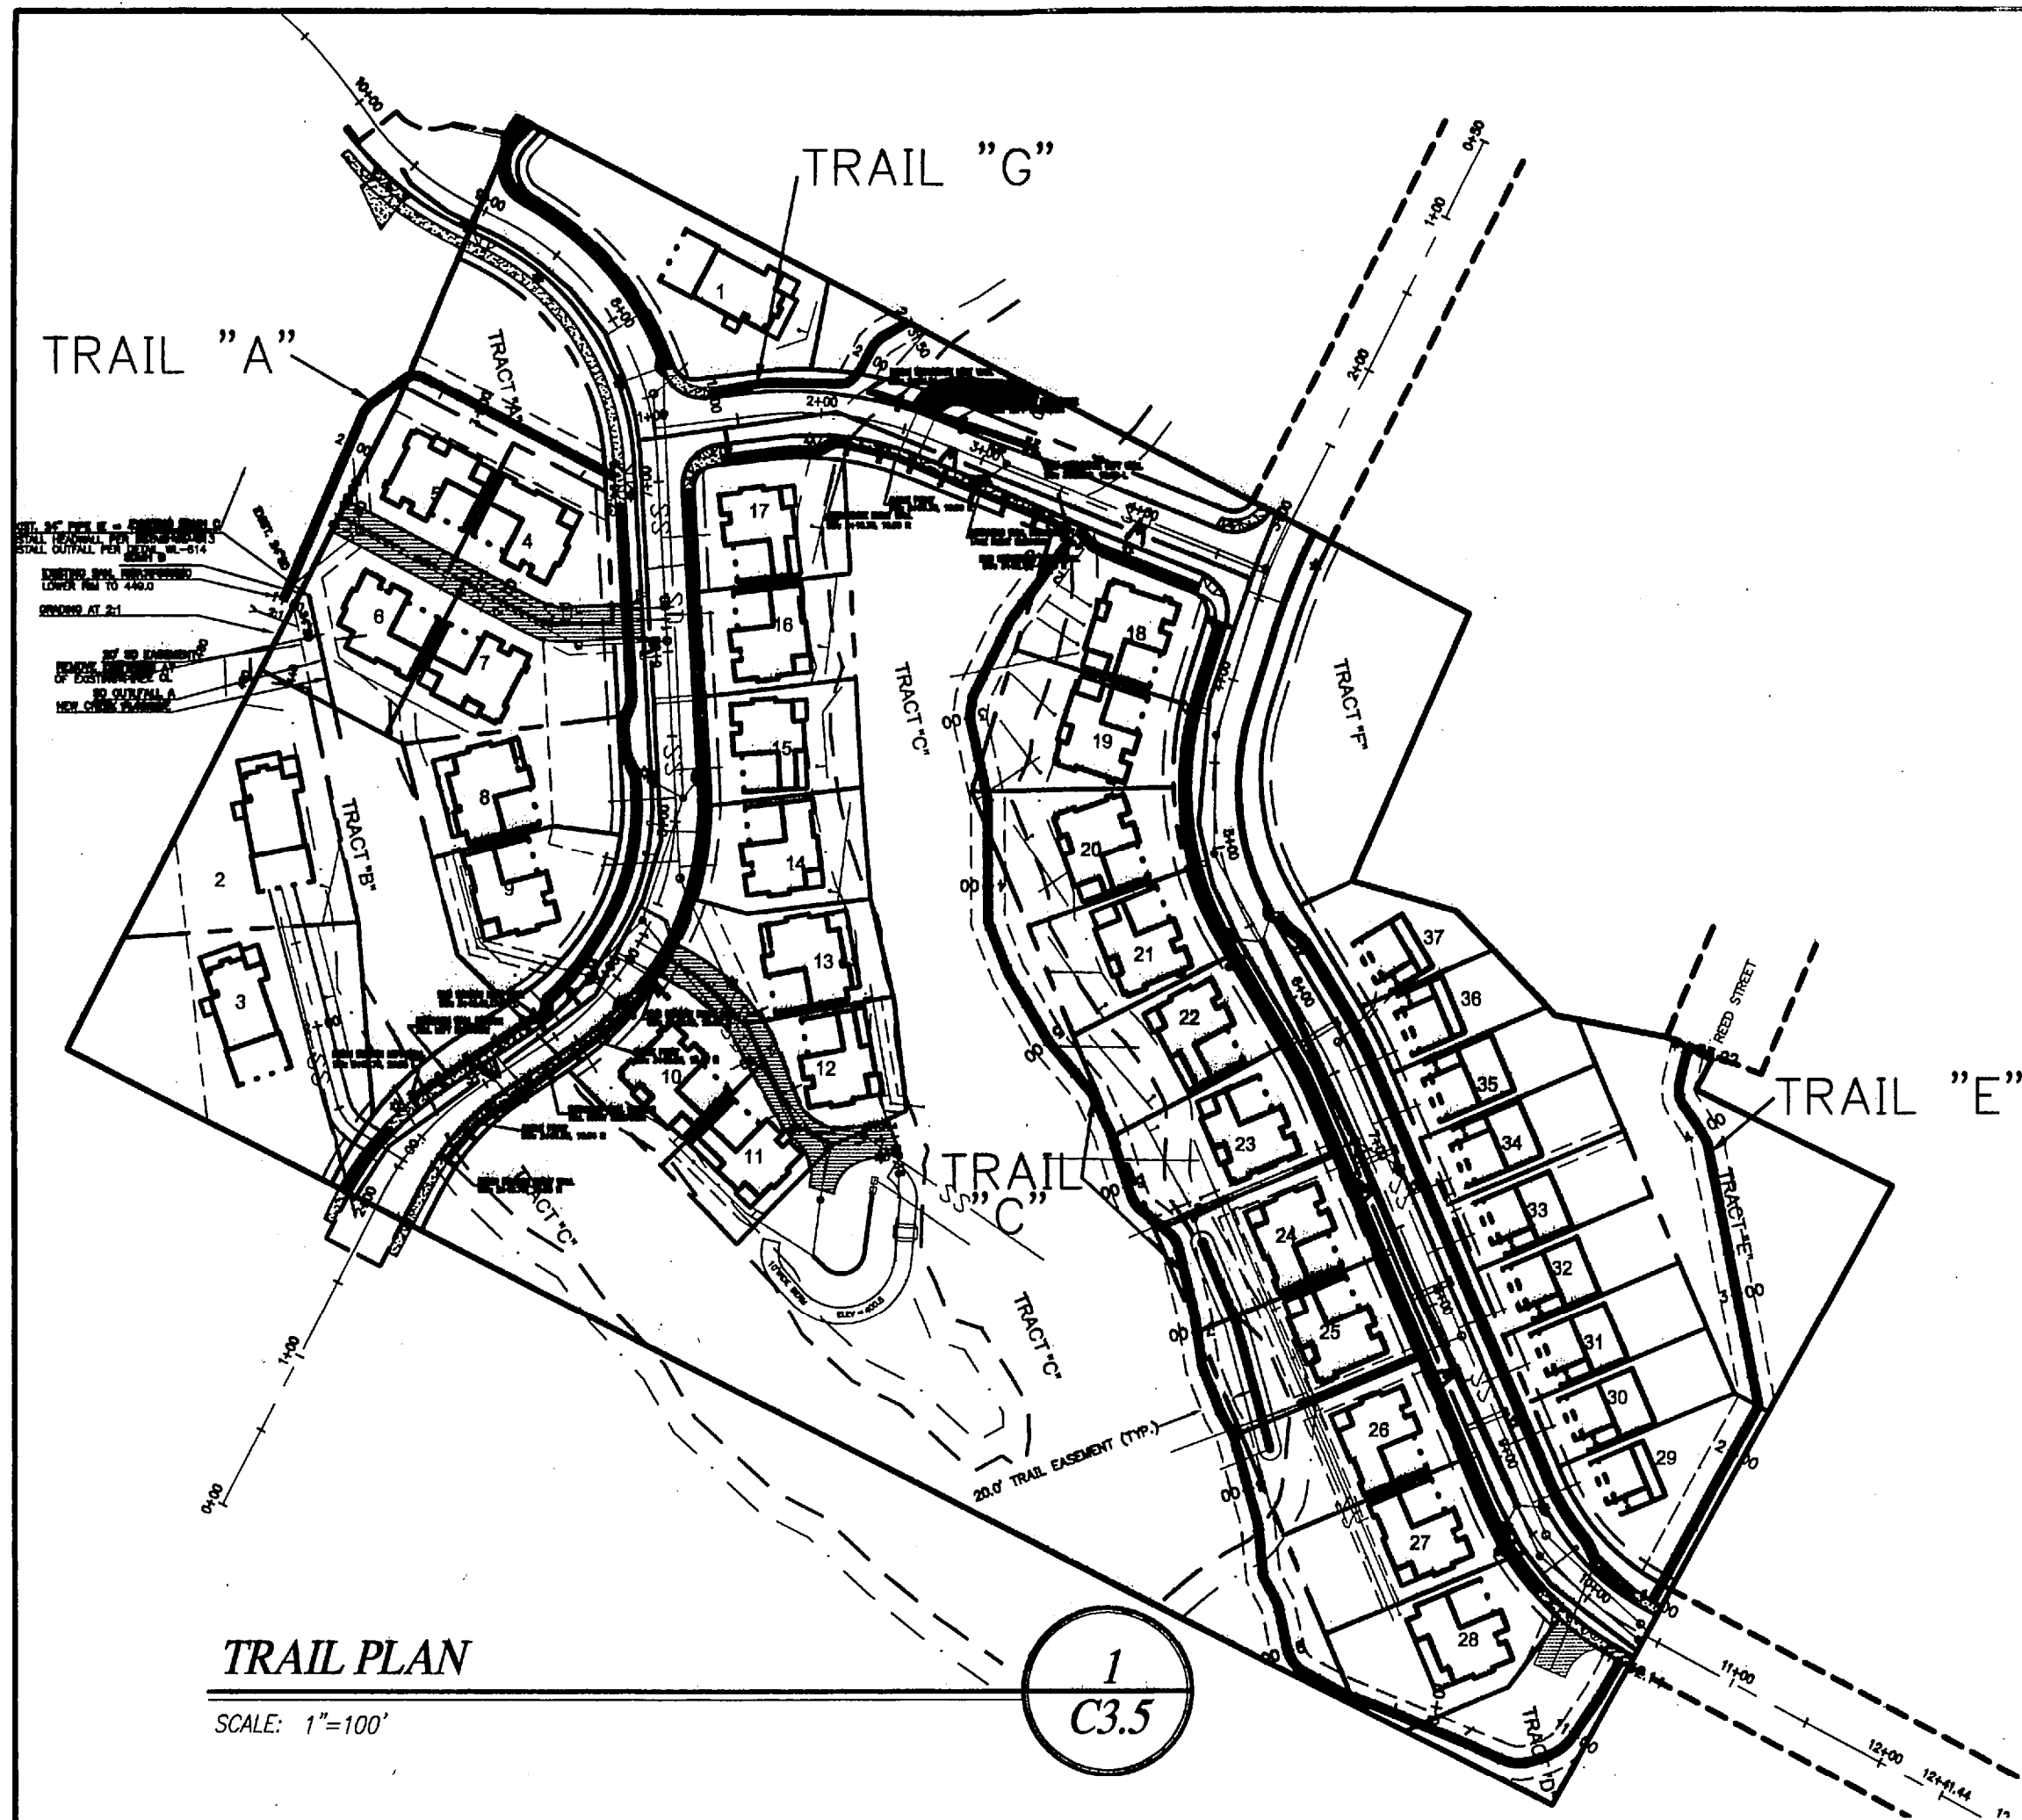

TRAIL "E" PROFILE

SCALE: 1"=50' HORIZ.
1"=10' VERT.

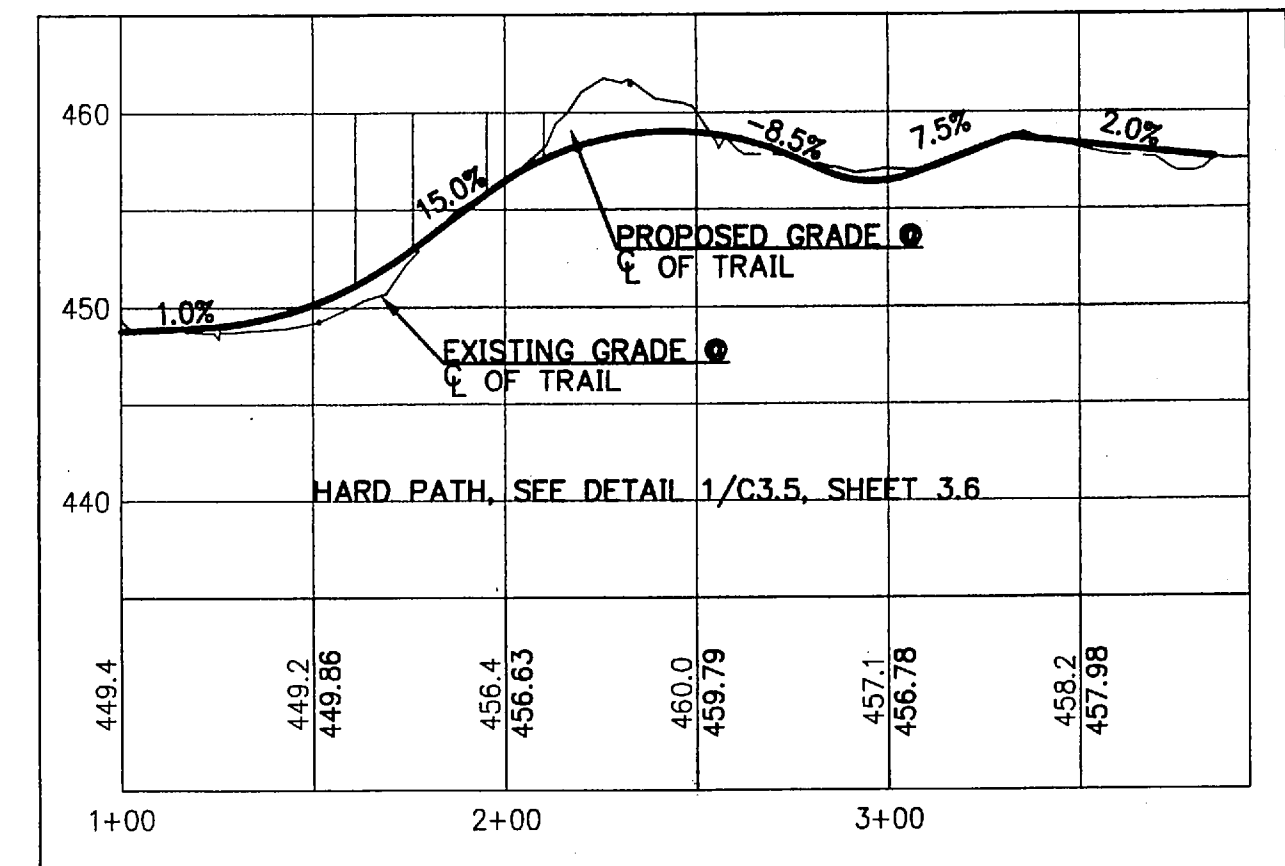


TRAIL "A" PROFILE

SCALE: 1"=50' HORIZ.
1"=10' VERT.

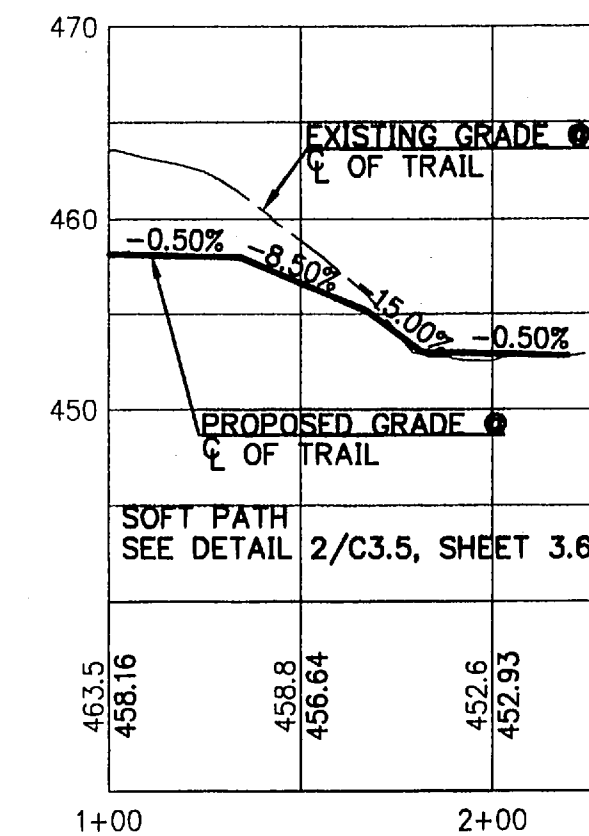

TRAIL "G" PROFILE

SCALE: 1"=50' HORIZ.
1"=10' VERT.

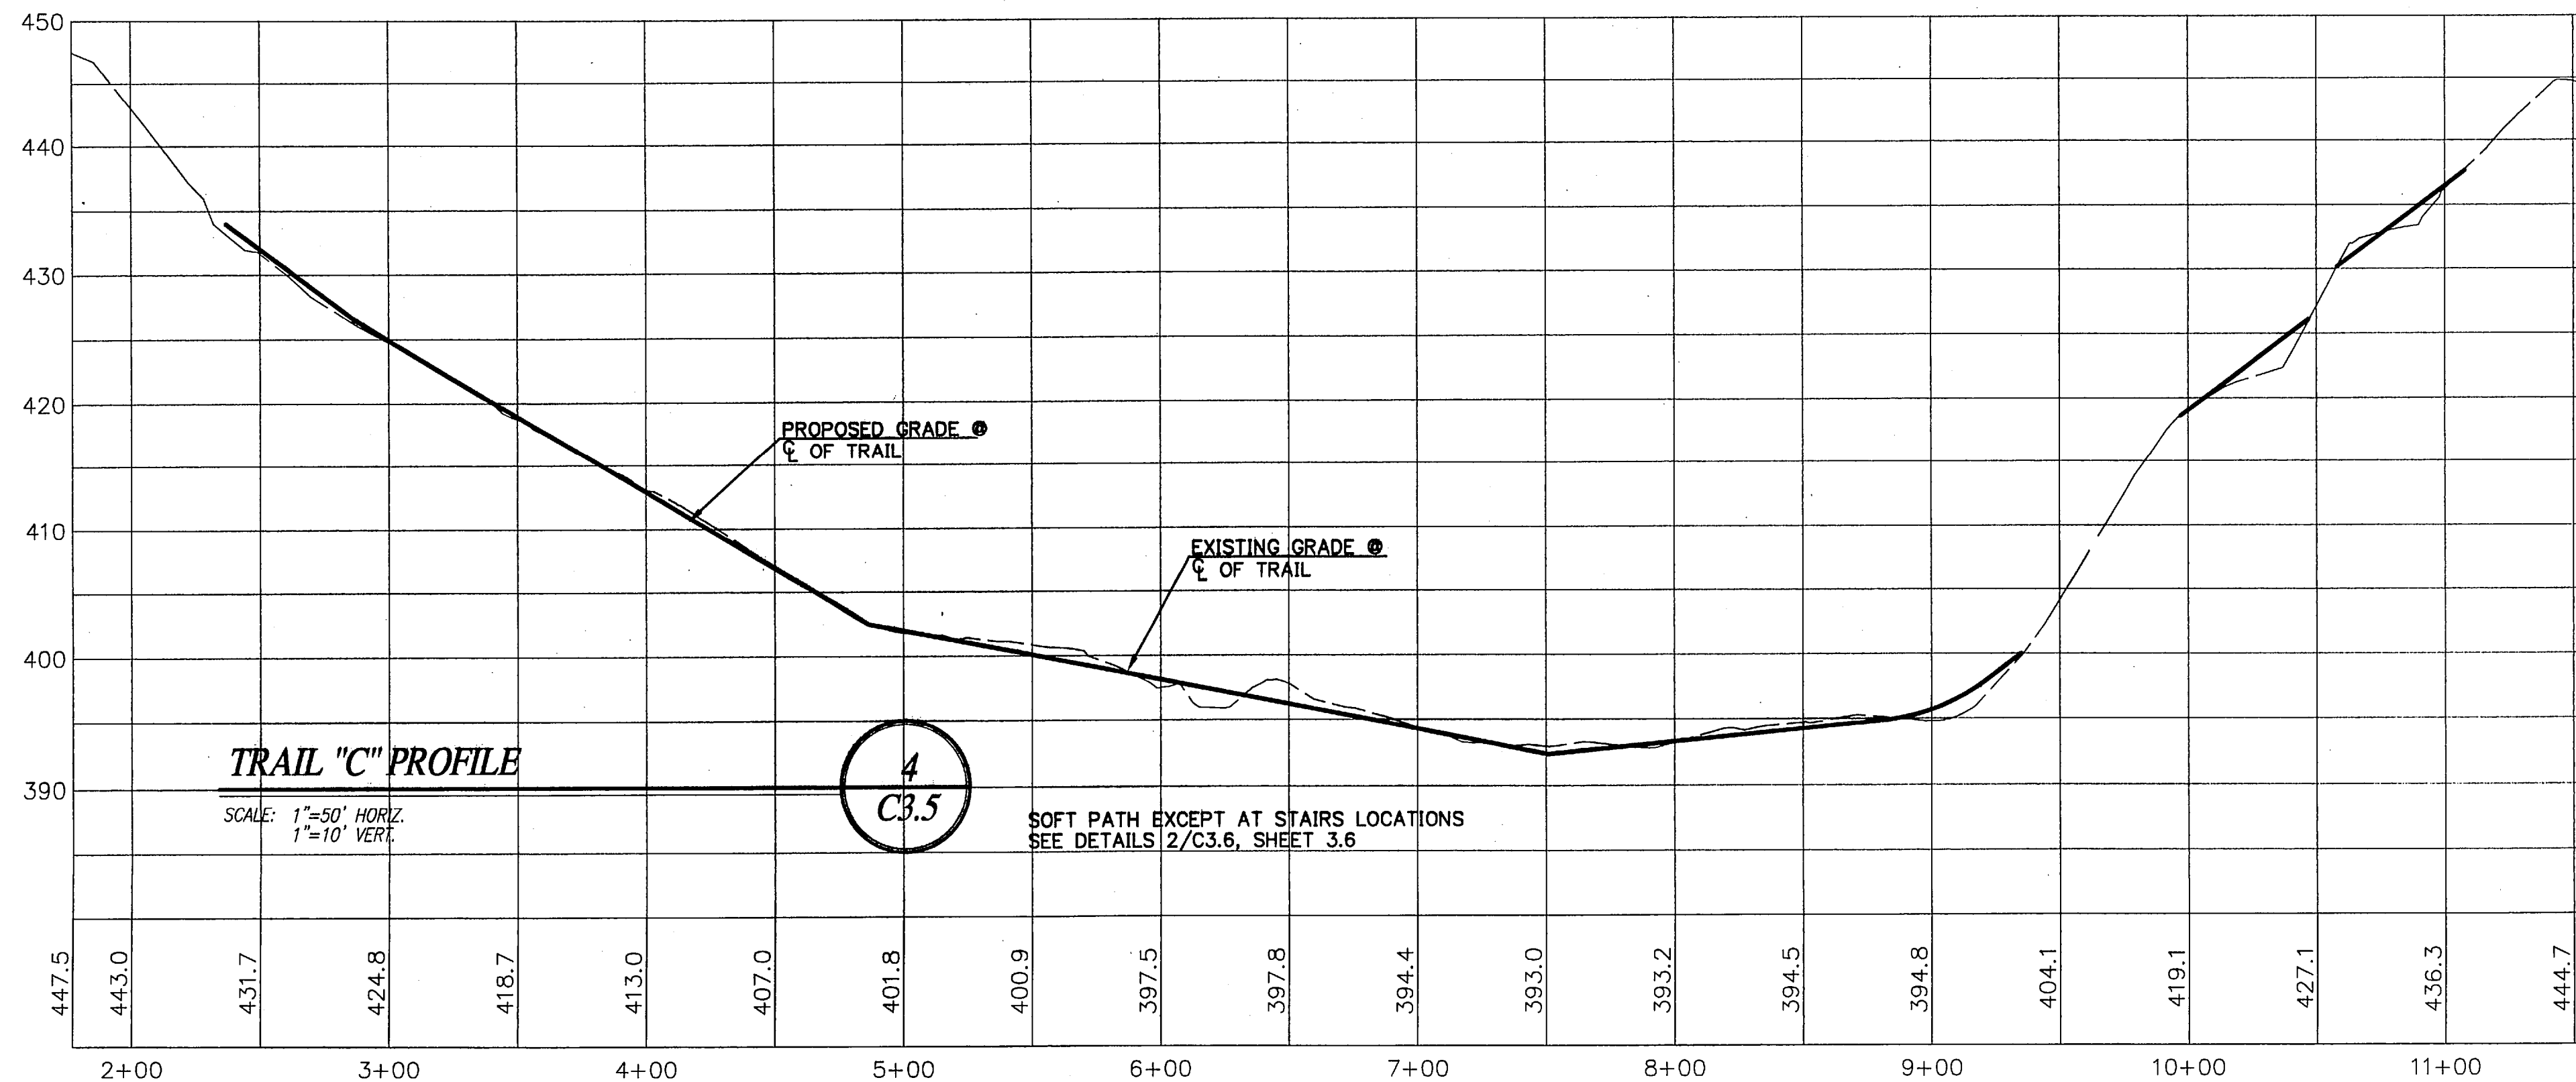

TRAIL "C" PROFILE

SCALE: 1"=50' HORIZ.
1"=10' VERT.

SOFT PATH EXCEPT AT STAIRS LOCATIONS
SEE DETAILS 2/C3.5, SHEET 3.6

08/21/2001
Date
AAH
Designed
AAH
Drawn
Checked By Date
RENEWAL 06/30/2003


NORWAY DEVELOPMENT
P.O. Box 387
Oregon City, Oregon 97045
PHONE: (503) 656-7000
FAX: (503) 656-0686

Tanner's Stonegate
001001
CITY OF WEST LINN, OREGON
PUBLIC OFFSITE TRAIL PLAN AND PROFILES


otak
Incorporated
17355 SW Boones Ferry Road
Lake Oswego, OR 97035-5217
Phone: (503) 635-3818
FAX: (503) 635-6395

AS BUILT
Project No. 10579
D579C3-5
File No. C3.5
Sheet No. Copyright 2001


XREF LIST
Title: 1
Resolved
D579X001

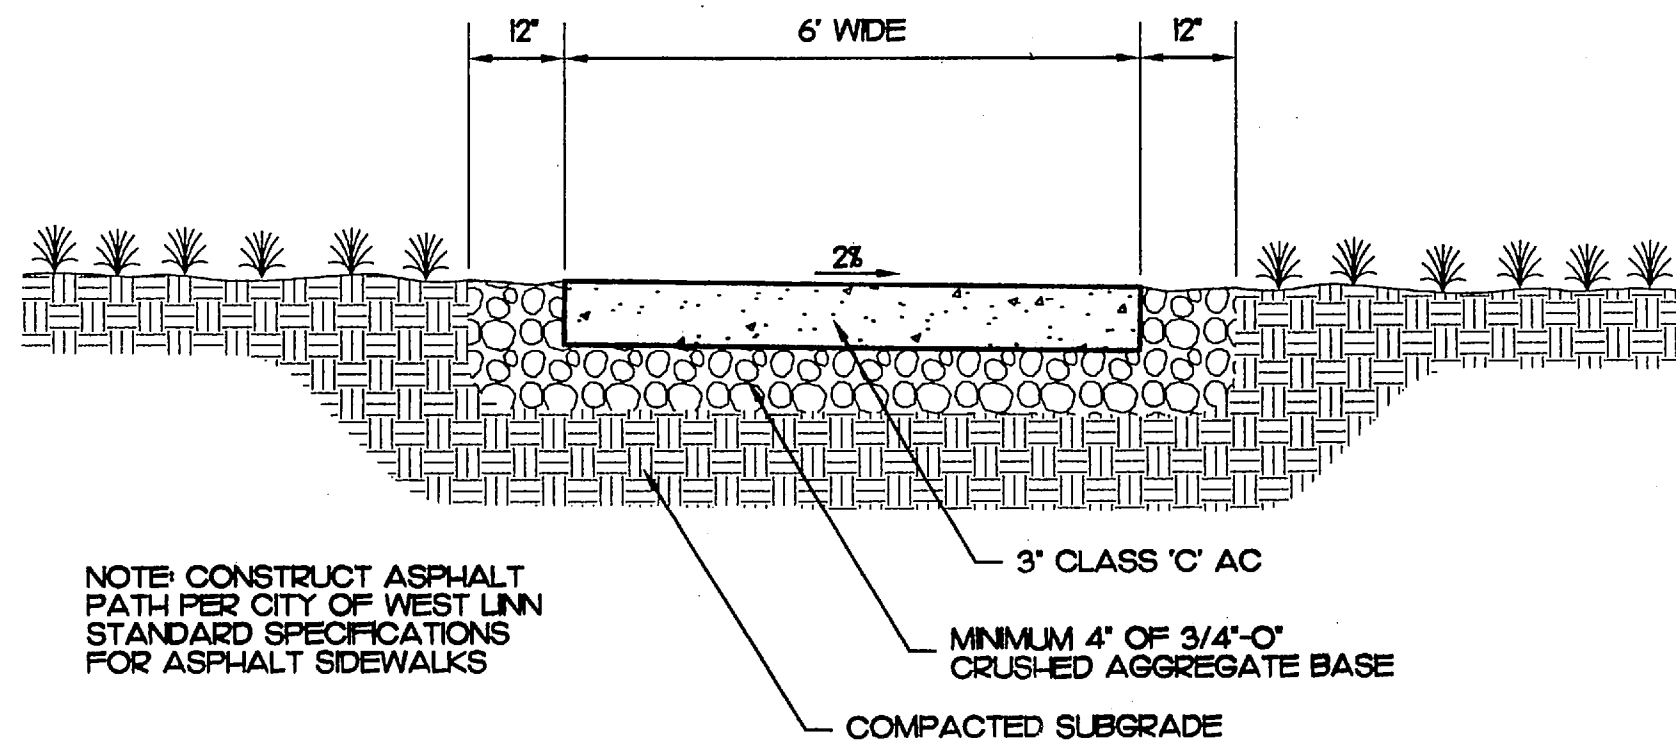


1 TRAIL SECTION - 6' HARD PATH
C3.6 NOT TO SCALE

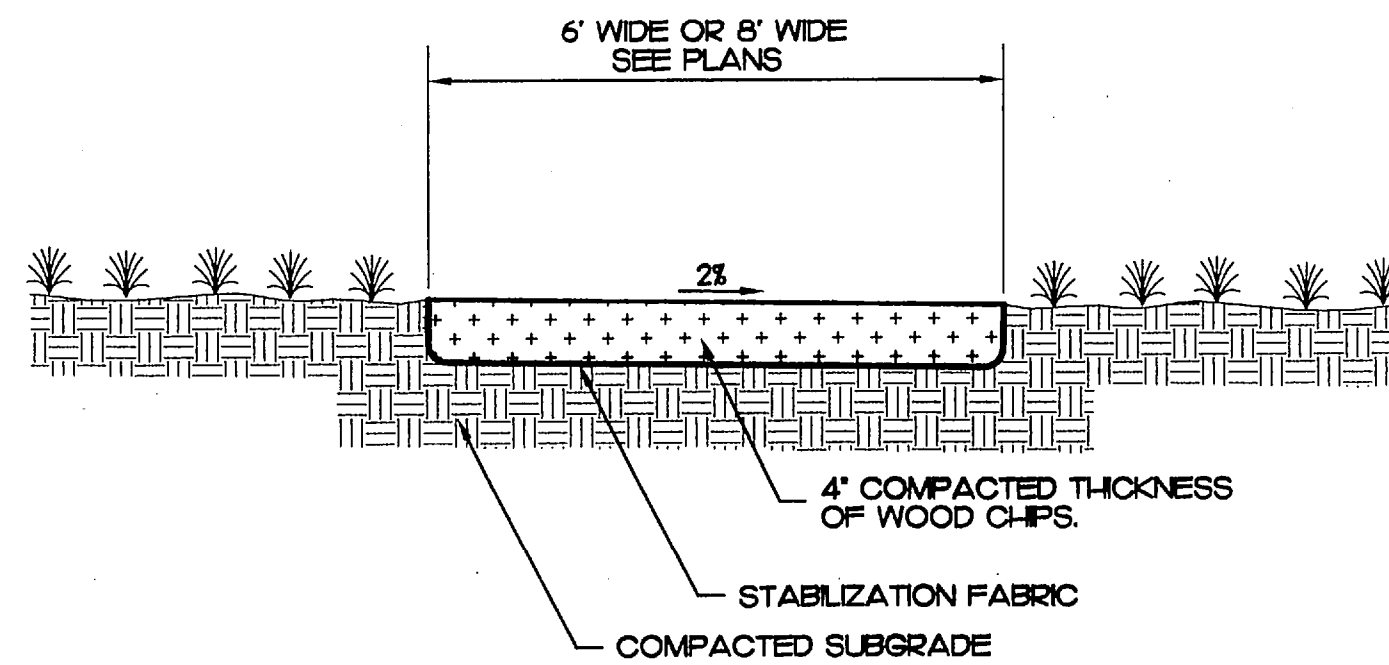

2 TRAIL SECTION- SOFT PATH
C3.6 NOT TO SCALE

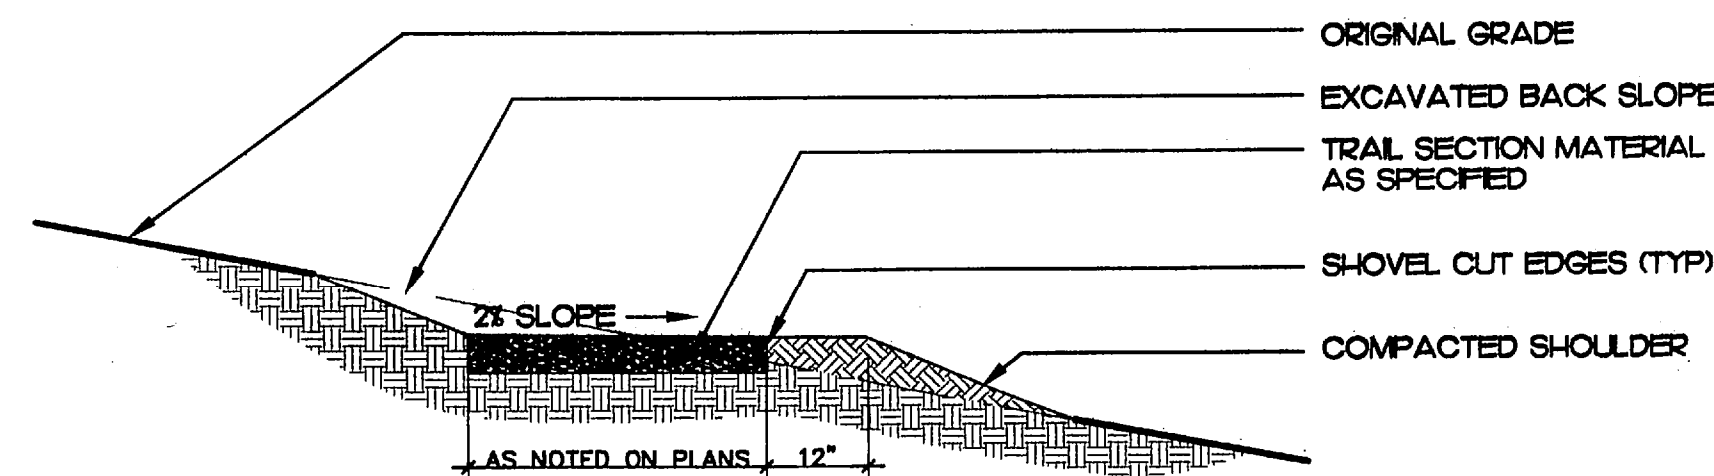


3 TRAIL SECTIONS AT CROSS SLOPES
C3.6 NOT TO SCALE

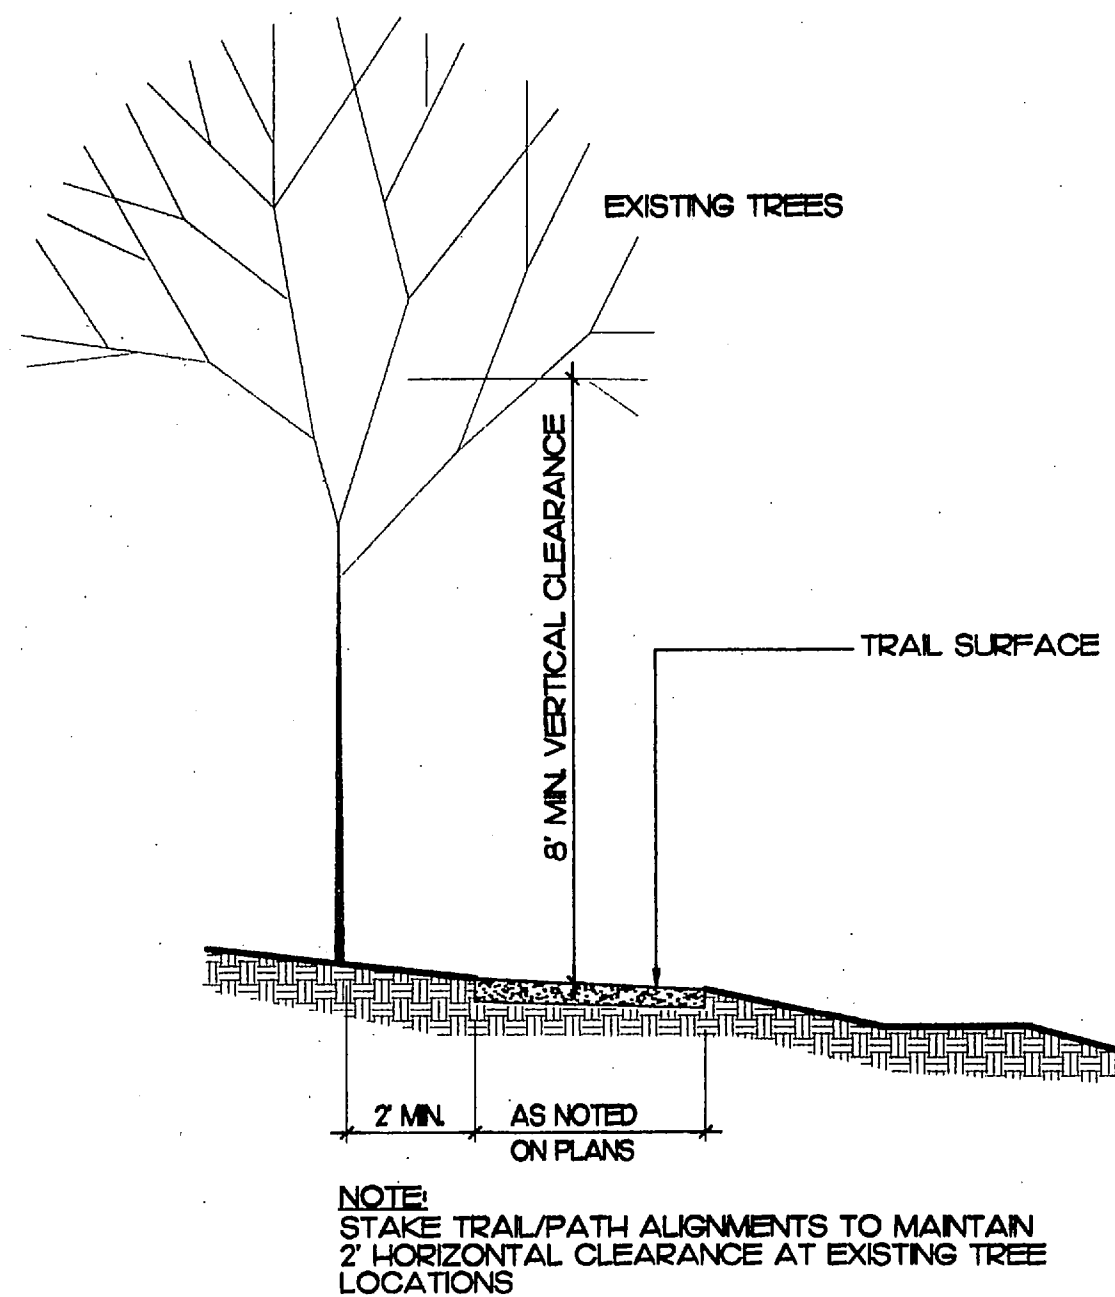

4 TRAIL SECTIONS AT TREE
C3.6 NOT TO SCALE

L: ADVAN 11/11/02 9:05am --> R: DWG D579C3-6.DWG

08/21/2001
Date
AAH
Designed
AAH
Drawn
Checked By Date

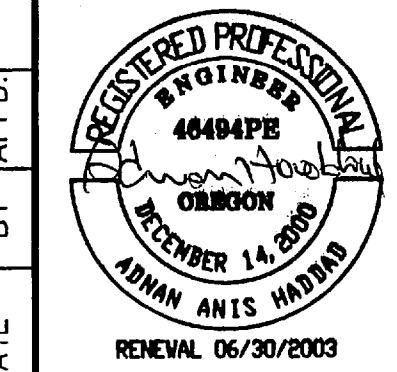

NORWAY DEVELOPMENT
P.O. Box 387
Oregon City, Oregon 97045
PHONE: (503) 656-7000
FAX: (503) 656-0686


Tanner's Stonegate
001001
CITY OF WEST LINN, OREGON
PUBLIC OFFSITE TRAIL DETAILS

oak
Incorporated
17355 SW Boones Ferry Road
Lake Oswego, OR 97035-5217
Phone: (503) 635-3618
FAX: (503) 635-5395

10579
Project No.
D579C3-6
File No.
C3.6
Sheet No.
Copyright 2001

AS BUILTS


XREF LIST
Ltscale: 1
Resolved
D579X001
D579X190
D579X230
D579X400
D579X430
D579X600
D579X630
D579X900

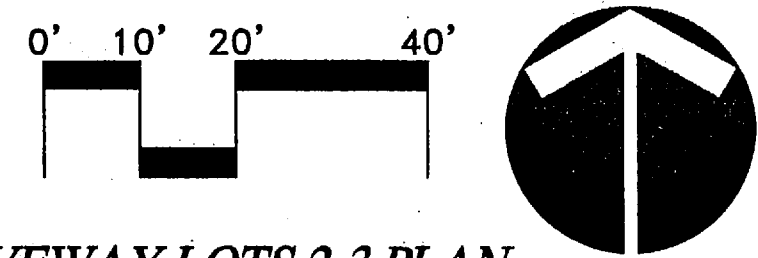

DRIVEWAY LOTS 2-3 PLAN

SCALE: AS SHOWN


1
C3.7

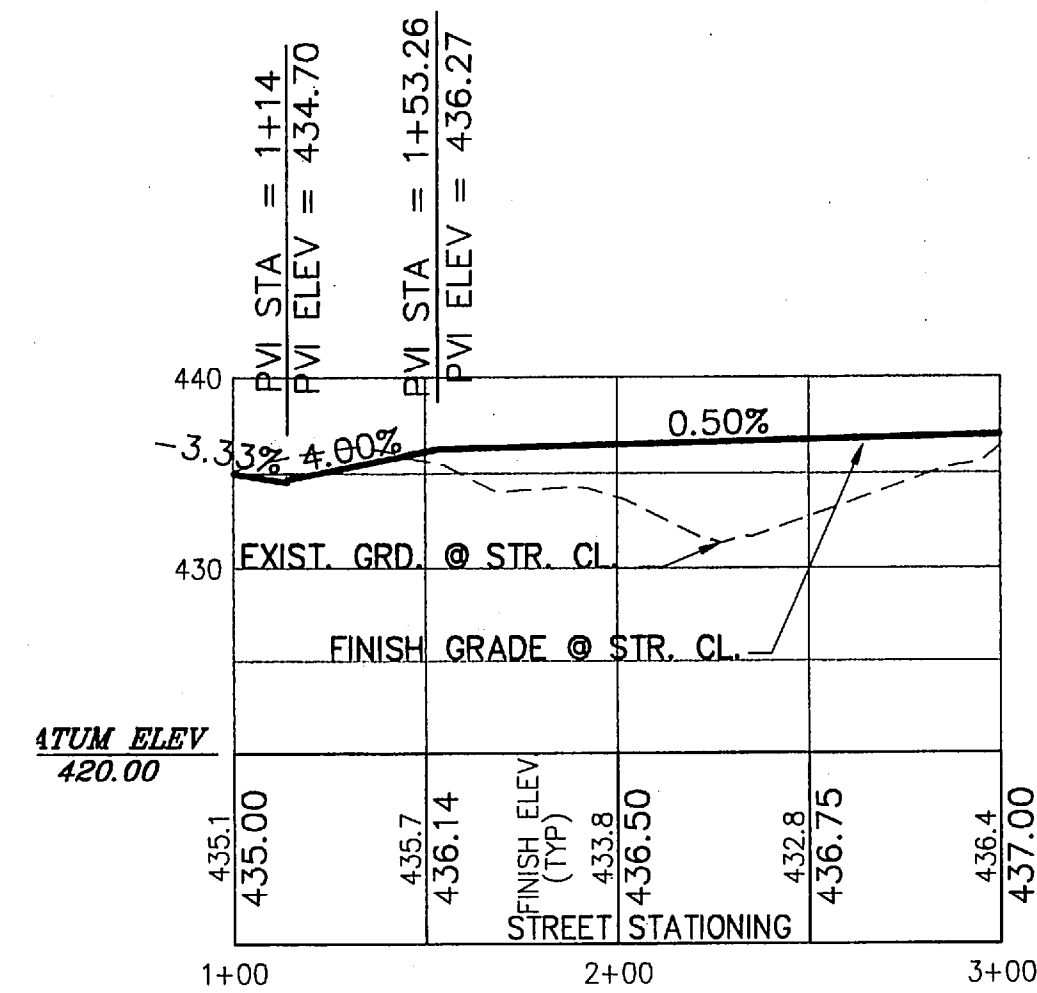

DRIVEWAY LOTS 2-3 PROFILE

SCALE: HORIZONTAL 1" = 50'
VERTICAL 1" = 10'


2
C3.7

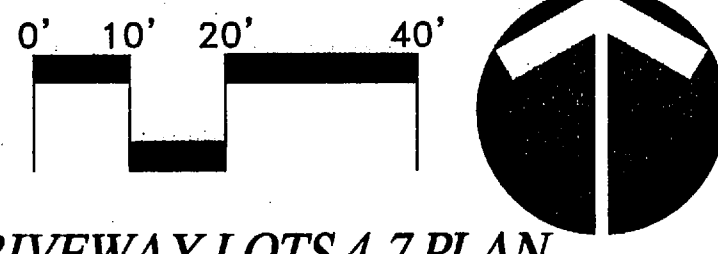

DRIVEWAY LOTS 4-7 PLAN

SCALE: AS SHOWN



3
C3.7

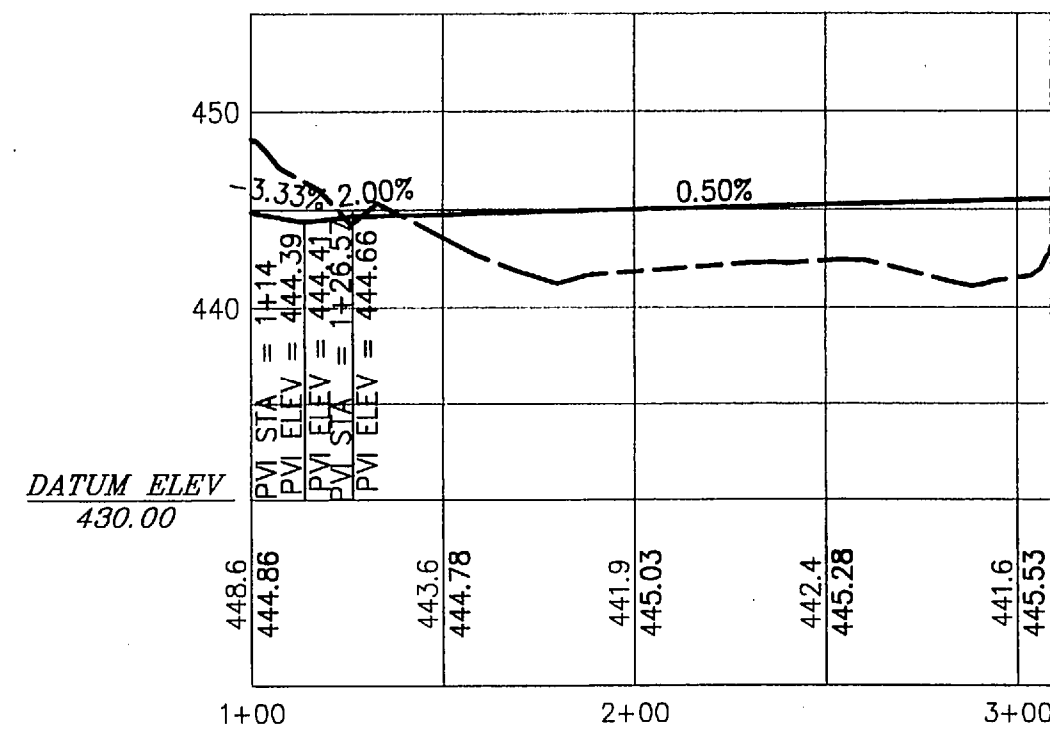

DRIVEWAY LOTS 4-7 PROFILE

SCALE: HORIZONTAL 1" = 50'
VERTICAL 1" = 10'


7
C3.7

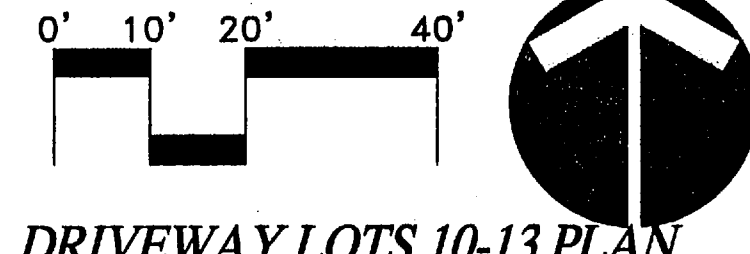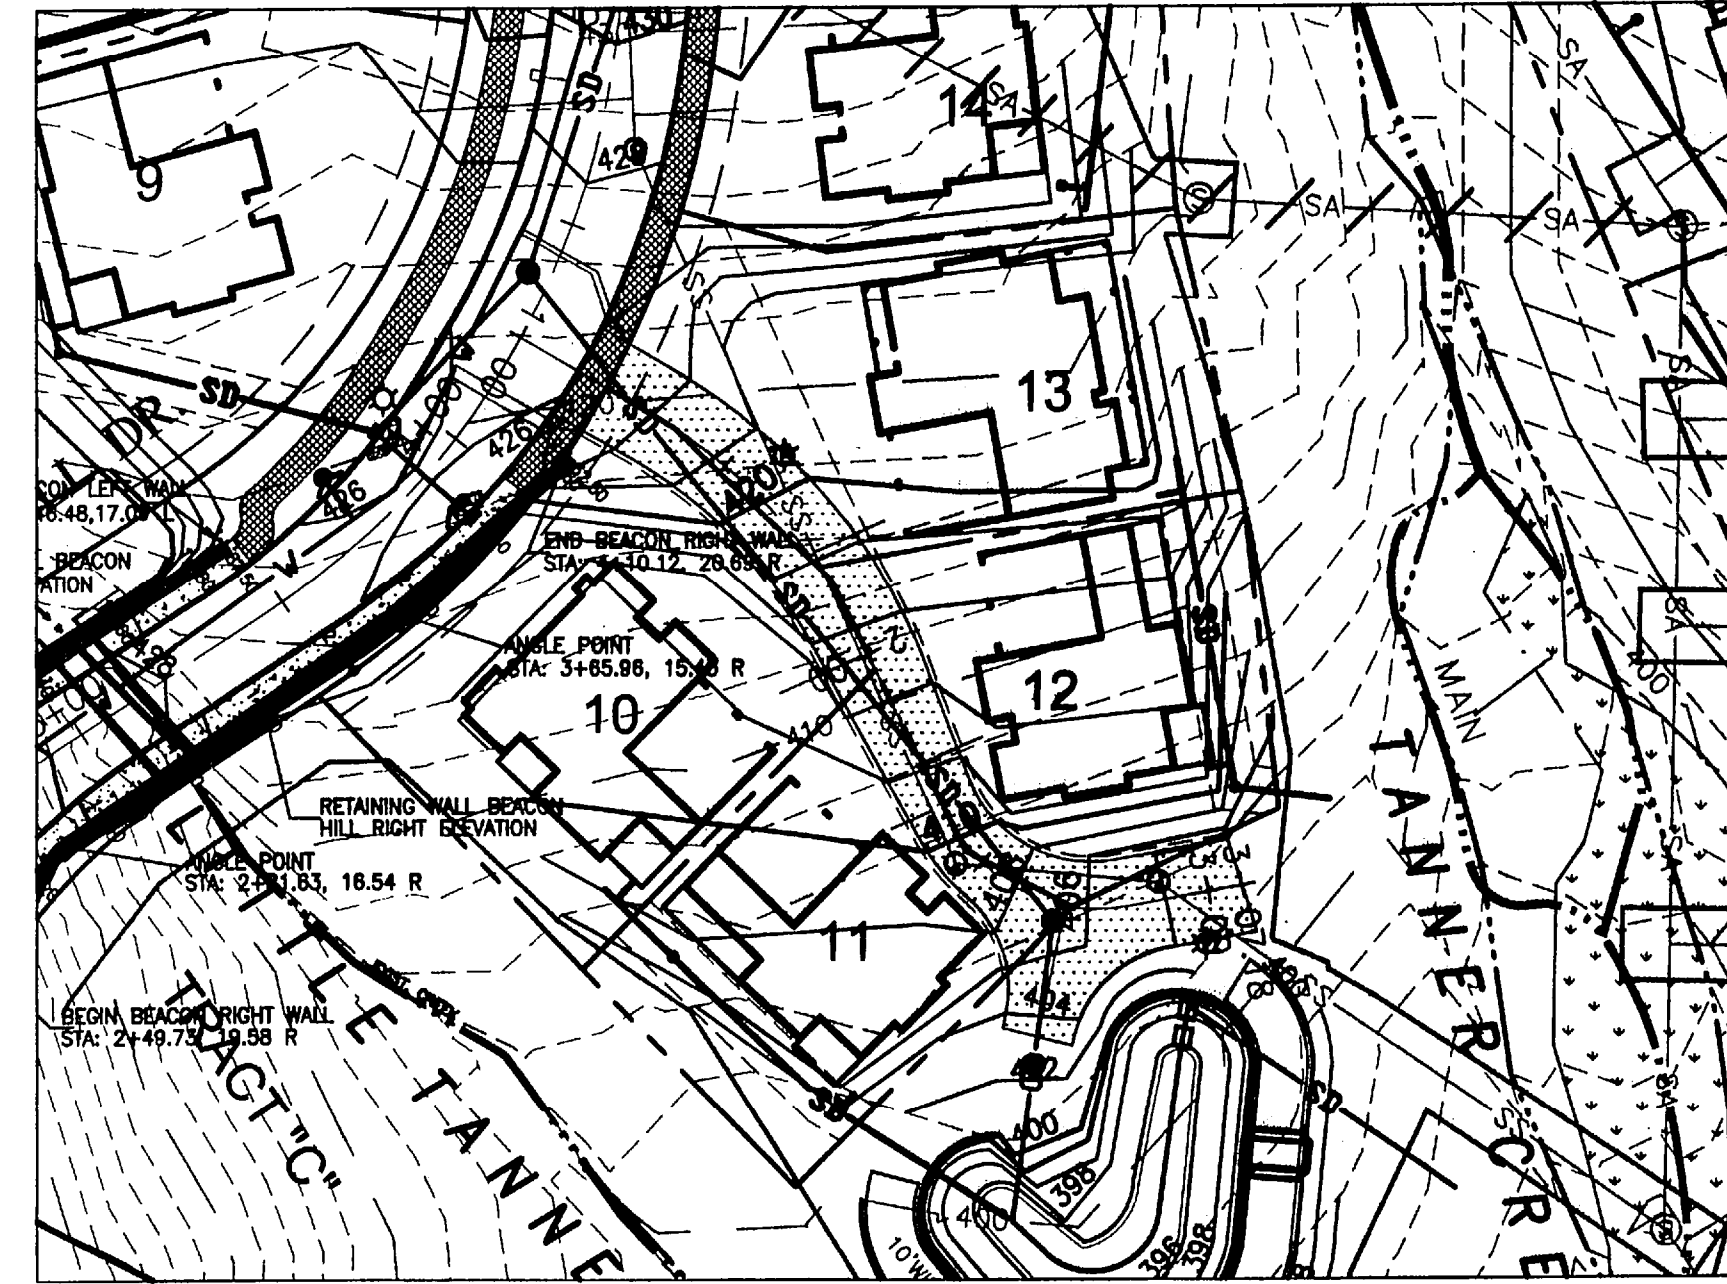

DRIVEWAY LOTS 10-13 PLAN

SCALE: AS SHOWN

5
C3.7

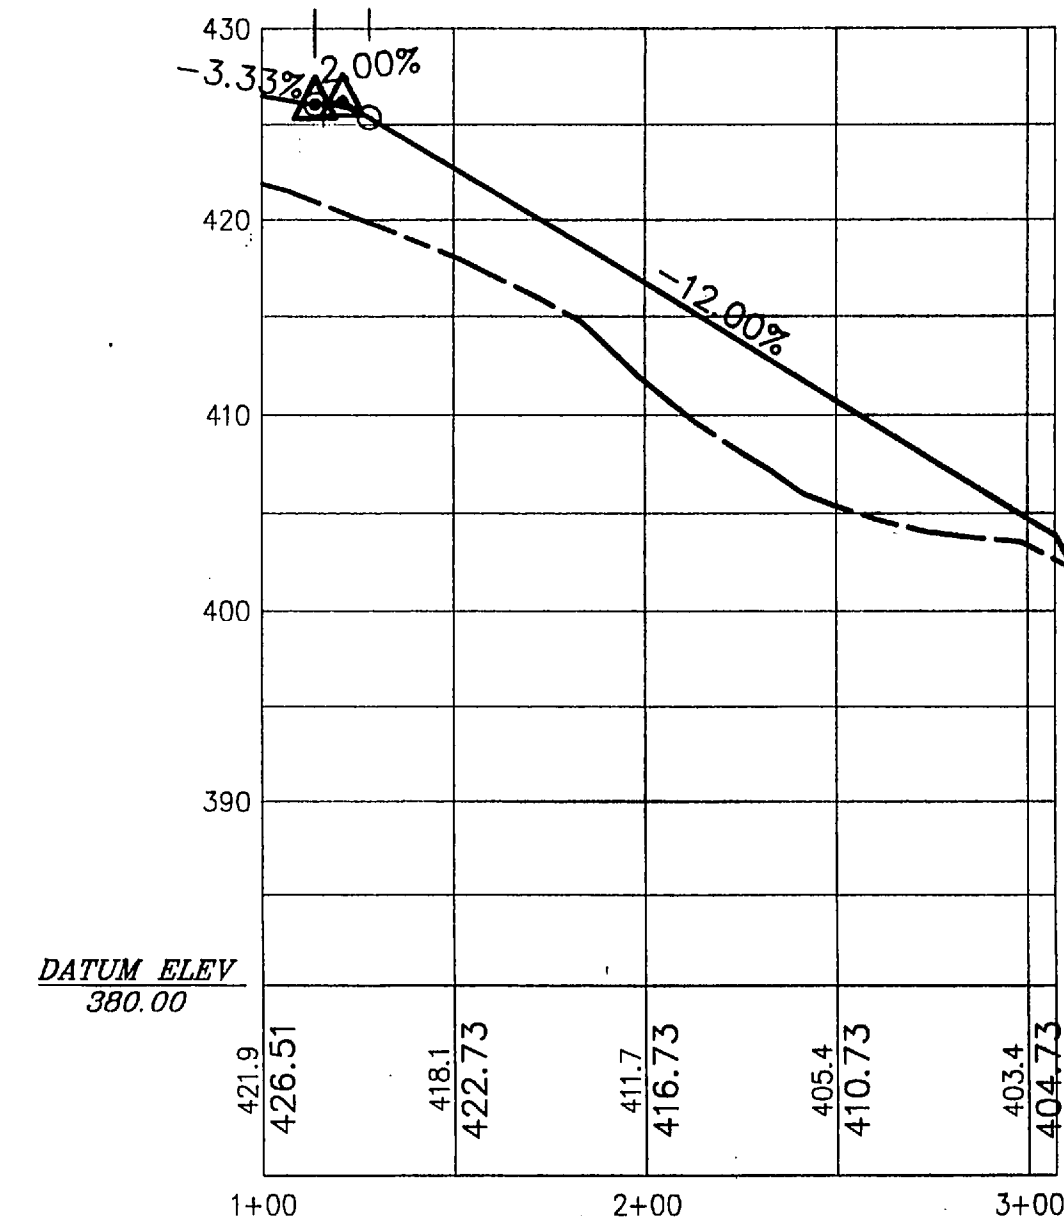


DRIVEWAY LOTS 10-13 PROFILE

SCALE: HORIZONTAL 1" = 50'
VERTICAL 1" = 10'

6
C3.7

08/21/2001
Date
AAH/BLW/JAH
Designed
AAH/BLW/JAH
Drawn
Checked By Date

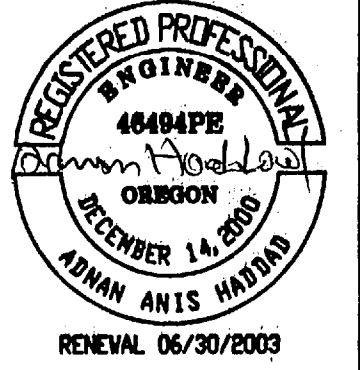

NORWAY DEVELOPMENT
P.O. Box 387
Oregon City, Oregon 97045
PHONE: (503) 656-7000
FAX: (503) 656-0686

Tanner's Stonegate
CITY OF WEST LINN, OREGON
DRIVEWAY AND ACCESS ROAD PROFILES

otak
Incorporated
17355 SW Boones Ferry Road
Lake Oswego, OR 97035-8217
Phone: (503) 635-3818
FAX: (503) 635-5395


10579
Project No.
D579C3-7
File No.
C3.7
Sheet No.
Copyright 2001

AS BUILTS


```


XREF LIST
=====
Ltscale: 1
-----
Resolved
-----
D579X001
D579X190
D579X230
D579X400
D579X430
D579X600

```

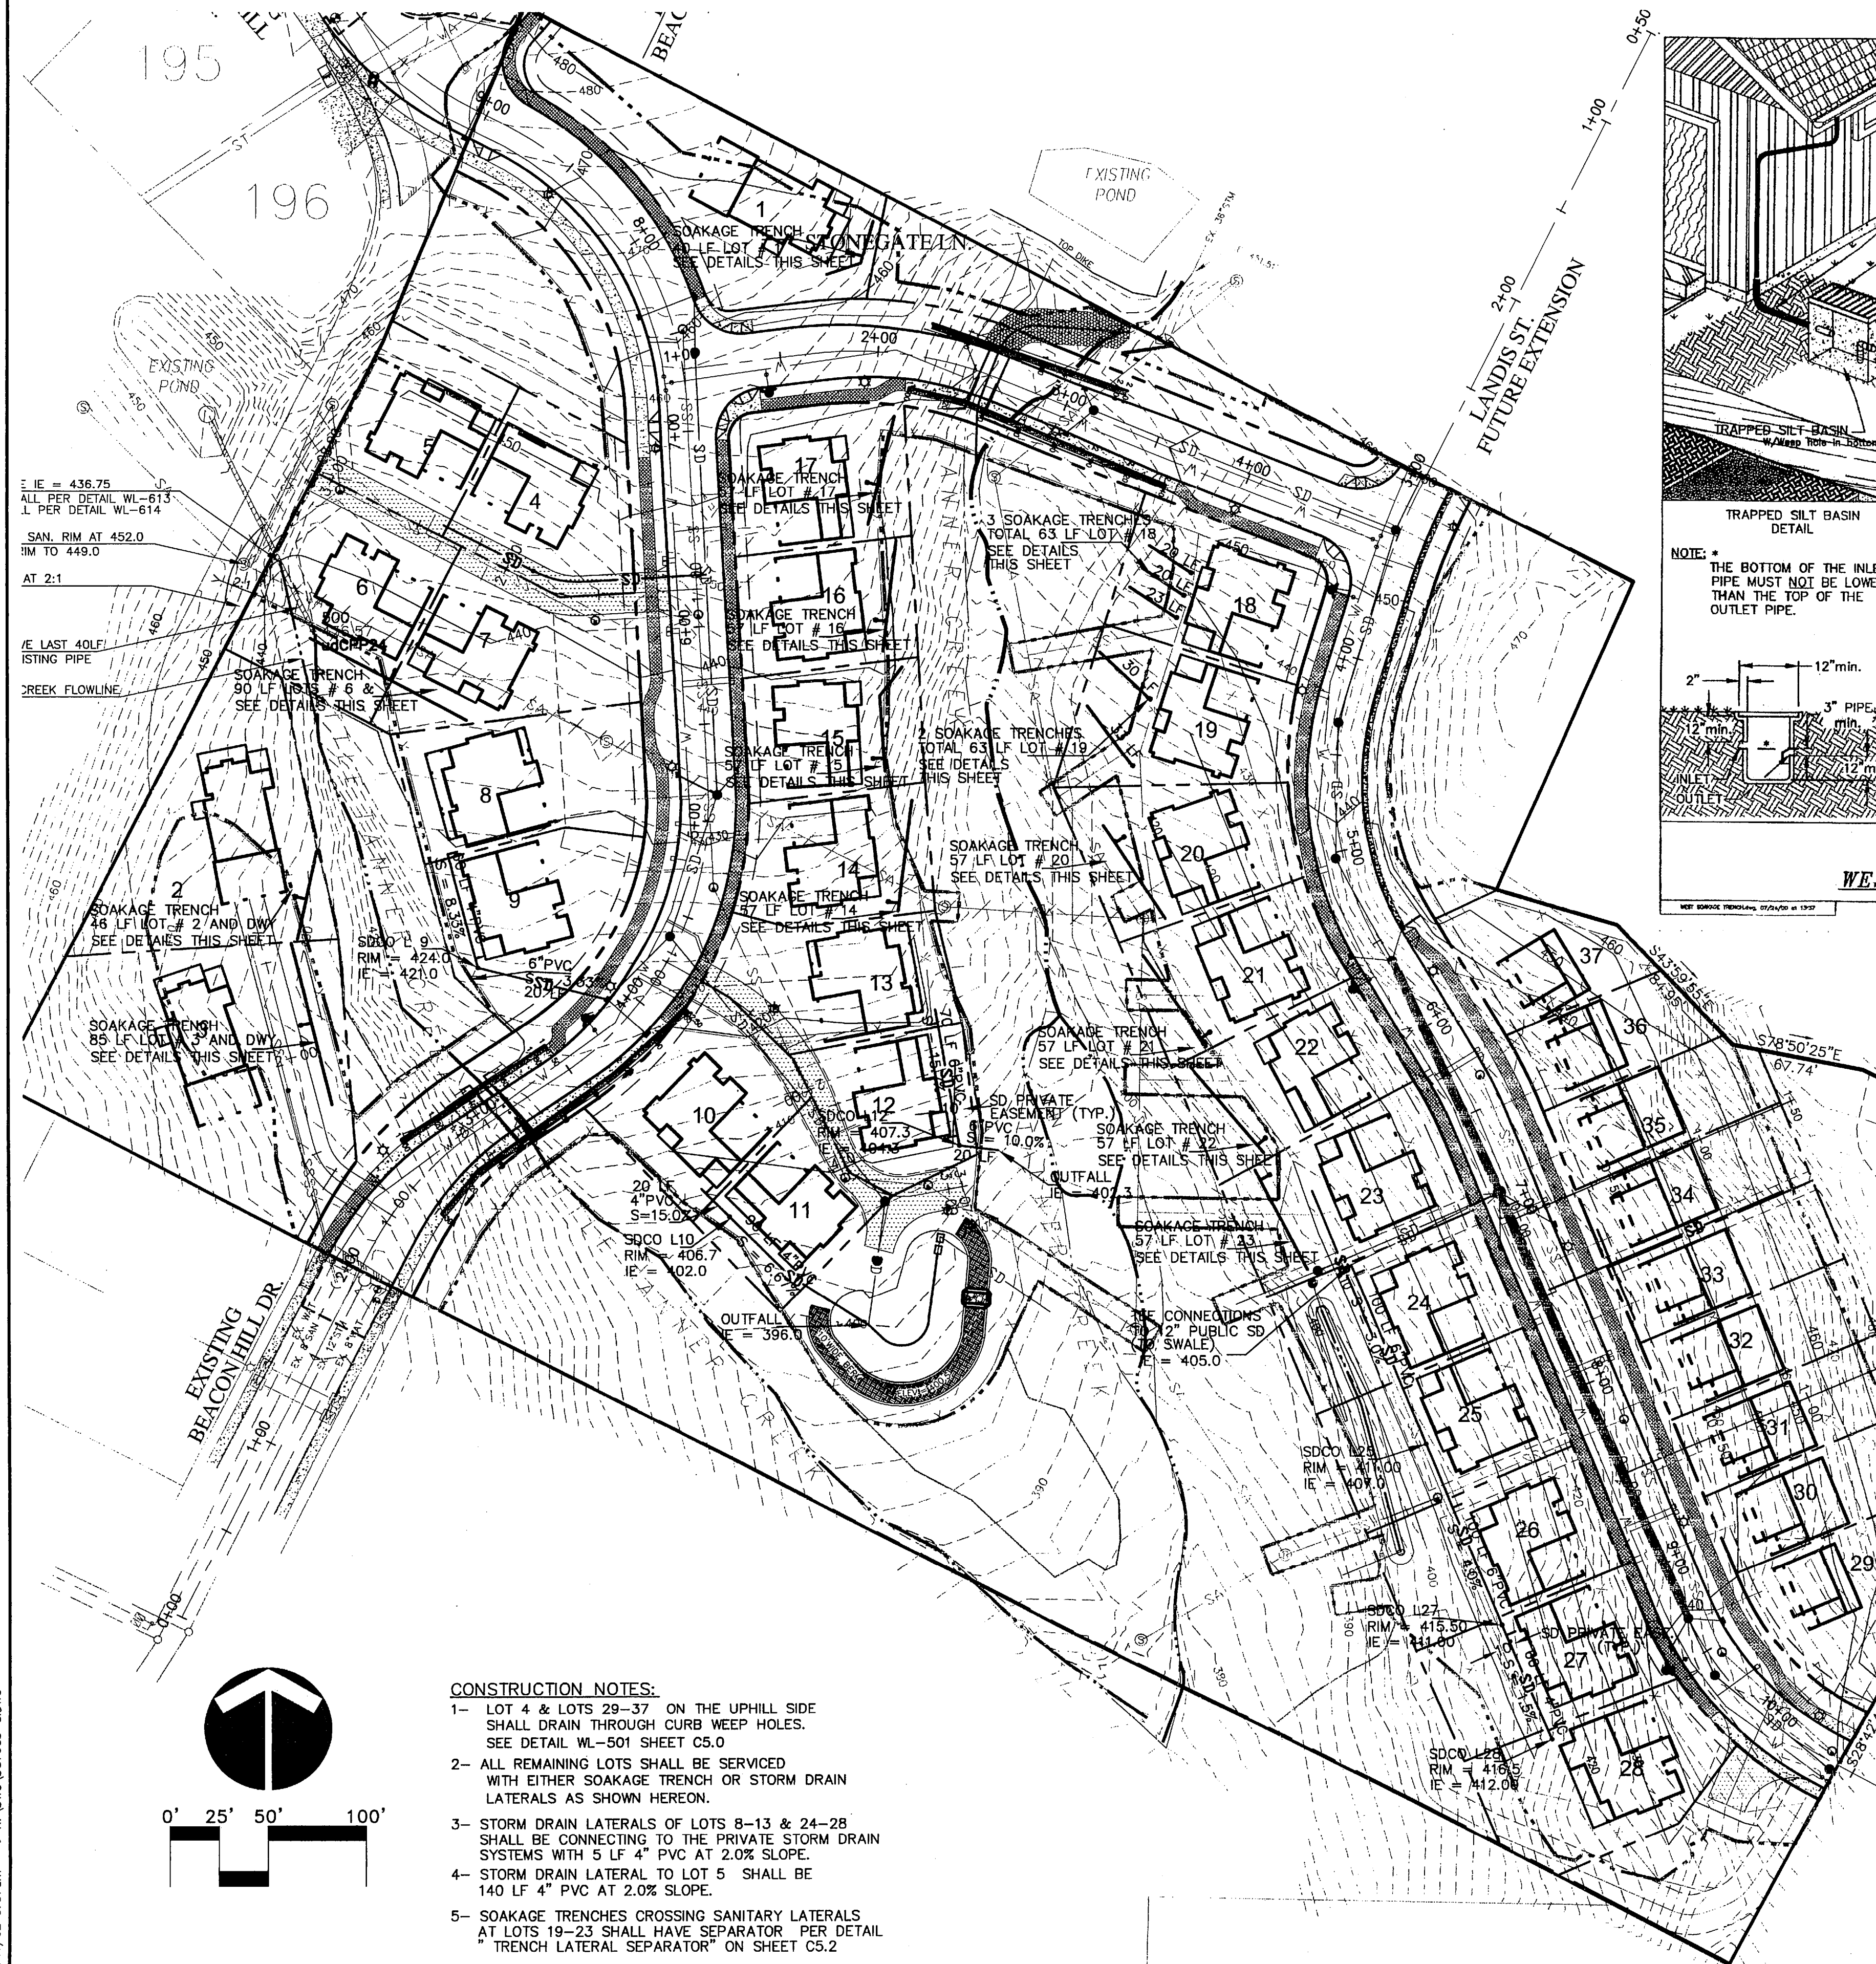

CONSTRUCTION NOTES:

- 1- LOT 4 & LOTS 29-31 ON THE UPHILL SIDE
SHALL DRAIN THROUGH CURB WEEP HOLES.
SEE DETAIL WL-501 SHEET C5.0
- 2- ALL REMAINING LOTS SHALL BE SERVICED
WITH EITHER SOAKAGE TRENCH OR STORM DRAIN
LATERALS AS SHOWN HEREON.
- 3- STORM DRAIN LATERALS OF LOTS 8-13 & 24-28
SHALL BE CONNECTING TO THE PRIVATE STORM DRAIN
SYSTEMS WITH 5 LF 4" PVC AT 2.0% SLOPE.
- 4- STORM DRAIN LATERAL TO LOT 5 SHALL BE
140 LF 4" PVC AT 2.0% SLOPE.
- 5- SOAKAGE TRENCHES CROSSING SANITARY LATERALS
AT LOTS 19-23 SHALL HAVE SEPARATOR PER DETAIL
"TRENCH LATERAL SEPARATOR" ON SHEET C5.2

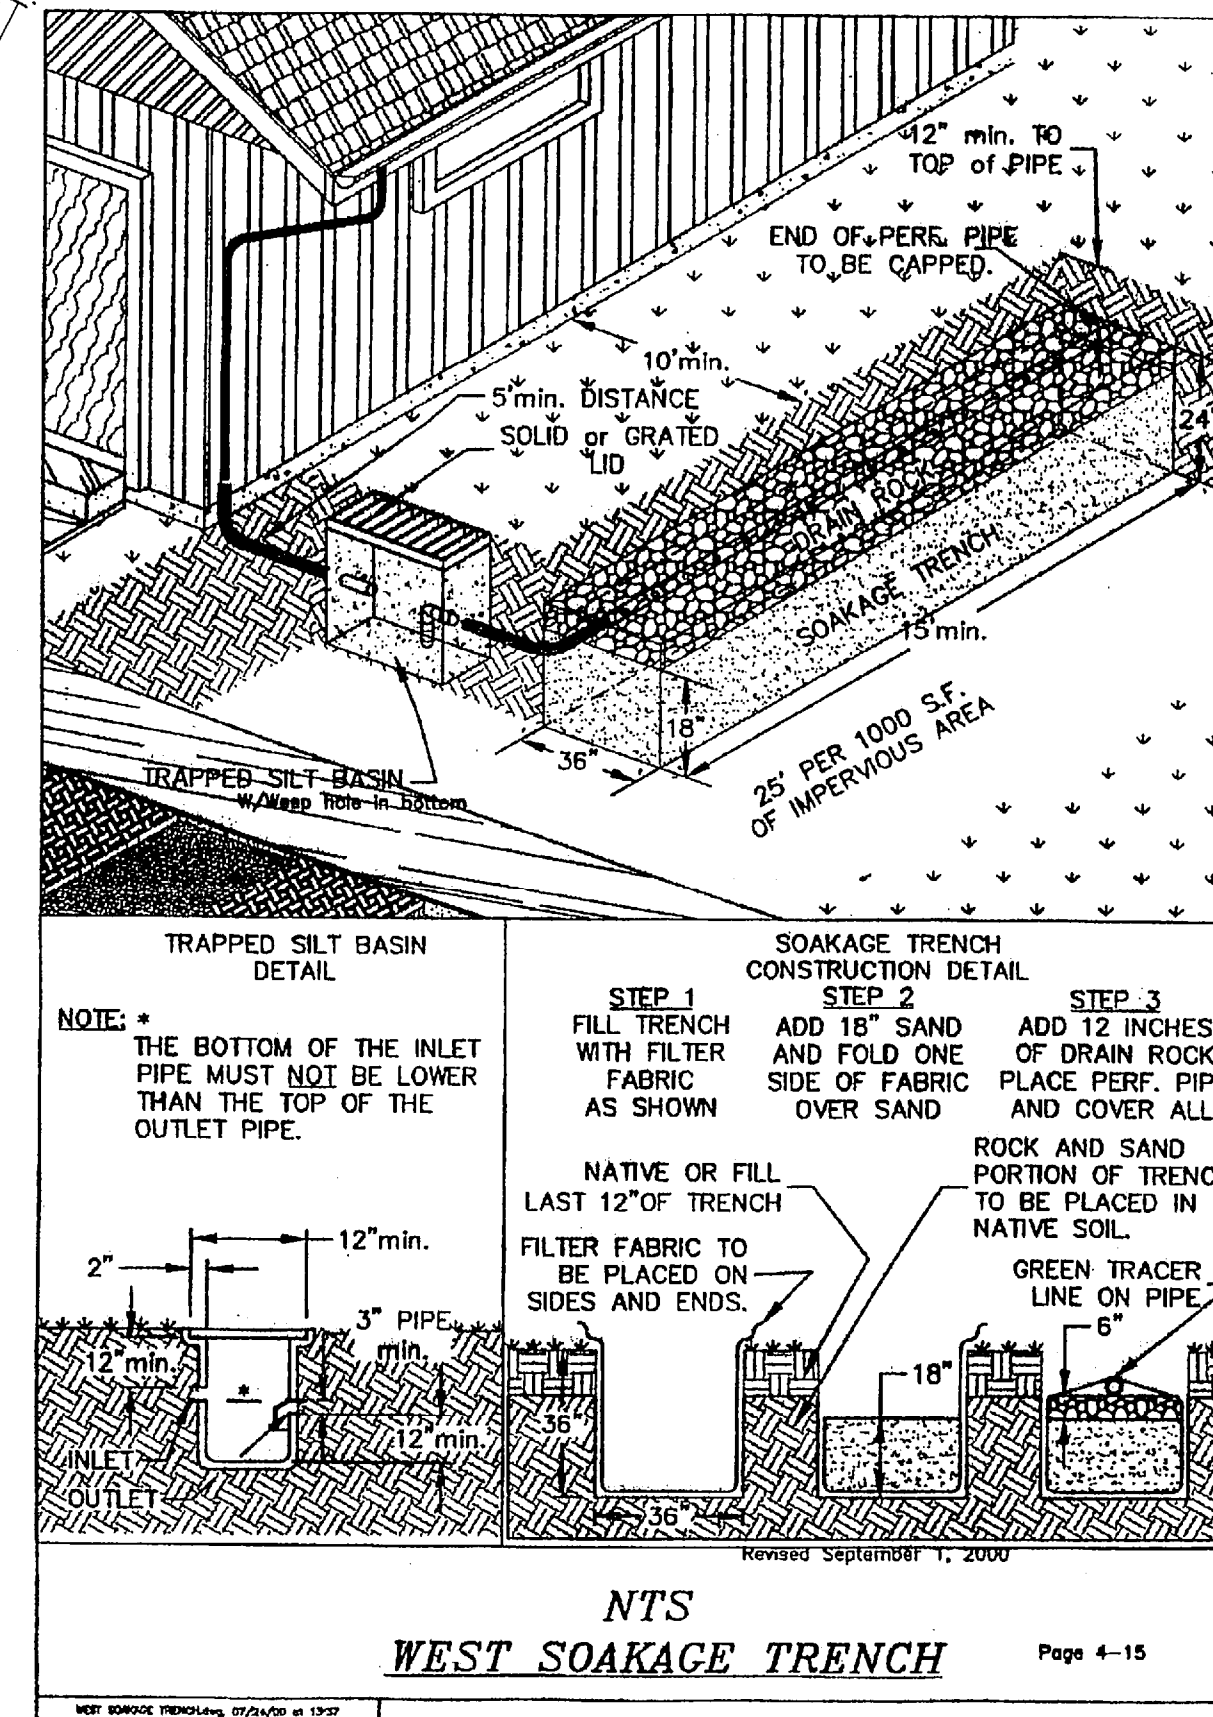

Stormwater Management/Disposal Trench
Applicable to Areas West of the Willamette

Sandfilter Sockage Trench Sizing:
25 linear feet of trench for every 1000 sf of impervious surface is required. A minimum 15-foot long sockage trench is required. Sockage trenches 15 feet long may serve a maximum of 600 sf of horizontally projected roof area or other impervious surface. This is a minimum sizing for treatment. However, if mitigation occurs on the site, this sizing may be increased by OPDR for stormwater disposal purposes due to soil percolation rates.

Trench

- Sandfilter soa/age trench and perforated pipe must be installed level and parallel to contour of finish grade.
- Sandfilter soa/age trench shall be located no closer than 10 feet to any building and not closer than 5 feet from property line.
- Sandfilter soa/age trench must be filled with a minimum of 18" Medium Sand Sieved OARS 340-71-293 (3)(c).
- Minimum 6" of "3/4" - 2 1/4" round or crushed rock to cover and separated by one layer of filter fabric.
- The pipe shall be laid on top of this gravel and covered with filter fabric.
- At least 12" minimum of backfill shall be placed over this trench.
- All trenches shall be constructed on water and/or gas lines are not subject to vehicular traffic or construction work that will compact the soil, thus reducing the permeability.
- Slope shall not exceed 20% without a stamped and signed geotechnical report addressing slope stability.

Sand

Medium Sand meeting OAR 340-71-295 (3)(e). Sieve analysis of the medium sand to be loaded into the filter may be required to be made by a qualified party and a report provided to City of Portland plumbing inspector at the time of inspection. Analysis to comply with ASTM C136, Standard Methods for Sieve Analysis of Fine and Coarse Aggregate and in conjunction and accordance with ASTM C-117, Standard Test Method for Materials Finer than No.200 Sieve in Mineral Aggregates by Washing.

<u>Sieve #</u>	<u>% Passing</u>
3/8	100%
#4	95-100%
#8	80-100%
#16	45-85%
#30	15-60%
#50	3-15%
#100	4% or less

Pipe


- The solid pipe from building or other source to connection with perforated pipe must be installed at a 1/4" per foot slope.
- All piping within 10 feet of building must be sch. 40 ABS, sch. 40 pipe, cast iron, sch. 40 ABS, 3" sch. 40 PVC or 3" cast iron pipe may be used for rain drain piping serving not more than 1500 sq ft of roof or surface area. Use 4" pipe if area is greater than 1500 ft.
- Non-Metallic pipe must have a minimum cover of 12" measured from top of pipe to finished grade.
- The pipe within the trench shall either be PVC D2720 or HDPE Leach field pipe.

Filter Fabric must be one of the following types/brands:

LINQ 125EX; LINQ TYPAR3201; TNS R035; TNS E040; TNS R040; TNS R042; AMOCO 4535; Marafi 140NL


SERVICES/STORMWATER MGT/WEST.DOC

LEGEND

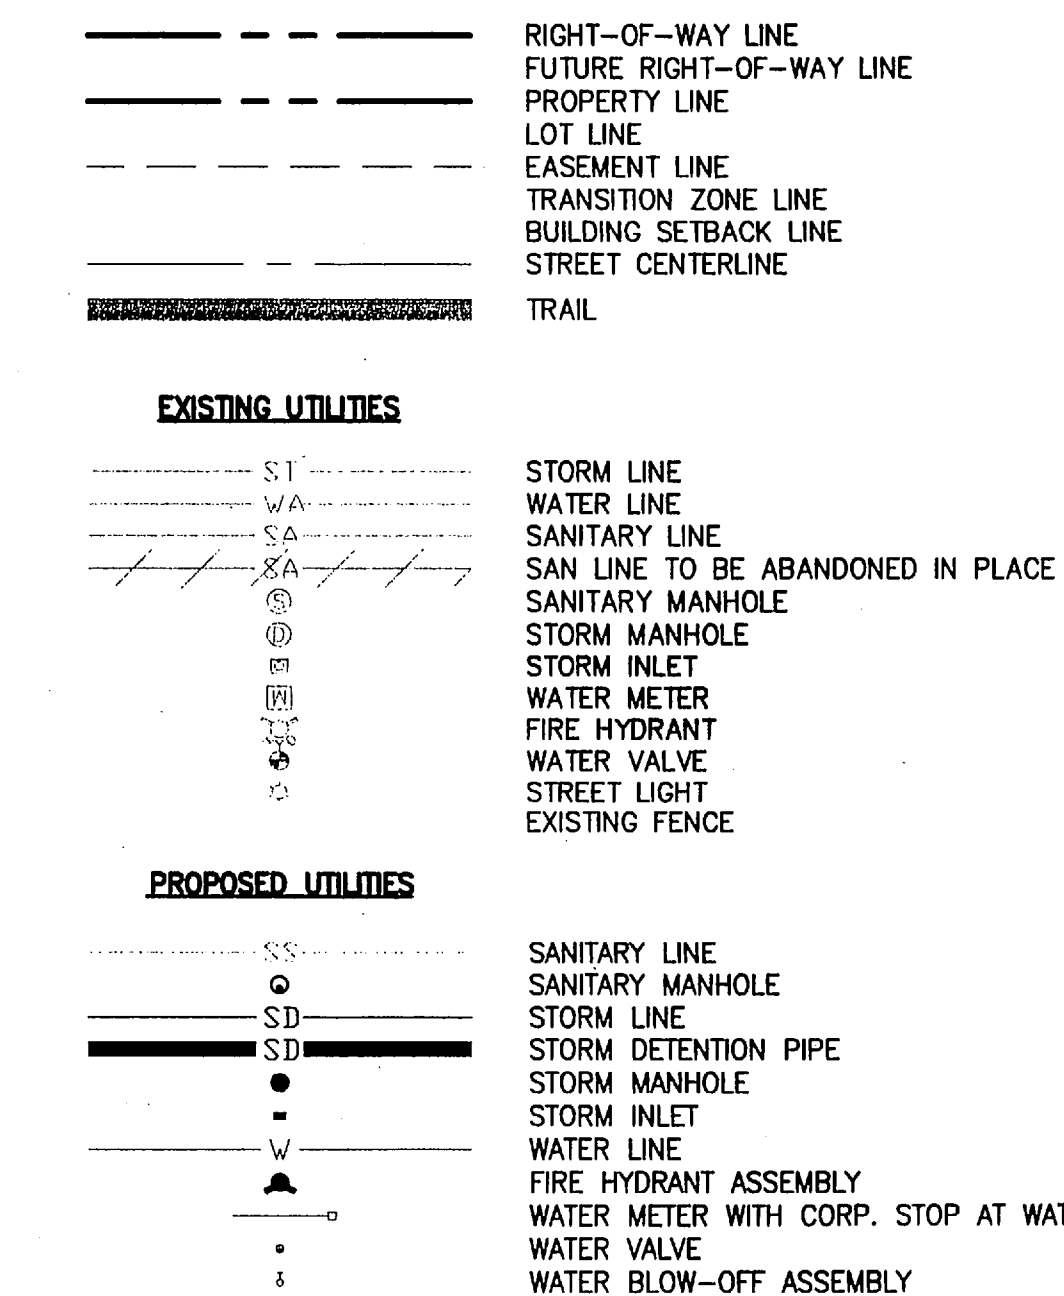

08/21/2001

Date AAH/BLW/JAH
Designed AAH/BLW/JAH
Drawn

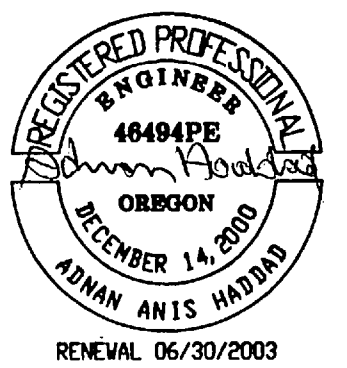

NORWAY DEVELOPMENT
P.O.Box 387

P.O.Box 387
Oregon City, Oregon 97045
PHONE: (503) 656-7000
FAX: (503) 656-0686

Tanner's Stonegate

CITY OF WEST LINN, OREGON

SOAKAGE TRENCHES AND PRIVATE STORM DRAIN PLAN



Incorporated

17355 SW Boones Ferry Road
Lake Oswego, OR 97035-5217
Phone: (503) 635-3818
FAX: (503) 635-5395

10579

Project No.

D579C3-8



C3.8

Sheet No.

Copyright 2001 ©

: ADNANH 11/11/02 9:07am --> R:\DWG\D579C3-8.DWG

XREF LIST
Ltscale: 1
Resolved
D579X001
D579X190
D579X230
D579X600
TRAILS

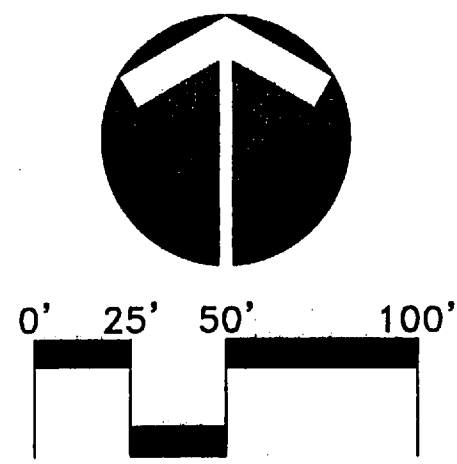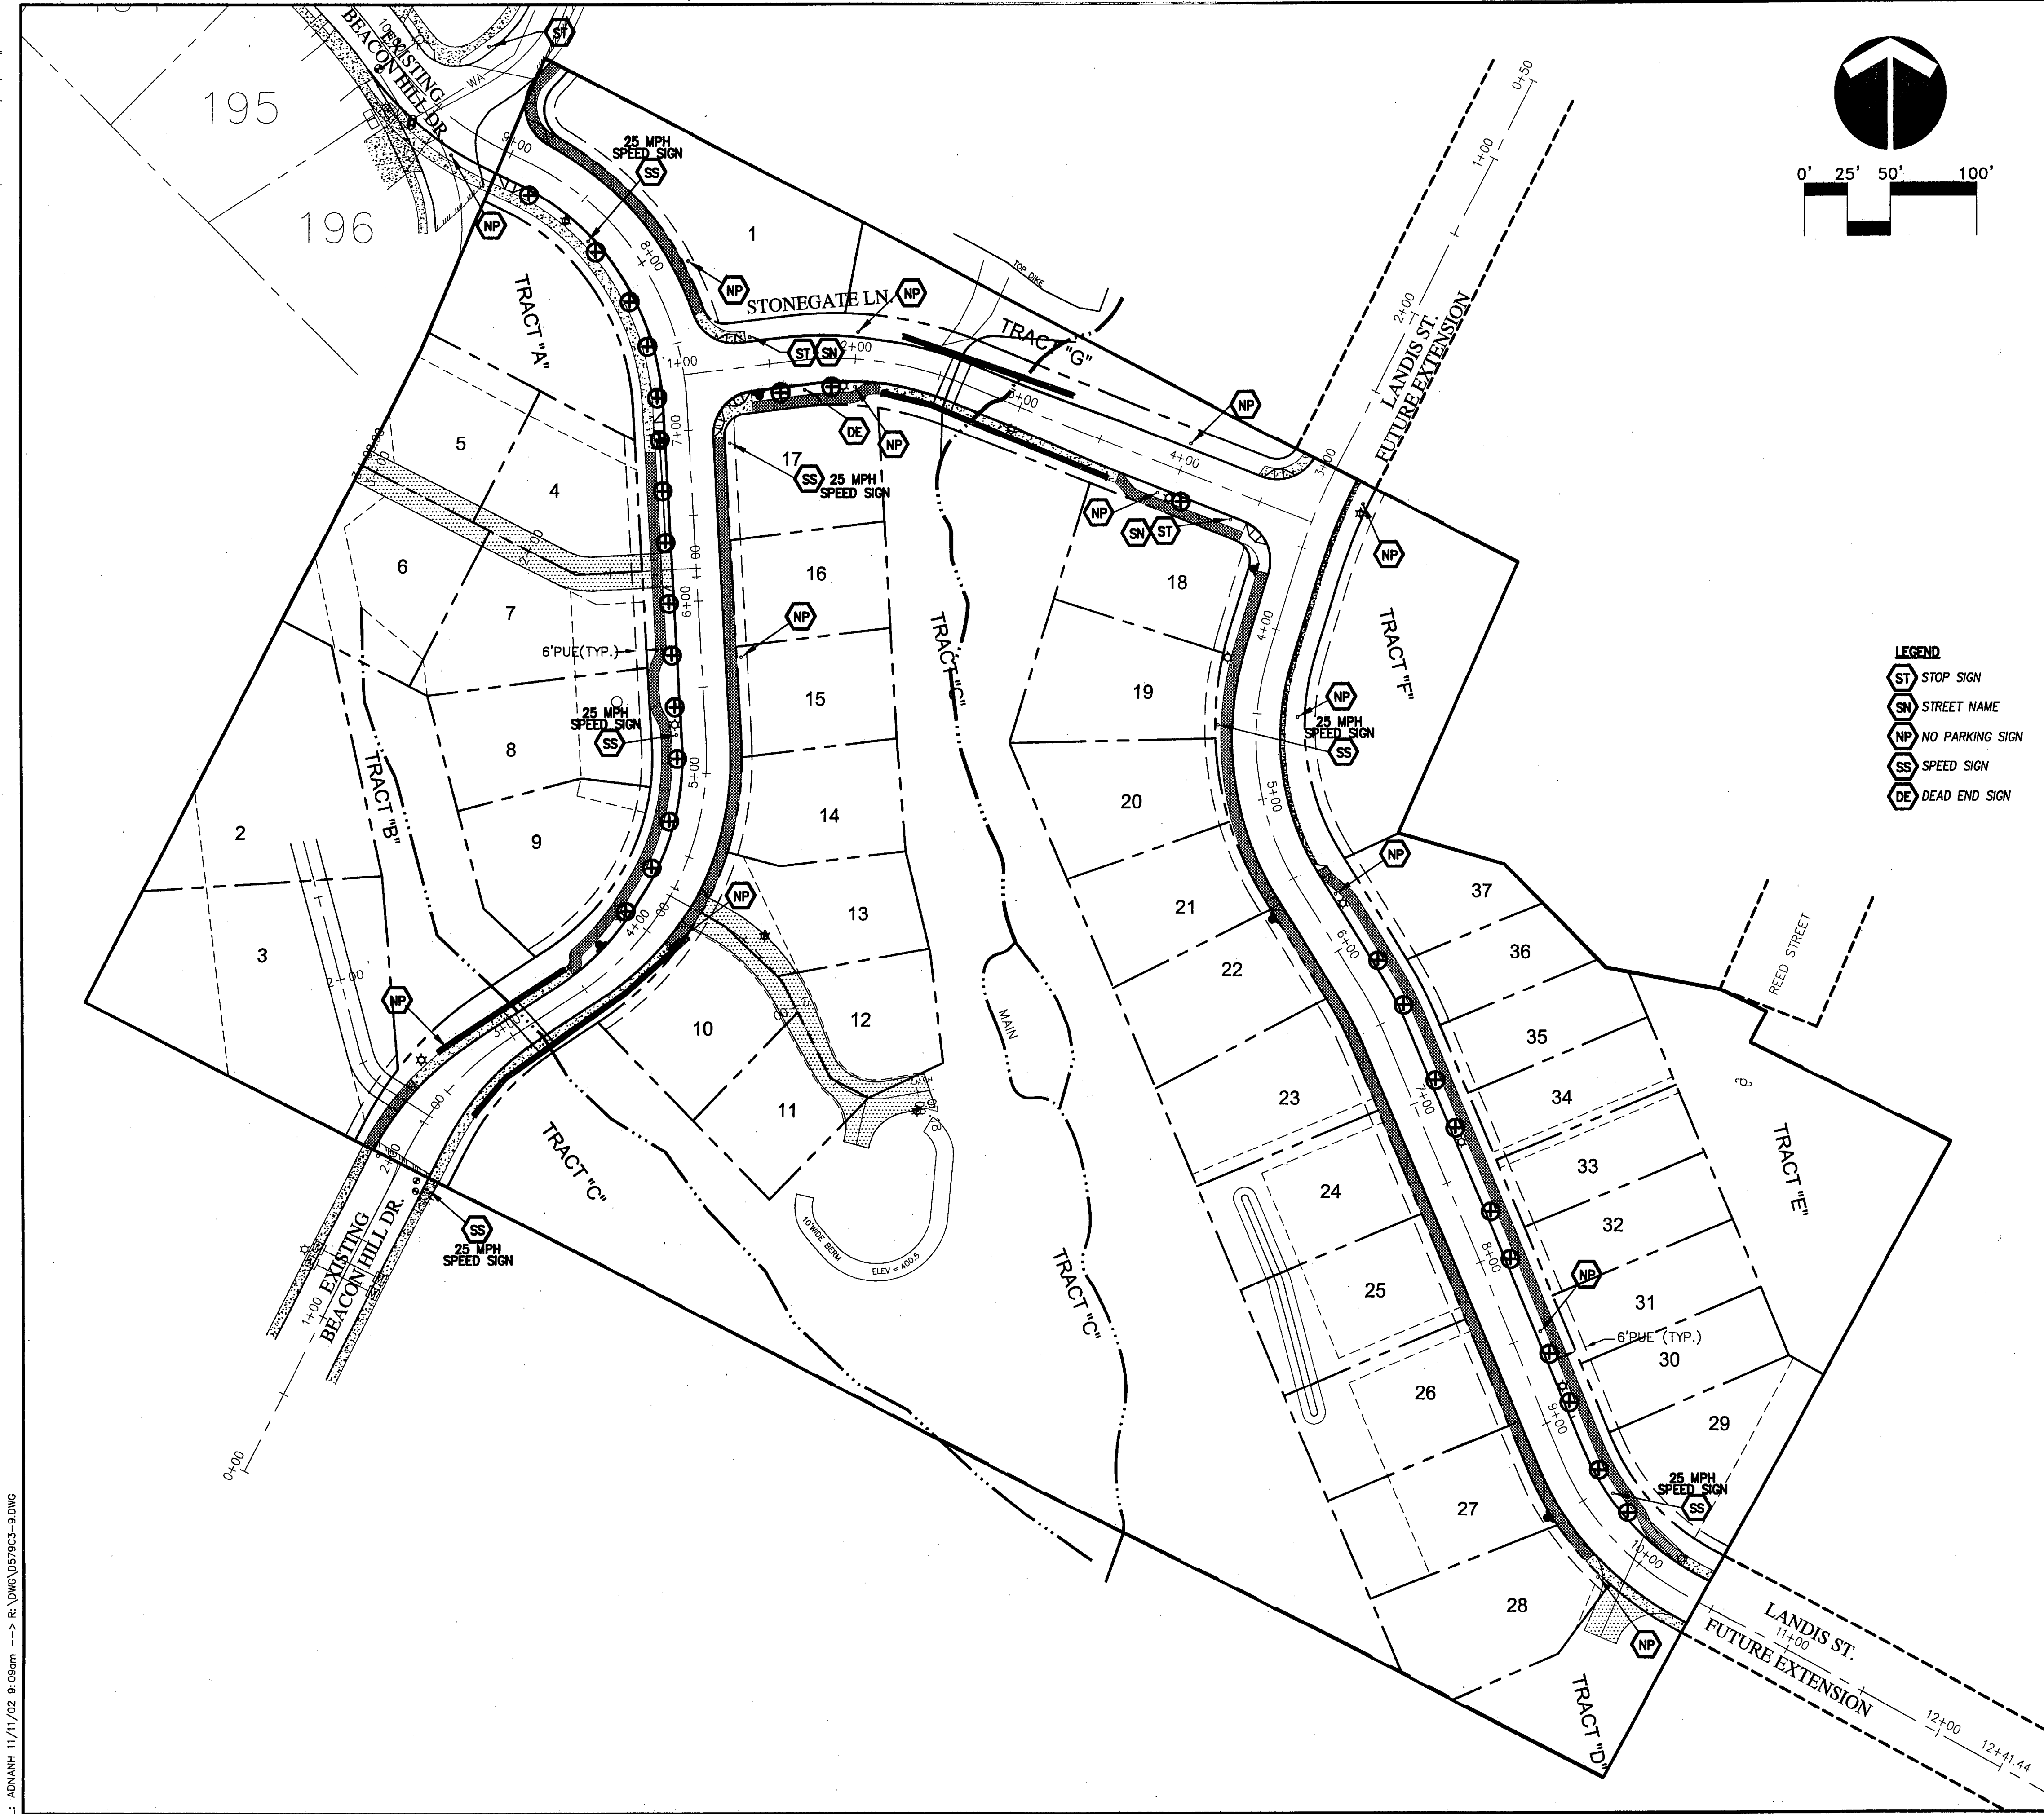

- LEGEND
- ST STOP SIGN
 - SN STREET NAME
 - NP NO PARKING SIGN
 - SS SPEED SIGN
 - DE DEAD END SIGN

LEGEND

- RIGHT-OF-WAY LINE
- FUTURE RIGHT-OF-WAY LINE
- PROPERTY LINE
- LOT LINE
- EASEMENT LINE
- TRANSITION ZONE LINE
- BUILDING SETBACK LINE
- STREET CENTERLINE
- TRAIL

EXISTING UTILITIES

- WA WATER
- STORM LINE
- SANITARY LINE
- SAN LINE TO BE ABANDONED IN PLACE
- SANITARY MANHOLE
- STORM MANHOLE
- STORM INLET
- WATER METER
- FIRE HYDRANT
- WATER VALVE
- STREET LIGHT
- EXISTING FENCE


PROPOSED UTILITIES

- SANITARY LINE
- SANITARY MANHOLE
- STORM LINE
- STORM DETENTION PIPE
- STORM MANHOLE
- STORM INLET
- WATER LINE
- FIRE HYDRANT ASSEMBLY
- WATER METER WITH CORP. STOP AT WATER MAIN
- WATER VALVE
- WATER BLOW-OFF ASSEMBLY
- WATER AIR-RELEASE ASSEMBLY
- STREET LIGHT

PLANT LIST

- ⊕ Raywood Ash
Fraxinus latifolia
1-1/2" caliper

Actual planting locations for each lot to be shown on the site plan when submitted for each individual residential building permit.

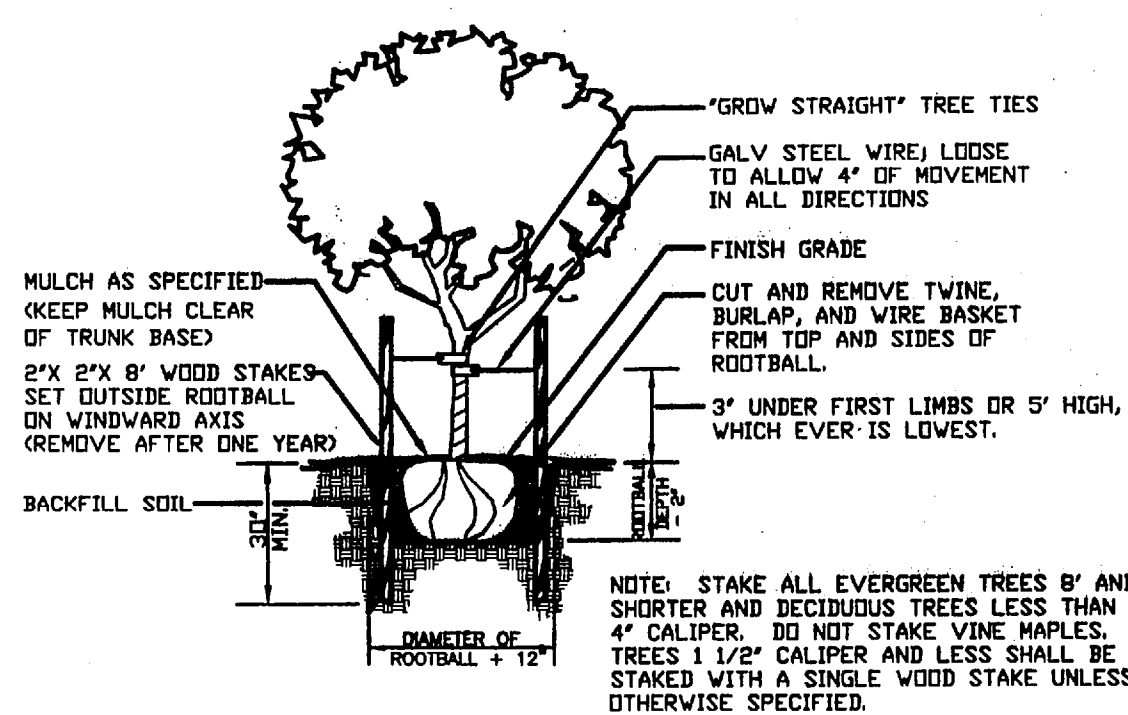

1 L-1 TREE PLANTING DETAIL

NOT TO SCALE

L: ADMANH 11/11/02 9:09am --> R: DWG/D579C3-9.DWG

AS BUILTS


08/21/2001
Date
AAH/BLW/JAH
Designed
AAH/BLW/JAH
Drawn
Checked By Date
REVISIONS
BY APPD.
DATE
NO
NORWAY DEVELOPMENT
P.O. Box 387
Oregon City, Oregon 97045
PHONE: (503) 656-7000
FAX: (503) 656-0686
RENEWAL 06/30/2003
REGISTERED PROFESSIONAL ENGINEER
46494PE
008800N
ADMAN ANIS HADAD

Tanner's Stonegate
CITY OF WEST LINN, OREGON
SIGNAGE PLAN & STREET TREE PLAN

otak
Incorporated
17355 SW Boones Ferry Road
Lake Oswego, OR 97035-5217
Phone: (503) 635-3818
FAX: (503) 635-5385

10579
Project No.
D579C3-9
File No.
C3.9
Sheet No.
Copyright 2001


XREF LIST
Ltscale: 1
Resolved
D579MAP
D579X001
D579X610
D579X620
D579X900

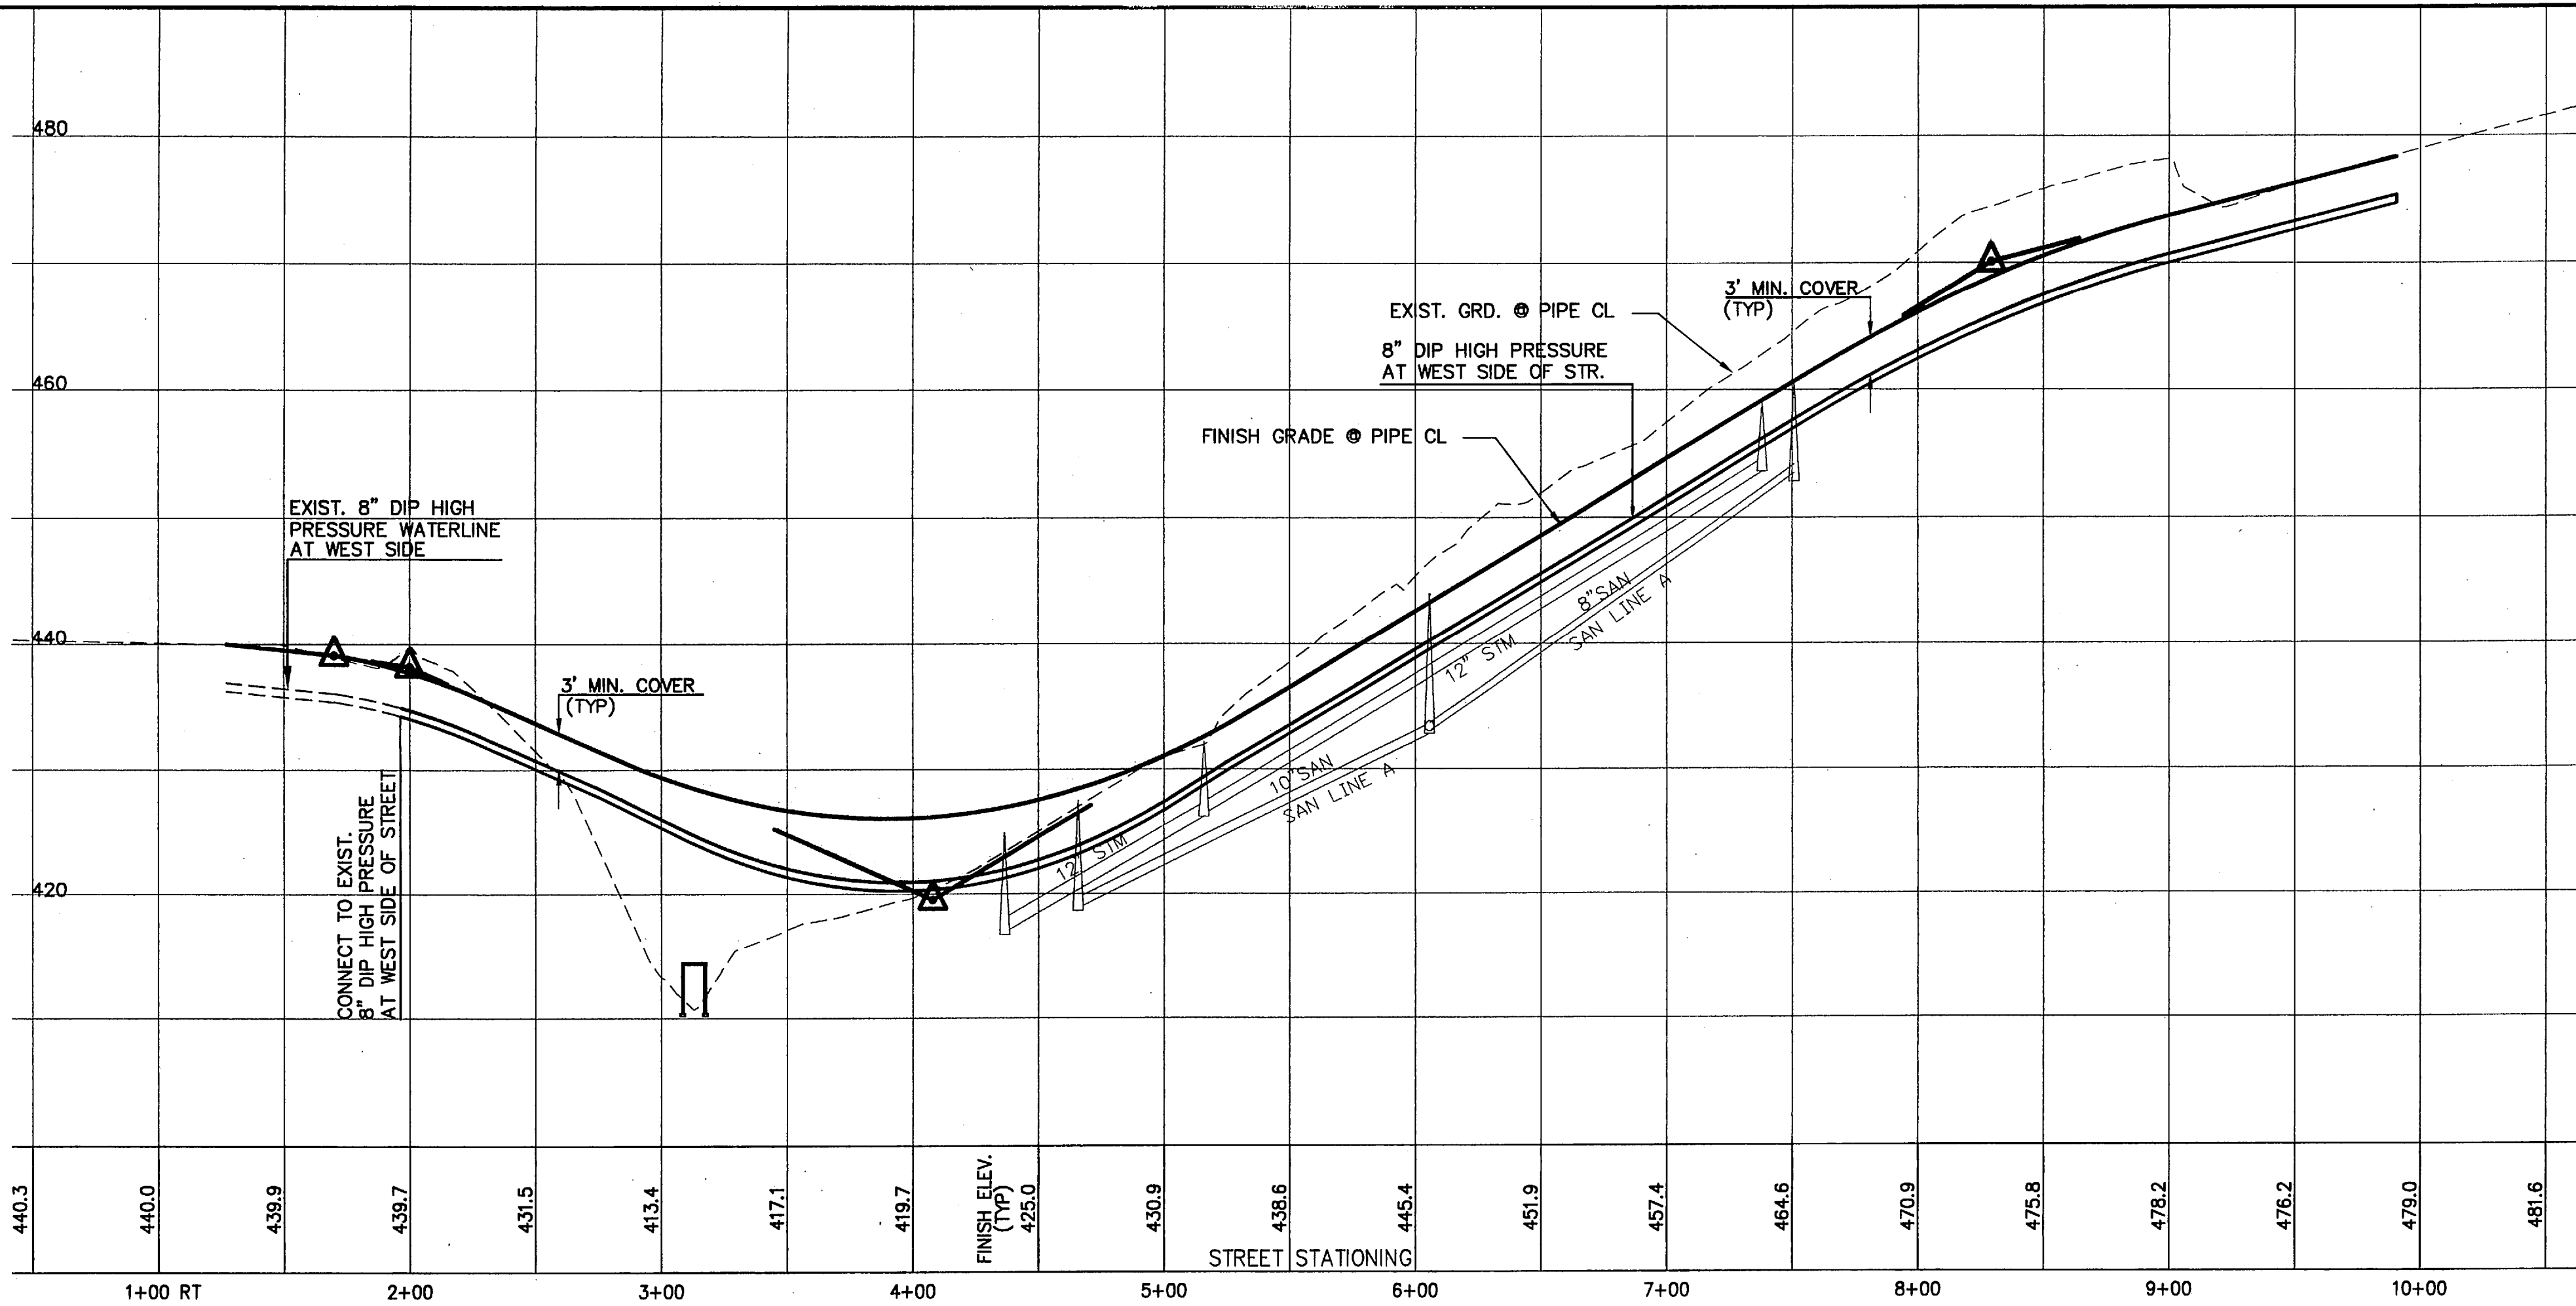

BEACON HILL DRIVE PROFILE

SCALE: HORIZONTAL 1"= 50'
VERTICAL 1"= 10'

1
C4.1

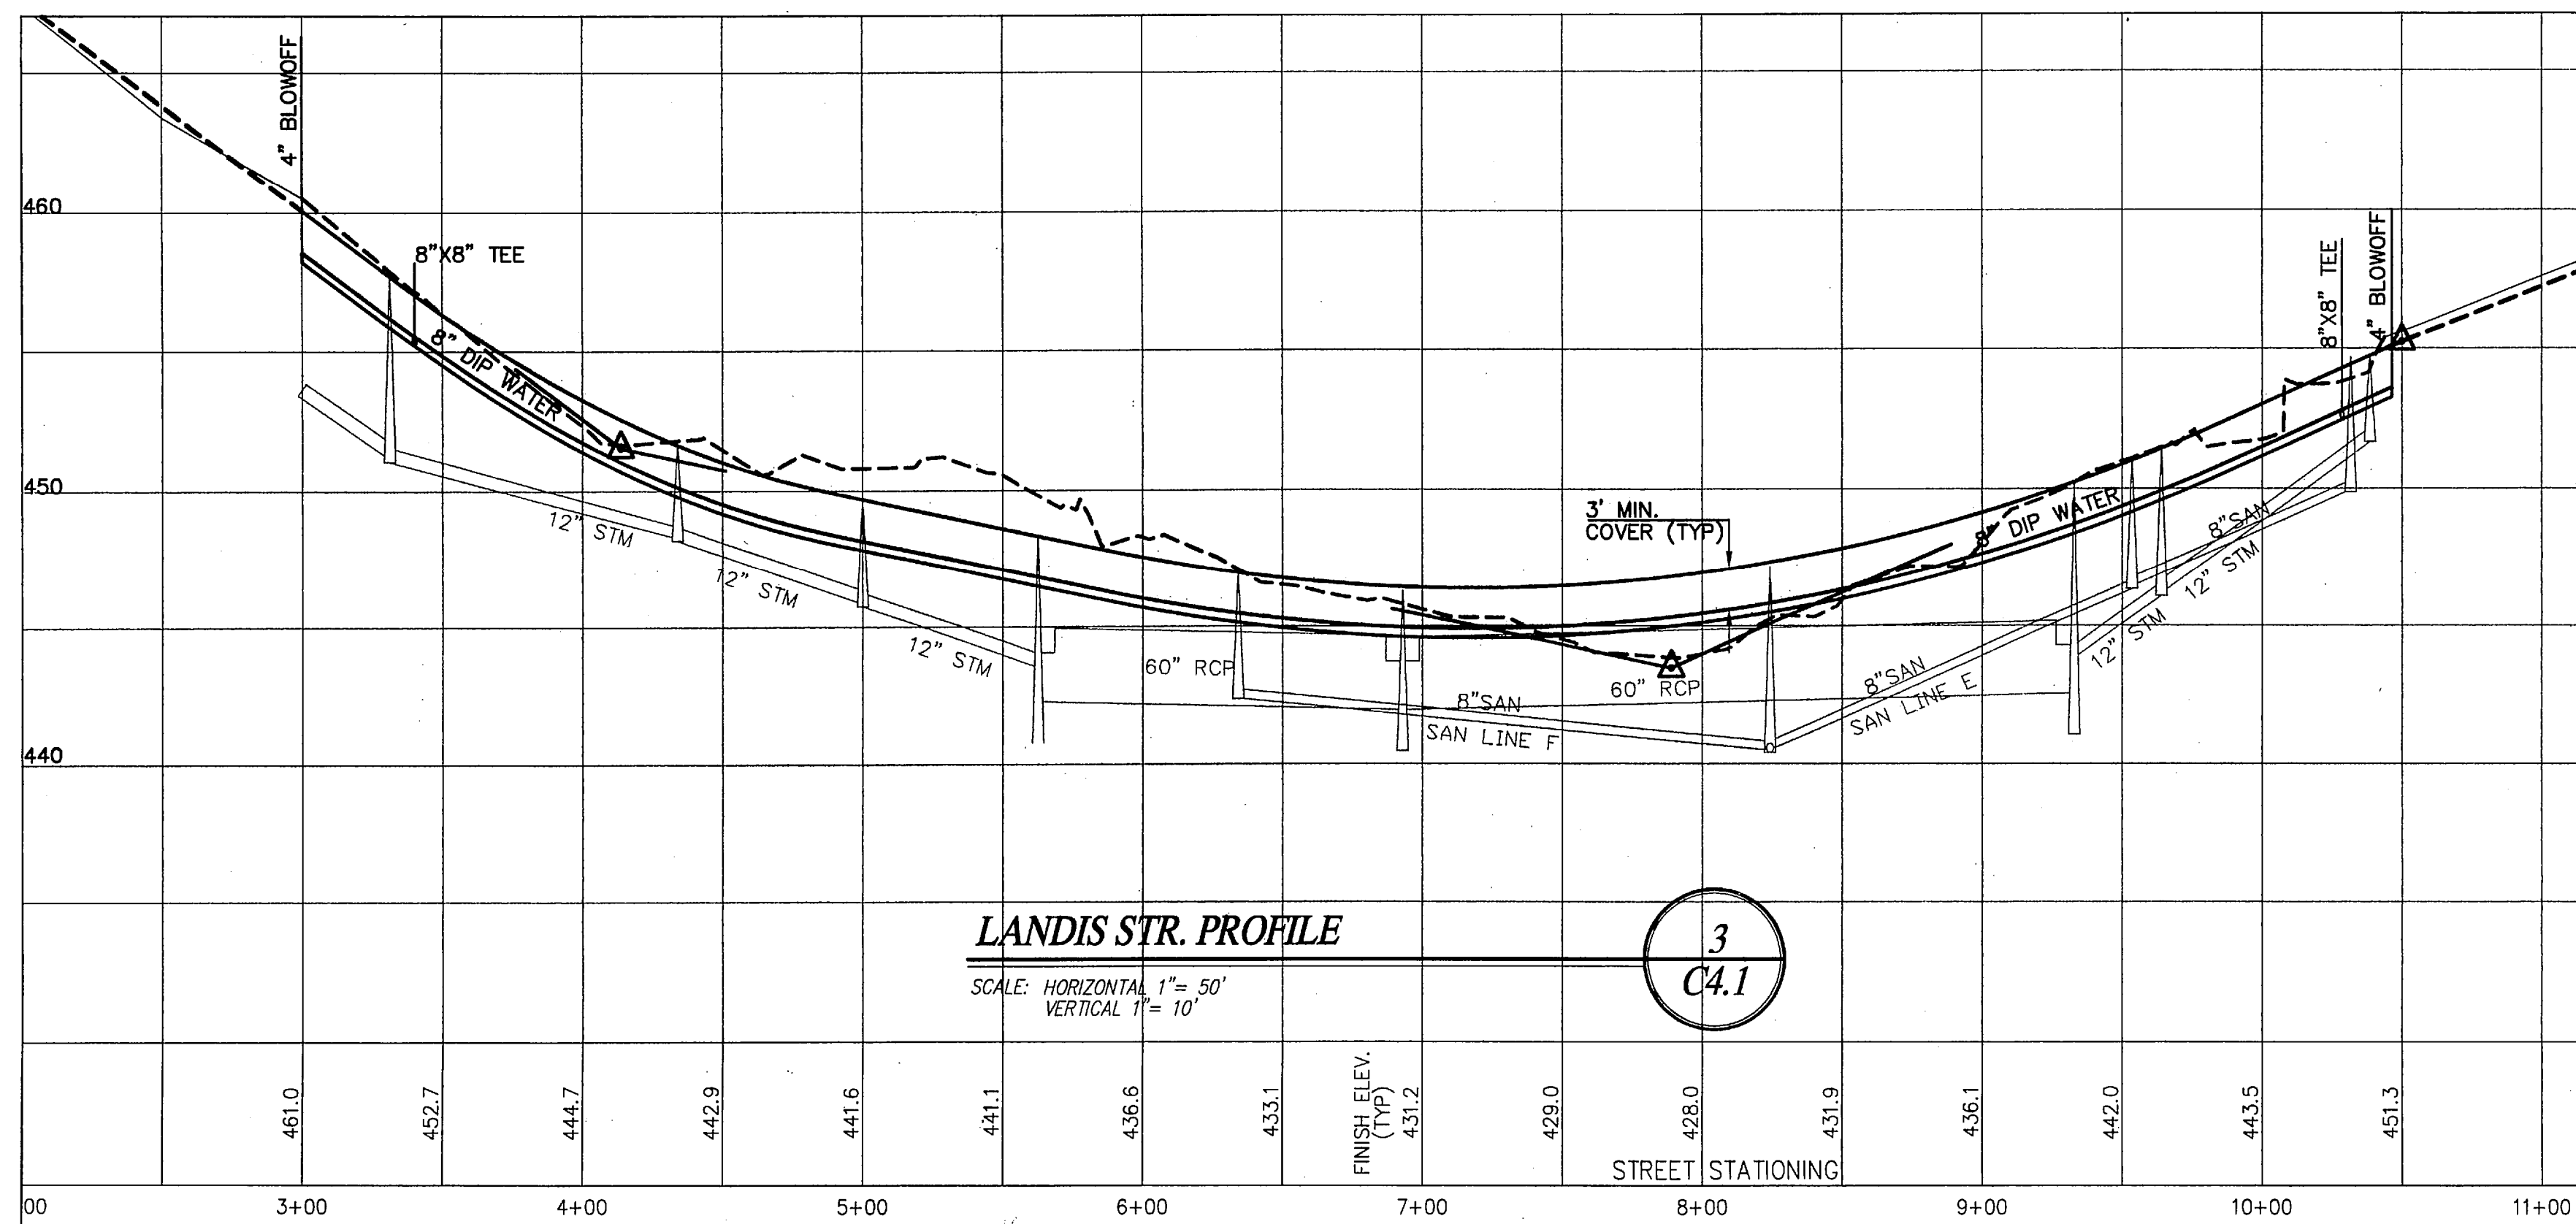


LANDIS STR. PROFILE

SCALE: HORIZONTAL 1"= 50'
VERTICAL 1"= 10'

3
C4.1


NOTE:
FOR WATERLINE AND SANITARY SEWER CONSTRUCTION NOTES, SEE SHEET C4.0

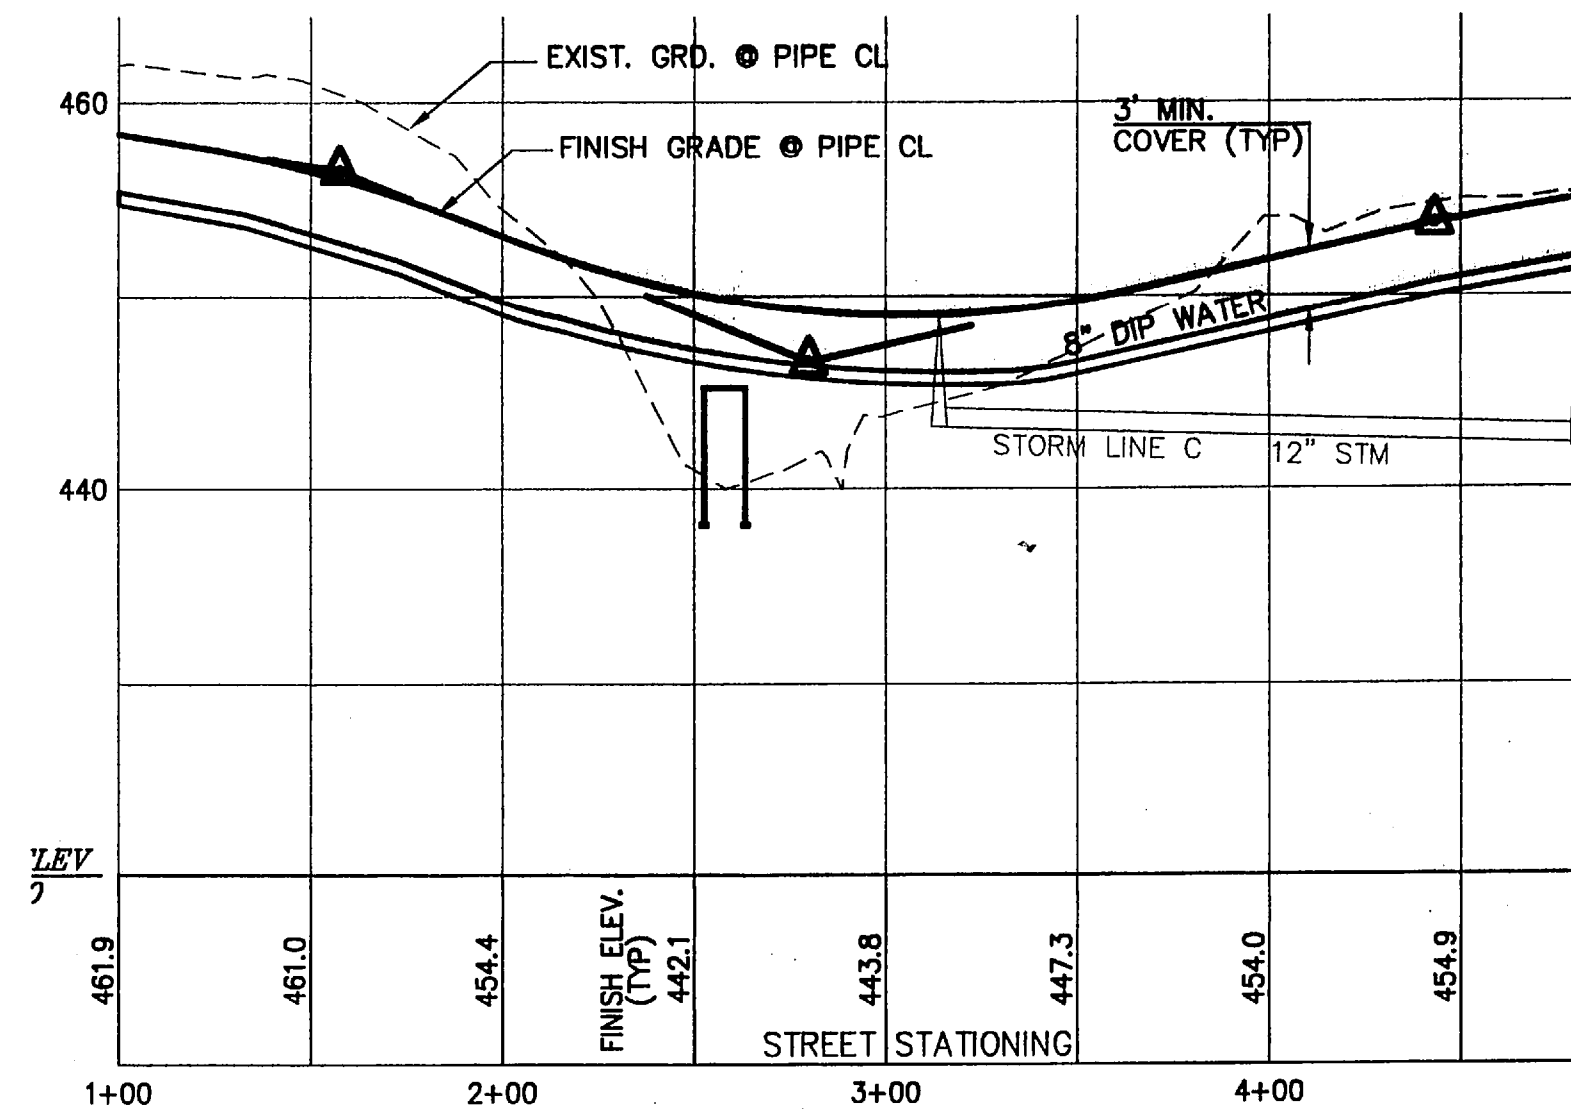

STONEGATE LANE PROFILE

SCALE: HORIZONTAL 1"= 50'
VERTICAL 1"= 10'

2
C4.1

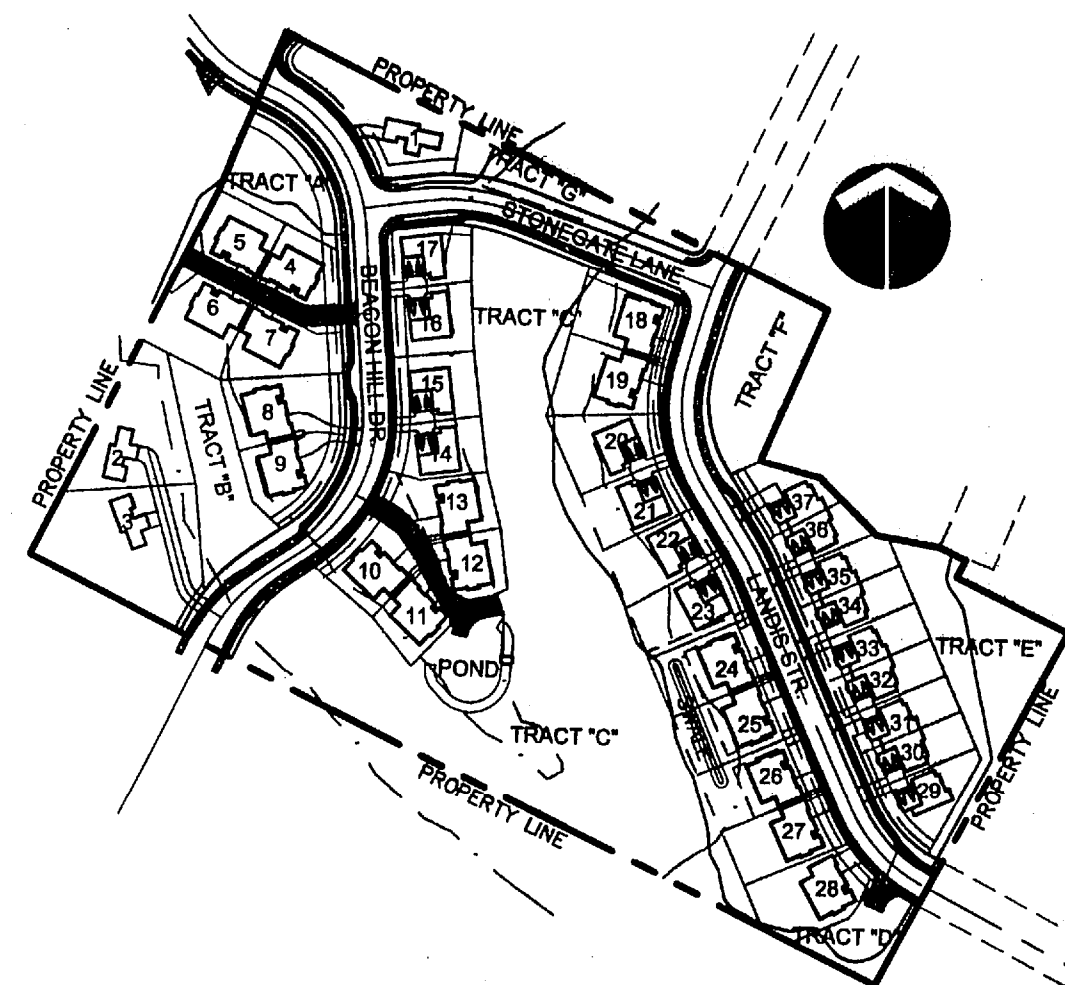

KEYMAP

SCALE: HORIZONTAL 1"= 200'

4
C4.1

08/21/2001
Date
AAH/BLW/JAH
Designed
AAH/BLW/JAH
Drawn
Checked By Date
REVISIONS
BY APPD.
DATE
NO.
REGISTERED PROFESSIONAL ENGINEER
40404PE
OREGON
DECEMBER 14, 2005
ADAM ANIS HADWIN
RENEWAL 06/30/2003
NORWAY DEVELOPMENT
P.O. Box 387
Oregon City, Oregon 97045
PHONE: (503) 656-7000
FAX: (503) 656-0686


Tanner's Stonegate
CITY OF WEST LINN, OREGON
WATERLINE PROFILE

otak
Incorporated
17355 SW Boones Ferry Road
Lake Oswego, OR 97035-6217
Phone: (503) 635-3818
FAX: (503) 635-5395

AS BUILTS

10579
Project No.
D579C4-1
File No.
C4.1
Sheet No.
Copyright 2001


XREF LIST
1:scale: 1
Resolved
D579MAP
D579X001
D579X190
D579X600
D579X610

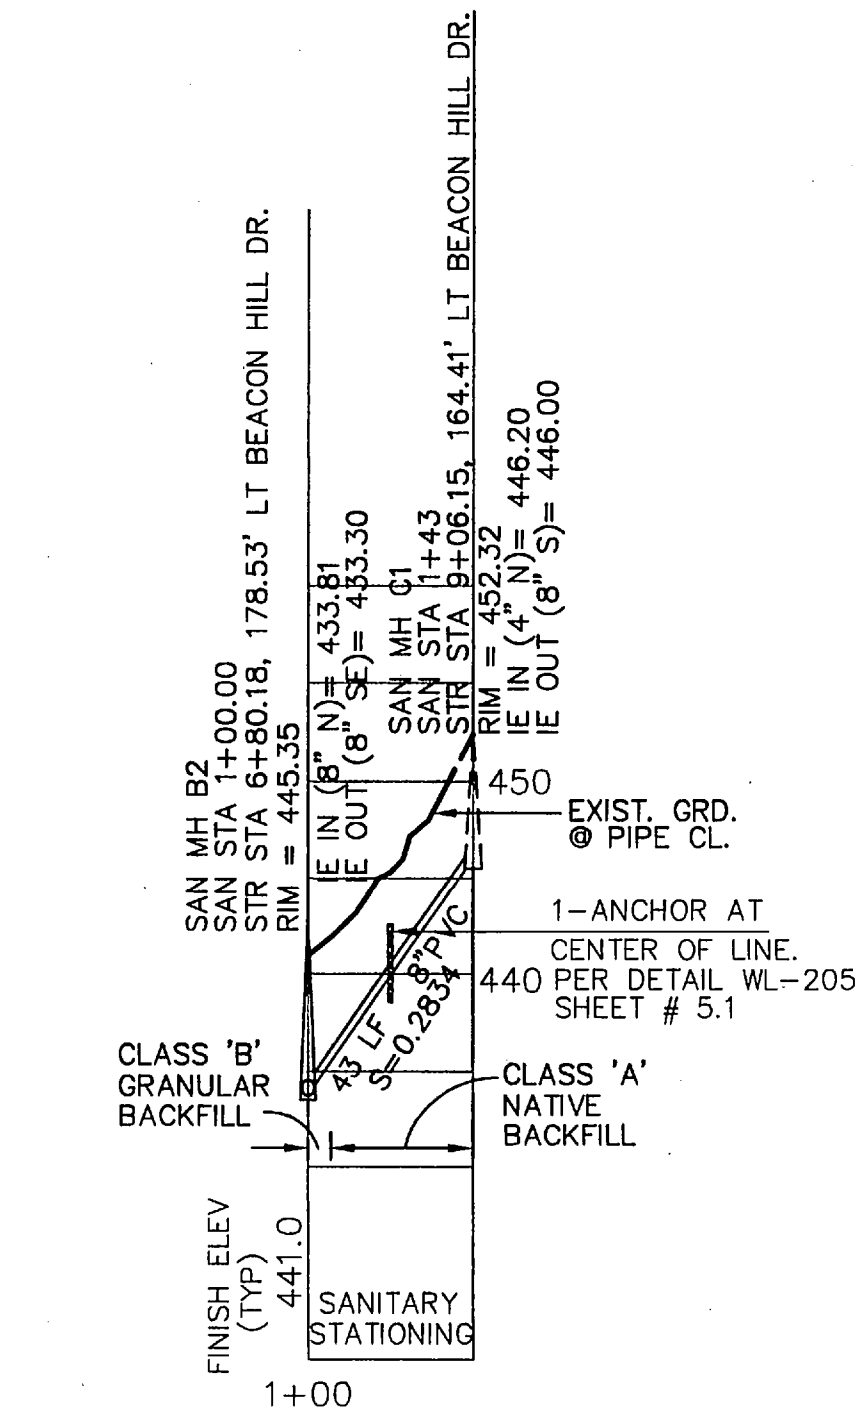

SANITARY LINE C PROFILE

SCALE: HORIZONTAL 1" = 50'
VERTICAL 1" = 10'

1
C4.2

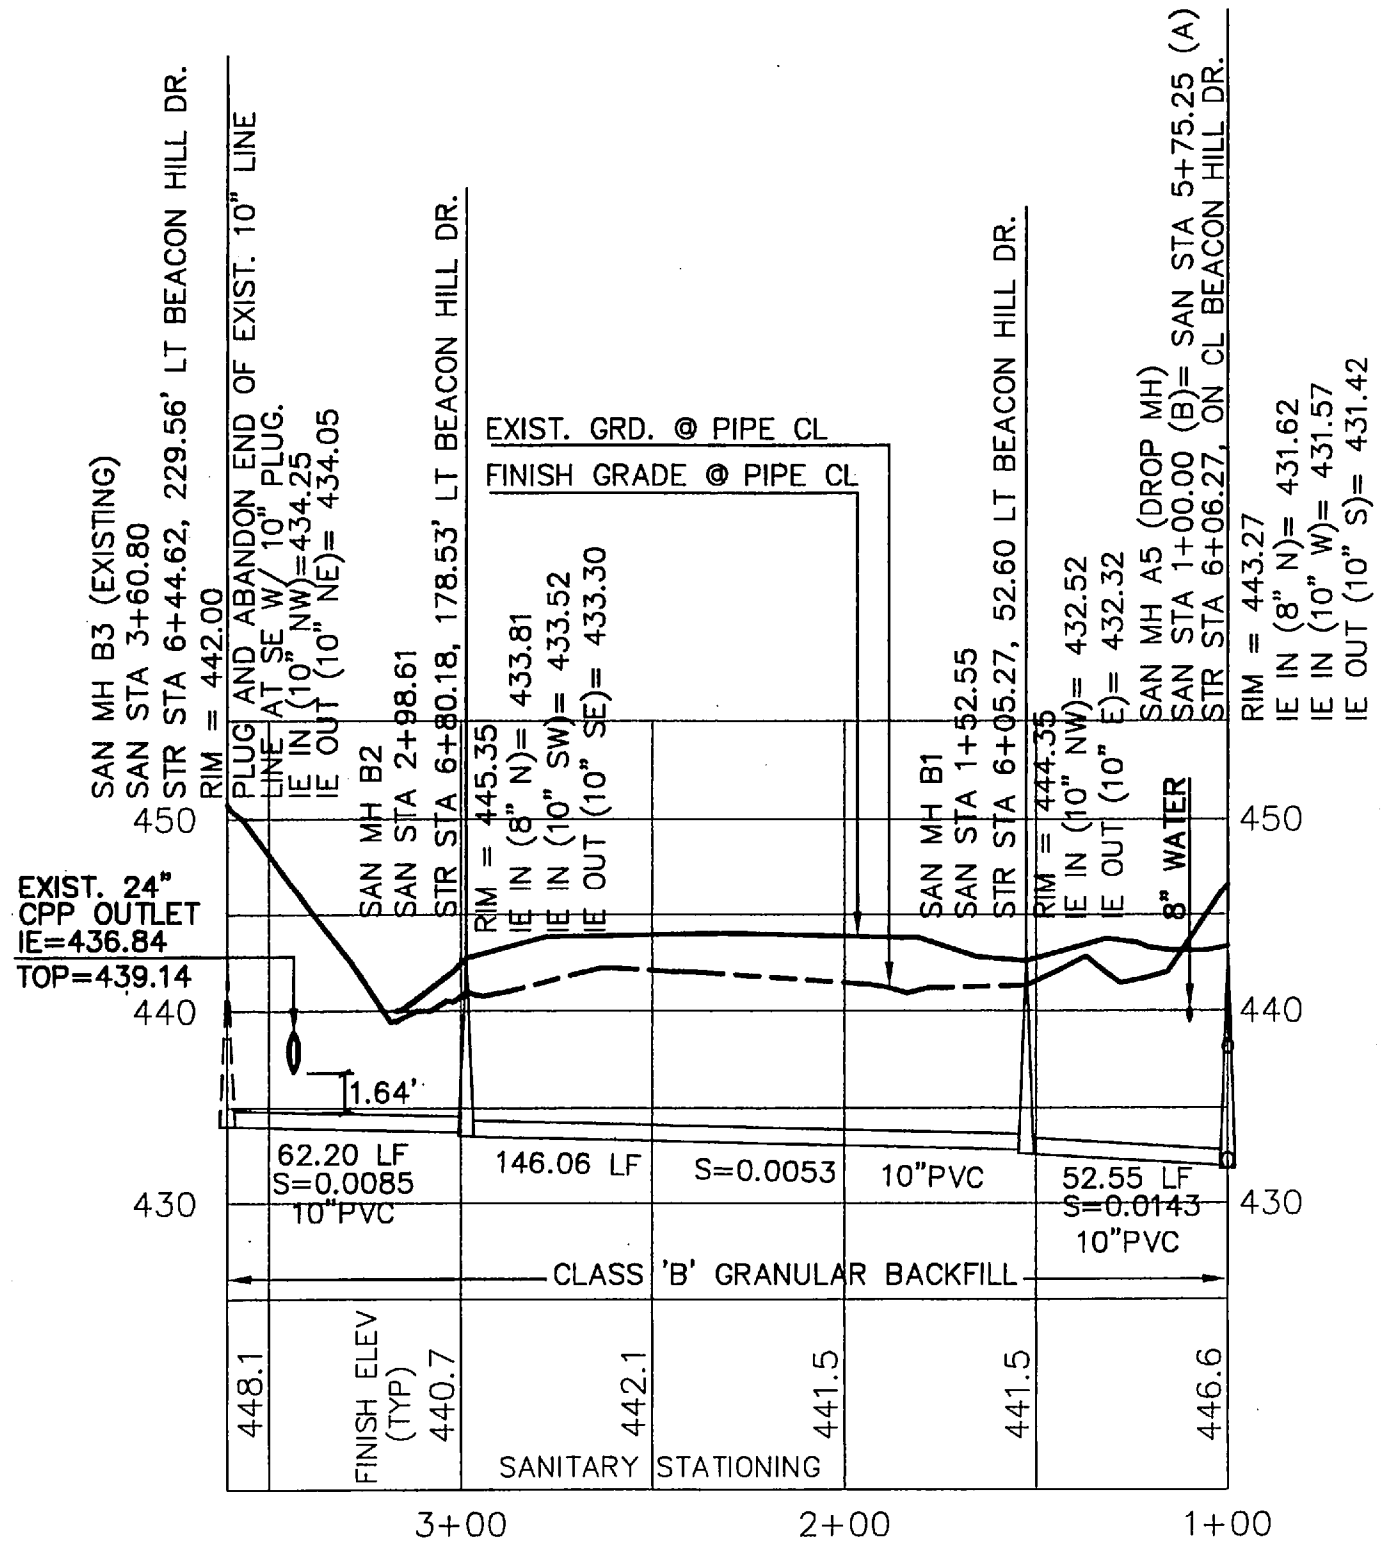


SANITARY LINE B PROFILE

SCALE: HORIZONTAL 1" = 50'
VERTICAL 1" = 10'

2
C4.2

NOTE:


- FOR WATERLINE AND SANITARY SEWER CONSTRUCTION NOTES, SEE SHEET C4.0

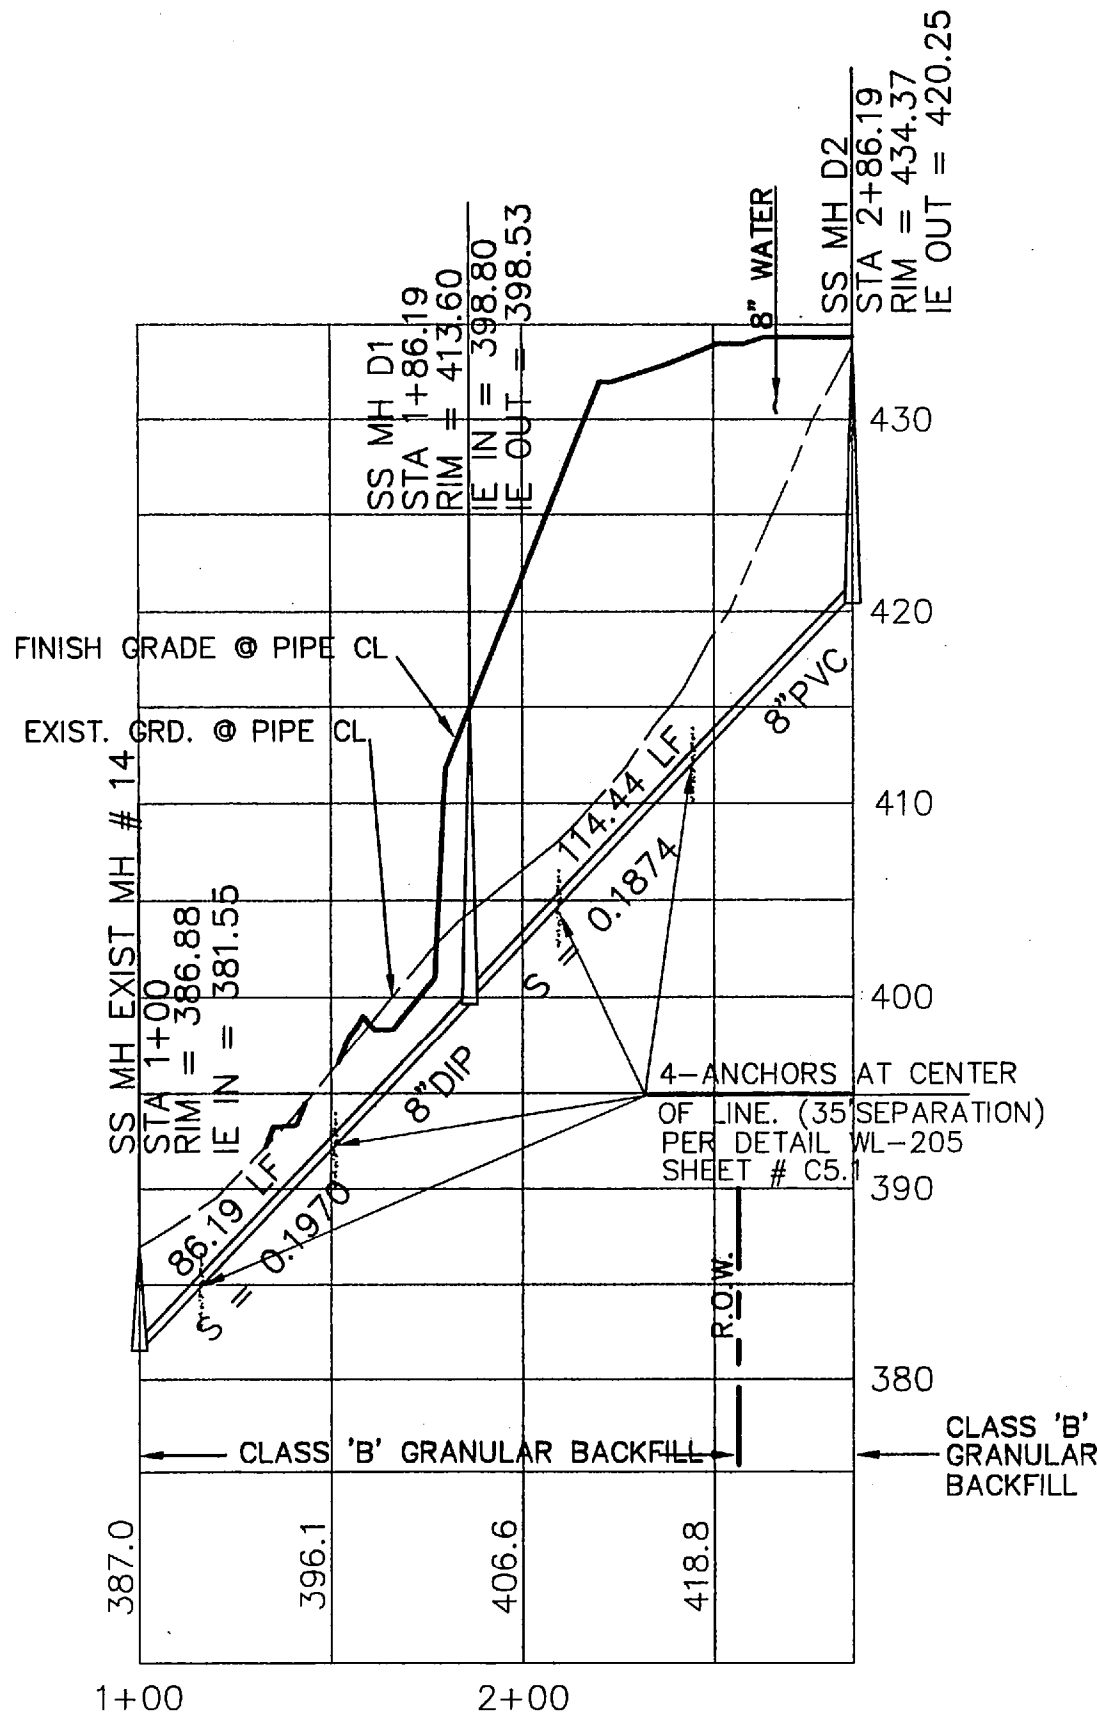

SANITARY LINE D PROFILE

SCALE: HORIZONTAL 1" = 50'
VERTICAL 1" = 10'


4
C4.2

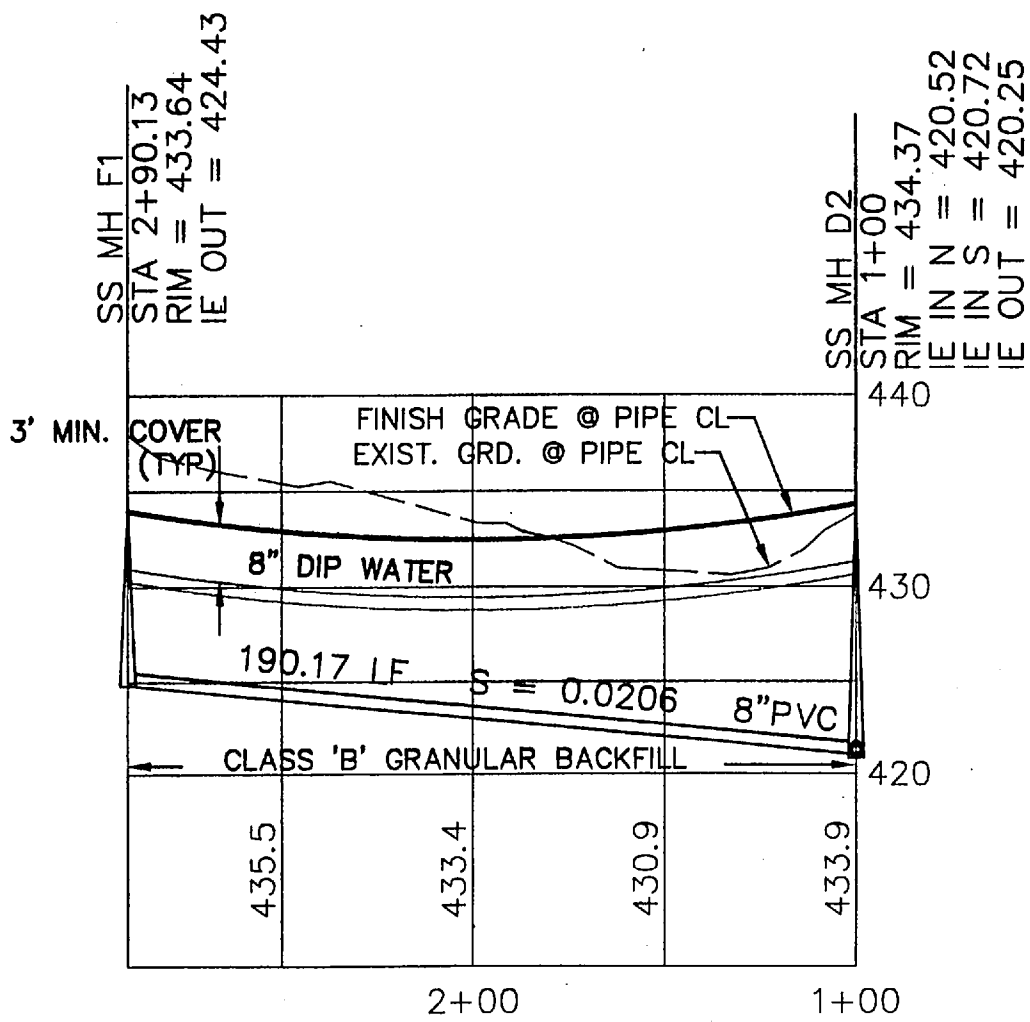

SANITARY LINE F PROFILE

SCALE: HORIZONTAL 1" = 50'
VERTICAL 1" = 10'


5
C4.2

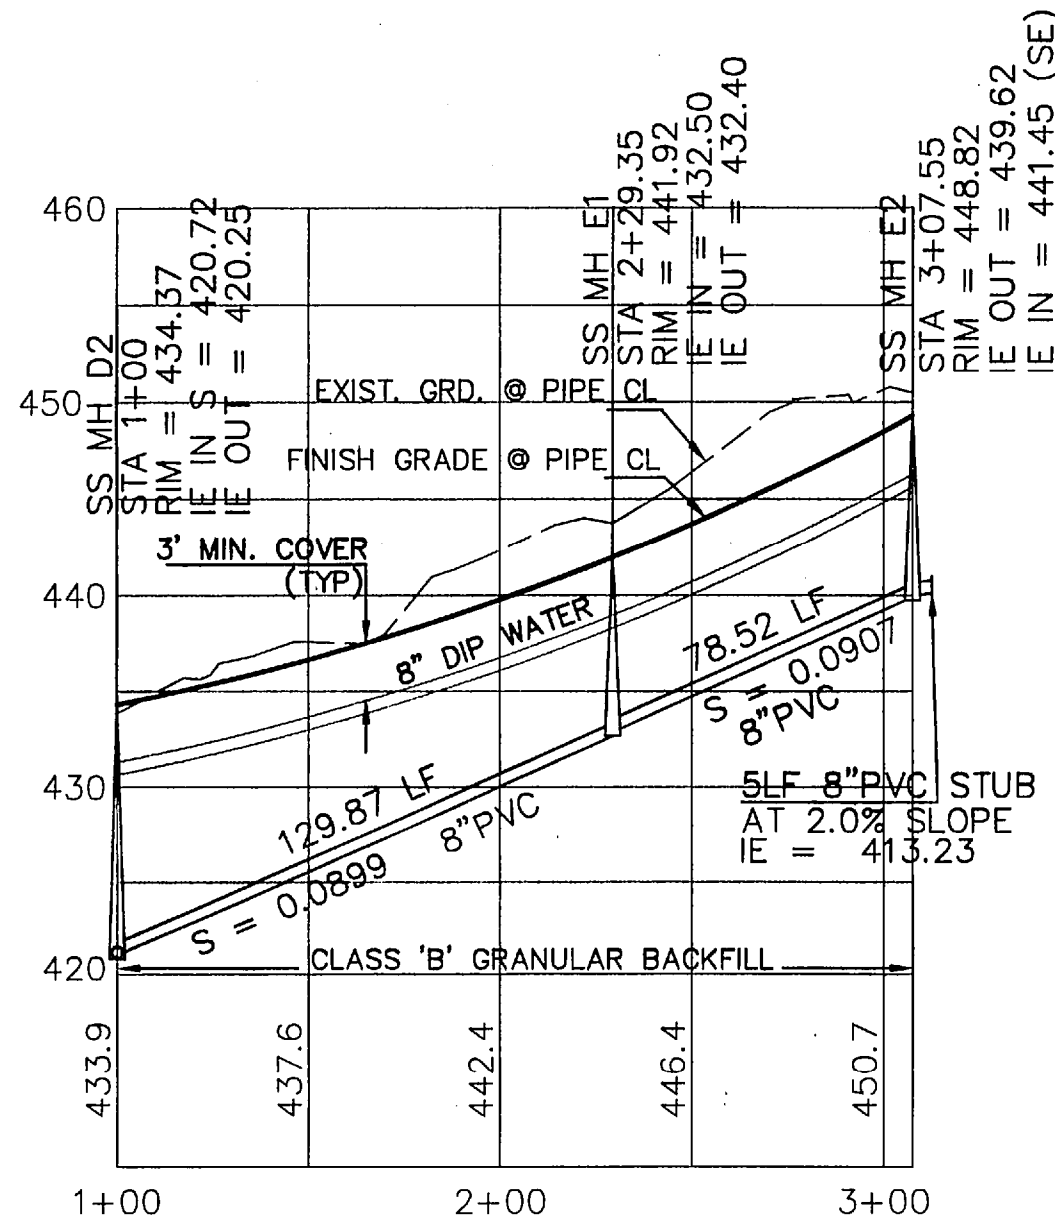

SANITARY LINE E PROFILE

SCALE: HORIZONTAL 1" = 50'
VERTICAL 1" = 10'


6
C4.2

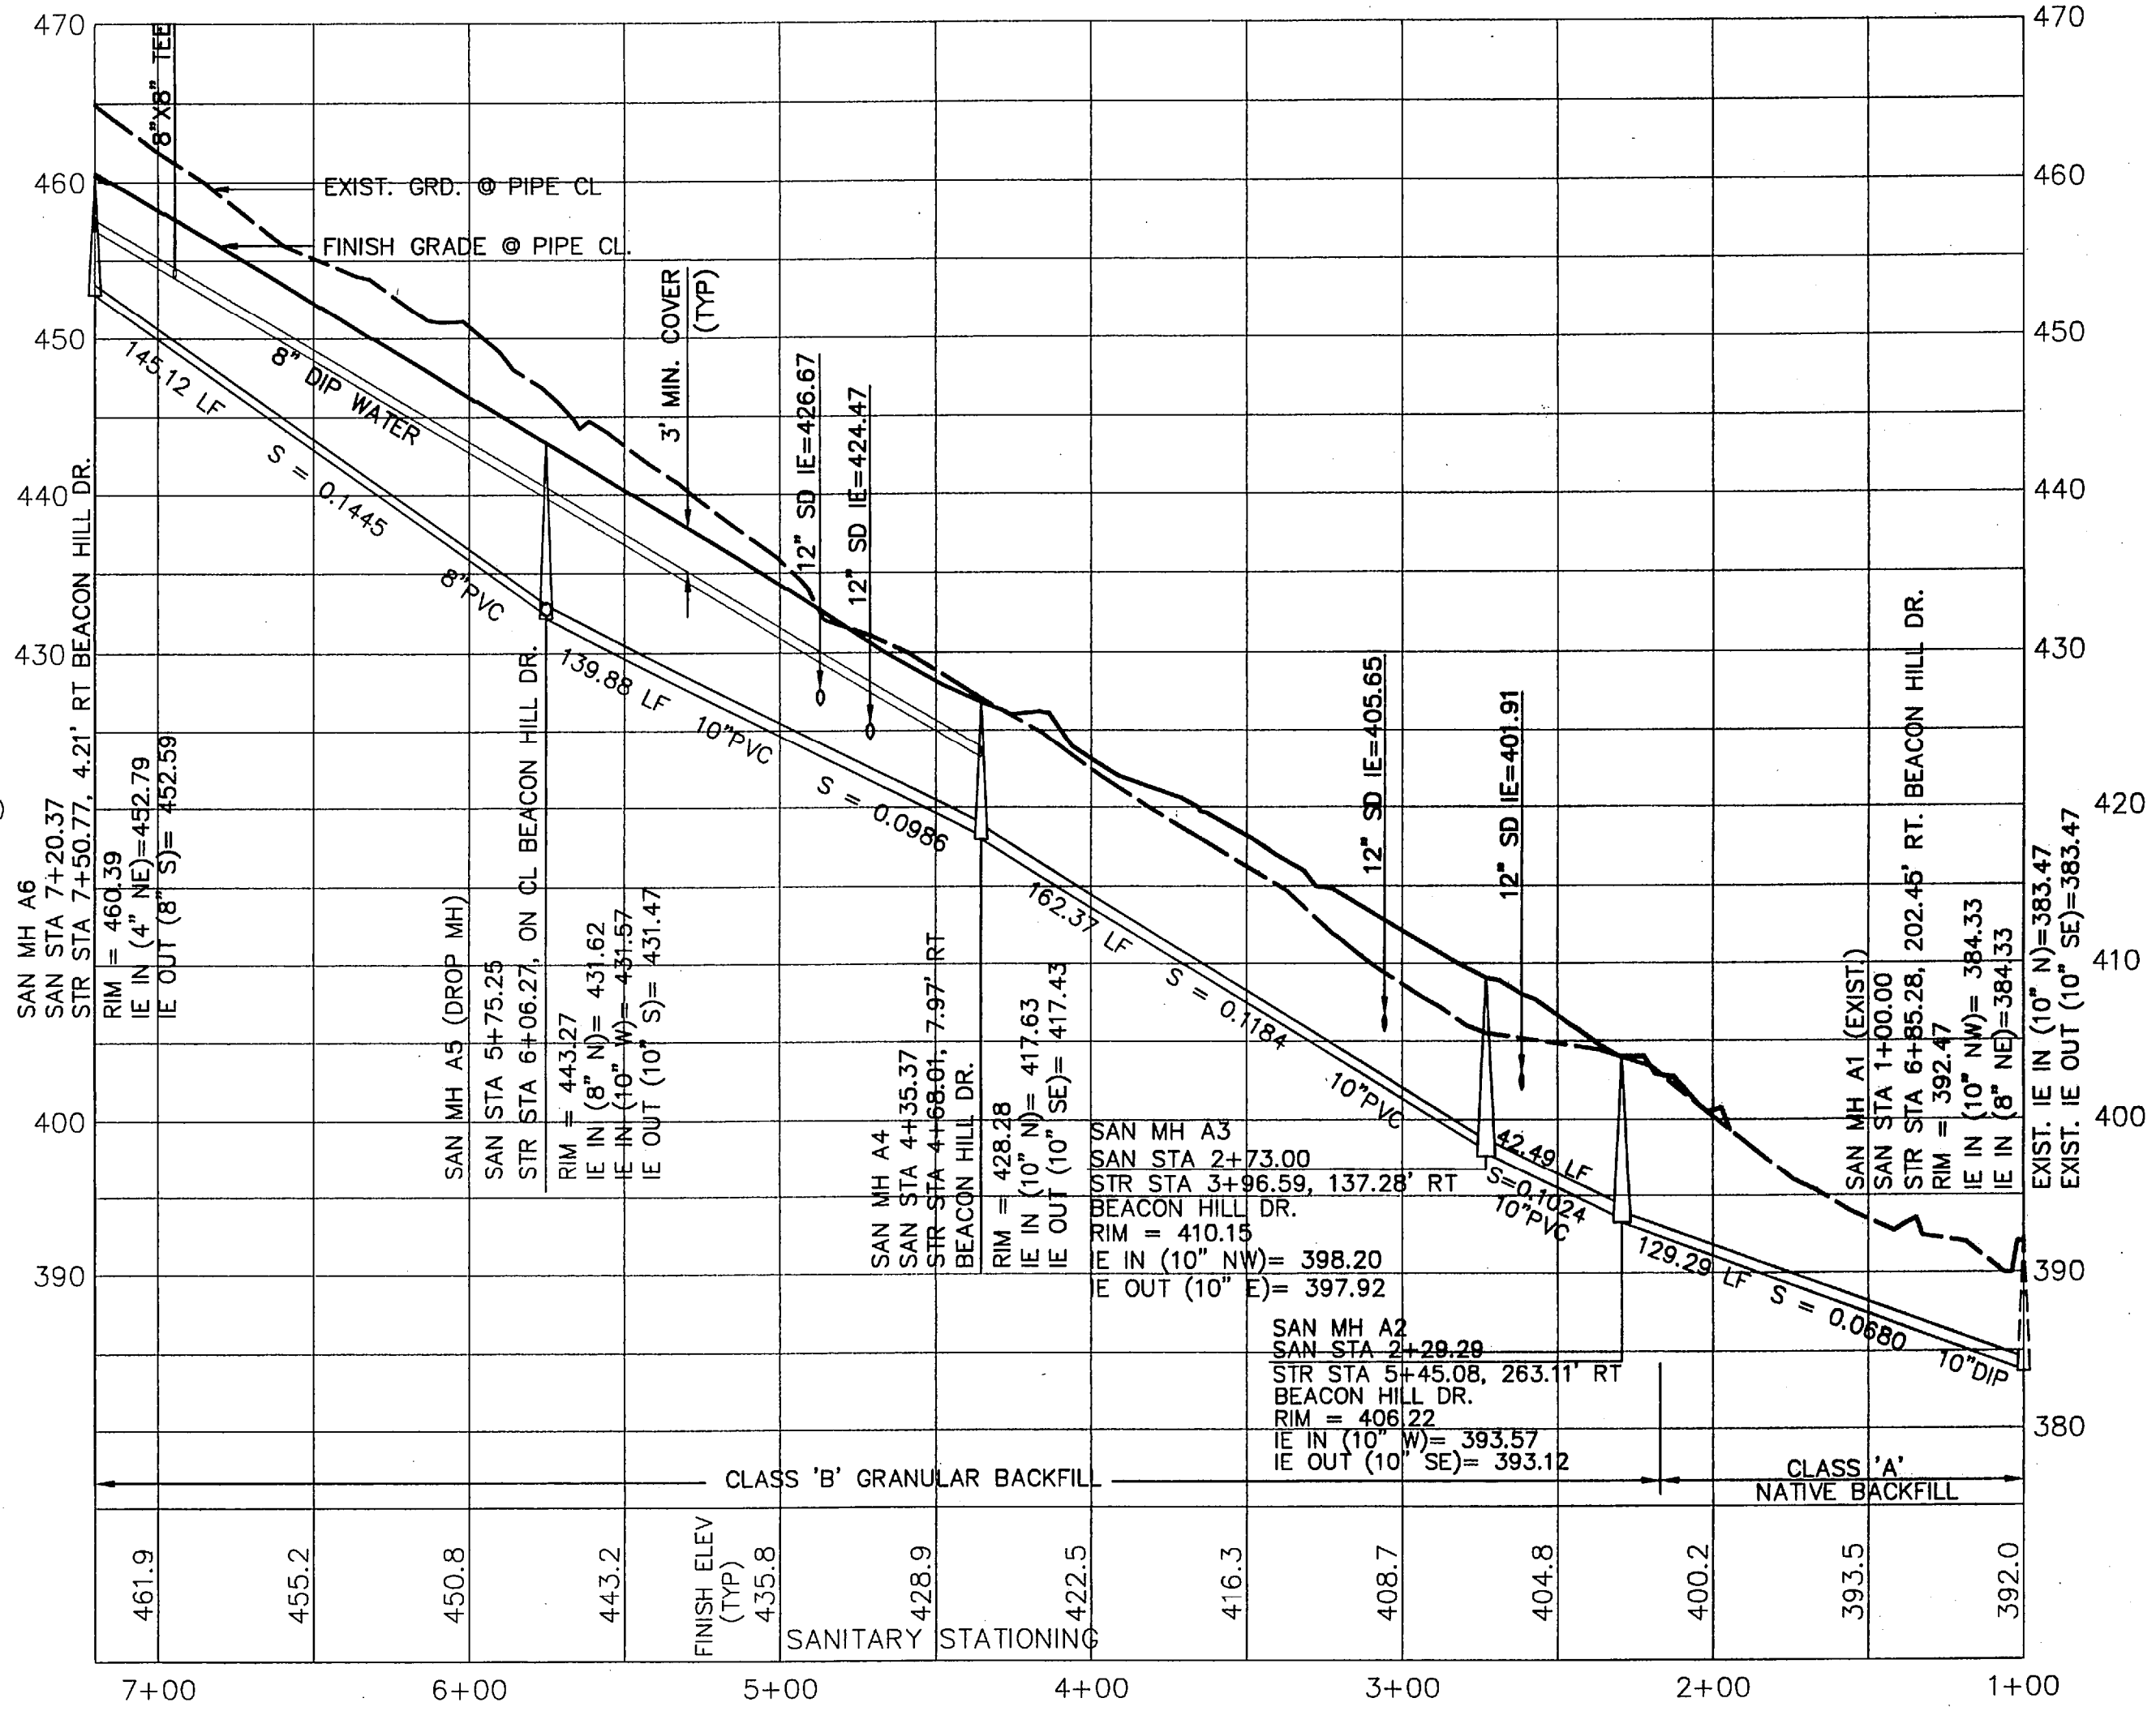

SANITARY LINE A PROFILE

SCALE: HORIZONTAL 1" = 50'
VERTICAL 1" = 10'

3
C4.2

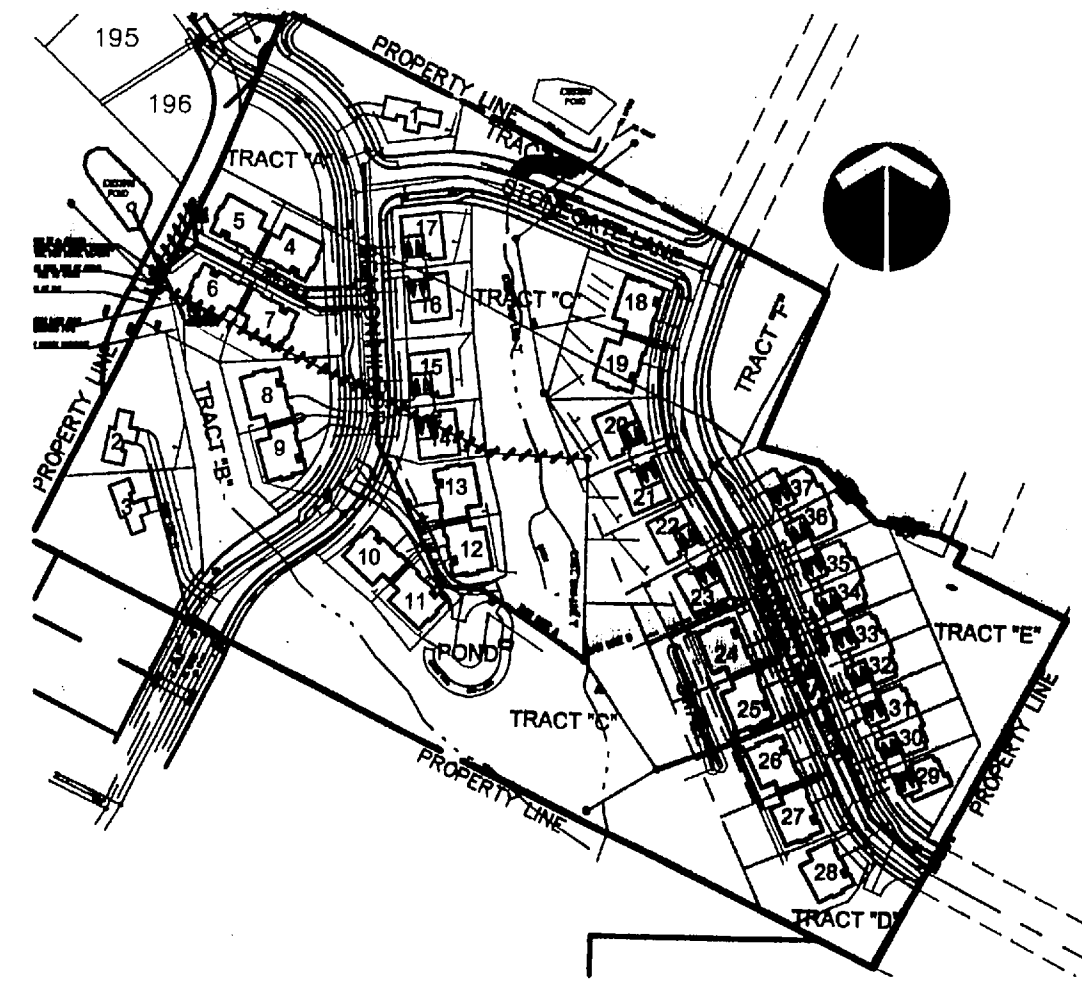

KEYMAP

SCALE: HORIZONTAL 1" = 200'

8
C4.2


08/21/2001
Date
AAH/BLW/JAH
Designed
AAH/BLW/JAH
Drawn
Checked By Date
REVISIONS
NO. DATE BY APPD.
REGISTERED PROFESSIONAL
ENGINEER
40494PE
OREGON
JANAN ANIS HADIAN
RENEWAL 06/30/2003

NORWAY DEVELOPMENT
P.O. Box 387
Oregon City, Oregon 97045
PHONE: (503) 656-7000
FAX: (503) 656-0666

Tanner's Stonegate
CITY OF WEST LINN, OREGON
SANITARY SEWER AND WATER PROFILES


otak
Incorporated
17955 SW Boones Ferry Road
Lake Oswego, OR 97035-5817
Phone: (503) 655-3818
FAX: (503) 655-5395

AS BUILTS
10579
Project No.
D579C4-2
File No.
C4.2
Sheet No.
Copyright 2001

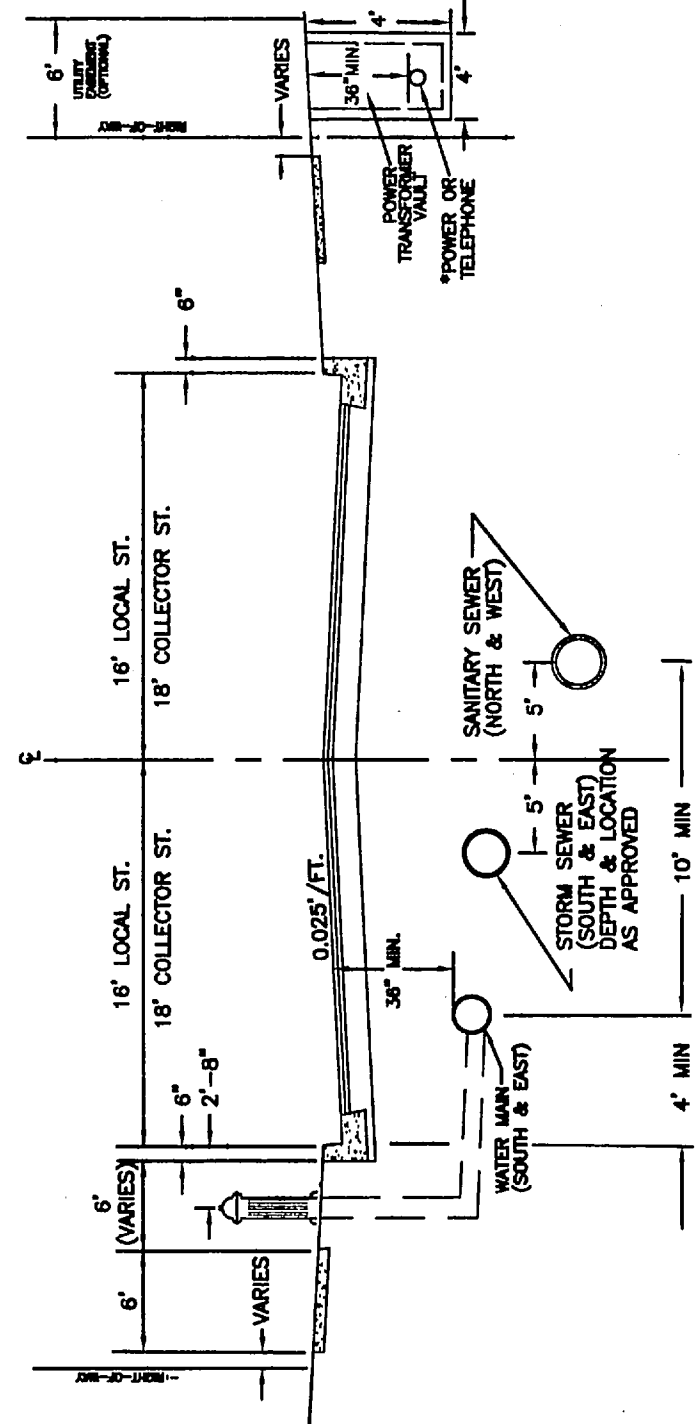


Typical Utility
Placement Detail

*West
Linn*
DATE: JAN 2000
DRAWING NO. WL-500
FILE NO. 00-500

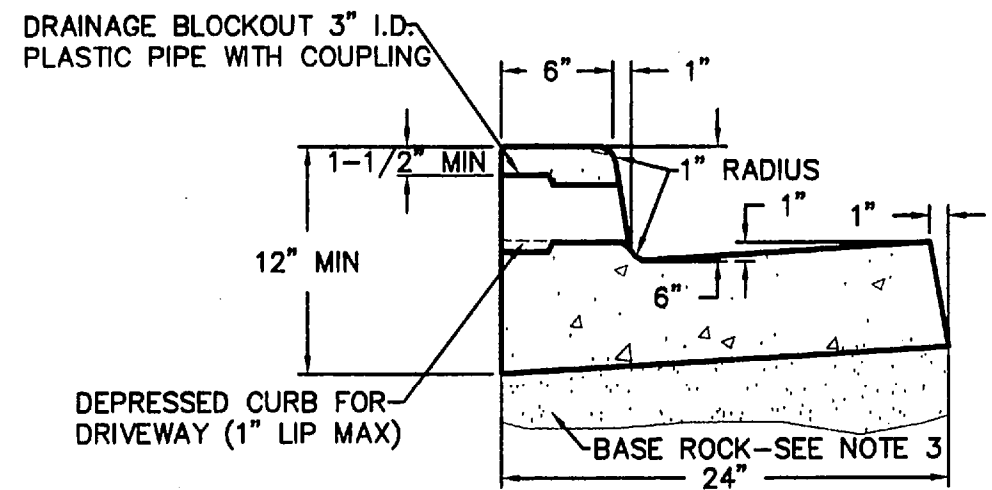

TYPICAL CURB & GUTTER

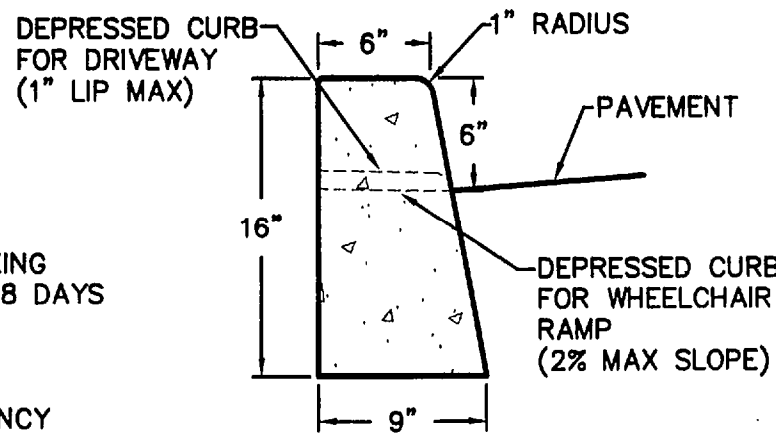


TYPICAL STRAIGHT CURB

- NOTES:
1. CONCRETE SHALL HAVE A BREAKING STRENGTH OF 3300 PSI AFTER 28 DAYS
 2. CONTRACTION JOINTS
A) TO BE PROVIDED
-AT EACH POINT OF TANGENCY
-AT EACH COLD JOINT
-AT EACH SIDE OF INLET STRUCTURES
-AT BOTH SIDES OF AN APPROACH
B) SPACING TO BE NOT MORE THAN 15 FEET
C) THE DEPTH OF THE JOINT SHALL BE AT LEAST 1/3 OF THE THICKNESS OF CONCRETE
D) EXPANSION JOINTS SHALL NOT BE USED
 3. BASE ROCK - 1-1/2\"-0\", 95% COMPACTION ROCK SHALL BE TO SUBGRADE OF THE STREET SECTION OR 4\" IN DEPTH, WHICHEVER IS GREATER
 4. DRAINAGE BLOCK - 3\" DIA. PLASTIC PIPE
A) DRAINAGE ACCESS THROUGH EXISTING CURBS SHALL BE DONE BY:
-CORE DRILLING
-VERTICAL SAWCUT OF CURB 18\" EACH SIDE OF DRAIN AND RE-POURED TO FULL DEPTH OF CURB
 5. STAMP TOP OF CURB WITH \"W\" AT WATER SERVICE CROSSING AND \"S\" AT SANITARY LATERAL CROSSING


Typical Curbs

*West
Linn*
DATE: JAN 2000
DRAWING NO. WL-501
FILE NO. 00-501

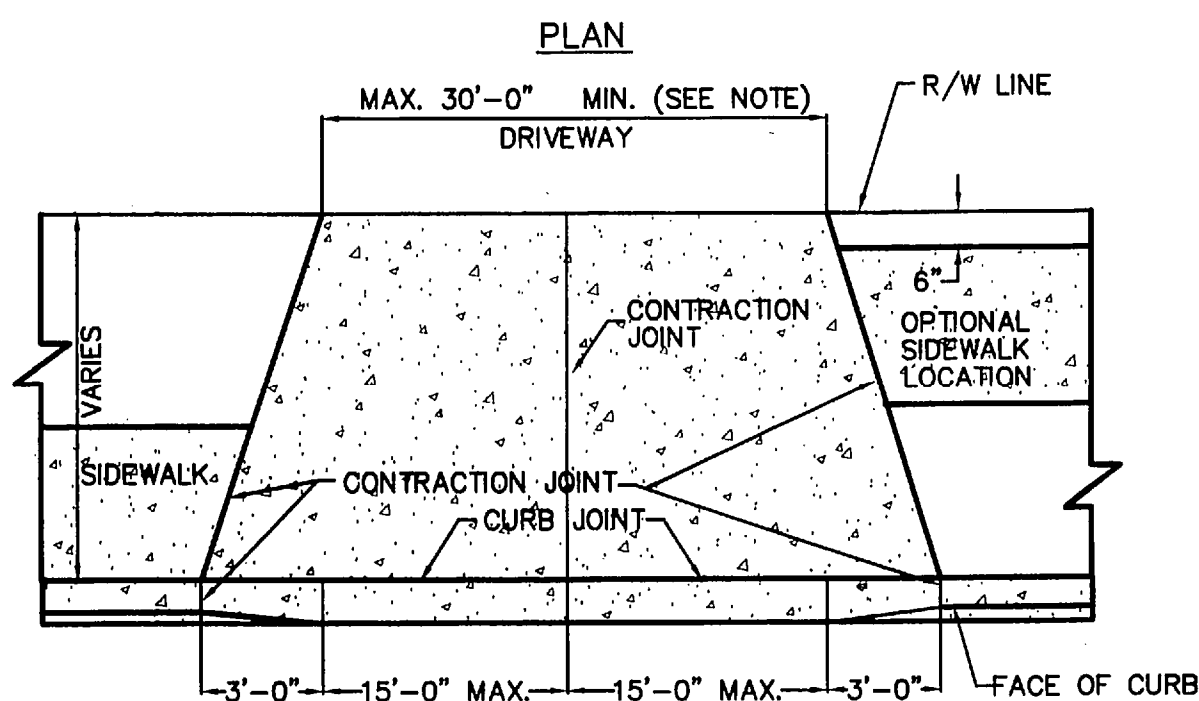


Commercial Driveway

NOTE: ONE-WAY TRAFFIC - MIN. 15' DRIVEWAY
TWO-WAY TRAFFIC - MIN. 24' DRIVEWAY

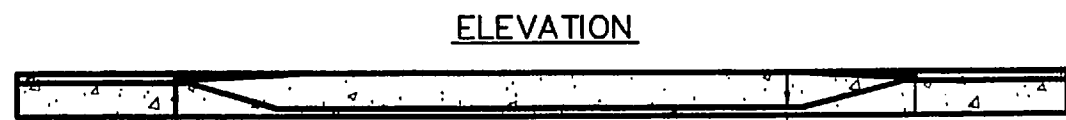

SECTION A-A

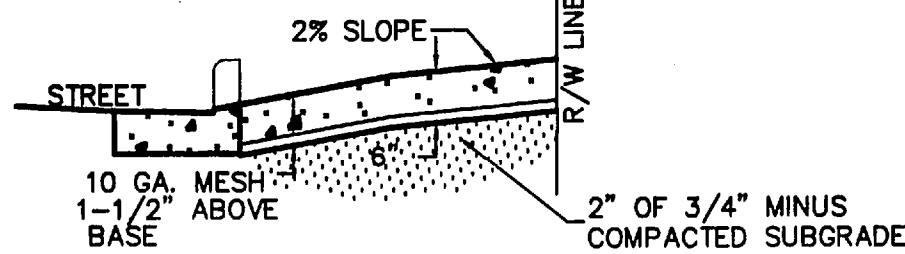


NOTES


1. CONCRETE SHALL HAVE A MINIMUM BREAKING STRENGTH OF 3300 PSI AFTER 28 DAYS, 6 SACK MIX.
2. CURB JOINT SHALL BE A TROWELED JOINT WITH A MIN. 1/2\" RADIUS ALONG BACK OF CURB.
3. DRIVEWAY SHALL BE A MINIMUM 6\" THICK.

Commercial Driveway

*West
Linn*
DATE: JAN 2000
DRAWING NO. WL-504
FILE NO. 00-504

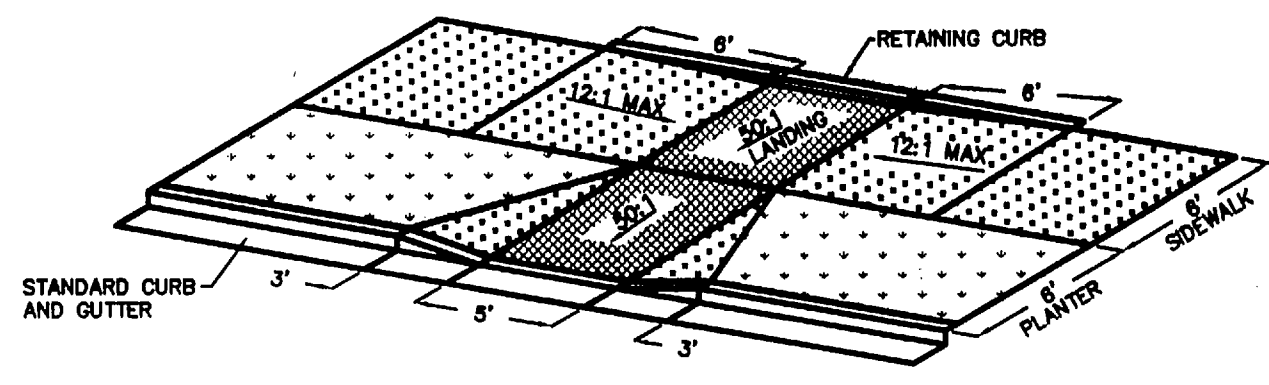

PARALLEL CURB RAMP

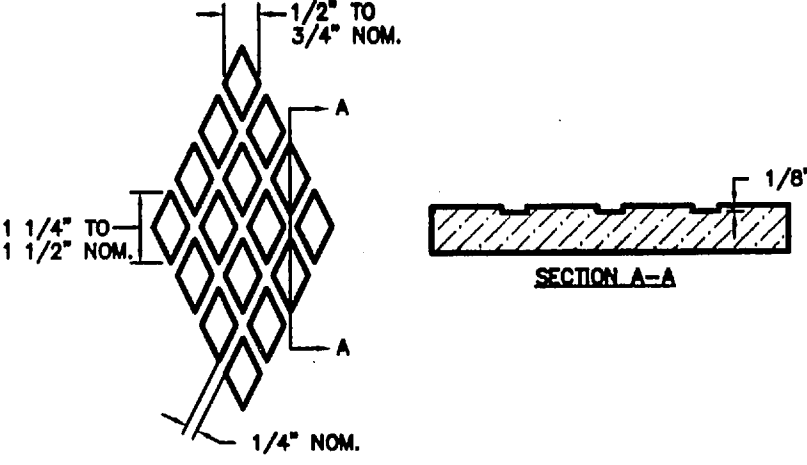


RAMP TEXTURE DETAIL

- NOTES:
1. THE AMERICANS WITH DISABILITIES ACT (ADA) REQUIRES THAT ACCESS RAMPS TO SIDEWALKS CONFORM TO ALL FEDERAL GUIDELINES. EXCEPTIONS TO THE REQUIREMENTS IN THIS DRAWING MUST BE APPROVED BY THE CITY ENGINEER AND MUST COMPLY WITH ADA.
 2. NO ABOVE GROUND UTILITIES ARE PERMITTED WITHIN RAMP AREA.
 3. LANDINGS SHALL BE PLACED AT THE TOP OF EACH RAMP. LANDING SLOPES SHALL NOT EXCEED 50:1 IN ANY DIRECTION. THE SLOPE OF THE SURFACING AT THE BOTTOM OF THE RAMP SHALL NOT EXCEED 20:1 FOR A DISTANCE OF 2' (SEE TYPICAL SECTION ABOVE).
 4. MINIMUM LANDING DIMENSIONS SHALL BE 4' X 4'.
 5. RAMP SURFACE SHALL BE TEXTURED WITH RAISED DIAMOND TEXTURE. TEXTURING SHALL BE DONE WITH AN EXPANDED METAL GRATE STAMPED INTO THE CONCRETE.
 6. CONCRETE STRENGTH SHALL BE 3300 PSI.

Parallel Curb Ramp


*West
Linn*
DATE: JAN 2000
DRAWING NO. WL-506
FILE NO. 00-506

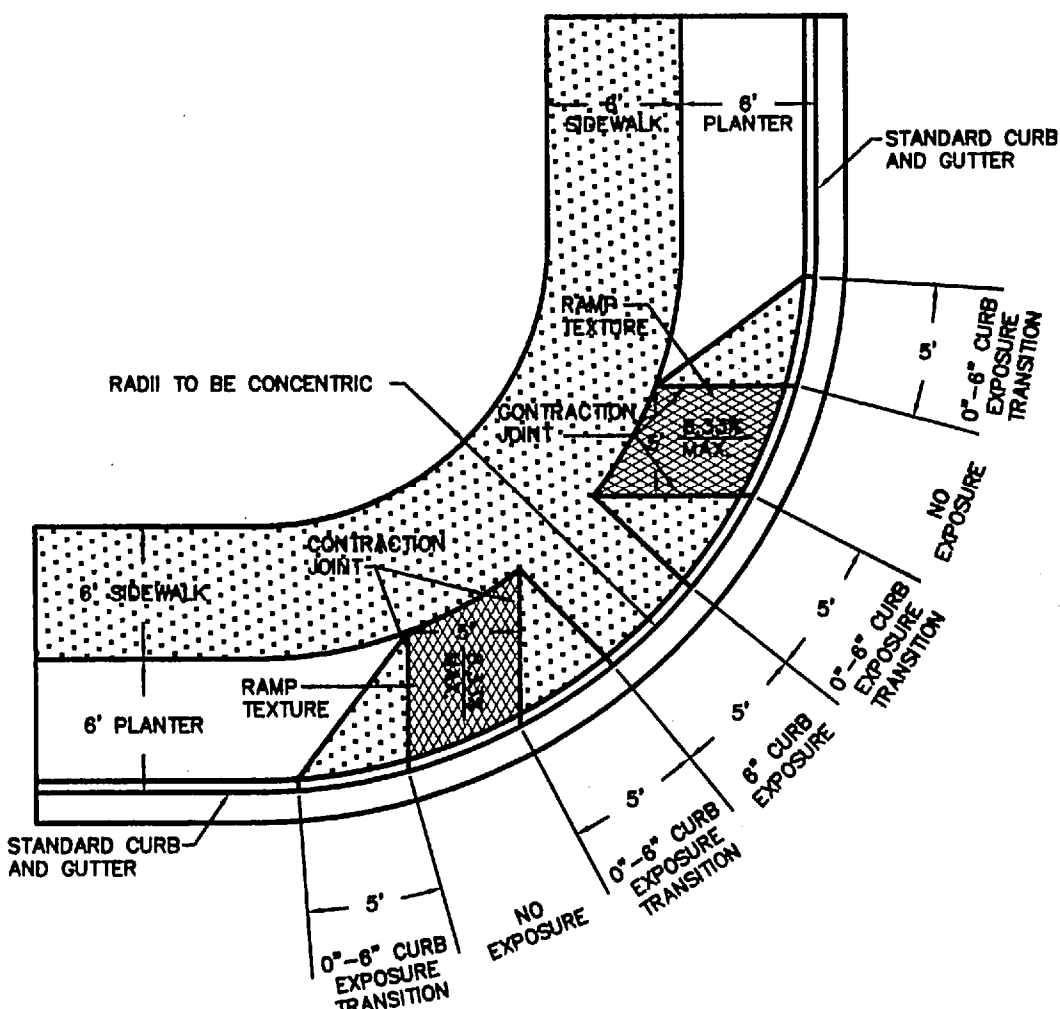


RAMP TEXTURE DETAIL

Twin Curb Ramp

*West
Linn*
DATE: JAN 2000
DRAWING NO. WL-507B
FILE NO. 00-507B

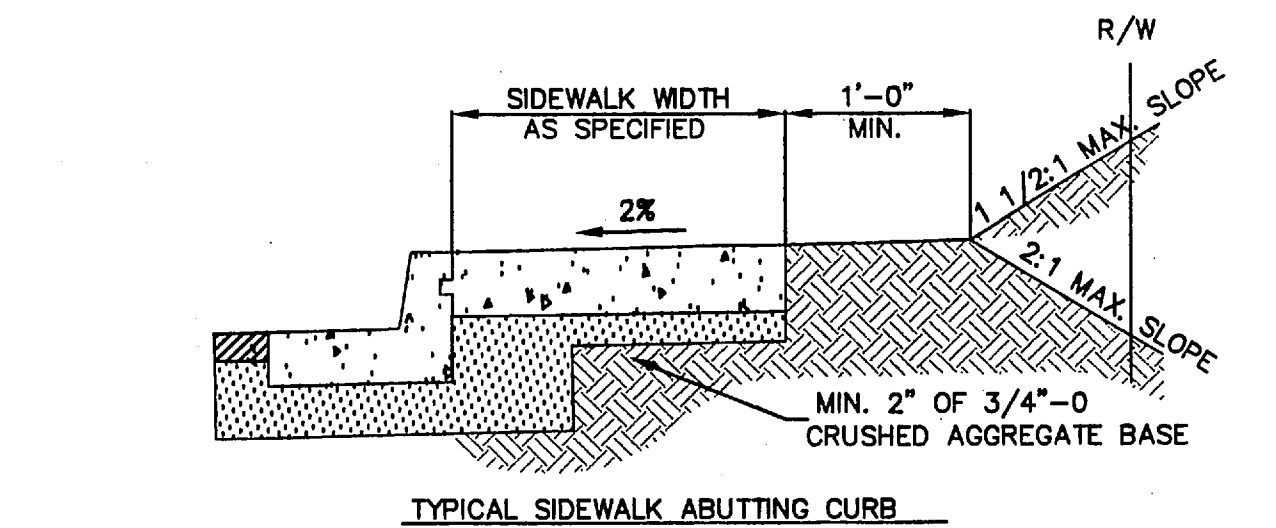

TYPICAL SIDEWALK ABUTTING CURB

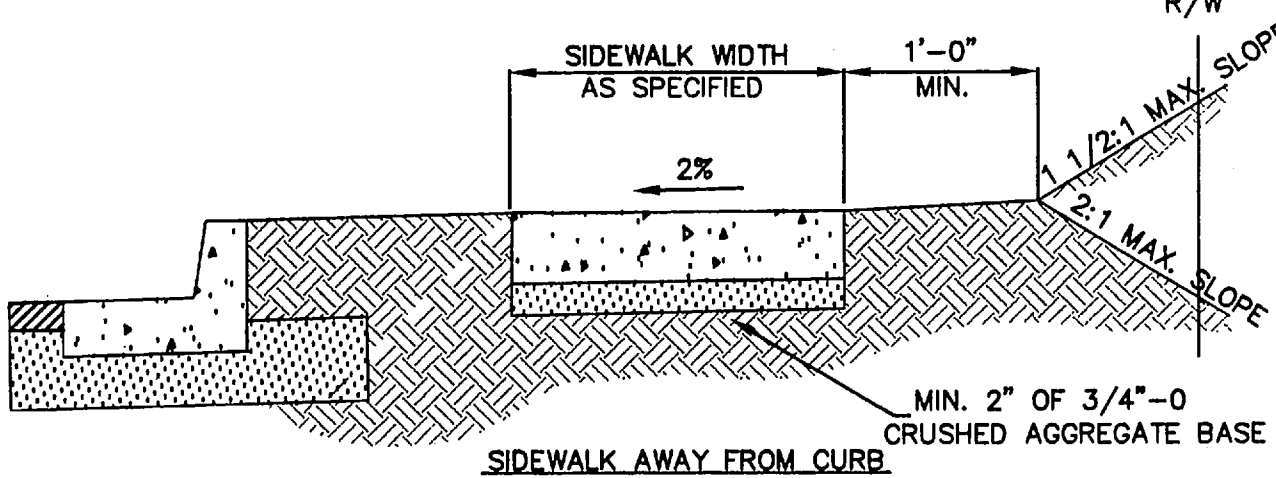


SIDEWALK AWAY FROM CURB

NOTES

1. CONCRETE SHALL BE 3300 PSI AT 28 DAYS, 6 SACK MIX, SLUMP RANGE OF 1 1/2\" TO 3\".
2. PANEL LENGTHS SHALL BE EQUAL TO THE SIDEWALK WIDTH, BUT MAY BE ADJUSTED WITH THE CITY ENGINEER'S APPROVAL.
3. CONTRACTION JOINTS (1/3RD OF THE THICKNESS OF CONCRETE) SHALL BE PLACED EVERY THIRD PANEL WITH A MAX. SPACING OF 18 FEET. JOINTS SHALL ALSO BE PLACED AT THE SIDES OF DRIVEWAY APPROACHES, UTILITY VAULTS, AND WHEELCHAIR RAMPS.
4. A CURING COMPOUND SHALL BE USED. WHITE REFLECTIVE SHEETING SHALL BE USED IN CASE OF RAIN.
5. FOR SIDEWALKS ADJACENT TO THE CURB AND POURED AT THE SAME TIME AS THE CURB, THE JOINT BETWEEN THEM SHALL BE A TROWELED JOINT WITH A MIN. 1/2\" RADIUS.
6. THE SIDEWALK SHALL HAVE A MIN. THICKNESS OF 6\" IF MOUNTABLE CURB IS USED OR IF THE SIDEWALK IS INTENDED AS A PORTION OF THE DRIVEWAY. OTHERWISE, THE SIDEWALK SHALL HAVE A MIN. THICKNESS OF 4\".
7. DRAIN BLOCKOUTS IN THE CURB SHALL BE EXTENDED TO THE BACK OF THE SIDEWALK WITH A 3\" DIA. PLASTIC PIPE AT A 2% SLOPE. A CONTRACTION JOINT SHALL BE PLACED OVER THE PIPE.

Concrete Sidewalk
Cross Section

*West
Linn*
DATE: JAN 2000
DRAWING NO. WL-508
FILE NO. 00-508

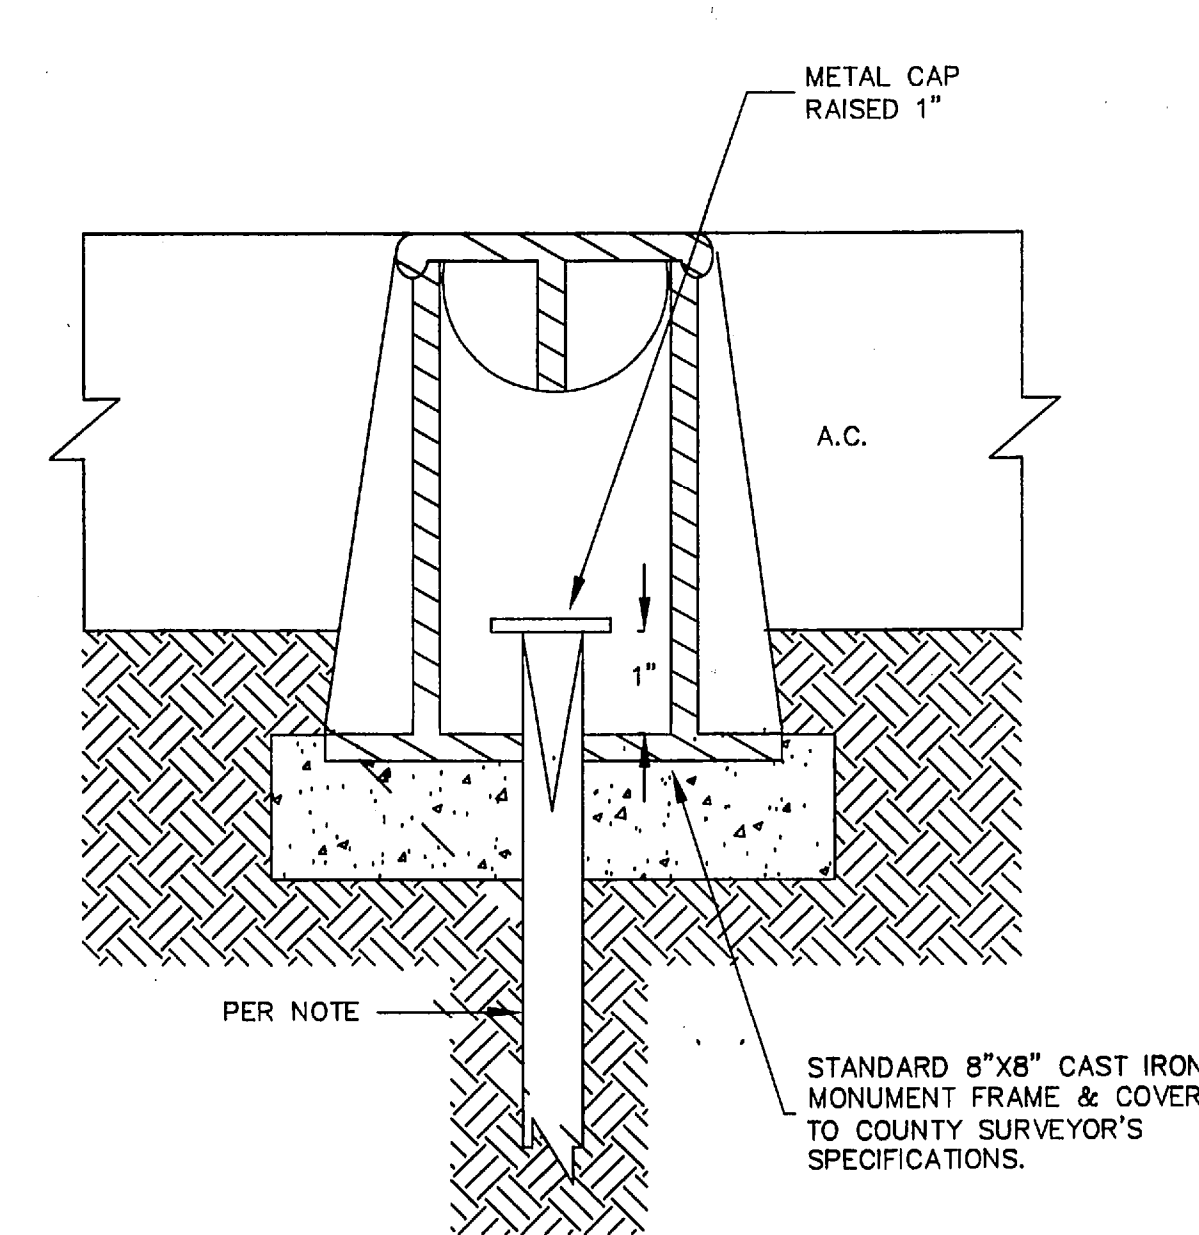

NOTES: ALL MONUMENTS SHALL USE EITHER 5/8\" DIA X 30\" LONG IRON ROD OR 3/4\" DIA X 30\" LONG IRON PIPE.


ALL MONUMENTS SHALL BE IN ACCORDANCE WITH ORS 209.250(4).

CONCRETE SHALL BE CLASS 3300. FRAME AND COVER SHALL BE CAST IRON OR ALUMINUM.


COVER SHALL HAVE \"MONUMENT\" CAST INTO TOP.

Centerline Survey
Monuments

*West
Linn*
DATE: JAN 2000
DRAWING NO. WL-513
FILE NO. 00-513

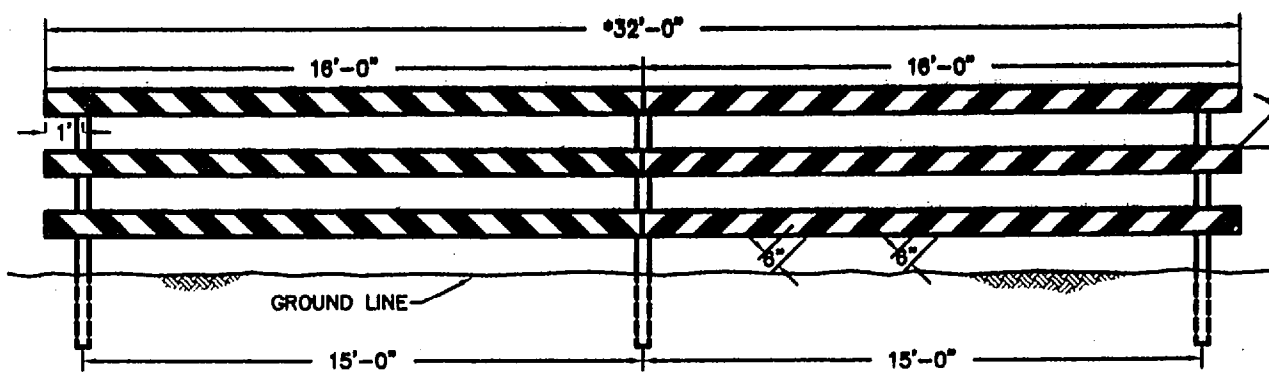

ELEVATION

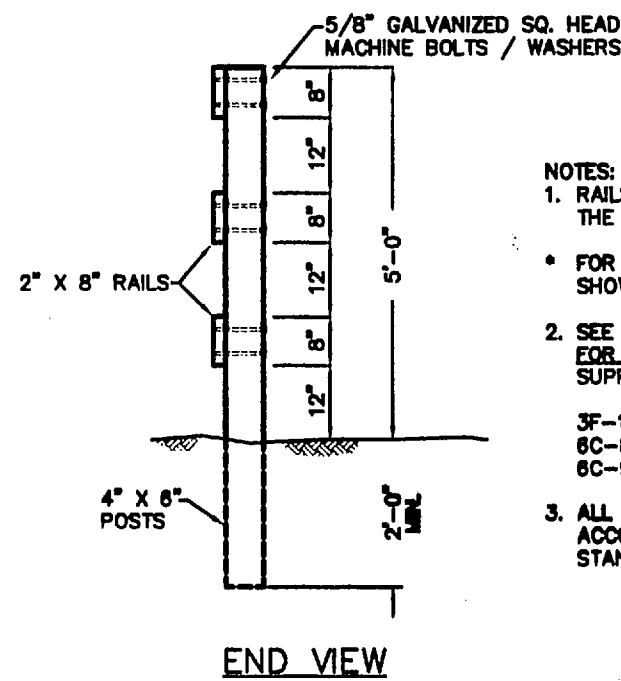

END VIEW

- NOTES:
1. RAILS TO BE PAINTED RED WITH WHITE STRIPES. THE WHITE STRIPES SHALL BE REFLECTORIZED
 - FOR WIDER APPLICATIONS, MULTIPLE SECTIONS AS SHOWN SHALL BE USED.
 2. SEE MANUAL ON UNIDIRECTIONAL TRAFFIC CONTROL DEVICES FOR STREETS AND HIGHWAYS AND THE OREGON SUPPLEMENT.
 - 3F-1 BARRICADES
6C-8 BARRICADE DESIGN
6C-9 BARRICADE APPLICATION
 3. ALL MATERIALS AND WORKMANSHIP SHALL BE IN ACCORDANCE WITH THE CURRENT STATE OF OREGON STANDARD SPECIFICATIONS FOR HIGHWAY CONSTRUCTION.

Street Barricade
Type 3

*West
Linn*
DATE: JAN 2000
DRAWING NO. WL-516
FILE NO. 00-516

08/21/2001

Date


AAH/BLW/JAH

Designed

AAH/BLW/JAH

Drawn

Checked By Date

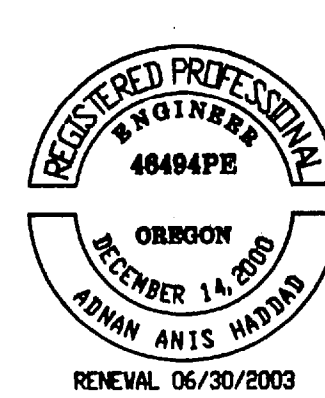

NORWAY DEVELOPMENT

P.O. Box 387
Oregon City, Oregon 97045
PHONE: (503) 656-7000
FAX: (503) 656-0686

Tanner's Stonegate

CITY OF WEST LINN, OREGON

DETAIL SHEET

ASBUILTS



17355 SW Boones Ferry Road
Lake Oswego, OR 97035-5217
Phone: (503) 635-3818
FAX: (503) 635-6395

10579

Project No.









D579C5-0


File No.

C5.0

Sheet No.


Copyright 2001

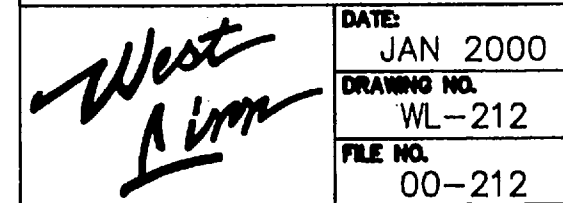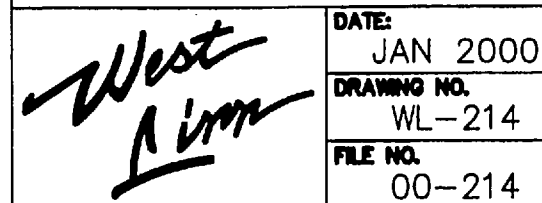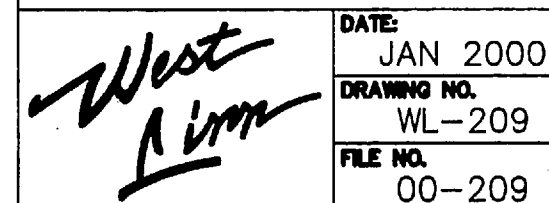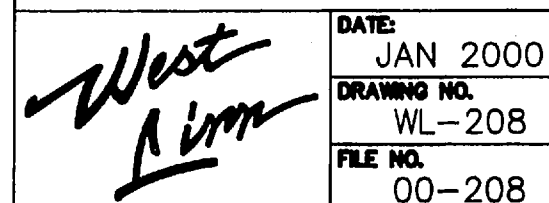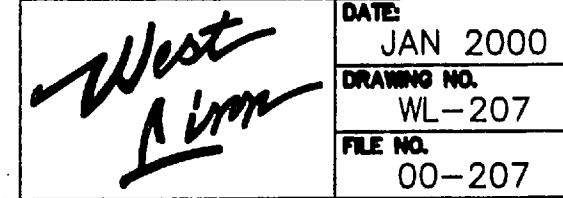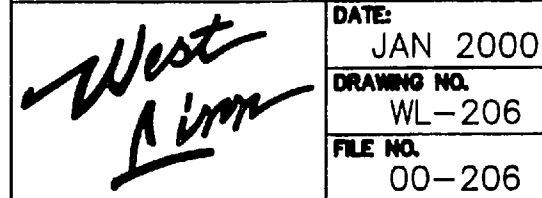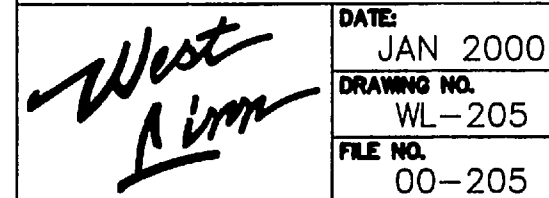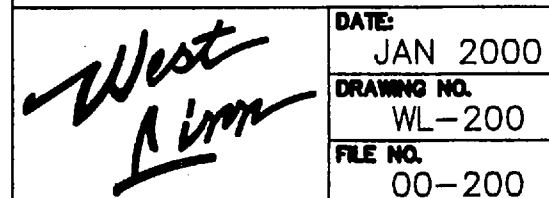

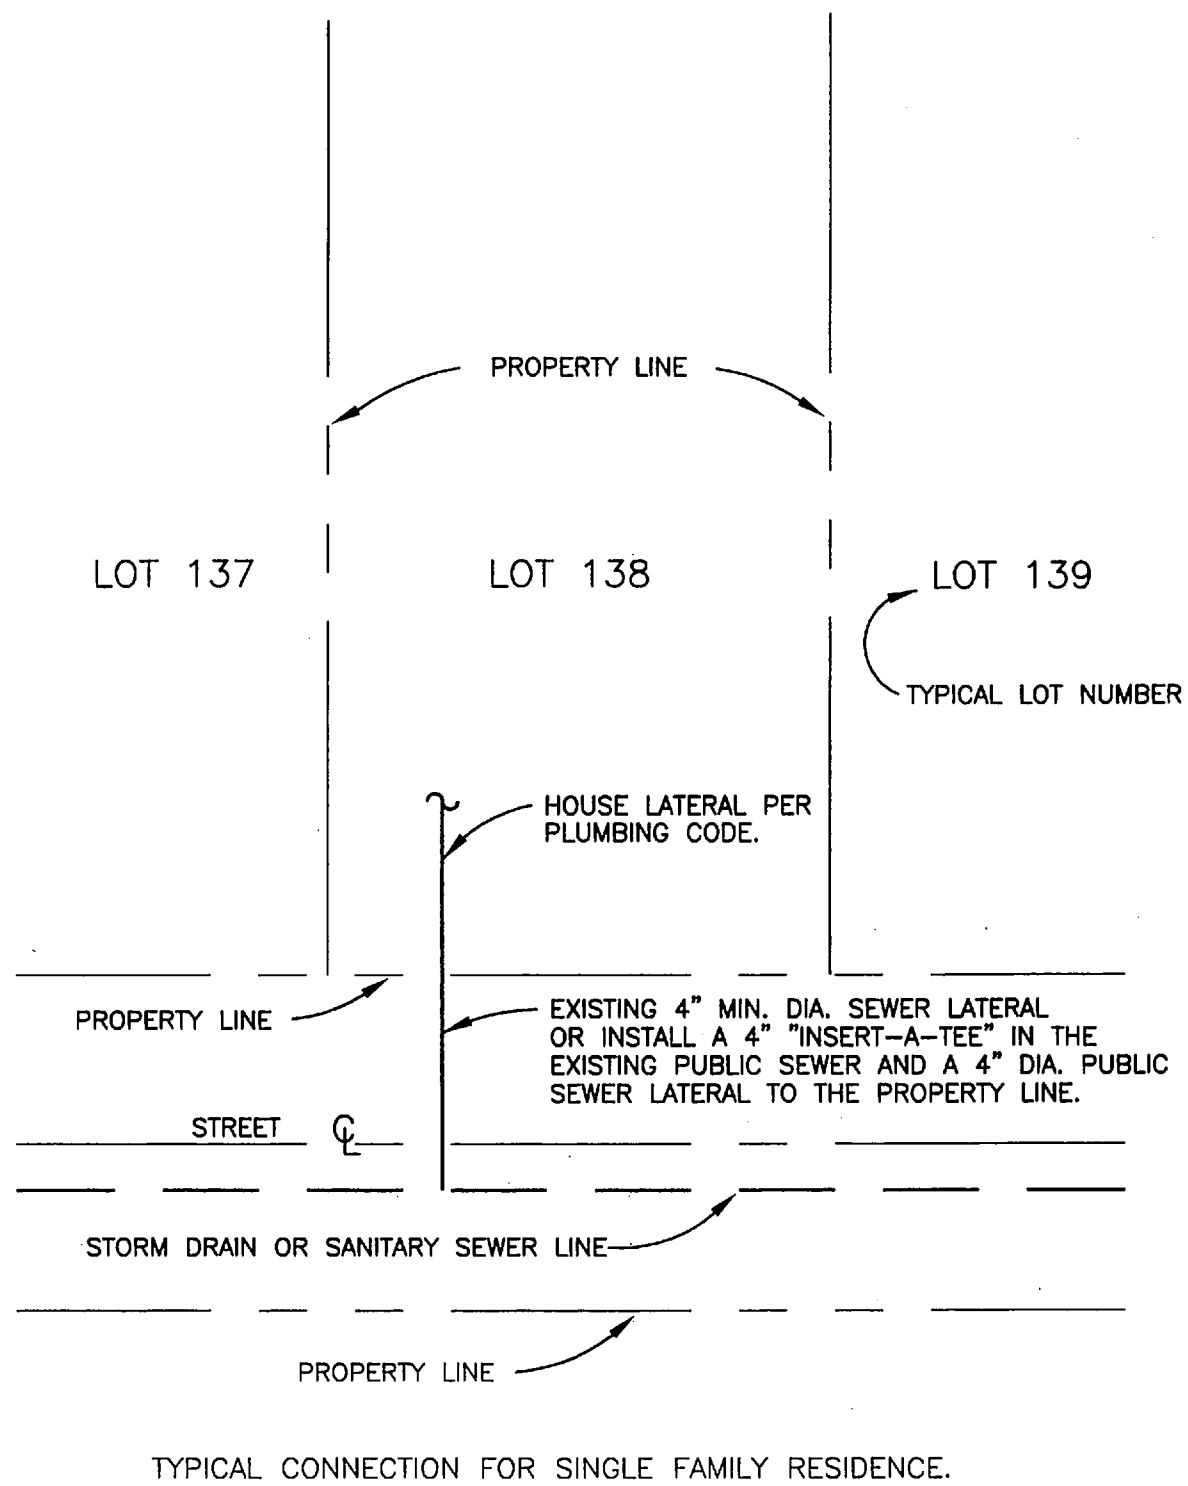


Sewer Connection
Single Family

West Lim
DATE: JAN 2000
DRAWING NO. WL-216
FILE NO. 00-216

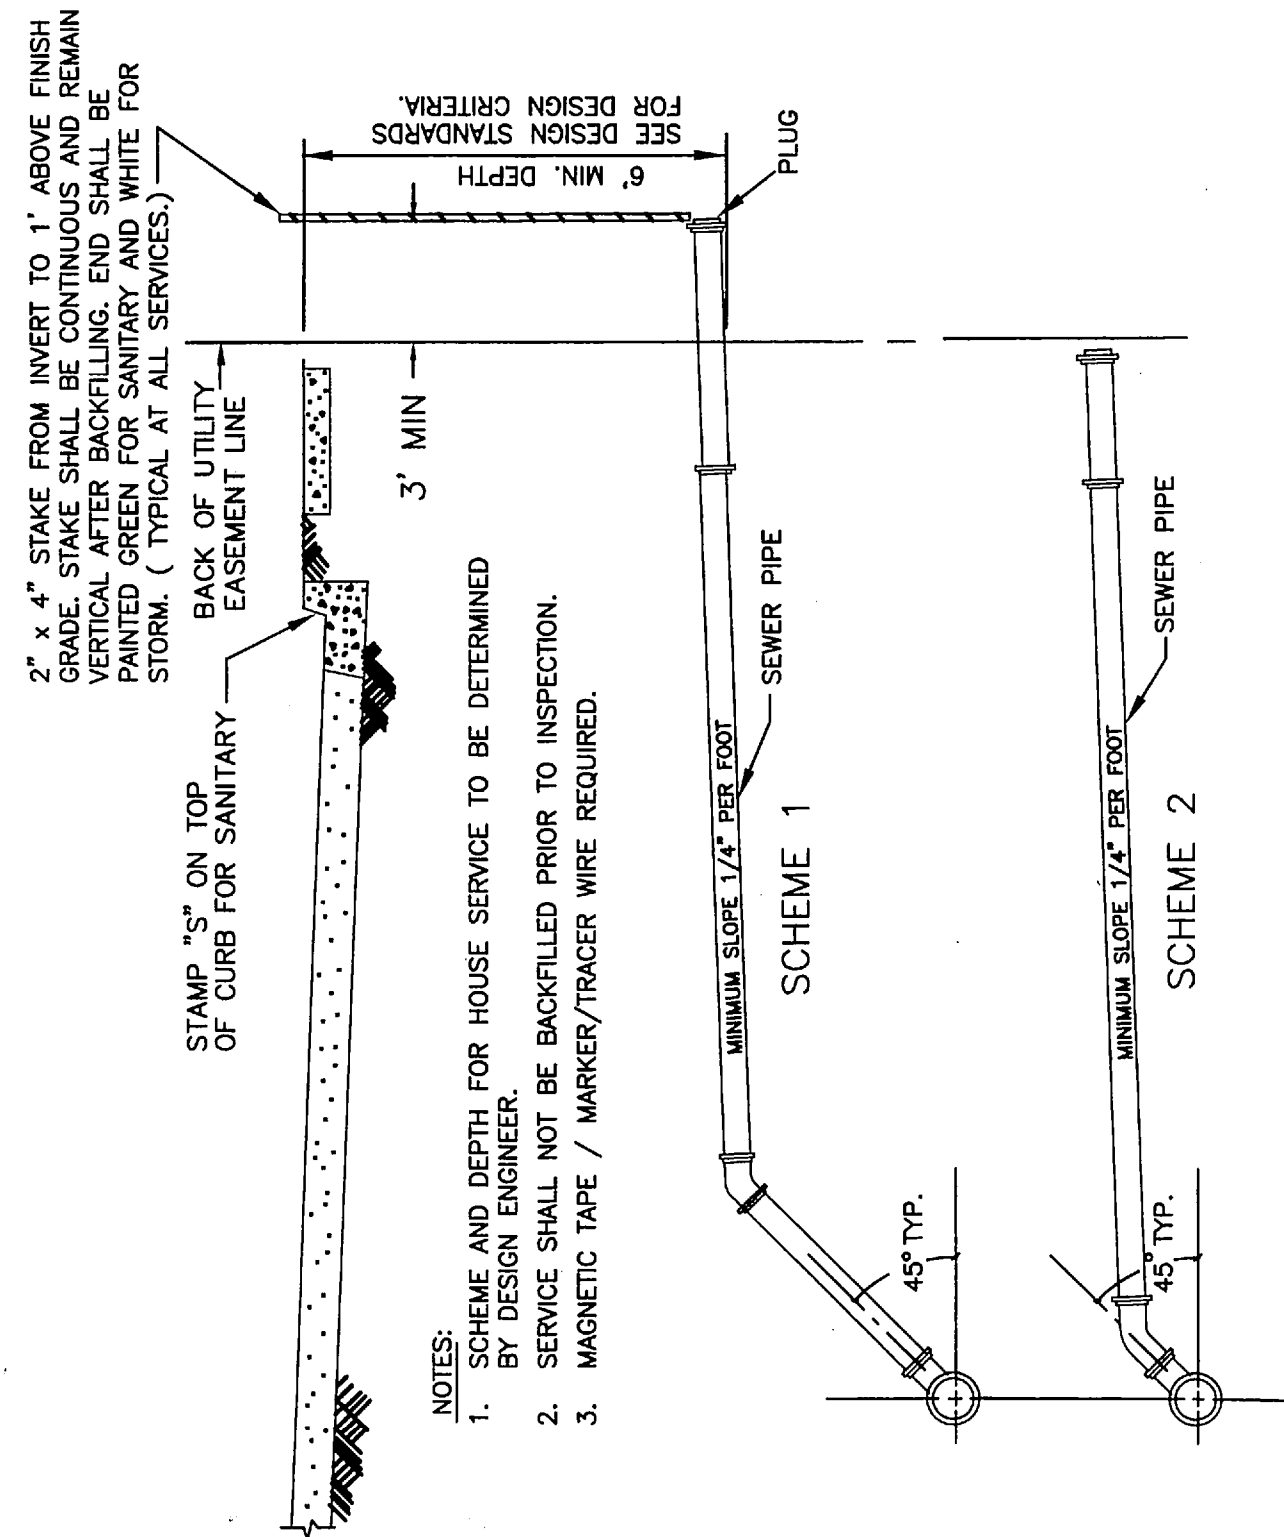


Service Branch

West Lim
DATE: JAN 2000
DRAWING NO. WL-218
FILE NO. 00-218

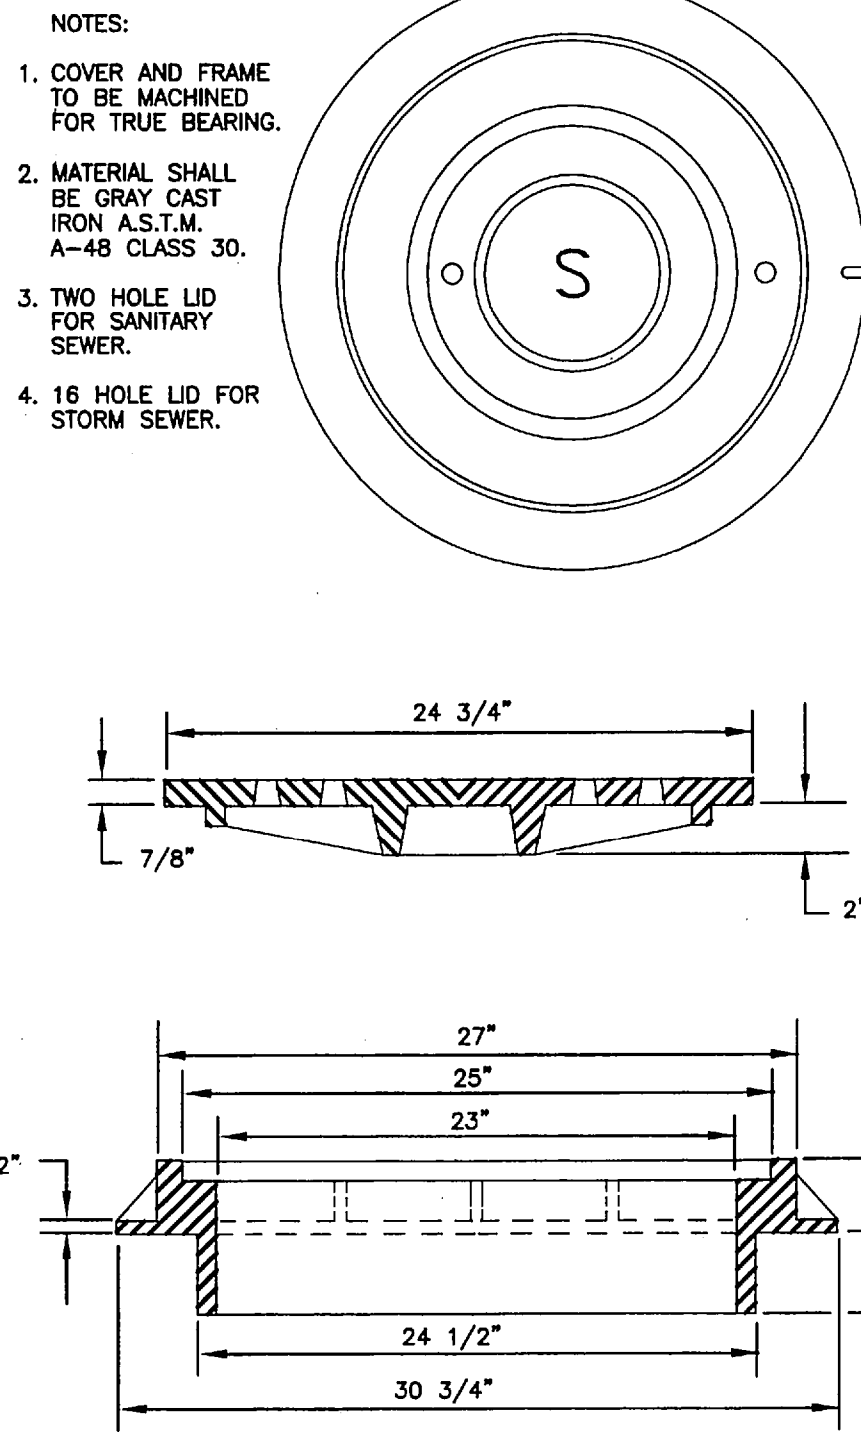


Suburban Manhole
Frame and Cover
3\"

West Lim
DATE: JAN 2000
DRAWING NO. WL-300
FILE NO. 00-300

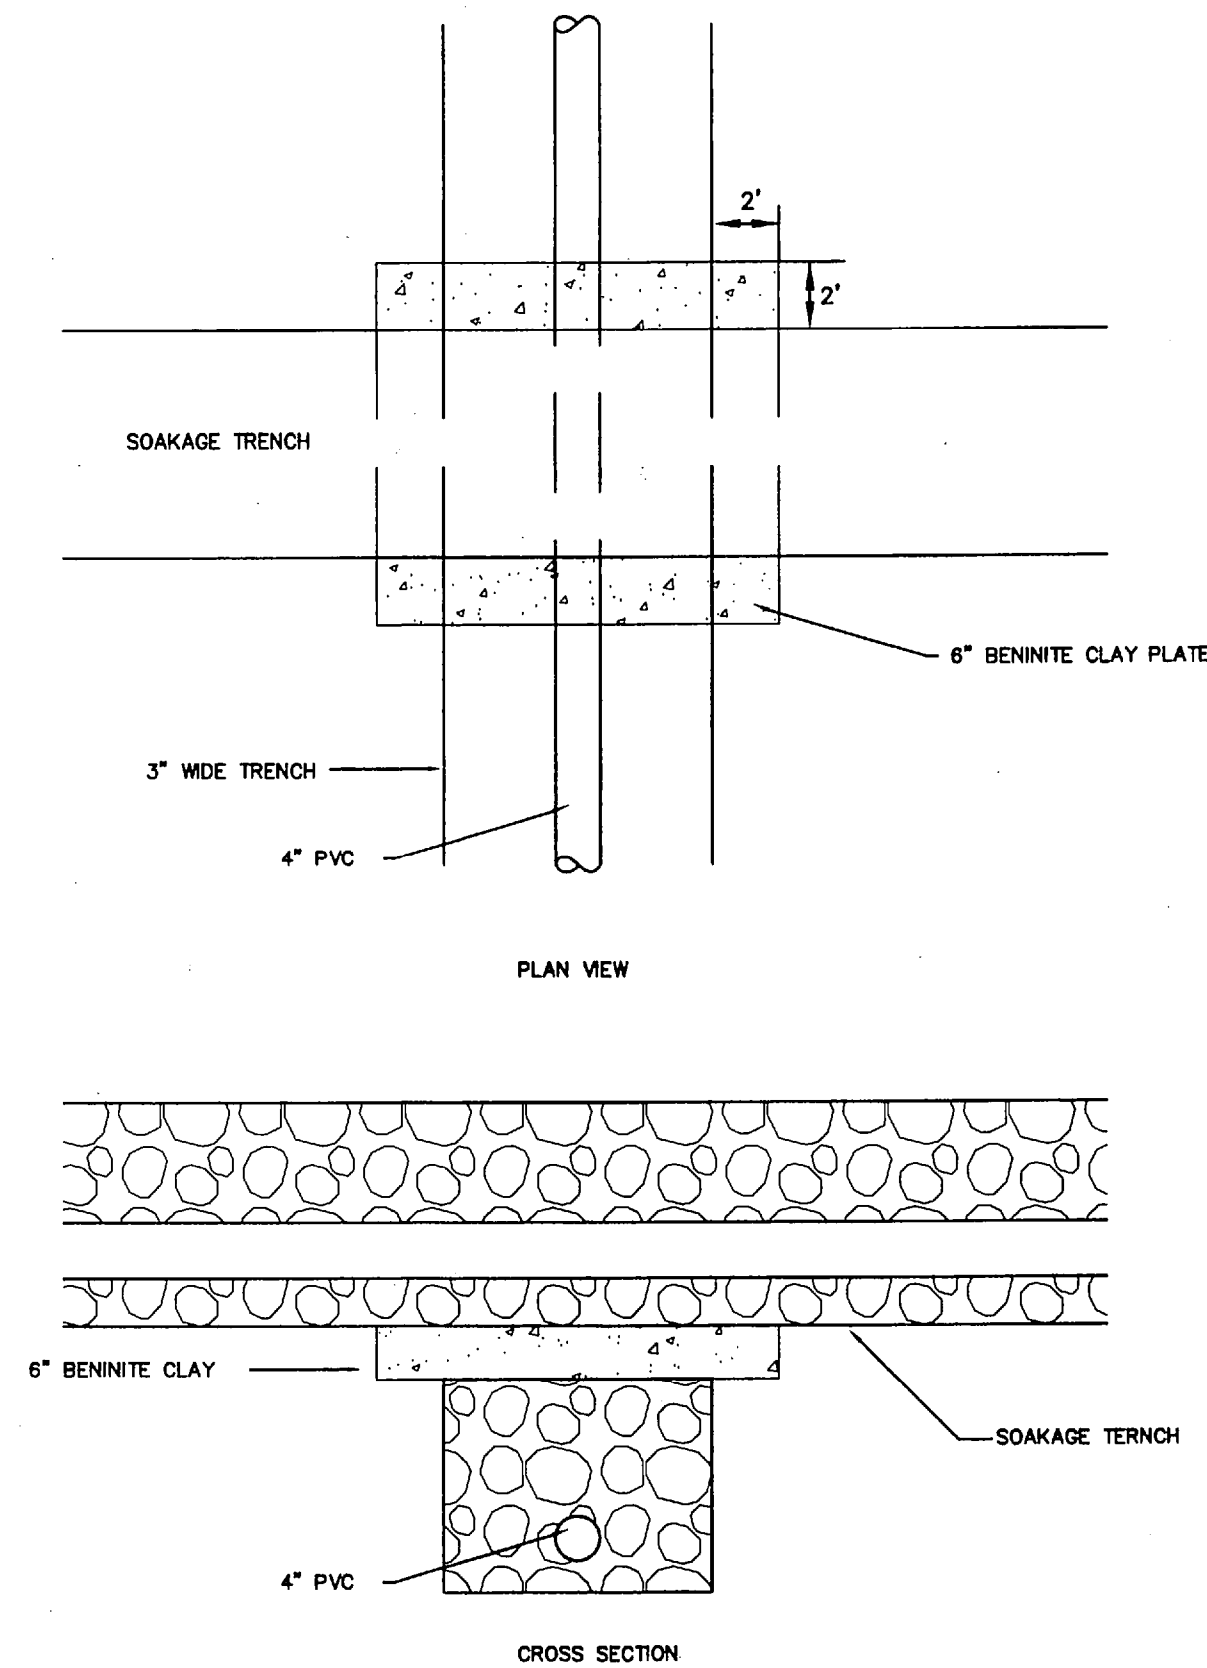


Trench-Lateral Separator

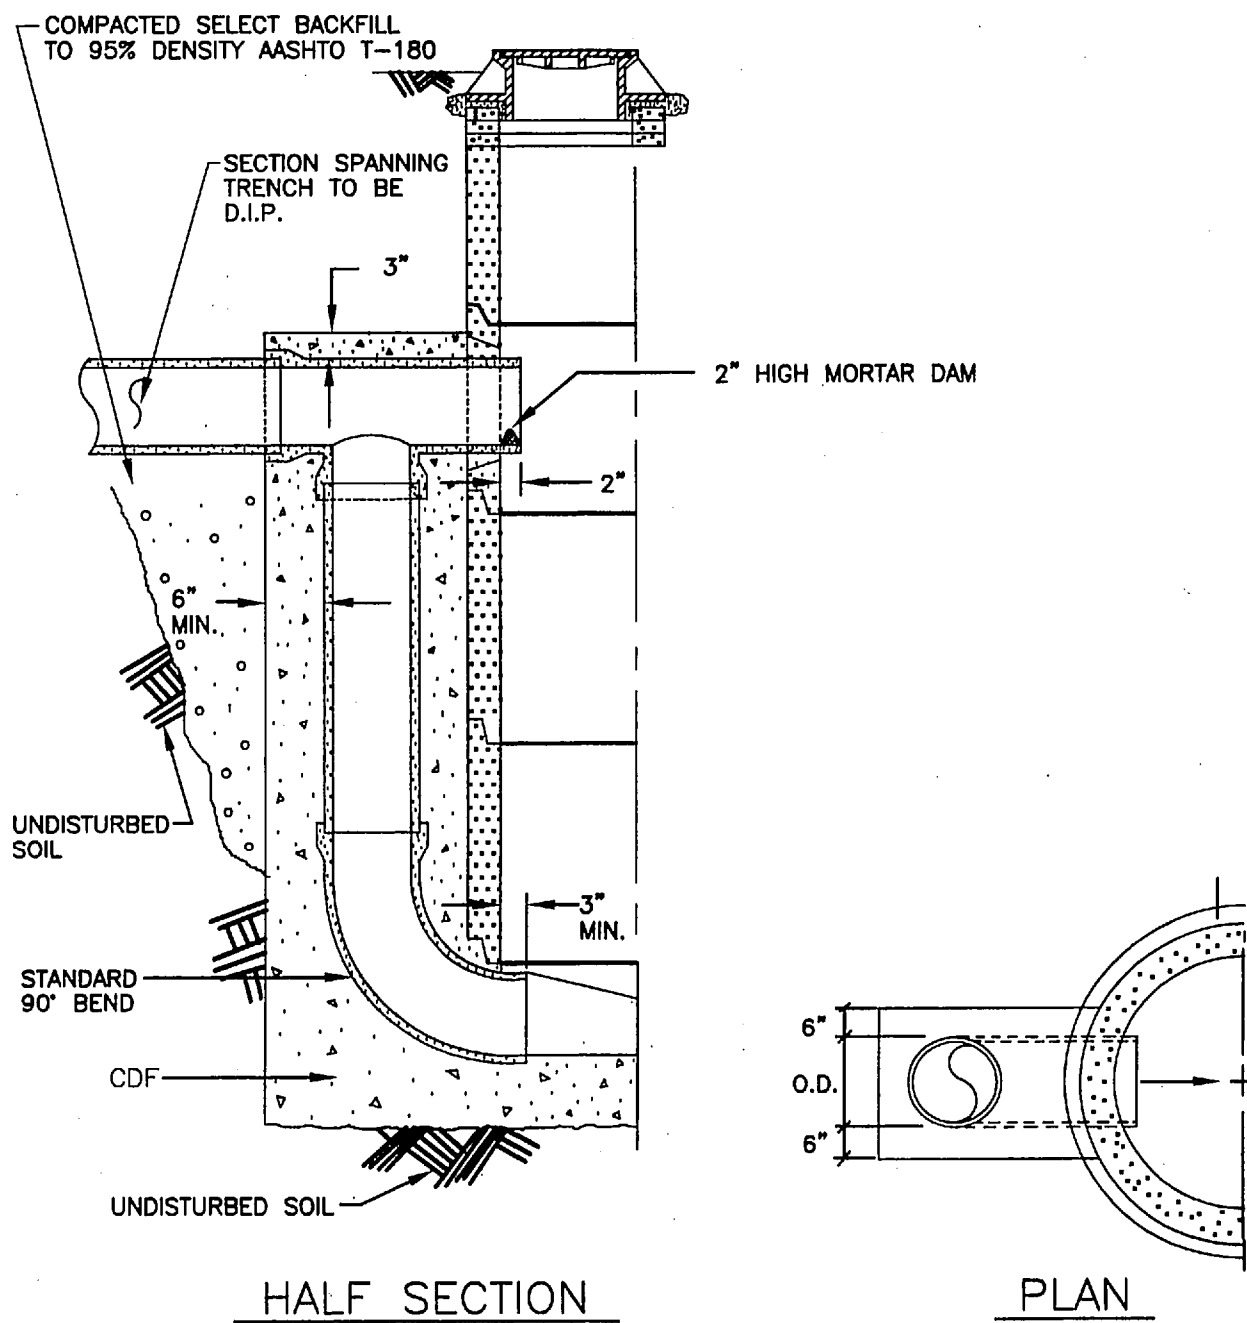

Outside Drop Manhole


West Lim
DATE: JAN 2000
DRAWING NO. WL-301
FILE NO. 00-301

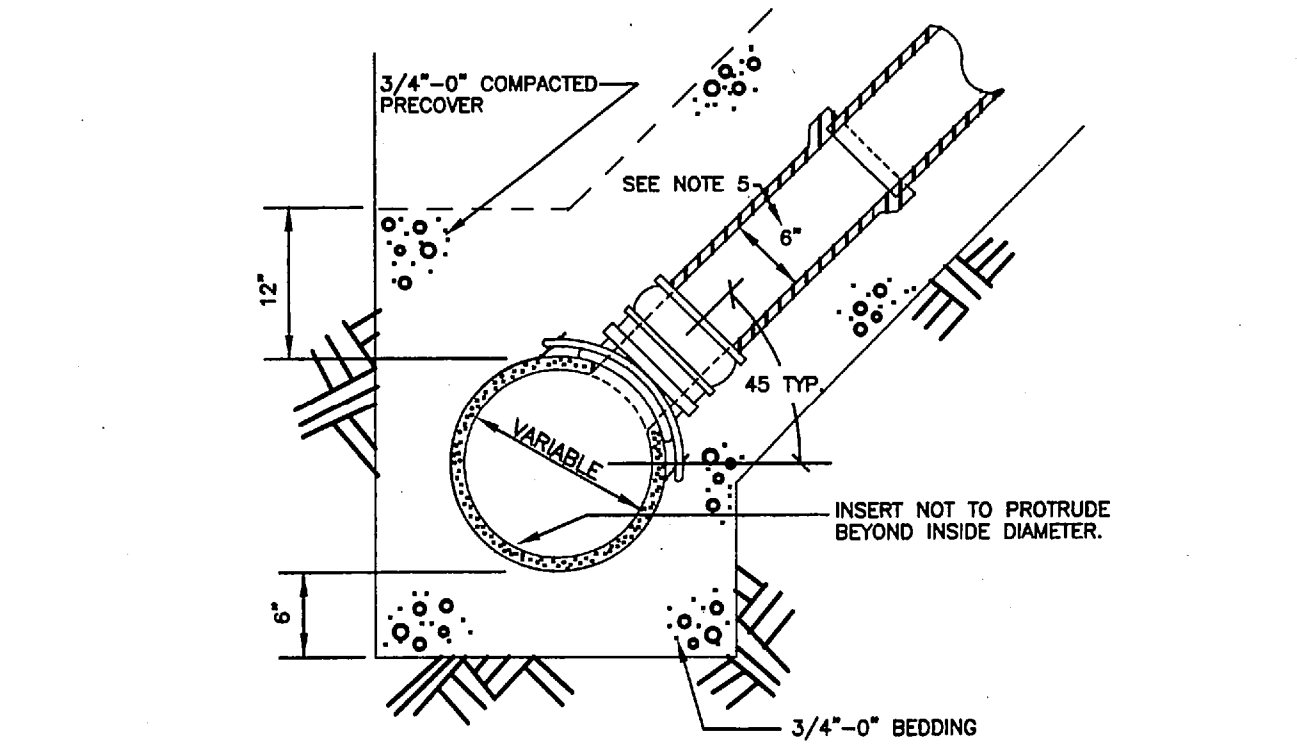

- NOTES:
1. A MINIMUM OF 24 HOURS NOTICE IS REQUIRED PRIOR TO A TAP INSPECTION. ALL TRENCHES SHALL BE SHORED IN COMPLIANCE WITH OR-OSHA EXCAVATION RULES, CHAPTER 437, DIVISION "3", SUBDIVISION "P", ADOPTED SEPTEMBER 1, 1990. PUBLIC WORKS INSPECTORS WILL NOT INSPECT A TAP IN A TRENCH WITHOUT LEGAL SHORING.
 2. THE TAP SHALL BE INSPECTED BEFORE BACKFILL IS ALLOWED AND BEFORE THE SIDE SEWER CONNECTION IS MADE. THE CORE DRILLED "SLUG" IS TO BE SHOWN TO THE INSPECTOR TO INSURE IT WAS REMOVED FROM THE SEWER LINE.
 3. ALL SERVICE LINE CONNECTIONS SHALL BE MADE WITH AN APPROVED CONNECTOR MANUFACTURED AND DESIGNED TO CONNECT TO A CORE DRILLED PIPE, FOWLER INSURT-A-TEE, SEAL TIGHT SADDLE, TAP TITE TEE, OR AN APPROVED EQUAL COMMERCIAL TAP.
 4. THE CENTERLINE OF TAP IS TO BE ABOVE THE SPRINGLINE.
 5. 4" MAXIMUM TAP FOR 8" MAIN (OUT-IN TEE TO BE USED FOR 6" HOUSE BRANCH ON 8" MAIN).
 6. 4" HOUSE BRANCH MAY BE USED FOR SINGLE FAMILY LOTS ONLY.


Sewer Service Tap to
Existing Sewers for
House Laterals

West Lim
DATE: JAN 2000
DRAWING NO. WL-303
FILE NO. 00-303

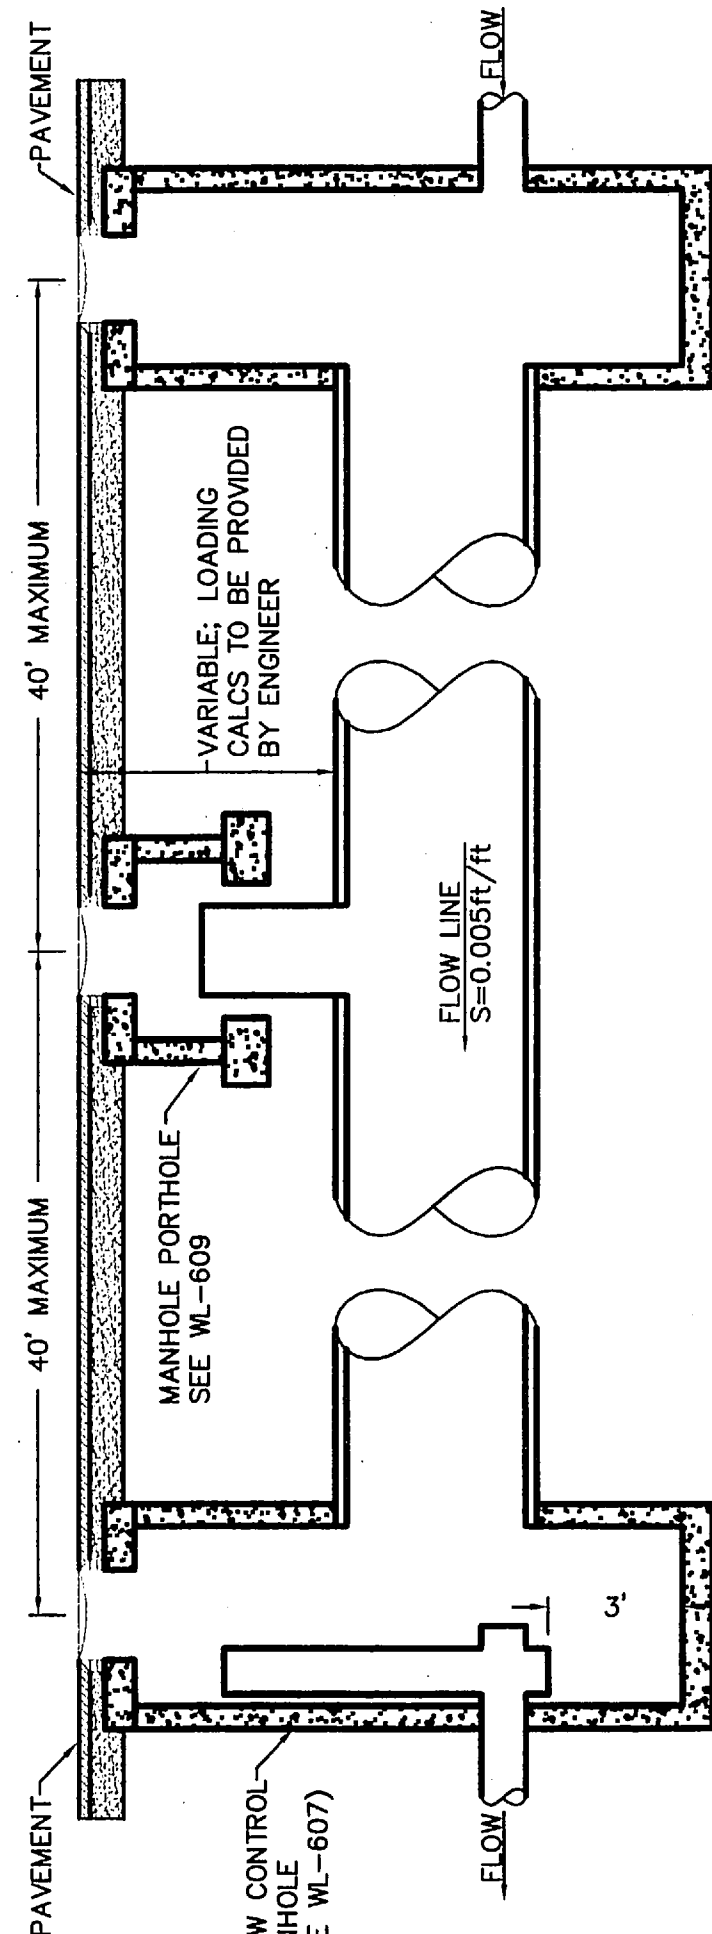

Underground Detention
Manholes


West Lim
DATE: JAN 2000
DRAWING NO. WL-608
FILE NO. 00-608

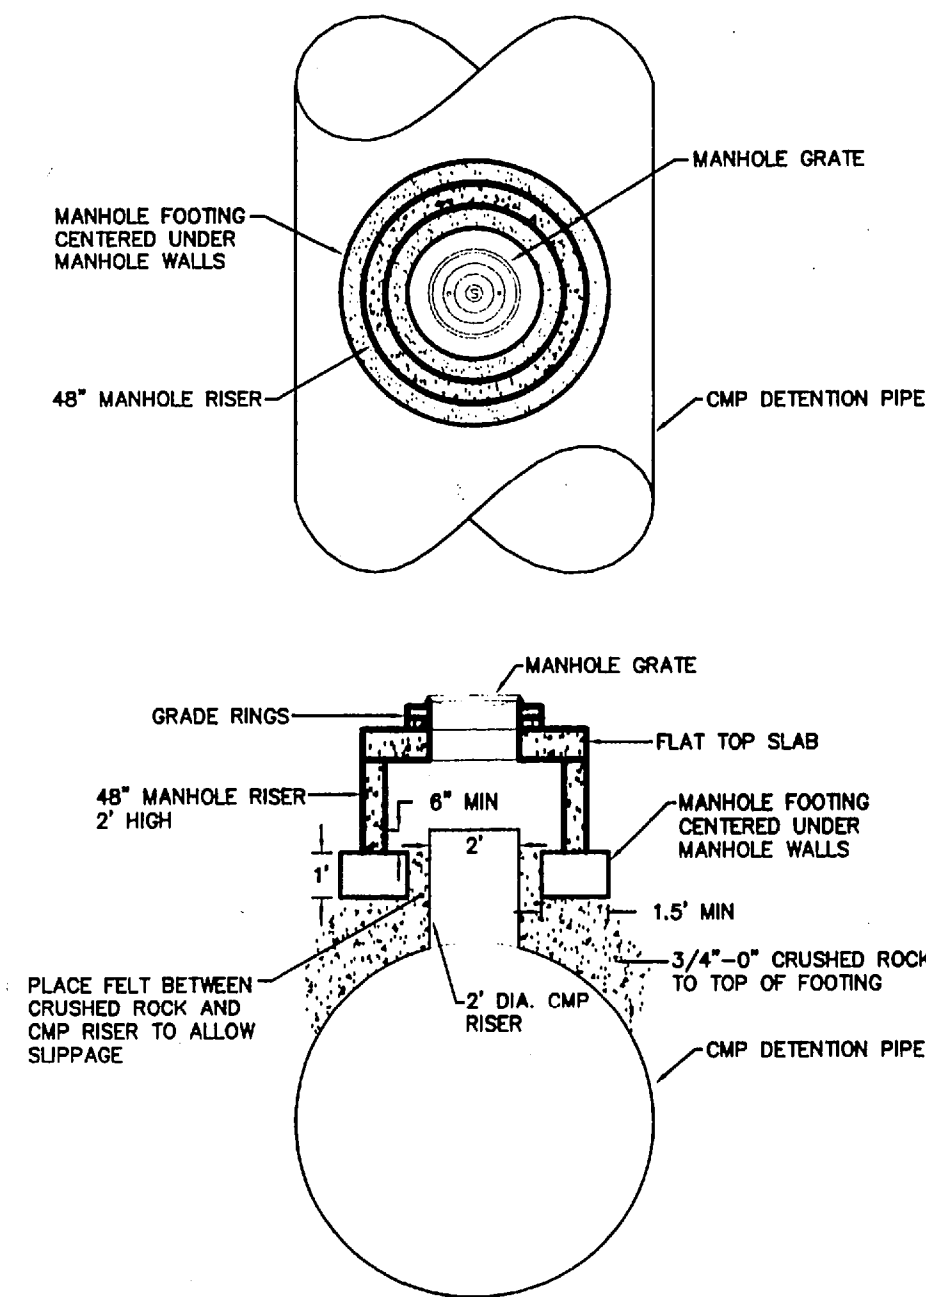

Manhole Porthole

West Lim
DATE: JAN 2000
DRAWING NO. WL-609
FILE NO. 00-609


XREF LIST
Ltscale: 1
Resolved
D579X001

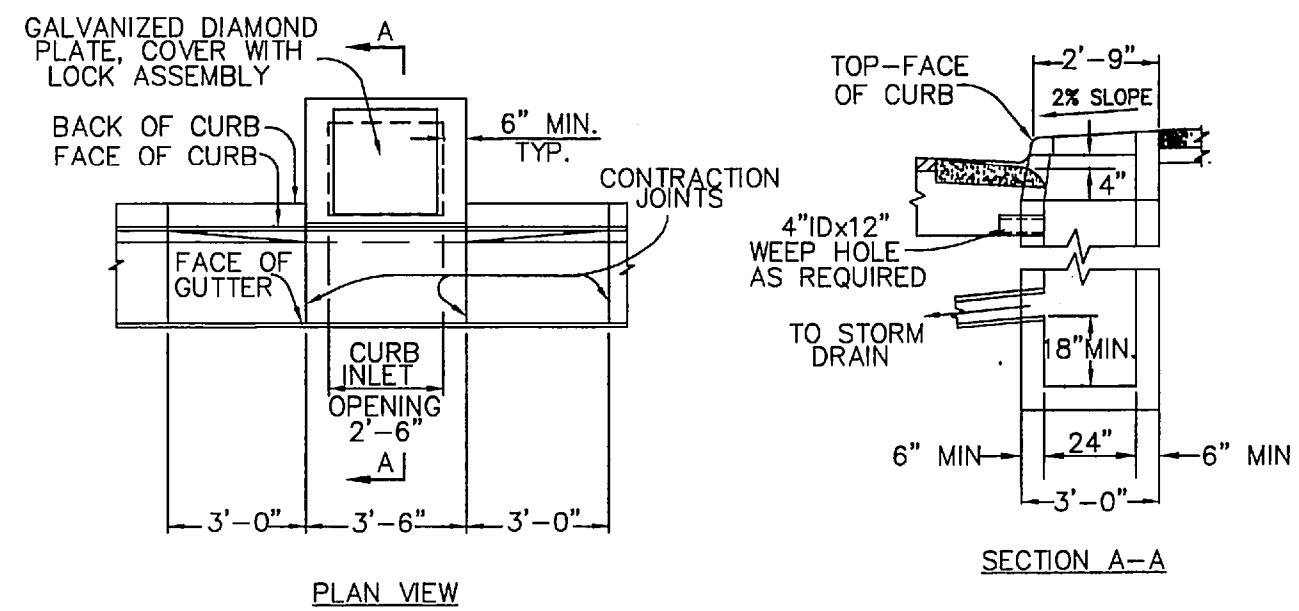

- NOTES:
1. ALL FABRICATED METAL PARTS SHALL BE HOT-DIPPED GALVANIZED AFTER FABRICATION.
 2. CONCRETE SHALL BE CLASS 3000.
 3. CURB INLET BASE MAY BE PRECAST OR CAST-IN-PLACE.
 4. FOR SLOPES OF 5% OR GREATER, USE DWG. WL-601.


Gutter Inlet
2 1/2 A

DATE: JAN 2000
DRAWING NO. WL-600
FILE NO. 00-600

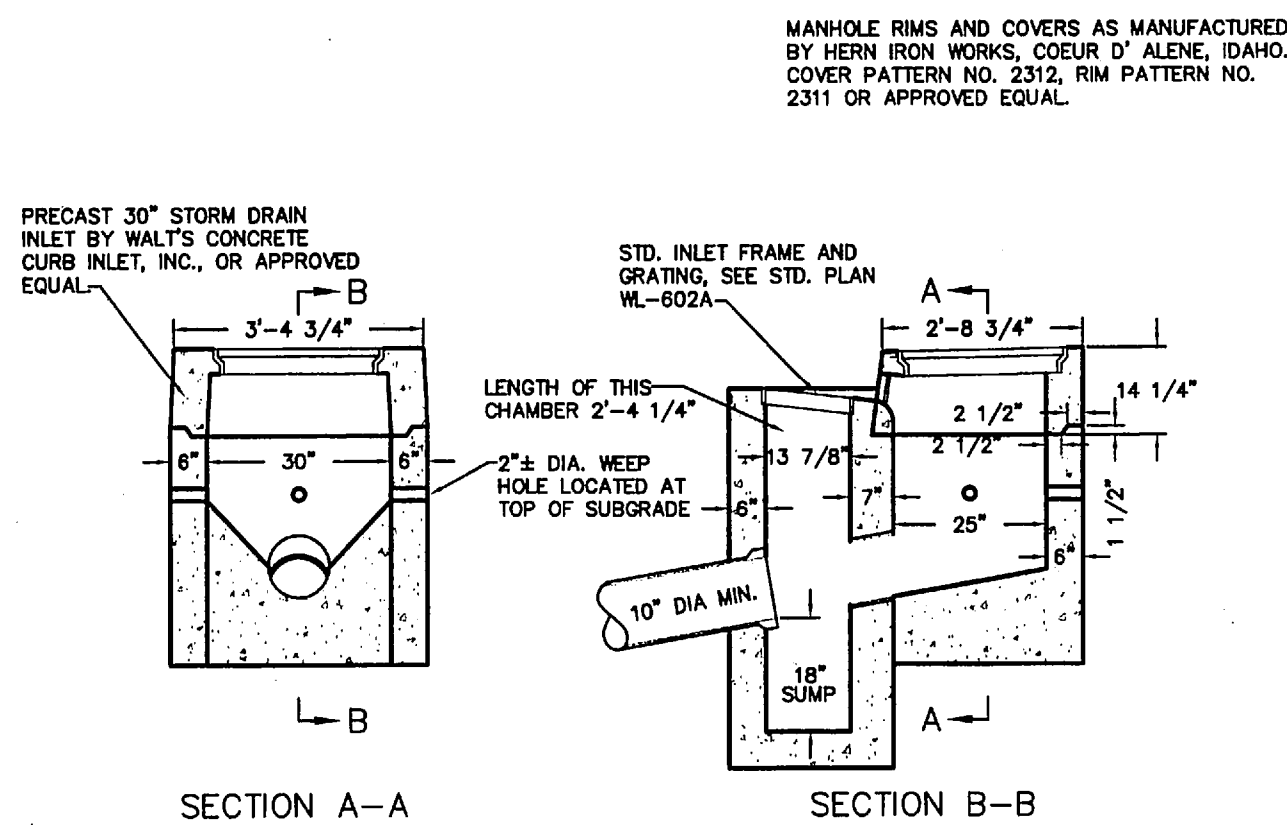


Combination Curb Inlet

DATE: JAN 2000
DRAWING NO. WL-601
FILE NO. 00-601

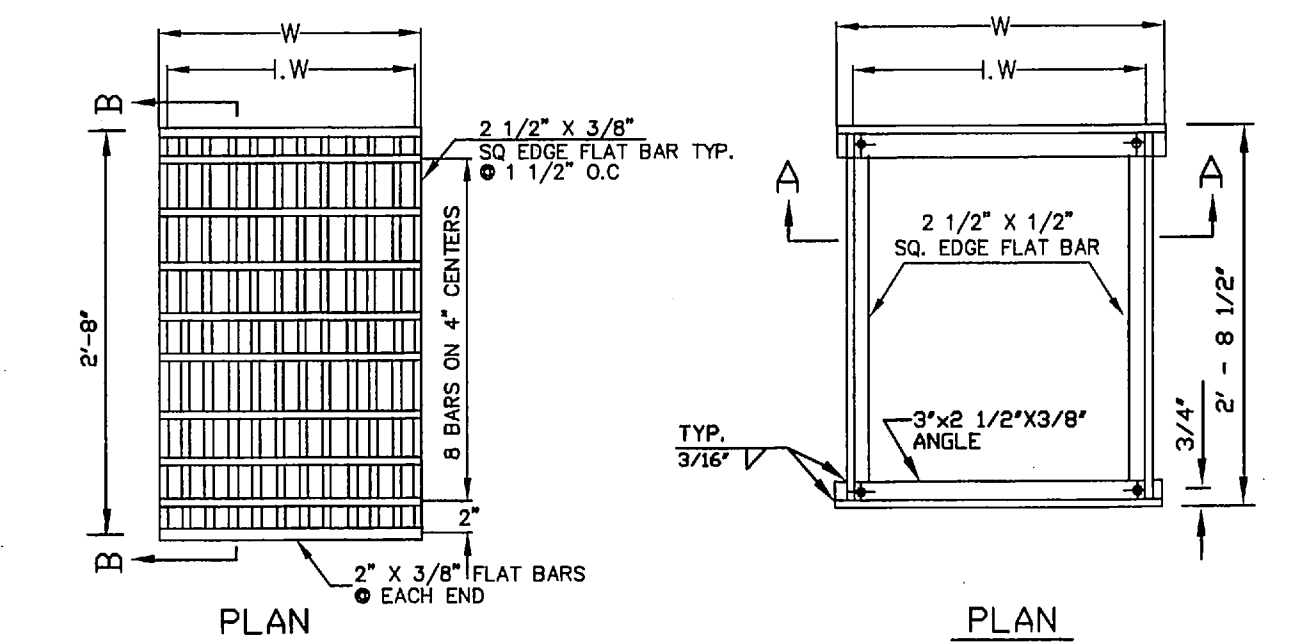

Frame & Grate
for Gutter & Curb Inlets


DATE: JAN 2000
DRAWING NO. WL-602A
FILE NO. 00-602A

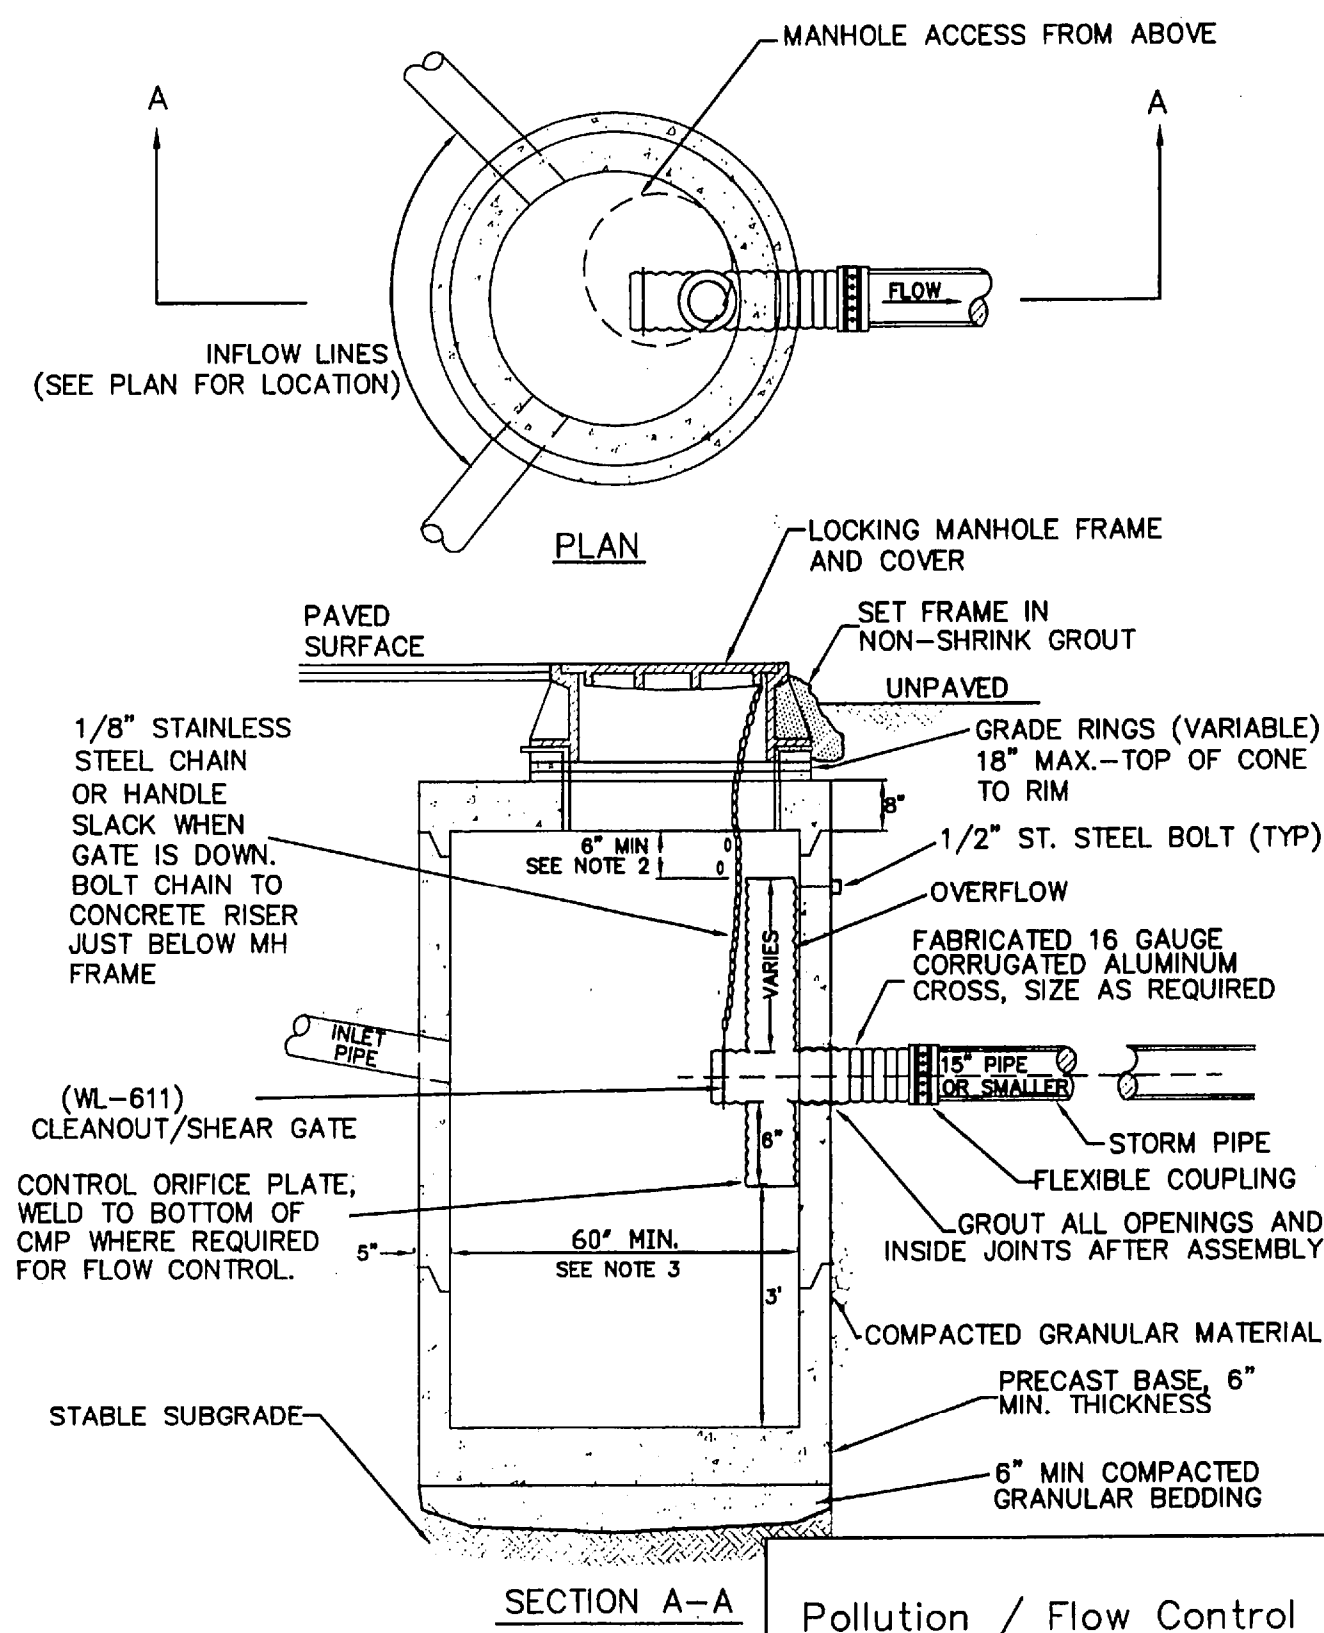

- NOTES:
1. ALL PRECAST SECTIONS SHALL CONFORM TO THE REQUIREMENTS OF ASTM C-478.
 2. DISTANCE FROM TOP OF OVERFLOW TO MH RIM SHALL BE BASED ON OVERFLOW CAPACITY CALC'S BY DESIGN ENGINEER. ASSUME ORIFICE CONTROL.
 3. 72" MINIMUM DIA. MANHOLE REQUIRED FOR OUTLET OR INLET > 21".
 4. NO STEPS REQUIRED


Pollution / Flow Control
Manhole

DATE: JAN 2000
DRAWING NO. WL-607
FILE NO. 00-607

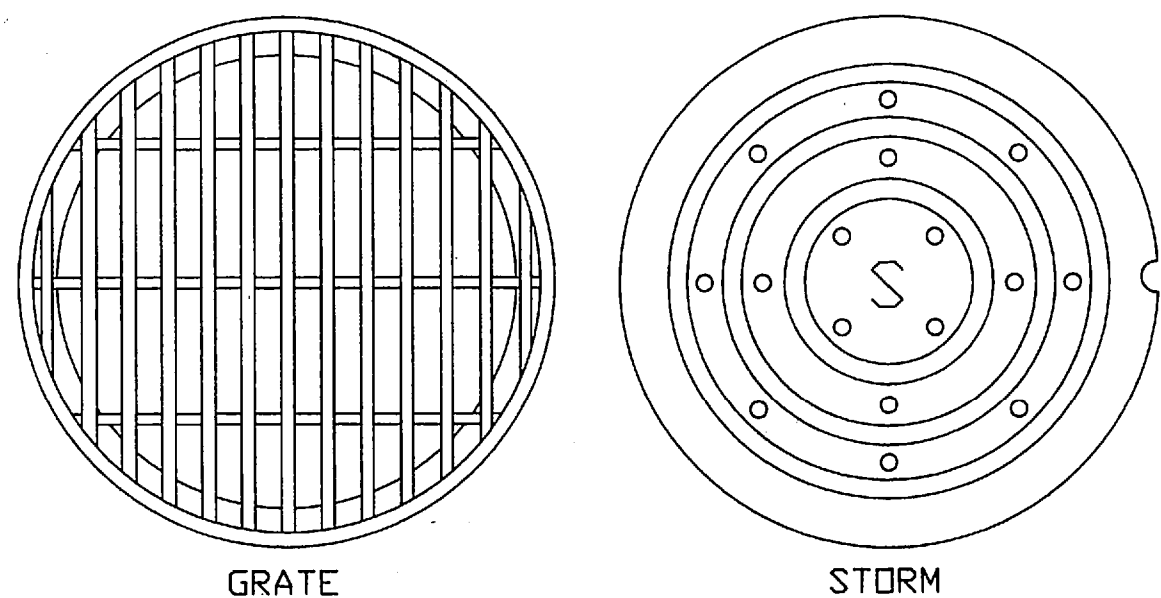


Manhole Covers

DATE: JAN 2000
DRAWING NO. WL-605
FILE NO. 00-605

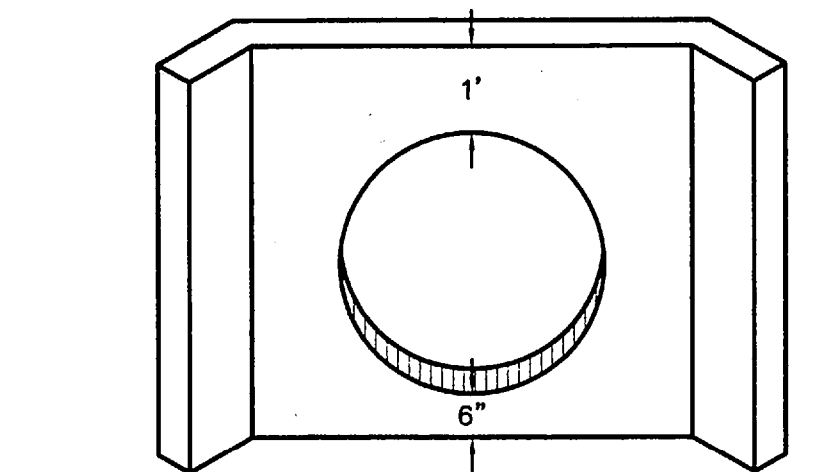


Outlet Headwall
(For Outlet Pipes of
10" to 33")

DATE: JAN 2000
DRAWING NO. WL-613
FILE NO. 00-613

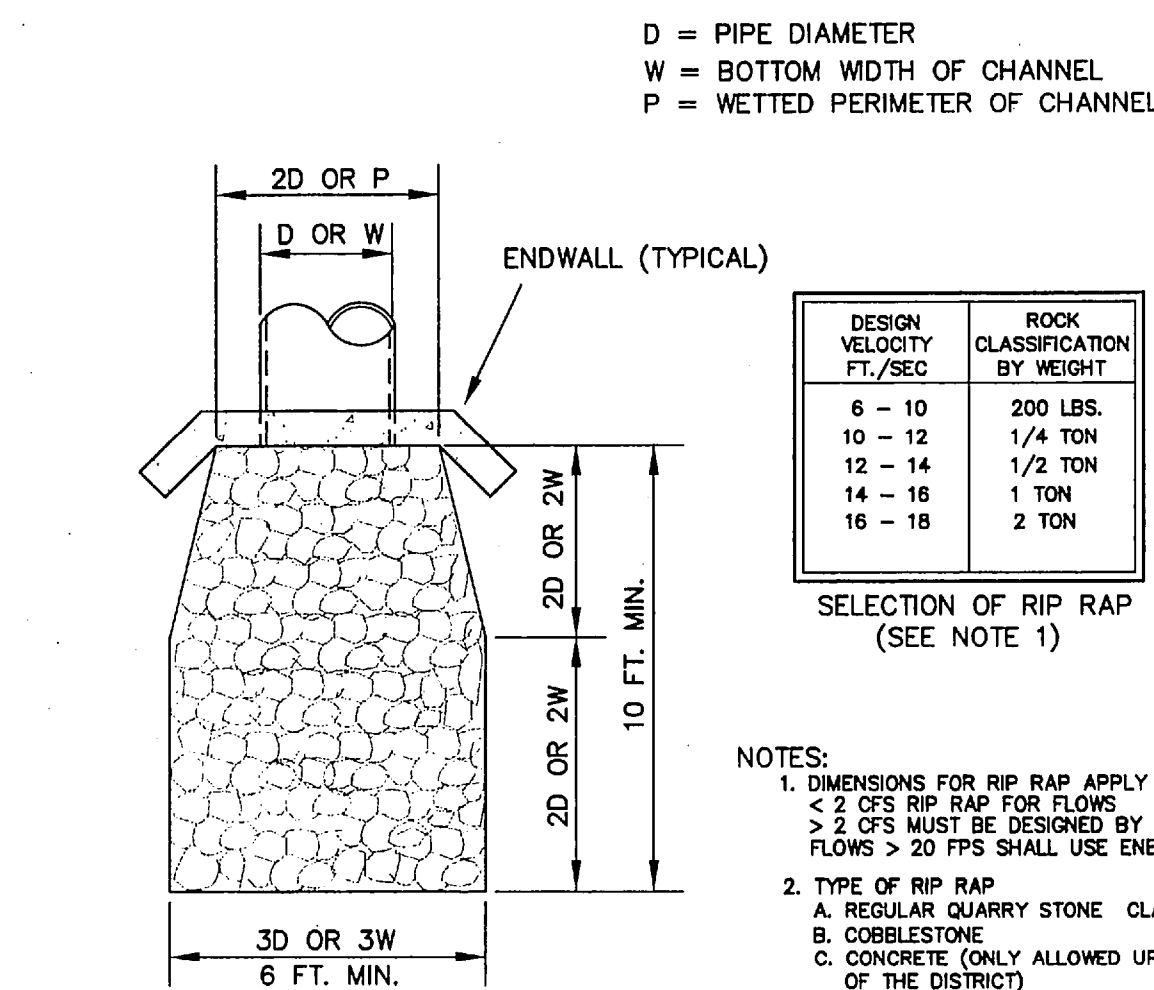

Storm Sewer Outfall

DATE: JAN 2000
DRAWING NO. WL-614
FILE NO. 00-614

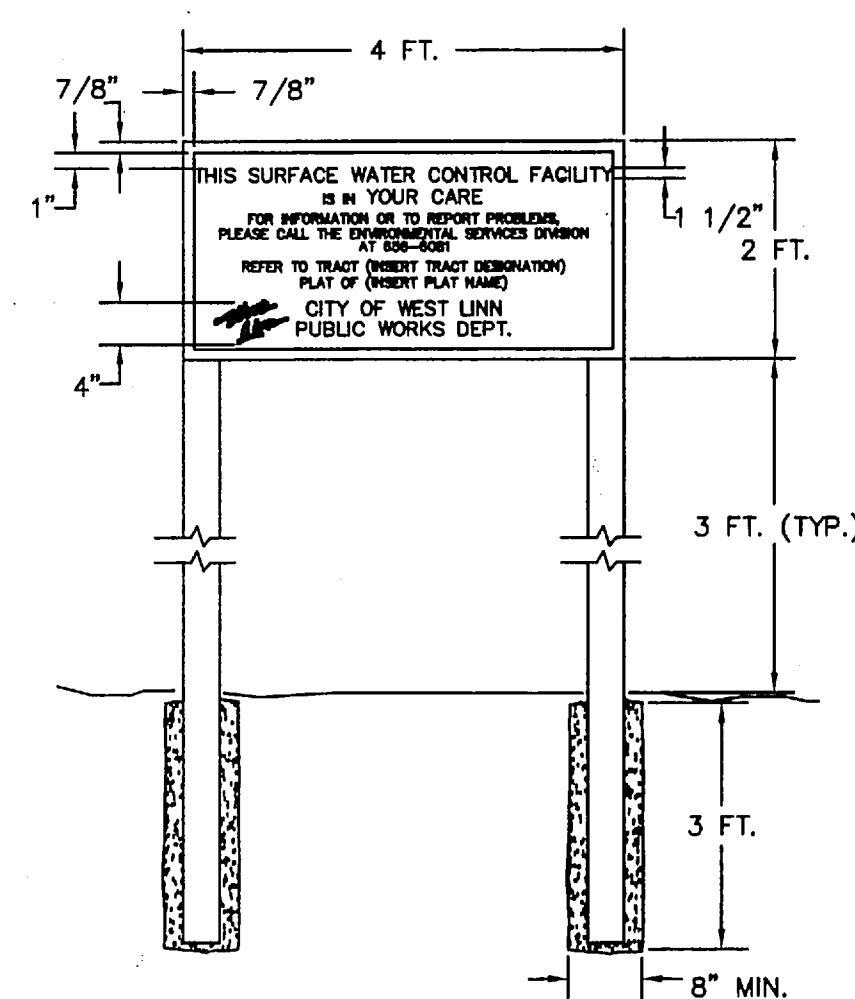


Surface Water Facility
Sign

DATE: JAN 2000
DRAWING NO. WL-615
FILE NO. 00-615

08/21/2001

Date
AAH/BLW/JAH
Designed
AAH/BLW/JAH
Drawn

Checked By Date

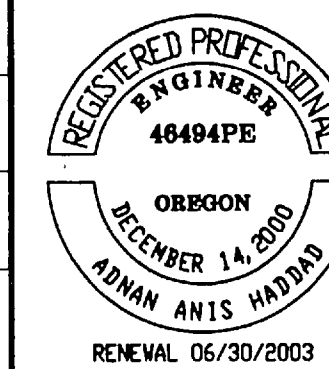

NORWAY DEVELOPMENT

P.O. Box 387
Oregon City, Oregon 97045
PHONE: (503) 656-7000
FAX: (503) 656-0686

Tanner's Stonegate

CITY OF WEST LINN, OREGON

DETAIL SHEET

ASBUILTS



17355 SW Boones Ferry Road
Lake Oswego, OR 97035-8217
Phone: (503) 635-3818
FAX: (503) 635-5395

10579

Project No.

D579C5-3

File No.

C5.3


Sheet No.

Copyright 8001 ©

NOTES:

- HYDRANTS TO BE MUELLER CENTURION MDL A-423 ONLY WITH 1 1/2" OPER. NUTS OR CLOW MEDALLION F-2545.
- HYDRANT COLOR TO BE MILLER EQUIP. ENAMEL O E 40 (SAFETY YELLOW).
- JOINTS TO BE RESTRAINED BY 3/4" DIA. GALVANIZED STEEL RODS AND THRUST BLOCKS OR MEGA LUGS AND THRUST BLOCKS.

- ALL FITTINGS IN CONTACT W/CONCRETE SHALL BE WRAPPED IN PLASTIC. HYDRANT DRAIN HOLES TO REMAIN OPEN TO DRAIN ROCK AND OPERATIONAL.
- MIN. 4 CU. FT. OF 1 1/2"-3/4" CLEAN DRAIN ROCK SHALL BE PLACED AROUND SICE UP TO A MIN. OF 6" ABOVE DRAIN OUTLETS.
- WHERE PLANTER STRIP EXISTS, HYDRANT SHALL BE PLACED SO FRONT PORT IS A MINIMUM OF 24" BEHIND FACE OF CURB.
- WHERE INTEGRAL S/W & CURB EXISTS, HYD. SHALL BE PLACED AT BACK OF SIDEWALK, OR AS DIRECTED BY ENGINEER.
- THRUST BLOCK AT FIRE HYDRANT TEE SHALL HAVE A 3.7 SQ. FT. BEARING AREA.
- HYDRANT VALVE SHALL BE MUELLER RESILIENT WEDGE GATE VALVE #A-2380-16 ONLY.
- WHERE NO SIDEWALK EXISTS, PLACE A 5'x 5'x 4" THICK A.C. OR CONC. APRON AROUND HYDRANT.
- NO EXTENSIONS ALLOWED.

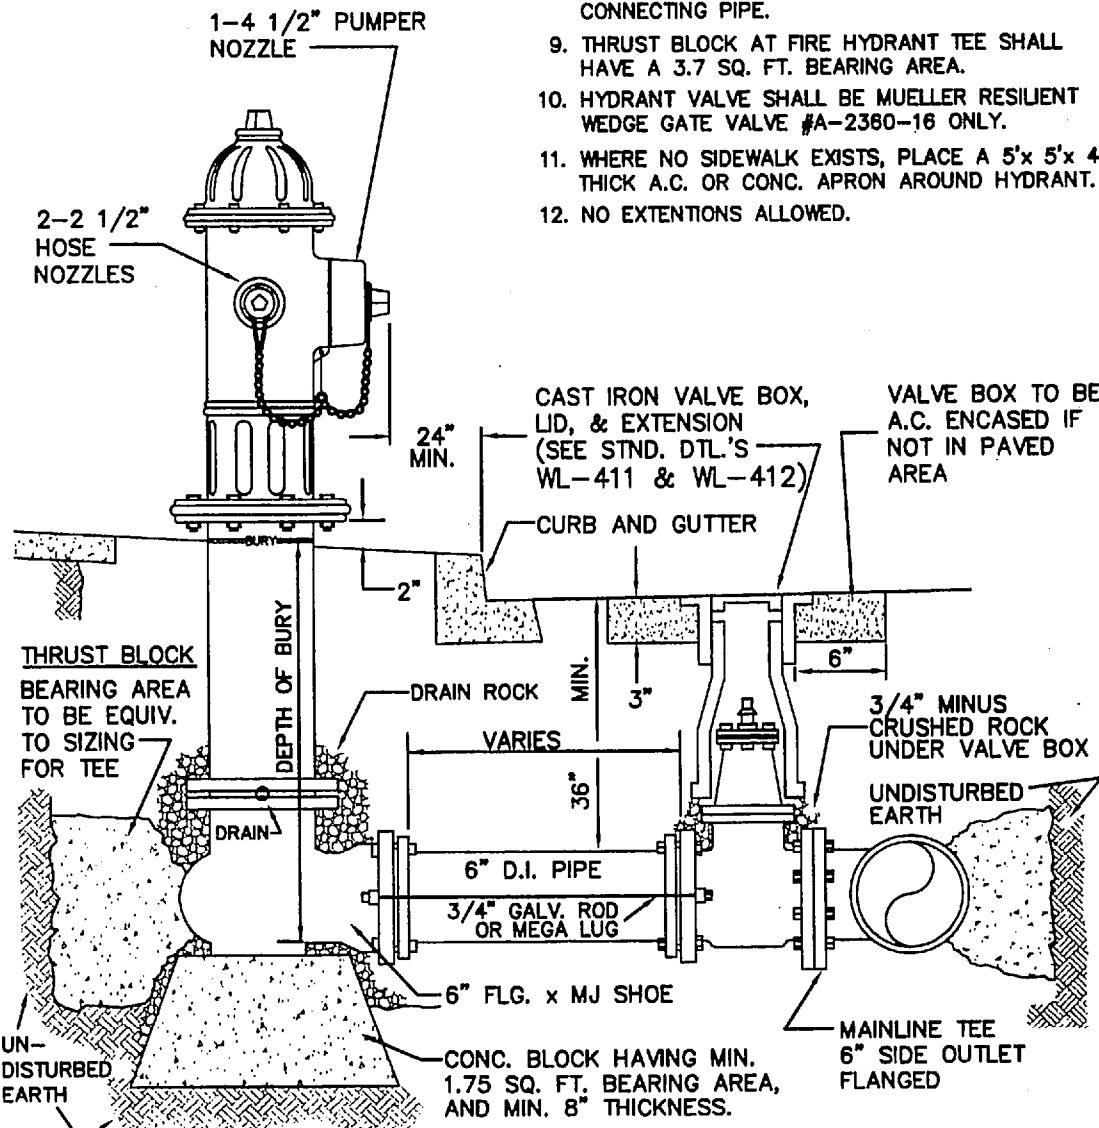


Standard Fire Hydrant Assembly

DATE: JAN 2000
DRAWING NO. WL-401
FILE NO. 00-401

FITTING SIZE (Inches)	TEE, WYE, & HYDRANTS	STRADDLE BLOCK	90° BEND PLUGGED CROSS TEE	45° BEND	22 1/2" BEND	11 1/2" BEND
2	*	*	*	*	*	*
4	1.7	2.1	2.4	1.3	*	*
6	3.7	4.9	5.3	2.9	1.5	*
8	6.7	8.7	9.5	5.1	2.7	1.3
10	10.5	13.6	14.8	8	4.1	2
12	15.1	19.6	21.3	11.6	5.9	2.9
14	26.8	34.8	37.9	20.5	10.4	5.2
16	33.9	44	47.9	25.9	12.8	6.7
LARGER	**	**	**	**	**	**


- ALL VALUES ARE BASED ON THE FOLLOWING ASSUMPTIONS:
AVG. PRESSURE = 100 PSI X 2 (safety factor); 1500 PSF SOIL BEARING CAPACITY; NORMAL DISTRIBUTION DESIGN VELOCITY NOT TO EXCEED 5 F/S.
- ALL FITTINGS SHALL BE WRAPPED IN PLASTIC PRIOR TO PLACEMENT OF CONCRETE.
- BEARING SURFACE OF THRUST BLOCKING SHALL BE AGAINST UNDISTURBED SOIL.
- ALL CONCRETE MIX SHALL HAVE A MIN. 28 DAY STRENGTH OF 3000 PSI.
- ALL PIPE ZONES SHALL BE GRAVEL FILLED AND COMPACTED.
- THRUST BLOCKS FOR PLUGGED CROSS AND PLUGGED TEE SHALL HAVE #4 REBAR LIFTING LOOPS INSTALLED AS SHOWN.
- VERTICAL THRUST DETAILS-SEE DWG. WL-407.
- STRADDLE BLOCK DETAILS-SEE DWG. WL-408.

- BLOCK TO UNDISTURBED TRENCH WALLS
- THRUST BLOCKS FOR PIPES LARGER THAN 18" WILL BE INDIVIDUALLY DESIGNED BY THE ENGINEER.

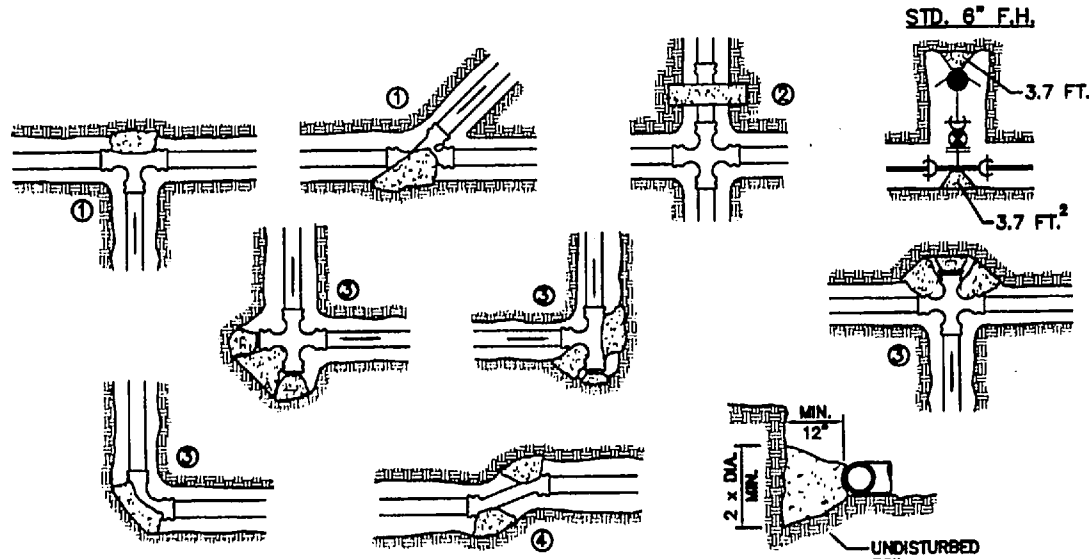

Horizontal Thrust Blocking

DATE: JAN 2000
DRAWING NO. WL-406
FILE NO. 00-406

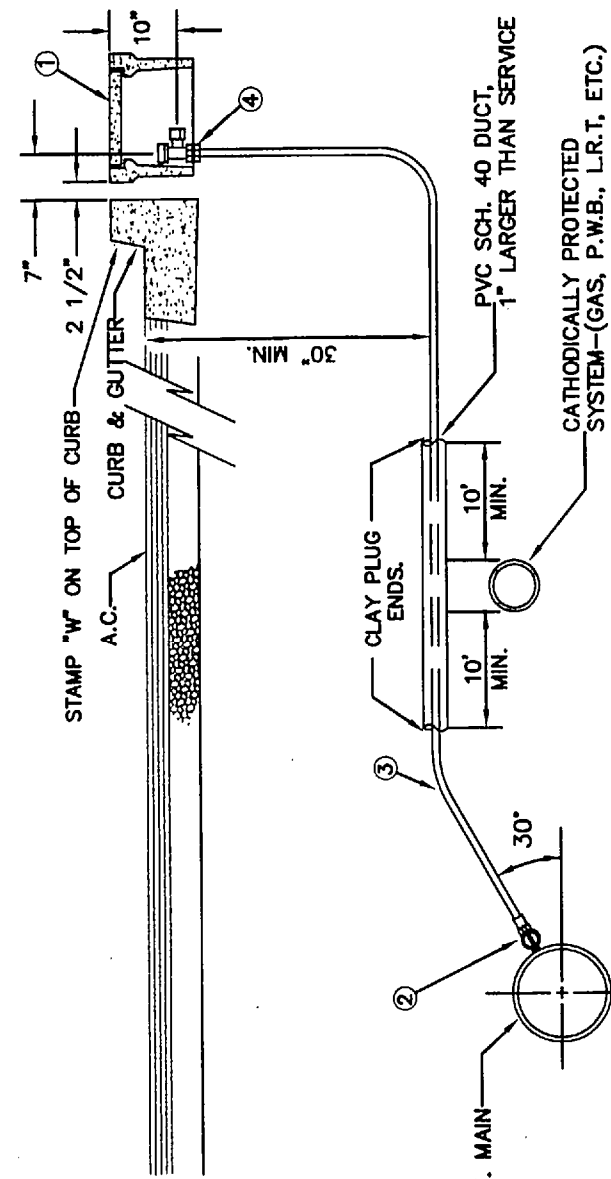

Standard 1" Water Service

Standard 1" Water Service

DATE: JAN 2000
DRAWING NO. WL-402
FILE NO. 00-402

MATERIALS:

- CONCRETE STRADDLE BLOCK.
- UNI-FLANGE, SERIES 400C, CLASS 125
- #4 REBAR EACH WAY, 12" O/C.
- 3/4" ALL THREAD GALVANIZED STEEL TIE RODS, QUANTITY PER ENGINEER.
- 3/4" GALVANIZED NUTS, 2-EACH SIDE
- 3/4" GALVANIZED NUTS, 1-EACH SIDE
- FLANGED FITTING

NOTES:

- STRADDLE BLOCKS SHALL BE DESIGNED INDIVIDUALLY BY THE ENGINEER AND SHALL BE BASED ON THE FOLLOWING:
a.) 200 PSI WATER PRESSURE
b.) SOIL BRG. CAPACITY, STEEL SIZE AND SPACING BY THE ENGINEER.
- BEARING AREA OF BLOCK SHALL BE AGAINST UNDISTURBED SOIL.
- STRADDLE BLOCK SHALL HAVE A MINIMUM OF 18" COVER.
- CONCRETE SHALL HAVE A MIN. 28-DAY STRENGTH OF 3300 PSI
- ALL FITTINGS WITHIN THE CONC. SHALL BE WRAPPED IN PLASTIC OR BE COATED W/ KOPPER'S #50.
- STRADDLE BLOCK HEIGHT(H) & WIDTH(W) SHALL BE DETERMINED BY THE ENGINEER.


Standard Straddle Block

DATE: JAN 2000
DRAWING NO. WL-408
FILE NO. 00-408

MAIN SIZE	BLOW-OFF SIZE
4" TO 6"	2"
8" TO 12"	4"
14" TO 18"	6"
20" & UP	PER ENGR.


NOTES:

- BACKFILL WITH SELECT CRUSHED AGGREGATE A MINIMUM OF 6" ON ALL SIDES.
- ON TEMPORARY BLOW-OFFS ONLY, AN MJ CAP TAP- PED 4" OR 6" MAY BE SUBSTITUTED FOR REDUCER.
- TEMPORARY BLOW-OFF IS ONE REMOVED AT THE END OF PROJECT CONSTRUCTION. A PERMANENT BLOW-OFF REMAINS ON THE PROJECT AFTER ACCEPTANCE.
- PLACE BLOW-OFF STANDPIPE 3 FT. INSIDE R.O.W. LINE AT END OF STREET (2FT. FROM BARRICADE).

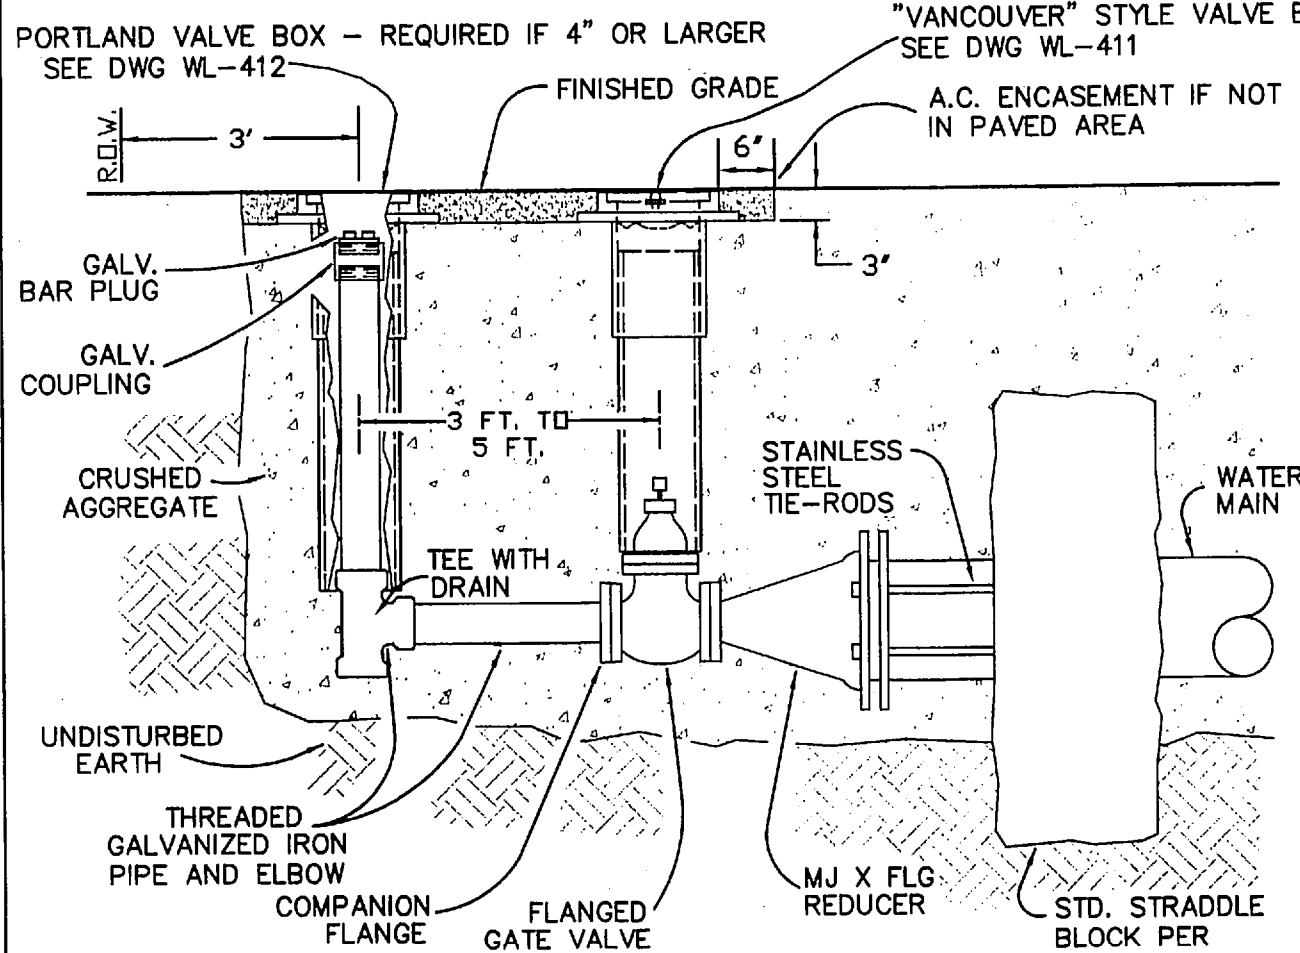

Permanent or Temporary 4" & 6" Blow-off

DATE: JAN 2000
DRAWING NO. WL-404B
FILE NO. 00-404B

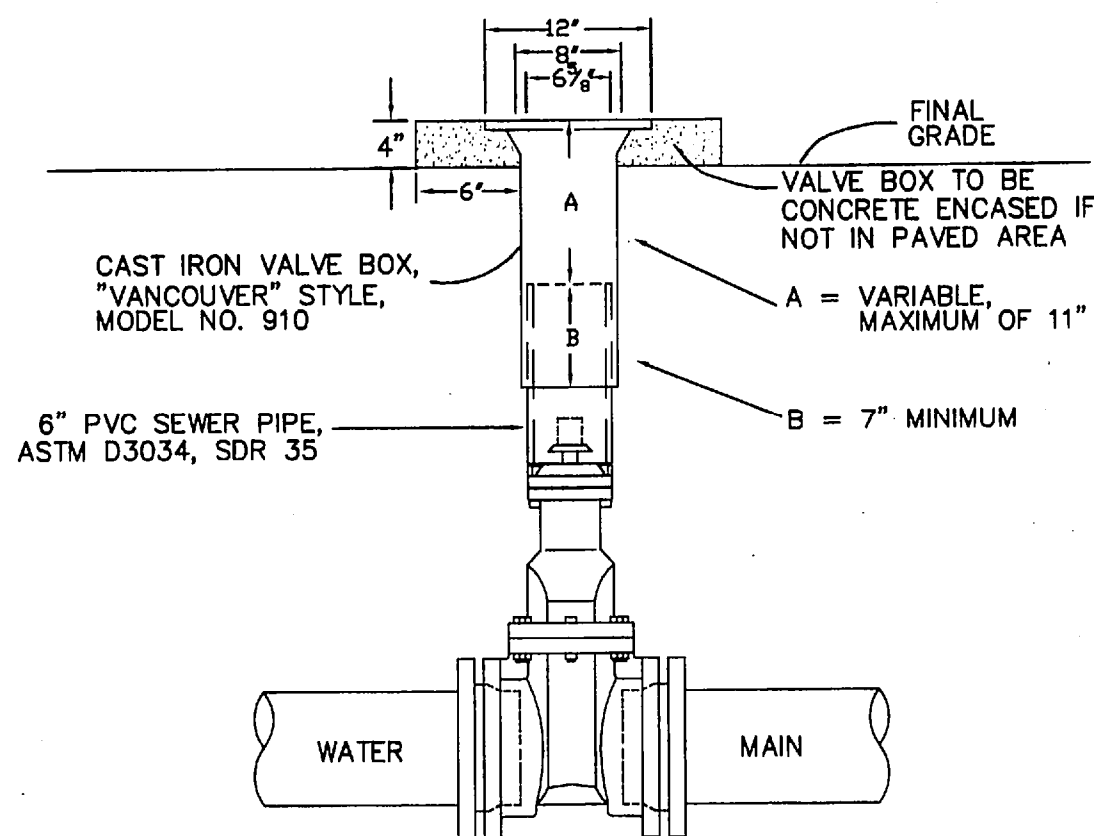


NOTES:


- VALVE BOXES SHALL BE CENTERED DIRECTLY OVER THE VALVE NUT IN A VERTICAL POSITION.
- VALVE BOX TOP SHALL BE ADJUSTED TO MEET FINISHED GRADE.
- PVC SHALL BE ONE CONTINUOUS PIECE- NO BELLS OR COUPLERS.
- ON VALVES 8" AND LARGER, PVC SHALL BE NOTCHED OVER VALVE PACKING BOLTS SO PVC SITS ON BONNET.

Standard Valve Box Detail


DATE: JAN 2000
DRAWING NO. WL-411
FILE NO. 00-411

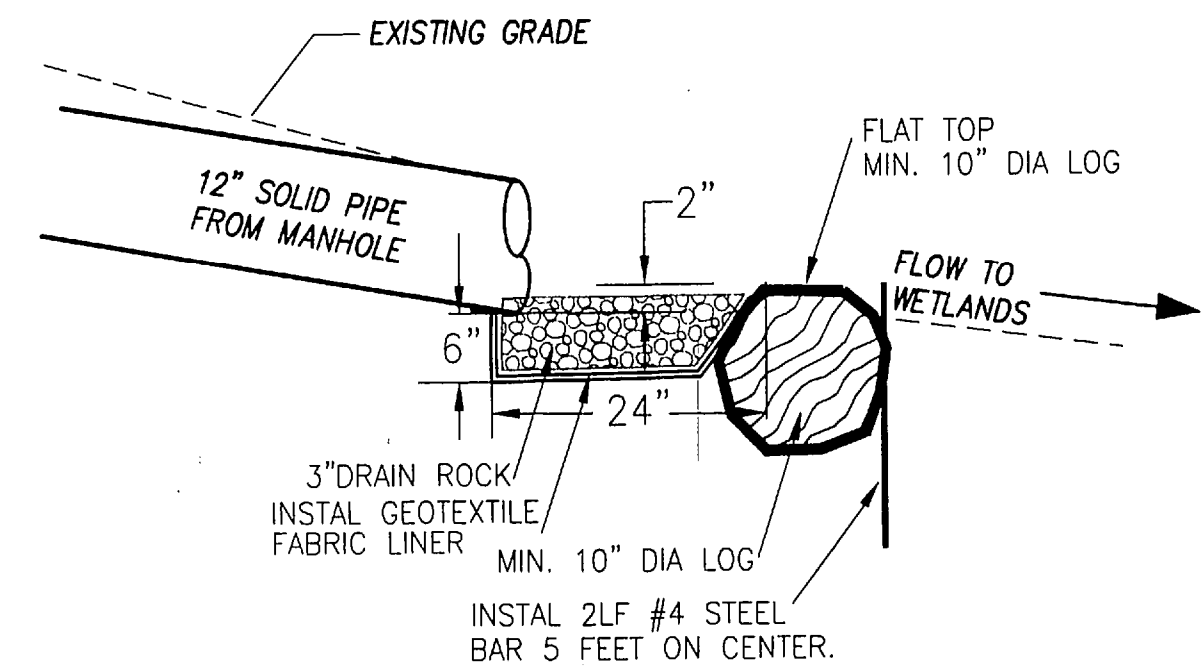

12/50 SPREADER

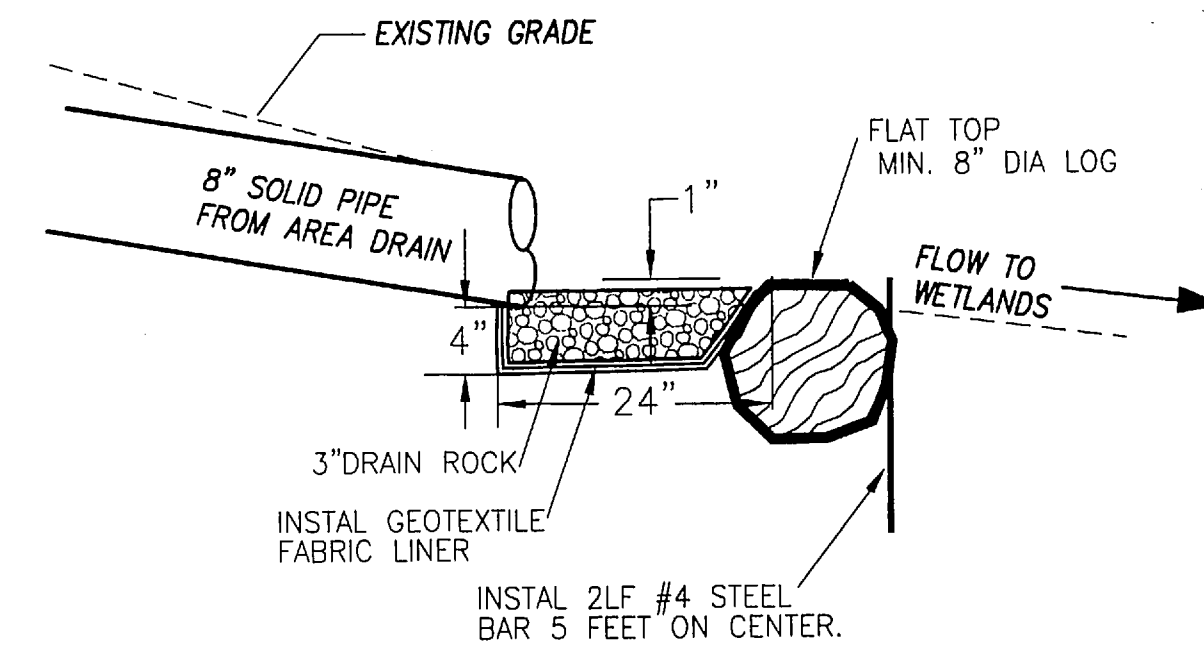

8/30 SPREADER

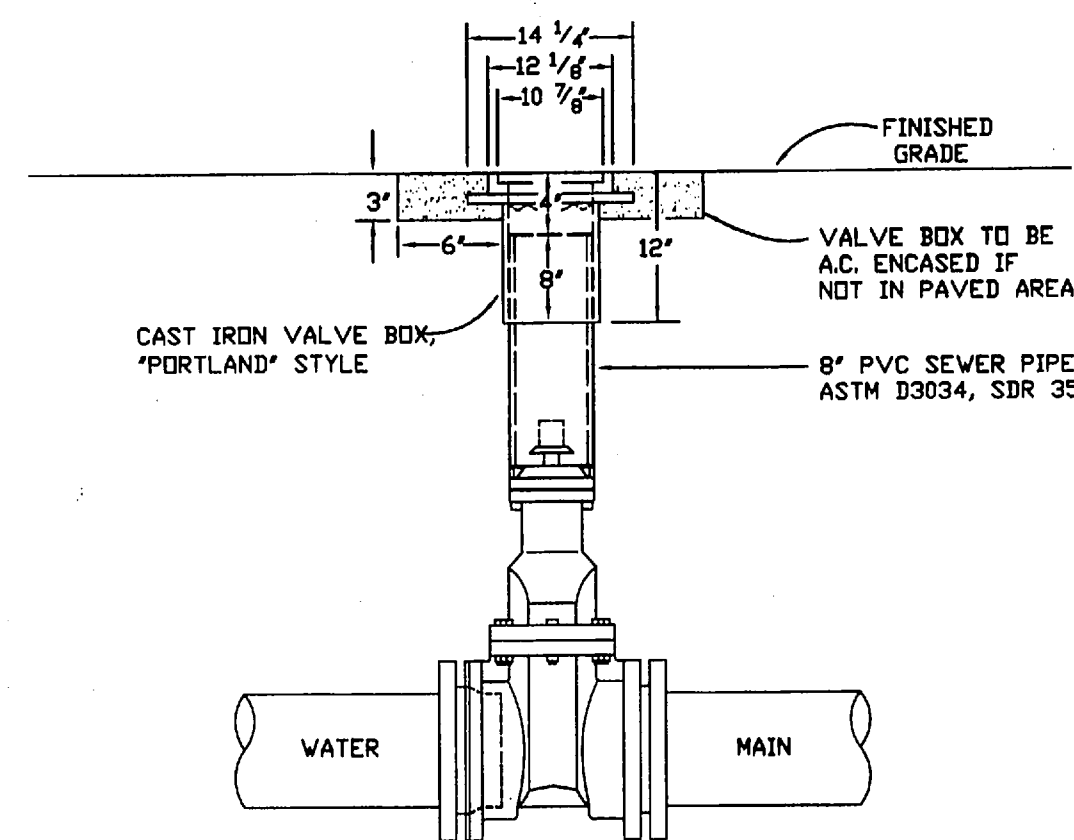


NOTES:

- VALVE BOXES SHALL BE CENTERED DIRECTLY OVER THE VALVE NUT IN A VERTICAL POSITION.
- VALVE BOX TOP SHALL BE ADJUSTED TO MEET FINISHED GRADE.
- PVC SHALL BE ONE CONTINUOUS PIECE- NO BELLS OR COUPLERS.


Standard Valve Box Detail for 4" or Larger Blow-offs

DATE: JAN 2000
DRAWING NO. WL-412
FILE NO. 00-412


XREF LIST
Ltscale: 1
Resolved
D579X190
D579X230
D579X400
D579X430
D579X600
D579X902
TRAILS

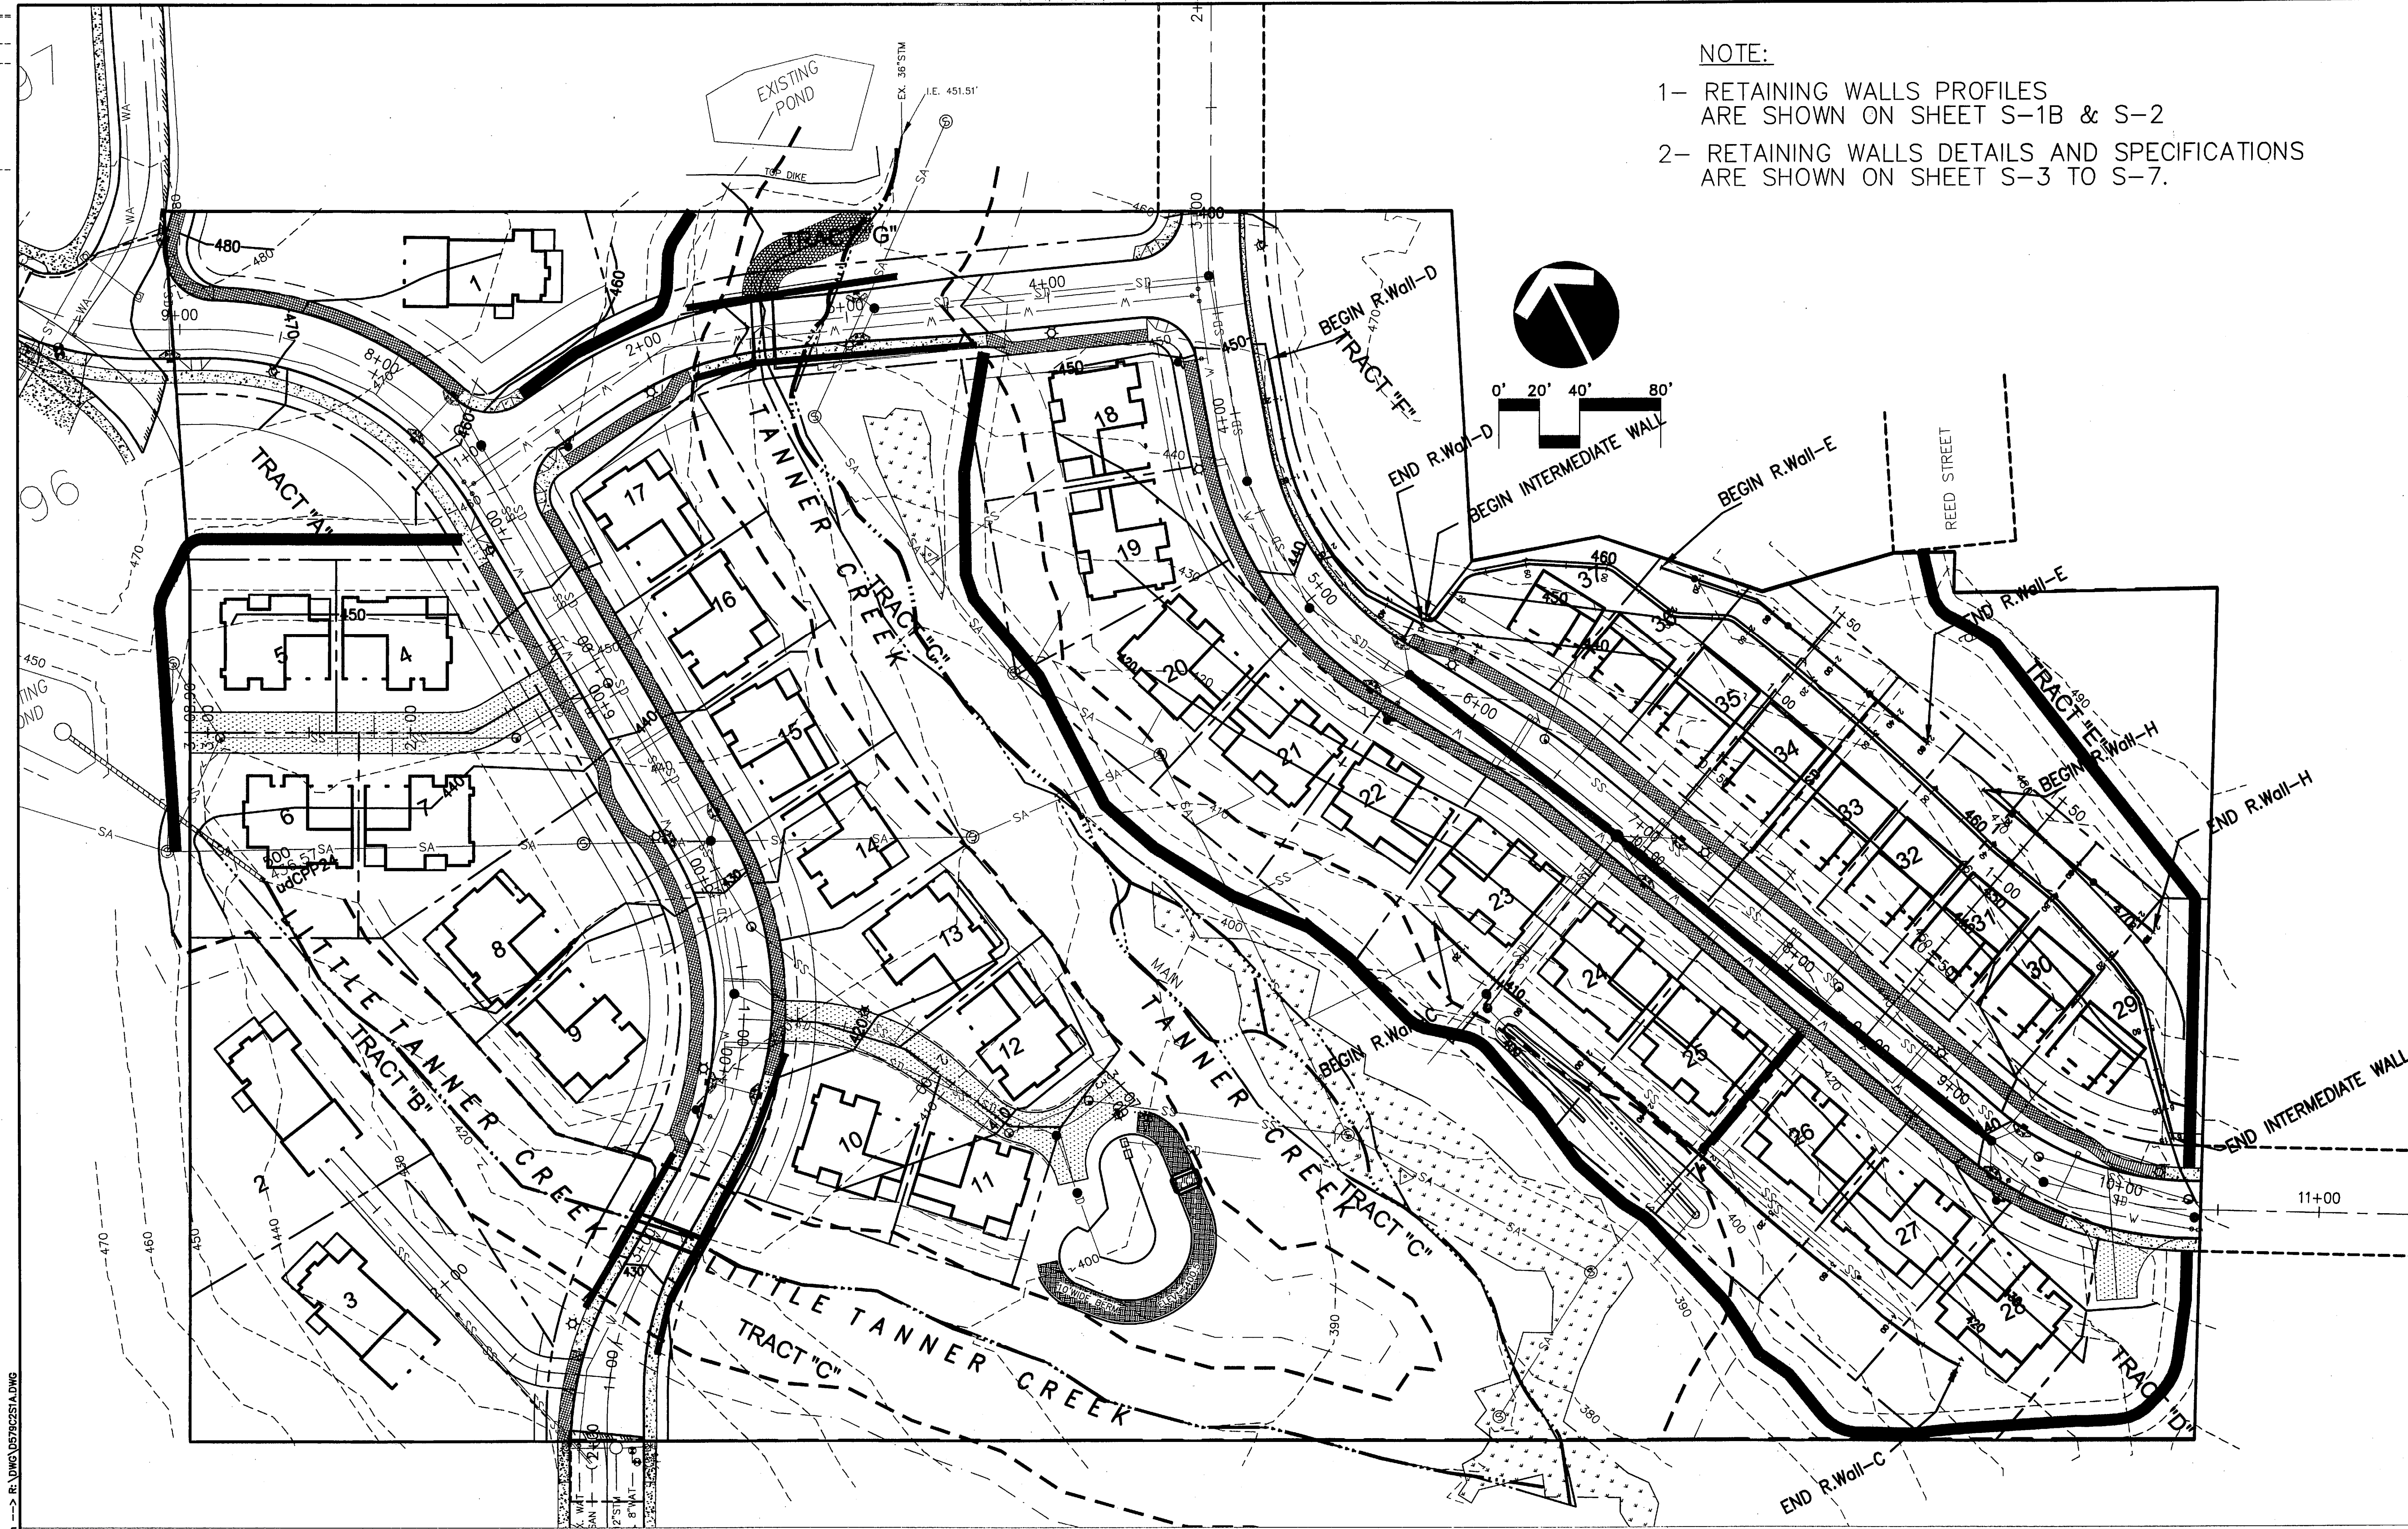

NOTE:
1- RETAINING WALLS PROFILES
ARE SHOWN ON SHEET S-1B & S-2
2- RETAINING WALLS DETAILS AND SPECIFICATIONS
ARE SHOWN ON SHEET S-3 TO S-7.

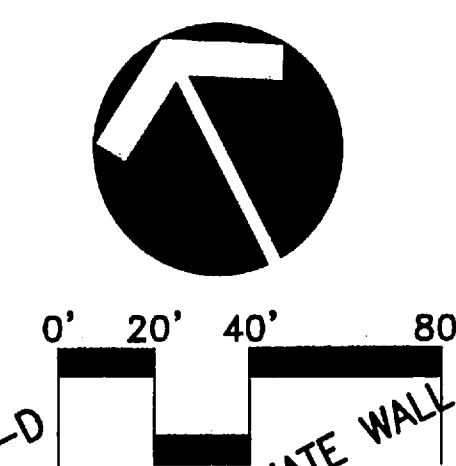

REVISIONS	Date	7/21/01	
	Designed	DAVID HALL	
	Drawn	DAVID HALL	
	Checked By	Date	
NO.	DATE	BY	APPD.
	DAH/SE		
	NORWAY DEVELOPMENT		
	P.O. Box 387 Oregon City, Oregon 97045 PHONE: (503) 656-7000 FAX: (503) 656-0686		
Tanner's Stonegate			
CITY OF WEST LINN, OREGON			
RETAINING WALLS PLAN			
AS BUILTS	Project No.	10579	
	File No.	D579C2S1A	
	Sheet No.	S-1A	
	Copyright 2001		

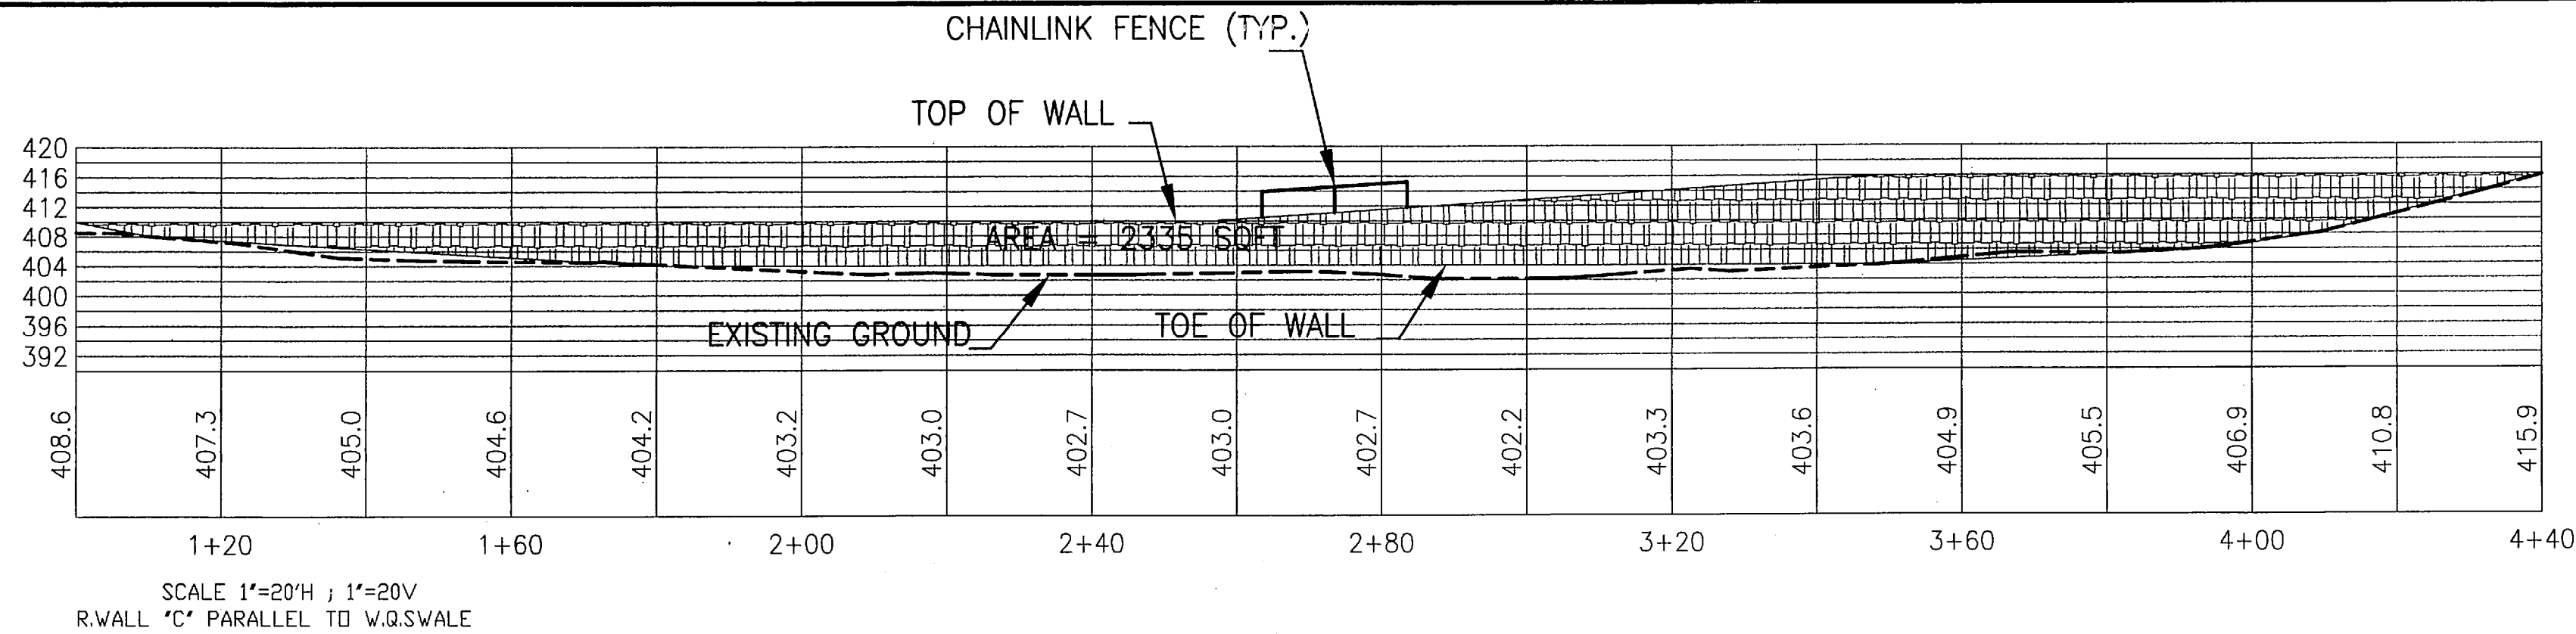


WALL C DRAIN SYSTEM TO BE CONNECTED TO DITCH INLET E2 (AT END OF SWALE) BEHIND LOT 26.
WALL C DRAIN SYSTEM TO BE CONNECTED TO DITCH INLET E2 (AT END OF SWALE) BEHIND LOT 26.

**ROCK WALL
RETAINING WALL "C" PROFILE**

SCALE: HORIZONTAL 1"= 20'
VERTICAL 1"= 20'

2
S-1

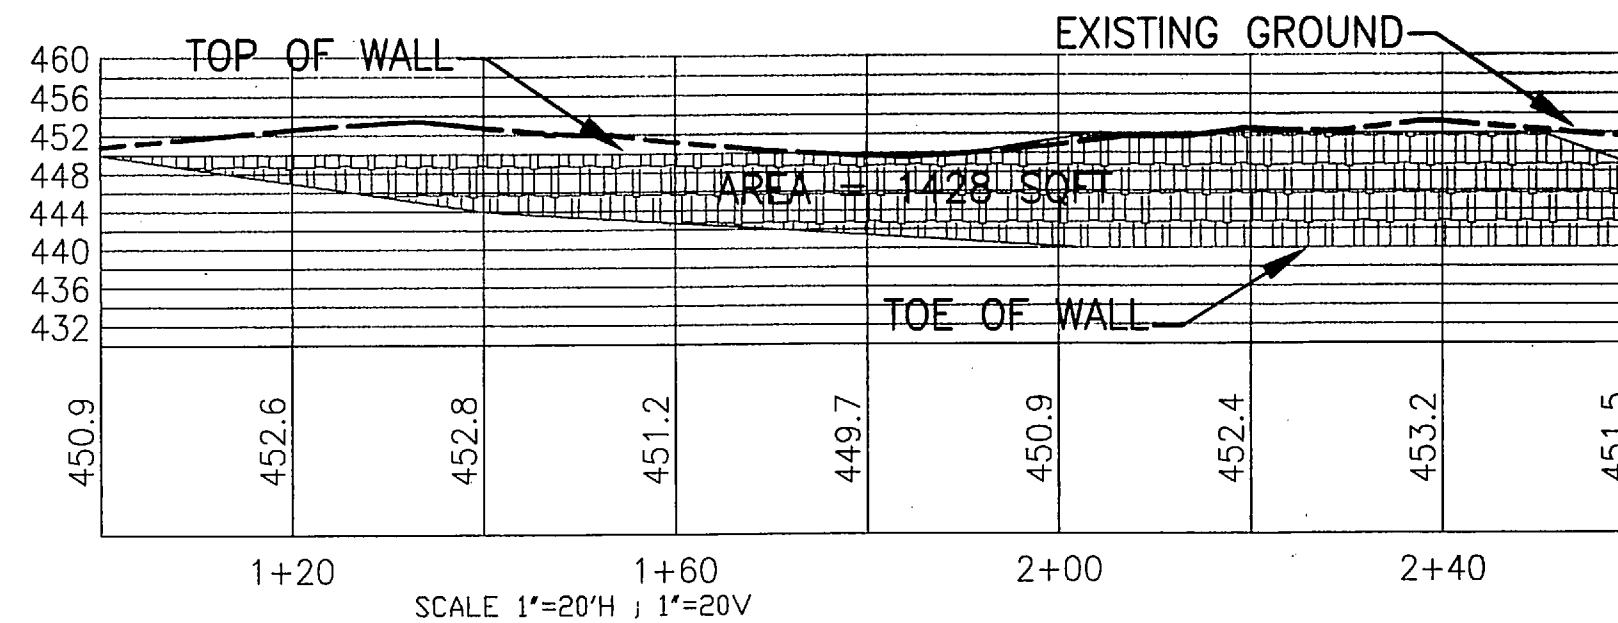


WALL D DRAIN SYSTEM TO BE CONNECTED TO CATCH BASIN C1B AT STA 5+50 AT LANDIS STREET.

**ROCK WALL
RETAINING WALL "D" PROFILE**

SCALE: HORIZONTAL 1"= 20'
VERTICAL 1"= 20'

3
S-1

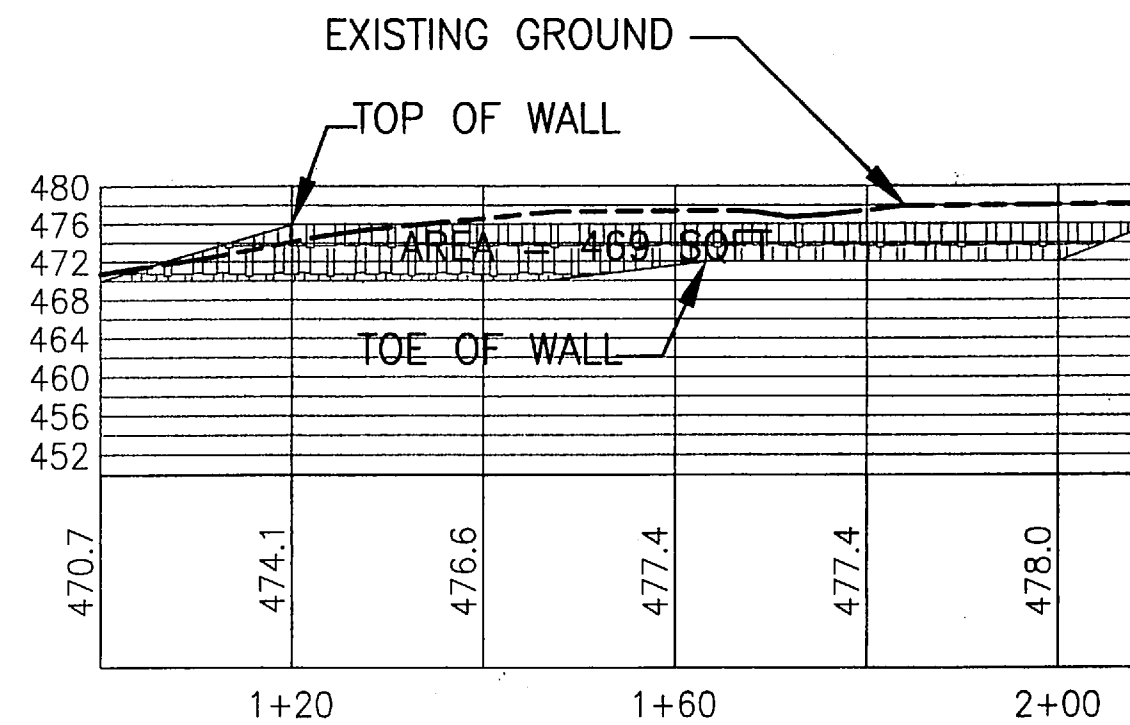


WALL "H" DRAIN SYSTEM TO BE EXTENDED AND CONNECTED TO
RETAINING WALL "F" DRAIN SYSTEM.

**ROCKER WALL
RETAINING WALL "H" PROFILE**

SCALE: HORIZONTAL 1"= 20'
VERTICAL 1"= 20'

7
S-1

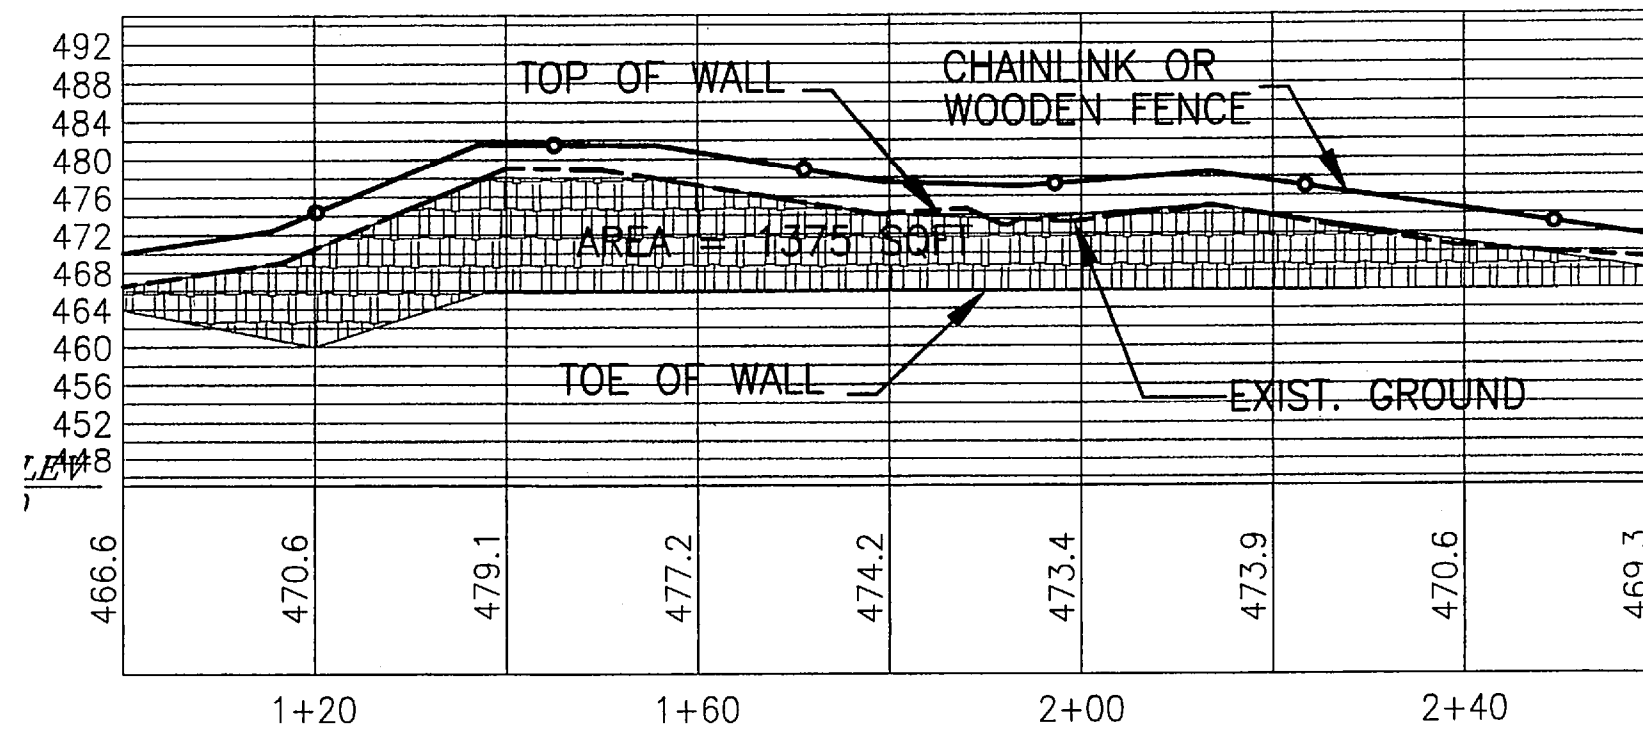

WALL "E" DRAIN SYSTEM TO BE CONNECTED TO CATCH BASIN B3B AT STA 7+20 AT LANDIS STREET.

**ROCK WALL
RETAINING WALL "E" PROFILE**

SCALE: HORIZONTAL 1"= 20'
VERTICAL 1"= 20'

5
S-1

NOTE:

- 1- RETAINING WALLS DETAILS AND SPECIFICATIONS ARE SHOWN ON SHEET S3-S7.
- 2-ALL ROCK WALLS NOT TO EXCEED 8 FEET IN HEIGHT.
- 3-ALL CHAINLINK OR WOODEN FENCES SHALL BE 42" HIGH.

7/21/01
Date
DAVID HALL
Designed
DAVID HALL
Drawn
Checked By Date

REVISIONS
BY
DATE
APPD.
NO.


DAVID HALL
DAVID A. HALL ARCHITECTURAL ENGINEERING
P.O. BOX 6223
PORTLAND, OR 97202-1223
PHONE: (503) 656-7000
FAX: (503) 656-0666

NORWAY DEVELOPMENT
P.O. Box 387
Oregon City, Oregon 97045
PHONE: (503) 656-7000
FAX: (503) 656-0666


Tanner's Stonegate
CITY OF WEST LINN, OREGON
RETAINING WALLS PROFILES

10579
Project No.
D579C2S1B
File No.
S-1B
Sheet No.
Copyright 2001 ©


AS BUILTS

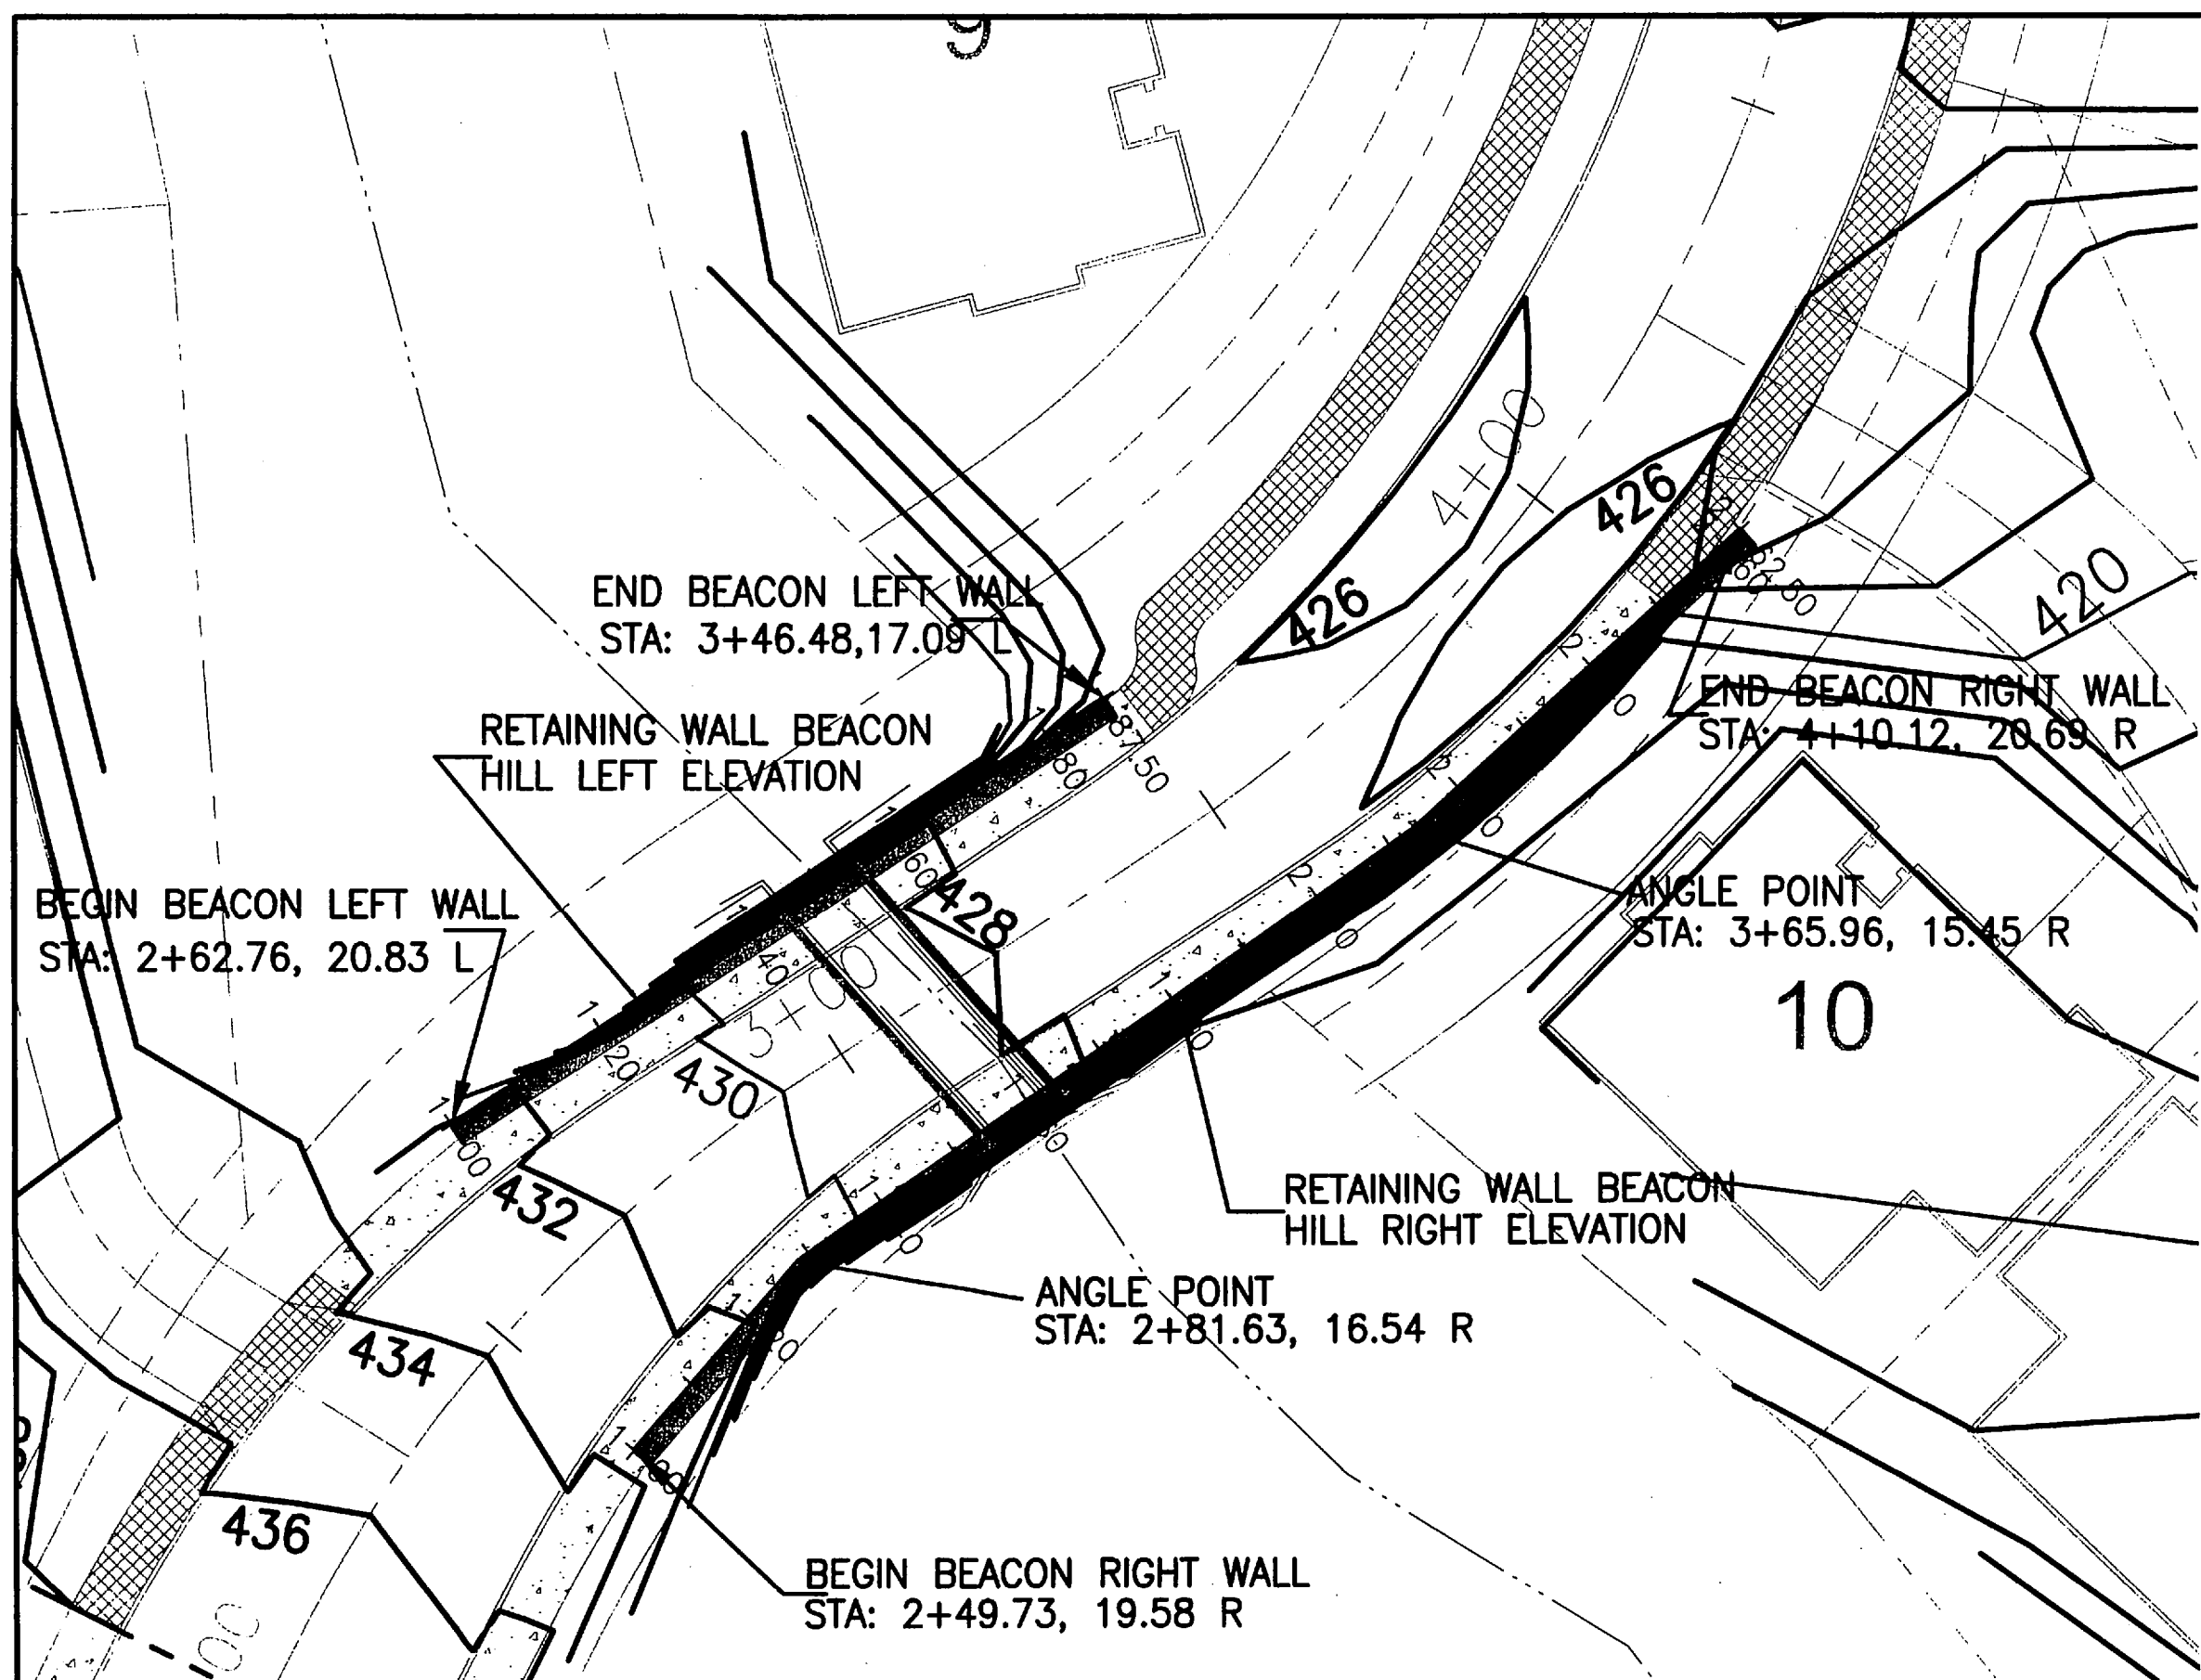


1 PLAN @ BEACON HILL CULVERT
SCALE: 1" = 20'-0"

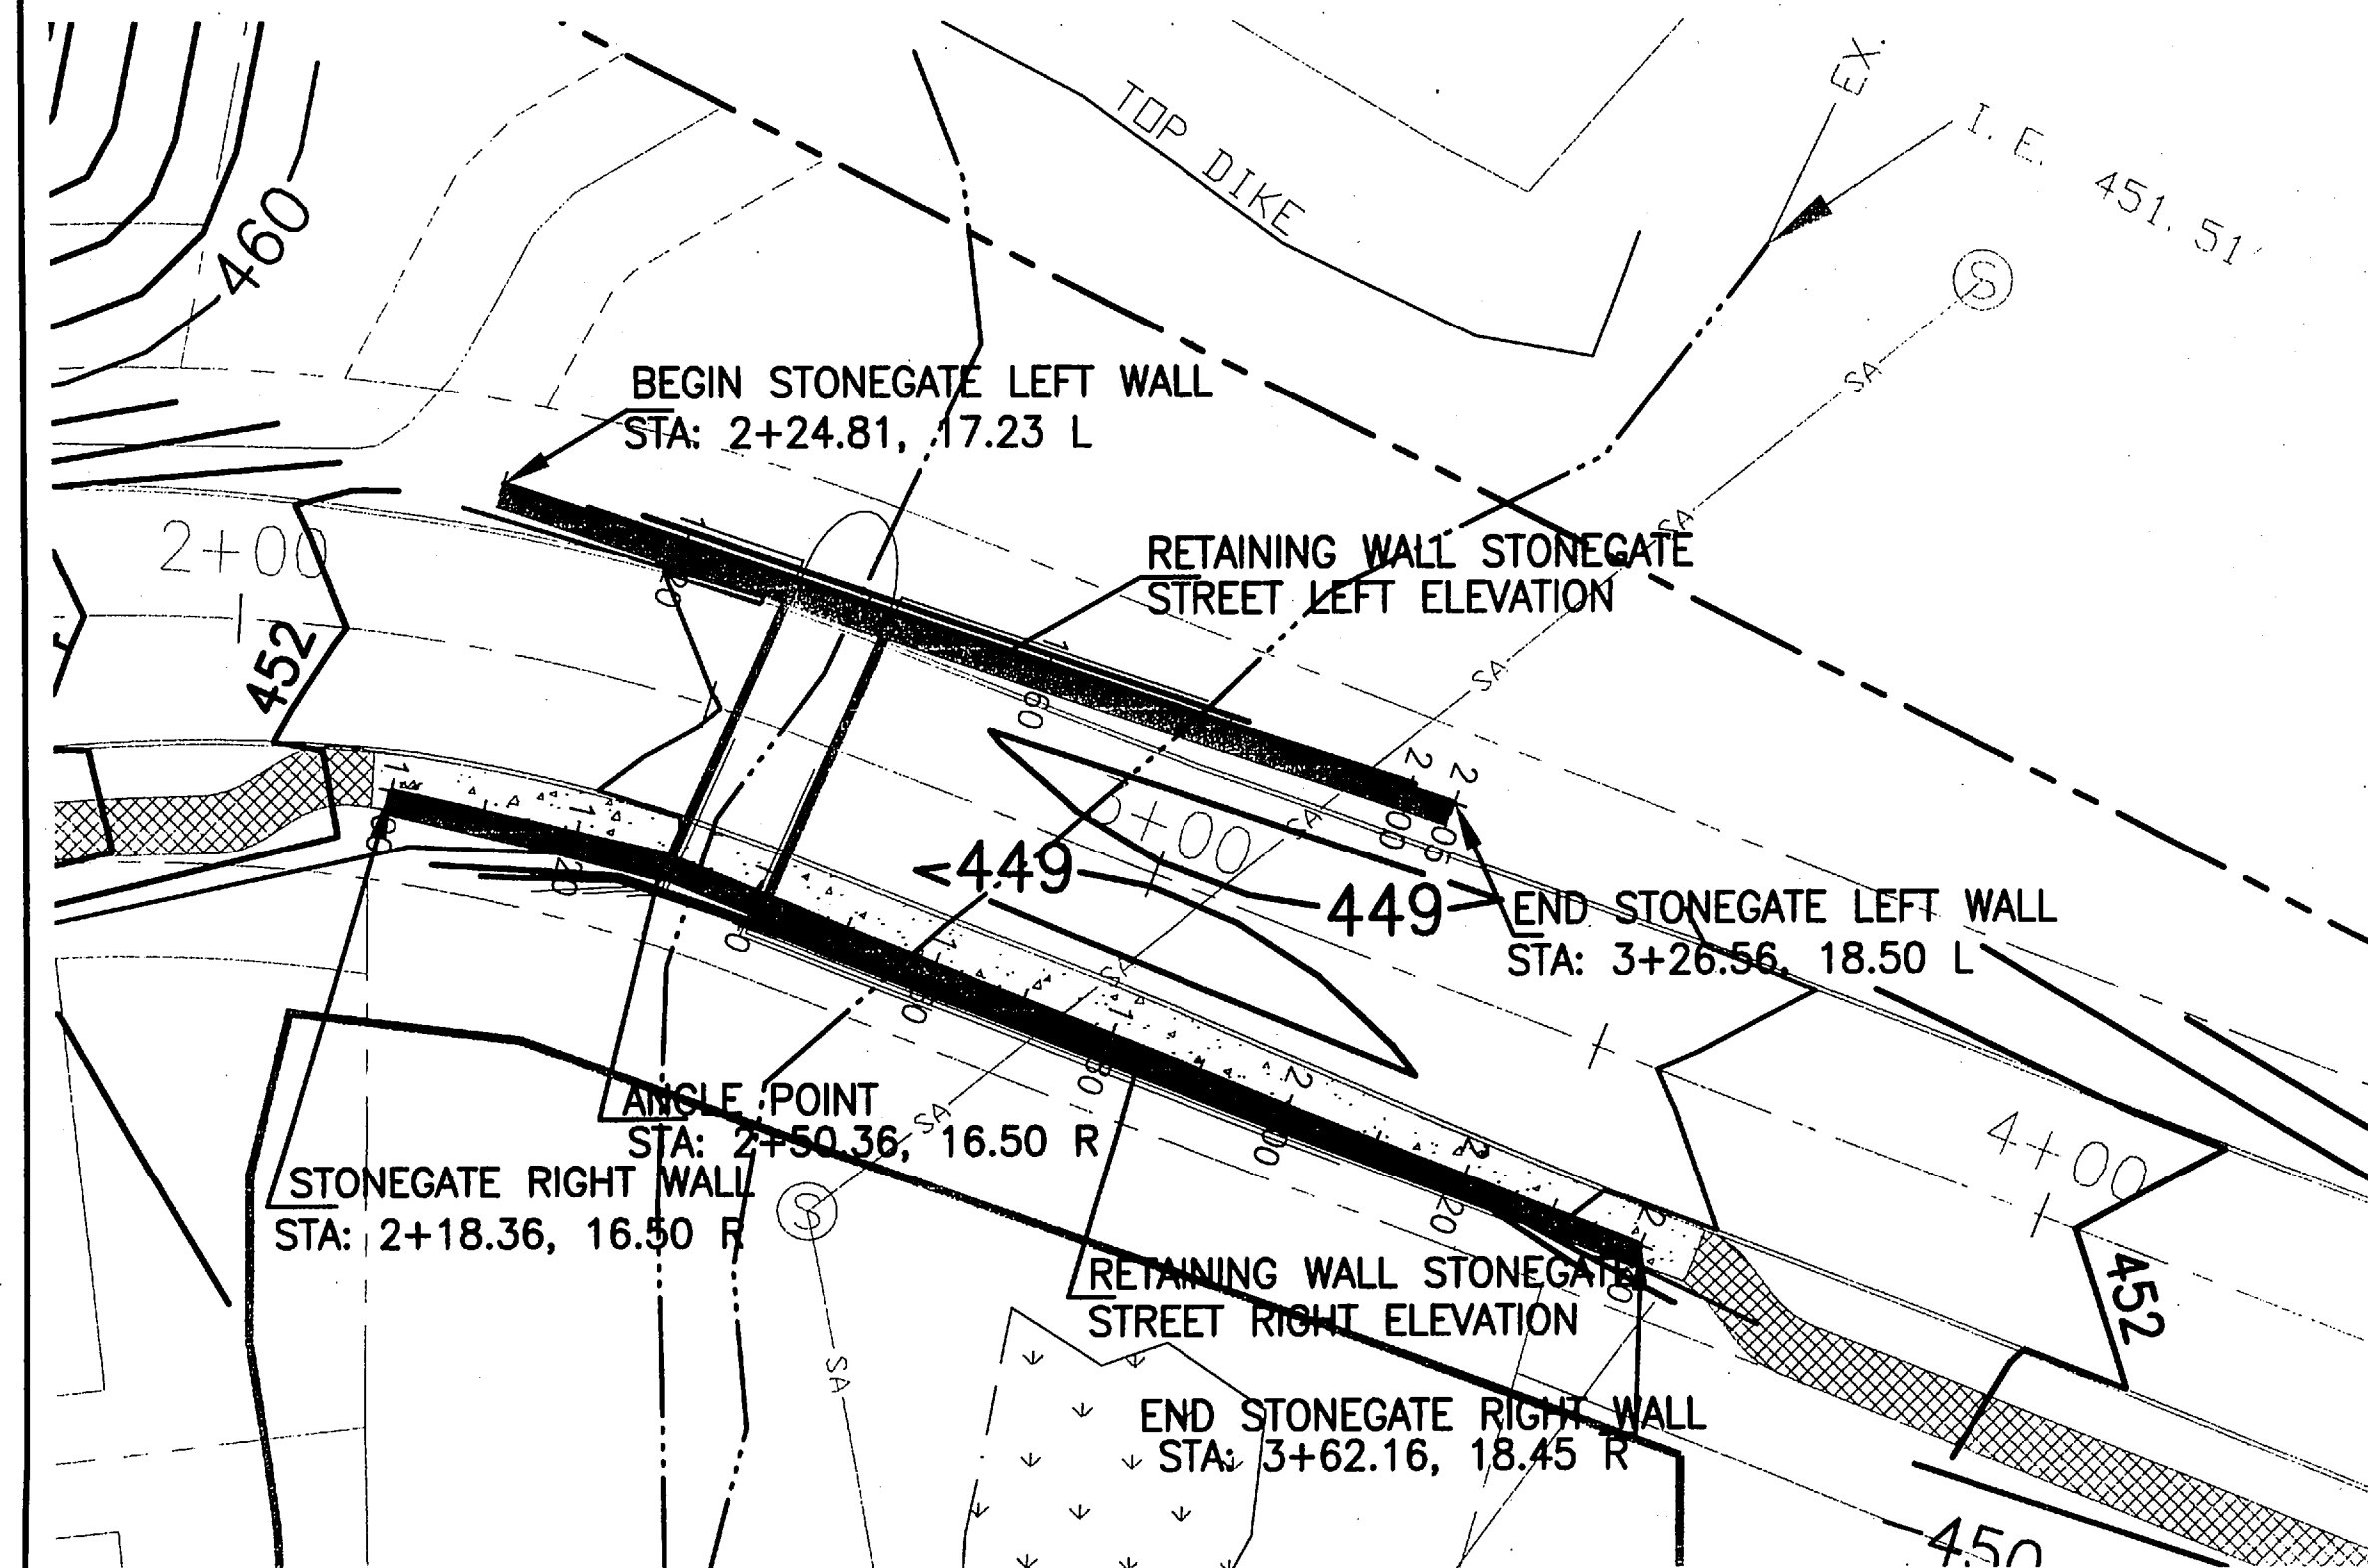

4 PLAN @ STONEGATE LANE CULVERT
SCALE: 1" = 20'-0"

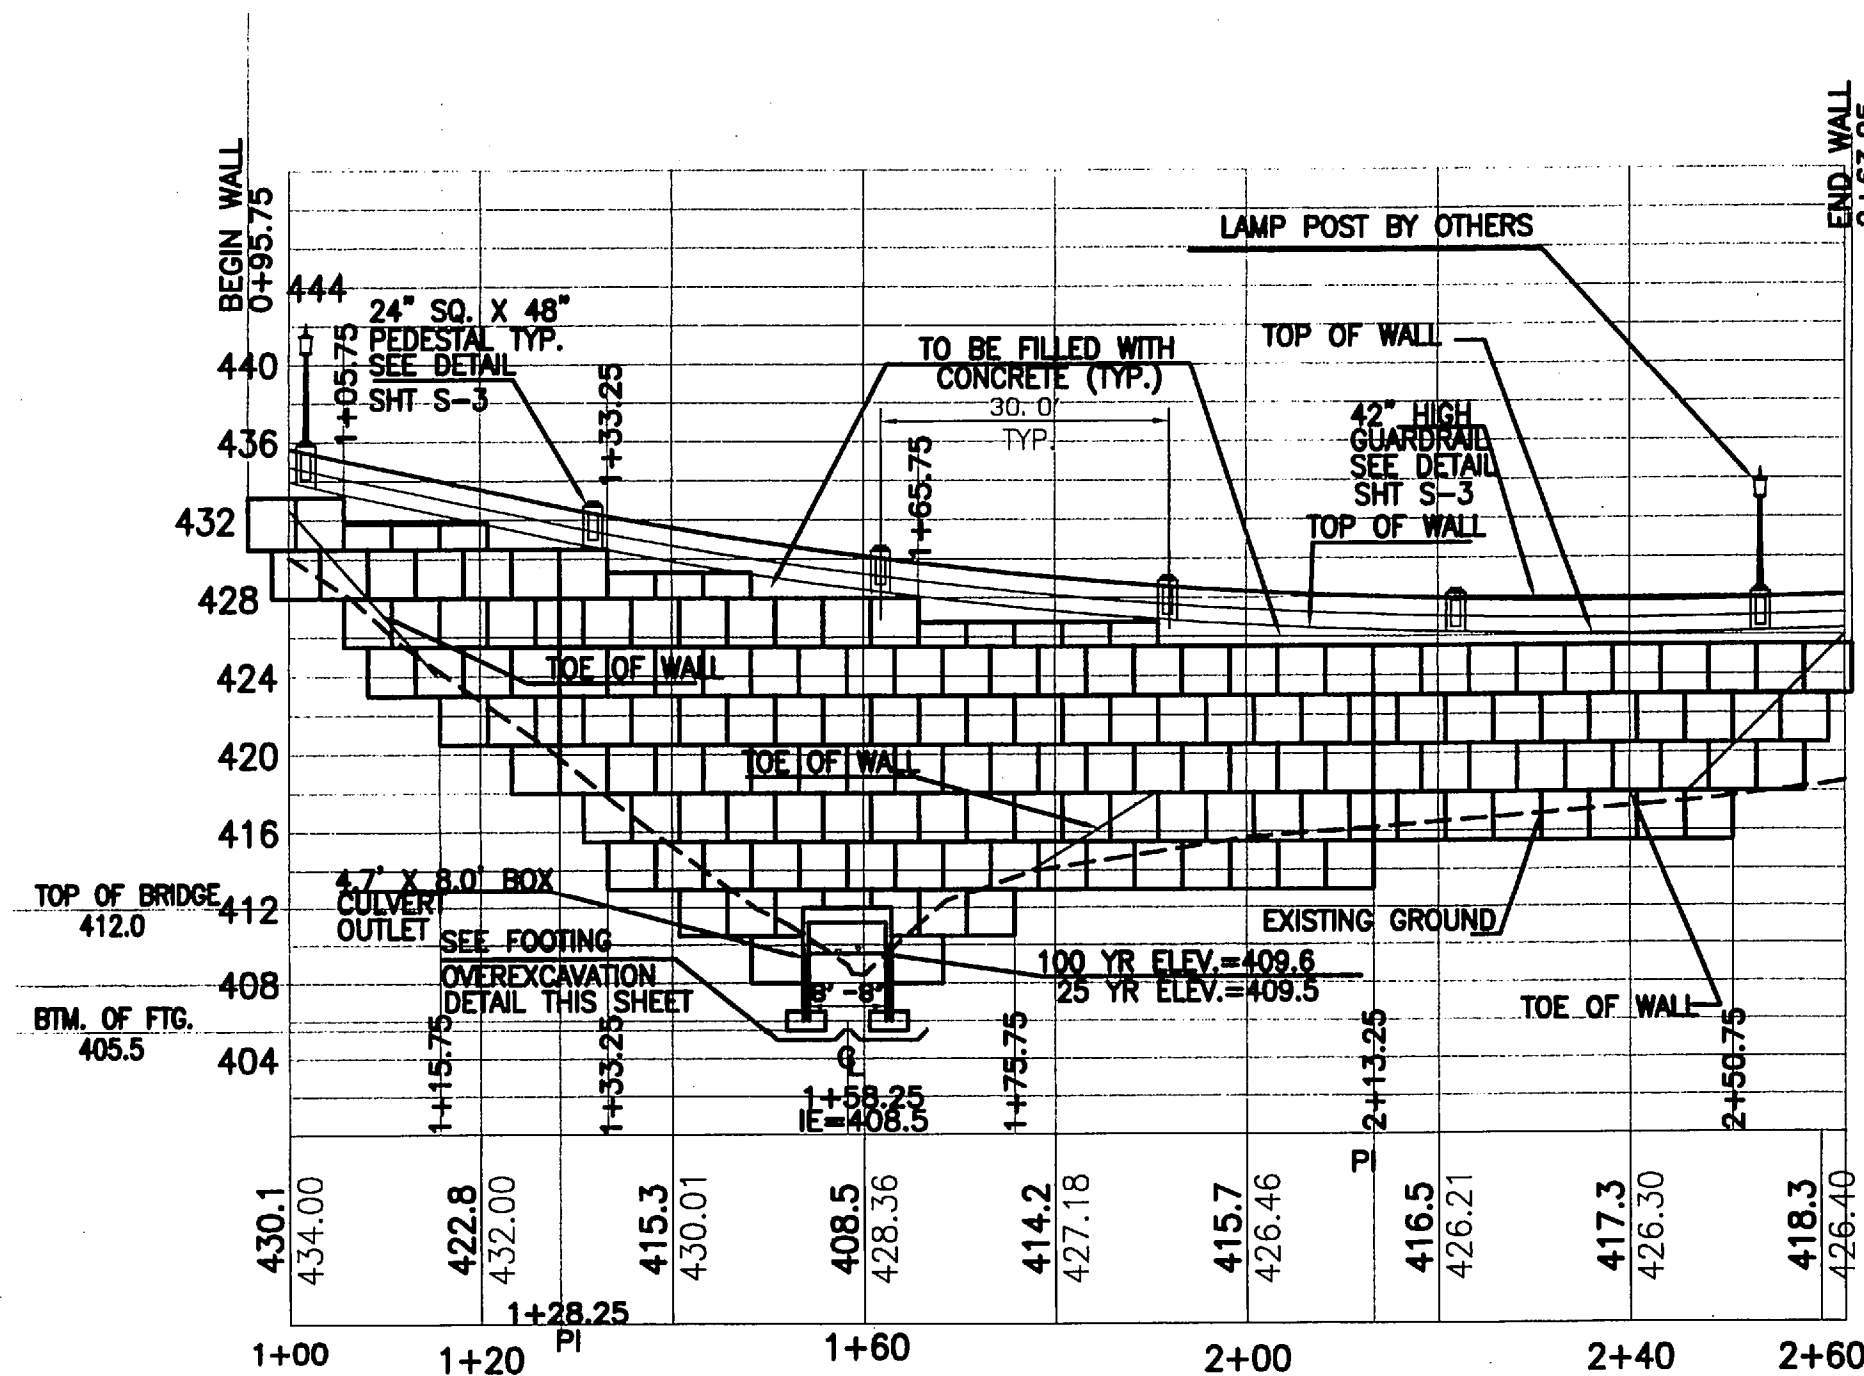


2 BEACON HILL RIGHT ELEVATION
SCALE: 1" = 20'-0" H, 1" = 10'-0" V

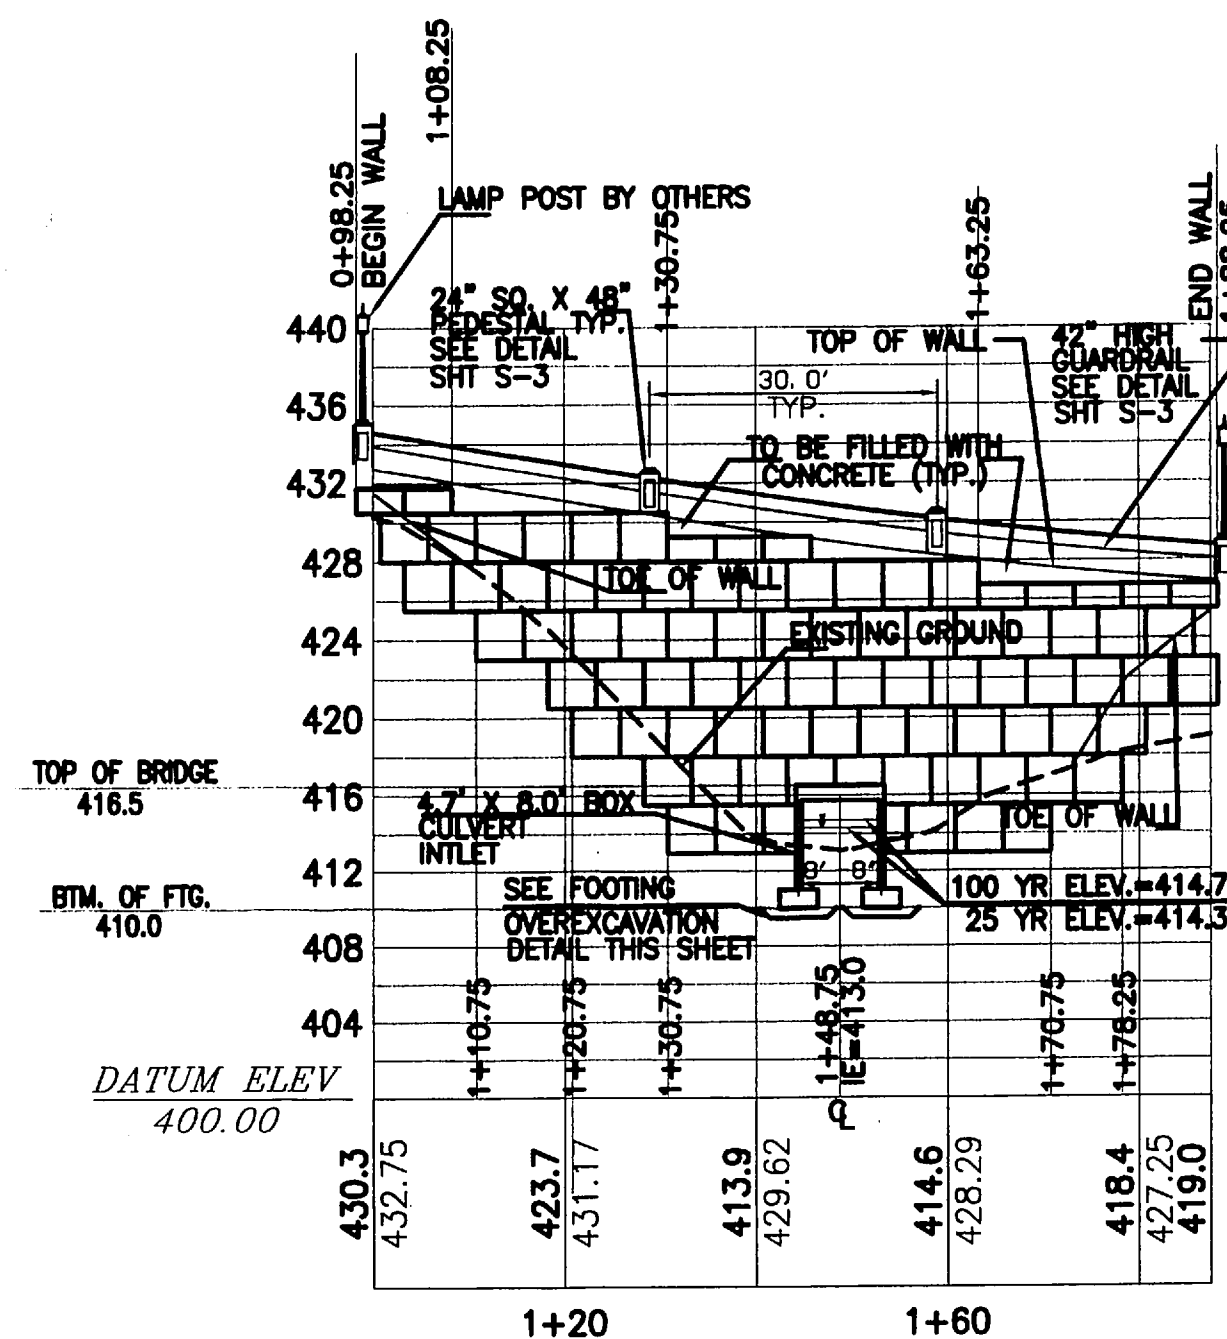


3 BEACON HILL LEFT ELEVATION
SCALE: 1" = 20'-0" H, 1" = 10'-0" V


- NOTE:
- FOR LAMP POST STATION AND LOCATION SEE STREET LIGHTING ON COMPOSITE UTILITY SHEET C1.3
 - Q100 ULTIMATE=54 CFS. AT LITTLE TANNER CREEK
 - Q25 ULTIMATE=38 CFS. AT LITTLE TANNER CREEK
 - Q100 ULTIMATE=300 CFS. AT TANNER CREEK
 - Q25 ULTIMATE=240 CFS. AT TANNER CREEK

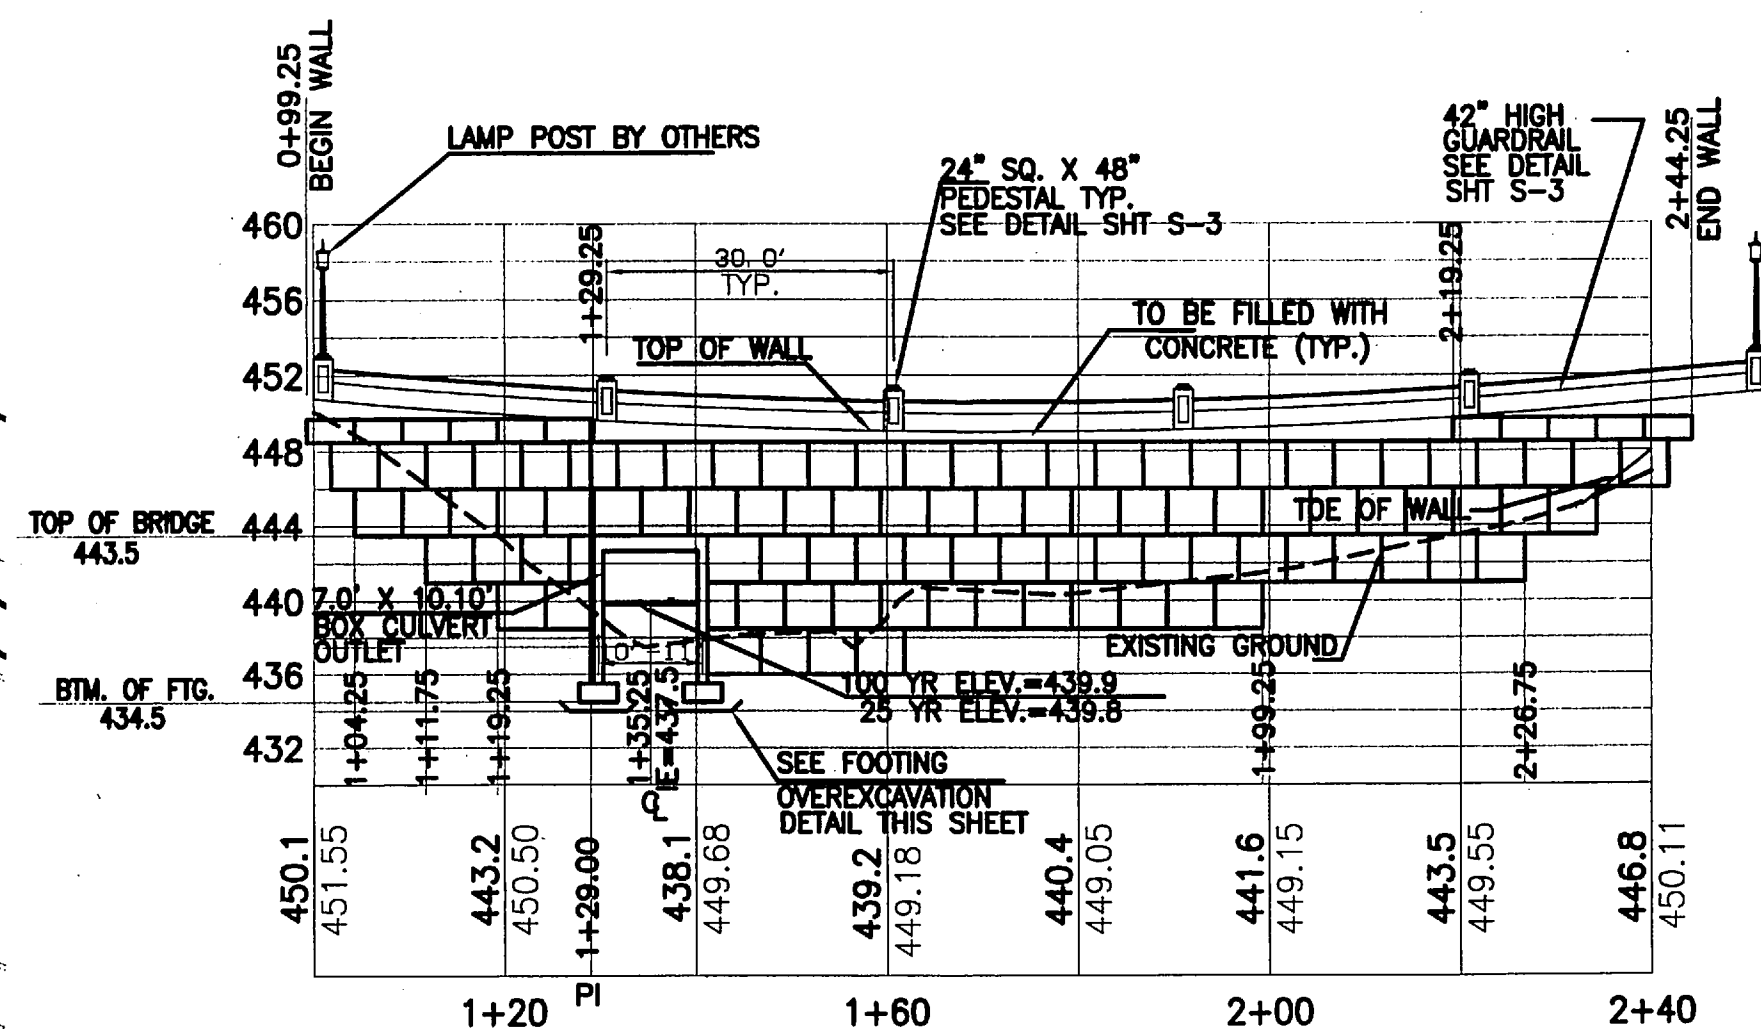

5 STONEGATE LANE RIGHT ELEVATION
SCALE: 1" = 20'-0" H, 1" = 10'-0" V

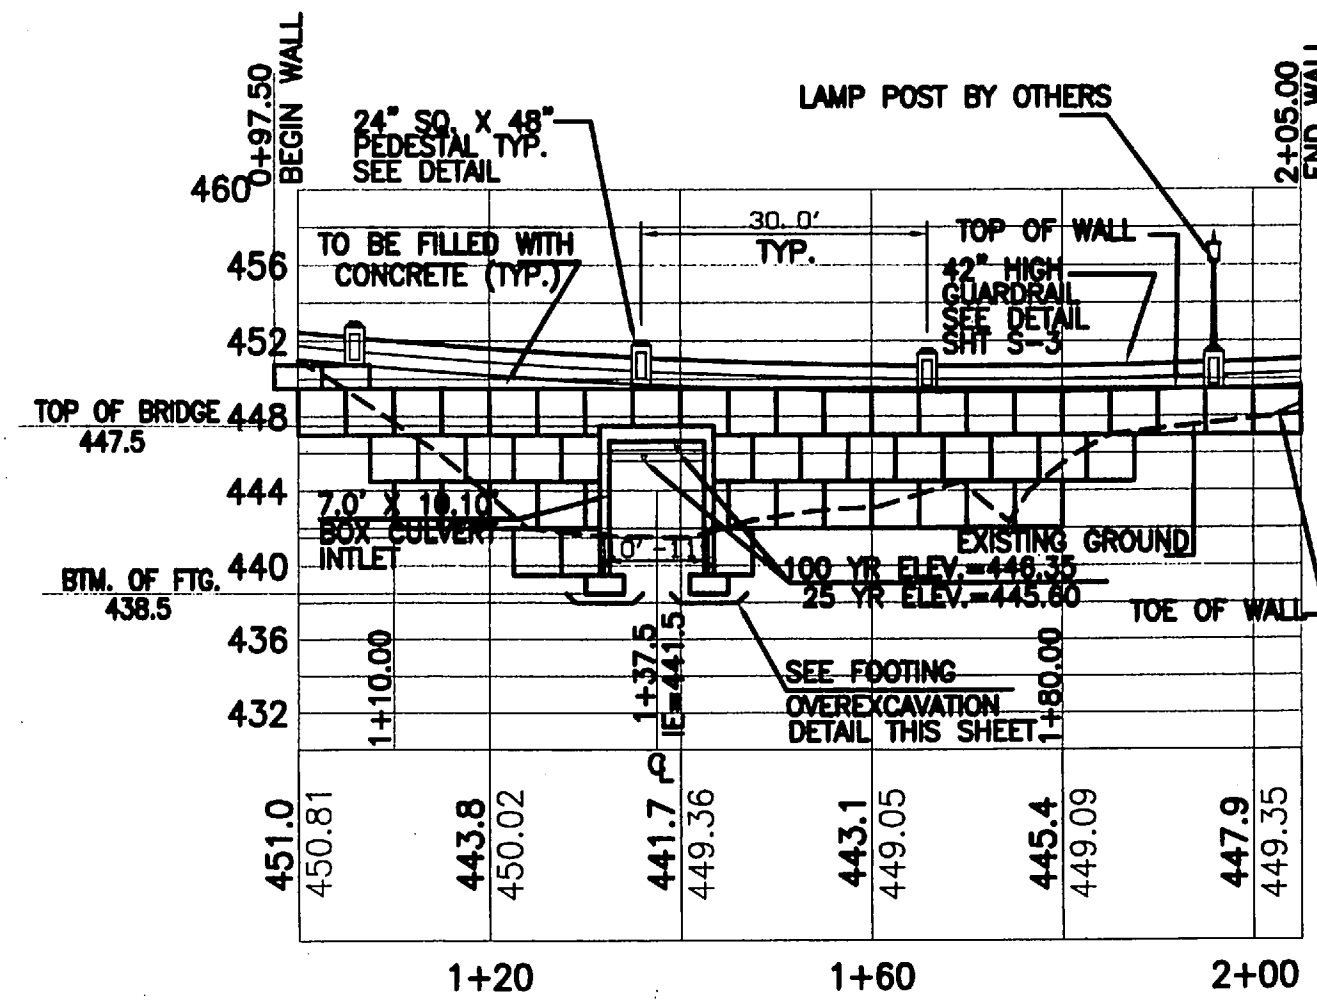

6 STONEGATE LANE LEFT ELEVATION
SCALE: 1" = 20'-0" H, 1" = 10'-0" V

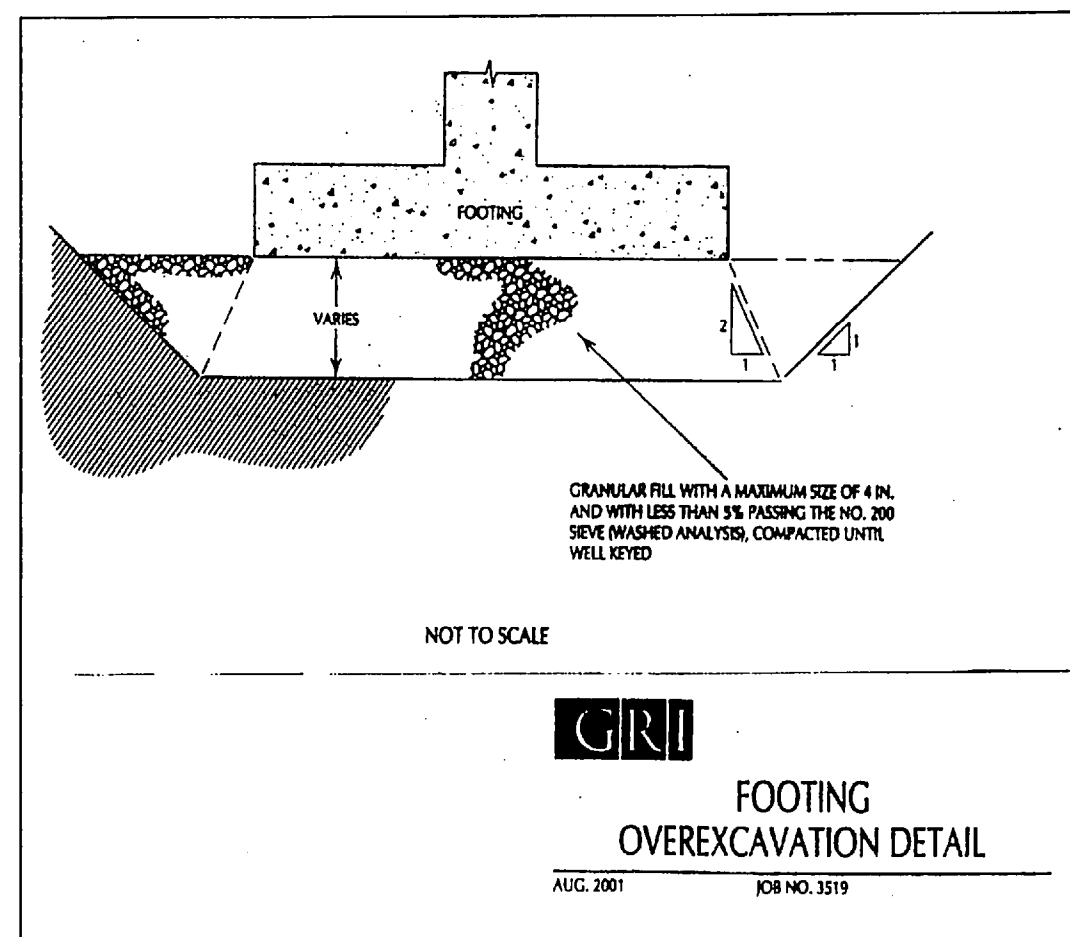


REVISIONS
BY
DATE
NO

DAVID HALL
DAVID HALL STRUCTURAL ENGINEERING
1000 N. W. 10TH AVE.
SUITE 200
FORT LAUDERDALE, FL 33304
PHONE: (305) 556-7000
FAX: (305) 656-0666


NORWAY DEVELOPMENT
P.O. Box 387
Oregon City, Oregon 97045
PHONE: (503) 656-7000
FAX: (503) 656-0666

Tanner's Stonegate
CITY OF WEST LINN, OREGON
STRUCTURAL DETAILS AND SPECIFICATIONS


AS BUILTS

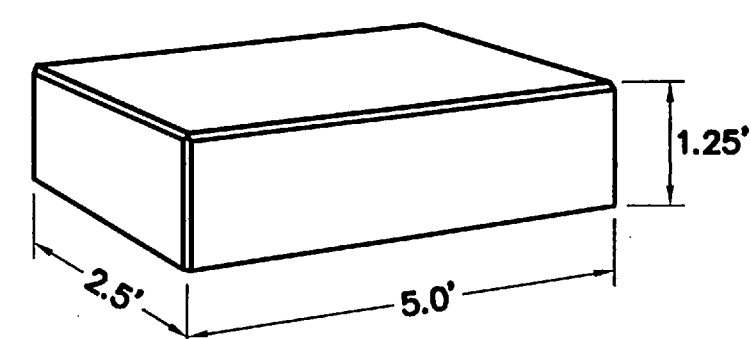


CAP BLOCK DETAIL
NOT TO SCALE

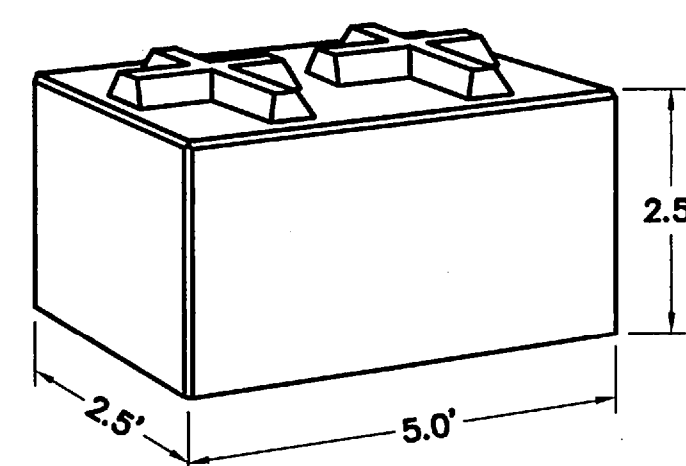


STANDARD BLOCK DETAIL
NOT TO SCALE

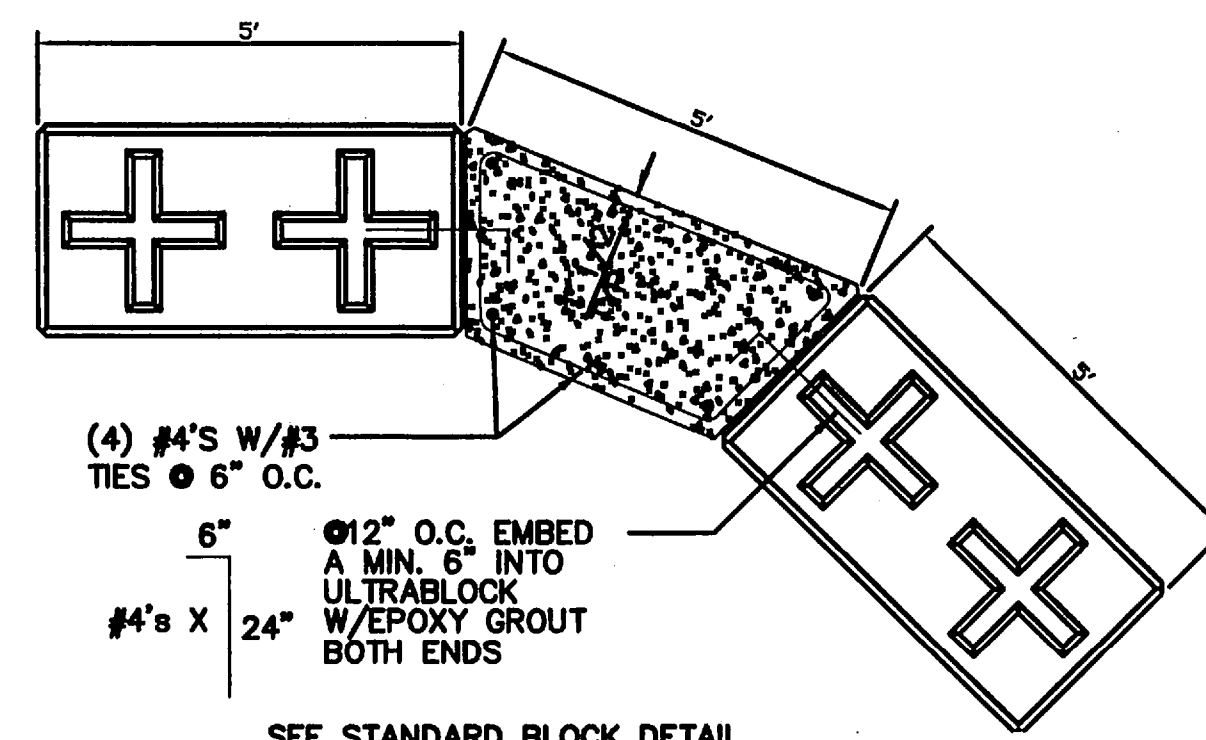

CAST-IN-PLACE WALL JOINT DETAIL
NOT TO SCALE

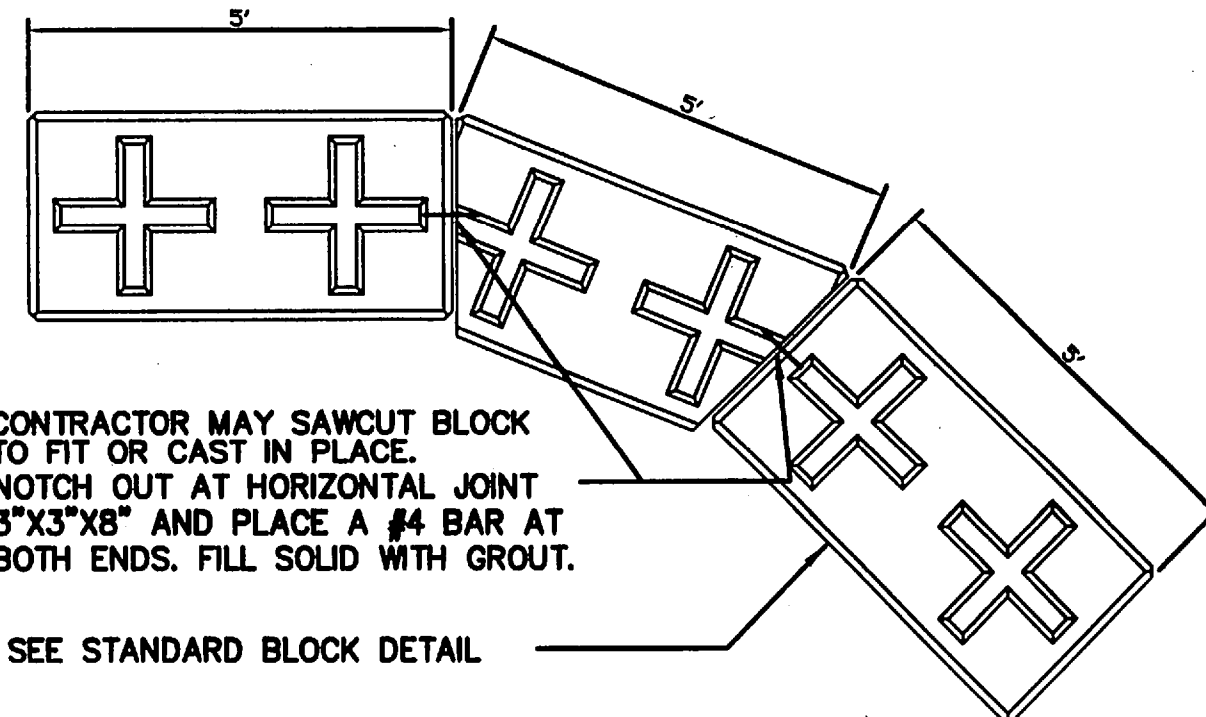


WALL JOINT DETAIL
NOT TO SCALE

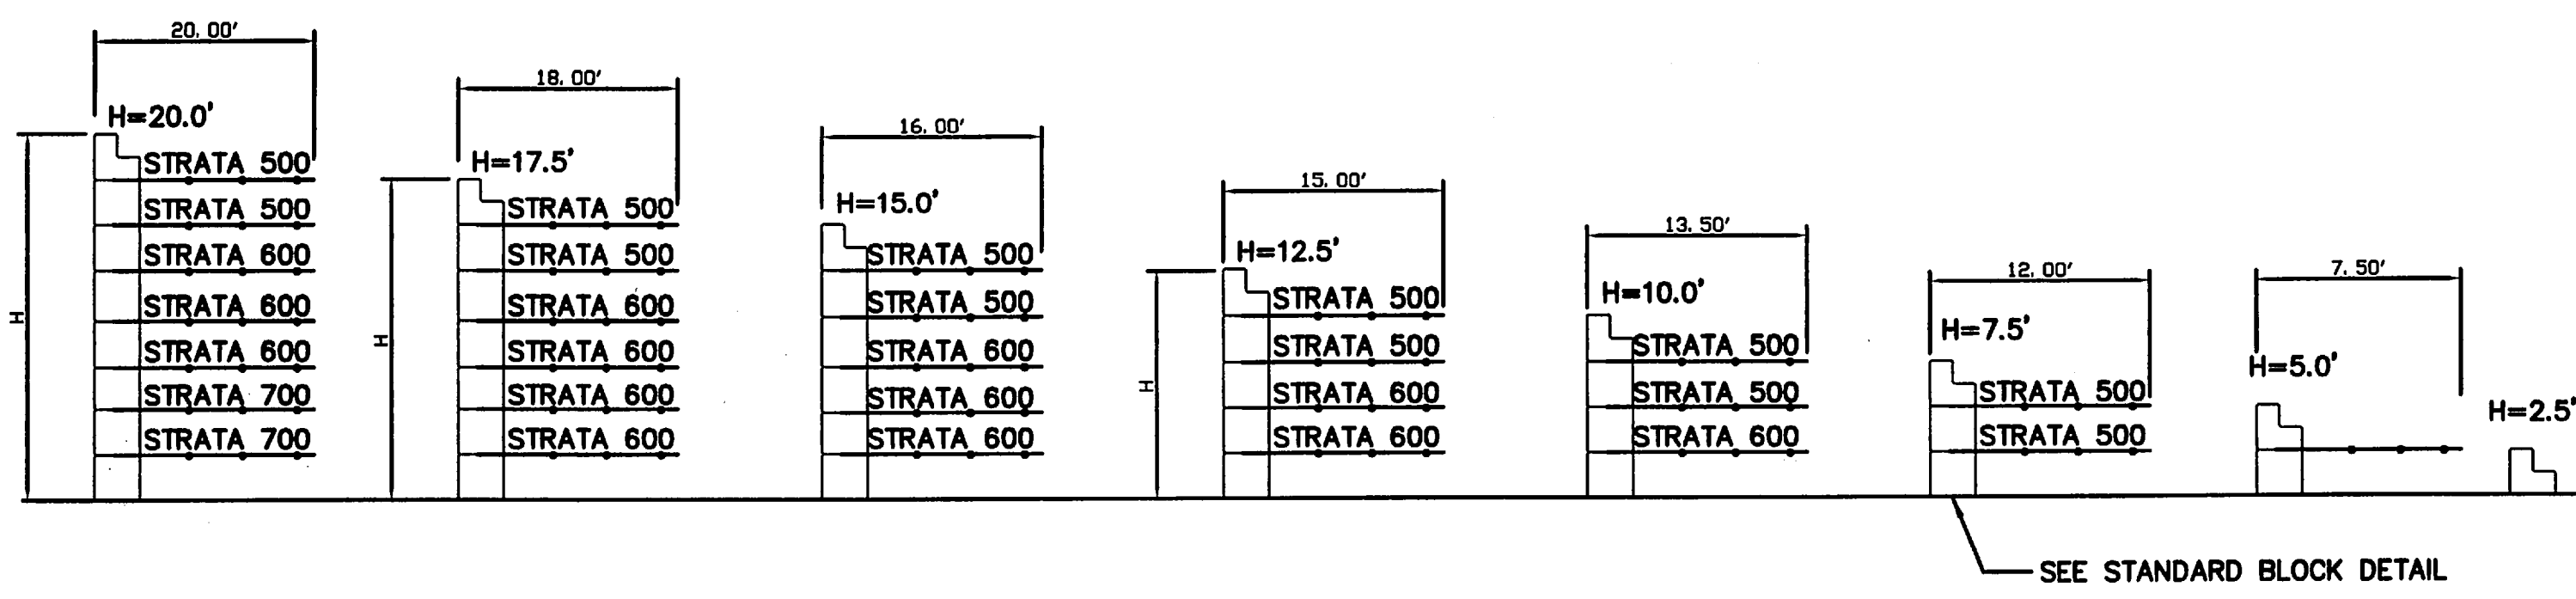


ULTRABLOCK WALL ASSEMBLY DETAIL
NOT TO SCALE

NOTE: THE TOP LAYER OF GEOGRID MAY BE SHORTENED TO ACCOMMODATE UTILITY. THIS SHOULD BE COORDINATED WITH THE STRUCTURAL ENGINEER DURING CONSTRUCTION AND APPROVED BY THE WALL MANUFACTURER.

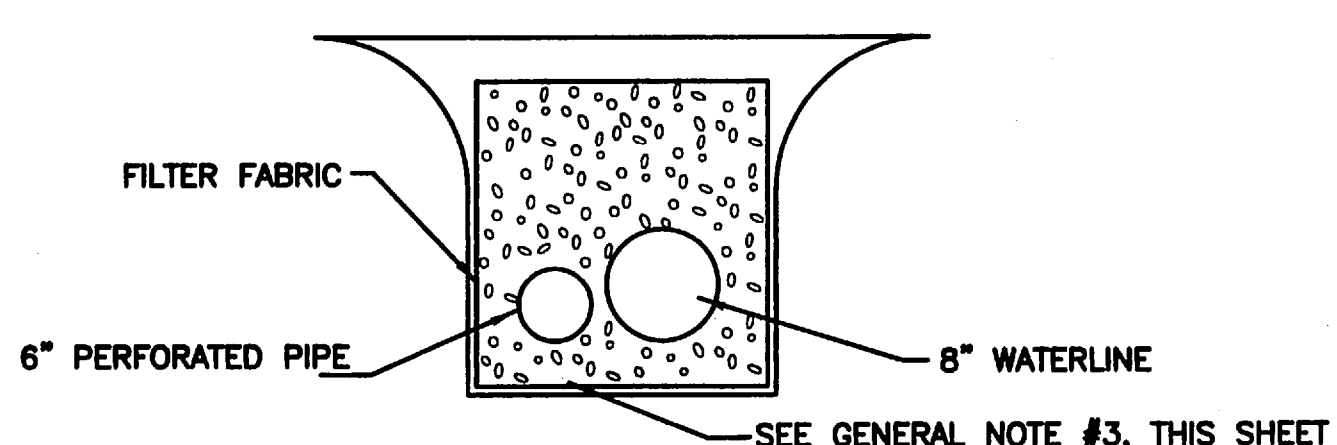

WATERLINE TRENCH AT BRIDGE
NOT TO SCALE

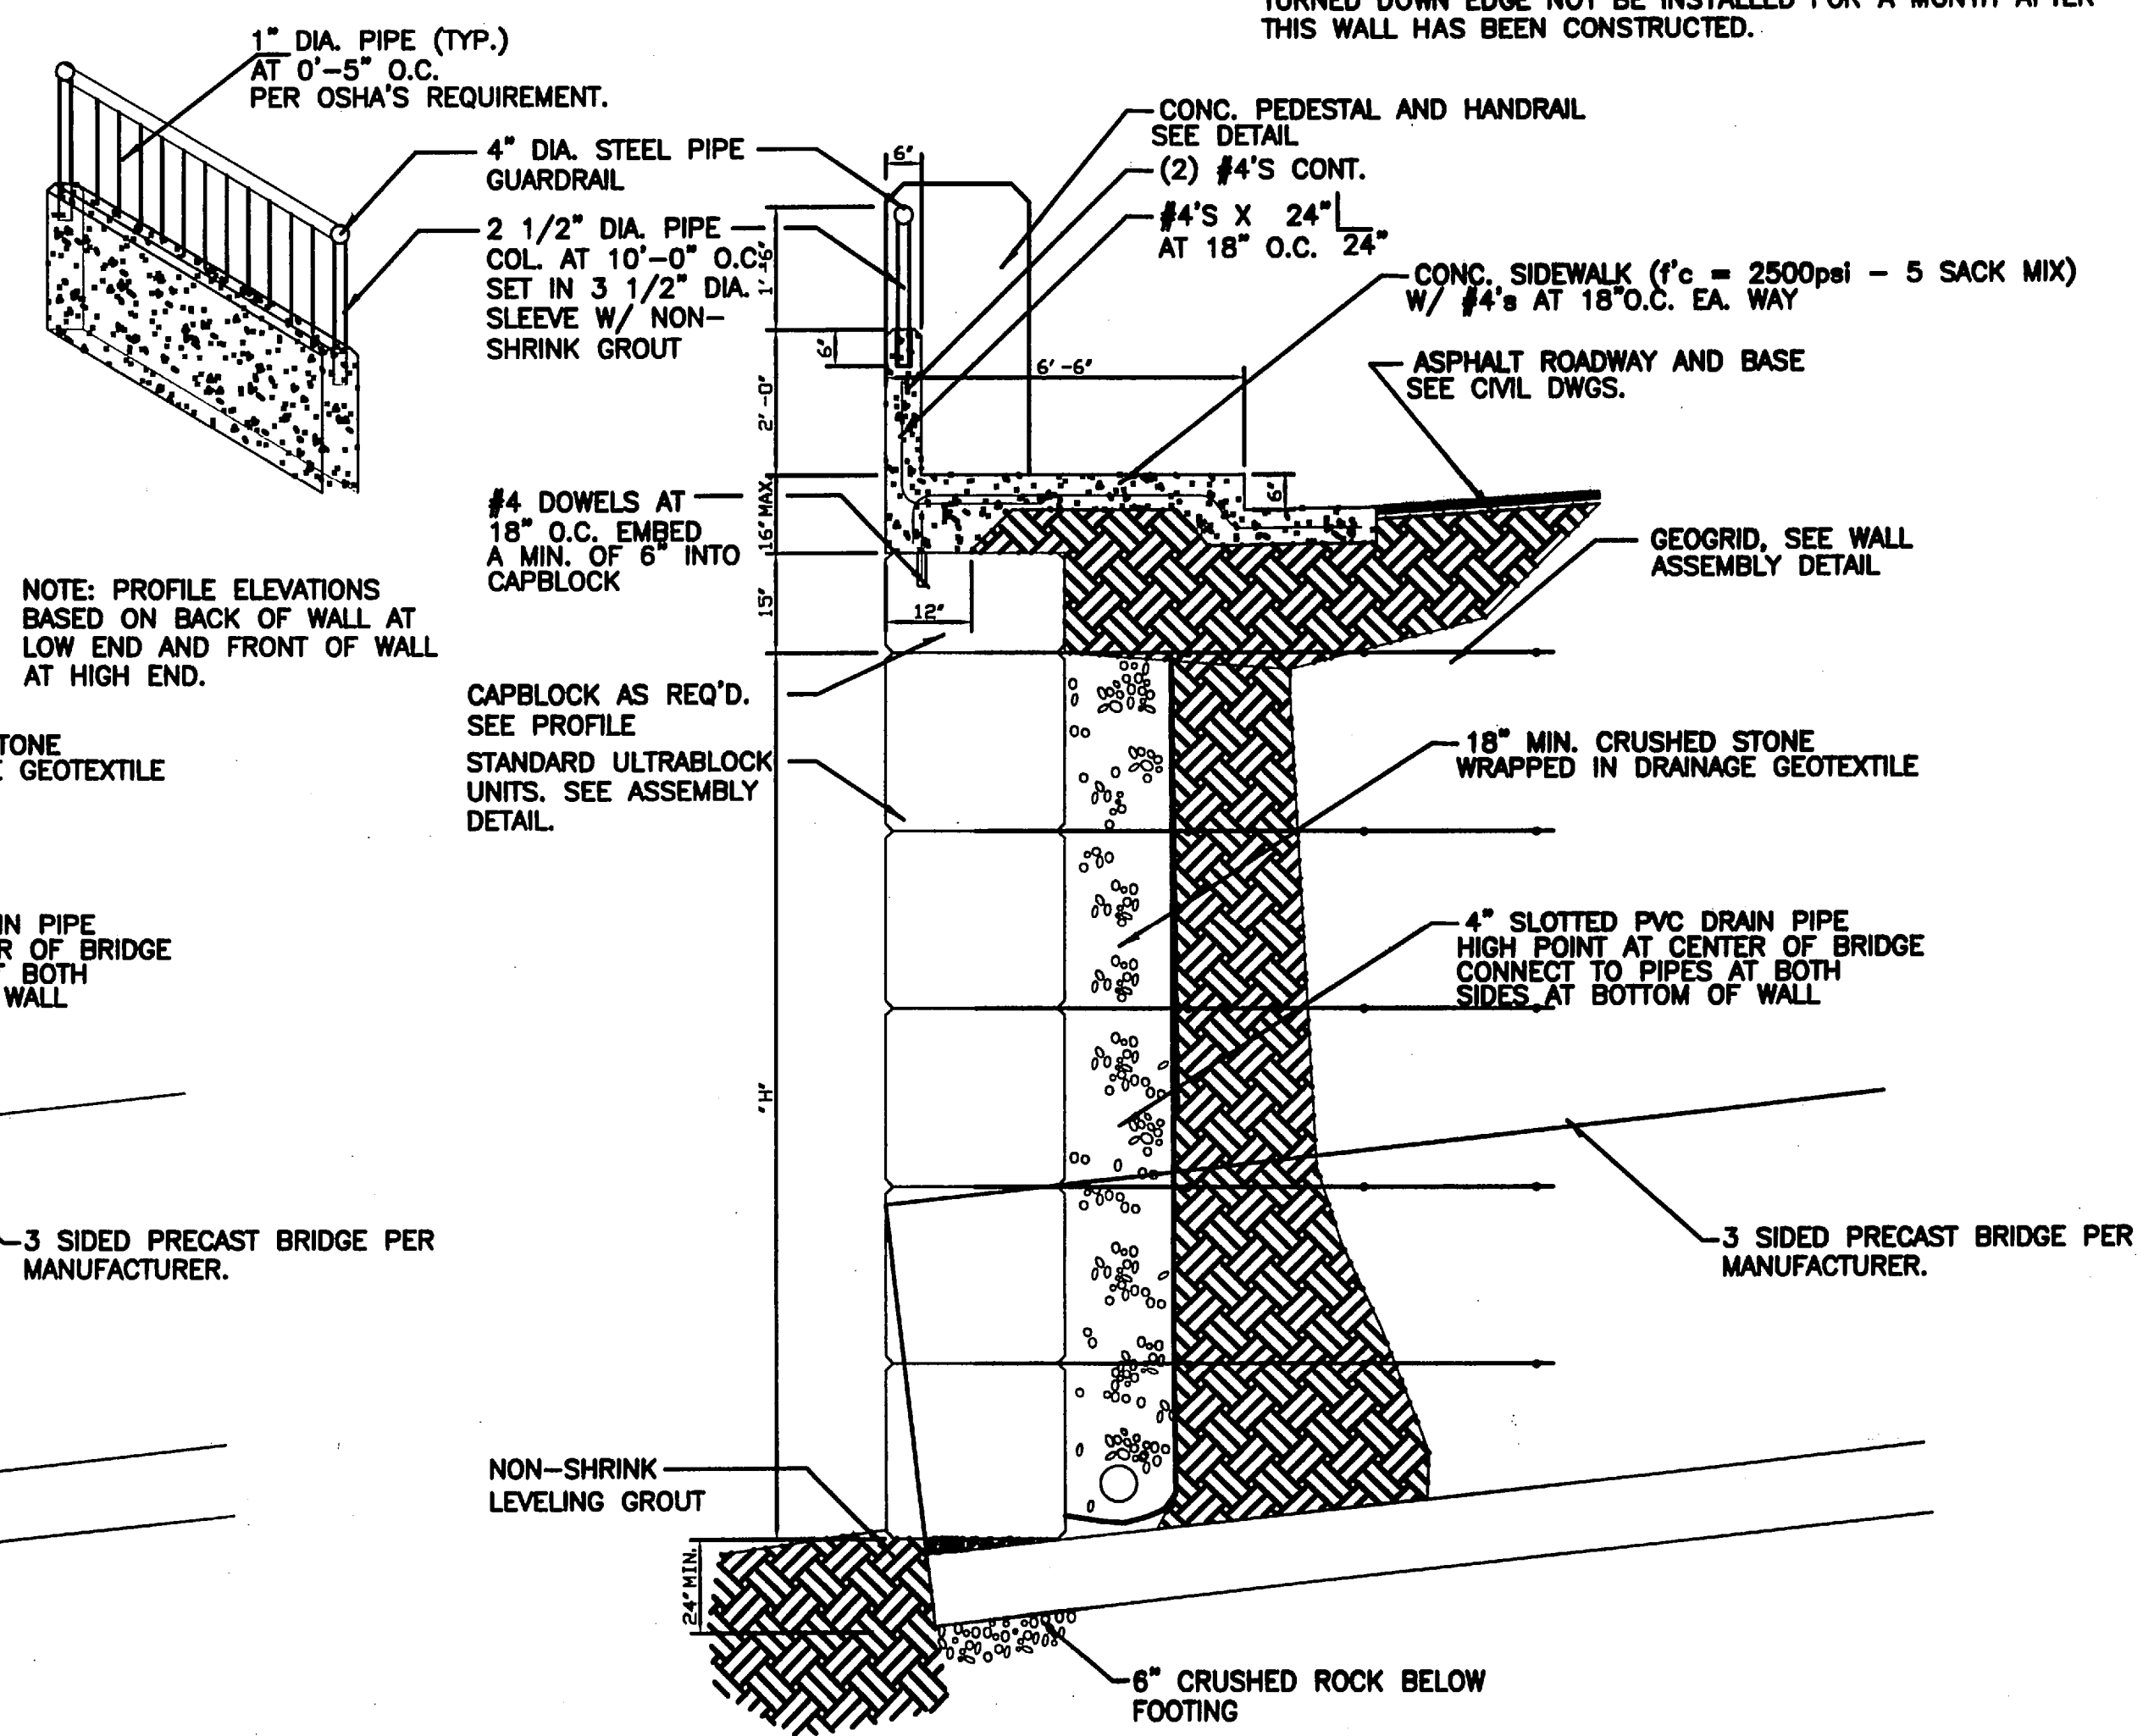

TYPICAL ULTRABLOCK WALL SECTION
NOT TO SCALE

TYPICAL ULTRABLOCK WALL SECTION
NOT TO SCALE

- GENERAL NOTES:
1. PLACE 6" OF CRUSHED ROCK LAYER UNDER ULTRABLOCK WALLS FOR ALL HEIGHTS.
 2. A REPRESENTATIVE OF GEOTECHNICAL RESOURCES, INC. (GRI) SHALL REVIEW THE SITE TO VERIFY IT IS GLOBALLY STABLE AFTER IT HAS BEEN CLEARED.
 3. DO NOT PLACE UTILITIES WITHIN THE AREA THAT IS REINFORCED WITH GEOGRID. IT IS RECOMMENDED THAT A DRAIN PIPE BE PLACED ADJACENT TO THE UTILITIES AND DAYLIGHTED BETWEEN THE GEOGRID WALLS IN A BED OF GRAVEL WRAPPED W/ FILTER FABRIC.
 4. NO MODIFICATIONS OR SUBSTITUTIONS ARE TO BE MADE WITHOUT THE APPROVAL IN WRITING BY DAH/SE.
 5. DESIGN COMPLIANCE WAS MADE PER THE RECOMMENDATION IN REPORT #3419 PREPARED BY GRI DATED MARCH 30, 2001. THE CONTRACTOR IS RESPONSIBLE FOR REVIEWING AND ADHERING TO ALL OF THE RECOMMENDATIONS MADE WITHIN.
 6. GRI SHALL REVIEW THESE PLANS TO MAKE SURE THAT THEY ADHERE TO ALL OF THEIR RECOMMENDATIONS MADE IN THE ABOVE REFERENCE REPORT.
 7. A SPECIAL INSPECTION IS REQUIRED TO REVIEW THE CONSTRUCTION OF THESE WALLS.
 8. THE BUILDER SHOULD BE AWARE THAT SETTLEMENT AND MOVEMENT MAY OCCUR IMMEDIATELY AFTER THIS WALL IS CONSTRUCTED. IT IS RECOMMENDED THAT THE SIDEWALL, TURNED DOWN EDGE NOT BE INSTALLED FOR A MONTH AFTER THIS WALL HAS BEEN CONSTRUCTED.



Confirm location and elevation of walls. Width of excavation should allow for width of wall base and drainpipe. Note: all excavation should follow OSHA guidelines. If the wall steps up one block in height, the base blocks should be installed at the lowest level in order to establish grade and face location of the second level.


Consult engineer's wall design for base material specification including type, width, depth and compaction. It is recommended to start at lowest wall level. Locate the front face of the wall and run a string line one (1) inch in front of the face-- two (2) inches above the base.

DIAGRAM 1

Labels and dimensions in the diagram:

- STRINGLINE
- FRONT BOARD
- BASE ELEVATION
- FILL
- SUBGRADE
- BASE WIDTH
- WALL BATTER
- BACK BOARD
- BASE DEPTH
- COMPACTED BASE MATERIAL

Page 1 of 5

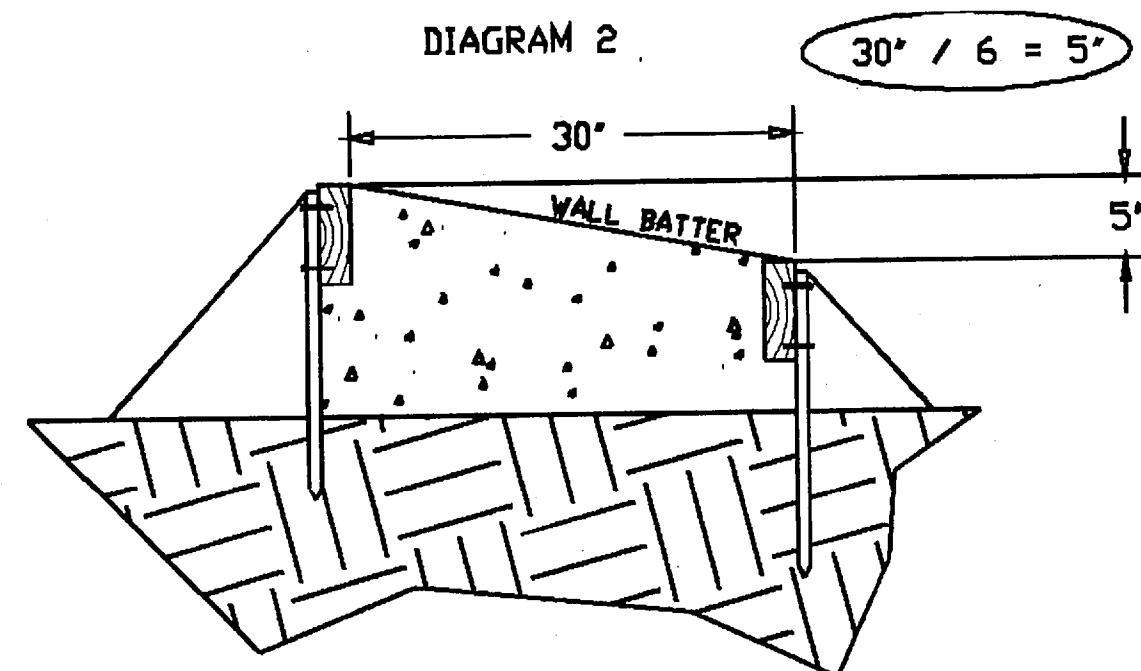


Without moving the string line, start leap-frogging the base boards further on down the wall line and continue preparing the base. Do not disturb stringline. It is best to prepare the entire base before setting the blocks.


Curved walls require many more location points to define the curve (the tighter the curve, the more location points). Use bender boards for the base boards. Set the front boards to the elevation and curve of the walls. Set the back boards to the back width and batter the wall. Fill, compact and screed base material as required.

Before placing blocks, make sure the top and bottom surfaces of the respective blocks are clean. At one end of the wall, or at one end of the lowest base elevation, start the wall. At the start of the wall, mark a line perpendicular to the face of the wall. This line will help place the first block square to the wall face. Place the first block one inch from the string line. Set the next block beside the first block, taking care to align the face. If the base width of the wall requires 2 or more blocks, place the blocks at the back of the wall first (it may help to run a temporary string line). Always place the best face of the blocks on the outside of the wall. (See DIAGRAM 3).

Page 2 of 5

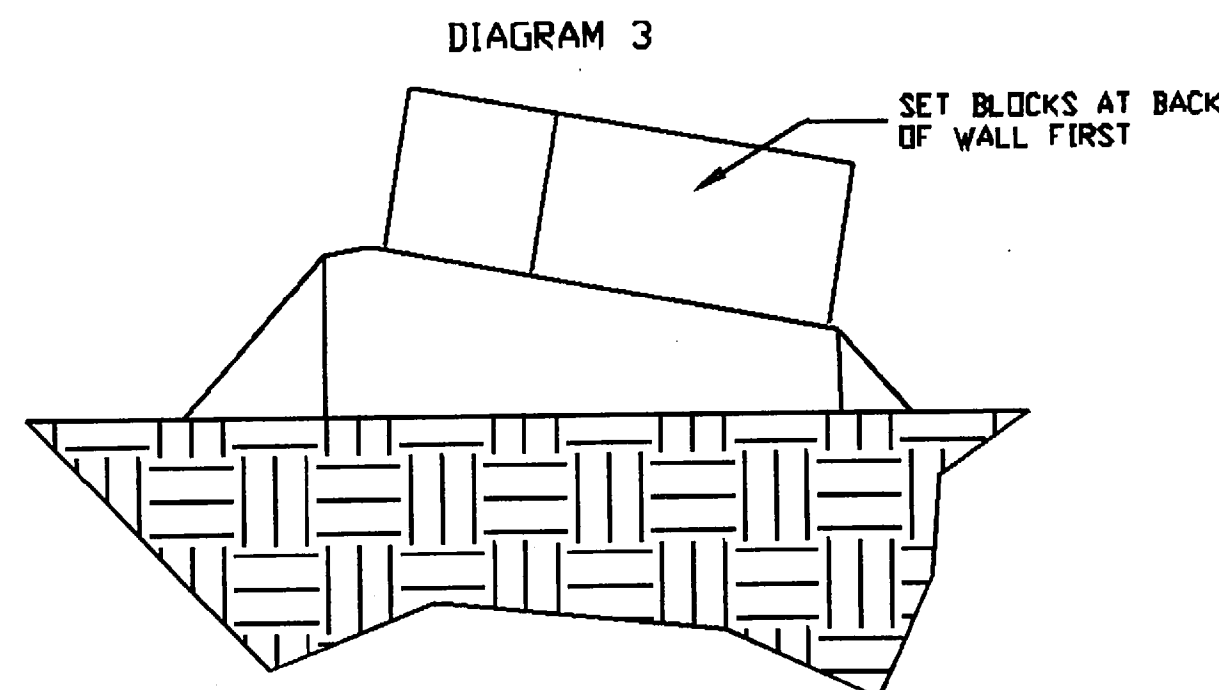

If binding does occur between the first and second row of blocks, leave a 1/4" gap when placing the next base block. Another suggestion to reduce the binding is as follows: When building the base going left to right, after placing each second row block, push the second row block right to left until it no longer slides along base block. Make sure the upper row blocks do not slide up on the keys of lower row blocks (See DIAGRAM 4).

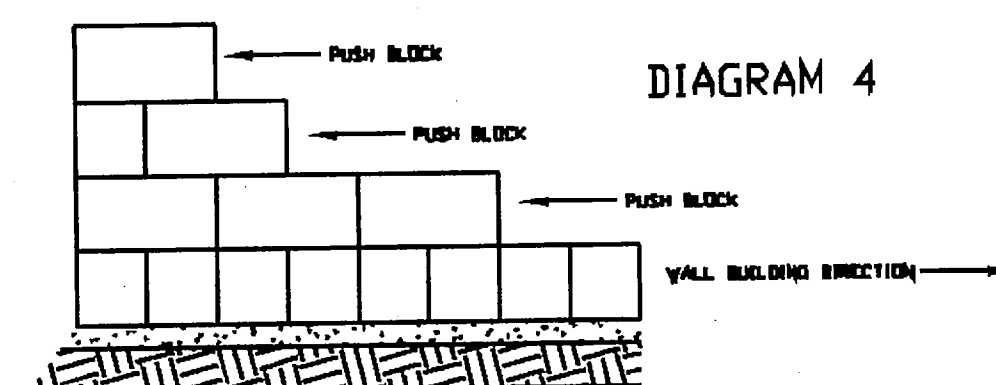

Page 3 of 5


A track mounted excavator is the ideal piece of equipment for setting blocks. A wire rigging with swivel hooks, OSHA approved and rated for the weight of the blocks, can be attached to the excavator and used for lifting and moving the blocks.

1. Never stand underneath a block.
2. Never accept or install blocks with a cold joint (LEAVE ON DELIVERY TRUCK)
3. Avoid getting any part of the body between pinch points while installing blocks (either between two blocks or between a block and the open excavation).
4. Always inspect rigging for lifting the block. Replace all worn out or broken parts. DO NOT USE INFERIOR, INADEQUATE OR UNAPPROVED EQUIPMENT.

1. Transit- to lay out a level base.
2. Shovels and rakes- for use by the base prep person.
3. A lifting jig- to hold the blocks at the correct batter.
4. A broom- to clean the keyways before placing the next layer.
5. One or more 5 foot pry bars-e for jostling the blocks into position.

1. Vertical walls can be locked at 90 degree corners.
2. Battered walls at 90 degree corners are constructed as follows:
 Stack a vertical column to fill the corner. Adjust toe of battered wall to meet with corners of vertical stack (ie: kick toe out for outside corner, meet toe at edge for inside corner). For walls higher than 7.5', you may use a stack of full-size, interlocked blocks to make a 5x5' vertical stack, rather than 2 2.5x2.5' stack with single half blocks. (See below).

Use geogrid between the vertical blocks, extending back into the fill. Make the corner stack the same width as the wall base (2.5' / 5' / 7.5' etc)

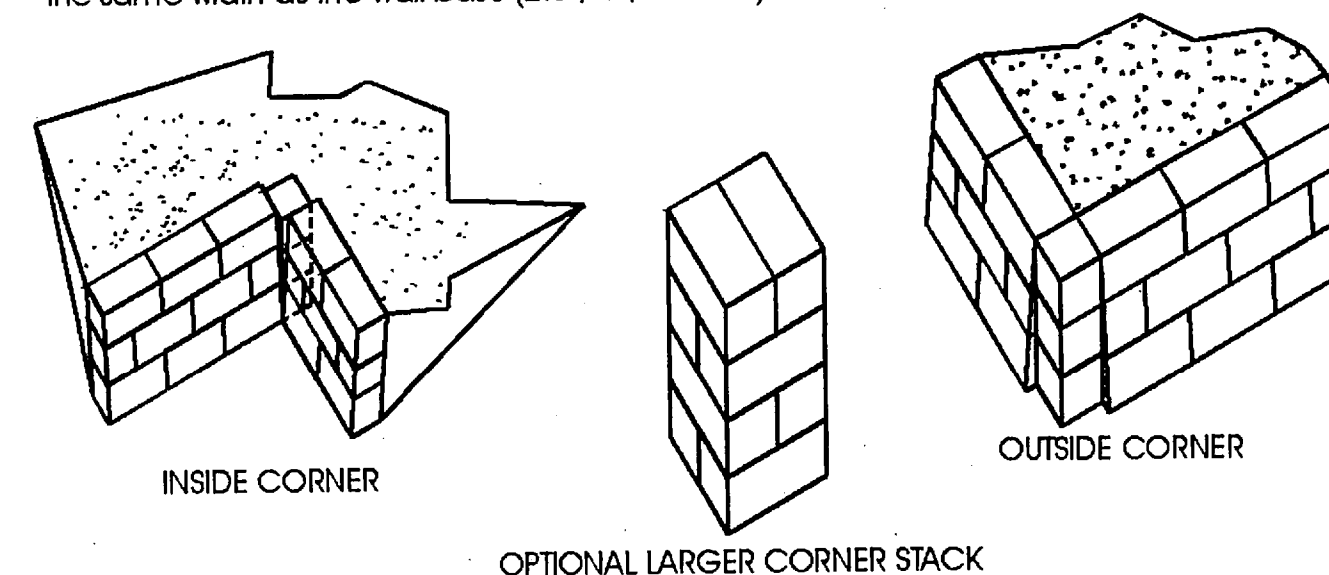


Page 4 of 5

If the radius of the wall is less than the allowable radius then contact the manufacturer and see if arrangements can be made for special block.

WALL WIDTH	MINIMUM RADIUS OF CURVE
2.5'	100'
5'	200'
7.5'	300'
10'	400'

Imperfect or disturbed bases can cause a wall to not run straight or level. It is recommended to shim (asphalt shingle) wall if necessary or place a 4x6 on top of the wall at the high points and pound down with the excavator bucket.

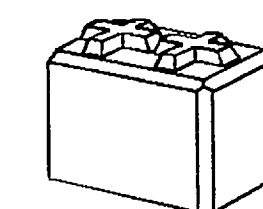

ULTRABLOCK, INC
7000 NE 40th Ave, D-3, Vancouver, WA
360-694-0141 Fax 360-694-028
1-800-377-3877

Page 5 of 5

NO.	DATE	BY	APPD.	REVISIONS
<div style="display: flex; justify-content: space-between;"> <div> <p>DAI/SE</p> <p>DAVID L. FULLERTON ENGINEERING</p> <p>704.871.8728</p> <p>10000 W. BAYVIEW BLVD. #1000</p> <p>MIAMI BEACH, FL 33154</p> <p>305.231.1717</p> </div> <div> <p>2/23/01</p> <p>Date</p> <p>DAVID HALL</p> <p>Designed</p> <p>DAVID HALL</p> <p>Drawn</p> <p>Checked By Date</p> </div> </div>				

NORWAY DEVELOPMENT
P.O. Box 387
Oregon City, Oregon 97045
PHONE: (503) 656-7000
FAX: (503) 656-0686

Tanner's Stonegate
CITY OF WEST LINN, OREGON

AS BUILT

10579


Project No.

File No.


S-4

Sheet No.


Copyright 2001 C

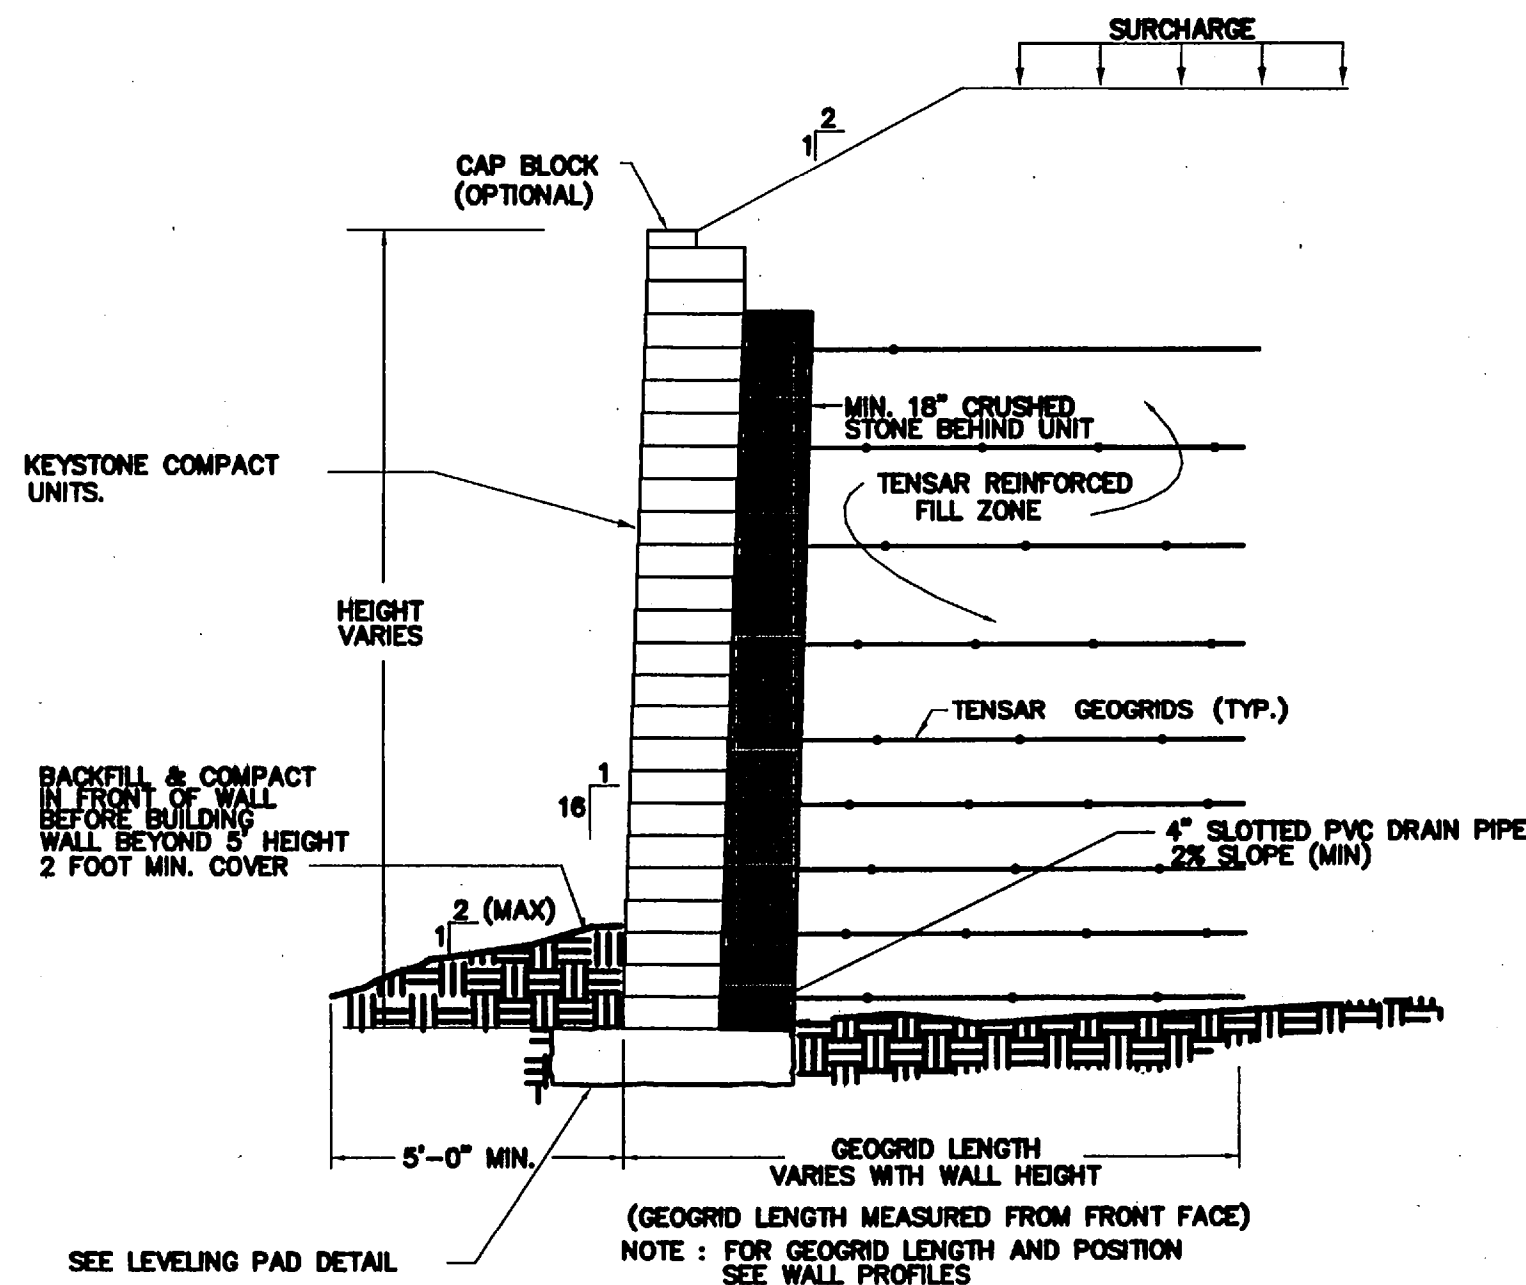

1 TYPICAL CROSS SECTION
WL5 NOT TO SCALE

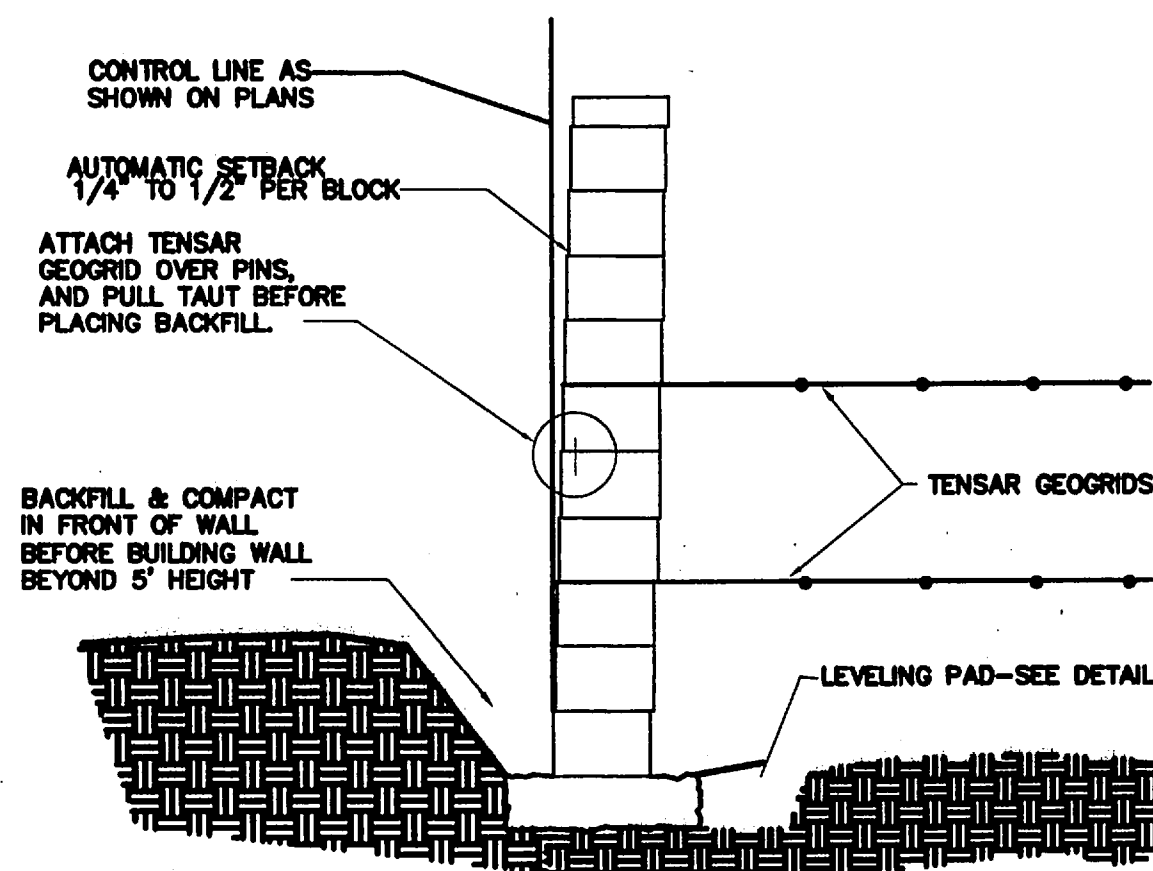

2 GEOGRID ATTACHMENT DETAIL
WL5 NOT TO SCALE

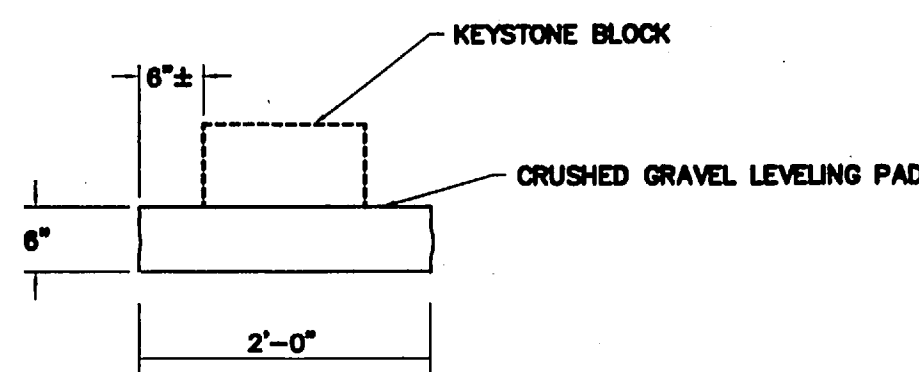

4 LEVELING PAD DETAIL
WL5 NOT TO SCALE

GEOGRID TABLE
2:1 BACKSLOPE - 2:1 FRONT SLOPE - MIN. EMBEDMENT AT TOE OF 2'-6". WALL HEIGHTS ARE FROM TOP OF GRADE TO BOTTOM OF GRADE AND DO NOT INCLUDE EMBEDMENT. HEIGHT OF WALLS INCLUDING EMBEDMENT IN PARENTHESES.


MAX. HEIGHT OF WALL "H"	GEOGRID TYPE	LENGTH OF GEOGRIDS "L"	POSITION OF GEOGRIDS FROM BOTTOM OF THE WALL								
			1	2	3	4	5	6	7	8	9
15'-0" (17'-4")	S8500 S8200	16'-0" 16'-0"	0'-8"	2'-8"	4'-8"	6'-8"	8'-8"	10'-8"	12'-8"	14'-8"	16'-8"
13'-0" (15'-4")	S8500 S8200	14'-0" 14'-0"	0'-8"	2'-8"	4'-8"	6'-8"	8'-8"	10'-8"	12'-8"	14'-8"	-
11'-0" (13'-4")	S8500 S8200	12'-0" 14'-0"	0'-8"	2'-8"	4'-8"	6'-8"	8'-8"	10'-8"	12'-8"	-	-
9'-0" (11'-4")	S8200	12'-0"	0'-8"	2'-8"	4'-8"	6'-8"	8'-8"	10'-8"	-	-	-
7'-0" (9'-4")	S8200	10'-0"	0'-8"	2'-8"	4'-8"	6'-8"	8'-8"	-	-	-	-
5'-0" (7'-4")	S8200	8'-0"	0'-8"	2'-8"	4'-8"	6'-8"	-	-	-	-	-

*USE COMPACT BLOCKS FOR THE UPPER 10'-0" OF WALL. USE STANDARD BLOCKS BELOW 10'-0" IN HEIGHT.

GEOGRID TABLE
2:1 BACKSLOPE - HORIZONTAL SLOPE AT BASE. WALL HEIGHTS ARE FROM TOP OF GRADE TO BOTTOM OF GRADE AND DO NOT INCLUDE EMBEDMENT. HEIGHT OF WALLS INCLUDING EMBEDMENT IN PARENTHESES.

MAX. HEIGHT OF WALL "H"	GEOGRID TYPE	LENGTH OF GEOGRIDS "L"	POSITION OF GEOGRIDS FROM BOTTOM OF THE WALL							
			1	2	3	4	5	6	7	8
15'-0" (16'-0")	S8500 S8200	14'-0" 14'-0"	0'-8"	2'-8"	4'-8"	6'-8"	8'-8"	10'-8"	12'-8"	14'-8"
13'-0" (14'-0")	S8500 S8200	12'-0" 12'-0"	0'-8"	2'-8"	4'-8"	6'-8"	8'-8"	10'-8"	12'-8"	-
11'-0" (12'-0")	S8200	12'-0"	0'-8"	2'-8"	4'-8"	6'-8"	8'-8"	10'-8"	-	-
9'-0" (10'-0")	S8200	9'-0"	0'-8"	2'-8"	4'-8"	6'-8"	8'-8"	-	-	-
7'-0" (8'-0")	S8200	8'-0"	0'-8"	2'-8"	4'-8"	6'-8"	-	-	-	-
5'-0" (6'-0")	S8200	6'-0"	0'-8"	2'-8"	4'-8"	-	-	-	-	-

*USE COMPACT BLOCKS FOR THE UPPER 10'-0" OF WALL. USE STANDARD BLOCKS BELOW 10'-0" IN HEIGHT.

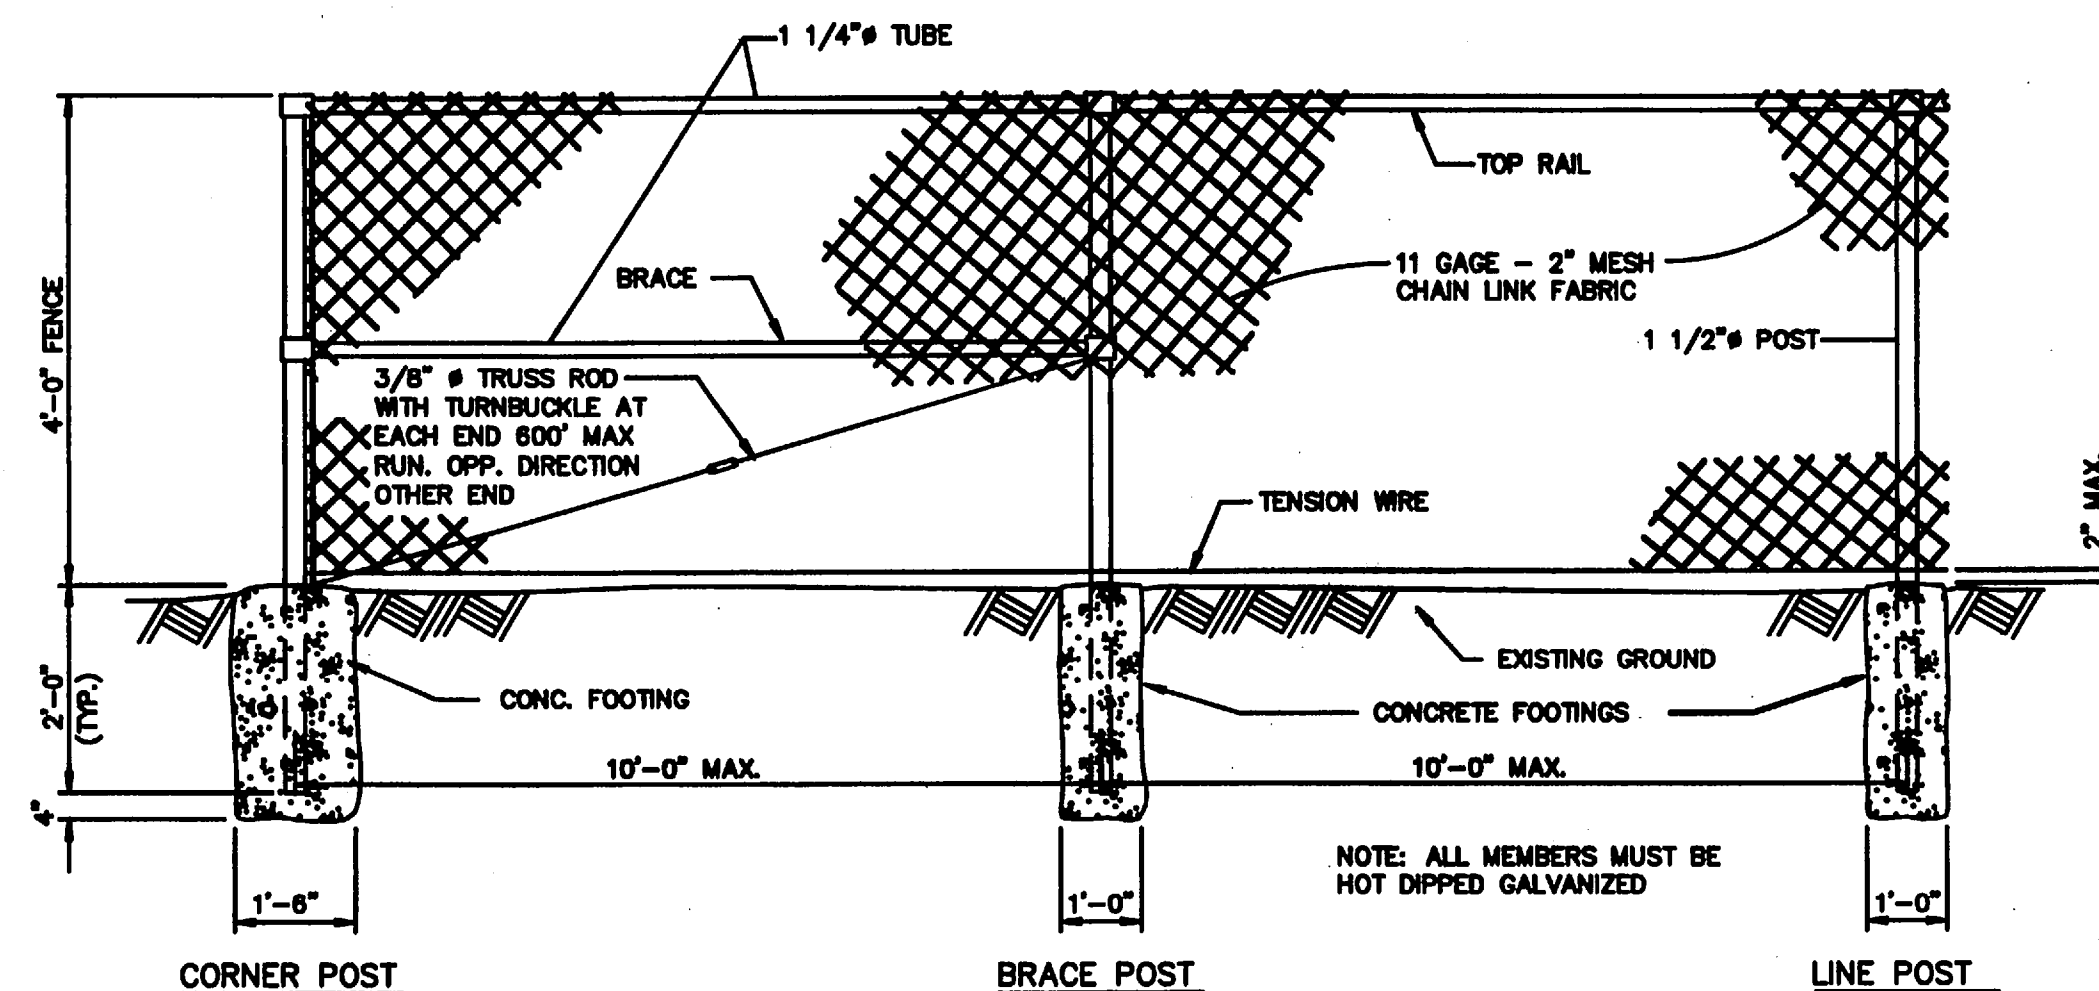

5 CHAIN LINK FENCE DETAIL
WL5 NOT TO SCALE

GEOGRID TABLE
HORIZONTAL BACKSLOPE - HORIZONTAL SLOPE AT BASE. WALL HEIGHTS ARE FROM TOP OF GRADE TO BOTTOM OF GRADE AND DO NOT INCLUDE EMBEDMENT. HEIGHT OF WALLS INCLUDING EMBEDMENT IN PARENTHESES.

MAX. HEIGHT OF WALL "H"	GEOGRID TYPE	LENGTH OF GEOGRIDS "L"	POSITION OF GEOGRIDS FROM BOTTOM OF THE WALL							
			1	2	3	4	5	6	7	8
15'-0" (16'-0")	S8500 S8200	14'-0" 14'-0"	0'-8"	2'-8"	4'-8"	6'-8"	8'-8"	10'-8"	12'-8"	14'-8"
13'-0" (14'-0")	S8200	12'-0"	0'-8"	2'-8"	4'-8"	6'-8"	8'-8"	10'-8"	12'-8"	-
11'-0" (12'-0")	S8200	10'-0"	0'-8"	2'-8"	4'-8"	6'-8"	8'-8"	10'-8"	-	-
9'-0" (10'-0")	S8200	8'-0"	0'-8"	2'-8"	4'-8"	6'-8"	8'-8"	-	-	-
7'-0" (8'-0")	S8200	6'-0"	0'-8"	2'-8"	4'-8"	6'-8"	-	-	-	-
5'-0" (6'-0")	S8200	6'-0"	0'-8"	2'-8"	4'-8"	-	-	-	-	-

*USE COMPACT BLOCKS FOR THE UPPER 12'-0" OF WALL. USE STANDARD BLOCKS BELOW 12'-0" IN HEIGHT.

KEYSTONE/TENSAR REINFORCED EARTH RETAINING WALLS

- GENERAL REQUIREMENTS:**
- THE DESIGN COMPLIANCE OF THIS WALL IS MADE WITH THE ASSUMPTION IT WILL NOT BE CONSTRUCTED ON EXPANSIVE OR FILL TYPE SOILS. A GEOTECHNICAL ENGINEER SHALL BE RETAINED TO VERIFY ALL DESIGN ASSUMPTIONS. ALL MODIFICATIONS SHALL BE MADE THROUGH DAVID A. HALL / STRUCTURAL ENGINEERING.
 - RETAINING WALL DESIGN ASSUMPTIONS USED:
 - ALLOWABLE BEARING PRESSURE 3000 PSF
 - DRY DENSITY OF SOIL 120 PCF
 - ANGLE OF FRICTION (PHI) 30 DEGREES
 - ALL CONSTRUCTION SHALL BE PERIODICALLY REVIEWED BY A REGISTERED PROFESSIONAL ENGINEER FAMILIAR WITH THE DESIGN AND CONSTRUCTION OF REINFORCED EARTH RETAINING WALLS.

REINFORCED EARTH RETAINING WALL CONSTRUCTION NOTES:

- ALL SOIL USED IN THE REINFORCED EARTH FILL SHALL BE FREE OF BRUSH, SOD, ROOTS, OR ANY OTHER DELETERIOUS MATERIAL. ALL FILL SOIL SHALL BE FREE OF SNOW OR ICE AND SHALL NOT BE FROZEN PRIOR TO PLACEMENT.
- ON-SITE SOIL MAY BE USED IN THE REINFORCED EARTH FILL IF APPROVED BY A REGISTERED GEOTECHNICAL ENGINEER. THE ON-SITE SOIL MUST MEET ALL DESIGN PARAMETERS MENTIONED ABOVE.
- ALL FILL SOIL MATERIALS PASSING THE NO. 200 SIEVE SHALL NOT HAVE A LIQUID LIMIT GREATER THAN 30 OR A PLASTICITY LIMIT GREATER THAN 20.
- SOIL DENSITY TESTS SHALL BE CONDUCTED BY OWNERS GEOTECHNICAL ENGINEER AT 2 FOOT VERTICAL INTERVALS UNLESS OTHERWISE SPECIFIED BY THE ENGINEER OF RECORD.
- ALL FILL SOIL SHALL BE PLACED IN HORIZONTAL LIFTS NOT EXCEEDING 10" IN UNCOMPACTED THICKNESS WHEN USING HEAVY COMPACTION EQUIPMENT. ALL FILL SOIL SHALL BE PLACED IN LIFTS NOT EXCEEDING 6" IN UNCOMPACTED WHEN USING HAND OPERATED COMPACTION EQUIPMENT.
- ALL FILL SHALL BE COMPACTED TO A MINIMUM 95% OF THE MAXIMUM DENSITY AS DETERMINED IN ACCORDANCE WITH ASTM D-698 (STANDARD PROCTOR DENSITY).
- WHEN USING LARGE ROCKS, STONE, OR APPROVED MATERIALS, CARE SHOULD BE TAKEN TO DISTRIBUTE THEM OVER THE ENTIRE AREA IN ORDER TO AVOID AIR POCKETS. ALL VOIDS SHALL BE FILLED WITH SMALL STONES OR OTHER APPROVED ACCEPTABLE MATERIALS. DO NOT PLACE ANY LARGE AGGREGATE DIRECTLY AGAINST THE KEYSTONE BLOCK WALLS.
- THE LEVELING PADS UNDER THE KEYSTONE BLOCK WALL SHALL BE PLACED ON FIRM UNDISTURBED NATIVE SOIL OR WELL COMPACTED FILL AS APPROVED BY OWNERS GEOTECHNICAL ENGINEER.
- ALL FACING UNITS SHALL BE KEYSTONE UNITS WITH A MINIMUM COMPRESSIVE STRENGTH OF 3000 PSI. NO SUBSTITUTIONS MAY BE MADE WITHOUT THE WRITTEN PERMISSION OF THE OWNER.
- ALL GEOGRID REINFORCING SHALL BE TENSAR UNIAXIAL GEOGRIDS AS SPECIFIED ON THE PLANS AS MANUFACTURED BY THE TENSAR CORPORATION, NORWICH, GEORGIA. NO SUBSTITUTIONS MAY BE USED WITHOUT THE APPROVED WRITTEN PERMISSION OF THE ENGINEER OF RECORD.
- THE LENGTHS OF EACH GEOGRID IS AS INDICATED ON THE PLANS. THE REINFORCED FILL ZONE IS MEASURED FROM THE FRONT FACE OF THE KEYSTONE BLOCK UNIT. FOR EASE OF CONSTRUCTION, THE CONTRACTOR MAY USE LONGER GEOGRID LENGTHS THAN THAT INDICATED ON THE PLANS.
- THE TENSAR GEOGRIDS SHALL BE ATTACHED FIRMLY BETWEEN THE BLOCKS OVER THE PINS AS ILLUSTRATED ON THE PLANS. THE GEOGRIDS SHALL BE PULLED TIGHT AWAY FROM THE FRONT FACE TO REDUCE ANY SLACK PRIOR TO PLACING ANY FILL.
- FILL MATERIALS SHALL BE PLACED FROM THE BACK FACE OF THE KEYSTONE BLOCKS BACK TOWARDS THE FILL TO ENSURE FURTHER TENSIONING OF THE GEOGRID MATERIALS.
- THE CONTRACTOR SHALL GRADE THE LANDSCAPE SUCH THAT THERE IS POSITIVE DRAINAGE AWAY FROM THE WALL. DRAINAGE SHY BE ROUTED TO AN APPROVED LOCATION FOR PERMANENT DISPOSAL.
- THE CONTRACTOR SHALL TAKE GREAT CARE TO PROTECT THE REINFORCED SOIL MASS FROM RAINSTORMS AND PONDING OF WATER DURING THE CONSTRUCTION PROCESS.

7/21/01
Date
DAVID HALL
Designed
DAVID HALL
Drawn
Checked By Date

REVISIONS
APPD.
BY
DATE
NO.

DAVID A. HALL
DAVID A. HALL STRUCTURAL ENGINEERING
P.O. BOX 387
NORWICH, GEORGIA 31406-0387
PHONE: (706) 656-7000
FAX: (706) 656-0666

NORWAY DEVELOPMENT
P.O. Box 387
Norwich City, Oregon 97045
PHONE: (503) 656-7000
FAX: (503) 656-0666

Tanner's Stonegate
CITY OF WEST LINN, OREGON
RETAINING WALL'S TABLES
AND SPECIFICATIONS

AS BUILTS


10579
Project No.
D579C2S5
File No.
S-5
Sheet No.
Copyright 2001 ©

BASE LEVELING PAD NOTES:

1. THE LEVELING PAD IS TO BE CONSTRUCTED OF CRUSHED STONE OR 2,000 PSI± UNREINFORCED CONCRETE.
2. THE BASE FOUNDATION IS TO BE APPROVED BY THE SITE GEOTECHNICAL ENGINEER PRIOR TO PLACEMENT OF THE LEVELING PAD.

MINI CAP UNIT	
WIDTH:	18"
*DEPTH:	10"
HEIGHT:	4"
*WEIGHT:	45 LBS

COMPAC UNIT	
WIDTH:	18"
*DEPTH:	12"
HEIGHT:	8"
*WEIGHT:	85 LBS

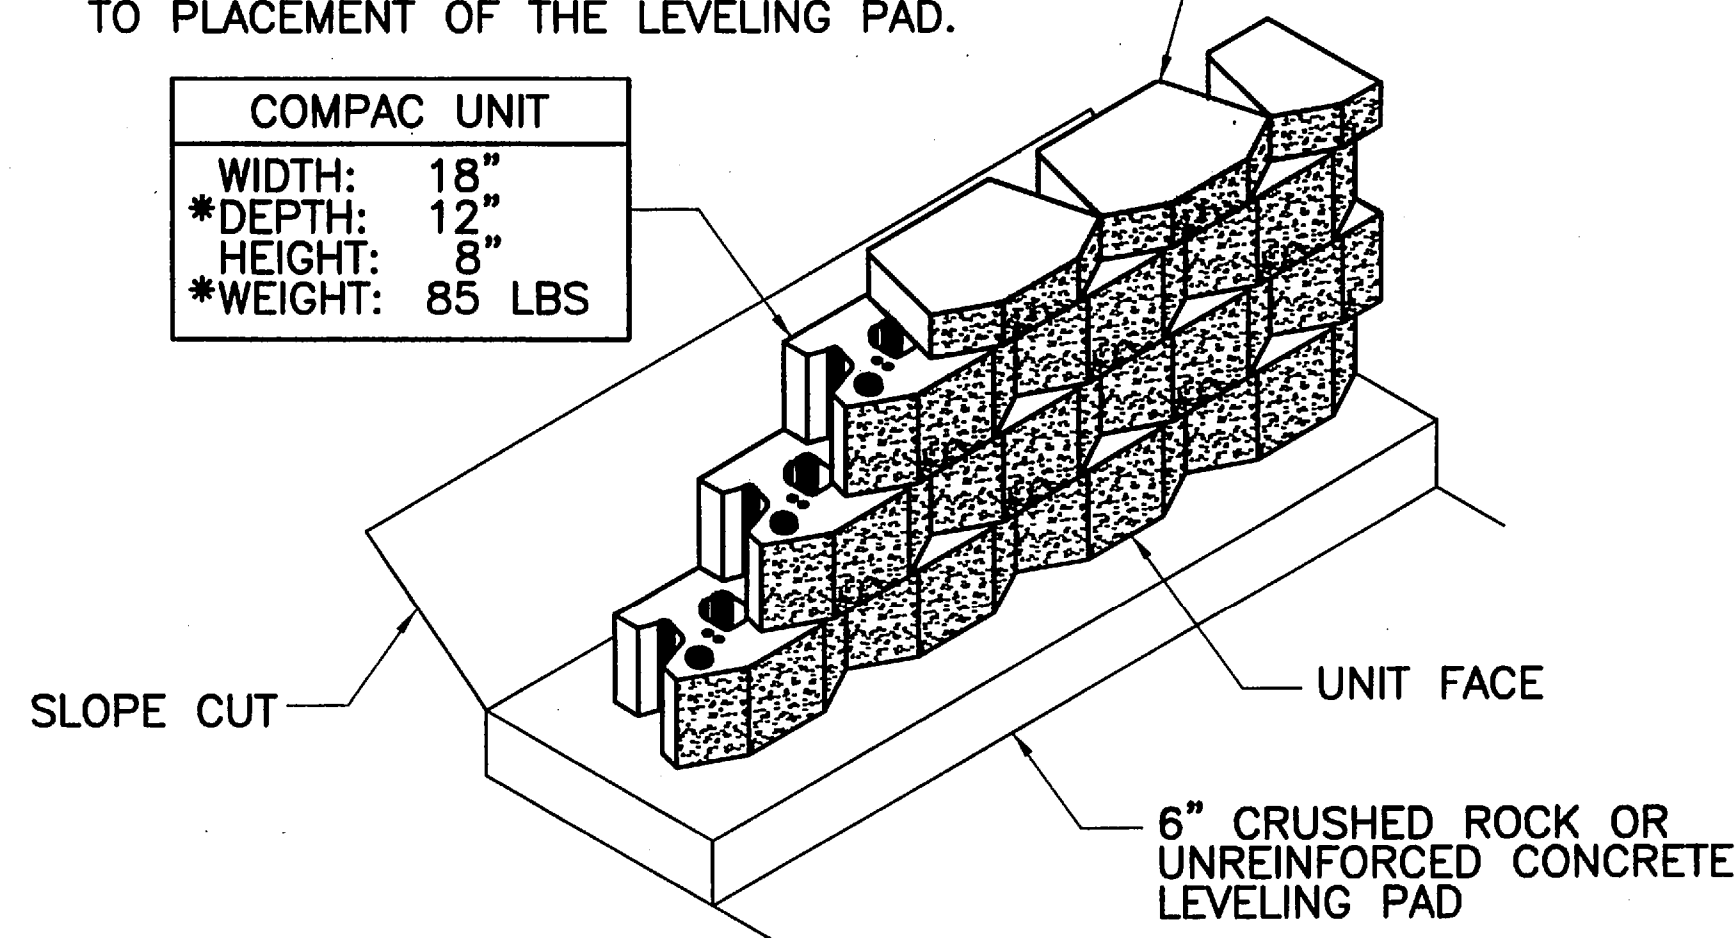


COMPAC UNIT/BASE PAD ISOMETRIC VIEW
SCALE: N.T.S.


*DIMENSIONS & WEIGHT MAY VARY BY REGION

NOTE:


1. CHECK WITH MANUFACTURER SPECIFICATIONS ON CORRECT DIRECTION OF ORIENTATION FOR GEOGRID TO OBTAIN PROPER STRENGTH.

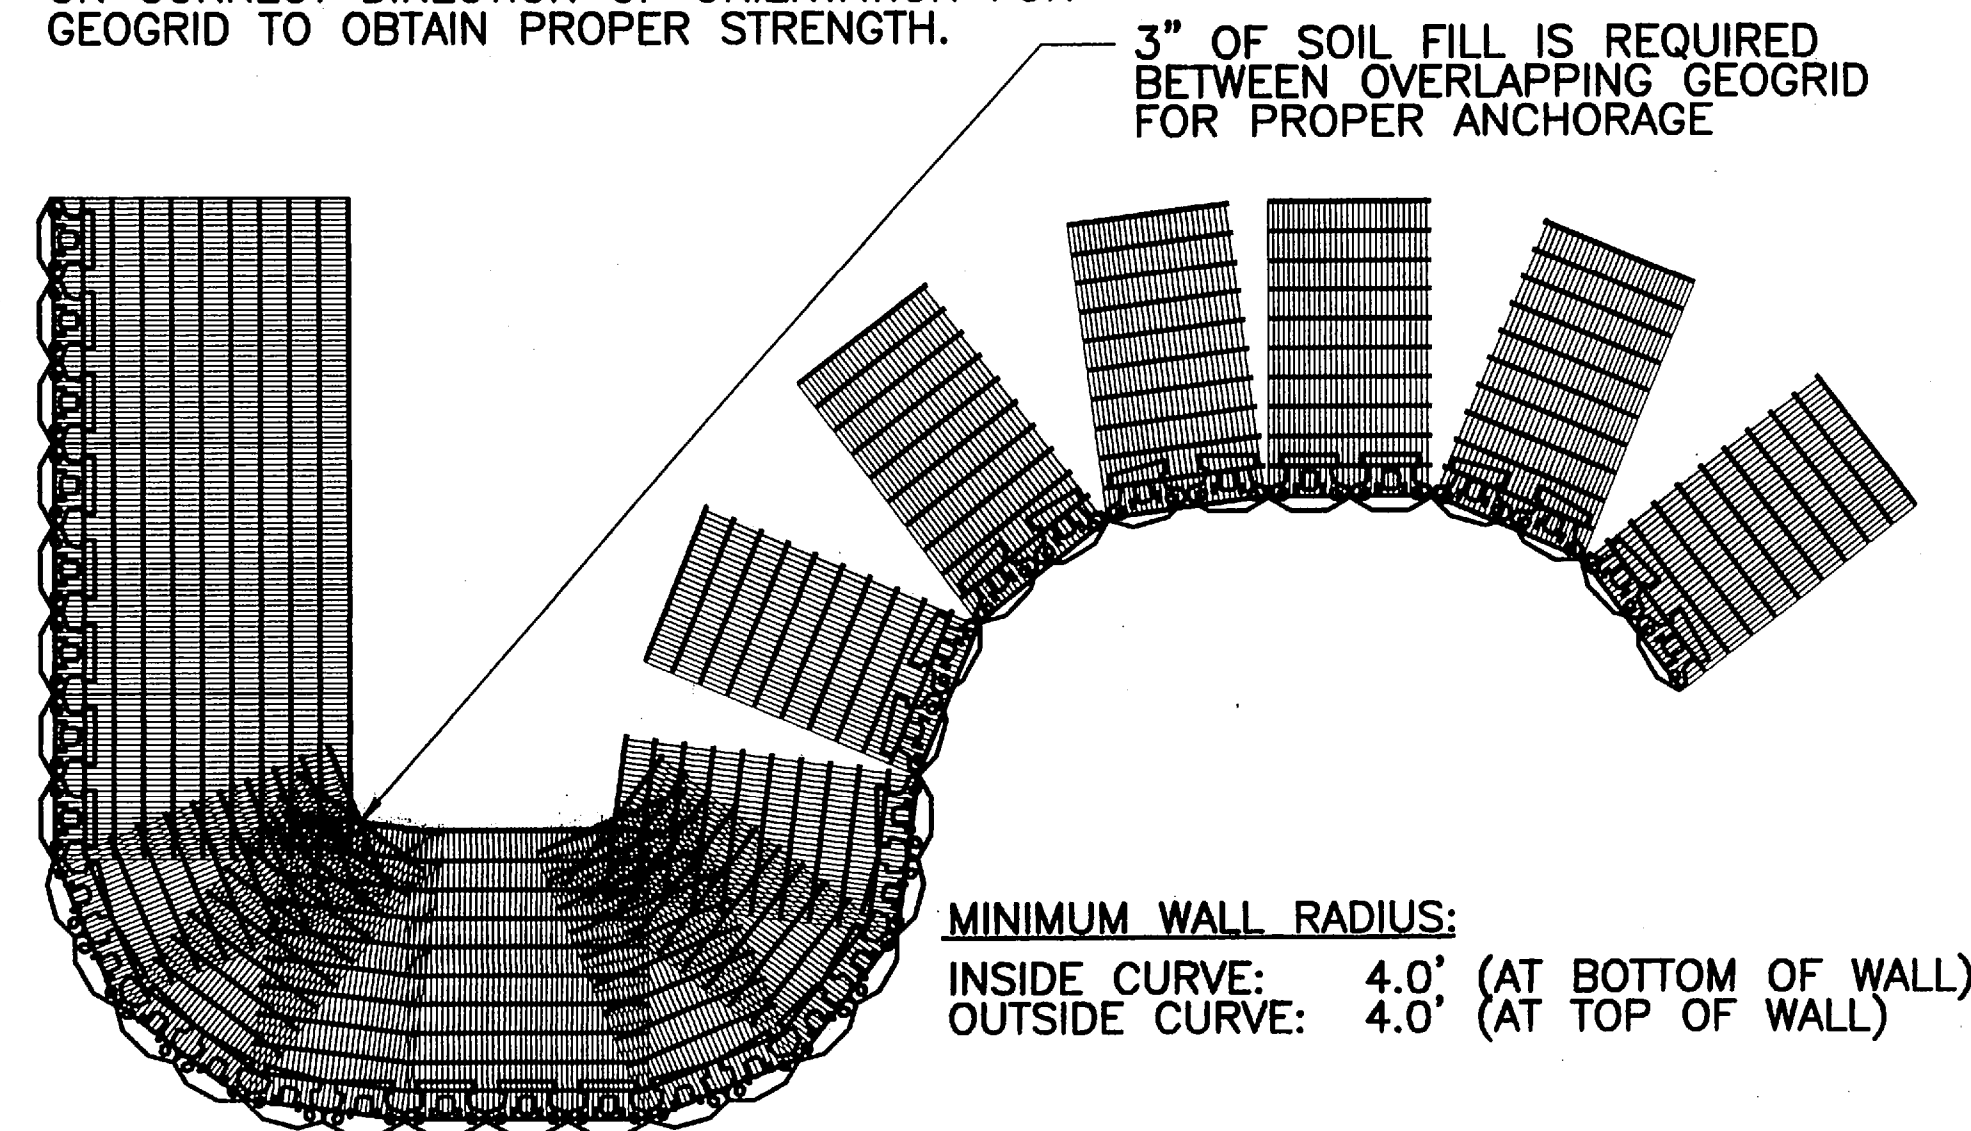


GEOGRID INSTALLATION ON CURVES
SCALE: N.T.S.

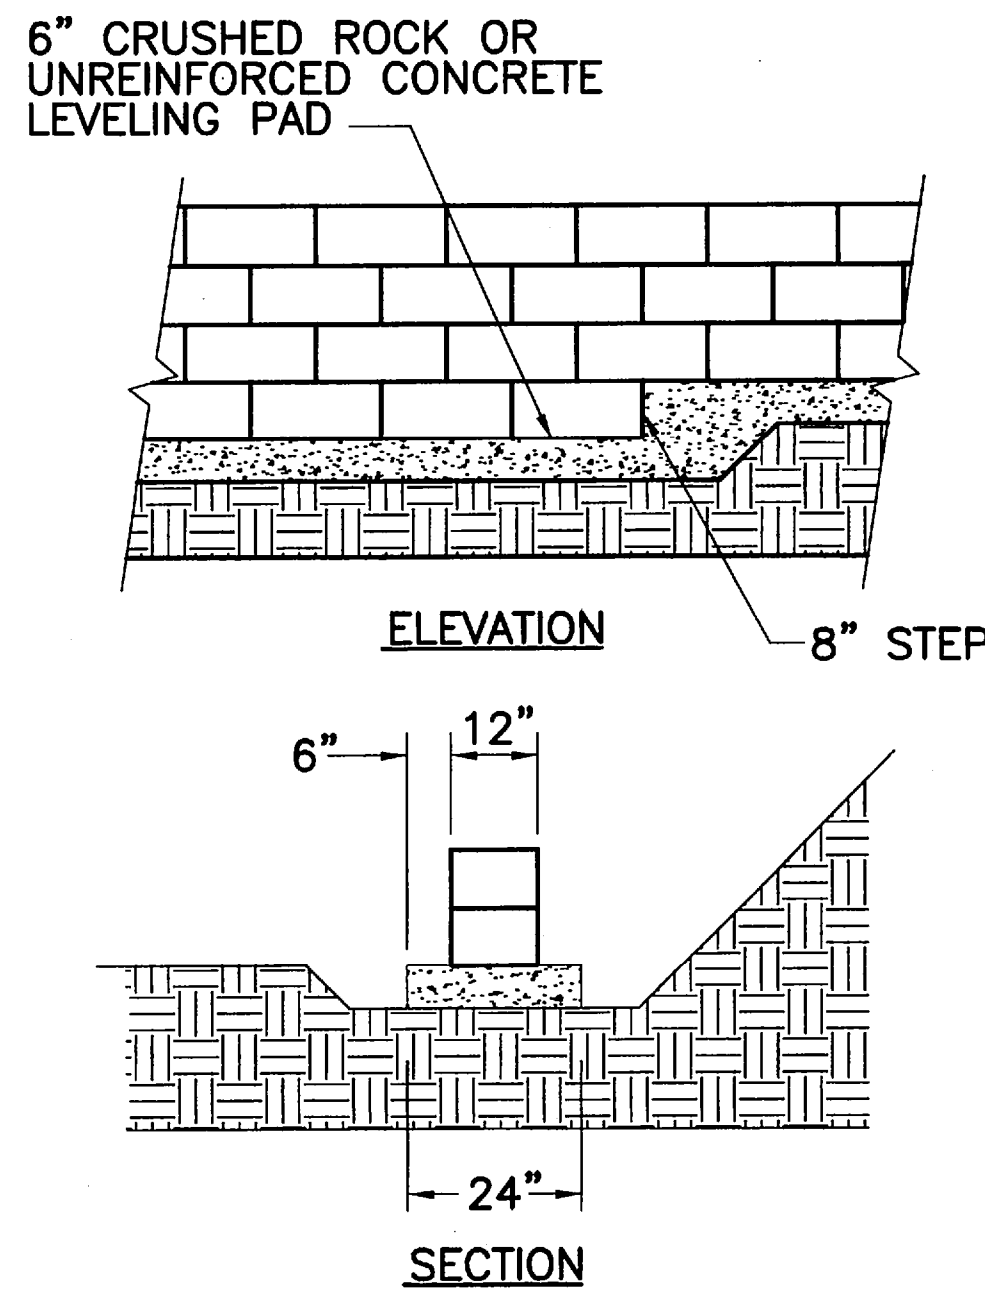


LEVELING PAD DETAIL
SCALE: N.T.S.

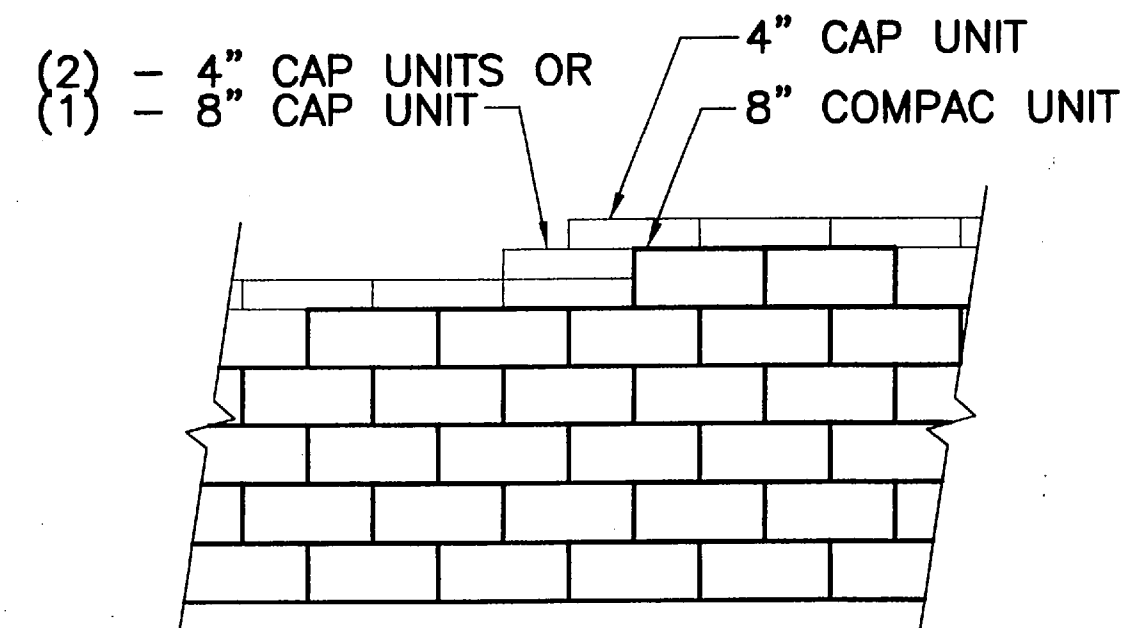

TOP OF WALL STEPS
SCALE: N.T.S.

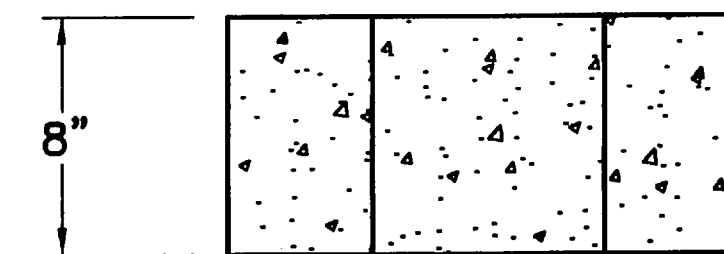

COMPAC ELEVATION

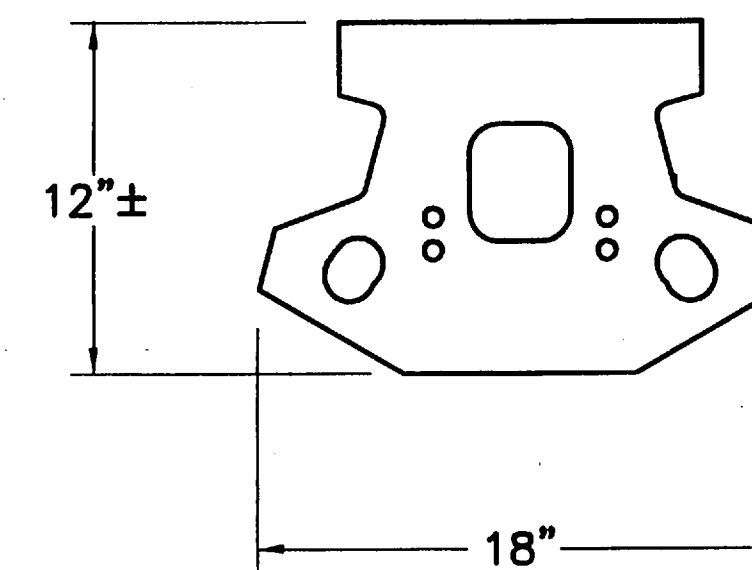


COMPAC PLAN


COMPAC UNIT
SCALE: N.T.S.

NOTE:

1. AUGER THROUGH GEOGRID LAYERS.
2. BACKFILL OR CONCRETE GUARD RAIL POST IN PLACE

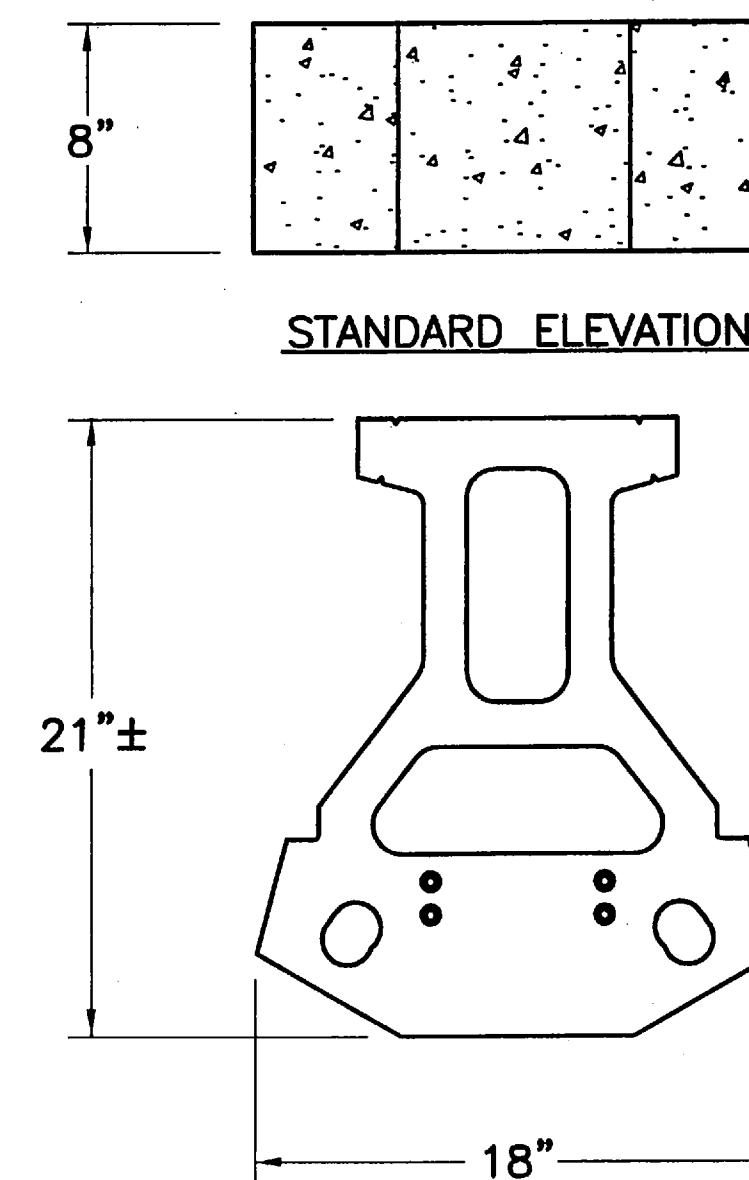


STANDARD ELEVATION

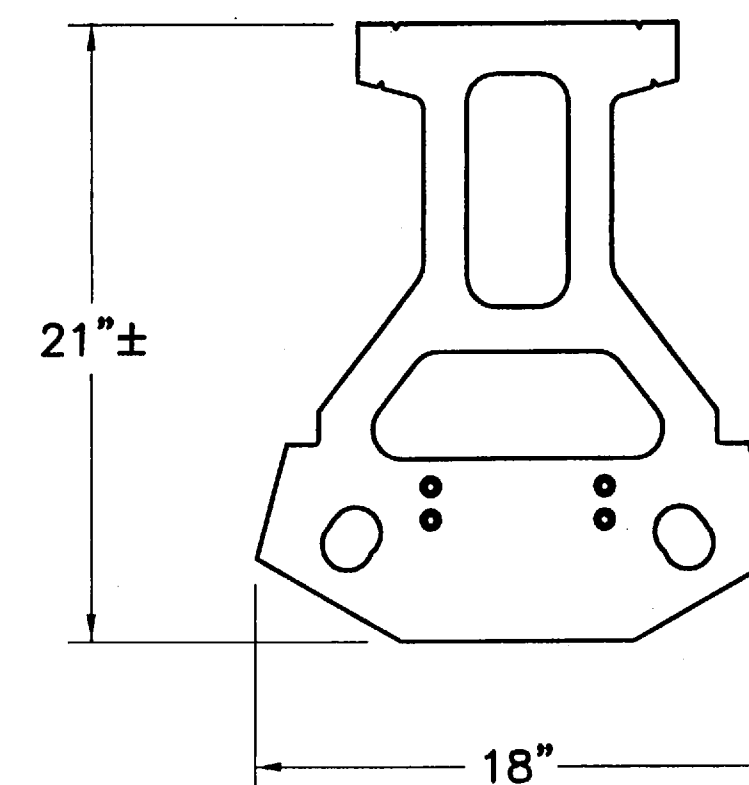


STANDARD PLAN

STANDARD UNIT
SCALE: N.T.S.

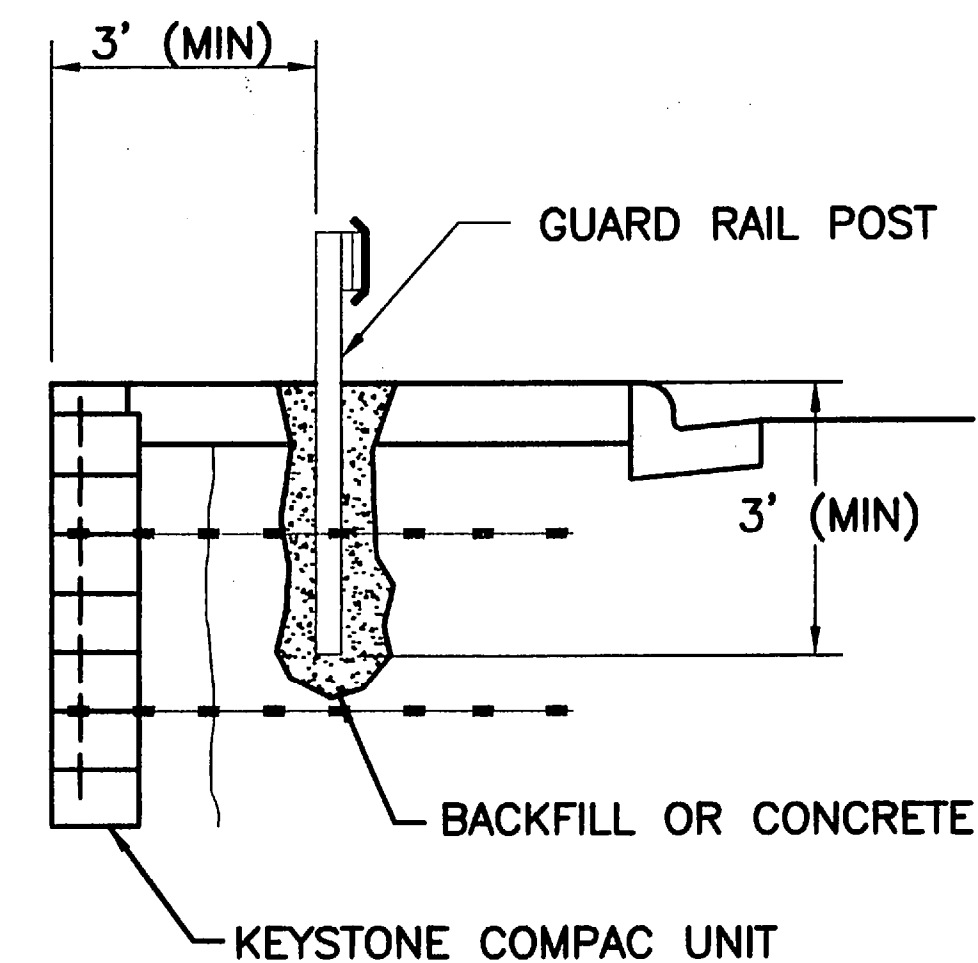

TYPICAL GUARD RAIL DETAIL
SCALE: N.T.S.

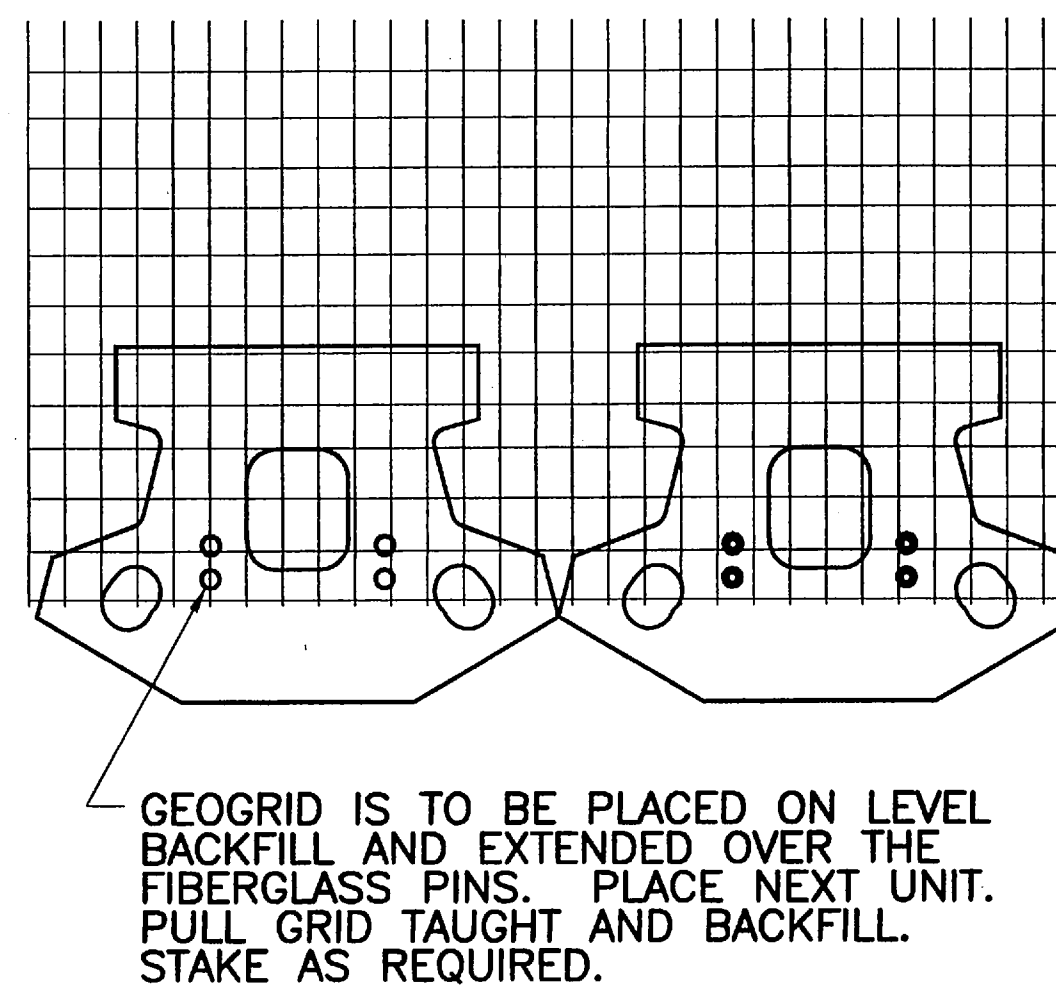

GRID & PIN CONNECTION
SCALE: N.T.S.

7/21/01

Date

DAVID HALL

Designed

DAVID HALL

Drawn

Checked By

Date

REVISIONS

APPD.

BY

DATE

NO.

DAVID HALL STRUCTURAL ENGINEERING

P.O. Box 387

Portland, OR 97208-0387

PHONE: (503) 656-7000

FAX: (503) 656-0686

DAVID HALL

NORWAY DEVELOPMENT

P.O. Box 387

Oregon City, Oregon 97045

PHONE: (503) 656-7000

FAX: (503) 656-0686

AS BUILTS

10579

Project No.

D579C2S6

File No.

S-6

Sheet No.


Copyright 2001

Tanner's Stonegate


CITY OF WEST LINN, OREGON

STRUCTURAL DETAILS AND SPECIFICATIONS

L: ADNAH 11/11/02 1:48pm --> R: DWG\J579C2S7.DWG

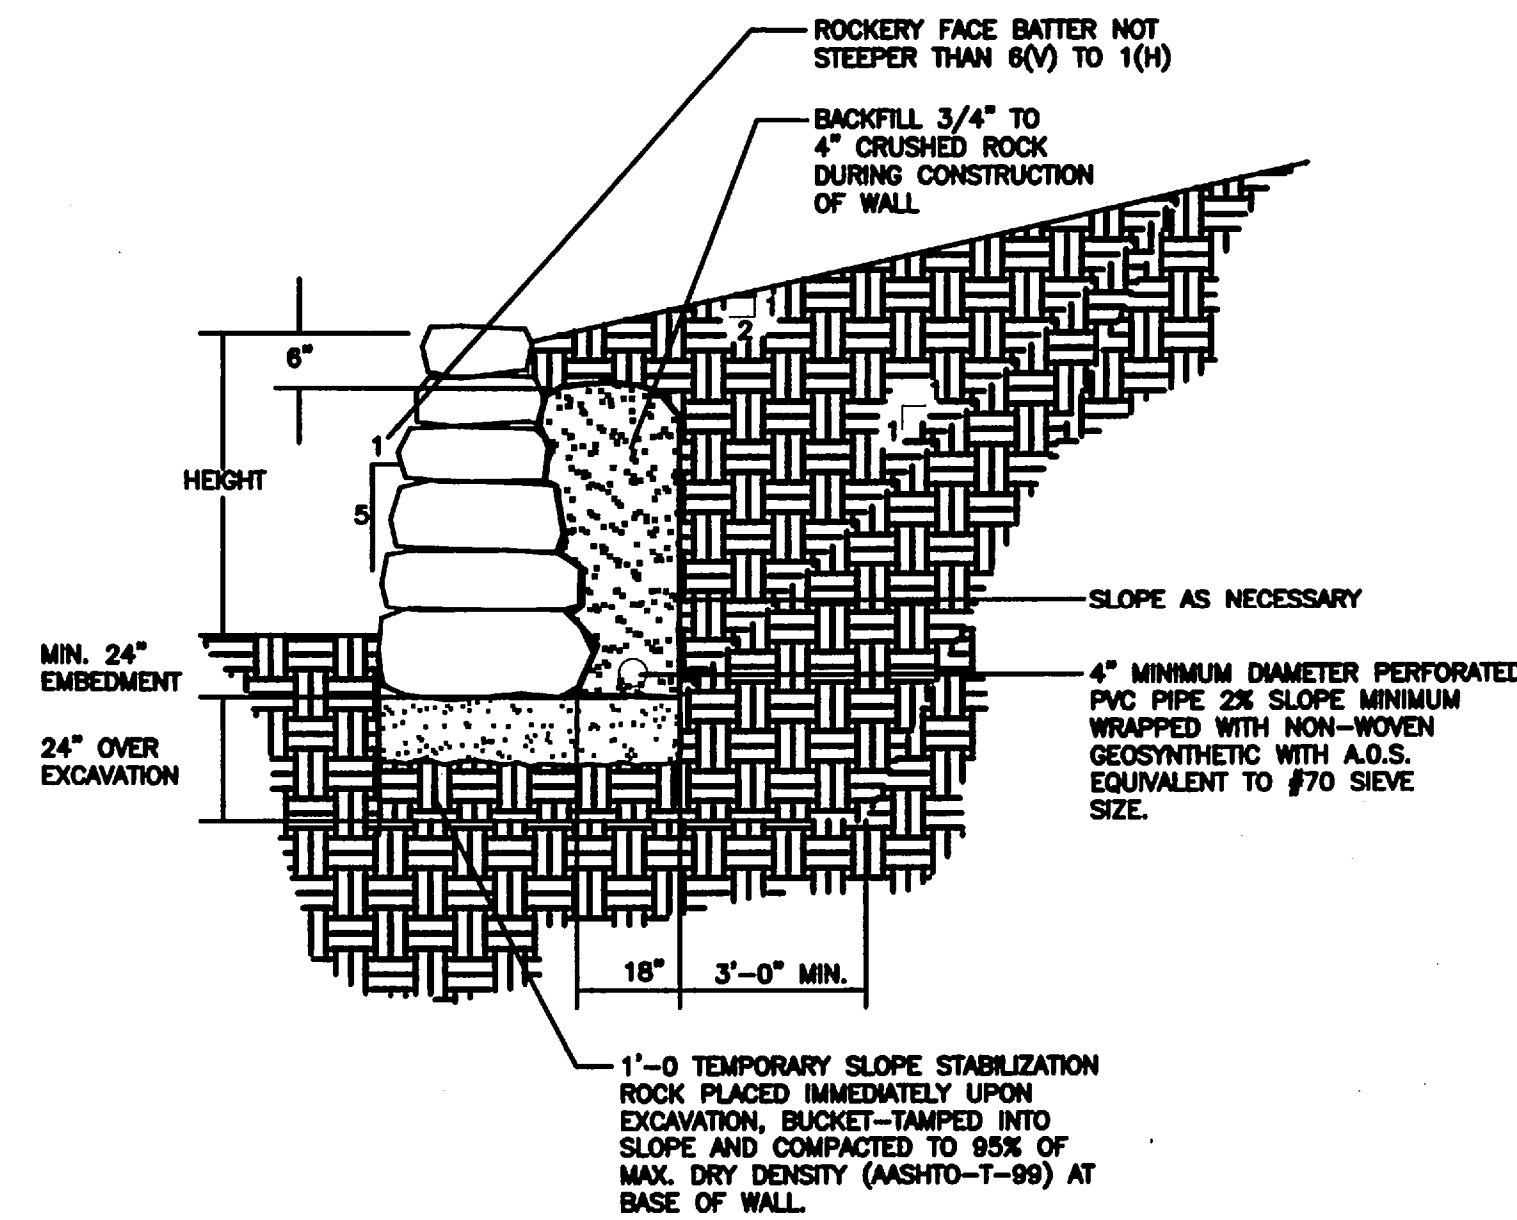

TYP. ROCKERY DETAIL
NOT TO SCALE

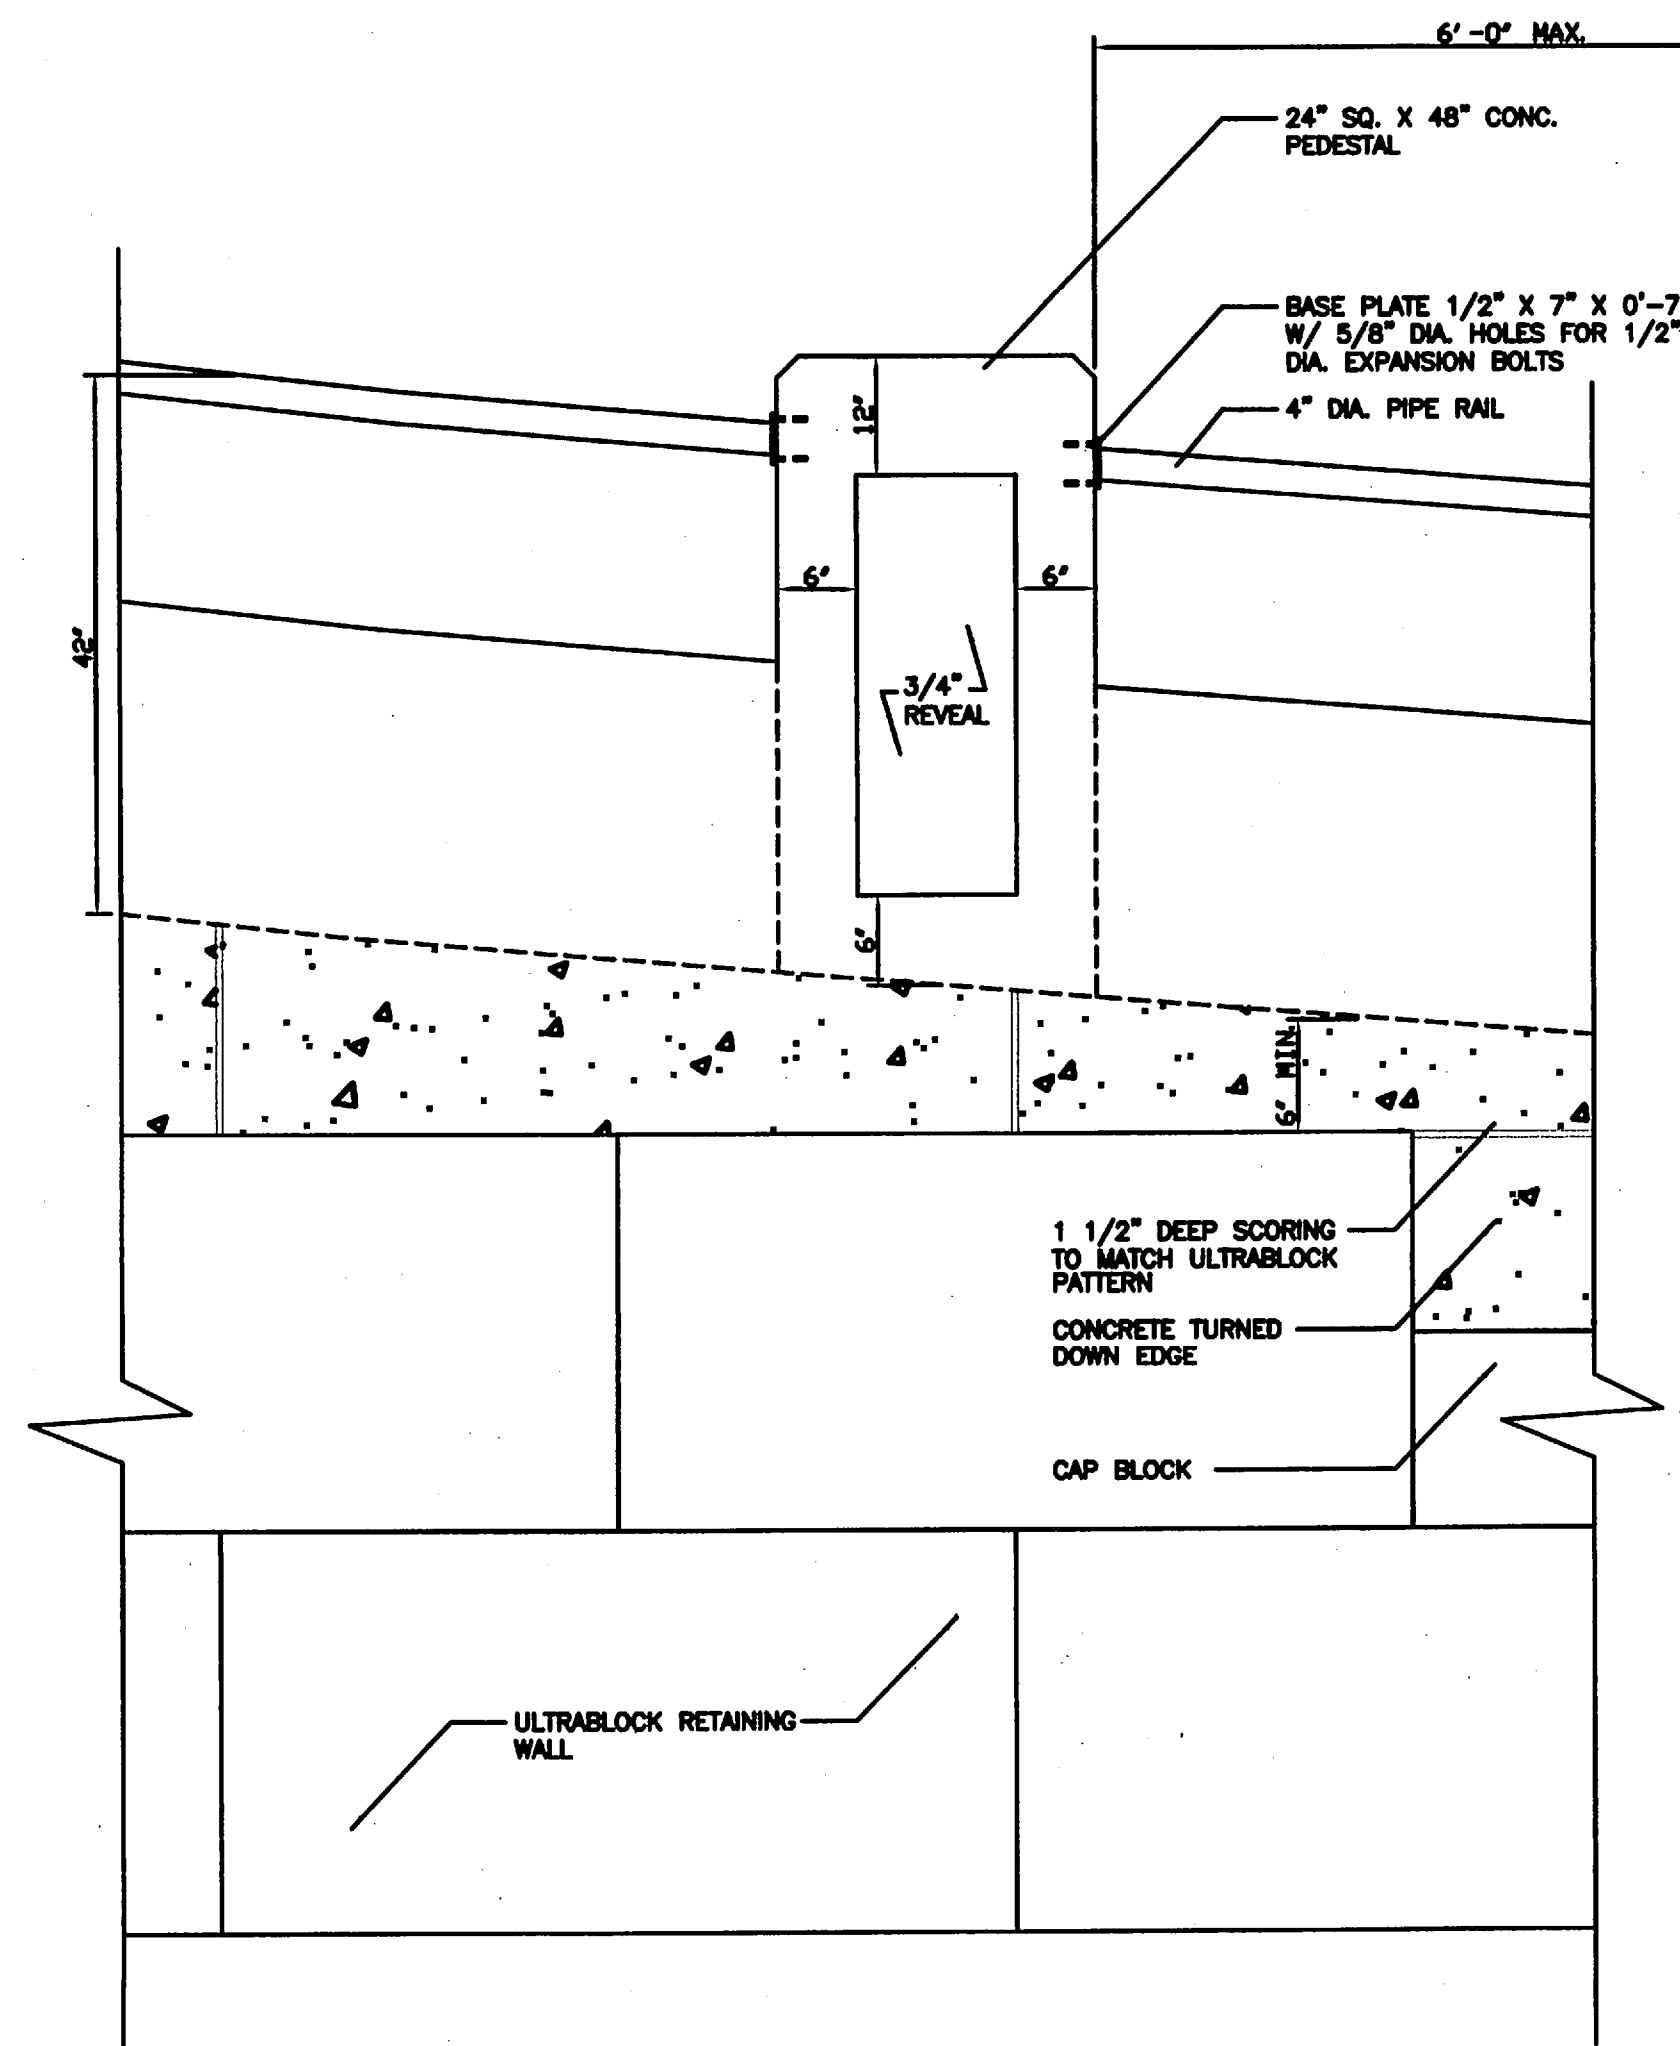

GUARDRAIL DETAIL
NOT TO SCALE

GENERAL REQUIREMENTS

- DESIGN COMPLIANCE OF THIS WALL WAS MADE PER THE RECOMMENDATIONS IN REPORT #3419 PREPARED BY GEOTECHNICAL RESOURCES INC. DATED MARCH 30, 2001. THE CONTRACTOR IS RESPONSIBLE FOR REVIEWING THIS REPORT AND ADHERING TO ALL RECOMMENDATIONS MADE WITHIN. ALL MODIFICATIONS SHALL BE MADE THROUGH DAVID A. HALL/STRUCTURAL ENGINEERING (DAH/SE).
- THE CONTRACTOR CONSTRUCTING THE ROCKERY RETAINING WALL SHALL BE SKILLED AND EXPERIENCED IN BUILDING THIS TYPE OF RETAINING WALL SYSTEM. THE CONTRACTOR BUILDING THIS WALL SHALL BE APPROVED BY BOTH THE OWNER AND DAH/SE.
- THE OWNER SHALL BE AWARE THAT ROCKERY'S TYPICALLY EXPERIENCE A "SETTLING IN" DURING AND FOR SOME TIME AFTER CONSTRUCTION. THE OWNER SHALL ALSO BE AWARE THAT A ROCKERY WALL IS CONSIDERED A MAINTENANCE ITEM AND WILL REQUIRE PERIODIC INSPECTION AND REPAIR.
- THE LONG DIMENSION OF THE ROCKS SHALL EXTEND BACK TOWARDS THE RETAINED PORTION OF THE SOIL IN ORDER TO PROVIDE MAXIMUM STABILITY. THE ROCKS SHOULD NOT BE STACKED LIKE SHOE BOXES. THE ROCKS SHALL BE PLACED TO AVOID CONTINUOUS JOINT PLANES IN BOTH THE VERTICAL AND HORIZONTAL DIRECTIONS SO THERE IS NO SIGN OF INSTABILITY SUCH AS "ROCKING" OR "TIPPING" OF INDIVIDUAL BOULDERS. THE ROCKS SHOULD FIT SO NO OPEN SPACES OR VOIDS LARGER THAN 6 INCHES EXIST. ROCKS SHOULD BE PLACED SO THAT THERE IS SOME BEARING BETWEEN FLAT ROCK FACES, RATHER THAN ON POINTS. HORIZONTAL OR NEARLY HORIZONTAL JOINTS SHOULD SLOPE DOWNWARD INTO THE MATERIAL PROTECTED (AWAY FROM THE ROCKERY FACE). EACH ROCK SHALL BEAR ON TWO OR MORE ROCKS BELOW IT WITH GOOD FLAT TO FLAT CONTACT.
- THE CONTRACTOR SHALL USE SUFFICIENT SPACE SO THAT HE CAN SELECT AMONG A NUMBER OF ROCKS FOR EACH SPACE IN THE ROCKERY TO BE FILLED. ROCKS WHICH HAVE SPACES WHICH DO NOT MATCH THE SPACES OFFERED BY THE PREVIOUS COURSE OF ROCK SHOULD BE REJECTED. ROCK MUST BE ANGULAR, TABULAR, OR SEMI-RECTANGULAR SHAPED; ANY ROCKS OF BASICALLY ROUNDED FORM SHALL NOT BE USED.
- THE FIRST COURSE OF ROCKS MUST BE PLACED ON FIRM, UNYIELDING SOIL. THERE MUST BE FULL CONTACT BETWEEN THE ROCK AND SOIL WHICH MAY REQUIRE SHAPING OF THE GROUND SURFACE OR SLAMMING OR DROPPING THE ROCKS INTO PLACE SO THAT THE SOIL FOUNDATION CONFORMS TO THE ROCK FACE BEARING ON IT. AS AN ALTERNATIVE, IT IS SATISFACTORY TO USE LEAN CONCRETE IN WHICH TO SEAL THE FIRST COURSE OF ROCKS OR TO USE 3/4-INCH MINUS CRUSHED ROCK INTO WHICH THE FOUNDATION ROCKS ARE SEALED. THE BOTTOM OF THE FIRST COURSE OF ROCK SHOULD BE A MINIMUM OF 1 FOOT BELOW THE LOWEST ADJACENT GRADE.
- THE ROCKERY FACE SHALL SLOPE TOWARD THE BANK BEING PROTECTED OF NOT STEEPER THAN 1 (HORIZONTAL) TO 5 (VERTICAL), BUT NOT FLATTER THAN 1H TO 3V.
- SPILLS SHOULD BE USED BEHIND THE ROCKERY ROCKS TO BLOCK SPACES AND WHERE NECESSARY, TO WEDGE BETWEEN ROCKS AND TO LOCK THEM TOGETHER. THIS SHOULD ALSO SERVE TO PREVENT WASHING OF BACKFILL MATERIAL THROUGH THE ROCKERY.

- BACKFILL BETWEEN THE ROCKERY AND THE ADJACENT SOIL FACE SHOULD BE A MINIMUM OF 1 FOOT WIDE AND CONSIST OF WASHED AND SCREENED CRUSHED ROCK RANGING FROM 3/4-INCH MINIMUM TO 4-INCH MAXIMUM GRADATION WITH THE MAJORITY ABOUT 1 INCHES IN PARTICLE SIZE. THE BACKFILL ZONE MUST BE FILLED AND THOROUGHLY TAMPED AS EACH COURSE OF BOULDERS IS PLACED.
- IF THERE IS SEEPAGE OR A POTENTIAL FOR INFILTRATION OF SURFACE WATER INTO THE BACKFILL ZONE, SPECIAL DRAINAGE MEASURES OR SEDIMENT FILTRATION MAY BE REQUIRED. THE GEOTECHNICAL ENGINEER SHOULD BE CONTACTED FOR FURTHER ADVICE.
- SURFACE DRAINAGE ABOVE THE ROCKERY SHOULD BE DIVERTED OR COLLECTED AND CARRIED IN CLOSED CONDUITS TO A POINT BELOW THE ROCKERY.

HEIGHT

- UNLESS SPECIFICALLY DESIGNED FOR GIVEN SITUATIONS, THE MAXIMUM ROCKERY HEIGHTS SHOULD BE AS FOLLOWS:
- NO MORE THAN 6 FEET WHEN RETAINING COMPACTED FILL WITH A 2 TO 1 (HORIZONTAL TO VERTICAL) SLOPE ABOVE THE ROCKERY.
 - NO MORE THAN 8 FEET WHEN RETAINING COMPACTED FILL WITH LEVEL GROUND ABOVE THE ROCKERY.
 - NO MORE THAN 8 FEET WHEN USED AS A FACING FOR STABLE CUTS IN UNDISTURBED NATIVE SOIL OR REINFORCED EARTH FILL WITH A 2 TO 1 SLOPE ABOVE THE ROCKERY.
 - NO MORE THAN 8 FEET WHEN USED AS A FACING FOR STABLE CUTS IN UNDISTURBED NATIVE SOIL OR REINFORCED EARTH FILL WITH LEVEL GROUND ABOVE THE ROCKERY.
 - WHERE SURCHARGE LOADS ACT ON THE ROCKERY, THE MAXIMUM HEIGHT WILL BE REDUCED AND DETERMINED BY THE GEOTECHNICAL ENGINEER.
 - THE MINIMUM HORIZONTAL BENCH WIDTH FOR STEPPED ROCKERY'S, MEASURED FROM THE BACK OF THE ROCKERY, SHOULD BE 0.8H FOR FILL SLOPES AND 0.6H FOR CUT SLOPES, WHERE H EQUALS THE ROCKERY HEIGHT.

ROCK QUALITY

ALL ROCK SHALL BE SOUND, UNWEATHERED, WEATHERING RESISTANT, ANGULAR LEDGE ROCK. THE LONGEST DIMENSION OF ANY INDIVIDUAL ROCK SHOULD NOT EXCEED THREE TIMES ITS SHORTEST DIMENSION. ACCEPTABILITY OF ROCK TO BE DETERMINED BY LABORATORY TESTS PROVIDED BY THE CONTRACTOR FROM A REPRESENTATIVE SAMPLE OF THE MATERIAL EVERY 100 FEET OF WALL OR AS DETERMINED BY THE GEOTECHNICAL ENGINEER.

- | | |
|--|-----------------------------|
| A. ABSORPTION
(CORPS OF ENGINEERS CRD-C-107) | NOT MORE THAN 3.0% |
| B. ACCELERATED EXPANSION (15 DAYS)
(CRD-C-148) | NOT MORE THAN 15% BREAKDOWN |
| C. SOUNDNESS
(MSS04 AT 5 CYCLES)
(CRD-C-137) | NOT GREATER THAN 5% LOSS |


- D. UNCONFINED COMPRESSIVE STRENGTH
ASTM D 2186-86 (REAPPROVED 1979) INTACT STRENGTH OF 14,500 PSI OR GREATER

THE MOST IMPORTANT DIMENSION IS THE HORIZONTAL BASEWIDTH OF THE ROCK MEASURED PERPENDICULAR TO THE RETAINED SOIL. THE MINIMUM THICKNESS VARIES WITH THE HEIGHT OF THE ROCKERY AND LATERAL LOADS TO BE CARRIED BY THE ROCKERY. THE ROCKERY CAN BE TAPERED IN THICKNESS PROVIDING THAT THE THICKNESS EQUALS OR EXCEEDS THE FOLLOWING:

MINIMUM WALL BASEWIDTH	ROCKERY HEIGHT (INCLUDING EMBEDMENT)
60 INCHES + TEMPORARY SLOPE ROCK	8 FEET
42 INCHES + TEMPORARY SLOPE ROCK	7 FEET
36 INCHES + TEMPORARY SLOPE ROCK	6 FEET
22 INCHES + TEMPORARY SLOPE ROCK	4 FEET

SIZE	APPROXIMATE WEIGHT	APPROXIMATE DIAMETER
1 MAN	50 TO 200 LBS	12 TO 18 INCHES
2 MAN	200 TO 700 LBS	18 TO 28 INCHES
3 MAN	700 TO 2000 LBS	28 TO 36 INCHES
4 MAN	2000 TO 4000 LBS	36 TO 48 INCHES
5 MAN	4000 TO 6000 LBS	48 TO 54 INCHES
6 MAN	6000 TO 8000 LBS	54 TO 60 INCHES

THE OWNER SHALL BE AWARE THAT ROCKERY CONSTRUCTION IS AN ART AND DEPENDS LARGELY ON THE SKILL OF THE BUILDER. ALTHOUGH ROCKERIES CAN OFFER SIGNIFICANT LATERAL RESTRAINT, THEY ARE PARTIALLY INDETERMINATE AND THEY PRESENT UNUSUAL RISK RELATIVE TO THE RETAINING STRUCTURES. EVEN WHEN THE FOUNDATION AND RETAINED MATERIALS ARE SATISFACTORY AND THE ROCKERY MATERIALS AND CONSTRUCTION APPEAR SATISFACTORY, THERE IS SOME RISK OF MOVEMENT AND FAILURE.

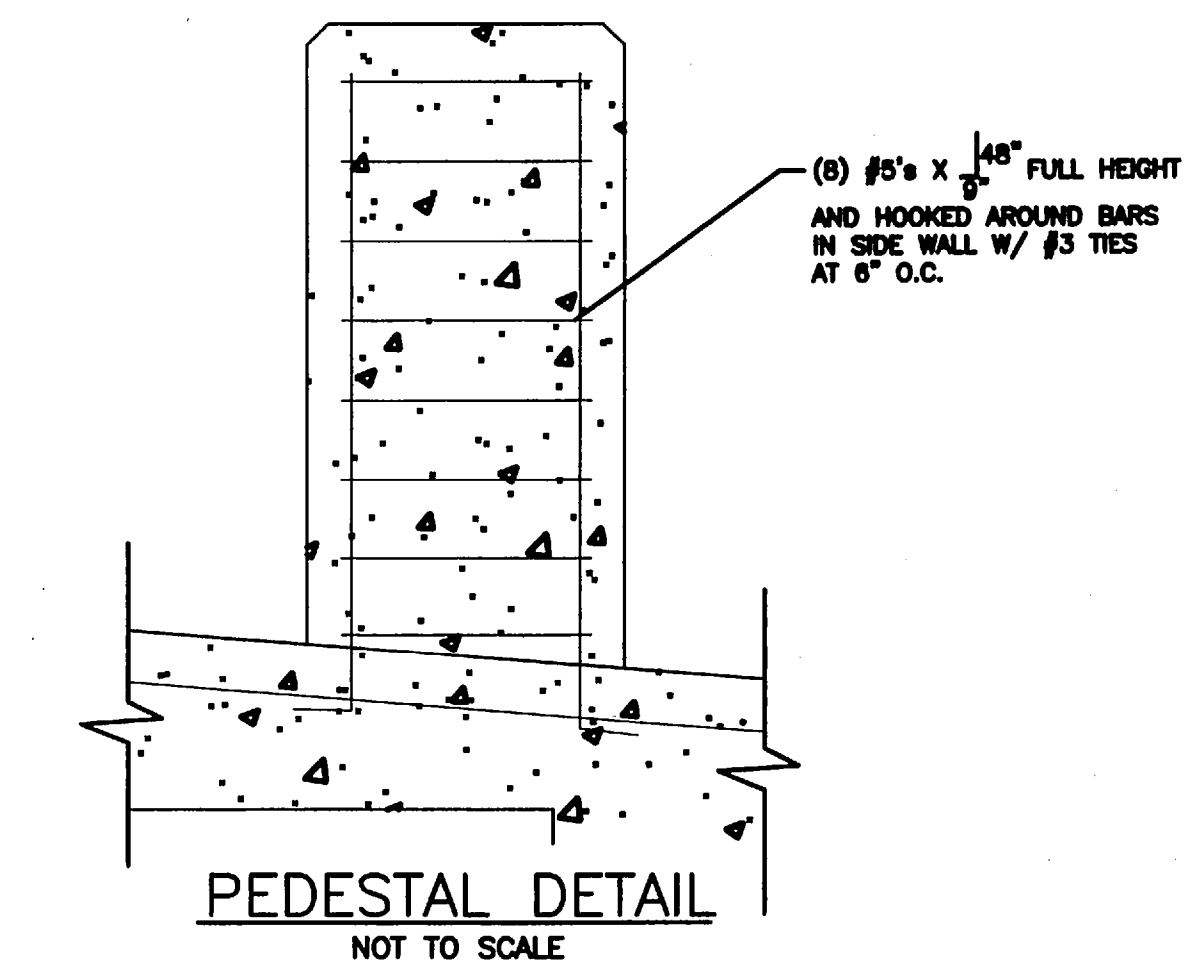

ULTRABLOCK PIN INSTALLATION
NOT TO SCALE

ULTRABLOCK PIN DETAIL
NOT TO SCALE

AS BUILTS

8/21/01
Date
DAVID HALL
Designed
DAVID HALL
Drawn
Checked By Date

NO. DATE BY APPD.


REVISIONS

DAH/SE
DAVID A. HALL/STRUCTURAL ENGINEERING
P.O. Box 387
Norway Development
Oregon City, Oregon 97045
PHONE: (503) 656-7000
FAX: (503) 656-0686


Tanner's Stonegate
CITY OF WEST LINN, OREGON
STRUCTURAL DETAILS AND SPECIFICATIONS

10579
Project No.
D579C2S7
File No.
S-7
Sheet No.
Copyright 2001

XREF LIST
Ltscale: 1
Resolved
d579x190
D579X230
D579X400
D579X600
D579X902
D579X903
TRAILS
Unresolved
D579X431

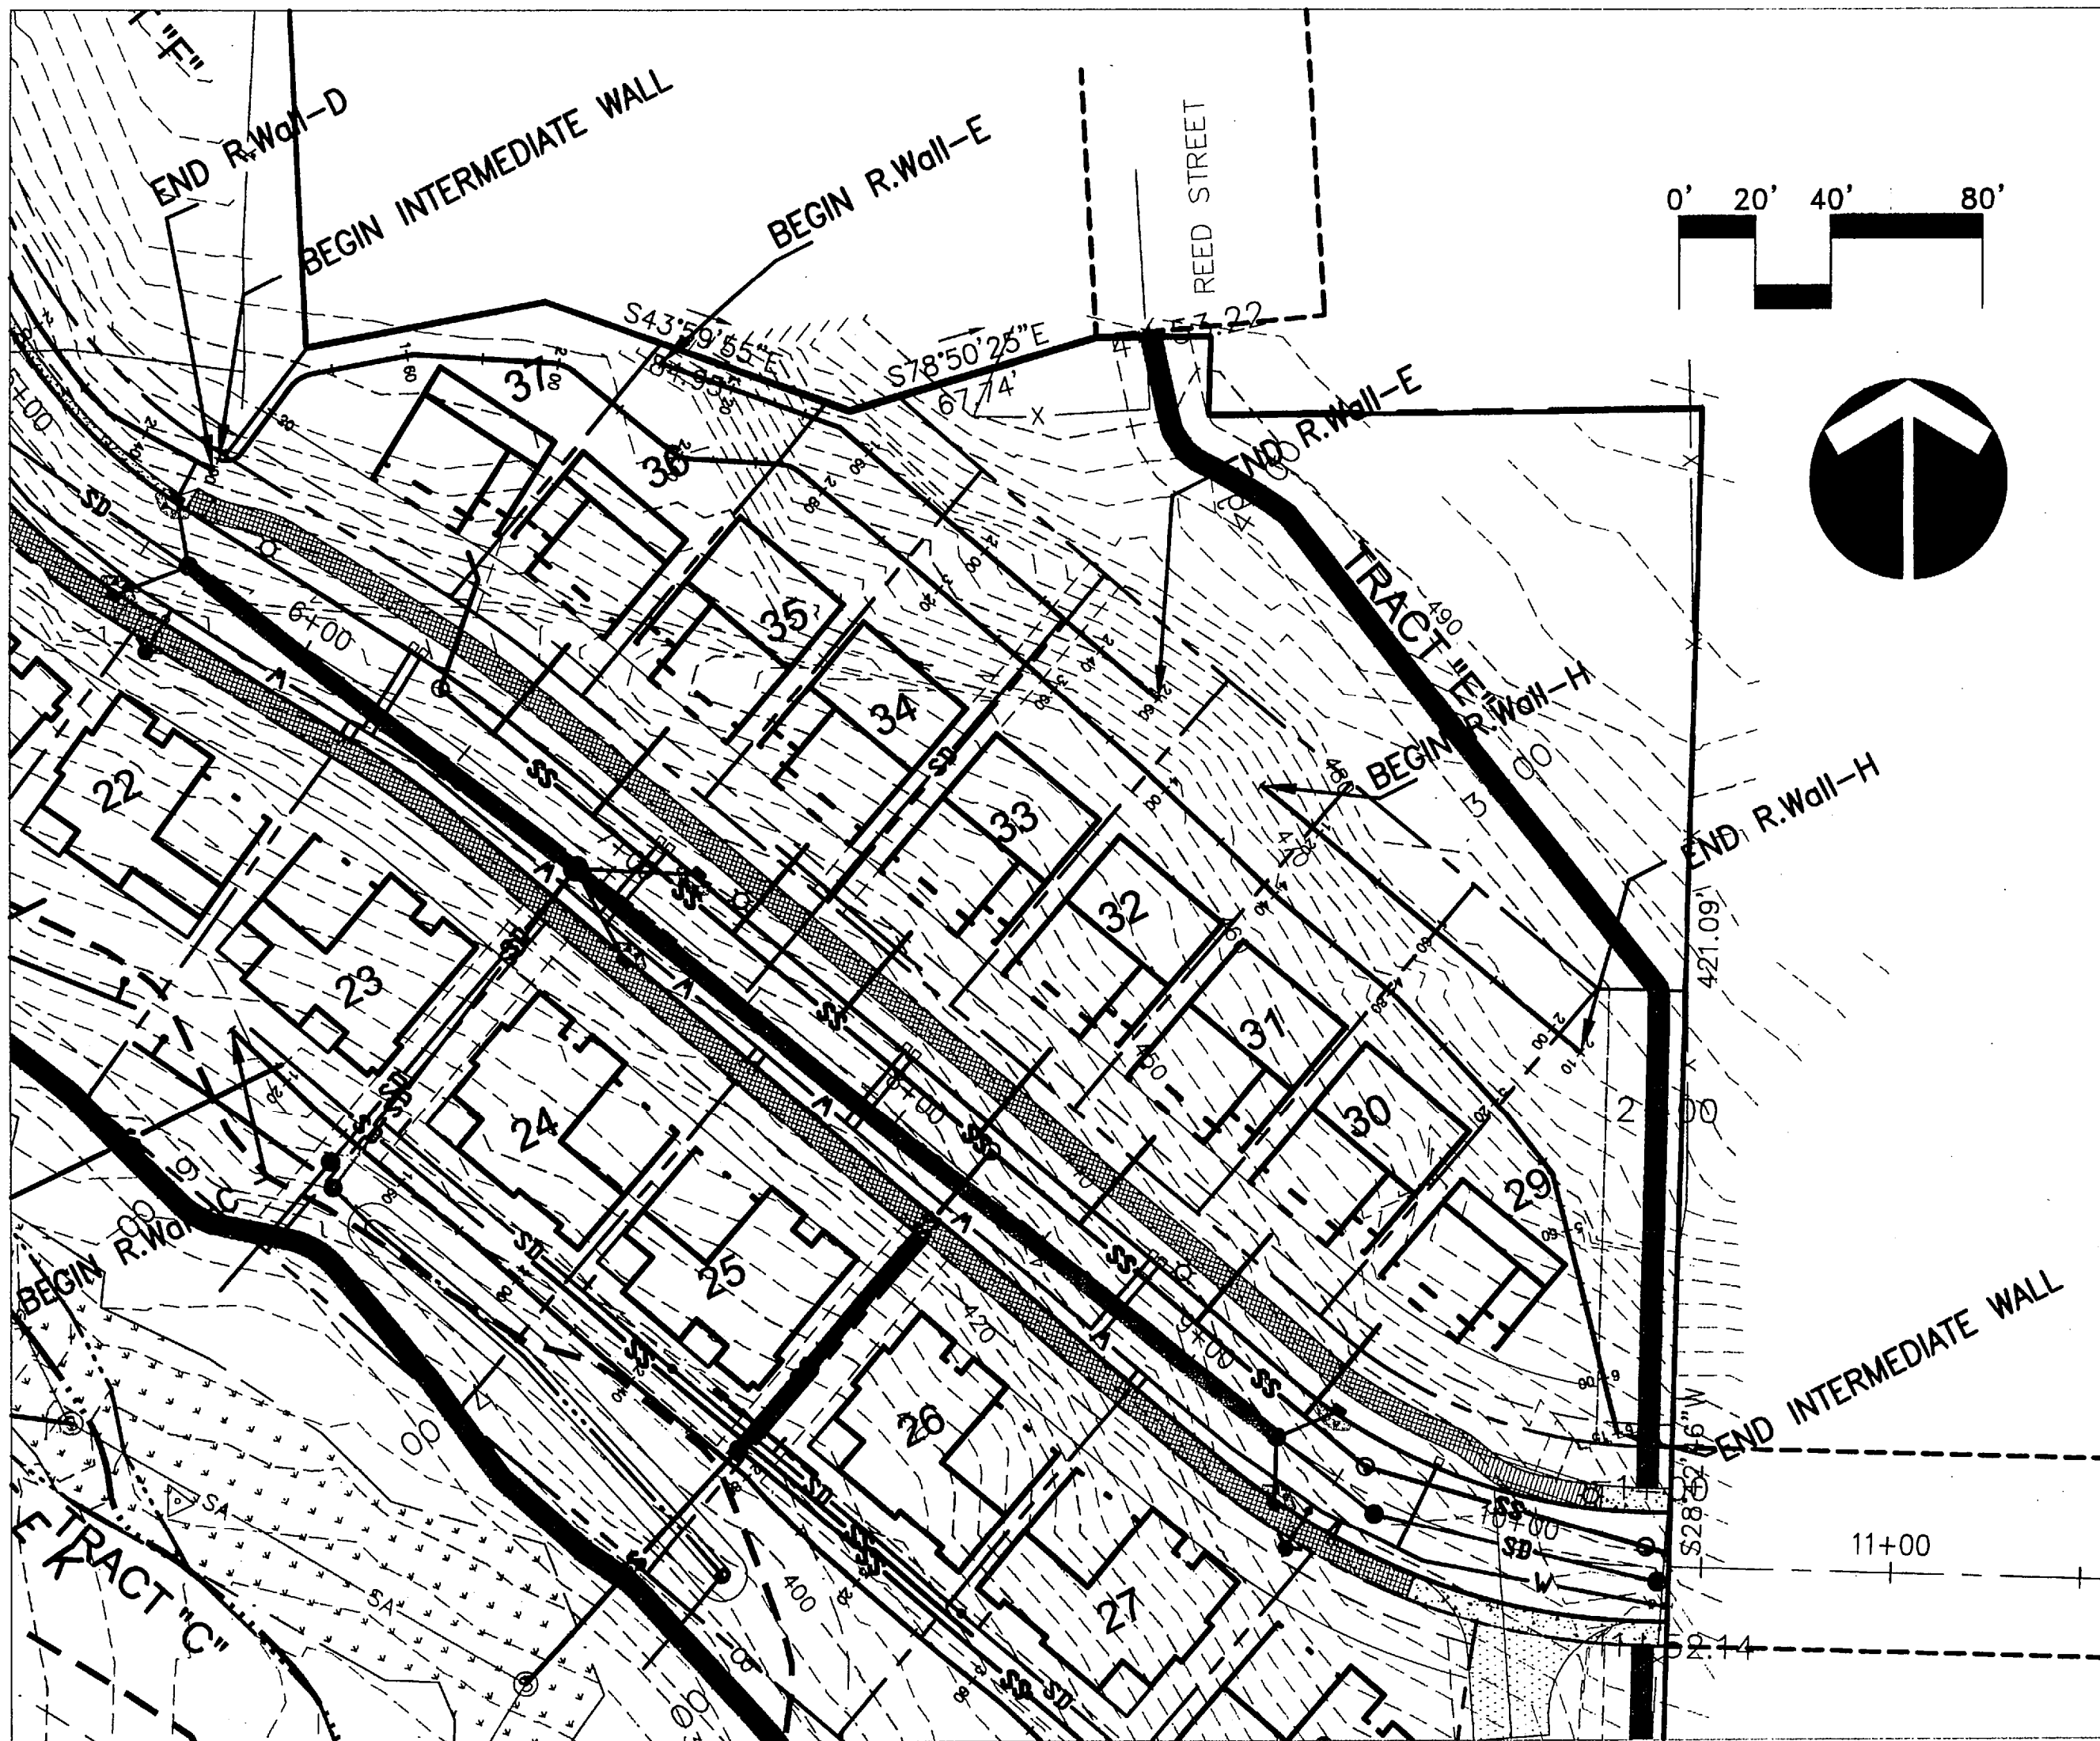

NOTE:
1- RETAINING WALLS DETAILS AND SPECIFICATIONS
ARE SHOWN ON SHEET S-3 TO S-7.

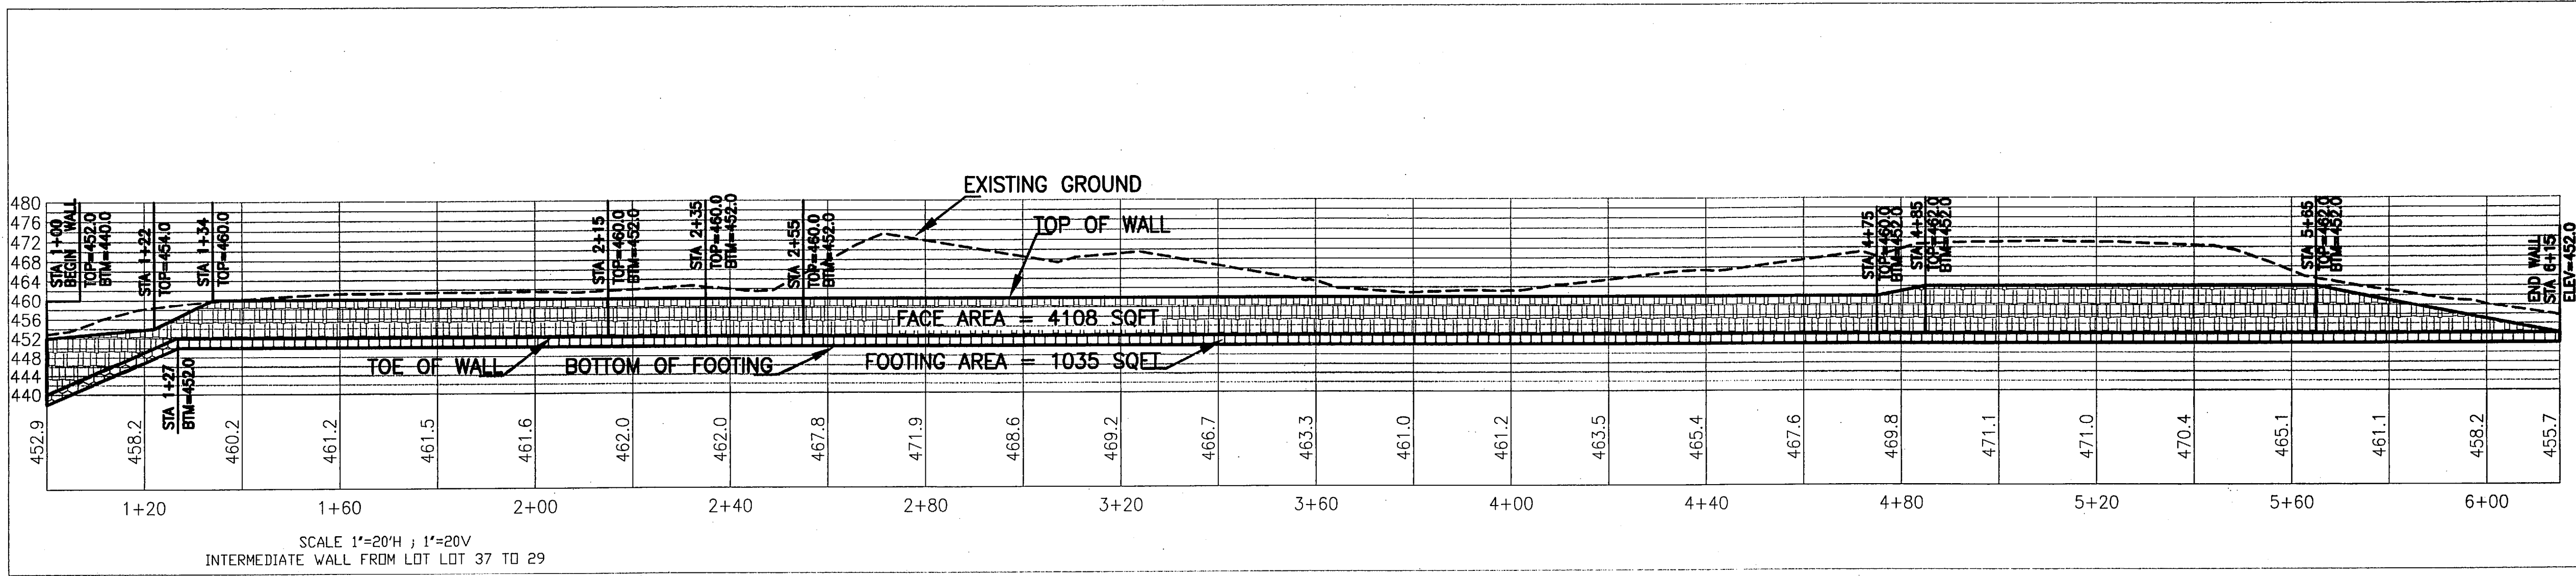

9/27/01
Date
DAVID HALL
Designed
DAVID HALL
Drawn
Checked By Date

REVISIONS
NO. DATE BY APPD.

DAVID HALL
DAVID HALL STRUCTURAL ENGINEERING
P.O. BOX 337
PORTLAND, OR 97202-0337
PHONE: (503) 656-7000
FAX: (503) 656-0686

NORWAY DEVELOPMENT
P.O. Box 387
Oregon City, Oregon 97045
PHONE: (503) 656-7000
FAX: (503) 656-0686

Tanner's Stonegate
CITY OF WEST LINN, OREGON
INTERMEDIATE RETAINING WALL

ASBUILT
10579
Project No.
D579NWLL
File No.
N-WALL
Sheet No.
Copyright 2001