


0



			DRAWN	
			FILE	DATE
			SCALE	
DATE	NO.	REVISION		

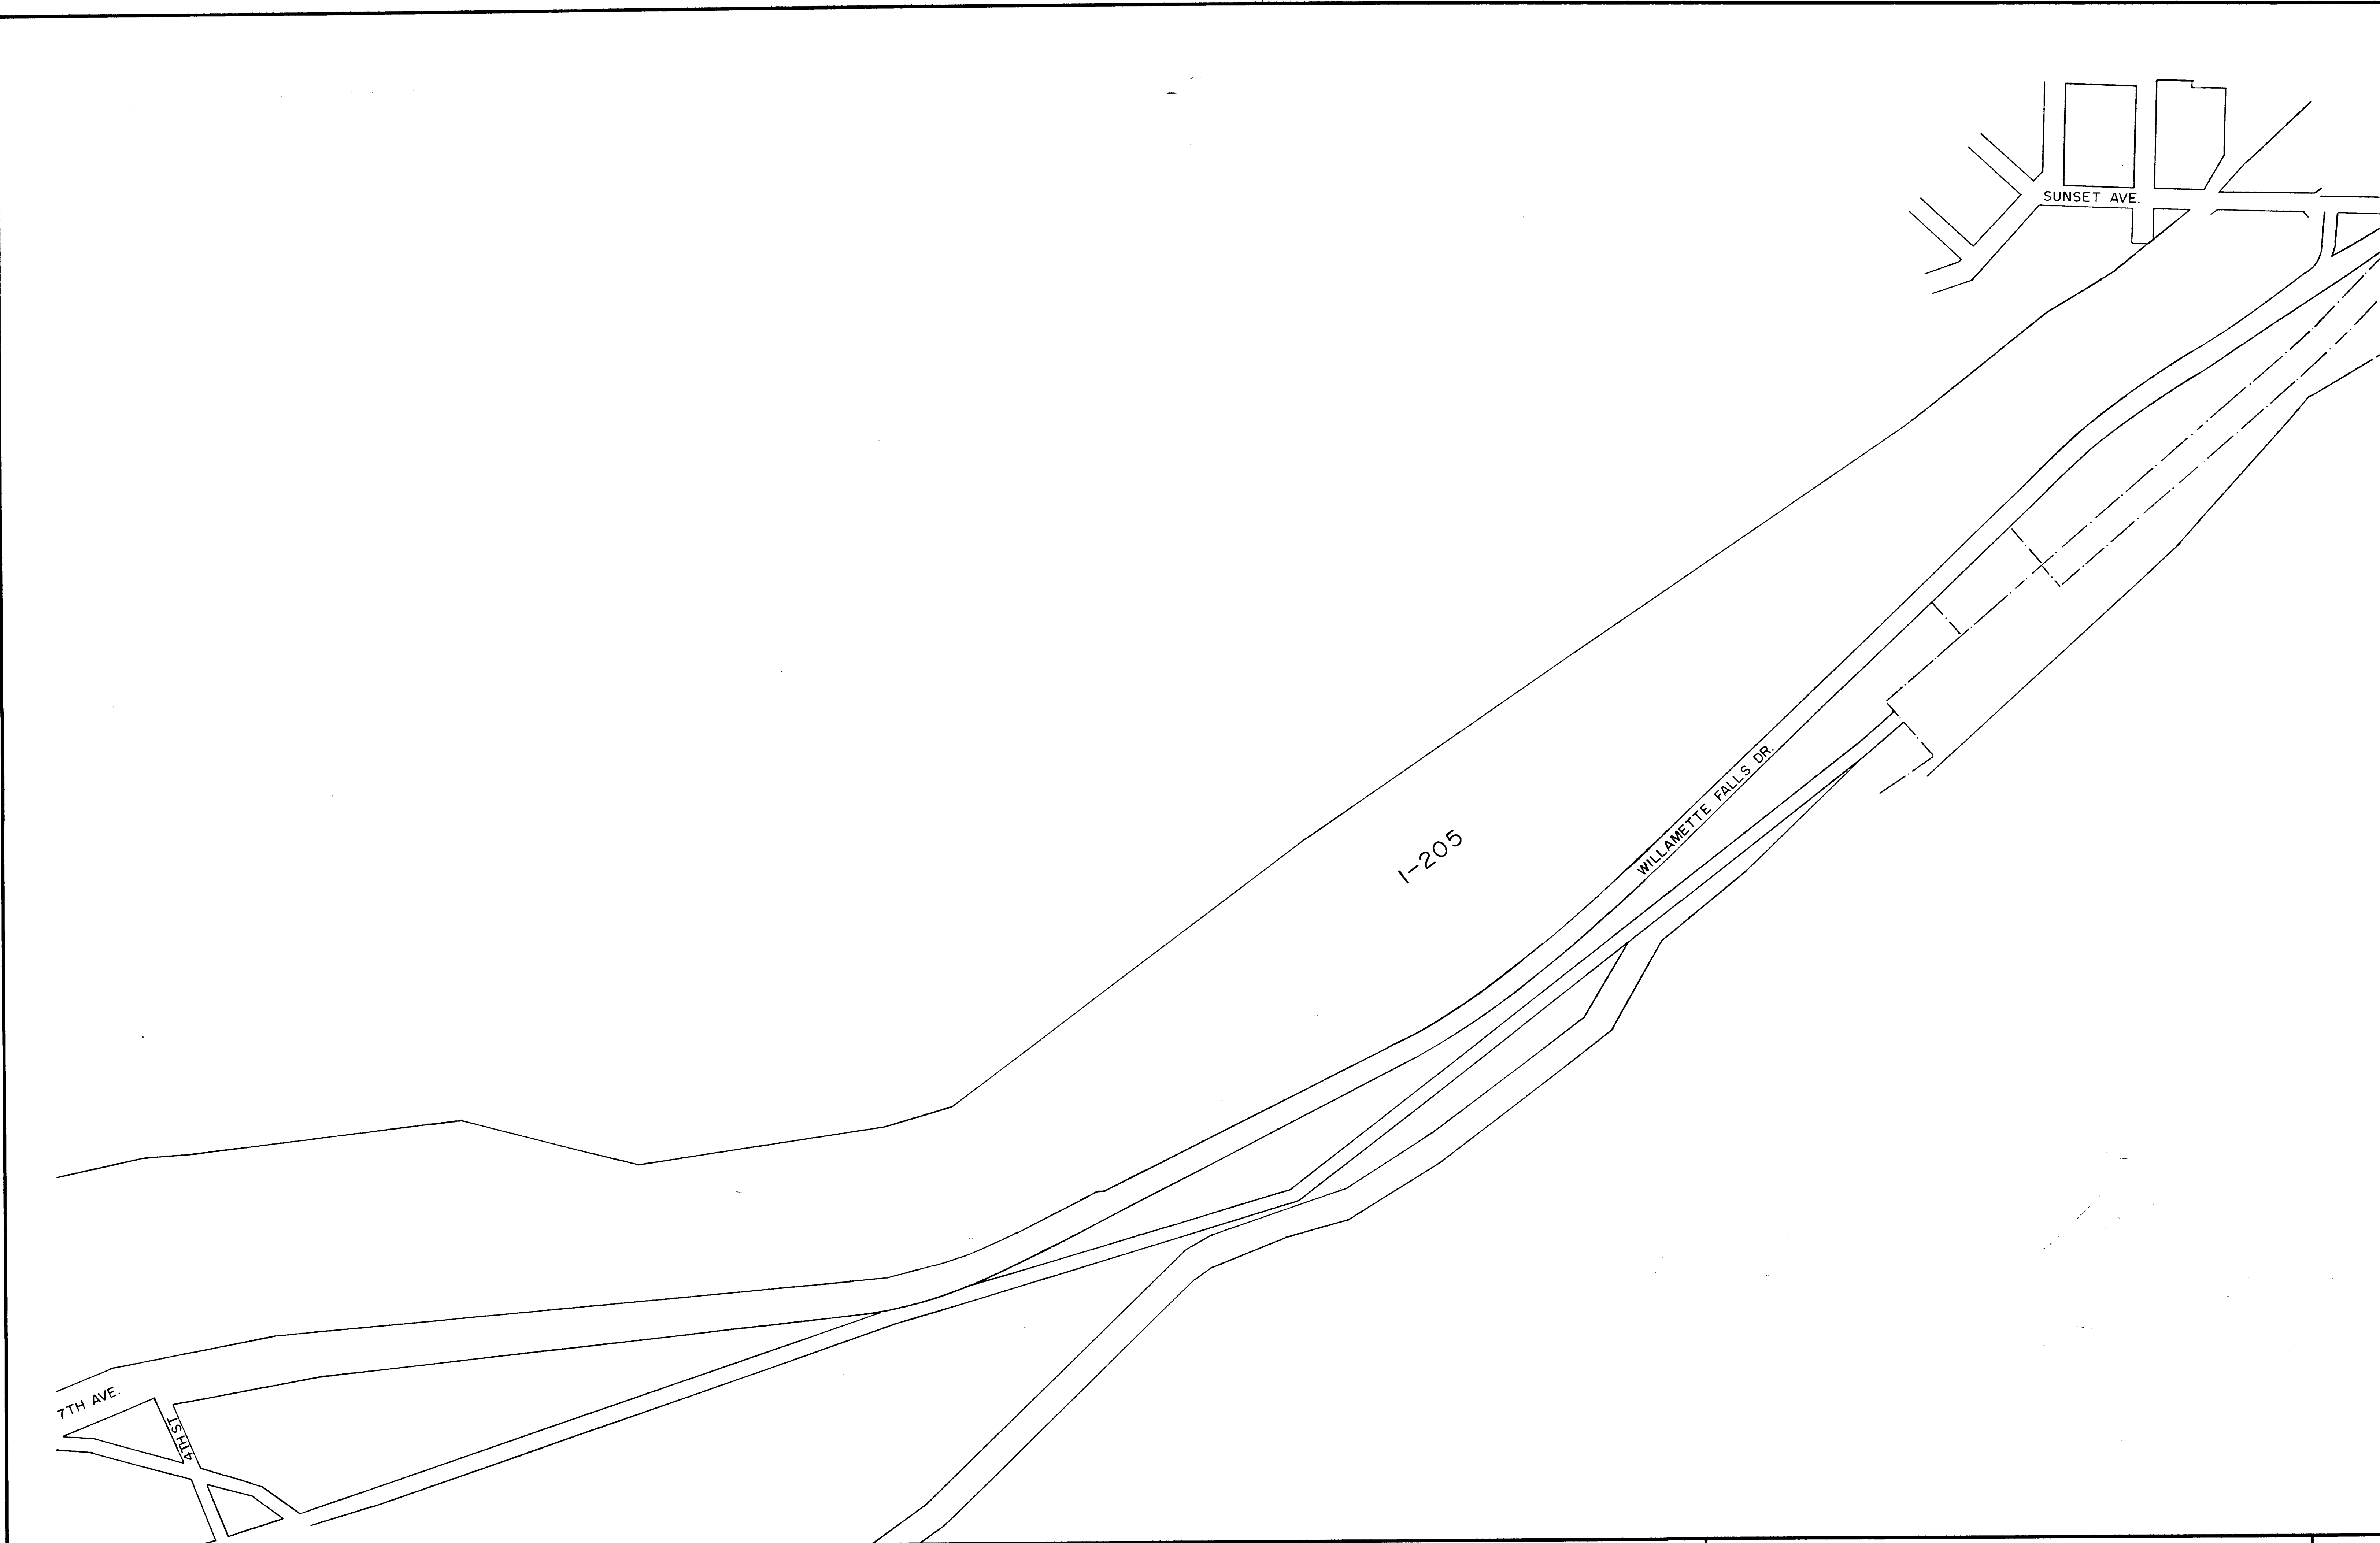

CITY OF WEST LINN
PUBLIC WORKS DEPARTMENT

WILLAMETTE FALLS DR.(6th-sunset)
STREET OVERLAY

