
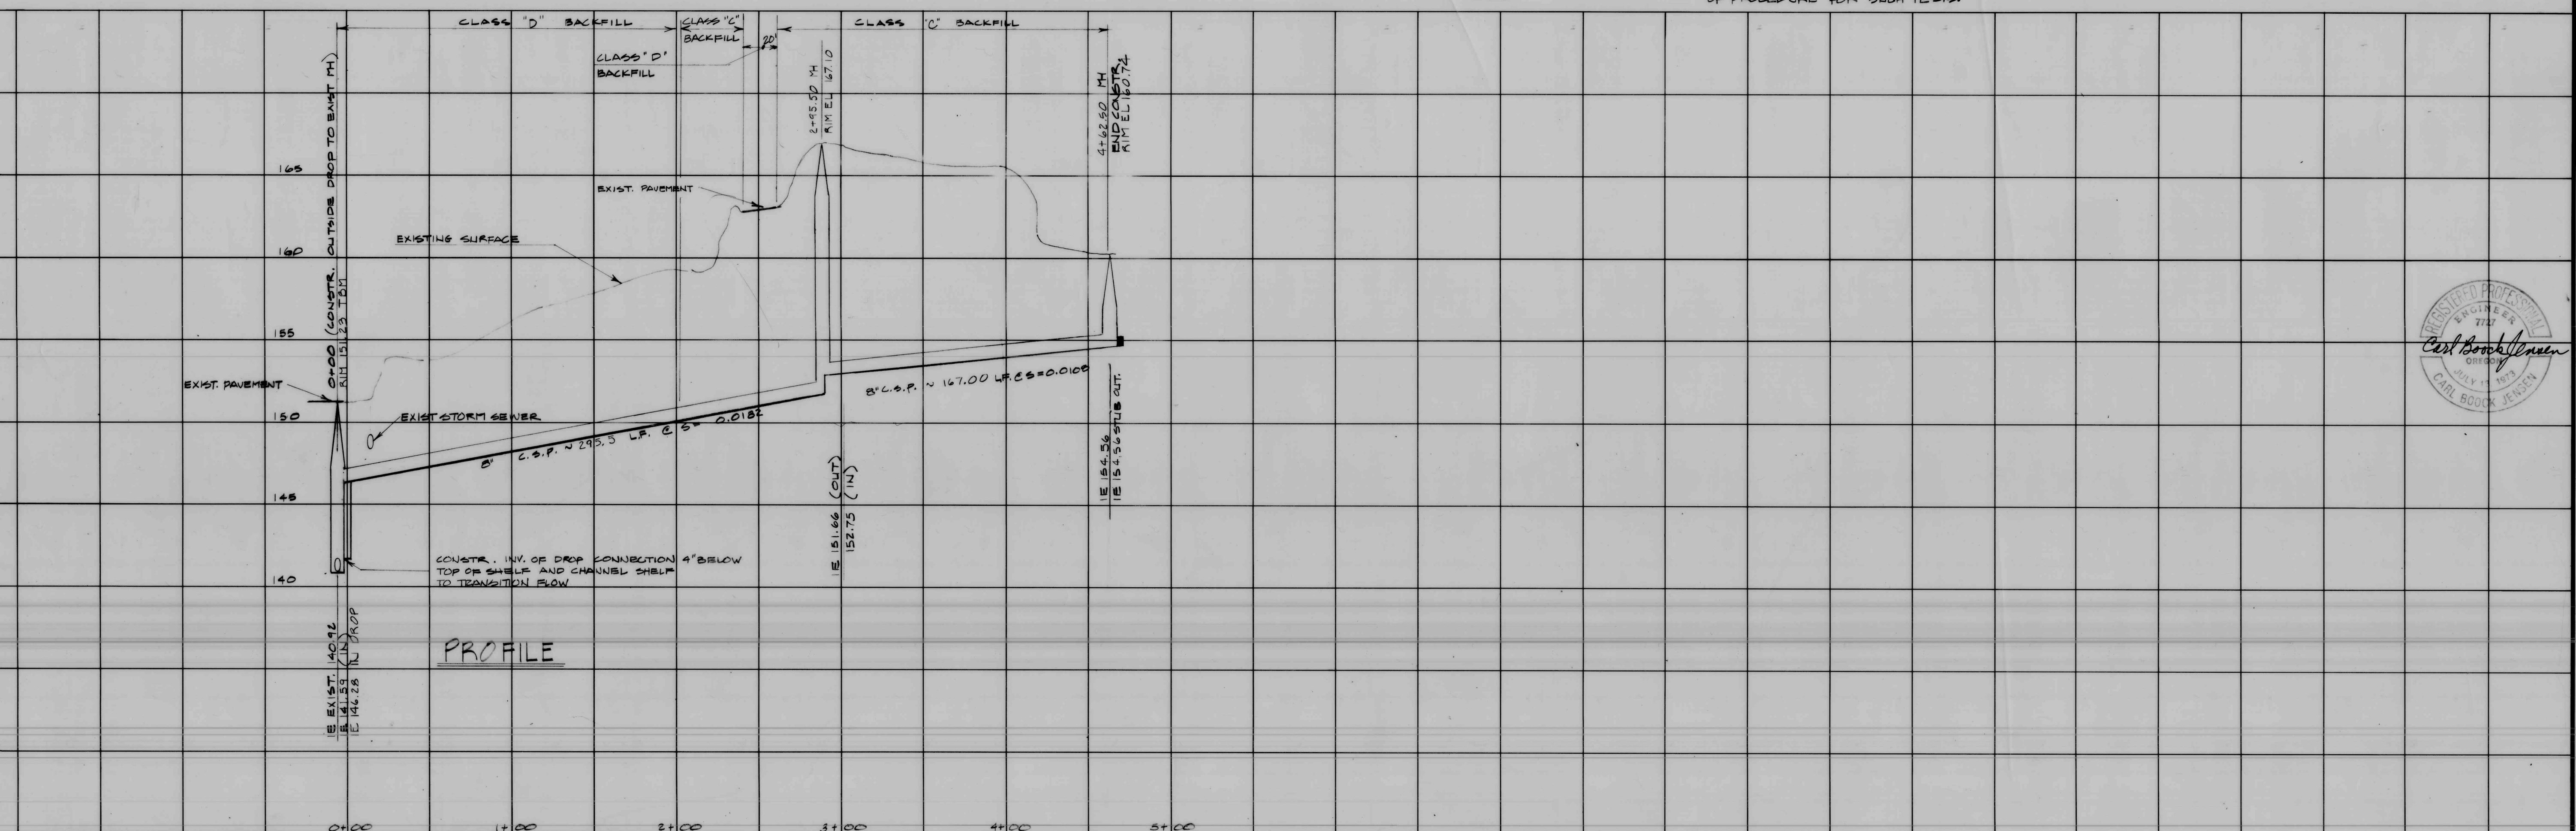


Second Scan

This As-Built was scanned twice due to illegibility issues of the original scan.

C78-1

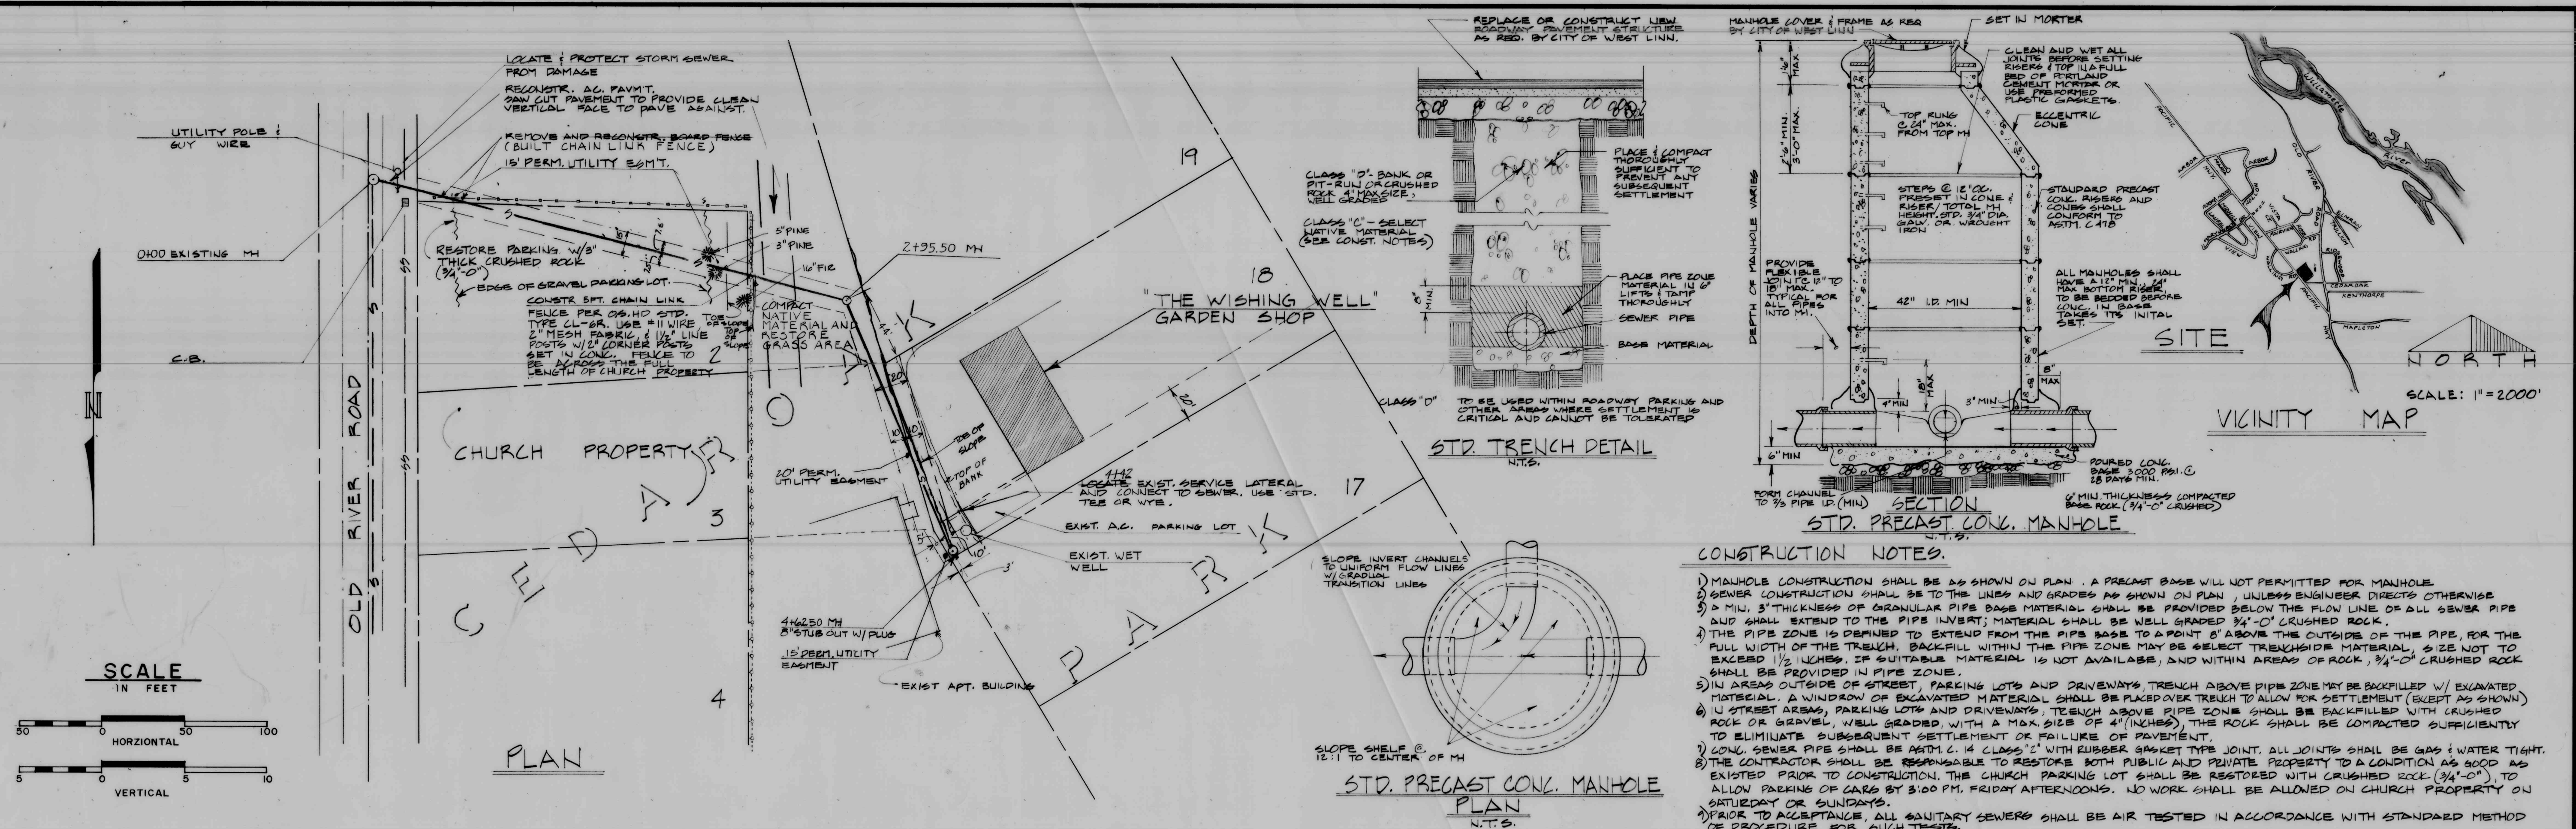

		DESIGNED: A.J.S.		CONSULTING ENGINEERS		LAND SURVEYORS		LAND PLANNERS		PREPARED FOR:		REGIS RAJOUL		SANITARY SEWER IMPROVEMENTS • PLAN & PROFILE		1
2 "AS BUILT"		1/5/78		DRAWN : S.M.B.		GARY M. BUFORD & ASSOCIATES										
1. MODIFIED GRADES, ALIGNMENT & EASEMENTS		9/24/77		DATE : OCT. '77		P.O. BOX 1531		16001 S.W. QUARRY ROAD		19080 S. PACIFIC HWY.						
NO REVISIONS		DATE		SCALE : AS SHOWN		LAKA OSWEGO, OREGON 97034		635 - 3511		WEST LINN, OREGON 97068		NE 1/4, NE 1/4, SEC. 23, T. 2S., R. 1E., W.M. WEST LINN, CLACKAMAS COUNTY, OREGON		SHEET		
																OF