



3/4" - 2" DOMESTIC & IRRIGATION DOUBLE CHECK VALVE ASSEMBLY
SCALE: N.T.S. 1 C6.8

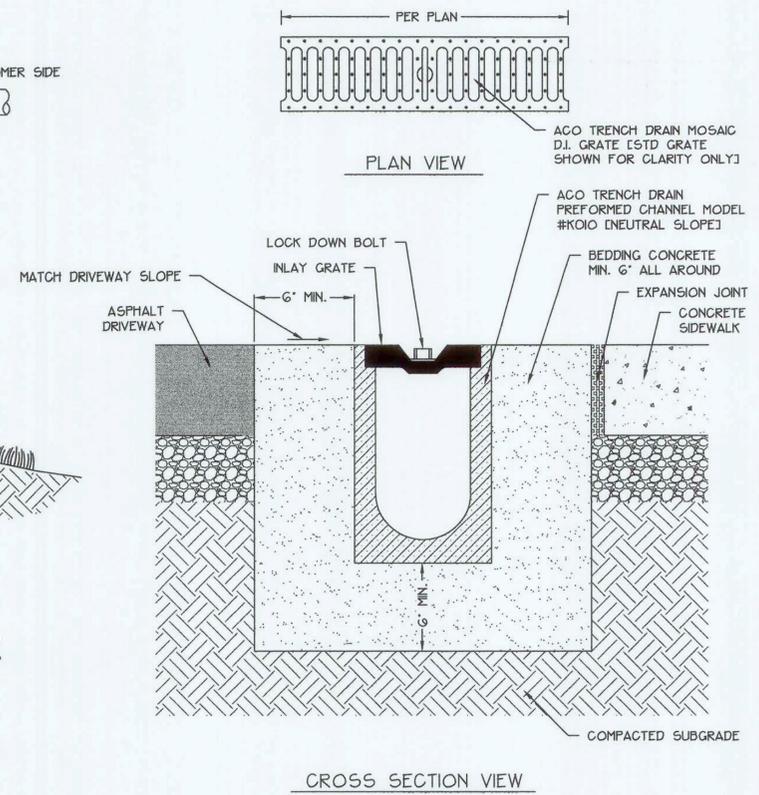



PREFORMED TRENCH DRAIN
SCALE: N.T.S. 2 C6.8

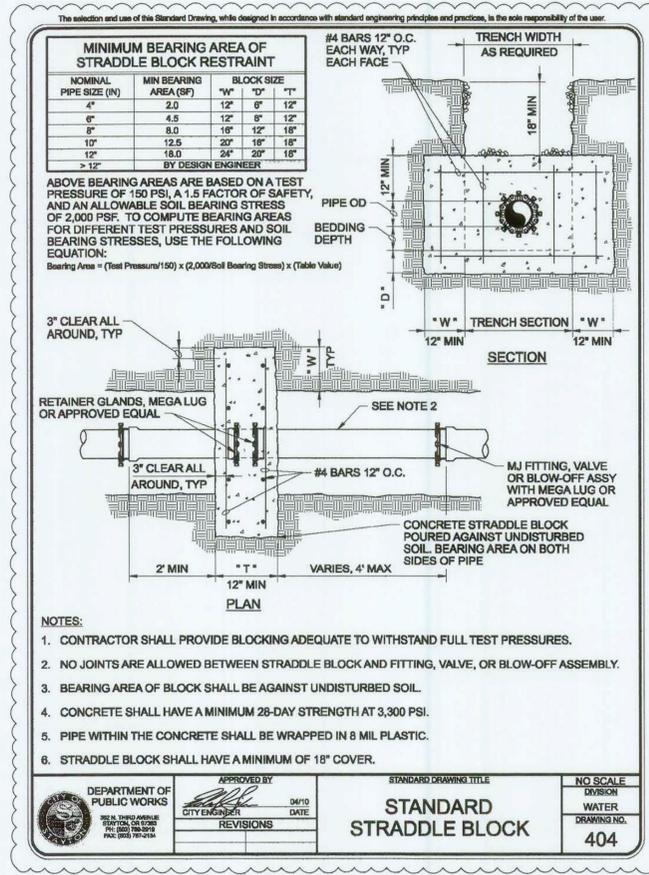

STRADDLE BLOCK
SCALE: N.T.S. 3 C6.8

NOT USED

UTILITY TRENCH RELIEF SUB-DRAIN INSTALLED AT PAVEMENT LOW POINTS
SCALE: N.T.S. 6 C6.8

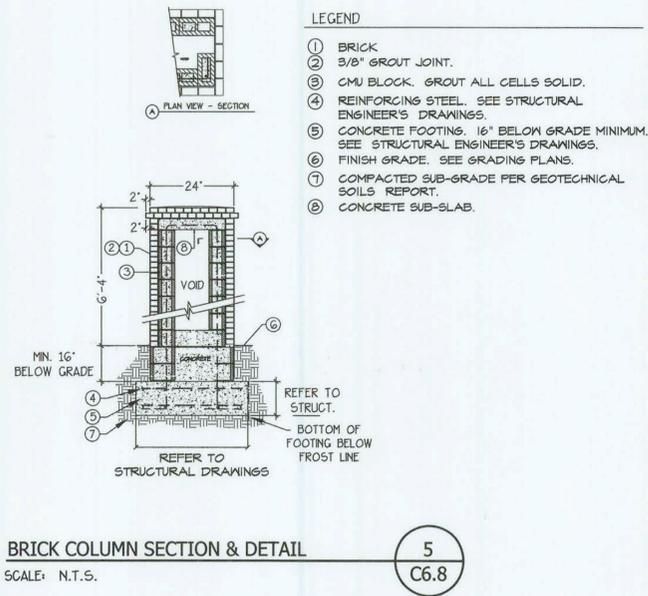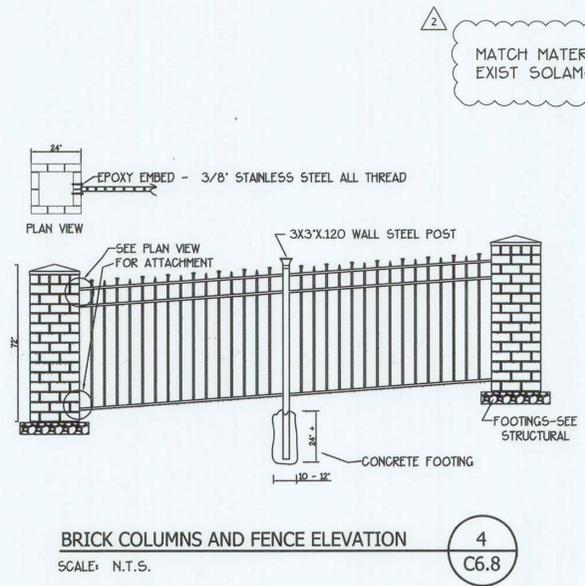

APPROVED FOR CONSTRUCTION BY
CITY OF WEST LINN
This approval is only for general conformance with the design concept and general compliance with applicable codes and requirements and shall not be construed as relieving the Design Engineer of full responsibility for accuracy and completeness of the drawings. This plan review approval does not prevent the City from requiring further code corrections.
DATE: 9-6-11 BY: K.W.C.E. ENGINEERING
DATE: 9-6-11 BY: PLANNING

DESIGN GROUP
901 N. Brutscher, Ste. 202
Newberg, Oregon 97132
Phone: 503-537-9347
www.thesaunderscompany.net

REGISTERED PROFESSIONAL ENGINEER
60644PE
OREGON
SEPT. 14, 1999
CHARLES EDWARD GREGORY
RENEWS: JUNE 30, 2013

J.T. SMITH companies

Teresa's Vineyard
Public Improvements
Sub-07-02/NDW-07-02/VAR-07-01
West Linn, Oregon

REV	DATE	SUMMARY
1	8/5/11	Client/Agency Comments
2	8/30/11	Agency Comments

Project #: 9130 Drawn: TGL

MISCELLANEOUS DETAILS

Date: April 15, 2011

C6.8