


PW0412-8TH AVE. & 10TH ST. STORMWATER PROJECT

GENERAL NOTES

1. ALL NEW IMPROVEMENTS SHALL BE IN ACCORDANCE WITH CITY OF WEST LINN PUBLIC WORKS STANDARDS, MAY 22, 2000, UNLESS NOTED OTHERWISE BY THESE PLANS OR OTHER CONTRACT DOCUMENTS.
2. BEFORE EXCAVATING FOR THIS CONTRACT, CONTRACTOR SHALL VERIFY LOCATION OF UNDERGROUND FACILITIES AND COORDINATE HIS WORK WITH THE UTILITY COMPANY REPRESENTATIVE (CALL MIN. 48 HOURS PRIOR TO EXCAVATION PER ORS 757.541 TO 757.572). THE EXISTENCE AND LOCATION OF ANY UNDERGROUND FACILITY, PIPES, OR STRUCTURES SHOWN ON THESE PLANS HAVE BEEN OBTAINED FROM AVAILABLE RECORDS AND FIELD SURVEYS AND MAY NOT REFLECT ALL EXISTING UTILITIES. THIS INFORMATION IS NOT GUARANTEED TO BE COMPLETE OR ACCURATE. LOCATIONS OF ALL EXISTING UTILITIES SHALL BE CONFIRMED BY FIELD MEASUREMENTS BY CONTRACTOR PRIOR TO CONSTRUCTION OF NEW WORK. CONTRACTOR SHALL KEEP EXISTING UTILITIES IN SERVICE AND PROTECT THEM DURING CONSTRUCTION.

UTILITY NOTIFICATION CENTER	(503) 248-5699
UTILITY ONE LOCATES	(503) 246-6699
CITY OF WEST LINN PUB. WORKS (SEWER & WATER)	(503) 656-6081
US WEST (TELEPHONE)	(800) 340-6342
NW NATURAL GAS	(800) 523-7661
PGE (ELECTRIC)	(800) 544-1793
COMCAST (CABLE TV)	(888) 824-8264

3. CONTRACTOR SHALL MAKE TIMELY EXPLORATORY EXCAVATIONS AND LOCATE MAJOR EXISTING UNDERGROUND FACILITIES AHEAD OF CONSTRUCTION. OWNER SHALL BE NOTIFIED OF ANY DISCREPANCIES BETWEEN THESE PLANS AND ACTUAL FIELD CONDITIONS AHEAD OF CONSTRUCTION TO PERMIT REVISIONS TO PLANS IF NECESSARY BECAUSE OF ACTUAL LOCATION OF EXISTING MAJOR UNDERGROUND FACILITIES.
4. HORIZONTAL LOCATION OF NEW IMPROVEMENTS SHALL BE BASED ON DIMENSIONS TO PHYSICAL FEATURES (EX. MANHOLES, EX. SEWERS, EDGE OF PAVEMENT, ETC.). DIMENSIONS REFER TO CENTER OF MANHOLE, PIPELINE, STRUCTURES OR EDGE OF PAVEMENT UNLESS NOTED OTHERWISE. LENGTH OF NEW PIPELINES IS ASSUMED TO BE CENTER OF MANHOLE/VAULT TO CENTER OF MANHOLE/VAULT MEASURED HORIZONTALLY.
5. NEITHER THE OWNER, ENGINEER, OR THEIR FIELD REPRESENTATIVES WILL ENFORCE SAFETY MEASURES OR REGULATIONS. THE CONTRACTOR SHALL DESIGN, CONSTRUCT, AND MAINTAIN ALL SAFETY DEVICES, AND SHALL BE SOLELY RESPONSIBLE FOR CONFORMING TO ALL LOCAL, STATE AND FEDERAL SAFETY AND HEALTH STANDARDS, LAWS AND REGULATIONS.
6. RIGHT-OF-WAY AND PROPERTY LINES SHOWN ARE APPROXIMATE. NO BOUNDARY SURVEYS HAVE BEEN COMPLETED.
7. PAVEMENT AND SIDEWALK RESTORATION REQUIREMENTS ARE ESTIMATED BASED ON ANTICIPATED CONSTRUCTION ACTIVITIES AND EXISTING FIELD CONDITIONS. FINAL REQUIREMENTS MAY VARY AND WILL BE DETERMINED BY THE OWNER FOLLOWING TRENCHING OPERATIONS. STRIPING, REFLECTORS AND OTHER MARKINGS THAT ARE DISTURBED WILL BE RESTORED.
8. CONTRACTOR SHALL MAINTAIN LOCAL ACCESS FOR RESIDENTS AND FOR EMERGENCY VEHICLES AT ALL TIMES. NOTICE TO AFFECTED PROPERTIES SHALL BE TIMELY AND CURRENT. COORDINATE DAILY CONSTRUCTION OPERATIONS WITH POLICE, FIRE, AMBULANCE, SCHOOL BUS, AND OTHER AFFECTED STREET USERS. FLAGGING WILL BE REQUIRED FOR LANE CLOSURES.

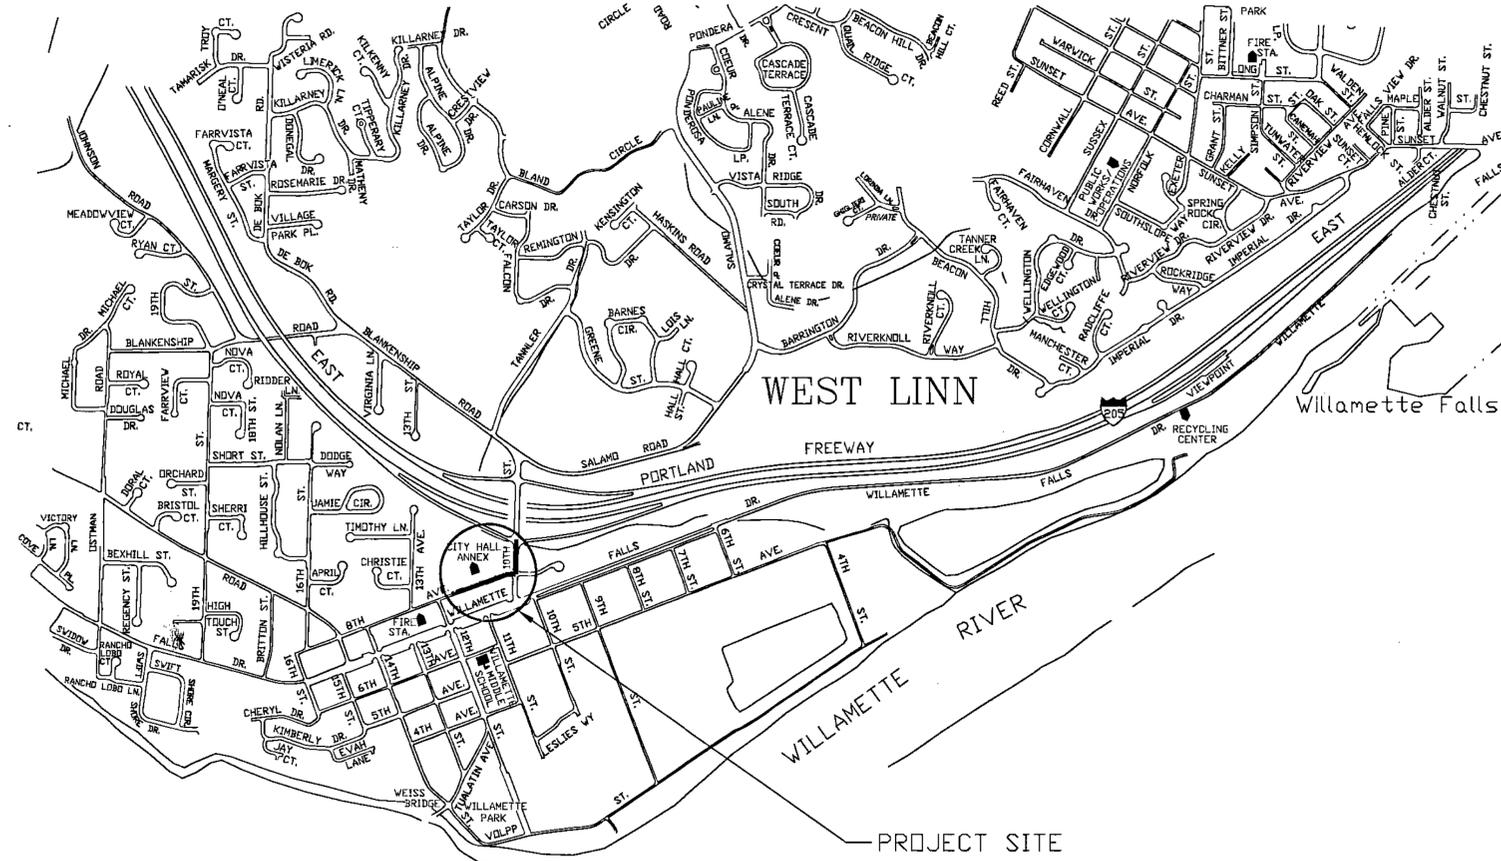


VICINITY MAP

EROSION CONTROL NOTES


1. THE IMPLEMENTATION OF EROSION CONTROL MEASURES (ECM) IS REQUIRED BY THE CONTRACTOR. INSTALLATION, MAINTAINANCE, REPLACEMENT, AND UPGRADING OF ECM IS THE RESPONSIBILITY OF THE CONTRACTOR PRIOR TO CONSTRUCTION ACTIVITIES THAT DISTURB SURFACES AND CONTINUING UNTIL ALL CONSTRUCTION IS COMPLETED AND APPROVED BY THE OWNER AND VEGETATION / PAVING IS RE-ESTABLISHED.
2. THE ECM SHOWN ON THESE PLANS MUST BE INSTALLED, MAINTAINED, REPLACED, AND UPGRADED IN SUCH A MANNER TO INSURE THAT SEDIMENT-LADEN WATER DOES NOT ENTER THE DRAINAGE SYSTEM, STREAMS, CREEKS, ROADWAYS AND PRIVATE PROPERTY.
3. THE ECM SHOWN ON THESE PLANS ARE MINIMUM REQUIREMENTS FOR ANTICIPATED SITE CONDITIONS. THE CONTRACTOR SHALL ADAPT AND UPGRADE THE ECM BASED ON HIS CONSTRUCTION, OPERATION AND WEATHER CONDITIONS.
4. THE ECM SHALL BE INSPECTED DAILY BY THE CONTRACTOR AND MAINTAINED OR UPGRADED AS NEEDED TO INSURE THAT SEDIMENT-LADEN WATER IS INTERCEPTED AND CONTROLLED IN ACCORDANCE WITH LOCAL, STATE, AND FEDERAL REQUIREMENTS.
5. ECM SHALL BE REMOVED FROM THE PROJECT AREA BY THE CONTRACTOR AFTER PAVING AND VEGETATION IS RE-ESTABLISHED.
6. EROSION PREVENTION AND SEDIMENT CONTROL, PLANNING AND DESIGN MANUAL, DECEMBER 2000, BY CITY OF WEST LINN, WATER ENVIRONMENT SERVICES AND UNIFIED SEWERAGE AGENCY (NOW CLEAN WATER SERVICES) IS REFERENCED STANDARD FOR EROSION CONTROL REQUIREMENTS FOR THIS PROJECT. STANDARD DETAIL DRAWINGS FROM THIS MANUAL ARE INCLUDED IN THIS PLAN SET FOR REFERENCE.

REVISION	DATE	PW0412 8th Ave/10th St. STORM IMPROV. PROJECT VICINITY MAP	
DRAWN: JF			
CHECKED:		SCALE: NTS	SHEET: 1/5







PW0412-8TH AVE. & 10TH ST. STORMWATER PROJECT

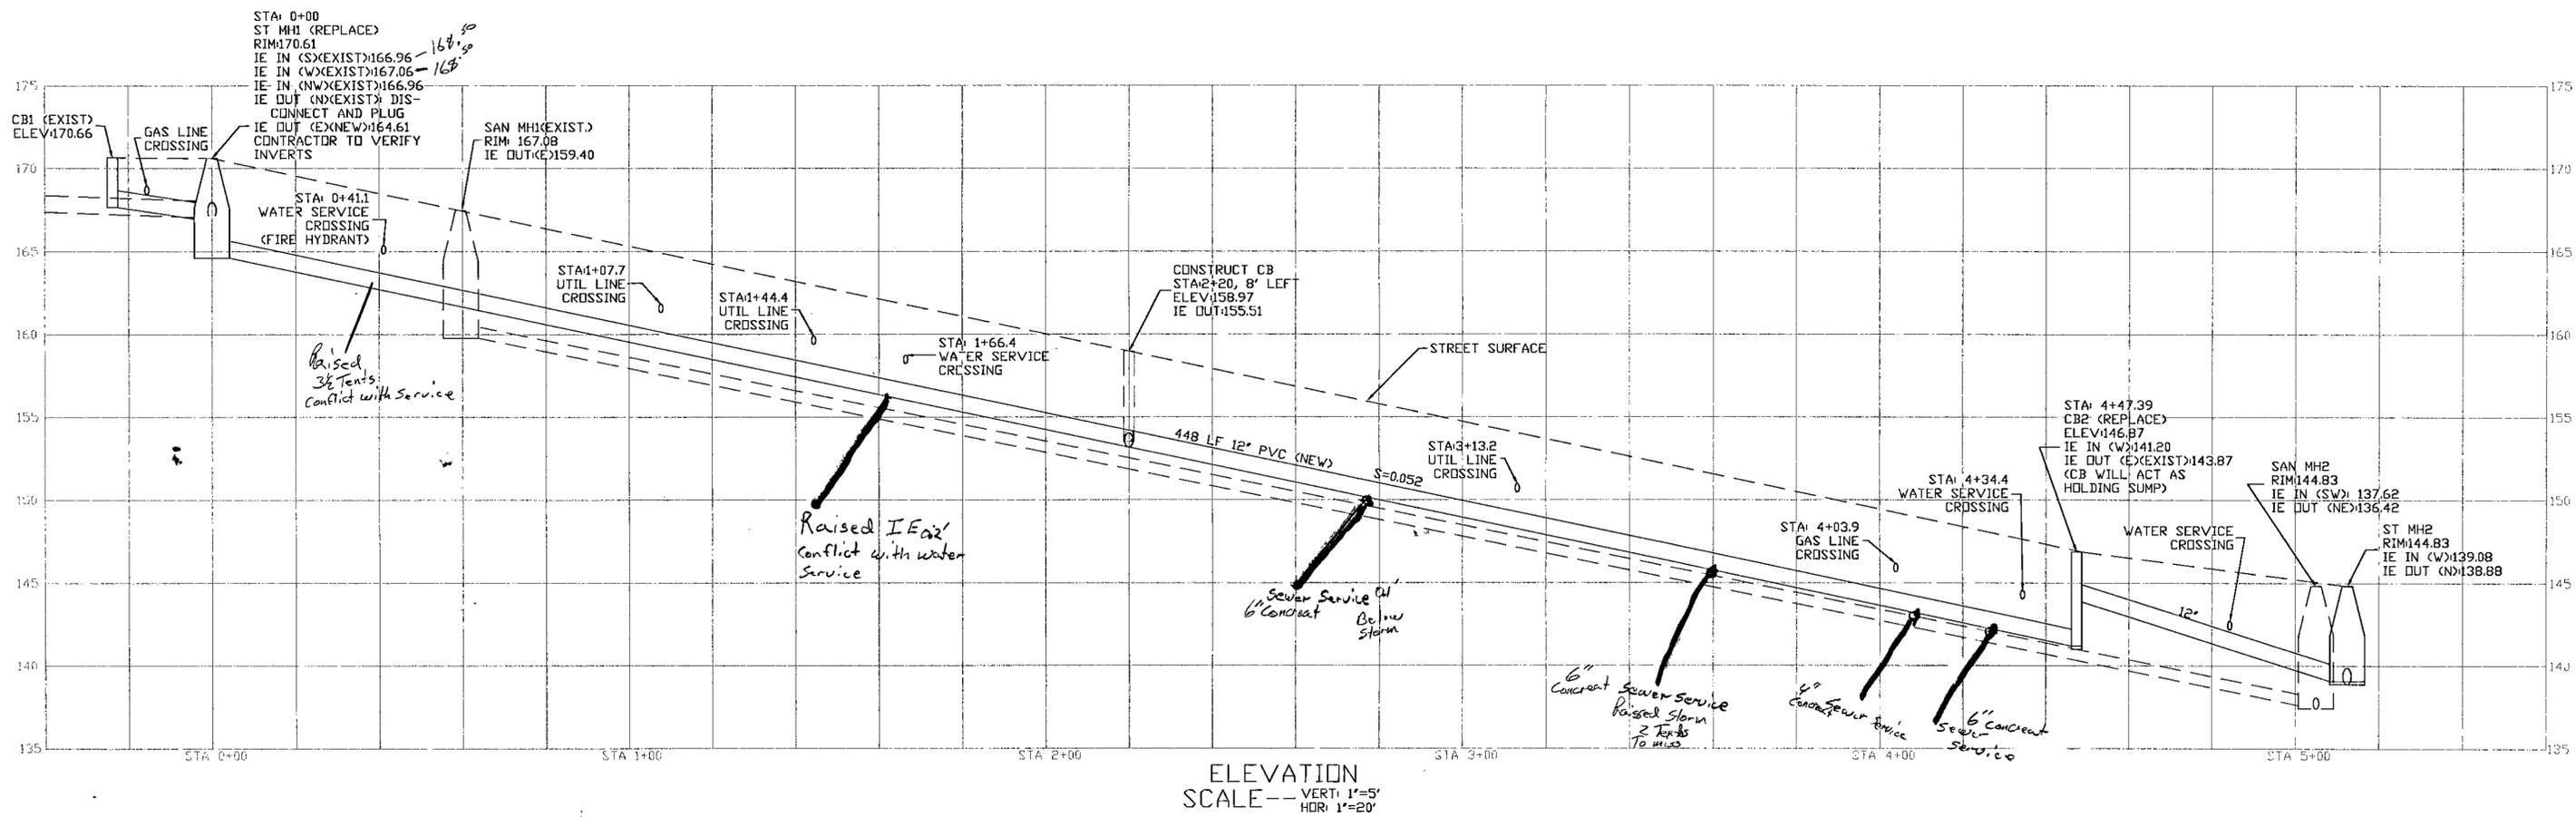

REVISION	DATE	PW0412 8th Ave/10TH St. STORM IMPROV. PROJECT ELEVATION
DRAWN: JF		SCALE: VERT 1"=5', HOR 1"=20' SHEET: 3/5
CHECKED:		

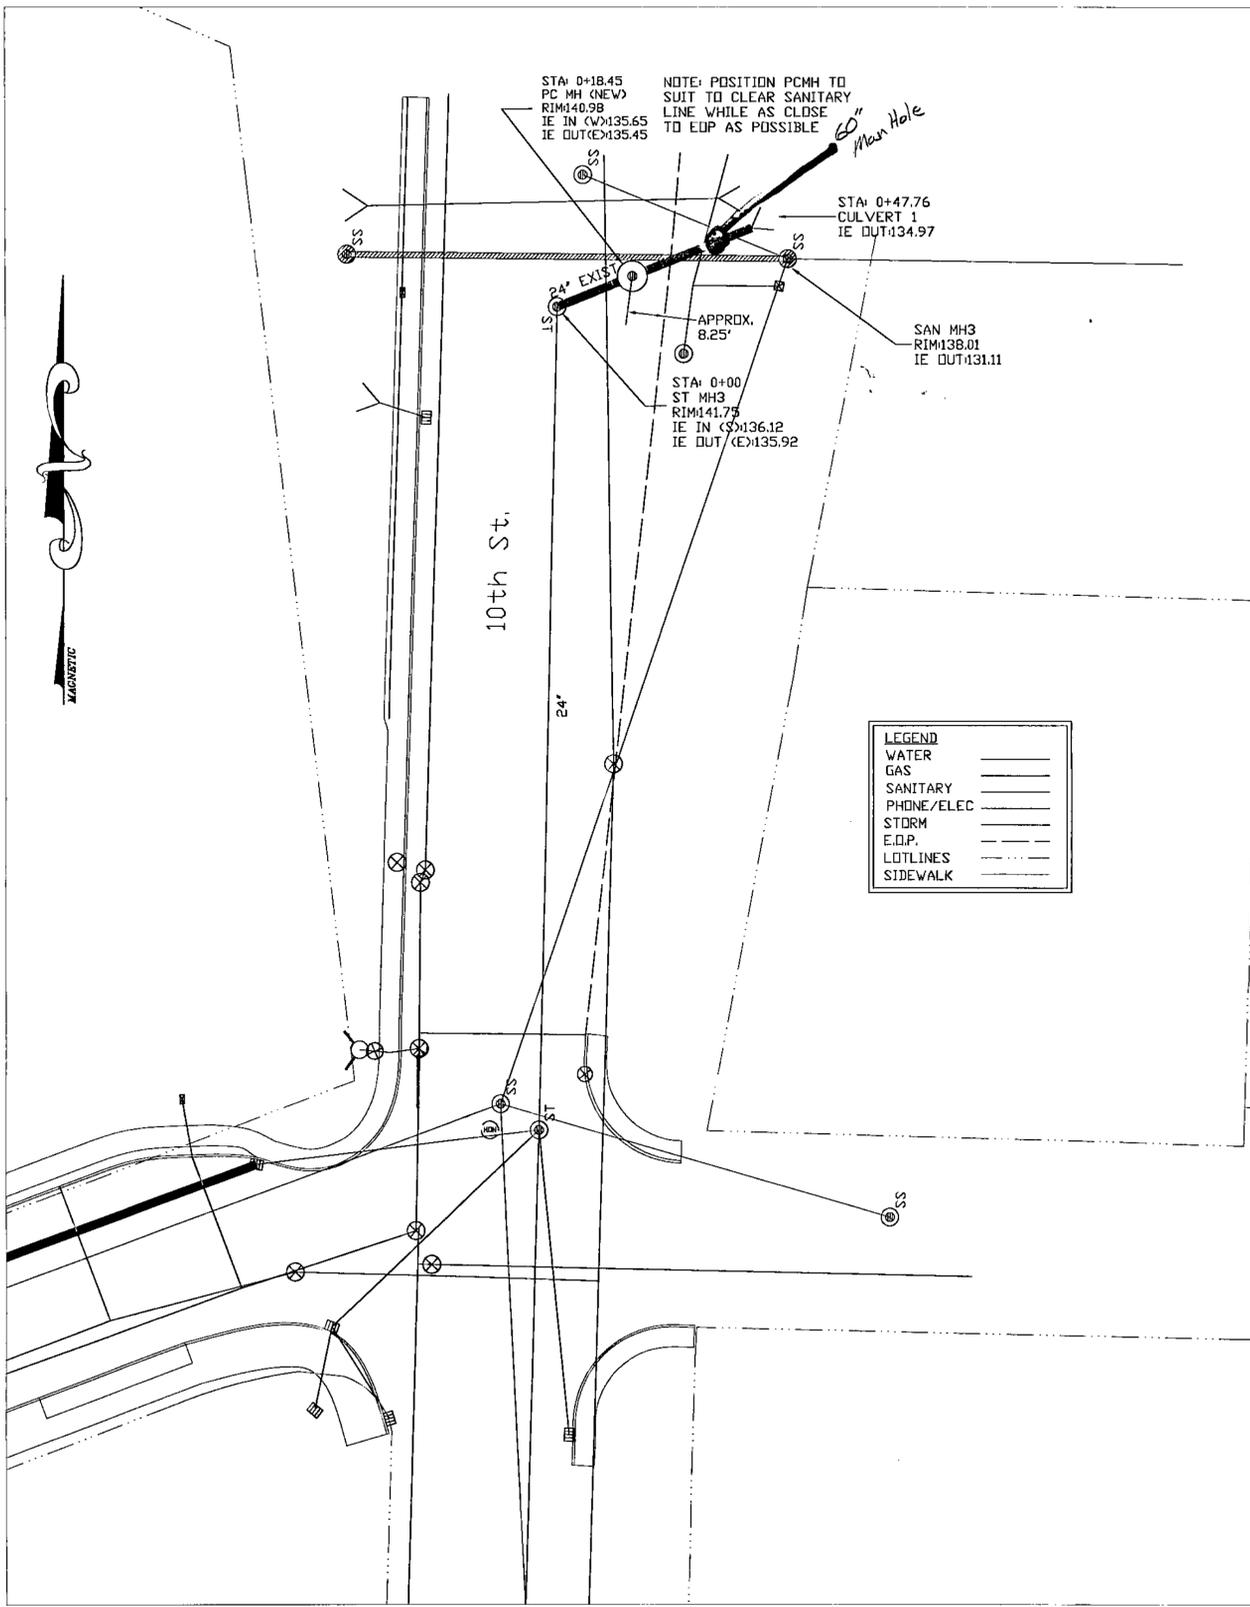

REVISION	DATE	PW0412 8th Ave/10TH St. STORM IMPROV. PROJECT PLAN VIEW
DRAWN: JF		SCALE: 1"=20'
CHECKED:		
		SHEET: 4/5

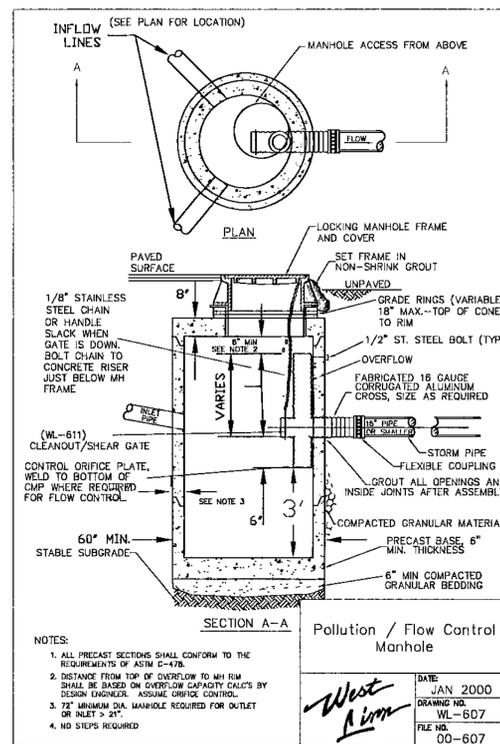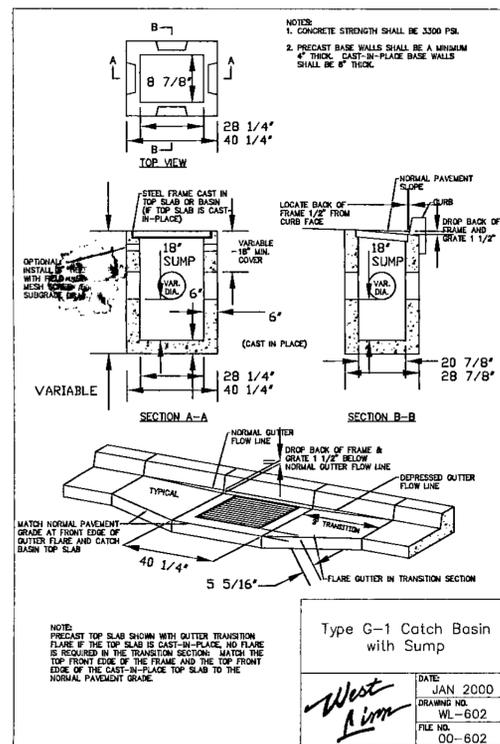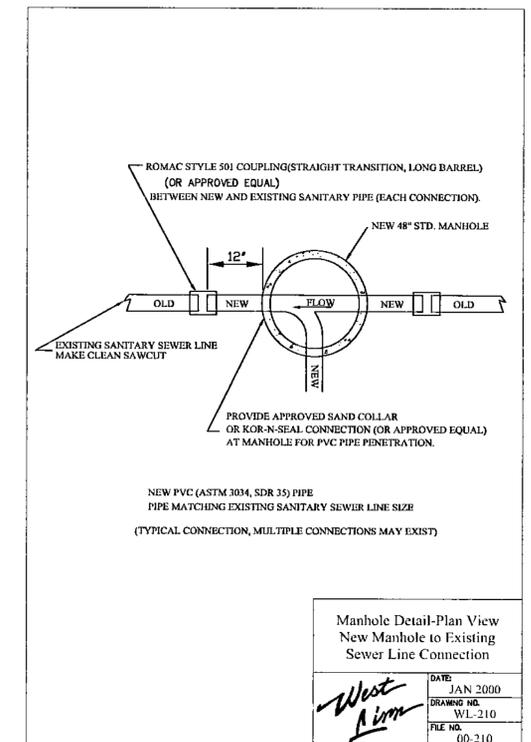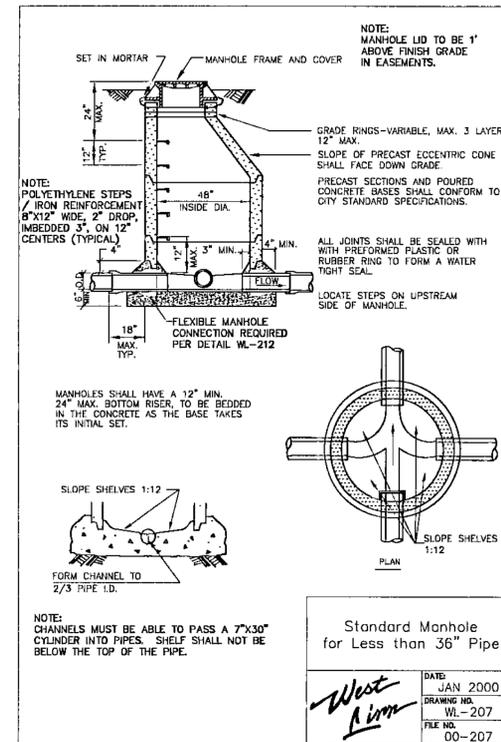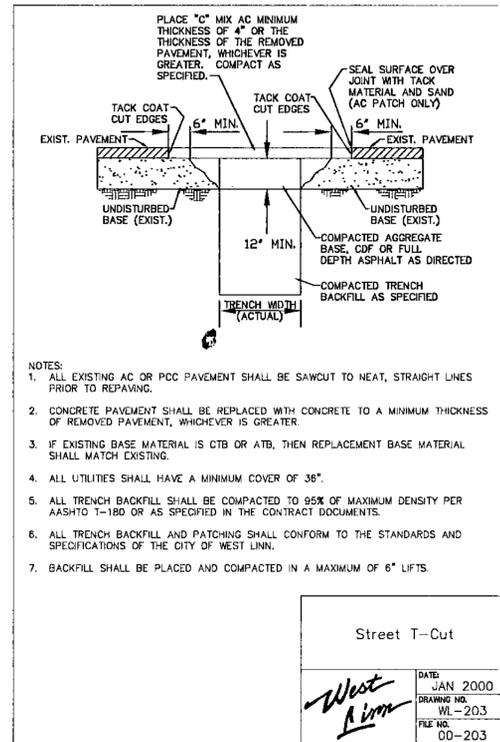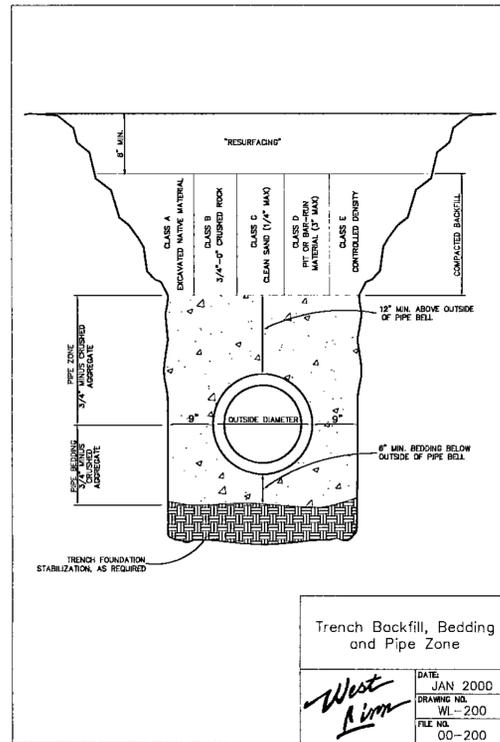

REVISION	DATE

PW0412 8th Ave/10TH St.
STORM IMPROV. PROJECT
DETAILS

DRAWN: JF
CHECKED: SCALE: NTS SHEET: 5/5