


- CONSTRUCTION NOTES:
1. Explore ahead of work to determine the exact location of underground utilities or other features which might interfere with construction. When utilities or other features are encountered, support and/or protect these items during construction so as to not interrupt service. Arrange with utility companies for moving or maintaining their respective services as required.
  2. Observe and comply at all times with all federal, state and local laws, ordinances and regulations in any manner affecting the conduct or safety of the work.
  3. All materials and construction shall conform with applicable parts of the Oregon Chapter of APWA 1980 Standard Specifications and Drawings for Public Works Construction.
  4. Sewer Pipe: ASTM 2034 PVC pipe.
  5. Manhole: per APWA Drawing No. 16.
  6. Air test new sewer pipe. Note that air test must be made prior to reconnection of existing service lateral to tax lot 2900.
  7. When and if actual conditions differ from those shown on the plans, notify engineer prior to proceeding with construction.
  8. Contact utility companies for locates prior to construction.
  9. Elevation datum is assumed, and project benchmark is top of 6/8 inch iron rod located 15 feet westerly and 5 feet southerly from proposed manhole at Station 1+16. Top of iron rod elevation is 170.74.
  10. Coordinate with owner and/or residents of tax lot 2900 regarding interruption of sewer service.

Proposed Temporary Construction Easement for Utilities

A portion of that parcel of land in the SE 1/4 of the NE 1/4 of Section 25, T2S, R1E, W.M., Clackamas County, Oregon, conveyed to Dell S. Farleigh and Lois Mae Farleigh as described and recorded in Book 417, Page 341, deed records of said Clackamas County, more particularly described as follows:

The westerly 80 feet of the southerly 25 feet of the northerly 100 feet of tract 27, Moody Investment Company's plat of HOLLY GARDENS ADDITION TO THE CITY OF WEST LINN.

**PLAN**  
1" = 20'

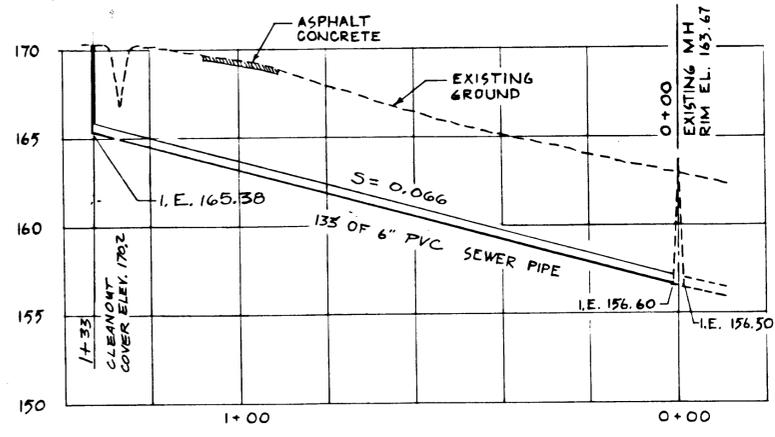

**PROFILE**  
VERT. 1" = 5'  
HORIZ. 1" = 20'

DATE	NO.	REVISION	BY	DES.	FILE NO.
6-17-87	1	Drawing of Record	P.M.D.	P. McD	743.02
			CH.	F Z	SCALE: AS SHOWN
				P. McD	DATE: AUG. 85

PROJECT: **BOLTON PLAZA PROJECT**  
**WEST LINN, OREGON**

SHEET TITLE: **SANITARY SEWER EXTENSION**  
**PLAN AND PROFILE**

**LEE ENGINEERING, INC.**  
CONSULTING ENGINEERS/PLANNERS

REGISTERED PROFESSIONAL ENGINEER  
8345  
LEE ENGINEERING, INC.  
PATRICK R. MCCOY

FILE NO. **743.02**  
SHEET NO. **1** / **1**