


PLAN VIEW
SCALE: 1" = 30'

- GENERAL PROJECT NOTES:**
- All construction to meet provisions of the 1990 APWA Oregon Chapter Standard Specifications, the City of West Linn Construction Standards and Capital Improvement Project Special Specifications and any permit conditions.
 - The Contractor shall provide erosion & sediment control on the site meeting the City of West Linn Standards and all areas disturbed shall be seeded with grass seed.
 - Traffic control shall meet provisions of the Manual on Uniform Traffic Control Devices and is the Contractor's responsibility.
 - The Contractor shall notify the City of West Linn Emergency Services (655-6214) & the Public Works Department (656-6081) of any disruption to water service or street closures.
 - The contractor is responsible to obtain utility locates prior to construction.
 - Work hours are restricted to 8:00 am to 6:00 pm Monday through Friday.
 - Remove Exist and salvage to homeowner tree's & landscaping within construction limits. Avoid destruction of tree's & vegetation wherever possible.
 - No Boundary Survey has been completed of the project area. Property Lines as shown are approximate only.
 - Utility line locations as shown are approximate, field verify before construction.

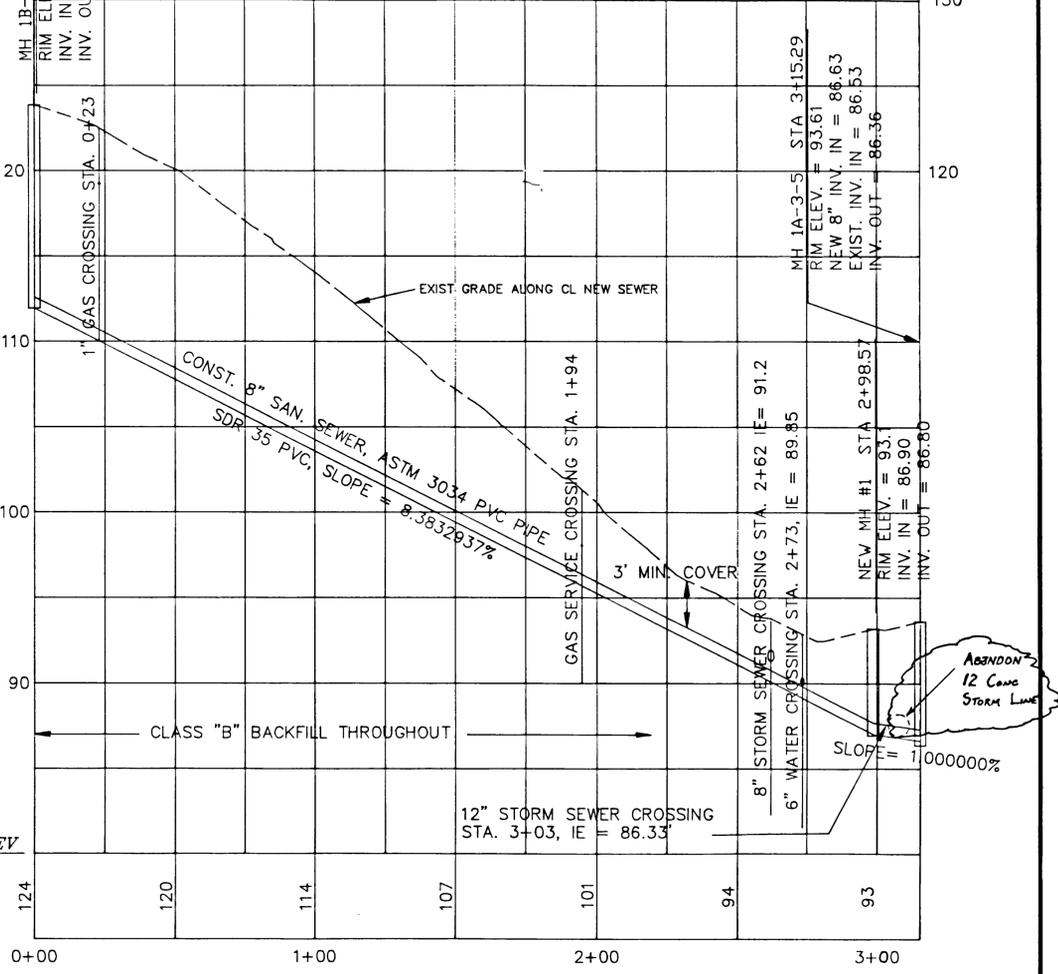

DATUM ELEV
80.00

PROFILE VIEW
H: 1" = 30'
V: 1" = 5'

As-Built
5-24-94

DATE	NO.	REVISION

DRAWN BY: K.G./K.K.
FILE: CI-92-09 DATE: 6-3-93
SCALE: AS NOTED

CITY OF WEST LINN
ENGINEERING DEPARTMENT

BURNS ST. SANITARY SEWER IMPROVEMENT
CI-92-09

SURVEYED BY: W.L. ENGINEERING DEPT.
CHECKED BY: STAFF
DESIGNED BY: K.GARLINGHOUSE, PE

PROJECT NO. CI-92-09
DRAWING FILE: CI9209\9209P01A



