


AS-BUILT
JANUARY 22, 1997

THESE AS-BUILT DRAWINGS HAVE BEEN PREPARED, IN PART, ON THE BASIS OF INFORMATION COMPILED AND FURNISHED BY THE CONTRACTOR AND OTHERS. THE ENGINEER CERTIFIES THAT THESE PLANS REPRESENT ACTUAL IMPROVEMENTS CONSTRUCTED AND THAT THESE IMPROVEMENTS ARE IN ACCORDANCE WITH GOVERNING JURISDICTIONAL STANDARDS.

W R G
D E S I G N I N G

10450 SW Nimbus Ave., Portland, Oregon 97223
503 | 603-9933 FAX: 503 | 603-9944
PLANNERS • ENGINEERS • LANDSCAPE ARCHITECTS • SURVEYORS

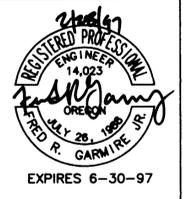

SAN. PLAN/PROFILE (STA 1+00 TO 6+00)
CASCADE SUMMIT PHASE IV OFF SITE SEWER

WEST LINN, OREGON
KOSS-BROD-GOODRICH AND ASSOCIATES, 22596 DAY RD., WEST LINN, OR 97066


| REV. | DATE | BY |
|------|------|----|
| | | |
| | | |
PROJECT NO.
KBG002.3


DATE 1/22/97
DESIGNED S. ROPER
ENGINEER F. GARMIRE
CHECKED

SHEET TITLE
SANITARY

SHEET NUMBER
C2

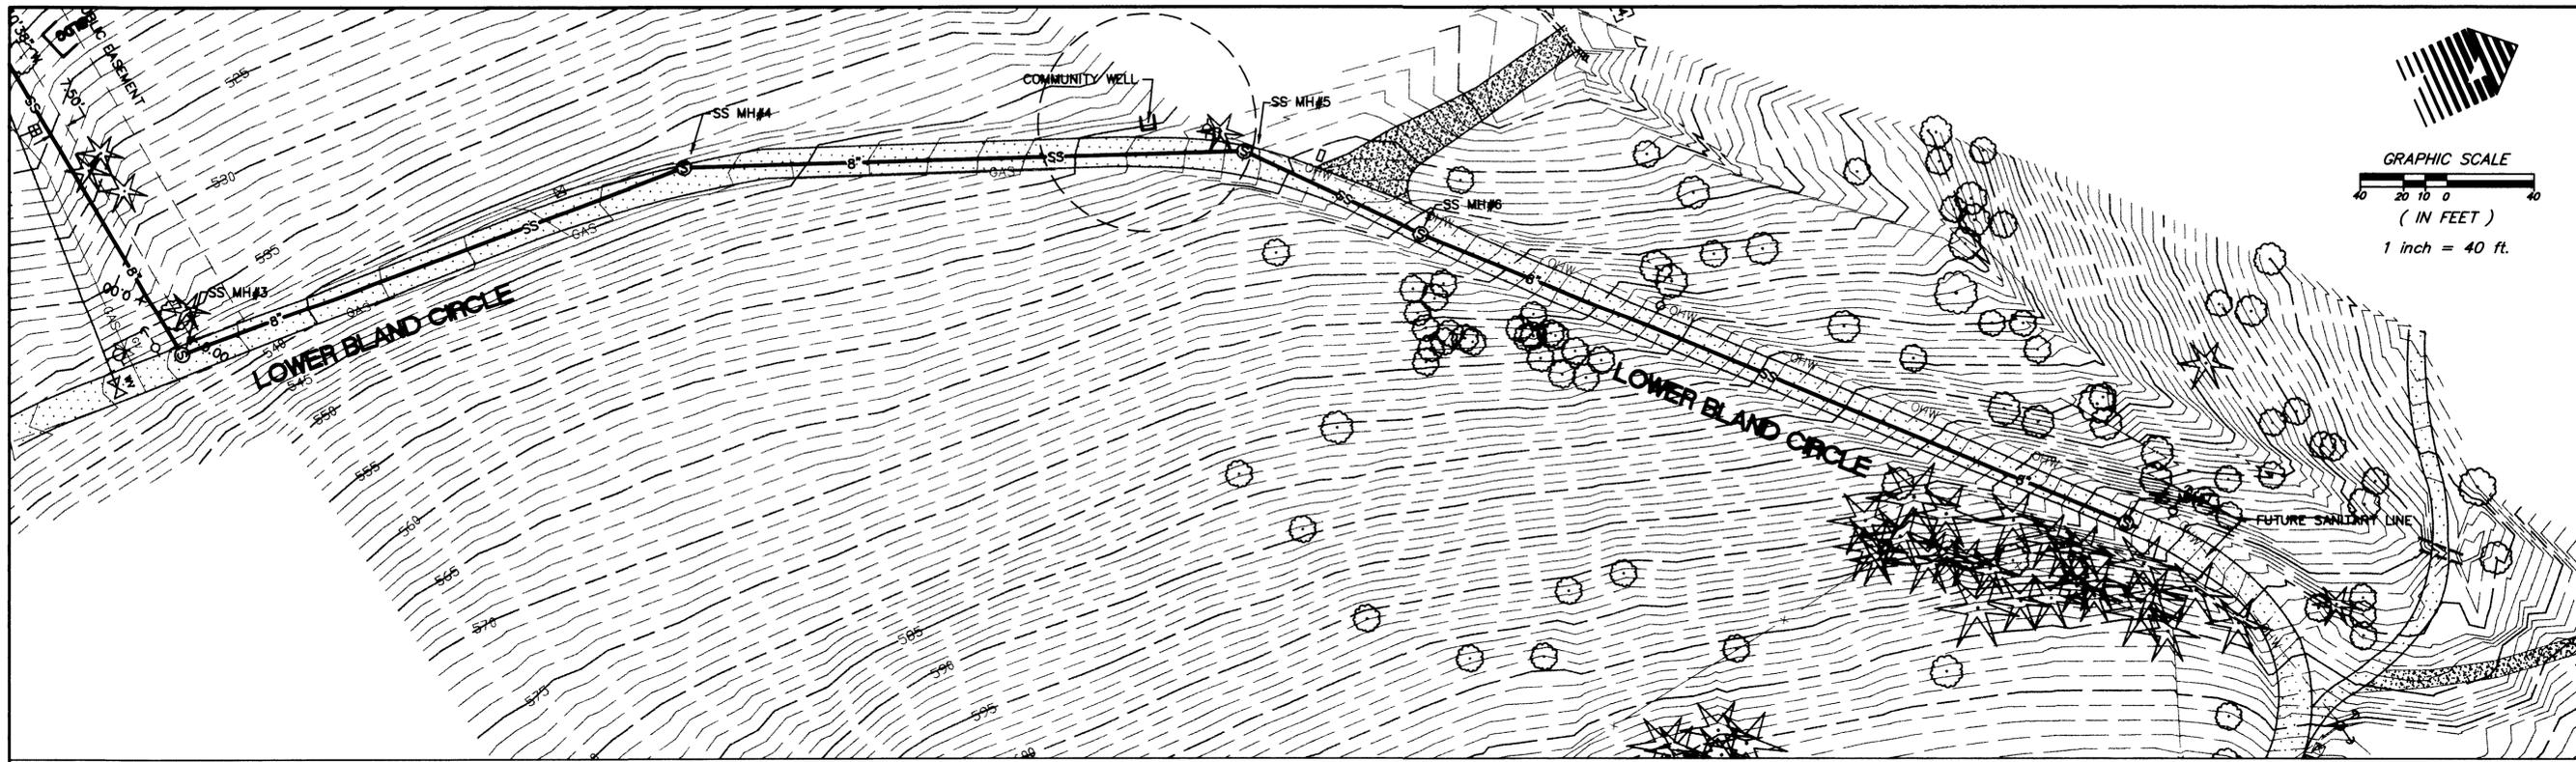


W R G
 DESIGN INC.
 10450 SW Nimbus Ave., Portland, Oregon 97223
 503.603.9933 FAX: 503.603.9944
 PLANNERS • ENGINEERS • LANDSCAPE ARCHITECTS • SURVEYORS

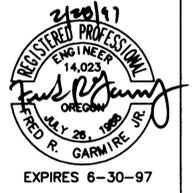

SAN PLAN/PROFILE (STA 6+00 TO 15+27.25)
CASCADE SUMMIT PHASE IV OFF SITE SEWER
 WEST LINN, OREGON

KOSS-BROD-GOODRICH AND ASSOCIATES, 22596 DAY RD., WEST LINN, OR 97066

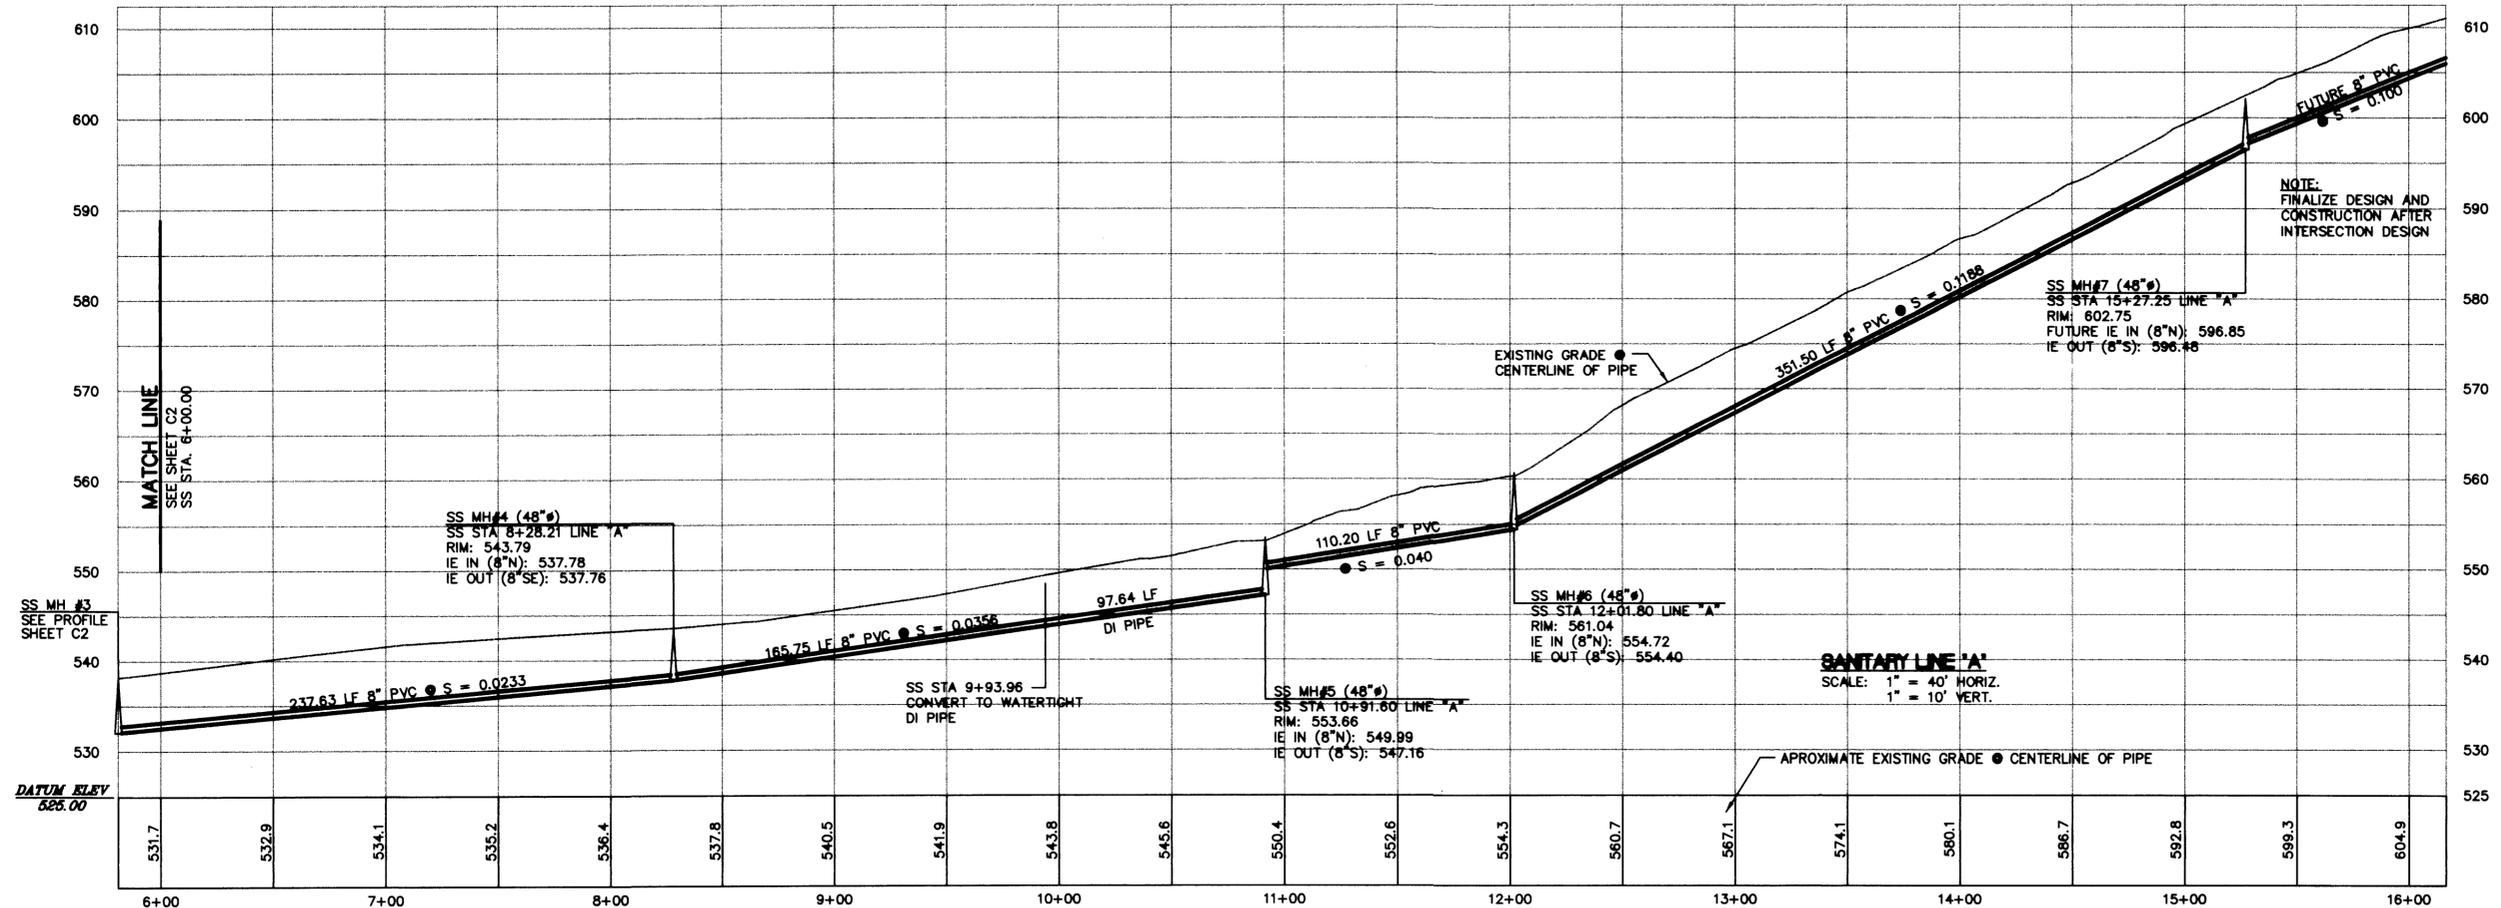

MATCH LINE
 SEE SHEET C2
 SS STA. 6+00.00

SS MH #3
 SEE PROFILE
 SHEET C2

DATUM ELEV
 525.00

AS-BUILT
 JANUARY 22, 1997


THESE AS-BUILT DRAWINGS HAVE BEEN PREPARED, IN PART, ON THE BASIS OF INFORMATION COMPILED AND FURNISHED BY THE CONTRACTOR AND OTHERS. THE ENGINEER CERTIFIES THAT THESE PLANS REPRESENT ACTUAL IMPROVEMENTS CONSTRUCTED AND THAT THESE IMPROVEMENTS ARE IN ACCORDANCE WITH GOVERNING JURISDICTIONAL STANDARDS.

| REV. | DATE | BY |
|------|------|----|
| | | |
| | | |
PROJECT NO.
KBG0023
 DATE 1/22/97
 DESIGNED S. ROPER
 ENGINEER F. GARMIRE
 CHECKED

SHEET TITLE
SANITARY
 SHEET NUMBER




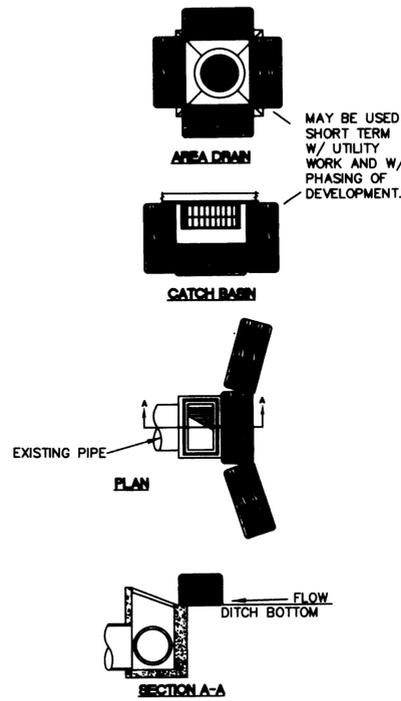


INLET SEDIMENT BARRIER
SCALE: NTS

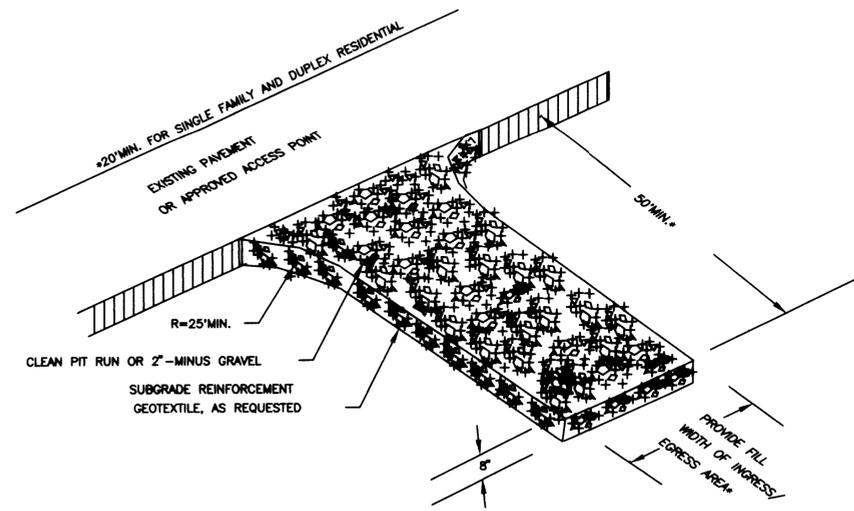

GRAVEL ENTRANCE
SCALE: NTS

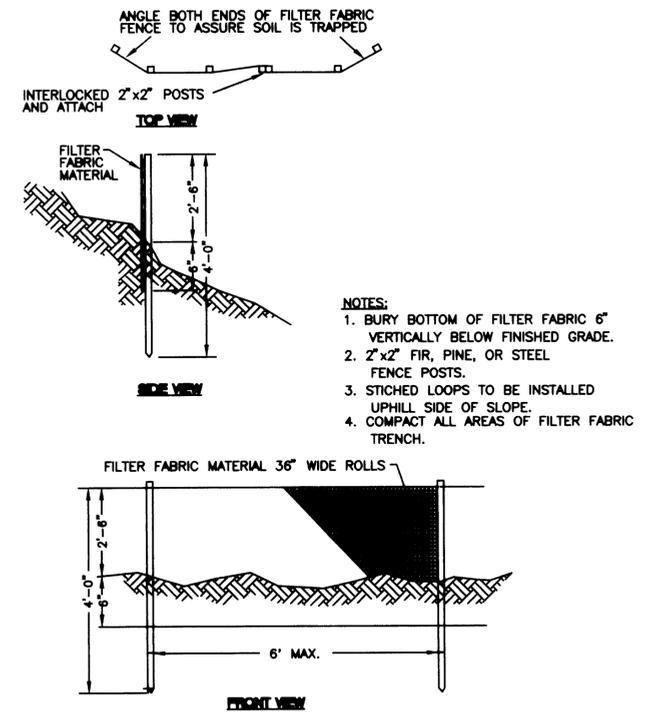

SEDIMENT FENCE
SCALE: NTS

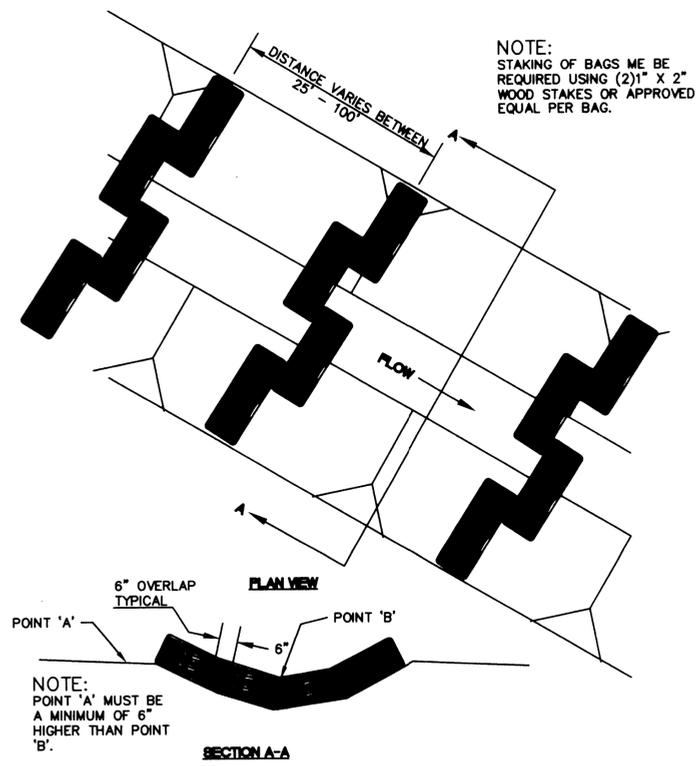


BIO-BAG DITCH PROTECTION
SCALE: NTS

AS-BUILT
JANUARY 22, 1997

THESE AS-BUILT DRAWINGS HAVE BEEN PREPARED, IN PART, ON THE BASIS OF INFORMATION COMPILED AND FURNISHED BY THE CONTRACTOR AND OTHERS. THE ENGINEER CERTIFIES THAT THESE PLANS REPRESENT ACTUAL IMPROVEMENTS CONSTRUCTED AND THAT THESE IMPROVEMENTS ARE IN ACCORDANCE WITH GOVERNING JURISDICTIONAL STANDARDS.

W R G
DESIGN INC.
10450 SW Nimbus Ave., Portland, Oregon 97223
503 603-9933 FAX: 503 603-9944
PLANNERS • ENGINEERS • LANDSCAPE ARCHITECTS • SURVEYORS

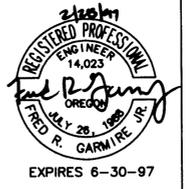

EROSION CONTROL DETAILS
CASCADE SUMMIT PHASE IV OFF SITE SEWER
WEST LINN, OREGON
KOSS-BROOD-GOODRICH AND ASSOCIATES, 22596 DAY RD., WEST LINN, OR 97066

| REV. | DATE | BY |
|------|------|----|
| | | |
| | | |
PROJECT NO.
KBG002.3

DATE | 1/22/97
DESIGNED | S. ROPER
ENGINEER | F. GARMIRE
CHECKED |

SHEET TITLE
EROSION

SHEET NUMBER
C5