




ELEV DATUM - CITY OF SEASIDE BENCH MARK AT 0th & WILLAMETTE FALLS DRIVE STAMPED 131.00

GRAPHIC SCALE






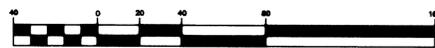


**LEGEND:**

- SS — EXISTING SANITARY SEWER
- WL — EXISTING WATERLINE
- - - - PROPOSED STORM DRAIN
- C & G — CURB & GUTTER
- - - - SIDEWALK BY OTHERS
- - - - E.O.P. — EXISTING EDGE OF PAVEMENT
- - - - DITCH — EXISTING DITCHLINE
- - - - RIGHT-OF-WAY
- - - - EASEMENT
- ⊙ EXISTING SANITARY MANHOLE
- ⊙ PROPOSED STORM DRAIN MANHOLE
- PROPOSED GUTTER INLET
- ⊕ EXISTING FIRE HYDRANT
- ⊕ EXISTING WATER VALVE
- ⊕ EXISTING UTILITY POLE
- EXISTING MAILBOX
- TREE
- ⊘ RIPRAP

**CURB RETURN DATA:**

CURB	DATA	a	b	c	d
①	Δ = 90°13'32" R = 29.00' L = 45.57'	83.87 FIFTH AVENUE STA 4+18.58	84.50	86.00	87.21 5th STREET STA 0+43.02

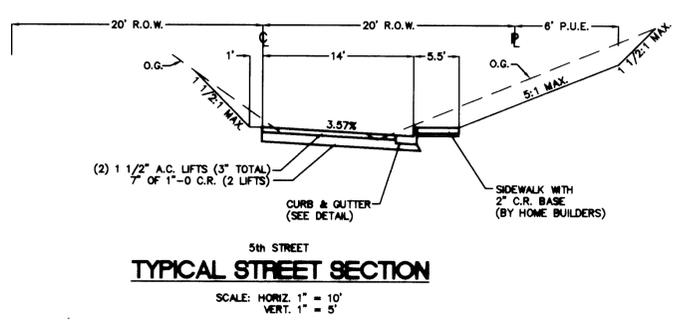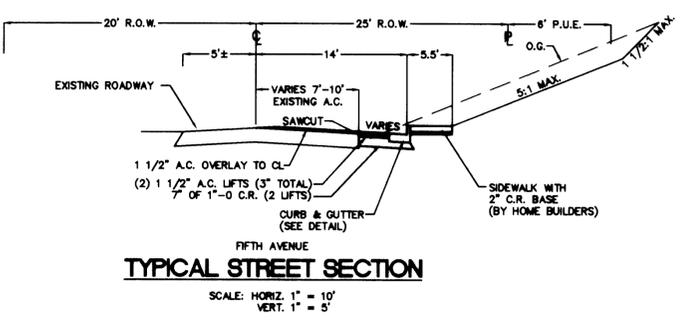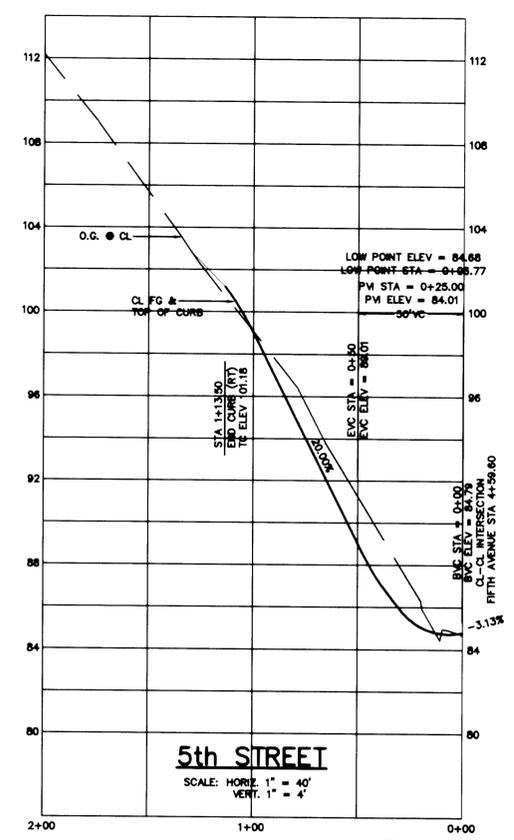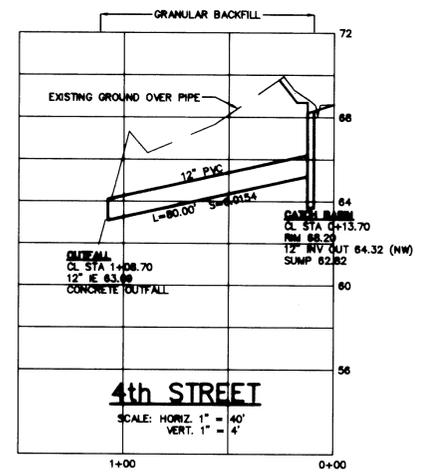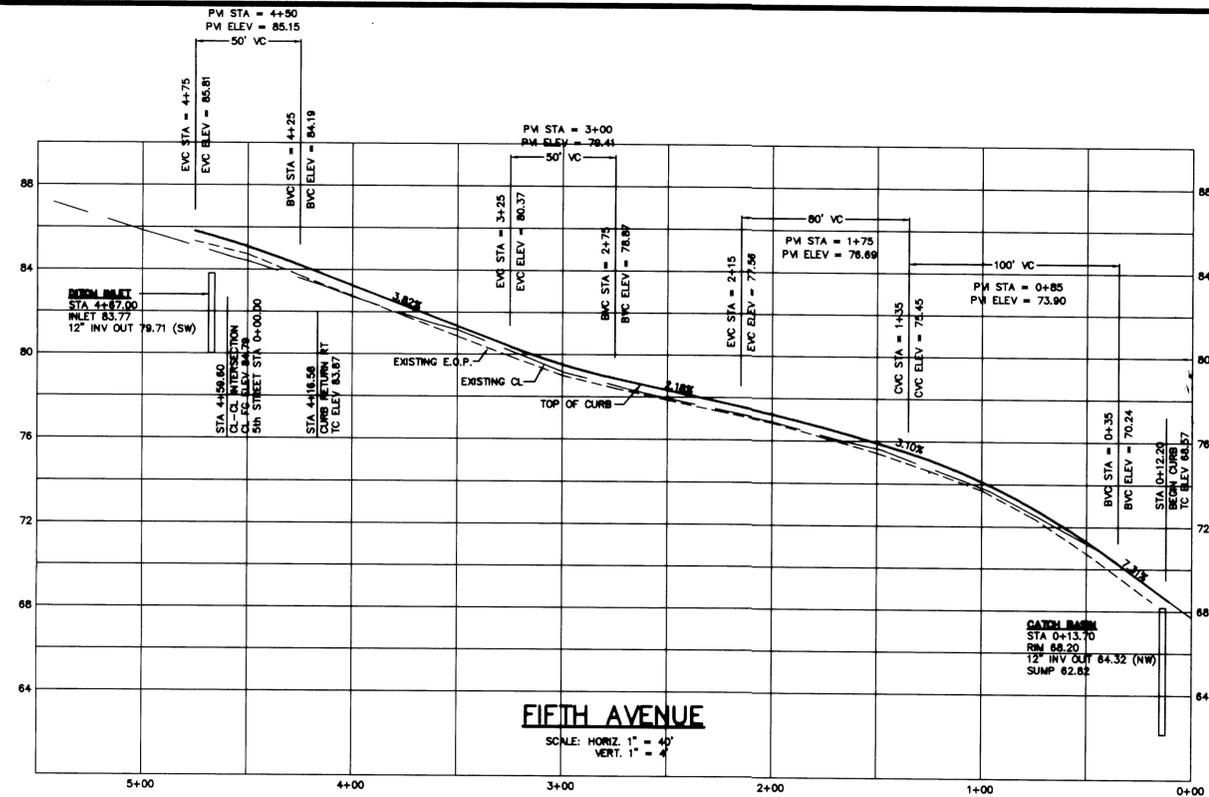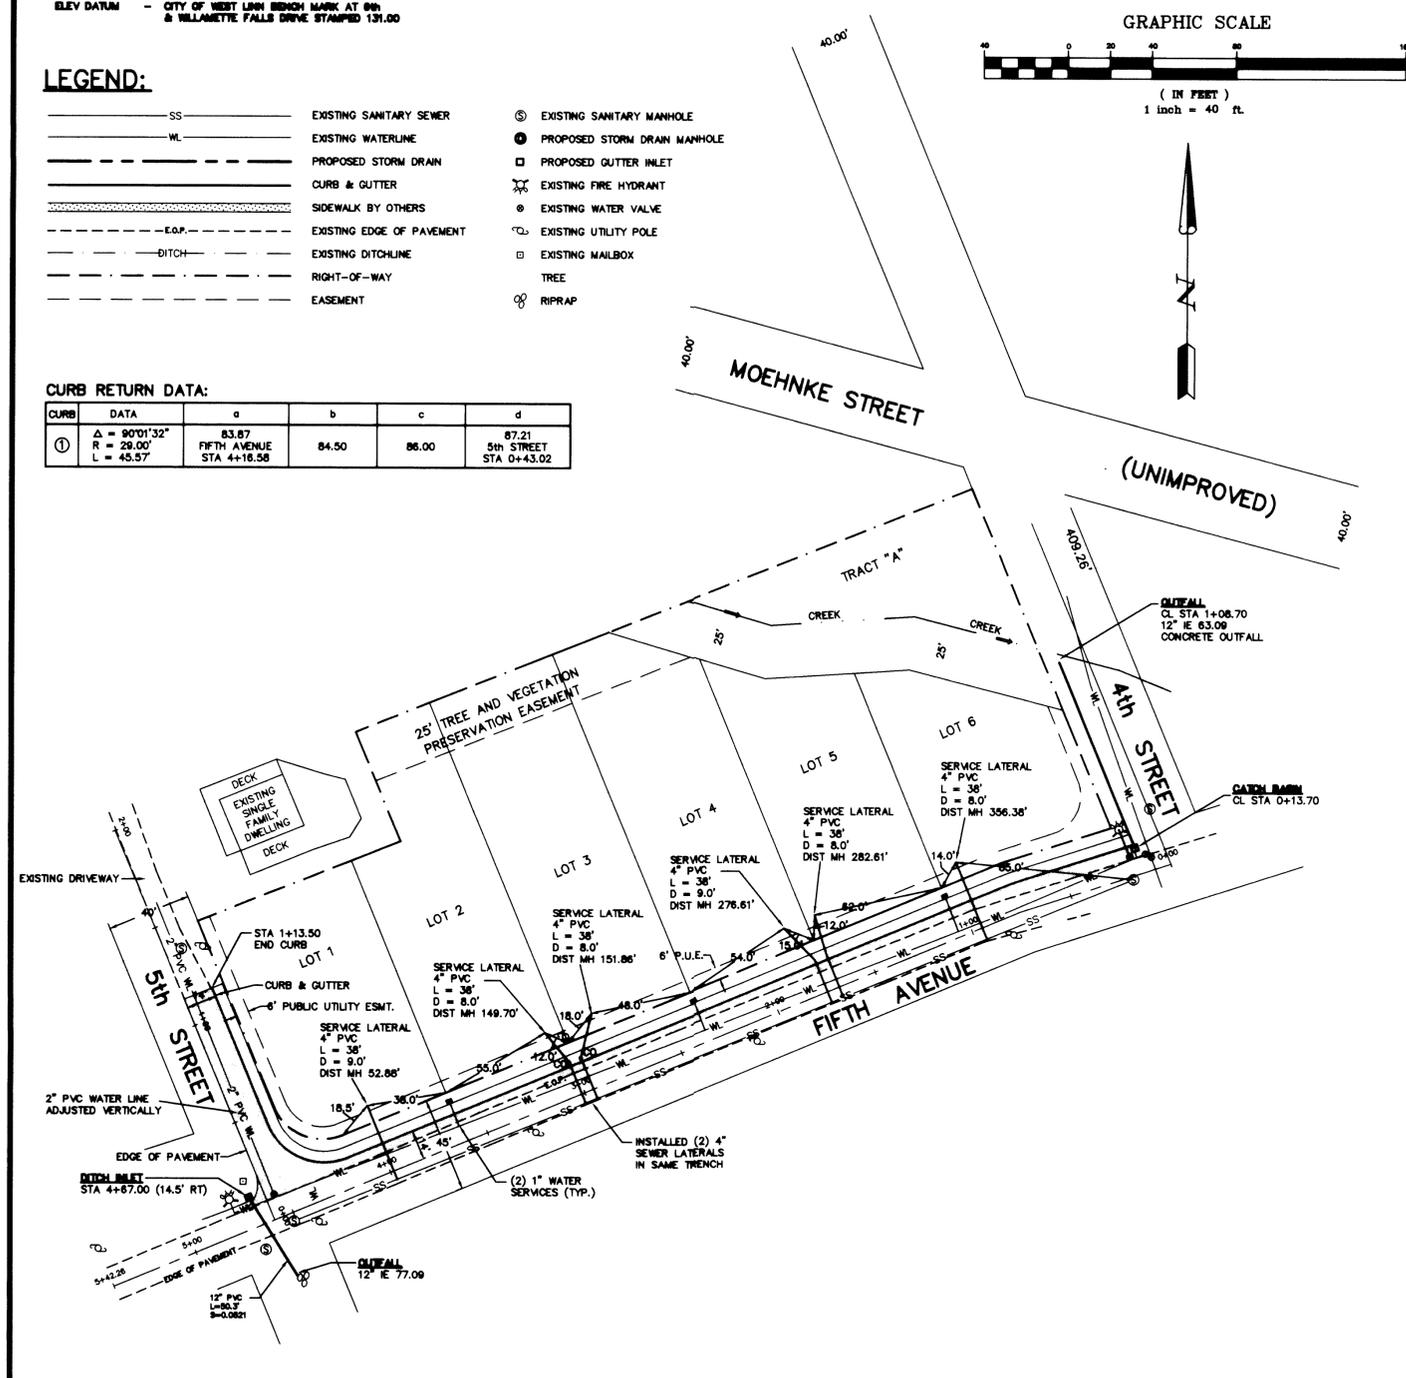

AS BUILTS



REVISIONS	BY
AS BUILTS 9-13-94	JK

FIR VIEW  
LEN OSBORNE

Street and Storm Drain Plan

**SISUL ENGINEERING**  
375 PORTLAND AVENUE  
ASTORIA, OREGON 97103  
(503) 687-0188

DATE	OCT. 1993
SCALE	H: 1" = 40' V: 1" = 4'
DRAWN	PS
JOB	93-67
SHEET	1
OF 3 SHEETS	

9/13/94