

1/30/01
 Date MFK
 Designed RK / WJK
 Drawn 10/29/01
 Checked By Date



99 "AS-BUILT"
 DATE 10-26-01 BY SAS

KOSS REAL ESTATE
 1098 S. ROSEMONT
 WEST LINN, OR 97068
 Phone: (503) 557-1144
 Fax: (503) 557-1294

ROSEMONT SUMMIT II SUBDIVISION
 PHASE B
 CITY OF WEST LINN, OREGON
 COVER SHEET



Incorporated
 17355 SW Boones Ferry Rd.
 Lake Oswego, Oregon 97035
 Phone: (503) 636-2618
 FAX: (503) 636-5395

L9754
 Project No. D754S01B
 File No. S01B
 Sheet No. Copyright 1999 ©

AS-BUILT DRAWINGS OCTOBER 26, 2001

ROSEMONT SUMMIT II SUBDIVISION PHASE B - 21 LOTS CITY OF WEST LINN SITE DEVELOPMENT PLANS

PROJECT TEAM
 - CLIENT: KOSS REAL ESTATE
 TEL: 603-557-1144
 - ENGINEER: OTAK
 PROJECT MANAGER - M. FARES KEKHIA PE
 TEL: 603-635-3618
 FAX: 603-635-5395

SHEET INDEX

- S01B COVER SHEET
- S02B TYPICAL STREET SECTIONS & CONDITION OF APPROVAL
- S03B COMPOSITE UTILITY PLAN
- S04B GRADING & EROSION CONTROL PLAN (FOR INFORMATIONAL PURPOSES ONLY)
- S05B EROSION CONTROL NOTES AND DETAILS (FOR INFORMATIONAL PURPOSES ONLY)
- S06B STREET AND STORM DRAIN PLAN
- S07B STREET AND STORM DRAIN PROFILE
- S08B SANITARY SEWER & WATER PLAN
- S09B SANITARY SEWER AND WATER PROFILES
- S10B DETAIL SHEET
- S11B DETAIL SHEET
- S12B DETAIL SHEET
- S13B DETAIL SHEET

GENERAL NOTES

1. ALL CONSTRUCTION SHALL BE IN ACCORDANCE WITH THE "CITY OF WEST LINN STREET/UTILITY DESIGN AND CONSTRUCTION STANDARDS", DATED MAY 22, 2000. ALL STREET, STORM SEWER AND SANITARY SEWER CONSTRUCTION THAT IS NOT ADDRESSED IN THE CITY'S STANDARDS SHALL BE IN ACCORDANCE WITH APWA STANDARDS. ALL WATER SYSTEM CONSTRUCTION THAT IS NOT ADDRESSED IN THE CITY'S STANDARDS SHALL BE IN ACCORDANCE WITH AWWA STANDARDS. CONTRACTOR TO OBTAIN A COPY OF THE GEOTECHNICAL REPORT PREPARED FOR THIS PROJECT PRIOR TO CONSTRUCTION. REPORT BY SQUIRE ASSOCIATES DATED NOVEMBER 12, 1998.
2. PRIOR TO ANY CONSTRUCTION, LOCATIONS OF EXISTING UTILITIES SHALL BE VERIFIED BY THE CONTRACTOR. WHEN ACTUAL CONDITIONS DIFFER FROM THOSE SHOWN ON THE PLANS, THE CONTRACTOR SHALL NOTIFY THE ENGINEER PRIOR TO PROCEEDING WITH CONSTRUCTION.
3. ORGANIC AND NON-DESIRABLE MATERIALS SHALL BE REMOVED FROM THE CONSTRUCTION AREA AS DIRECTED BY THE GEOTECHNICAL ENGINEER.
4. ALL FILL AREAS SHALL BE STRIPPED OF ORGANIC MATERIAL. FILL WILL BE PLACED IN 8-INCH LAYERS AND COMPACTED TO 95 PERCENT RELATIVE MAXIMUM DENSITY ACCORDING TO AASHTO T-180 STANDARDS. BASE ROCK IN THE STREET SHALL BE COMPACTED TO THE SAME STANDARD. LANDSCAPE AREAS SHALL BE COMPACTED TO 90 PERCENT. THE CONTRACTOR SHALL PROVIDE DENSITY TESTING, ONE FOR EVERY 10,000 SQUARE FEET OF AREA AND FOR EVERY 2 LAYERS OR 16' AND EVERY 100 LINEAR FEET OF FILL PLACED. COMPACTION REPORTS FROM A NATIONALLY ACCREDITED TESTING LAB SHALL BE SUPPLIED TO THE ENGINEER.
5. CONTRACTOR SHALL LEAVE ALL AREAS OF THE PROJECT FREE OF DEBRIS AND UNUSED CONSTRUCTION MATERIALS.
 - a. AREAS TO BE LANDSCAPED SHALL BE SMOOTHED AND LEFT TO THE GRADES INDICATED ON THE GRADING PLAN, PLUS OR MINUS 0.1 FOOT.
 - b. ALL DISTURBED AREAS NOT TO BE LANDSCAPED SHALL BE SEEDED PER EROSION CONTROL NOTES ON SHEET 5 TO PREVENT EROSION.
6. ANY CHANGES FROM THE APPROVED PLANS SHALL BE REQUESTED BY THE CONTRACTOR IN WRITING. THE DESIGN ENGINEER AND THE CITY OF WEST LINN'S PROJECT ENGINEER MUST APPROVE THE CHANGE PRIOR TO ITS IMPLEMENTATION. COMPLEXITY OF MODIFICATION WILL DETERMINE IF REVISED PLANS ARE REQUIRED.
7. STANDARD SIDEWALK RAMPS SHALL BE CONSTRUCTED IN ACCORDANCE WITH APWA DRAWING 206.
8. THE FOLLOWING CITY OF WEST LINN DETAILS SHALL BE USED AS SPECIFIED IN THE PLANS:


TRENCH BACKFILL - DWG. WL-200	TWIN CURB RAMP - DWG. WL-507B
CLEANOUT - DWG. WL-206	SIDEWALK CROSS SECTION - DWG. WL-508
STANDARD MANHOLE - DWG. WL-207	STREET BARRICADE - DWG. WL-516
SHALLOW MANHOLE - DWG. WL-208	COMBINATION CURB INLET - DWG. WL-601
FLEXIBLE MANHOLE CONNECTION - DWG. WL-212	TYPE G-1 CB WITH SUMP - DWG. WL-602
MANHOLE FRAME AND COVER - DWG. WL-300	FRAME AND GRATE DETAIL - DWG. WL-602A
FIRE HYDRANT ASSY. - DWG. WL-401	POLLUTION CONTROL MANHOLE - DWG. WL-607
STANDARD WATER SERVICE - DWG. WL-402	OUTLET HEADWALL - DWG. WL-613
WATERLINE BLOWOFF - DWG. WL-404B	STORM SEWER OUTFALL - DWG. WL-614
AIR RELEASE ASSY. - DWG. WL-405	
HORIZONTAL WATERLINE THRUST BLOCKING - DWG. WL-406	
WATERLINE STRADDLE BLOCK - DWG. WL-408	
VALVE BOX DETAIL - DWG. WL-411	
BLOWOFF VALVE BOX - DWG. WL-412	
CURBS - DWG. WL-501	
COMMERCIAL DRIVEWAY - DWG. WL-504	
PARALLEL CURB RAMP - DWG. WL-506	
9. DURING CONSTRUCTION, ALL EROSION CONTROL MEASURES SHALL CONFORM TO CLACKAMAS COUNTY EROSION CONTROL STANDARDS AND WILL BE STRICTLY ENFORCED.
10. ALL AGGREGATE MATERIAL SHALL CONFORM TO APWA STANDARDS.
11. IN CASE OF A DISCREPANCY BETWEEN THE DRAWINGS AND THE FIGURES WRITTEN THEREON, THE FIGURES SHALL BE DEEMED TO GOVERN.
12. THE OWNER WILL SUPPLY ONE SET OF STAKES FOR EACH CONSTRUCTION OPERATION AS DESCRIBED IN THE CONTRACT DOCUMENTS AND SPECIFICATIONS. THE CONTRACTOR SHALL DESIGNATE A REPRESENTATIVE OR REPRESENTATIVES WHO ARE AUTHORIZED TO REQUEST STAKES. STAKING REQUESTS FROM AUTHORIZED REPRESENTATIVE SHALL BE MADE TO DAVE LIDEN AT OTAK (899-2401) AT LEAST 48 HOURS IN ADVANCE OF THE NEED FOR SAID STAKES. ONLY REQUESTS FROM AUTHORIZED REPRESENTATIVES WILL BE HONORED. ANY RESTAKING WILL BE DONE AT THE EXPENSE OF THE CONTRACTOR.
13. THE DESIGN ENGINEER WILL PROVIDE THE CITY OF WEST LINN A LETTER INDICATING THAT THE IMPROVEMENTS WERE CONSTRUCTED PER THE DESIGN PLANS AND SPECIFICATIONS.
14. WEEK DAY WORK HOURS ARE 7 AM TO 6 PM; SATURDAY, SUNDAY, AND HOLIDAY WORK HOURS ARE LIMITED TO 9 AM TO 6 PM.
15. THE CITY OF WEST LINN SHALL BE SUPPLIED WITH A COPY OF ALL TEST RESULTS.

STORM/SANITARY SEWERS:


16. MANHOLE CONSTRUCTION SHALL BE IN ACCORDANCE WITH THE CITY OF WEST LINN'S STANDARD PLANS.
17. TRENCH BACKFILL IN PAVED AREAS WILL BE 3/4-INCH TO 0-INCH CRUSHED ROCK COMPACTED TO 95 PERCENT RELATIVE MAXIMUM DENSITY, AASHTO T-180.
18. ALL SANITARY SEWER AND STORM PIPE LATERALS SHALL BE MATERIALS IN ACCORDANCE WITH CITY OF WEST LINN SPECIFICATIONS D-3034. FOR STORM MAINS, USE "ULTRA-RIB" PVC CONFORMING TO ASTM F-794 AND THE CITY OF WEST LINN SPECIFICATIONS.
19. UNLESS NOTED OTHERWISE, SANITARY SEWER SERVICES SHALL BE 4" PVC WITH A MINIMUM SLOPE OF 2%. STORM SEWER SERVICES SHALL BE 6" WITH A MINIMUM SLOPE OF 2%.
20. PRIOR TO ACCEPTANCE, ALL PUBLIC SANITARY SEWERS SHALL BE TV, PRESSURE, AND DEFLECTION TESTED IN ACCORDANCE WITH THE CITY OF WEST LINN'S REQUIREMENTS. ALL PUBLIC STORM STORM SEWERS SHALL BE TV AND DEFLECTION TESTED.
21. MANHOLE RIM ELEVATIONS SHOWN ARE APPROXIMATE AND FOR INFORMATION ONLY. FINAL ELEVATIONS SHALL BE SET TO MATCH CONSTRUCTED FINISH GRADE.
22. SANITARY MANHOLES 16, AND 17, AS WELL AS STORM MANHOLE 10 NEED TO HAVE A NON-SKID MANHOLE COVER.

WATERLINES:

23. ALL WATER PIPE AND FITTINGS SHALL BE DUCTILE IRON CLASS 52 AND CONFORM TO STANDARD CITY SPECIFICATIONS AND DETAILS.
24. WATERLINES SHALL BE PRESSURE TESTED FOLLOWING COMPLETION. PRESSURE TESTS AT THE LOWEST POINT IN TEST SECTION SHALL BE IN ACCORDANCE TO THE CITY OF WEST LINN'S STANDARDS WITH A MINIMUM TEST PRESSURE OF 180 PSI. WHEN THE PRESSURE TEST IS PERFORMED, THE TEST PRESSURE OF 180 PSI SHALL STABILIZE BEFORE THE TEST BEGINS. SERVICE LINES WILL ALSO BE TESTED TO THE METER LOCATION IF INSTALLED BY THE CONTRACTOR.
25. PRIOR TO BEING PLACED INTO SERVICE, THE WATERLINE SHALL BE FLUSHED, STERILIZED AND FLUSHED AGAIN ALL IN ACCORDANCE WITH STANDARD METHODS OF THE HEALTH DIVISION, DEPARTMENT OF HUMAN RESOURCES, STATE OF OREGON.
26. PRIOR TO CONNECTION TO EXISTING WATERLINE, A SAMPLE SHALL BE TAKEN AND TESTED FOR BACTERIOLOGICAL QUALITY. RESULTS MUST BE WITHIN STANDARDS OF THE STATE OF OREGON.
27. CONCRETE THRUST BLOCKING SHALL BE PROVIDED AT ALL WATERLINE FITTINGS AS REQUIRED BY CITY STANDARDS. BLOCKING SHALL BE POURED AGAINST UNDISTURBED EARTH AND CLEAR OF JOINT ACCESSORIES. BEARING AREA OF THRUST BLOCK SHALL BE COMPUTED ON THE BASIS OF ALLOWABLE SOIL BEARING PRESSURE. ALL PIPE FITTINGS IN CONTACT WITH CONCRETE SHALL BE WRAPPED IN PLASTIC.
28. MINIMUM COVER OVER WATERLINES IS TO BE 36" AS MEASURED FROM FINISH GRADE TO TOP OF PIPE. MINIMUM VERTICAL SEPARATION BETWEEN WATERLINE AND SANITARY SEWER AT A CROSSING IS 18". SANITARY SEWER AT WATERLINE CROSSINGS WITH LESS THAN THE MINIMUM VERTICAL SEPARATION SHALL BE CONSTRUCTED OF DUCTILE IRON PIPE WITH WATER-TIGHT JOINTS. IN SUCH CASES THE 18-FOOT LENGTH OF SANITARY SEWER SHALL BE CENTERED AT THE CROSSING.
29. ALL WATER SERVICES SHALL BE SEPARATED BY A MINIMUM HORIZONTAL DISTANCE OF 2' AT THE MAINLINE.

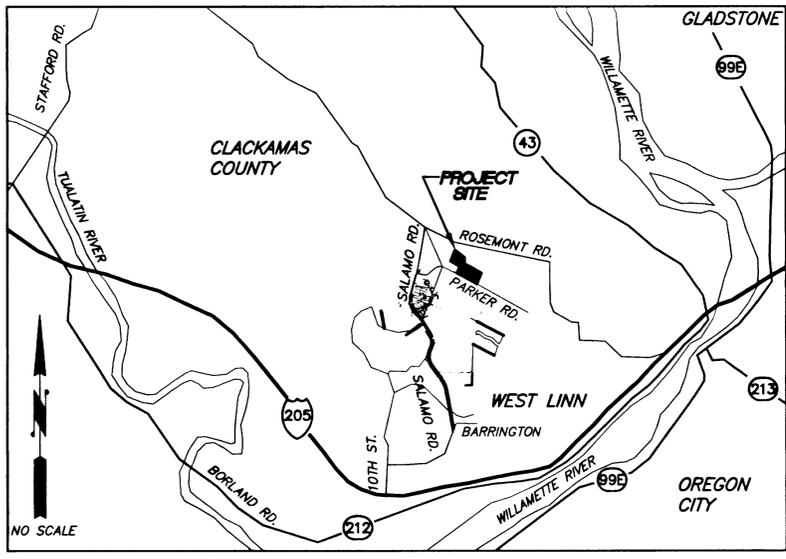

VICINITY MAP

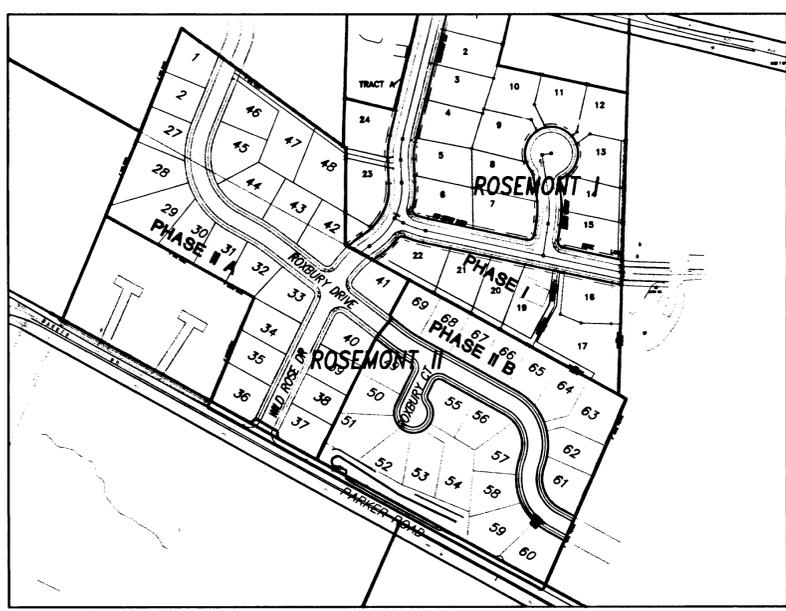

PROJECT MAP

NOT TO SCALE

LEGEND	
PROPOSED	EXISTING
--- ROW/PROPERTY LINE	--- EXISTING EDGE OF PAVEMENT
--- EASEMENT	--- EXISTING 2' CONTOUR
--- LOT LINE	--- EXISTING 10' CONTOUR
---SS--- PROPOSED SANITARY LINE	○ EXISTING TELEPHONE MANHOLE
---SD--- PROPOSED STORM LINE	○ EXISTING WATER LINE
---V--- PROPOSED WATER LINE	○ EXISTING GAS LINE
● PROPOSED STORM MANHOLE	○ EXISTING TELEPHONE LINE
● PROPOSED CATCH BASIN	○ EXISTING ELECTRIC LINE
● PROPOSED SANITARY MANHOLE	○ EXISTING STREET LIGHT
● GATE VALVE	○ EXISTING PERPENDICULAR CURB RAMP
● BLOW OFF	○ PARALLEL CURB RAMP
● FIRE HYDRANT	---SS--- EXISTING SANITARY LINE (PHASE A)
● WATER METER	---ST--- EXISTING STORM LINE (PHASE A)
● PROPOSED PRIVATE CLEAN OUT	● EXISTING STORM MANHOLE (PHASE A)
---XX--- SILT FENCE	● EXISTING CATCH BASIN (PHASE A)
○ STREET LIGHT	● EXISTING GATE VALVE (PHASE A)
○ STREET BARRICADE TYPE III	● EXISTING BLOW OFF (PHASE A)
● AIR RELEASE	● EXISTING FIRE HYDRANT (PHASE A)
○ PERPENDICULAR CURB RAMP	● EXISTING WATER METER (PHASE A)
○ PARALLEL CURB RAMP	

BENCH MARK

BENCH MARK: CITY OF WEST LINN BENCH MARK "B" IS 93.5' EAST AND 17.0' SOUTH OF EDGE OF PAVEMENT FROM 5-WAY INTERSECTION OF ROSEMONT/SANTA ANA. 3" CAP ON PIPE WITH YELLOW WATER WORKS' LD. ELEV. = 667.22.



LOCATING EXISTING UTILITIES

--- 48 HOUR NOTICE REQUIRED PRIOR TO EXCAVATION ---

- ONE CALL SYSTEM
 (GENERAL TELEPHONE, NORTHWEST) (503) 246-6699
 NATURAL GAS, U.S. WEST, U.S. SPRINT
 PORTLAND GENERAL ELECTRIC (503) 643-5454, EXT. 312, 313, 314
 TOI CABLE TELEVISION 243-7491
- REPAIR EMERGENCIES
 NORTHWEST NATURAL GAS (503) 226-4211, EXT. 4413
 CITY OF WEST LINN (503) 656-3535
 WATER OPERATIONS
 SANITARY SEWER OPERATIONS

THE CONTRACTOR, IN LOCATING AND PROTECTING UNDERGROUND UTILITIES, MUST COMPLY WITH THE REGULATIONS OF O.R.S. 757.541 TO 757.571

ATTENTION EXCAVATORS: Oregon law requires you to follow rules adopted by the Oregon Utility Notification Center. Those rules are set forth in OAR 952-001-0010 through OAR 952-001-0090. You may obtain copies of these rules from the Center by calling (503) 232-1987. If you have any questions about the rules, you may contact the call center. YOU MUST NOTIFY THE CENTER AT LEAST 2 BUSINESS DAYS, BUT NOT MORE THAN 10 BUSINESS DAYS, BEFORE COMMENCING AN EXCAVATION. CALL (503) 246-6699.

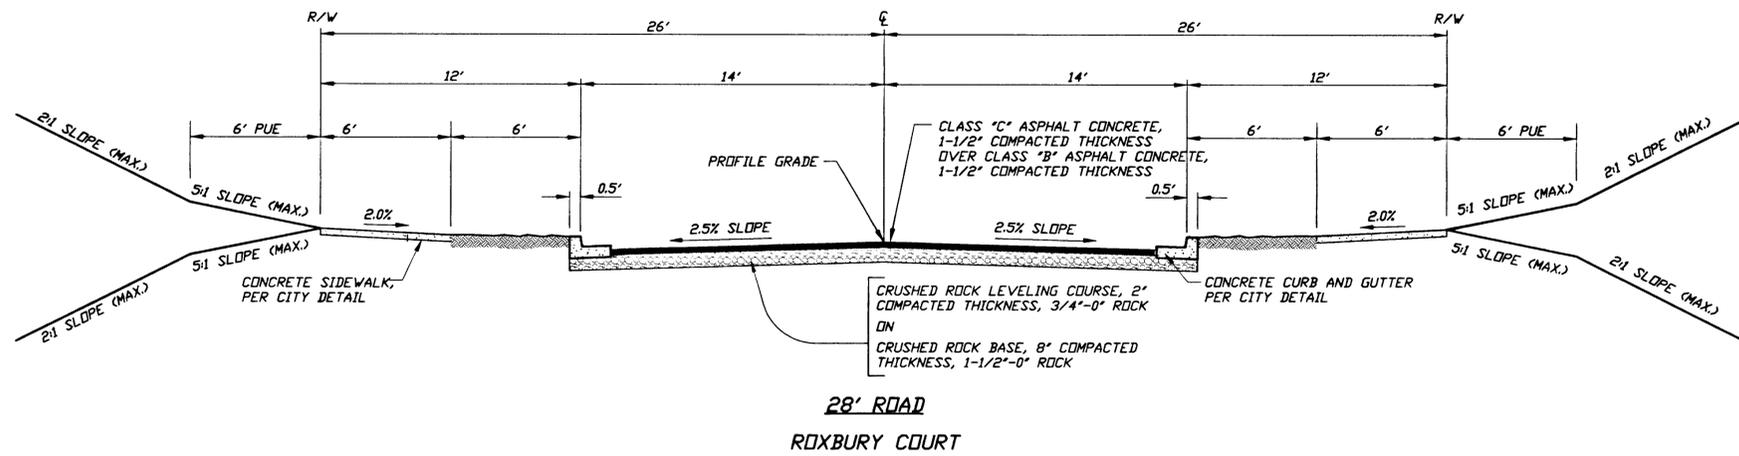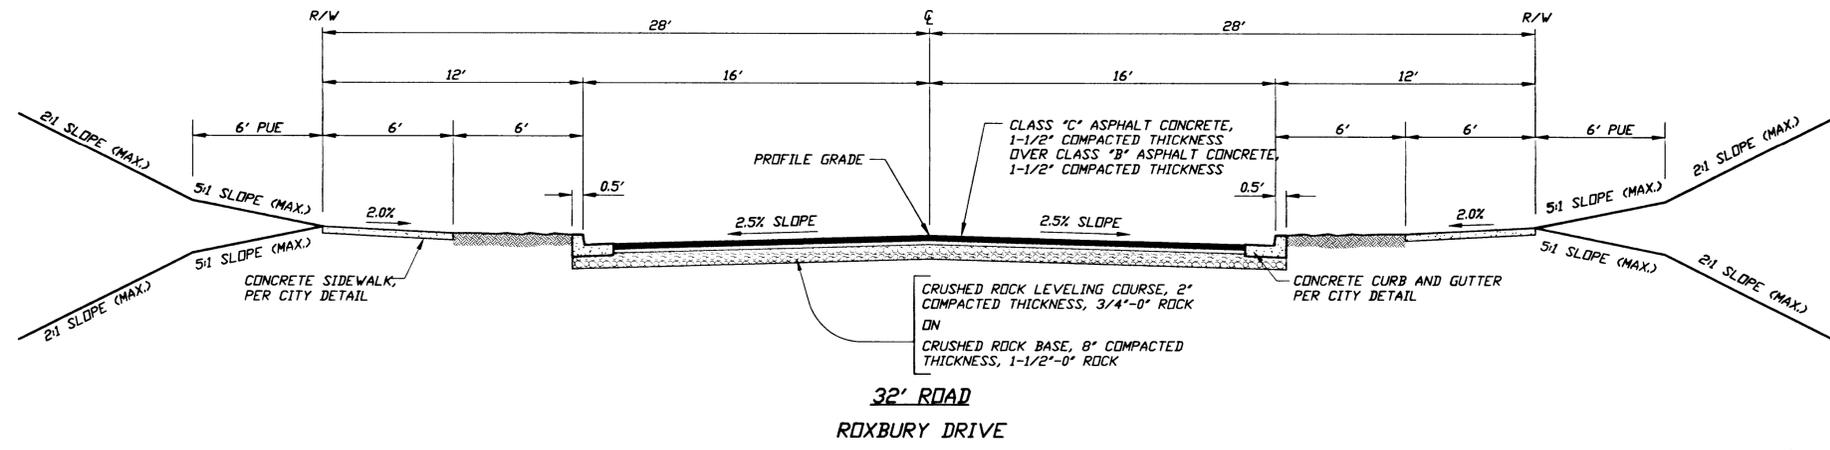

1/30/01
Date
MFK
Designed
RK / WJK
Drawn
Checked By Date



AS-BUILT
DATE 10-24-01 BY SAS

KOSS REAL ESTATE
1098 S. ROSEMONT
WEST LINN, OR 97068
Phone: (503) 557-1144
Fax: (503) 557-1294



ROSEMONT SUMMIT II SUBDIVISION
PHASE B
CITY OF WEST LINN, OREGON
TYPICAL STREET SECTIONS &
CONDITION OF APPROVAL



17355 SW Boones Ferry Rd.
Lake Oswego, Oregon 97035
Phone: (503) 635-3618
FAX: (503) 635-5396

L9754
Project No.
D754S02
File No.
S02B
Sheet No.
Copyright 1999 ©

AS-BUILT DRAWINGS OCTOBER 26, 2001

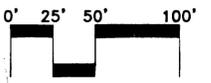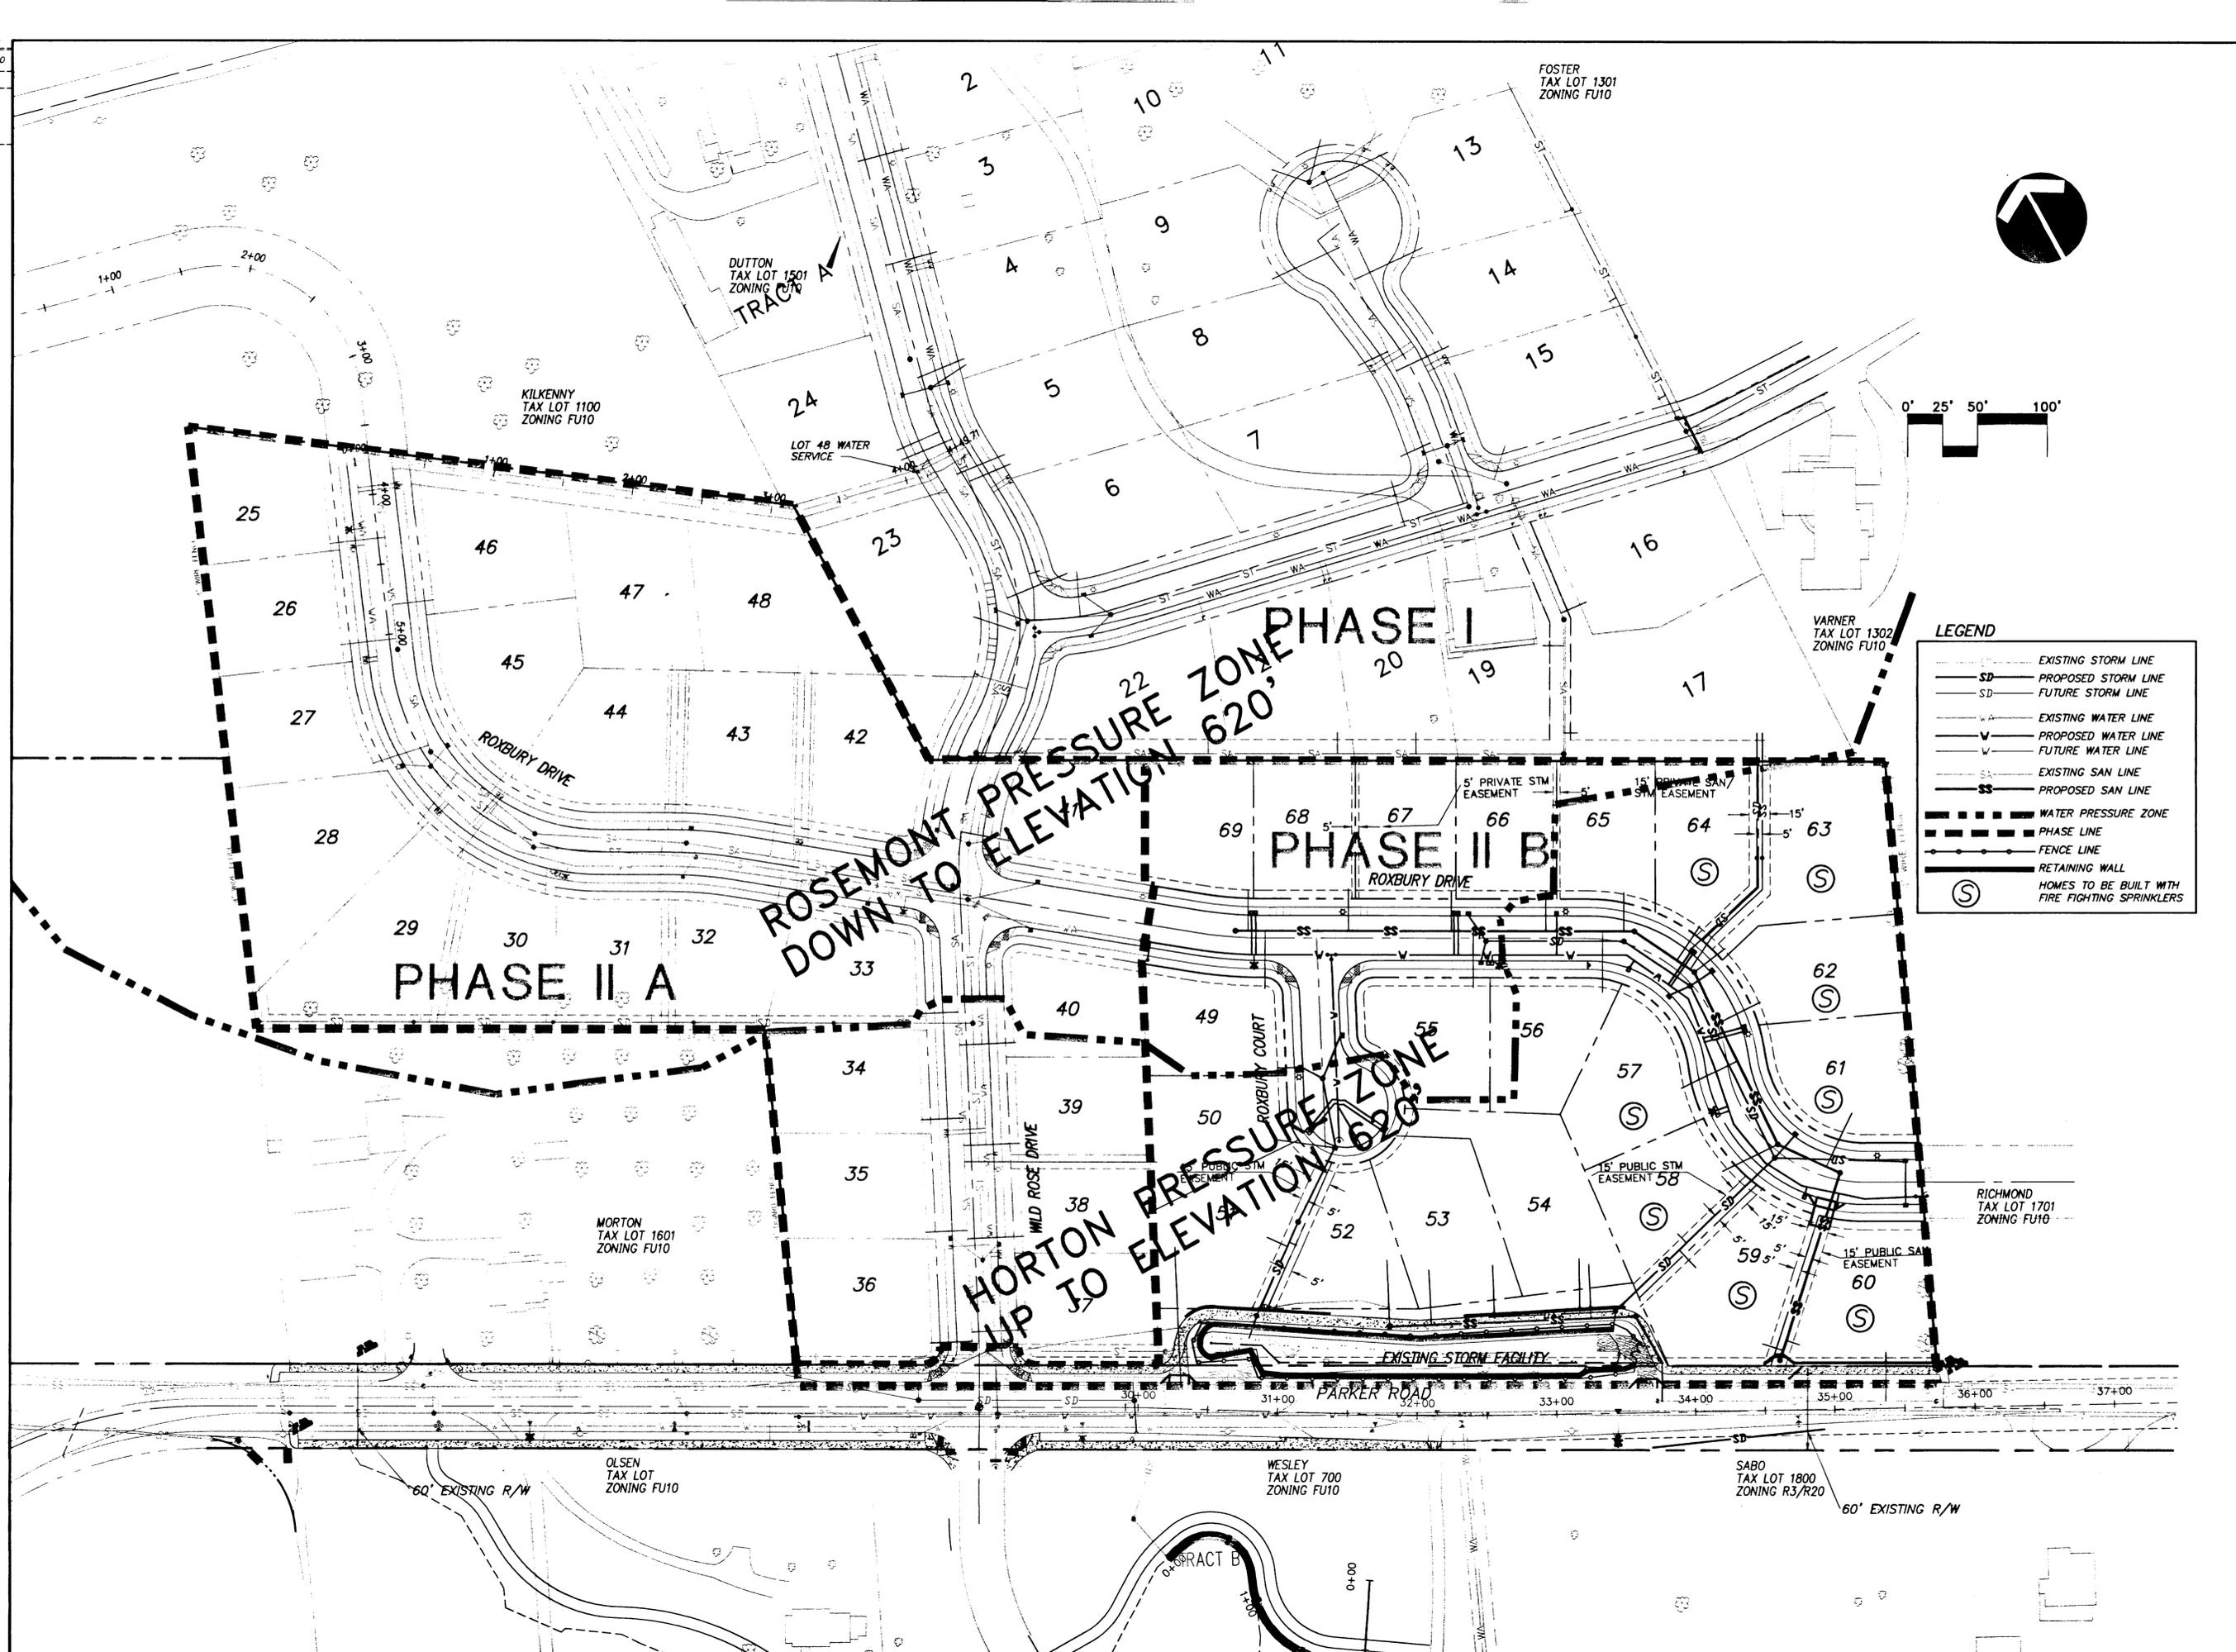

LEGEND

- SD - - - - - EXISTING STORM LINE
- SD - - - - - PROPOSED STORM LINE
- SD - - - - - FUTURE STORM LINE
- WA - - - - - EXISTING WATER LINE
- WA - - - - - PROPOSED WATER LINE
- WA - - - - - FUTURE WATER LINE
- SA - - - - - EXISTING SAN LINE
- SA - - - - - PROPOSED SAN LINE
- WATER PRESSURE ZONE
- - - - - PHASE LINE
- - - - - FENCE LINE
- - - - - RETAINING WALL
- (S) HOMES TO BE BUILT WITH FIRE FIGHTING SPRINKLERS

Date 1/30/01
 Designed MFK
 Drawn RK / WJK
 Checked By Date

 EXPIRES JUNE 30, 2001

KOSS REAL ESTATE
 1098 S. ROSEMONT
 WEST LINN, OREGON 97068
 Phone: (503) 557-1144
 Fax: (503) 557-1294

ROSEMONT SUMMIT II SUBDIVISION
 PHASE B
 CITY OF WEST LINN, OREGON
 COMPOSITE UTILITY PLAN

Incorporated
 17355 SW Boones Ferry Rd.
 Lake Oswego, Oregon 97035
 Phone: (503) 635-3618
 FAX: (503) 635-5395

L9754
 Project No.
 D754S03B
 File No.
S03B
 Sheet No.
 Copyright 1999 ©

AS-BUILT DRAWINGS OCTOBER 26, 2001

1/30/01
 Date
 MFK
 Designed
 RK / WJK
 Drawn
 Checked By Date

GRADING/EROSION CONTROL CONSTRUCTION SEQUENCE

1. INSTALL CONSTRUCTION ENTRANCE
2. INSTALL STAGE I PERIMETER SILT FENCING OR OTHER APPROVED SEDIMENT CONTROL MEASURES
3. INSTALL CATCH BASIN PROTECTION
4. CALL FOR INSPECTION AND APPROVAL OF THE ABOVE LISTED ITEMS
5. CONSTRUCT SURFACE WATER CONTROLS SIMULTANEOUSLY WITH CLEARING AND GRADING
6. CONSTRUCT SEDIMENT PONDS/BIO-SWALES AS PER APPROVED EROSION CONTROL PLANS
7. INSTALL STAGE II SILT FENCING OR OTHER APPROVED SEDIMENT CONTROL MEASURES
8. HYDROSEED EXPOSED AREA UPON COMPLETION OF GRADING

GRADING PLAN SHOWN FOR INFORMATIONAL PURPOSES ONLY.
 GRADING PLAN APPROVED BY BUILDING DEPT. ON 8/30/99
 PERMIT # 9-9-413

GRADING LEGEND

	EXISTING 2' CONTOUR
	EXISTING 10' CONTOUR
	CONSTRUCTION ENTRANCE
	SILT FENCE STAGE I
	SILT FENCE STAGE II
	EROSION CONTROL FOR C.B.
	PROPOSED 2' CONTOUR
	PROPOSED 10' CONTOUR
	EXISTING 2' CONTOUR (ROSEMONT I)
	EXISTING 10' CONTOUR (ROSEMONT I)



KOSS REAL ESTATE
 1098 S. ROSEMONT
 WEST LINN, OR 97068
 Phone: (503) 557-1144
 Fax: (503) 557-1294

ROSEMONT SUMMIT II SUBDIVISION
 PHASE B
 CITY OF WEST LINN, OREGON
 GRADING AND EROSION CONTROL PLAN
 FOR INFORMATIONAL PURPOSES ONLY

otak
 Incorporated
 17355 SW Boones Ferry Rd.
 Lake Oswego, Oregon 97035
 Phone: (503) 635-3618
 FAX: (503) 635-5395

L9754
 Project No.
D754S04B
 File No.
S04B
 Sheet No.
 Copyright 1999 ©

AS-BUILT DRAWINGS OCTOBER 26, 2001

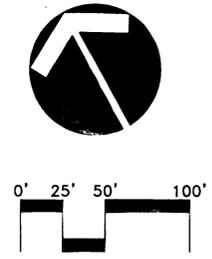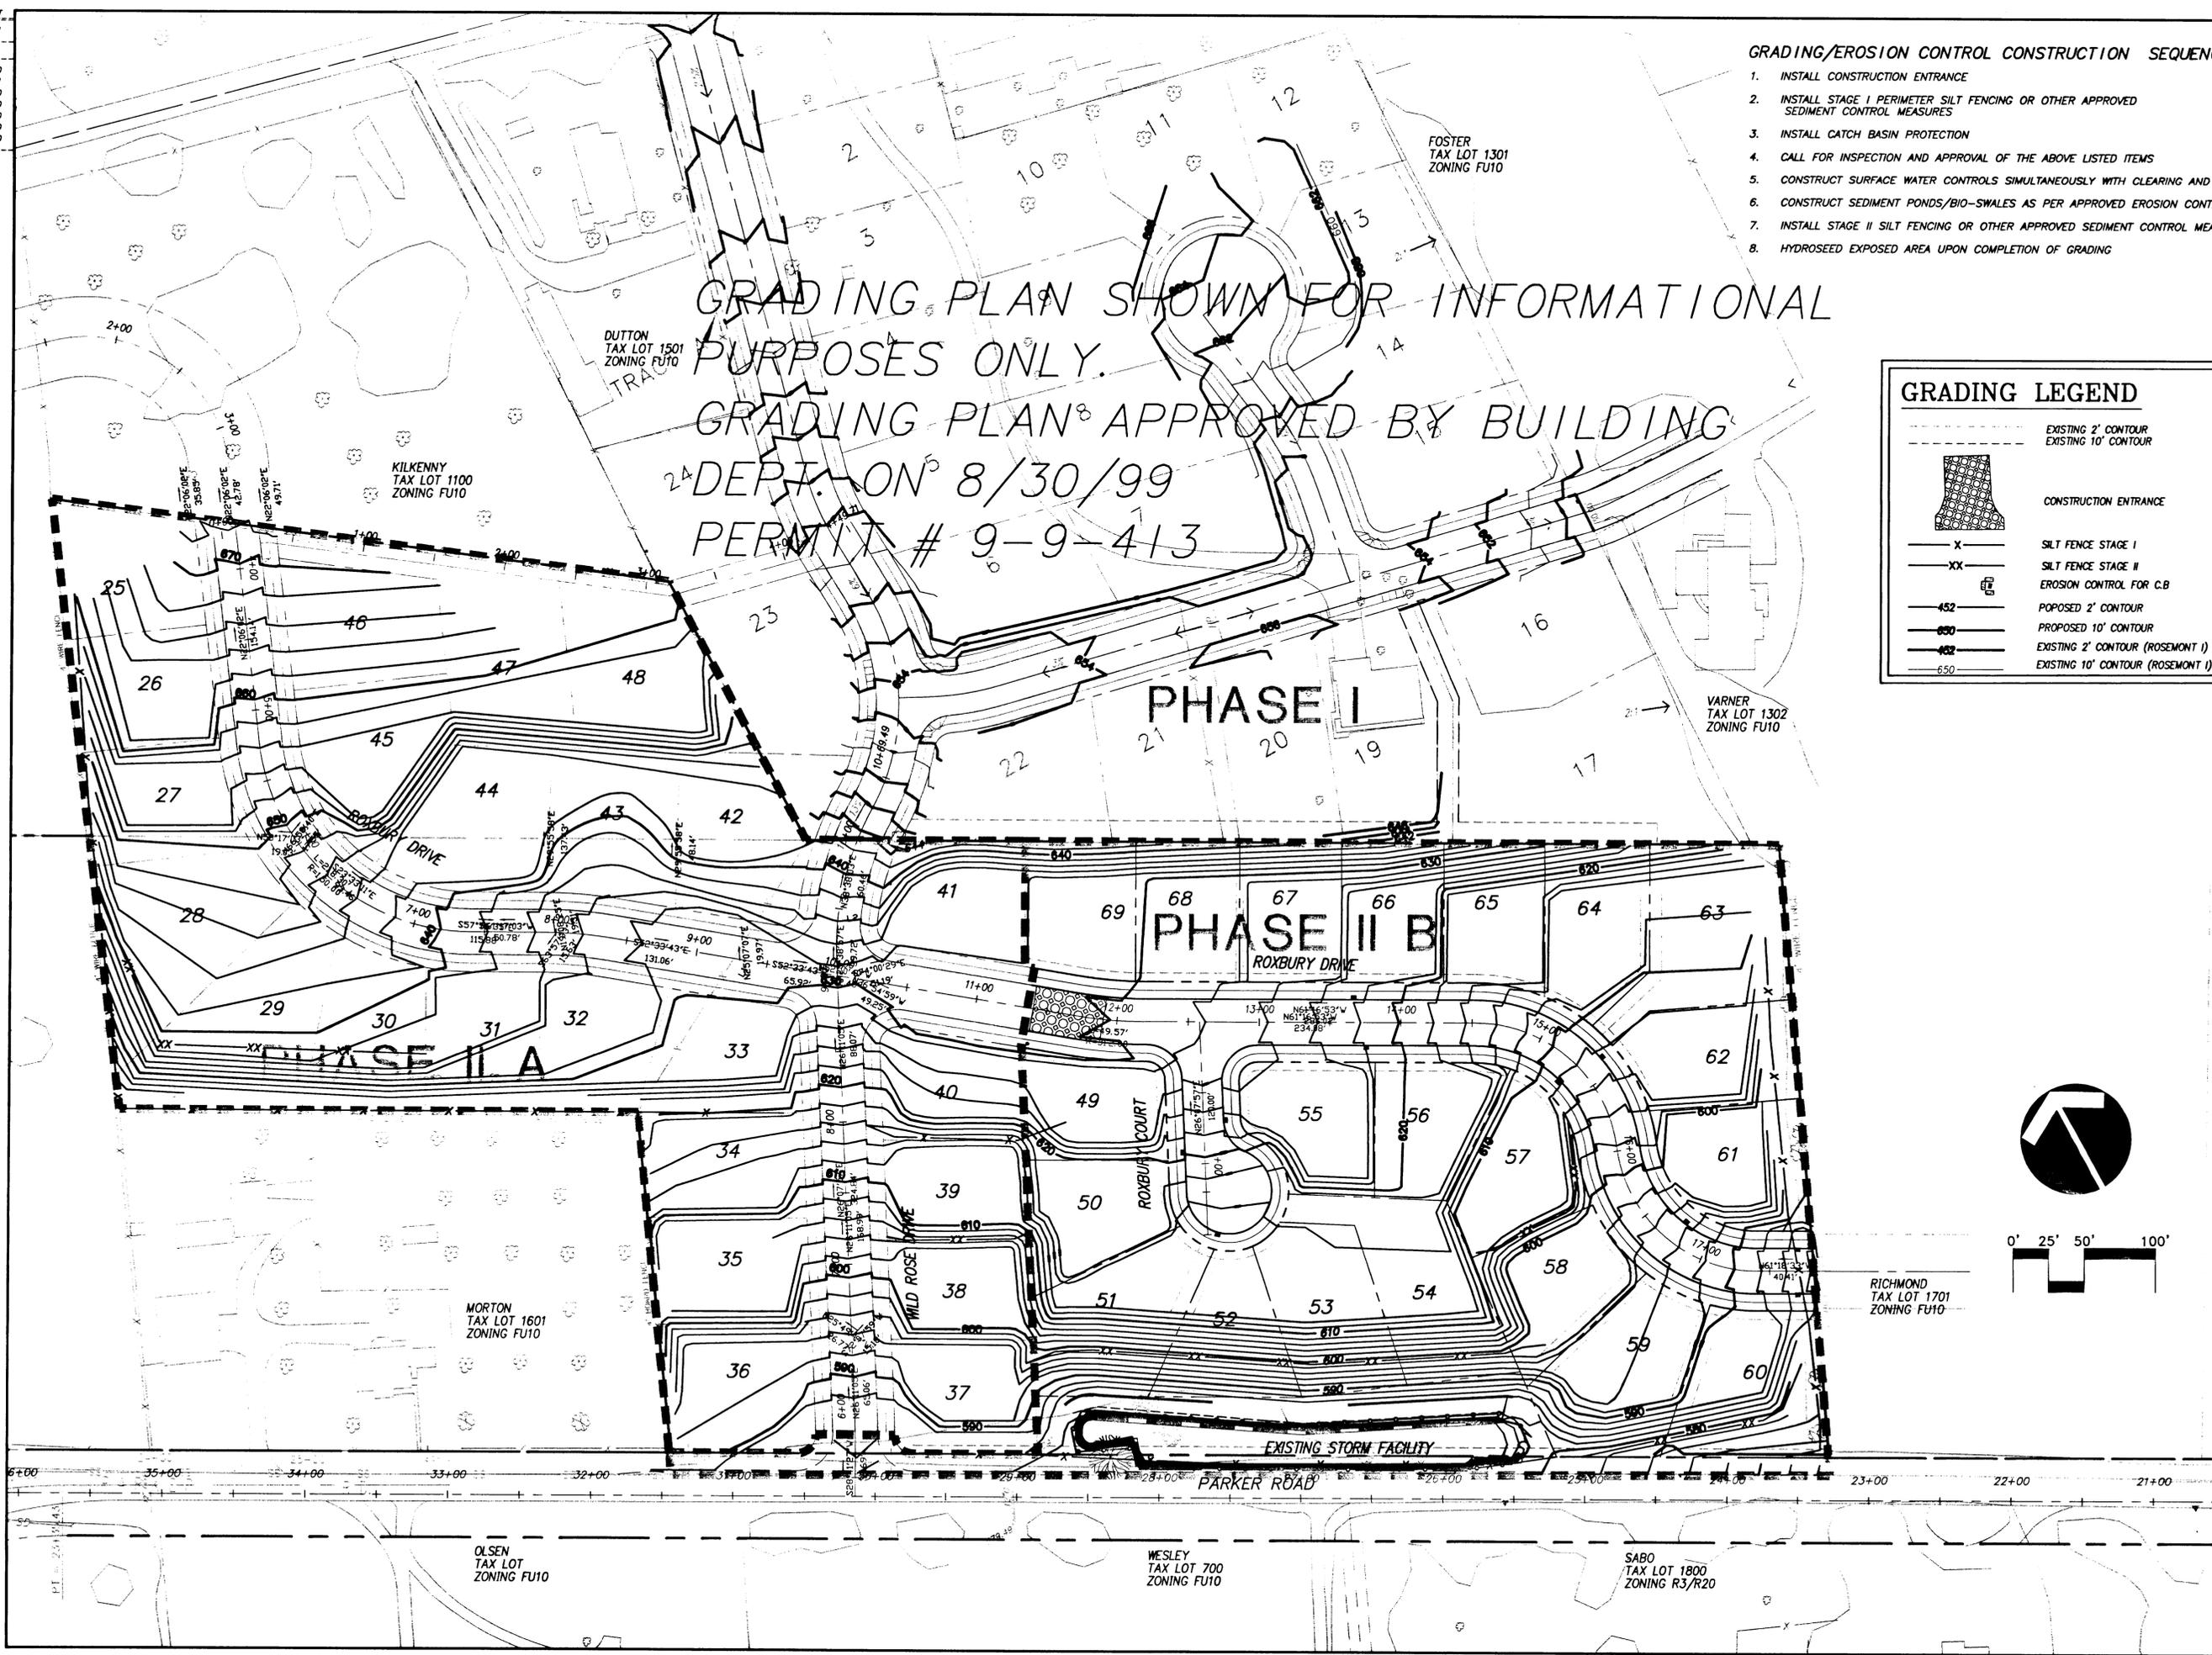

MORTON TAX LOT 1601 ZONING FU10

OLSEN TAX LOT ZONING FU10

WESLEY TAX LOT 700 ZONING FU10

SABO TAX LOT 1800 ZONING R3/R20

FOSTER TAX LOT 1301 ZONING FU10

DUTTON TAX LOT 1501 ZONING FU10

KILKENNY TAX LOT 1100 ZONING FU10

VARNER TAX LOT 1302 ZONING FU10

RICHMOND TAX LOT 1701 ZONING FU10

EXISTING STORM FACILITY

PARKER ROAD

ROXBURY DRIVE

PHASE I

PHASE II A

PHASE II B

EROSION CONTROL GENERAL NOTES

APPROVAL OF THIS EROSION/SEDIMENTATION CONTROL (ESC) PLAN DOES NOT CONSTITUTE AN APPROVAL OF PERMANENT ROAD OR DRAINAGE DESIGN (E.G. SIZE AND LOCATION OF ROADS, PIPES, RESTRICTORS, CHANNELS, DETENTION FACILITIES, UTILITIES, ETC.).

THE IMPLEMENTATION OF THESE ESC PLANS AND THE CONSTRUCTION, MAINTENANCE, REPLACEMENT, AND UPGRADING OF THESE ESC FACILITIES IS THE RESPONSIBILITY OF THE APPLICANT/CONTRACTOR UNTIL ALL CONSTRUCTION IS COMPLETED AND APPROVED AND VEGETATION/LANDSCAPING IS ESTABLISHED.

THE BOUNDARIES OF THE CLEARING LIMITS SHOWN ON THIS PLAN SHALL BE CLEARLY FLAGGED IN THE FIELD PRIOR TO CONSTRUCTION. DURING THE CONSTRUCTION PERIOD, NO DISTURBANCE BEYOND THE FLAGGED CLEARING LIMITS SHALL BE PERMITTED. THE FLAGGING SHALL BE MAINTAINED BY THE APPLICANT/CONTRACTOR FOR THE DURATION OF CONSTRUCTION.

THE ESC FACILITIES SHOWN ON THIS PLAN MUST BE CONSTRUCTED IN CONJUNCTION WITH ALL CLEARING AND GRADING ACTIVITIES, AND IN SUCH A MANNER AS TO INSURE THAT SEDIMENT LADEN WATER DOES NOT ENTER THE DRAINAGE SYSTEM OR VIOLATE APPLICABLE WATER STANDARDS.

THE ESC FACILITIES SHOWN ON THIS PLAN ARE THE MINIMUM REQUIREMENTS FOR ANTICIPATED SITE CONDITIONS. DURING THE CONSTRUCTION PERIOD, THESE ESC FACILITIES SHALL BE UPGRADED AS NEEDED FOR UNEXPECTED STORM EVENTS AND TO ENSURE THAT SEDIMENT-LADEN WATER DOES NOT LEAVE THE SITE.

THE ESC FACILITIES SHALL BE INSPECTED DAILY BY THE APPLICANT/CONTRACTOR AND MAINTAINED AS NECESSARY TO ENSURE THEIR CONTINUED FUNCTIONING.

THE ESC FACILITIES ON INACTIVE SITES SHALL BE INSPECTED AND MAINTAINED A MINIMUM OF ONCE A MONTH OR WITHIN THE 24 HOURS FOLLOWING A STORM EVENT.

AT NO TIME SHALL MORE THAN ONE FOOT OF SEDIMENT BE ALLOWED TO ACCUMULATE WITHIN A TRAPPED CATCH BASIN. ALL CATCH BASINS AND CONVEYANCE LINES SHALL BE CLEANED PRIOR TO PAVING. THE CLEANING OPERATION SHALL NOT FLUSH SEDIMENT LADEN WATER INTO THE DOWNSTREAM SYSTEM.

STABILIZED CONSTRUCTION ENTRANCES SHALL BE INSTALLED AT THE BEGINNING OF CONSTRUCTION AND MAINTAINED FOR THE DURATION OF THE PROJECT. ADDITIONAL MEASURES MAY BE REQUIRED TO INSURE THAT ALL PAVED AREAS ARE KEPT CLEAN FOR THE DURATION OF THE PROJECT.

EROSION CONTROL AND POLLUTION CONTROL MEASURE

EROSION CONTROL MEASURES FOR DISTURBED AREAS:

ALL DISTURBED SLOPES GREATER THAN 3:1 HAVE BEEN GRADED AND COMPACTED PRIOR TO OCTOBER 1ST SHALL BE HYDROSEEDING USING THE FOLLOWING SPECIFICATIONS:

SEEDING SHALL NOT BE DONE DURING WINDY WEATHER OR WHEN THE GROUND IS FROZEN, EXCESSIVELY WET OR OTHERWISE UNTILLABLE.

SEED MAY BE DOWN BY THE FOLLOWING METHOD:

HYDROSEEDING WHICH UTILIZED WATER AS THE CARRYING AGENT, AND MAINTAINS CONTINUOUS AGITATION THROUGH PADDLE BLADES. IT SHALL HAVE AN OPERATING CAPACITY SUFFICIENT TO AGITATE, SUSPEND AND MIX INTO A HOMOGENEOUS SLURRY OF THE SPECIFIED AMOUNT OF SEED AND WATER OR OTHER MATERIAL. DISTRIBUTION AND DISCHARGE LINES SHALL BE LARGE ENOUGH TO PREVENT STOPPAGE AND SHALL BE EQUIPPED WITH A SET OF HYDRAULIC DISCHARGE SPRAY NOZZLES WHICH WILL PROVIDE A UNIFORM DISTRIBUTION OF THE SLURRY.

GRASS SHALL BE SEED AT THE RATE OF NOT LESS THAN ONE HUNDRED THIRTY (130) POUNDS PER ACRE. SEED MIX SHALL INCLUDE:

STATE HIGHWAY ROADSIDE SEEDING MIX.

FERTILIZER SHALL BE APPLIED AT THE RATE OF 300 POUNDS PER ACRE.

NITROGEN - 22%

PHOSPHORIC ACID - 16%

SOLUBLE POTASH - 8%

WOOD CELLULOSE FIBER SHALL BE APPLIED AT THE RATE OF ONE AND ONE (1-1/2) TONS PER ACRE.

THE EXACT TIME FOR SEEDING WILL BE DETERMINED BY ACTUAL WEATHER CONDITIONS. THE NORMAL SATISFACTORY PERIOD FOR SEEDING SHALL BE CONSIDERED BETWEEN MARCH 1 TO JUNE 1 AND SEPTEMBER 1 TO OCTOBER 1 UNLESS OTHERWISE AUTHORIZED BY THE OWNER EXCEPT THAT CONTRACTOR MAY PERFORM SEEDING OPERATIONS FROM JUNE 1 TO SEPTEMBER 1 PROVIDED THAT HE WATERS THE NEW GRASS TO THE SATISFACTION OF THE OWNER.

WHEN DELAYS IN OPERATIONS CARRY THE WORK BEYOND THE MOST FAVORABLE PLANTING SEASON, OR WHEN WEATHER CONDITIONS ARE SUCH THAT SATISFACTORY RESULTS ARE NOT LIKELY TO BE OBTAINED FOR ANY STAGE OF THE SEEDING OPERATIONS, THE CONTRACTOR WILL STOP THE WORK AND IT SHALL BE RESUMED ONLY WHEN THE DESIRED RESULTS ARE LIKELY TO BE OBTAINED. IF OPERATIONS EXTEND PAST OCTOBER 1 ALTERNATE HAY PLACEMENT AND SPRING SEEDING SHALL BE SUBSTITUTED.

THE CONTRACTOR SHALL PROTECT ALL SEEDING AREAS FROM EROSION UNTIL FINAL INSPECTION AND ACCEPTANCE HAS BEEN MADE. AREAS DAMAGED BY EROSION SHALL BE REPAIRED BY THE CONTRACTOR AT HIS OWN EXPENSE.

ALL DISTURBED AREAS WITH SLOPES LESS THAN 3:1 THAT HAVE BEEN GRADED AND COMPACTED SHALL BE SEEDING PRIOR TO OCTOBER 1, WITH THE SAME SEED AND FERTILIZER MIX AS USED IN HYDROSEEDING AND SPREAD EVENLY OVER THE SITE.

ALL DISTURBED AREAS NOT GRADED AND COMPACTED PRIOR TO OCTOBER 1, SHALL BE SEEDING WITH 200 LBS PER ACRE OF HIGHWAY MIX AND SPREAD WITH A HAY MULCH LAYER 1 1/2" TO 2" THICK.

EROSION CONTROL PROTECTION SHALL BE CONSIDERED COMPLETE AND SUCCESSFUL WHEN A GRASS MAT HAS BEEN ESTABLISHED.

ADDITIONAL TEMPORARY EROSION CONTROL (DURING CONSTRUCTION)

HAY BALES WILL BE PLACED AT THE TOP OF ALL MAJOR FILL SLOPES WHEN NECESSARY, TO PREVENT SILT FROM WASHING INTO EXISTING DRAINAGE WAYS. (SILTATION BARRIER).

TEMPORARY DITCHES WILL BE CONSTRUCTED AS NECESSARY TO ASSURE DRAINAGE IS CHANNELLED TO THE FACILITIES BEING PROVIDED.

IF CONSTRUCTION TAKES PLACE DURING RAINY SEASON, HAY BALES AND "MIRAF" 140 S FABRIC WILL BE REQUIRED AT ALL STORM DRAINAGE INLETS UNTIL ROCKING OF STRETCH IS COMPLETED AND DISTURBED SLOPES STABILIZED BY HYDROSEEDING.

SEDIMENT FENCES

THE FILTER FABRIC SHALL BE PURCHASED IN A CONTINUOUS ROLL CUT TO THE LENGTH OF THE BARRIER TO AVOID USE OF JOINTS. WHEN JOINTS ARE NECESSARY, FILTER CLOTH SHALL BE SPICED TOGETHER ONLY AT A SUPPORT POST, WITH A MINIMUM 6-INCH OVERLAP, AND BOTH ENDS SECURELY FASTENED TO THE POST.

THE FILTER FABRIC FENCE SHALL BE INSTALLED TO FOLLOW THE CONTOURS WHERE FEASIBLE. THE FENCE POSTS SHALL BE SPACED A MAXIMUM OF 6 FEET APART AND DRIVEN SECURELY INTO THE GROUND A MINIMUM OF 30 INCHES.

A TRENCH SHALL BE EXCAVATED, ROUGHLY 8 INCHES WIDE BY 12 INCHES DEEP, UPSLOPE AND ADJACENT TO THE WOOD POST TO ALLOW THE FILTER FABRIC TO BE BURIED.





WHEN STANDARD STRENGTH FILTER FABRIC IS USED, A WIRE SUPPORT FENCE SHALL BE FASTENED SECURELY TO THE UPSLOPE SIDE OF THE POSTS USING HEAVY-DUTY WIRE STAPLES AT LEAST 1 INCH LONG, TIE WIRE OR HOG RINGS. THE WIRE SHALL EXTEND INTO THE TRENCH A MINIMUM OF 4 INCHES AND SHALL NOT EXTEND MORE THAN 36 INCHES ABOVE THE ORIGINAL GROUND SURFACE.

THE STANDARD STRENGTH FILTER FABRIC SHALL BE STAPLED OR WIRED TO THE FENCE, AND 20 INCHES OF THE FABRIC SHALL BE EXTENDED INTO THE TRENCH. THE FABRIC SHALL NOT EXTEND MORE THAN 30 INCHES ABOVE THE ORIGINAL GROUND SURFACE. FILTER FABRIC SHALL NOT BE STAPLED TO EXISTING TREES.

WHEN EXTRA-STRENGTH FILTER FABRIC AND CLOSER POST SPACING ARE USED, THE WIRE MESH SUPPORT FENCE MAY BE ELIMINATED. IN SUCH A CASE, THE FILTER FABRIC IS STAPLED OR WIRED DIRECTLY TO THE POSTS WITH ALL OTHER PROVISIONS OF THE ABOVE STANDARD NOTE FOR STANDARD STRENGTH FILTER FABRIC APPLYING.

SEDIMENT FENCES SHALL BE REMOVED WHEN THEY HAVE SERVED THEIR USEFUL PURPOSE, BUT NOT BEFORE THE UPSLOPE AREA HAS BEEN PERMANENTLY STABILIZED.

SEDIMENT FENCES SHALL BE INSPECTED BY APPLICANT/CONTRACTOR IMMEDIATELY AFTER EACH RAINFALL AND AT LEAST DAILY DURING PROLONGED RAINFALL. ANY REQUIRED REPAIRS SHALL BE MADE IMMEDIATELY.

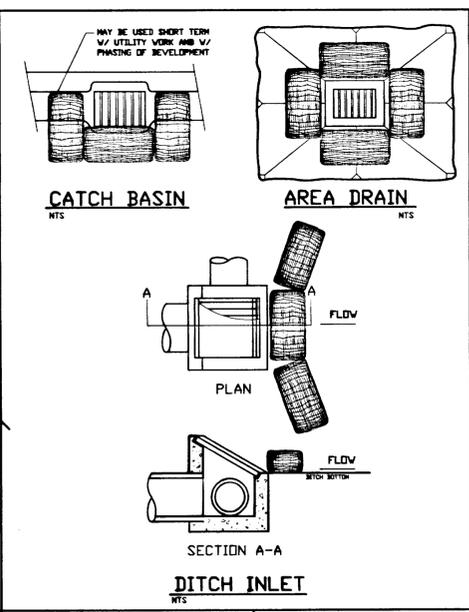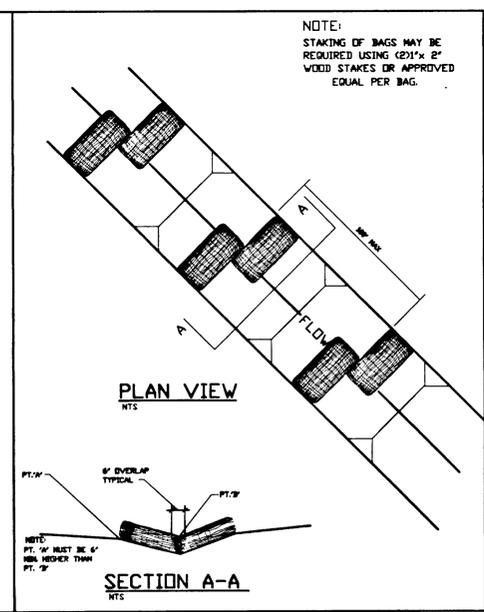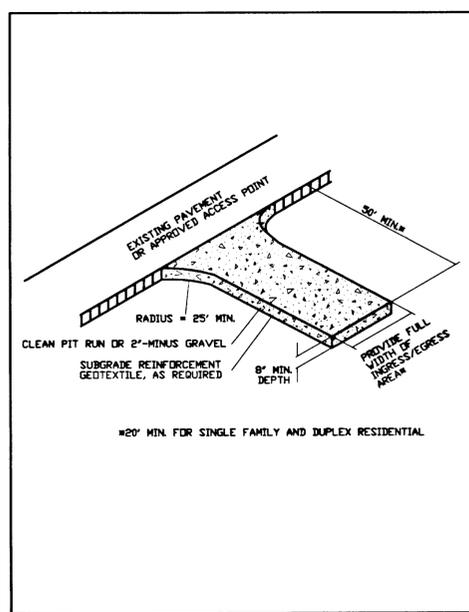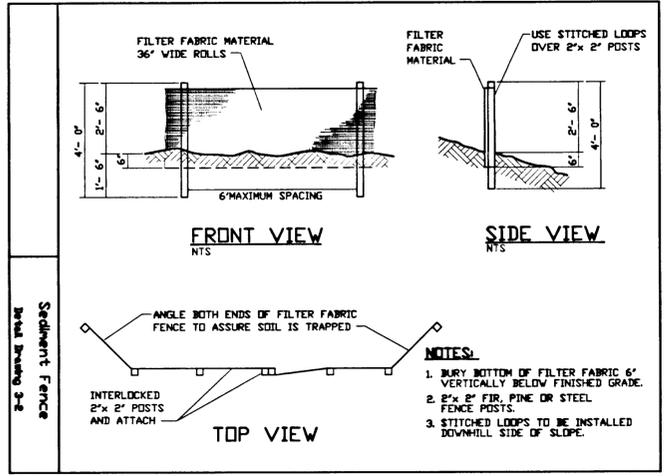

EROSION CONTROL MATRIX

EROSION MEASURES	SITE SITUATION													
	1	2	3	4	5	6	7	8	9	10	11	12	13	14
GRAVEL CONSTRUCTION ENTRANCE														
SEDIMENT FENCE/BARRIER AT TOE OF DISTURBED AREA OR STOCKPILE	X	X												
SIDEWALK SUBGRADE GRAVEL BARRIER (SITE SLOPES TO STREET AT <5% GRADE) ALTERNATE TO #2			A(2)											
UNDISTURBED BUFFER AT TOE OF DISTURBED AREAS (ALTERNATE TO #2) (SITE SLOPES <10%)				A(2)										
SEDIMENT FENCE OR BARRIER INSTALLED ON CONTOURS (SPACING)					X300'									
TEMP. INTERCEPTOR DIKES/SWALES AROUND ACTIVE WORK AREAS					X150'									
CHECK DAMS					X100'									
STORM DRAIN INLET PROTECTION BARRIER					X 50'									
6-MIL PLASTIC SHEET COVER					X 25'									
2'- MIN. STRAW MULCH COVER					X 25'									
ESTABLISH GRASS														
EROSION BLANKETS WITH ANCHORS														
SEDIMENT TRAP OR POND														
RE-ESTABLISH VEGETATION OR LANDSCAPE PRIOR TO REMOVAL OF EROSION CONTROL MEASURES														
SINGLE FAMILY/ DUPLEX RESIDENTIAL														
SLOPE <2%	X	X												
SLOPE >2%	X	X												
STOCK PILES														
COMMERCIAL, SUBDIVISION LARGE SITE CONSTRUCTION														
SITE SLOPE <2%	X	X												
SITE SLOPE <10%	X	X												
SITE SLOPE <15%	X	X												
SITE SLOPE <20%	X	X												
SITE SLOPE <30%	X	X												
SITE SLOPE <50%	X	X												
STOCK PILE SLOPE >50%	X	X												
UTILITIES CONSTRUCTION														
CATCH BASIN DRAINAGE														
DITCH DRAINAGE														
STOCK PILES														
STOCK PILES														
DITCHES/SWALES (CONSTRUCTION/PROTECTION)														
DITCHES/SWALES	X													

KEY: X = BASE MEASURE A = ALTERNATE TO BASE MEASURE INDICATED IN PARENTHESIS # = OPTIONAL BASE MEASURE CAN USE AS APPLICABLE

■ = SUPPLEMENTAL WET WEATHER MEASURE (NOVEMBER 1-APRIL 30) □ = ALTERNATE WET WEATHER MEASURE TO ■

KOSS REAL ESTATE
1098 S. ROSEMONT
WEST LINN, OR 97068
Phone: (503) 557-1144
Fax: (503) 557-1294

ROSEMONT SUMMIT II SUBDIVISION
PHASE B
CITY OF WEST LINN, OREGON

EROSION CONTROL NOTES AND DETAILS



17355 SW Boones Ferry Rd.
Lake Oswego, Oregon 97035
Phone: (503) 635-3618
FAX: (503) 635-5395

L9754

Project No. D754S05B

File No. S05B

Sheet No. Copyright 1999 ©

99 AS-BUILT
 DATE 10-26-01 BY S-AS

KOSS REAL ESTATE
 1038 S. ROSEMONT
 WEST LINN, OR 97068
 Phone: (503) 557-1144
 Fax: (503) 557-1294


ROSEMONT SUMMIT II SUBDIVISION
 PHASE B
 CITY OF WEST LINN, OREGON
 STREET AND STORM DRAIN PLAN



Incorporated
 17355 SW Boones Ferry Rd.
 Lake Oswego, Oregon 97035
 Phone: (503) 635-3618
 FAX: (503) 635-5395

L9754
 Project No.
 D754S06B
 File No.
S06B
 Sheet No.
 Copyright 1999

AS-BUILT DRAWINGS OCTOBER 26, 2001

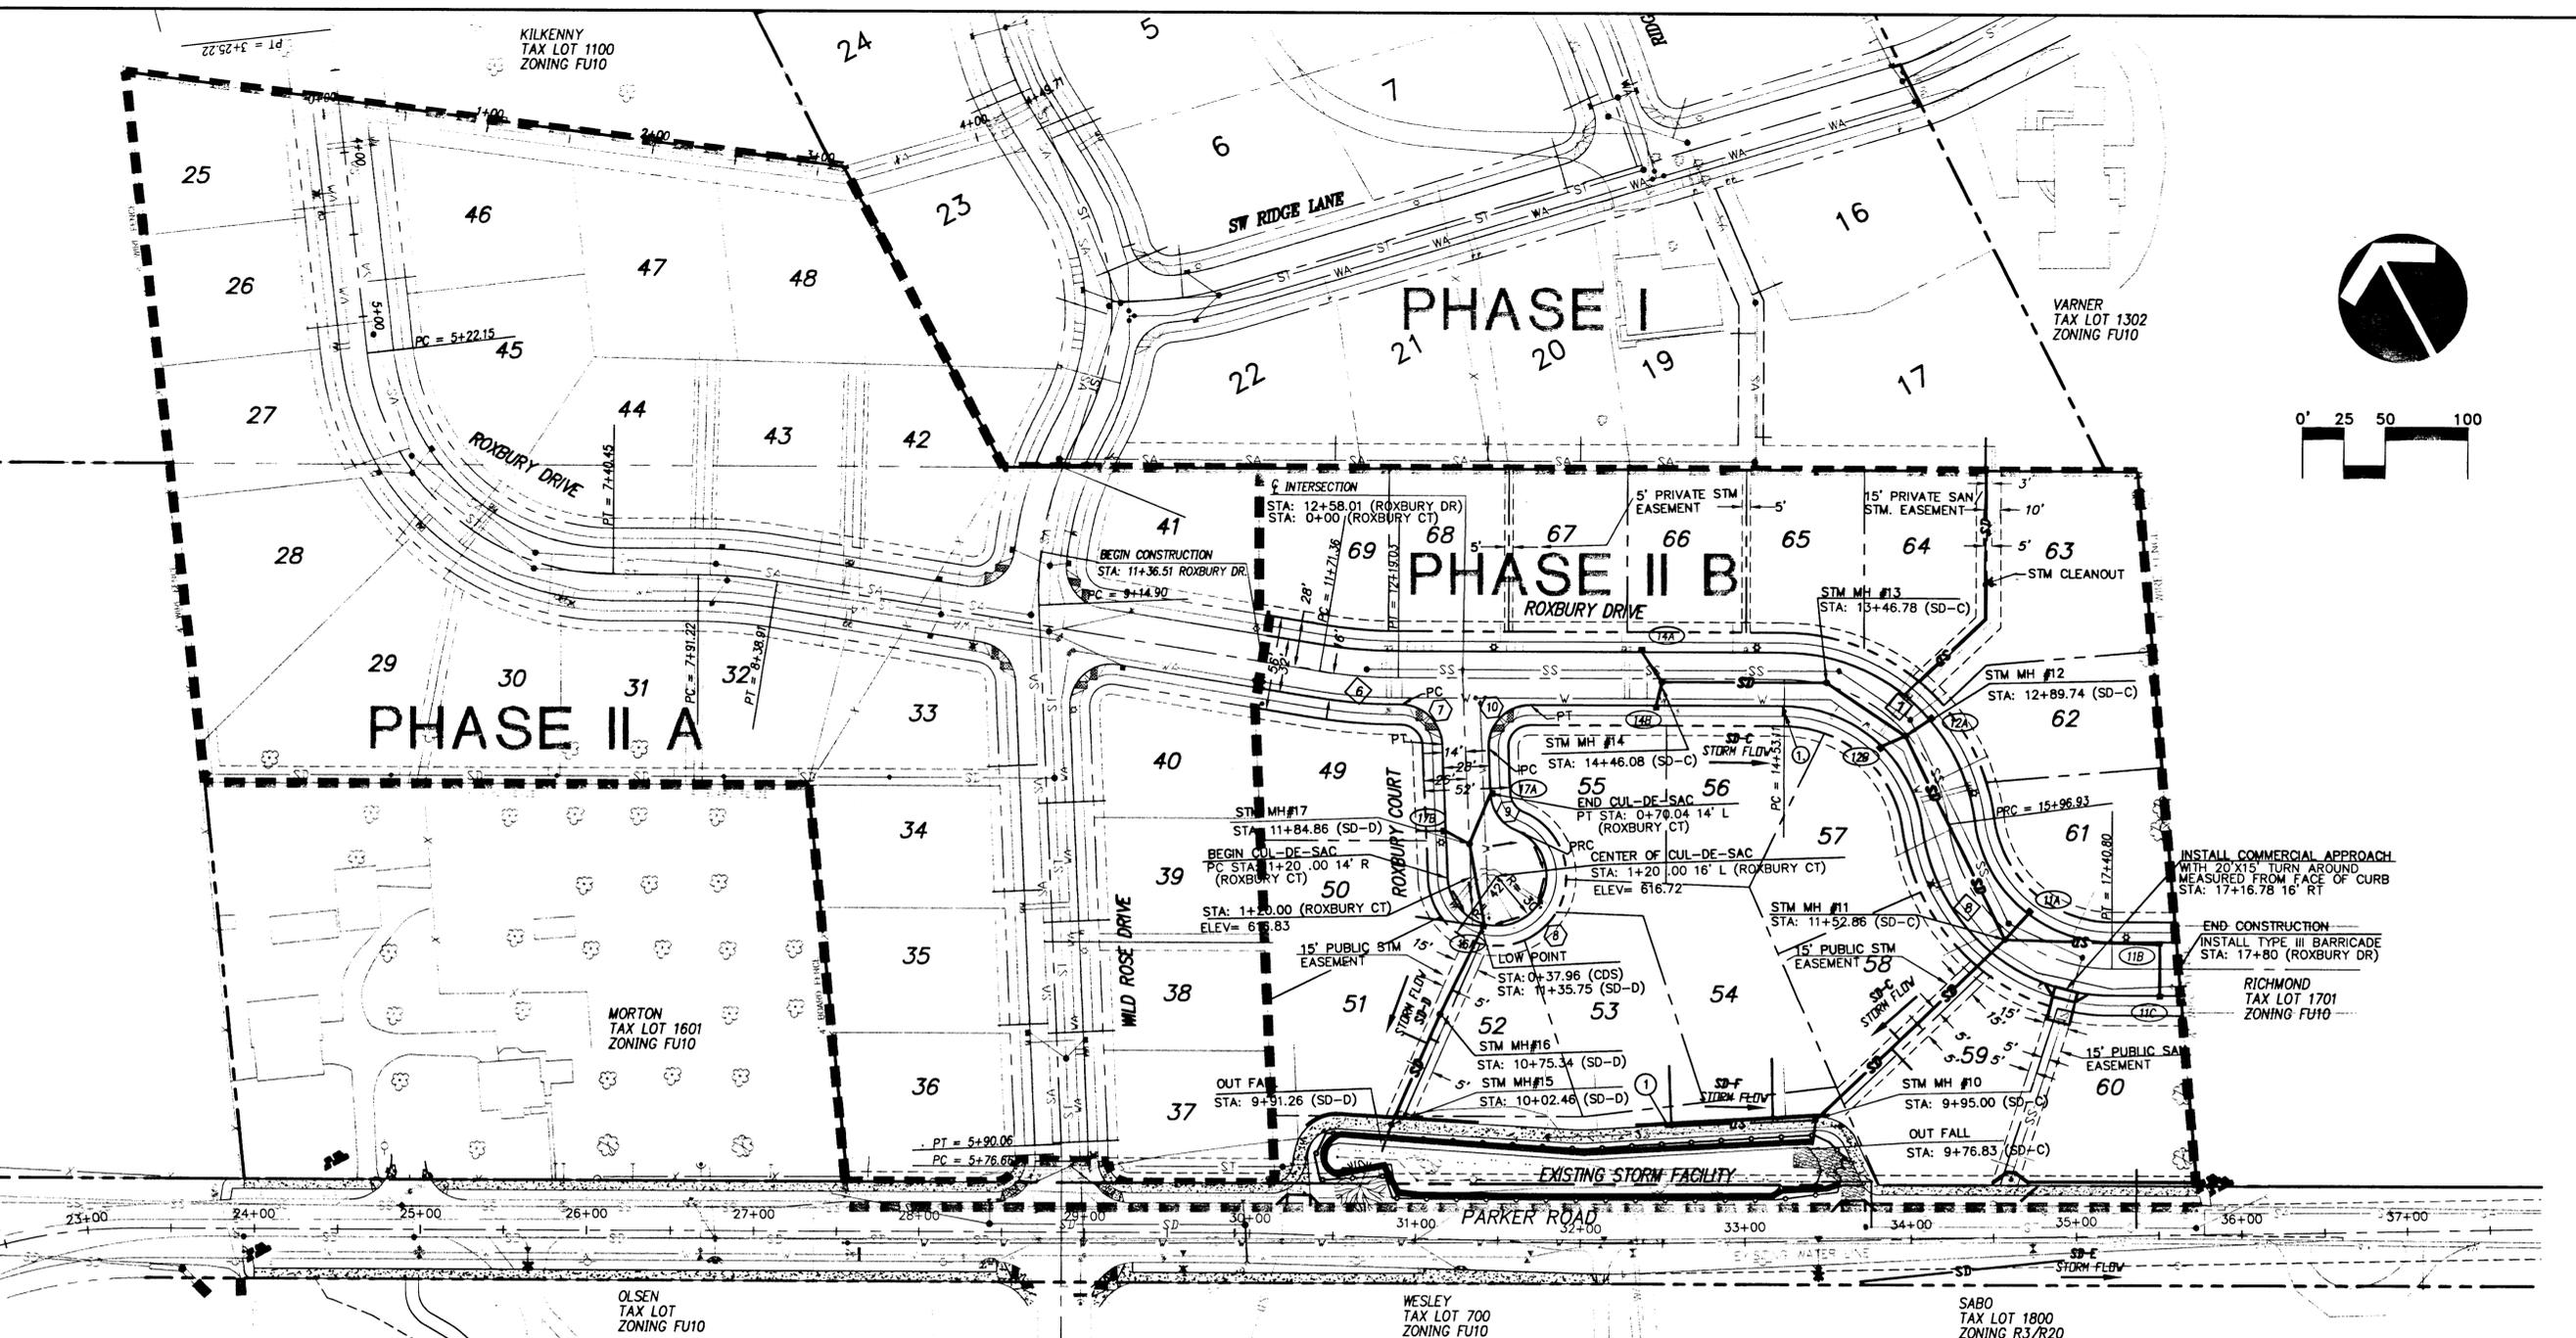

CURB INFORMATION (T.O.C ELEVATION)

- ⑦ PC AT STA: 12+20.83 16.00' R (ROXBURY DR)
 R = 25.00'
 L = 38.14'
 Δ = 87°24'50"
 PT AT STA: 0+39.28 14.00' R (ROXBURY CT)
- ⑩ PC AT STA: 0+42.80 14.00' L (ROXBURY CT)
 R = 25.00'
 L = 40.40'
 Δ = 92°35'10"
 PT AT STA: 12+98.90 16.00' R (ROXBURY DR)


CUL-DE-SAC INFORMATION

- ⑧ PC AT STA: 1+20.00 14.00' R (ROXBURY CT)
 R = 30.00'
 L = 128.43'
 Δ = 245°16'4"
 PRC AT STA: 0+92.75 28.55' L (ROXBURY CT)
- ⑨ PRC AT STA: 0+92.75 28.55' L (ROXBURY CT)
 R = 25.00'
 L = 28.48'
 Δ = 65°16'49"
 PT AT STA: 0+70.04 14.00' L (ROXBURY CT)

GUTTER INLET / CATCH BASIN INFORMATION

- ⑪A STA: 16+76.26 16.00' R TO FACE OF CURB (ROXBURY DR)
 TOC: 594.56
 IE IN: 589.30
 IE OUT: 582.25
 22 LF 10" STM
 S = 0.0057
 USE DETAIL WL-601
- ⑪B STA: 17+69.79 16.00' L TO FACE OF CURB (ROXBURY DR)
 TOC: 585.14
 IE IN: 582.30
 IE OUT: 582.25
 30.6 LF 10" DIP STM
 S = 0.0183
 USE DETAIL WL-601
- ⑪C STA: 17+69.79 16.00' R TO FACE OF CURB (ROXBURY DR)
 TOC: 585.05
 IE IN: 582.86
 IE OUT: 582.86
 30.6 LF 10" DIP STM
 S = 0.0183
 USE DETAIL WL-601
- ⑫A STA: 15+38.73 16.00' L TO FACE OF CURB (ROXBURY DR)
 TOC: 607.50
 IE OUT: 602.64
 19 LF 10" STM
 S = 0.0820
 USE DETAIL WL-601
- ⑫B STA: 15+30.41 16.00' R TO FACE OF CURB (ROXBURY DR)
 TOC: 608.16
 IE OUT: 602.45
 15 LF 10" STM
 S = 0.0532
 USE DETAIL WL-601
- ⑫A STA: 13+66.86 16.00' L TO FACE OF CURB (ROXBURY DR)
 TOC: 622.44
 IE OUT: 617.64
 22 LF 10" STM
 S = 0.1344
 USE DETAIL WL-601
- ⑫B STA: 13+66.86 16.00' L TO FACE OF CURB (ROXBURY DR)
 TOC: 622.44
 IE OUT: 617.64
 22 LF 10" STM
 S = 0.1344
 USE DETAIL WL-601
- ⑫A STA: 13+75.66 16.00' R TO FACE OF CURB (ROXBURY DR)
 TOC: 621.87
 IE OUT: 617.17
 14 LF 10" STM
 S = 0.1743
 USE DETAIL WL-601
- ⑫B STA: 13+75.66 16.00' R TO FACE OF CURB (ROXBURY DR)
 TOC: 621.87
 IE IN: 609.01
 IE OUT: 608.45
 USE DETAIL WL-601
- ⑫A STA: 0+37.96 (CUL-DE-SAC)
 TOC: 613.90
 IE IN: 609.01
 IE OUT: 608.45
 USE DETAIL WL-601
- ⑫B STA: 0+37.96 (CUL-DE-SAC)
 TOC: 613.90
 IE IN: 609.01
 IE OUT: 608.45
 USE DETAIL WL-601
- ⑫A STA: 0+70.04 14.00' L TO FACE OF CURB (ROXBURY CT)
 TOC: 623.74
 IE OUT: 617.70
 33 LF 10" STM
 S = 0.1489
 USE DETAIL WL-601
- ⑫B STA: 0+70.04 14.00' L TO FACE OF CURB (ROXBURY CT)
 TOC: 623.74
 IE OUT: 617.70
 33 LF 10" STM
 S = 0.1489
 USE DETAIL WL-601
- ⑫A STA: 0+91.56 14.00' R TO FACE OF CURB (ROXBURY CT)
 TOC: 620.50
 IE OUT: 618.00
 16 LF 10" STM
 S = 0.0745
 USE DETAIL WL-601
- ⑫B STA: 0+91.56 14.00' R TO FACE OF CURB (ROXBURY CT)
 TOC: 620.50
 IE OUT: 618.00
 16 LF 10" STM
 S = 0.0745
 USE DETAIL WL-601

LEGEND

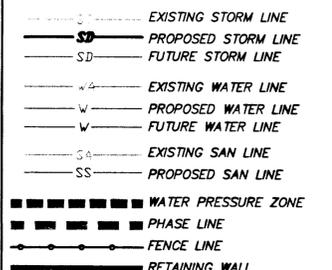

PRIVATE STORM SEWER CONSTRUCTION NOTES

- ① SD-F STA 0+90.66
 CLEANOUT
 RIM = 584.52, IE = 581.00

STORM MANHOLE TABLE

MH #	STM STATION	RIM	INVERT OUT	ALIGNMENT
10	9+95.00	584.47	579.00	SD-C
11	11+52.86	594.62	581.47	SD-C
12	12+89.74	607.48	601.43	SD-C
13	13+46.78	613.10	606.60	SD-C
14	14+46.08	621.51	614.61	SD-C
15	10+02.46	585.02	576.42	SD-D
16	10+75.34	615.60	608.63	SD-D
17	11+84.86	619.92	612.67	SD-D

CENTERLINE CURVE DATA








CURVE	RADIUS	LENGTH	TANGENT	DELTA
6	300.00	47.67	23.88	9°06'13"
7	100.00	143.82	87.55	82°24'11"
8	100.00	143.87	87.59	82°25'51"

STORM LATERAL TABLE

Lot No.	STORM Station	Length (L.F.)	Invert @ main	Slope	Invert @ end of lateral	Alignment
49	CB 17B	15	616.21	0.1288	618.18	SD-D
50	CB 16A	42	609.35	0.0890	613.00	SD-D
51	10+42	16	599.37	0.3810	605.39	SD-D
52	10+52	6	601.71	0.2934	603.19	SD-D
53	0+89	37	586.41	0.2598	595.97	SD-F
54	0+28	39	585.09	0.2366	594.20	SD-F
58	10+65	9	585.56	1.3978	598.00	SD-C
59	10+58	18	585.45	0.5457	595.00	SD-C
*60	35+37	35	562.87	0.1252	567.00	EX-STM

LOTS 55 - 57, AND 61 - 69, WILL ALL BE SERVICED BY WEEPHOLES FOR STORM CONNECTIONS.
 *LATERAL FOR LOT 60 IS TO BE CONSTRUCTED WITH PARKER RD.

MANUAL OF UNIFORM TRAFFIC CONTROL DEVICES (MUTCD)
 ① SPEED LIMIT 20 - MUTCD DETAIL #R2-1 (24" x 30")

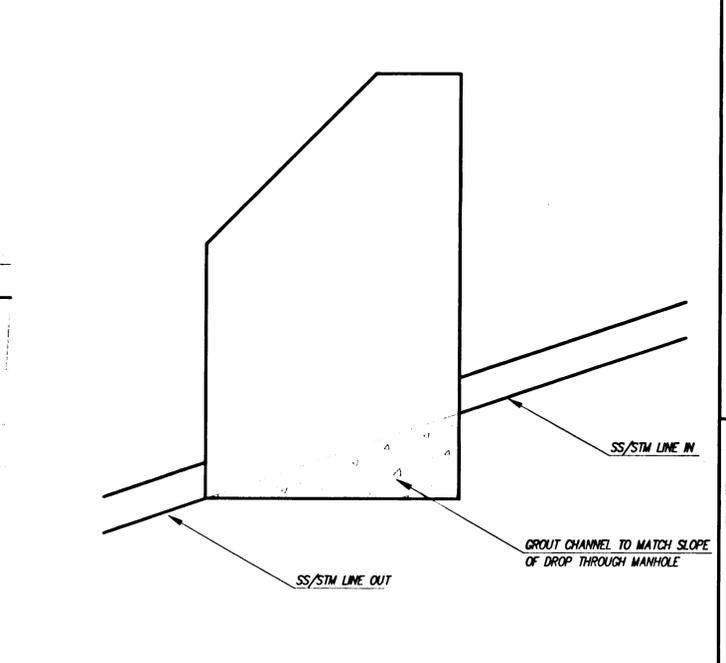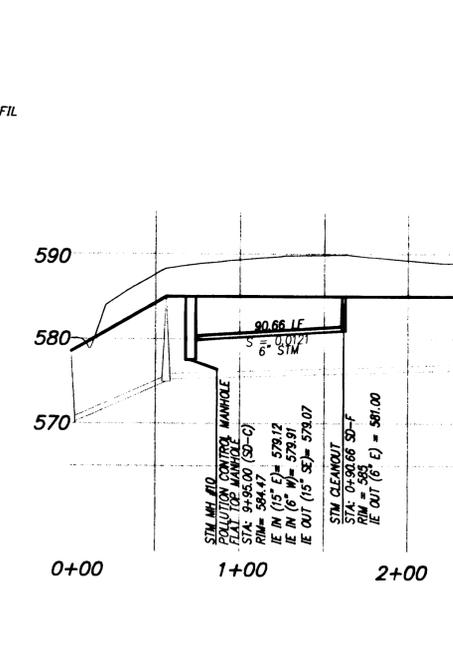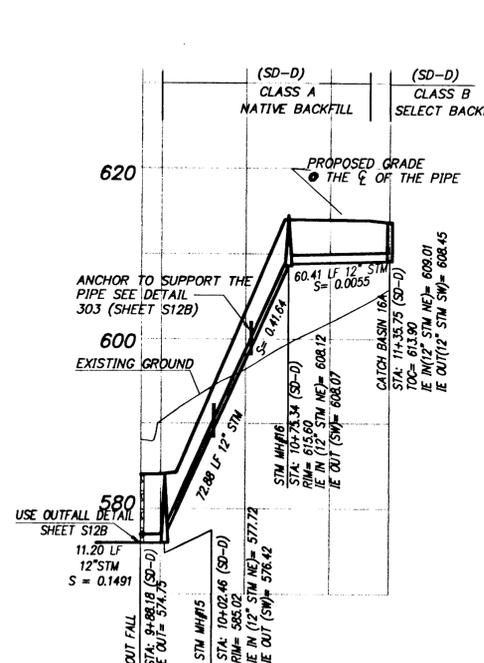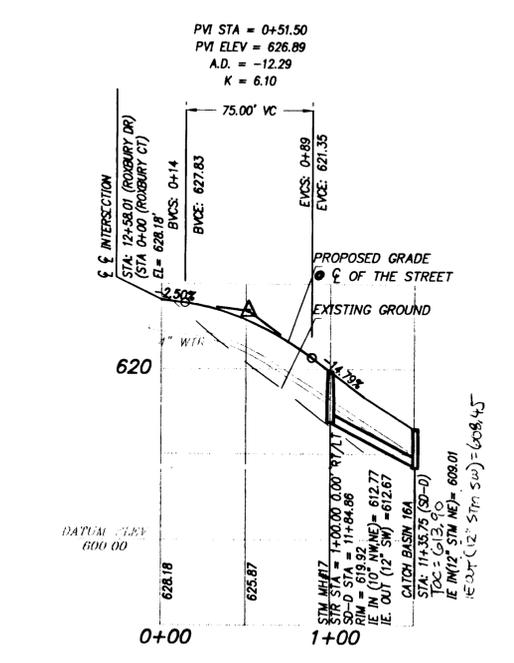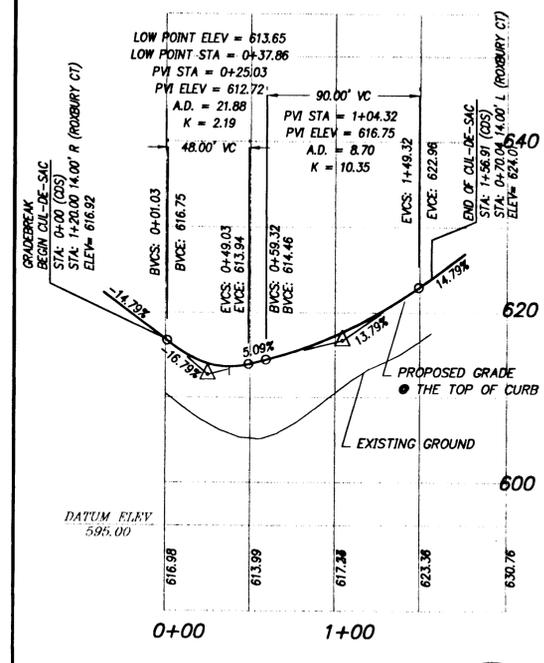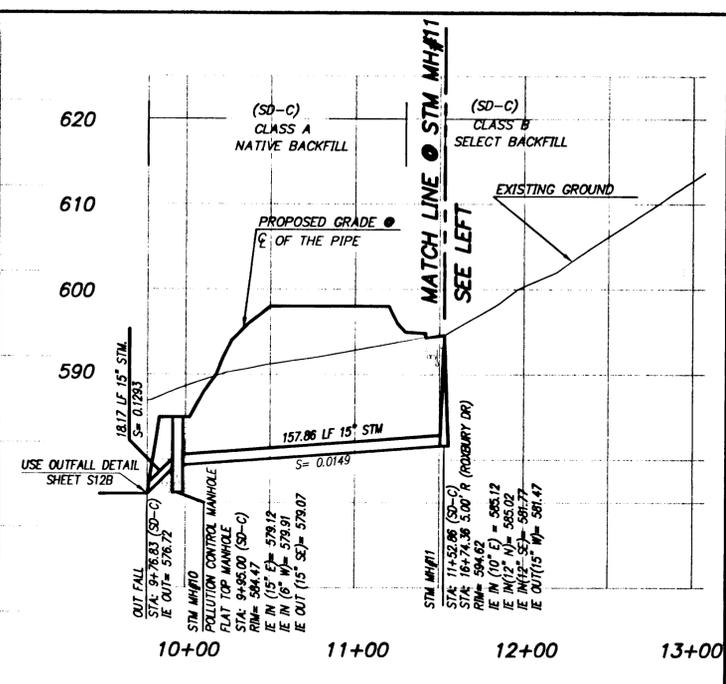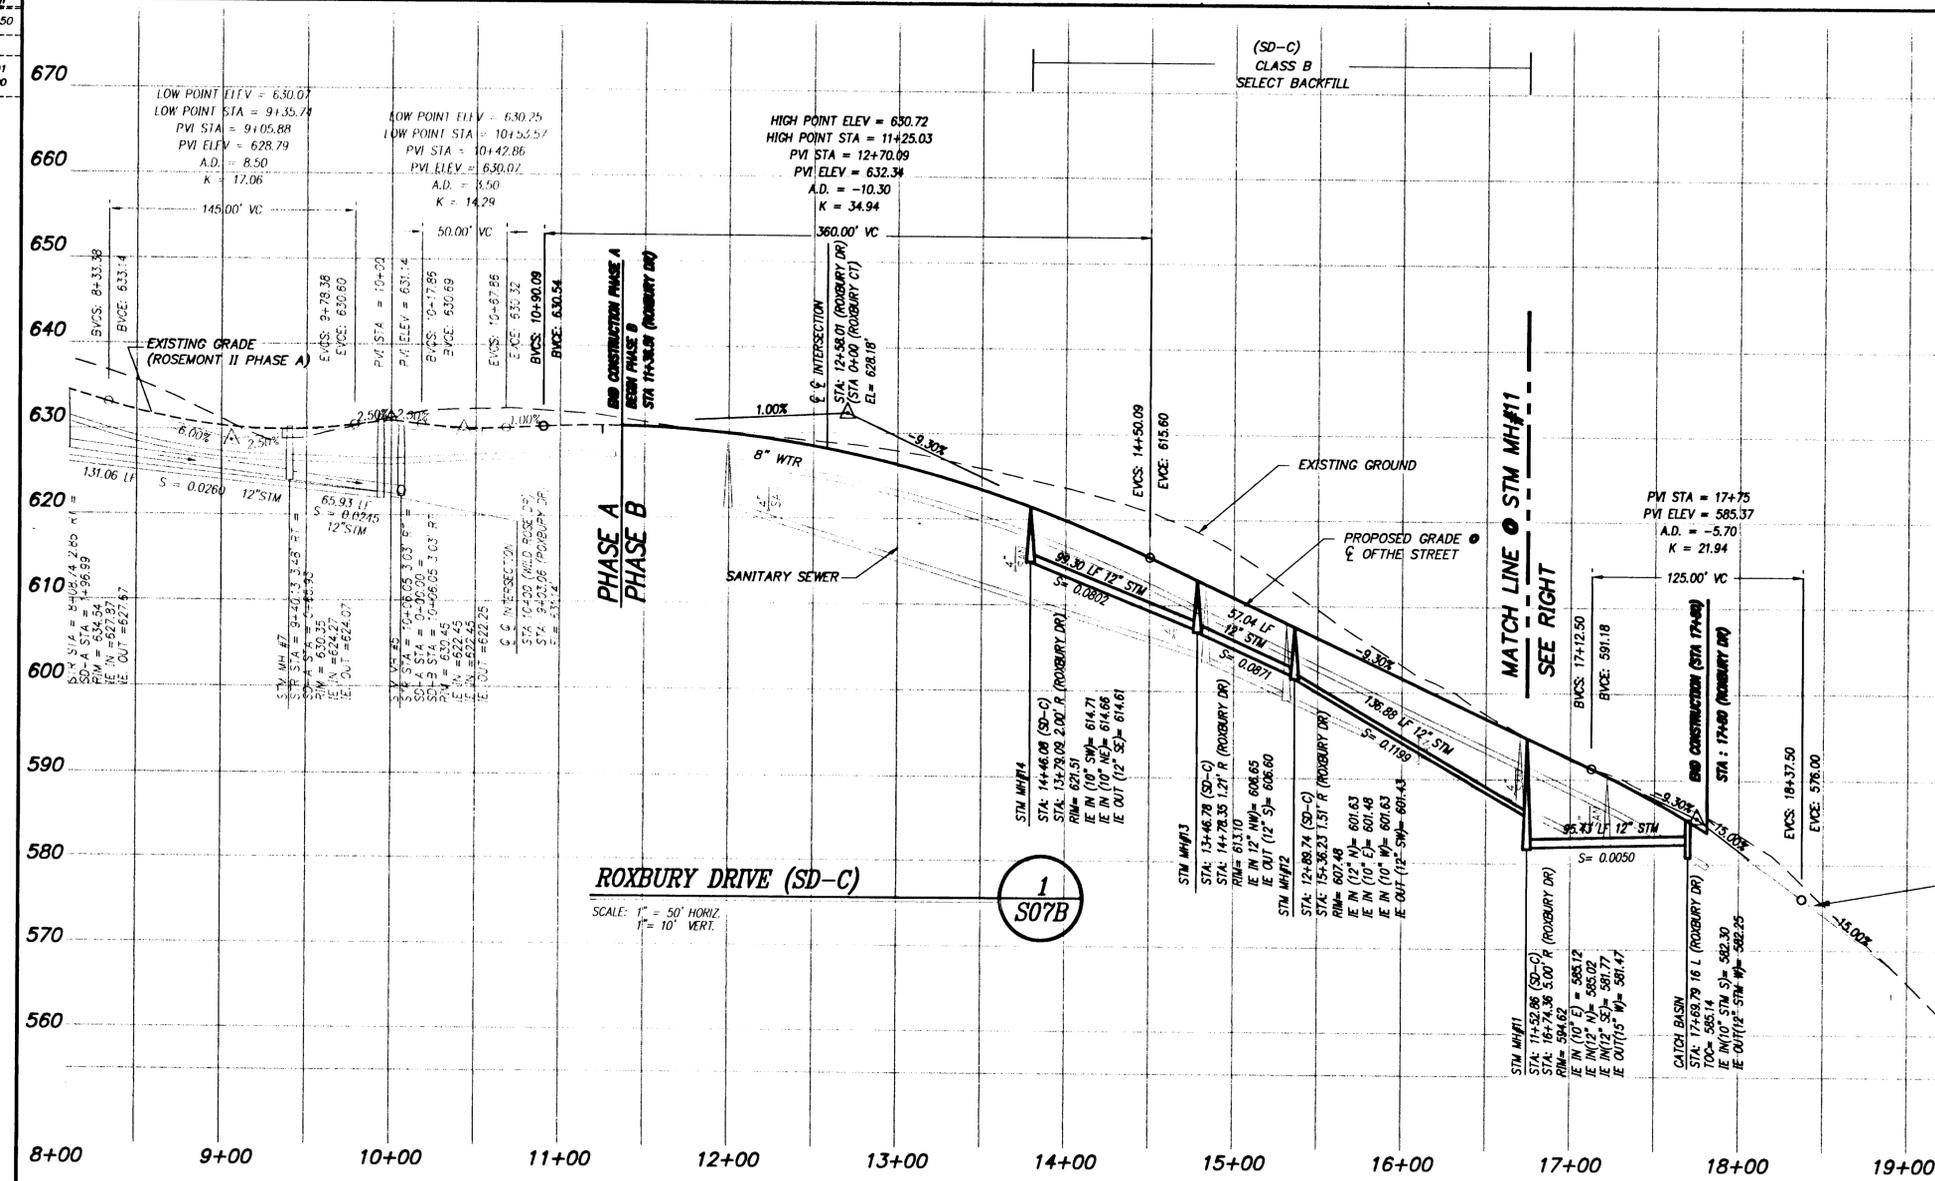

CUL-DE-SAC (TOP OF CURB)
 SCALE: 1" = 50' HORIZ.
 1" = 10' VERT.
 3 S07B

ROXBURY CT
 SCALE: 1" = 50' HORIZ.
 1" = 10' VERT.
 4 S07B

SD-D
 SCALE: 1" = 50' HORIZ.
 1" = 10' VERT.
 5 S07B

SD-F
 SCALE: 1" = 50' HORIZ.
 1" = 10' VERT.
 6 S07B

STEEP TRANSITION THROUGH MANHOLE
 SCALE: NO SCALE
 NO SCALE
 7 S07B

1/30/01
 Date
 Designed MFK
 Drawn RK / WJK
 Checked By Date



AS-BUILT '99
 DATE 10-26-01 BY SAS

KOSS REAL ESTATE
 1098 S. ROSEMONT
 WEST LINN, OR 97068
 Phone: (503) 557-1144
 Fax: (503) 557-1294

ROSEMONT SUMMIT II SUBDIVISION
 PHASE B
 CITY OF WEST LINN, OREGON
 STREET AND STORM DRAIN PROFILES



otak
 Incorporated
 17355 SW Boones Ferry Rd.
 Lake Oswego, Oregon 97035
 Phone: (503) 835-3618
 Fax: (503) 835-5395
 Project No. L9754
 File No. D754S07B
 Sheet No. S07B
 Copyright 1999 ©

AS-BUILT DRAWINGS OCTOBER 26, 2001

KOSS REAL ESTATE
 1098 S. ROSEMONT
 WEST LINN, OR 97068
 Phone: (503) 557-1144
 Fax: (503) 557-1294

ROSEMONT SUMMIT II SUBDIVISION
 PHASE B
 CITY OF WEST LINN, OREGON

otak
 Incorporated
 17355 SW Boones Ferry Rd.
 Lake Oswego, Oregon 97035
 Phone: (503) 635-3618
 FAX: (503) 635-5395

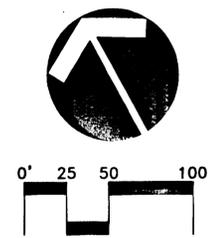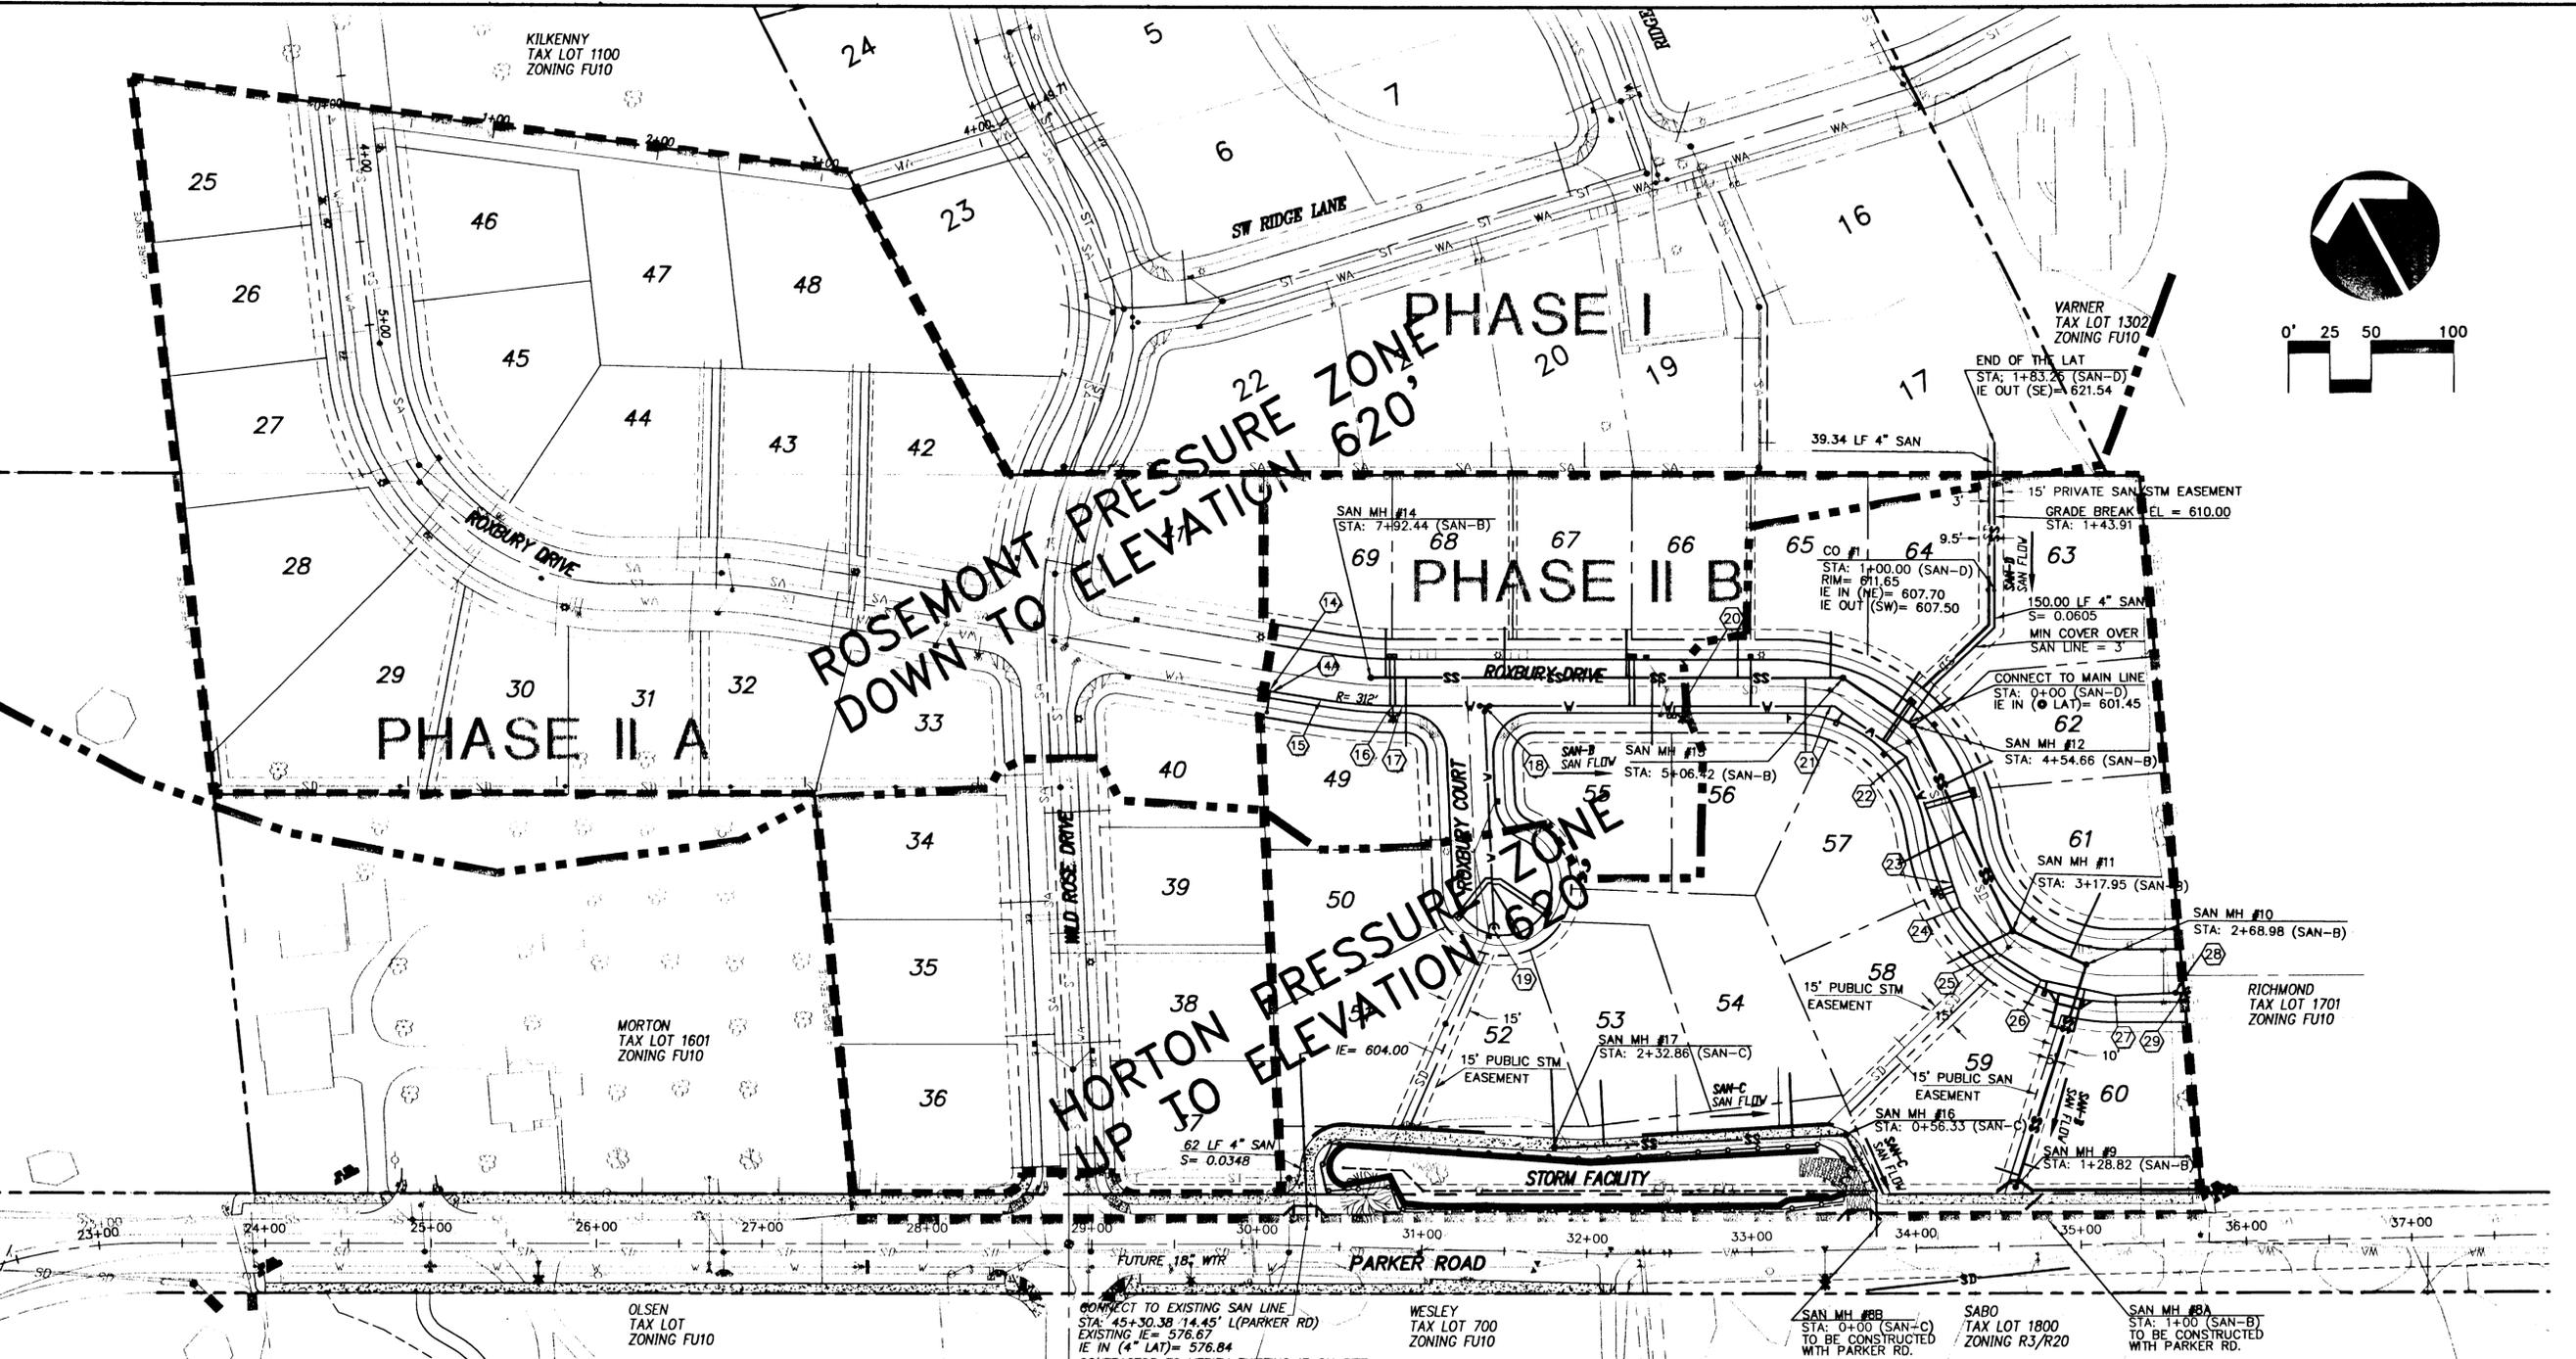


WATER LINE CONSTRUCTION NOTES
 WATER LINE STATION REFER TO ☉ OF THE STREET

- 14 STA: 11+40.12 12.00' R (ROXBURY DR)
CONNECT TO EXISTING WATER LINE
REMOVE BLOWOFF
- 14A STA: 11+42.12 25.00' R (ROXBURY DR)
INSTALL AIR RELEASE ASSEMBLY
- 15 WTR PC STA: 11+71.36 12.00' R (ROXBURY DR)
- 16 STA: 12+13.34 12.00' R (ROXBURY DR)
INSTALL FIRE HYDRANT
- 17 WTR PT STA: 12+19.03 12.00' R (ROXBURY DR)
- 18 STA: 12+68.57 12.00' R (ROXBURY DR)
INSTALL 8" 8'x 4" TEE WITH 2-8" AND 1-4"
GATE VALVES
- 19 STA: 1+46.00 10.11' LT (EXTENSION ROXBURY CT)
INSTALL BLOWOFF
- 20 STA: 13+88.59 12.00' R (ROXBURY DR)
INSTALL FIRE HYDRANT
- 21 STA: 14+83.46 7.79' R (ROXBURY DR)
INSTALL 1-11/25' BEND, 1-22/50' BEND
DEFLECT TO 34/33'05"
USE RESTRAINED JOINT IN ADDITION TO THRUST BLOCK
- 22 STA: 15+42.64 8.32' R (ROXBURY DR)
INSTALL 1-11/25' BEND, 1-22/50' BEND
DEFLECT TO 34/33'01"
USE RESTRAINED JOINT IN ADDITION TO THRUST BLOCK
- 23 STA: 16+21.04 8.15' R (ROXBURY DR)
INSTALL FIRE HYDRANT
- 24 STA: 16+39.28 10.86' R (ROXBURY DR)
INSTALL 22/50' BEND DEFLECT
TO 20/13/59"
- 25 STA: 16+71.16 12.00' R (ROXBURY DR)
INSTALL 22/50' BEND DEFLECT
TO 19/00'25"
- 26 STA: 16+99.24 12.00' R (ROXBURY DR)
INSTALL 22/50' BEND DEFLECT
TO 19/57'01"
- 27 STA: 17+40.80 12.00' R (ROXBURY DR)
INSTALL 11/25' BEND DEFLECT
TO 14/28'26"
- 28 STA: 17+77.09 10.37' R (ROXBURY DR)
INSTALL 8" GATE VALVE
- 29 STA: 17+82.42 10.13' R (ROXBURY DR)
INSTALL BLOWOFF

CONNECT TO EXISTING SAN LINE
 STA: 45+30.38 14.45' L (PARKER RD)
 EXISTING IE = 576.67
 IE IN (4" LAT) = 576.84
 CONTRACTOR TO VERIFY EXISTING IE ON SITE

LEGEND

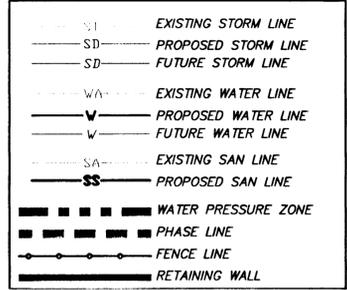

SAN MANHOLE TABLE

MH #	SEWER STATION	RIM	INVERT OUT	ALIGNMENT
8A	1+00.00	572.82	564.04	SAN-B
8B	0+00.00	578.54	569.69	SAN-C
9	1+28.82	576.36	570.71	SAN-B
10	2+68.98	590.15	580.75	SAN-B
11	3+17.95	595.11	585.86	SAN-B
12	4+54.66	607.89	598.29	SAN-B
13	5+06.42	612.34	603.14	SAN-B
14	7+92.44	629.90	620.70	SAN-B
16	0+56.33	584.29	574.49	SAN-C
17	2+32.86	584.42	575.67	SAN-C

SANITARY SEWER LATERAL TABLE
 Sanitary Sewer Line SAN-B

Lot No.	Sewer Station	Length (l.f.)	Invert @ main	Slope	Invert @ end of lateral
17	4+58	188	598.66	VARIES	621.54
49	7+69	41	619.26	.0505	621.33
50	2+75	138	595.89	.0588	604.00
55	6+22	40	610.23	.1943	618.00
56	5+29	43	604.52	.0807	607.99
57	3+84	45	591.86	.0880	595.82
58	MH #11	44	586.06	.0945	590.22
59	1+36	15	571.22	.0593	572.11
60	1+43	10	571.73	.1210	572.94
61	2+79	42	581.80	.1726	589.05
62	4+14	33	594.59	.1191	598.52
63	MH #12	28	598.49	.0989	601.26
64	4+69	29	599.63	.1093	602.80
65	5+14	28	603.60	.2286	610.00
66	5+70	29	607.04	.1707	611.99
67	6+38	28	611.22	.1214	614.12
68	7+11	30	615.70	.2100	622.00
69	7+83	29	620.12	.0721	622.21

SANITARY SEWER LATERAL TABLE
 Sanitary Sewer SAN-C

Lot No.	Sewer Station	Length (l.f.)	Invert @ main	Slope	Invert @ end of lateral
52	MH #17	47	579.32	.4928	599.03
53	2+2	39	575.47	.4638	593.56
54	0+88	39	574.70	.5603	596.55

99 AS-BUILT
 DATE 10-26-01 BY SAS

SANITARY SEWER AND WATER PLAN





L9754

Project No. D754S08B

File No. S08B

Sheet No. Copyright 1999

09/01/1999 8:43pm -> D754SC09.DWG

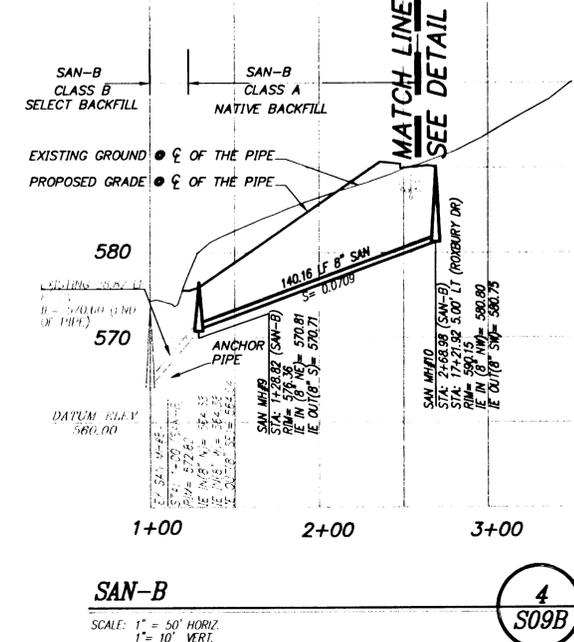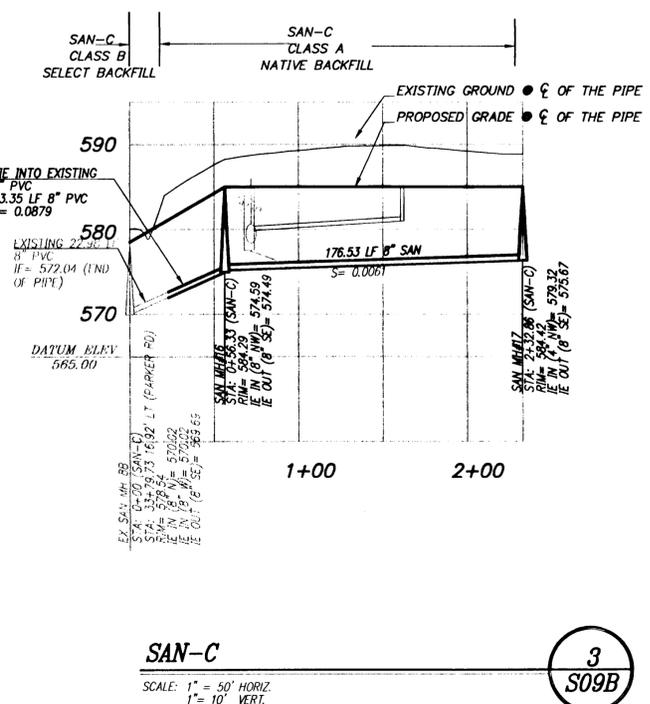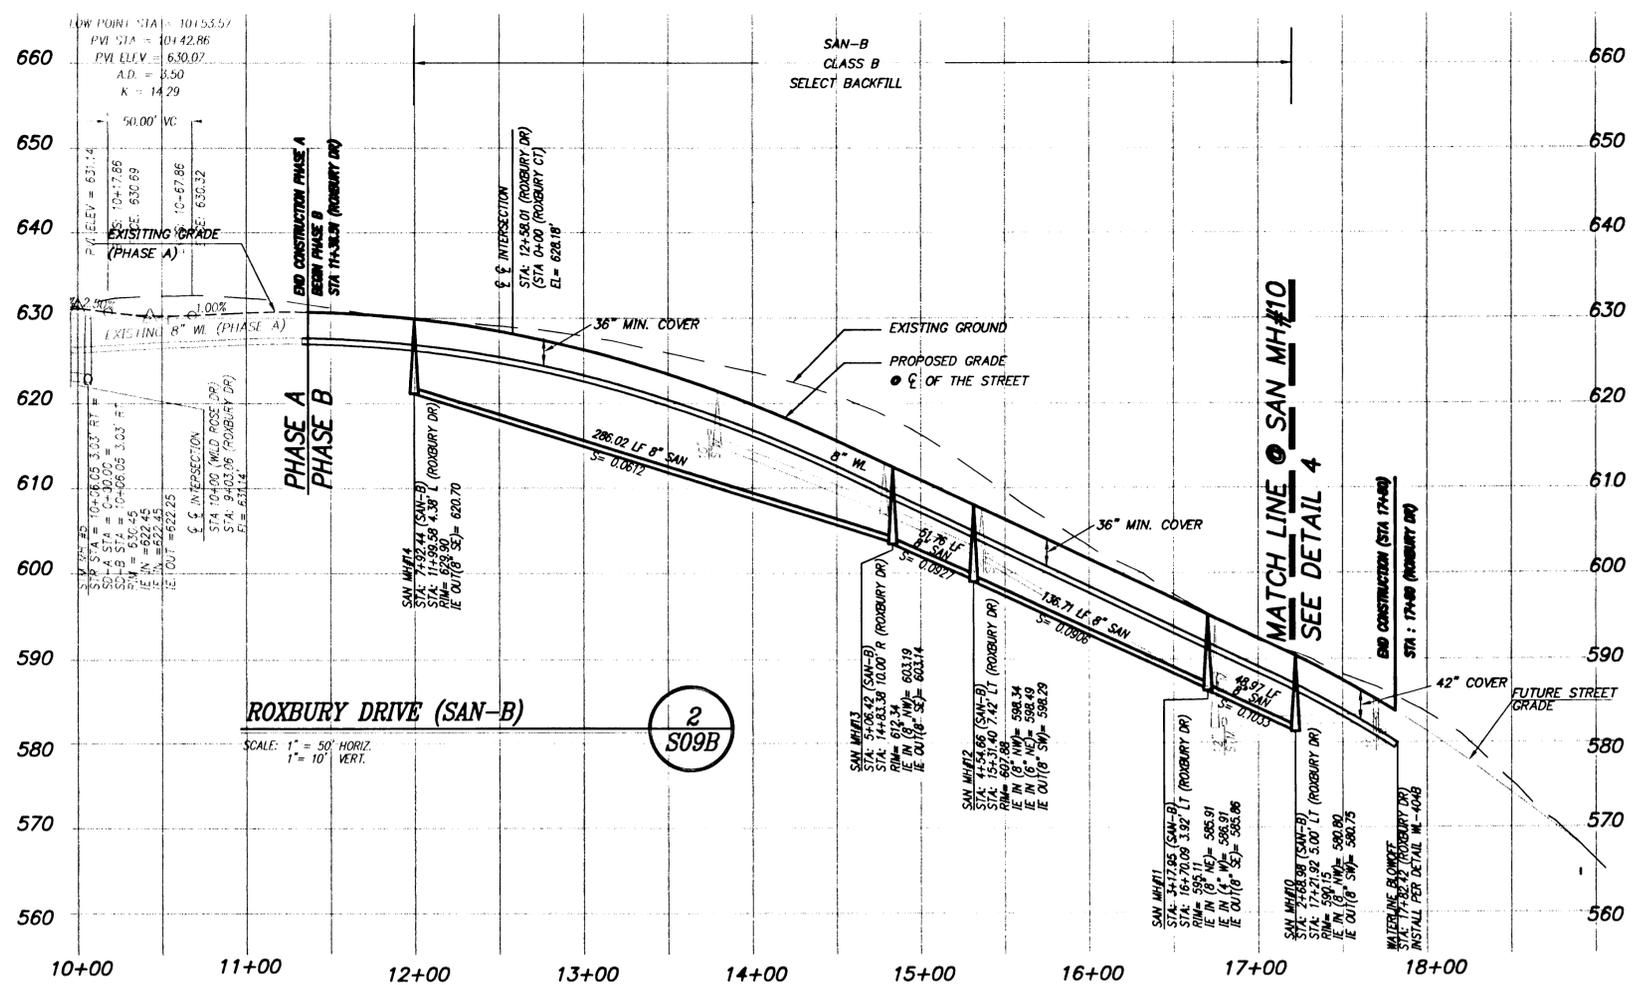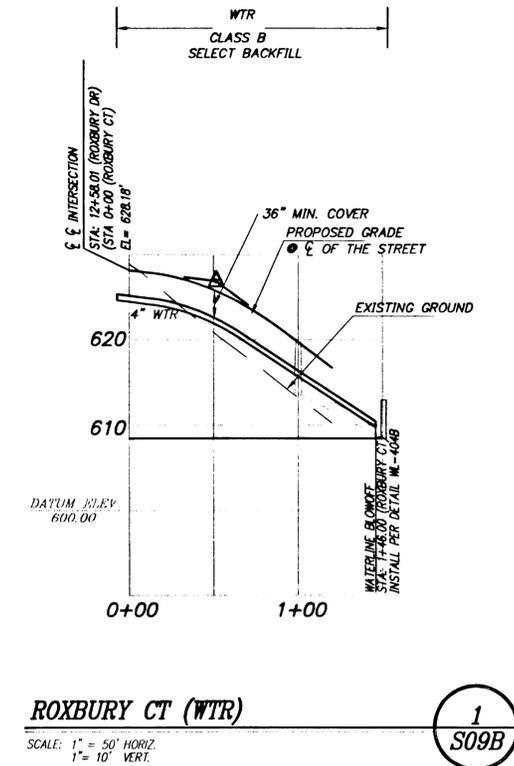


1/30/01
 Date
 MFK
 Designed
 RK / WJK
 Drawn
 Checked By Date
 REGISTERED PROFESSIONAL ENGINEER
 1747
 1997
 1998
 1999
 2000
 2001
 FEBRUARY 28, 1994
 K. FARES KERRIA
 EXPIRES JUNE 30, 2001

KOSS REAL ESTATE
 1098 S. ROSEMONT
 WEST LINN, OR 97068
 Phone: (503) 557-1144
 Fax: (503) 557-1294

99 AS-BUILT
 DATE 10-26-01 BY S-B5

ROSEMONT SUMMIT II SUBDIVISION
 PHASE B
 CITY OF WEST LINN, OREGON
 SANITARY SEWER AND WATER PROFILES

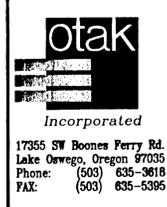

17055 SW Boones Ferry Rd.
 Lake Oswego, Oregon 97035
 Phone: (503) 635-3618
 FAX: (503) 635-5395

L9754
 Project No.
 D754S09B
 File No.
S09B
 Sheet No.
 Copyright 1999 ©

AS-BUILT DRAWINGS OCTOBER 26, 2001

1/30/01
 Date MFK
 Designed RK / WJK
 Drawn
 Checked By Date

KOSS REAL ESTATE
 1098 S. ROSEMONT
 WEST LINN, OR 97068
 Phone: (503) 557-1144
 Fax: (503) 557-1294


ROSEMONT SUMMIT II SUBDIVISION
 PHASE B
 CITY OF WEST LINN, OREGON
 DETAIL SHEET




17355 SW Boones Ferry Rd.
 Lake Oswego, Oregon 97035
 Phone: (503) 635-3618
 FAX: (503) 635-5395

L9754
 Project No. D754s12B
 File No. S12B
 Sheet No. Copyright 1999 ©

AS-BUILT DRAWINGS OCTOBER 26, 2001

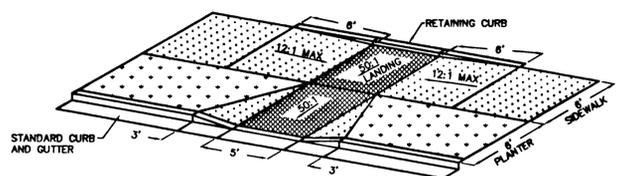

PARALLEL CURB RAMP

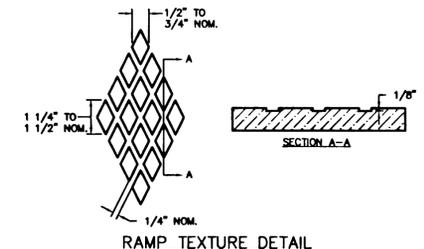


- NOTES:
1. THE AMERICANS WITH DISABILITIES ACT (ADA) REQUIRES THAT ACCESS RAMPS TO SIDEWALKS CONFORM TO ALL FEDERAL GUIDELINES. EXCEPTIONS TO THE REQUIREMENTS IN THIS DRAWING MUST BE APPROVED BY THE CITY ENGINEER AND MUST COMPLY WITH ADA.
 2. NO ABOVE GROUND UTILITIES ARE PERMITTED WITHIN RAMP AREA.
 3. LANDINGS SHALL BE PLACED AT THE TOP OF EACH RAMP. LANDING SLOPES SHALL NOT EXCEED 50:1 IN ANY DIRECTION. THE SLOPE OF THE SURFACING AT THE BOTTOM OF THE RAMP SHALL NOT EXCEED 20:1 FOR A DISTANCE OF 2' (SEE TYPICAL SECTION ABOVE).
 4. MINIMUM LANDING DIMENSIONS SHALL BE 4' X 4'.
 5. RAMP SURFACE SHALL BE TEXTURED WITH RAISED DIAMOND TEXTURE. TEXTURING SHALL BE DONE WITH AN EXPANDED METAL GRATE STAMPED INTO THE CONCRETE.
 6. CONCRETE STRENGTH SHALL BE 3300 PSI.


Parallel Curb Ramp

West Linn

DATE: JAN 2000
 DRAWING NO. WL-506
 FILE NO. 00-506

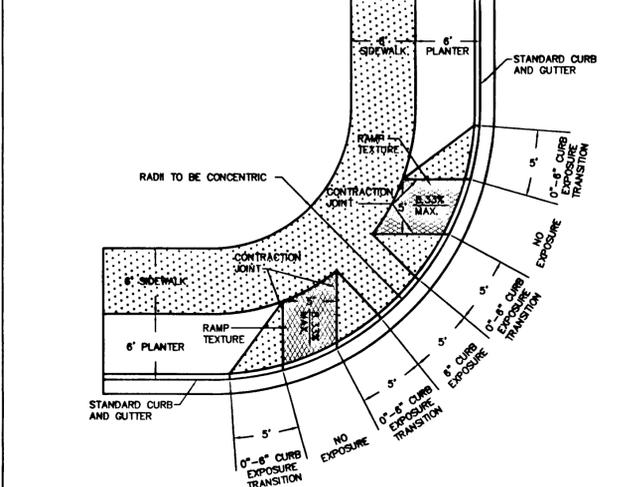


TWIN CURB RAMP

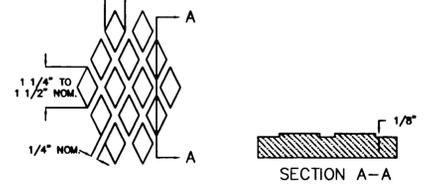


Twin Curb Ramp

West Linn

DATE: JAN 2000
 DRAWING NO. WL-507B
 FILE NO. 00-507B

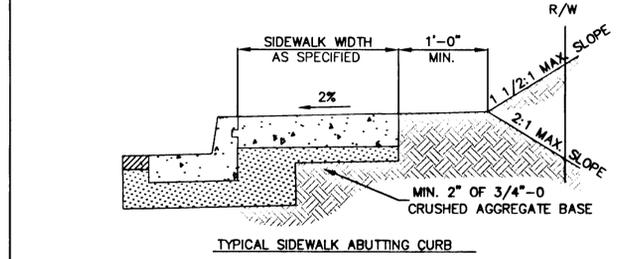

TYPICAL SIDEWALK ABUTTING CURB

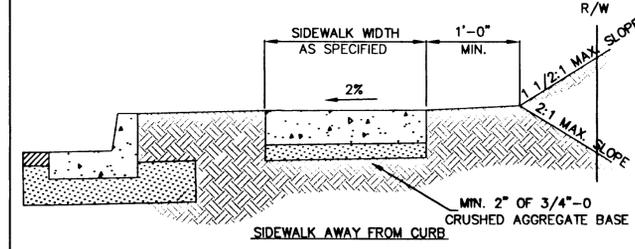


SIDEWALK AWAY FROM CURB

- NOTES:
1. CONCRETE SHALL BE 3300 PSI AT 28 DAYS, 6 SACK MIX, SLUMP RANGE OF 1 1/2" TO 3".
 2. PANEL LENGTHS SHALL BE EQUAL TO THE SIDEWALK WIDTH, BUT MAY BE ADJUSTED WITH THE CITY ENGINEER'S APPROVAL.
 3. CONTRACTION JOINTS (1/3RD OF THE THICKNESS OF CONCRETE) SHALL BE PLACED EVERY THIRD PANEL, WITH A MAX. SPACING OF 18 FEET. JOINTS SHALL ALSO BE PLACED AT THE SIDES OF DRIVEWAY APPROACHES, UTILITY VAULTS, AND WHEELCHAIR RAMPS.
 4. A CURING COMPOUND SHALL BE USED. WHITE REFLECTIVE SHEETING SHALL BE USED IN CASE OF RAIN.
 5. FOR SIDEWALKS ADJACENT TO THE CURB AND POURED AT THE SAME TIME AS THE CURB, THE JOINT BETWEEN THEM SHALL BE A TROWELED JOINT WITH A MIN. 1/2" RADIUS.
 6. THE SIDEWALK SHALL HAVE A MIN. THICKNESS OF 4" IF MOUNTABLE CURB IS USED OR IF THE SIDEWALK IS INTENDED AS A PORTION OF THE DRIVEWAY. OTHERWISE, THE SIDEWALK SHALL HAVE A MIN. THICKNESS OF 4".
 7. DRAIN BLOCKOUTS IN THE CURB SHALL BE EXTENDED TO THE BACK OF THE SIDEWALK WITH A 3" DIA. PLASTIC PIPE AT A 2% SLOPE. A CONTRACTION JOINT SHALL BE PLACED OVER THE PIPE.


Concrete Sidewalk Cross Section

West Linn

DATE: JAN 2000
 DRAWING NO. WL-508
 FILE NO. 00-508

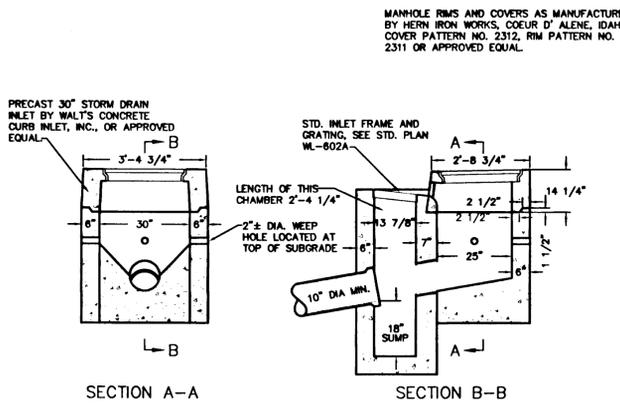


COMBINATION CURB INLET

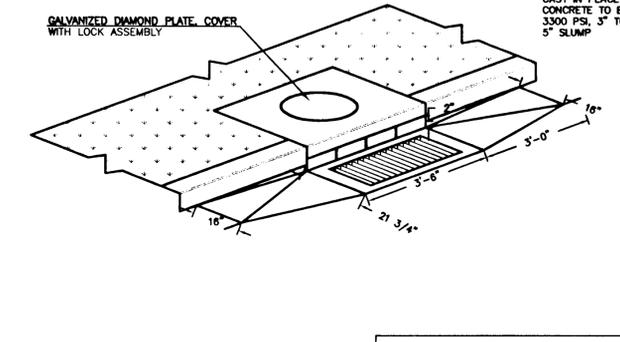


Combination Curb Inlet

West Linn

DATE: JAN 2000
 DRAWING NO. WL-601
 FILE NO. 00-601

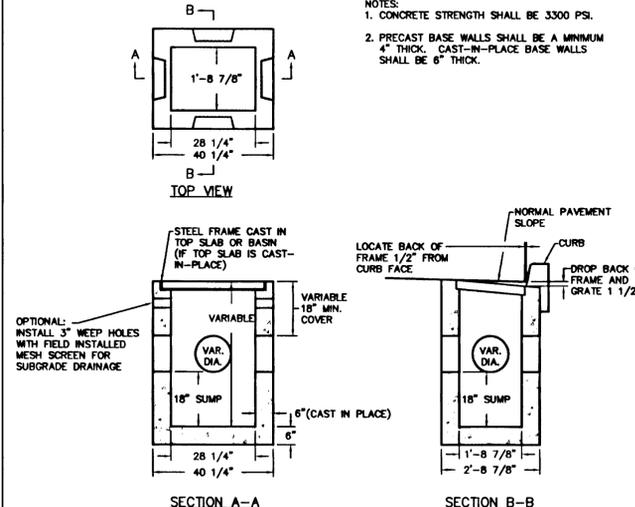

TYPE G-1 CATCH BASIN WITH SUMP

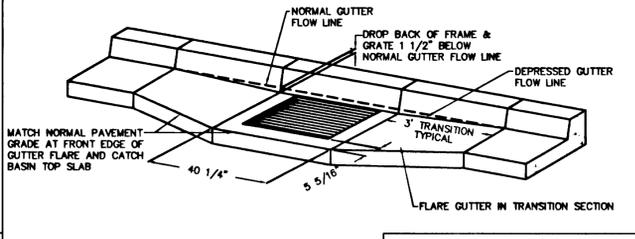

Frame & Grate for Gutter & Curb Inlets


West Linn

DATE: JAN 2000
 DRAWING NO. WL-602A
 FILE NO. 00-602A

Type G-1 Catch Basin with Sump

West Linn

DATE: JAN 2000
 DRAWING NO. WL-602
 FILE NO. 00-602

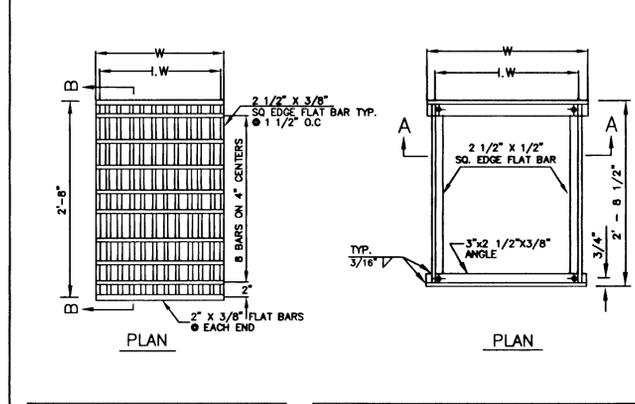

FRAME & GRATE FOR GUTTER & CURB INLETS

Frame & Grate for Gutter & Curb Inlets



West Linn

DATE: JAN 2000
 DRAWING NO. WL-602A
 FILE NO. 00-602A

Frame & Grate for Gutter & Curb Inlets

West Linn

DATE: JAN 2000
 DRAWING NO. WL-602A
 FILE NO. 00-602A

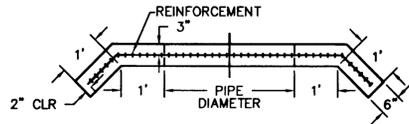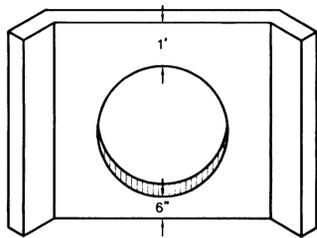


- NOTES:
- USE CONCRETE HAVING A 28 DAY DESIGN STRENGTH OF 3300 PSI.
 - OUTLET WING WALL SHALL BE USED FOR ALL OUTFALL PIPES FROM 10" TO 36".
 - THIS DETAIL REPRESENTS THE MINIMUM REQUIREMENT. THE NEED FOR ADDITIONAL STEEL, A FOOTING AND DRAINAGE BEHIND THE WALL SHALL BE INVESTIGATED BY THE DESIGN ENGINEER.
 - FOR PIPES LARGER THAN 33" OR MULTIPLE PIPE OUTLETS, USE DETAIL WL-612.
 - CONCRETE REINFORCEMENT SHALL CONSIST OF:
 - ADDING A POLY-FIBER MESH TO THE CONCRETE MIX OR
 - USE (2) #4 BARS ABOVE AND BELOW PIPE AND #4 BARS AT 6" O.C. VERTICALLY.

Outlet Headwall
(For Outlet Pipes of
10" to 33")

West Linn

DATE:	JAN 2000
DRAWING NO.	WL-613
FILE NO.	00-613


D = PIPE DIAMETER
W = BOTTOM WIDTH OF CHANNEL
P = WETTED PERIMETER OF CHANNEL

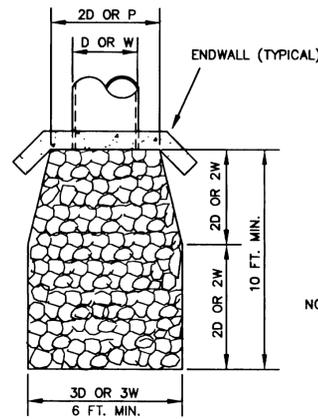

DESIGN VELOCITY FT./SEC	ROCK CLASSIFICATION BY WEIGHT
6 - 10	200 LBS.
10 - 12	1/4 TON
12 - 14	1/2 TON
14 - 16	1 TON
16 - 18	2 TON

SELECTION OF RIP RAP
(SEE NOTE 1)

- NOTES:
- DIMENSIONS FOR RIP RAP APPLY TO FLOWS < 2 CFS RIP RAP FOR FLOWS > 2 CFS MUST BE DESIGNED BY AN ENGINEER FLOWS > 20 FPS SHALL USE ENERGY DISSIPATOR
 - TYPE OF RIP RAP
 - REGULAR QUARRY STONE CLASS 50-200
 - COBBLESTONE
 - CONCRETE (ONLY ALLOWED UPON APPROVAL OF THE DISTRICT)
 - PLACEMENT
 - MINIMUM DEPTH = 1 1/2 TIMES AVERAGE STONE SIZE
 - ROCKS SHALL BE PLACED TO PROVIDE A MINIMUM OF VOIDS.
 - SURFACE ROCKS OR CONCRETE SHALL PROTRUDE AT LEAST 1/2 THEIR VERTICAL DIMENSION.
 - RIP RAP IS TO BE PLACED OVER A NATURAL BEDDING, OR IT MAY BE GROUTED OR PLACED OVER A GRAVEL BEDDING AS REQUIRED BY THE CITY.

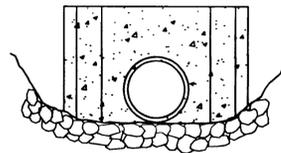

Storm Sewer Outfall

West Linn

DATE:	JAN 2000
DRAWING NO.	WL-614
FILE NO.	00-614

1/30/01
Date
MFK
Designed
RK / WJK
Drawn
Checked By Date

KOSS REAL ESTATE
1098 S. ROSEMONT
WEST LINN, OR 97068
Phone: (503) 557-1144
Fax: (503) 557-1294

ROSEMONT SUMMIT II SUBDIVISION
PHASE B
CITY OF WEST LINN, OREGON
DETAIL SHEET

otak
Incorporated
17355 SW Boones Ferry Rd.
Lake Oswego, Oregon 97035
Phone: (503) 635-3818
FAX: (503) 635-5395

L9754
Project No.
D754s13B
File No.
S13B
Sheet No.
Copyright 1999 ©