

VISTA RIDGE ESTATES SUBDIVISION OFF-SITE IMPROVEMENT PLANS WEST LINN, OREGON

| NO. | BY | DATE | DESCRIPTION |
|-----|-----|---------|-------------|
| 1 | JMB | 5/24/94 | AS-BUILT |
| 2 | JMB | 5/24/94 | PER CITY |

| | | | | | |
|-------------------|------------|--------------|---------------|---------------|---------------|
| Designed: JMB/JMB | Drawn: JMB | Checked: JMB | Approved: JMB | Date: 5/24/94 | Scale: 1"=40' |
|-------------------|------------|--------------|---------------|---------------|---------------|

KAMPE ASSOCIATES, INC.
PLANNING, ENGINEERING, ARCHITECTURE
18617 SW BRYANT ROAD
LAKE OSWEGO, OREGON 97036
(503) 635-8911 FAX (503) 635-5465

VISTA RIDGE DEVELOPMENT COMPANY
18617 SW BRYANT ROAD
LAKE OSWEGO, OREGON 97036

**VISTA RIDGE ESTATES
SUBDIVISION
OFF-SITE IMPROVEMENTS
COVER SHEET & INDEX**

GENERAL NOTES:

- ALL WORK AND MATERIALS TO BE IN ACCORDANCE WITH THE CITY OF WEST LINN DESIGN STANDARDS, O.S.H.D. AND A.P.W.A. OREGON CHAPTER SPECIFICATIONS.
- CONTRACTOR TO VERIFY ALL UTILITY LOCATIONS PRIOR TO CONSTRUCTION AND SHALL ARRANGE FOR THE RELOCATION OF ANY IN CONFLICT WITH THE PROPOSED CONSTRUCTION.
- CONTRACTOR TO OBTAIN ALL REQUIRED PERMITS AND LICENSES BEFORE STARTING CONSTRUCTION.
- EXISTING UTILITY LOCATIONS SHOWN ARE APPROXIMATE ONLY AND MUST BE VERIFIED BY THE CONTRACTOR. ADDITIONAL UNDERGROUND UTILITIES MAY EXIST.
- THE ENGINEER HAS NOT BEEN RETAINED OR COMPENSATED TO PROVIDE DESIGN AND CONSTRUCTION REVIEW SERVICES RELATING TO THE CONTRACTOR'S SAFETY PRECAUTIONS TO MEANS, METHODS, TECHNIQUES, SEQUENCES OR PROCEDURES REQUIRED FOR THE CONTRACTOR TO PERFORM HIS WORK.
- CONTRACTOR SHALL REMOVE AND DISPOSE OF TREES, STUMPS, BRUSH, ROOTS, TOPSOIL AND OTHER MATERIAL IN THE ROADWAY AND WHERE INDICATED ON THE PLANS. MATERIAL SHALL BE DISPOSED OF IN SUCH A MANNER AS TO MEET LOCAL REGULATIONS.

GENERAL EROSION CONTROL NOTES:

- APPROVAL OF THESE EROSION/SEDIMENTATION CONTROL (ESC) PLANS DOES NOT CONSTITUTE AN APPROVAL OF PERMANENT ROAD OR DRAINAGE DESIGN (E.G., SIZE AND LOCATION OF ROADS, PIPES, RESTRICTIONS, CHANNELS, RETENTION FACILITIES, UTILITIES, ETC.).
- THE IMPLEMENTATION OF THESE ESC PLANS AND THE CONSTRUCTION, MAINTENANCE, REPLACEMENT, AND UPGRADING OF THESE ESC FACILITIES IS THE RESPONSIBILITY OF THE APPLICANT/CONTRACTOR, UNTIL ALL CONSTRUCTION IS COMPLETED AND APPROVED AND VEGETATION/LANDSCAPING IS ESTABLISHED.
- THE ESC FACILITIES SHOWN ON THIS PLAN MUST BE CONSTRUCTED IN CONJUNCTION WITH ALL CLEARING AND GRADING ACTIVITIES, AND IN SUCH A MANNER AS TO ENSURE THAT SEDIMENT-LOADED WATER DOES NOT ENTER THE DRAINAGE SYSTEM OR VIOLATE APPLICABLE WATER STANDARDS.
- THE ESC FACILITIES SHOWN ON THIS PLAN ARE THE MINIMUM REQUIREMENTS FOR ANTICIPATED SITE CONDITIONS. DURING THE CONSTRUCTION PERIOD, THESE ESC FACILITIES SHALL BE UPGRADED, AS NEEDED, FOR UNEXPECTED STORM EVENTS AND TO ENSURE THAT SEDIMENT-LOADED WATER DOES NOT LEAVE THE SITE.
- THE ESC FACILITIES SHALL BE INSPECTED DAILY BY THE APPLICANT/CONTRACTOR AND MAINTAINED, AS NECESSARY, TO ENSURE THEIR CONTINUED FUNCTIONING.
- THE ESC FACILITIES ON INACTIVE SITES SHALL BE INSPECTED AND MAINTAINED A MINIMUM OF ONCE A MONTH, OR WITHIN THE 48 HOURS FOLLOWING A STORM EVENT.
- AT NO TIME SHALL MORE THAN ONE-FOOT OF SEDIMENT BE ALLOWED TO ACCUMULATE WITHIN A TRAPPED CATCH BASIN. ALL CATCH BASINS AND CONVEYANCE LINES SHALL BE CLEANED PRIOR TO PAVING. THE CLEANING OPERATION SHALL NOT FLUSH SEDIMENT-LOADED WATER INTO THE DOWNSIDE SYSTEM.
- STABILIZED CONSTRUCTION ENTRANCES SHALL BE INSTALLED AT THE BEGINNING OF CONSTRUCTION AND MAINTAINED FOR THE DURATION OF THE PROJECT. ADDITIONAL MEASURES MAY BE REQUIRED TO ENSURE THAT ALL PAVED AREAS ARE KEPT CLEAN FOR THE DURATION OF THE PROJECT.
- CUT AND FILL SLOPES SHALL BE GROOVED BY DRIVING A CRAWLING TRACTOR AND CUTTING FURROWS ALONG SLOPE CONTOURS TO CATCH RAIN WATER AND PROVIDE COVERAGE OF FERTILIZER AND SEED.

ROAD & STORM SEWER NOTES:


- ALL WORK AND MATERIALS TO CONFORM TO 1990 EDITION OREGON CHAPTER A.P.W.A. AND THE CITY OF WEST LINN DEPT. OF PUBLIC WORKS DESIGN STANDARDS.
- CONTRACTOR TO OBTAIN ALL REQUIRED PERMITS AND LICENSES PRIOR TO STARTING CONSTRUCTION.
- CONTRACTOR SHALL NOTIFY KAMPE ASSOCIATES, INC. AND THE CITY OF WEST LINN DEPARTMENT OF ENGINEERING 48 HOURS BEFORE STARTING CONSTRUCTION, OR 24 HOURS BEFORE RESUMING WORK AFTER SHUTDOWNS, EXCEPT FOR NORMAL RESUMPTION OF WORK FOLLOWING SATURDAYS, SUNDAYS, OR HOLIDAYS. CONTRACTOR SHALL NOTIFY KAMPE ASSOCIATES, INC. OF ANY SHUTDOWNS, SO AS TO ELIMINATE UNNECESSARY INSPECTION TIME.
- ALL CONCRETE MANHOLES SHOWN ON THE PLAN ARE 48 INCHES MINIMUM DIAMETER AND CONFORM TO CITY OF WEST LINN STANDARDS. MANHOLE EXTENSION RINGS SHALL BE LIMITED TO A MAXIMUM OF TWELVE INCHES TOTAL HEIGHT.
- CONCRETE CULVERT PIPE SHALL BE ASTM C14, CLASS 3, NON-REINFORCED CONCRETE PIPE. PVC PIPE SHALL CONFORM TO ASTM 3034, SDR 35 SPECIFICATIONS. CAP SHALL CONFORM TO ASTM 305.2.02.
- EXCESS EXCAVATION TO BE SPREAD AND COMPACTED EVENLY ON LOTS, AS DIRECTED BY OWNER. VEGETATION AND TOPSOIL TO BE STRIPPED OFF FILL AREAS PRIOR TO FILLING. (95% COMPACTION, AASHTO T99).
- ALL TRENCH EXCAVATION SHALL CONFORM TO A.P.W.A. DIVISION III, SECTION 301.1.01, AND SHALL BE UNCLASSIFIED. ALL EXCESS MATERIAL FROM THE TRENCH EXCAVATION SHALL BE DISPOSED OF ON-SITE.
- PIPE BEDDING SHALL CONFORM WITH GRANULAR BEDDING AND BACKFILL REQUIREMENTS OF A.P.W.A. DIVISION III, SECTION 301.2.02 AND SHALL BE 3/4"-0" CRUSHED ROCK.
- TRENCHES WITHIN THE RIGHT-OF-WAYS SHALL BE "CLASS B" BACKFILL WITH SELECT GRANULAR MATERIAL CONFORMING TO CITY OF WEST LINN STANDARDS AND SHALL BE 3/4"-0" CRUSHED ROCK.
- COMPACTION SHALL BE PER A.P.W.A. DIVISION III, SECTION 301.3.07. CONTRACTOR TO DETERMINE TYPE OF EQUIPMENT AND METHOD TO USE TO ACHIEVE REQUIRED COMPACTION.
- TRENCH BACKFILL OUTSIDE OF PAVED AREAS MAY BE EXCAVATED TRENCH MATERIAL CONFORMING TO "CLASS A", PER CITY OF WEST LINN STANDARDS.
- MATERIAL IN SOFT SPOTS WITHIN THE ROADWAY SHALL BE REMOVED TO THE DEPTH REQUIRED TO PROVIDE A FIRM FOUNDATION AND SHALL BE REPLACED WITH 1-1/2"-0" CRUSHED ROCK. THE ENTIRE SUBGRADE SHALL BE COMPACTED TO 92% OF MAXIMUM RELATIVE DENSITY, PER AASHTO T99. MOISTURE CONTENT SHALL BE + 2% OF OPTIMUM.
- CONTRACTOR SHALL NOTIFY THE ENGINEER WHEN SUBGRADE IS COMPLETE AND 24 HOURS PRIOR TO PLACEMENT OF ROCK BASE MATERIAL AND 24 HOURS PRIOR TO FINAL PAVING FOR AN INSPECTION OF THE WORK. FAILURE TO DO SO WILL MAKE ANY SUBGRADE FAILURE OR DRAINAGE PROBLEMS THE RESPONSIBILITY OF THE CONTRACTOR.
- ASPHALT CONCRETE PAVEMENT MIX TO BE DESIGNED FROM A MIX FORMULA APPROVED BY O.S.H.D. FOR MATERIAL USED. CONTRACTOR TO PROVIDE ENGINEER WITH CERTIFICATE OF COMPLIANCE FROM ASPHALT PAVEMENT PLANT, UNLESS OTHERWISE INDICATED.
- ALL HOUSE SERVICE STUBOUTS TO BE A MINIMUM OF 3" INTO PROPERTY AND/OR BEYOND EASEMENT LINE AND TO BE MARKED (STORM SERVICE) WITH A 2" X 4" FOR FUTURE LOCATION. SERVICE STUBOUTS TO BE 6" DIAMETER PIPE.

SANITARY SEWER NOTES:

- ALL WORK AND MATERIALS TO CONFORM TO 1990 EDITION OREGON CHAPTER A.P.W.A. AND THE CITY OF WEST LINN DEPARTMENT OF PUBLIC WORKS DESIGN STANDARDS.
- CONTRACTOR TO OBTAIN ALL REQUIRED PERMITS AND LICENSES PRIOR TO STARTING CONSTRUCTION.
- CONTRACTOR SHALL NOTIFY KAMPE ASSOCIATES, INC. AND THE CITY OF WEST LINN DEPARTMENT OF ENGINEERING 48 HOURS BEFORE STARTING CONSTRUCTION, OR 24 HOURS BEFORE RESUMING WORK AFTER SHUTDOWNS, EXCEPT FOR NORMAL RESUMPTION OF WORK FOLLOWING SATURDAYS, SUNDAYS, OR HOLIDAYS. CONTRACTOR SHALL NOTIFY KAMPE ASSOCIATES, INC. OF ANY SHUTDOWNS, SO AS TO ELIMINATE UNNECESSARY INSPECTION TIME.
- ALL CONCRETE MANHOLES SHOWN ON THE PLAN ARE 48 INCHES MINIMUM DIAMETER AND CONFORM TO CITY OF WEST LINN STANDARDS. MANHOLE EXTENSION RINGS SHALL BE LIMITED TO A MAXIMUM OF TWELVE INCHES TOTAL HEIGHT.
- ALL P.V.C. SEWER PIPE SHALL CONFORM TO ASTM D3034, SDR 35 SPECIFICATIONS AND SHALL BE CLEARLY MARKED AS SUCH.
- PIPE BEDDING SHALL BE AS PER A.P.W.A. DIVISION III, SECTION 301.2.02, AND SHALL BE 3/4"-0" CRUSHED ROCK.
- TRENCH BACKFILL SHALL BE "CLASS A", PER CITY OF WEST LINN STANDARDS, ON ALL SEWER LINES OUTSIDE PUBLIC RIGHT-OF-WAYS OR OUTSIDE OF PAVED AREAS. TRENCH BACKFILL SHALL BE "CLASS B", PER CITY OF WEST LINN STANDARDS, IN ALL PUBLIC RIGHT-OF-WAY OR PAVED AREAS IN THE PROJECT.
- TRENCH BACKFILL COMPACTION SHALL BE AS PER A.P.W.A. DIVISION III, SECTION 301.3.07. CONTRACTOR TO DETERMINE TYPE OF EQUIPMENT AND METHOD TO USE TO ACHIEVE THE REQUIRED COMPACTION.
- CONTRACTOR SHALL PREPARE A PRINT FOR THE ENGINEER, SHOWING AS-CONSTRUCTED DATA.
- ALL SEWER LINES ARE TO BE AIR TESTED, PER SECTION 400.0603 OF THE CITY OF WEST LINN STANDARDS. ALL MANHOLES THAT REQUIRE HYDROSTATIC TESTING SHALL BE TESTED, IN ACCORDANCE WITH SECTION 200.0603 OF THE CITY OF WEST LINN STANDARDS.
- ALL HOUSE SERVICE STUBOUTS TO BE A MINIMUM OF 3" INTO PROPERTY AND/OR BEYOND EASEMENT LINE AND TO BE MARKED (SANITARY SERVICE) WITH A 2" X 4" FOR FUTURE LOCATION. SERVICE STUBOUTS TO BE 4" DIAMETER PIPE.
- ENGINEER RESERVES THE RIGHT TO ADJUST GRADES OR MOVEMENT TO ACCOMMODATE OTHER UTILITIES, AS REQUIRED; SUCH ADJUSTMENTS SHALL BE REVIEWED BY U.S.A. AND APPROVED PRIOR TO COMMENCING WORK.
- ALL P.V.C. SEWER PIPE SHALL CONFORM TO ASTM D3034, SDR 35 SPECIFICATIONS AND SHALL BE CLEARLY MARKED AS SUCH.
- ALL MANHOLES LOCATED IN UNIMPROVED EASEMENTS SHALL BE WATERTIGHT AND PROVIDED WITH TAMPER-PROOF LIDS.

WATER SYSTEM NOTES:

- NOTIFY CITY OF WEST LINN (656-4212), 48 HOURS PRIOR TO STARTING CONSTRUCTION, TO SET UP A PRE-CONSTRUCTION MEETING.
- CONTRACTOR TO VERIFY ALL UTILITY LOCATIONS, PRIOR TO CONSTRUCTION AND SHALL COORDINATE WATERLINE INSTALLATION WITH OTHER UTILITIES.
- ALL WORK AND MATERIALS SHALL COMPLY WITH CITY OF WEST LINN STANDARDS, THE OREGON STATE HEALTH DIVISION ADMINISTRATIVE RULES, CHAPTER 33, A.W.W.A. AND A.P.W.A. STANDARDS.
- ALL WORK WILL BE INSPECTED AND APPROVED BY CITY OF WEST LINN.
- ALL PIPE SHALL BE "TYTON JOINT", CLASS 52 DUCTILE IRON. ALL PIPE AND FITTINGS SHALL BE CEMENT LINES.
- FIRE HYDRANT ASSEMBLY INCLUDES 8" MAX 6" FLG TEE, 6" FLG X MJ GATE VALVE, 6" MAX MJ HOLDING SPOOL, FIRE HYDRANT, 6" MJ, 5-1/4" M.V.O. 3 PORT (TWO 2-1/2" NST HOSE CONNECTIONS, ONE 4-1/2" NST PUMPER CONNECTION), 1-1/2" OPERATING NUT, OPEN LEFT, YELLOW COLOR, RODDA #2202.
- FIRE HYDRANT TO BE INSTALLED UPON A PREFORMED CONCRETE BLOCK, WITH 1-1/2" CUBIC YARDS OF CRUSHED 1 1/2" DRAIN ROCK. ROCK TO BE COVERED WITH TAR PAPER TO SEPARATE IT FROM NATIVE BACKFILL.
- ALL TEES, BENDS AND BLOW-OFF LOCATIONS TO HAVE A POURED-IN-PLACE CONCRETE THRUST BLOCK, CONFORMING TO CHART SHOWN ON DETAILS SHEET.
- ALL WATER MAINS TO HAVE A MINIMUM COVER OF 36" FROM FINISH GRADE.
- PIPE BEDDING SHALL BE AS PER A.P.W.A. DIVISION III, SECTION 301.2.02 AND SHALL BE 3/4"-0" CRUSHED ROCK.
- TRENCH BACKFILL SHALL BE "CLASS B", PER CITY OF WEST LINN STANDARDS, IN ALL PUBLIC RIGHT-OF-WAYS OR PAVED AREAS IN THE PROJECT.
- ALL SANITARY SEWER LINES WITHIN 10' LATERALLY OR 3' VERTICALLY OF WATER MAIN TO BE ENCASED IN CONCRETE.
- ANY CROSSING OF WATER MAIN BY SANITARY SEWER SHALL BE MADE AT APPROXIMATELY 90° AND HAVE 18" OF VERTICAL CLEARANCE.
- ALL MAINS TO BE TESTED, PER CITY OF WEST LINN STANDARDS.
- ALL COPPER SERVICES TO BE INSTALLED BY THE CONTRACTOR, PRIOR TO PROOF ROLL OF SUBGRADE.
- ALL MAINS SHALL BE CLEANED AND FLUSHED WITH POTABLE WATER, PRIOR TO DISINFECTION AND BACTERIOLOGICAL TESTING, IN ACCORDANCE WITH A.W.W.A. STANDARDS 0601, AND PRIOR TO CONNECTION TO THE CITY WATER SYSTEM.

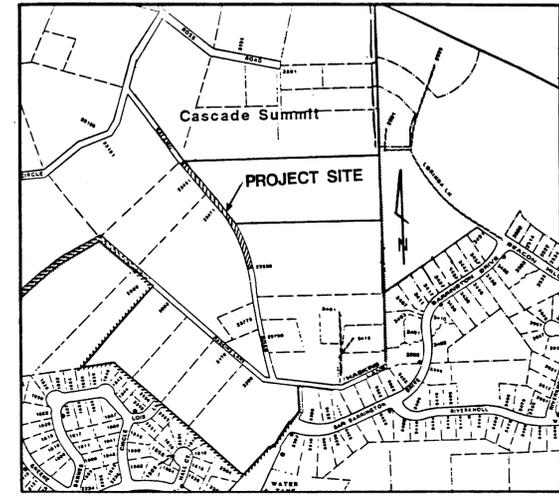

VICINITY MAP
SHEET INDEX

- COVER SHEET & INDEX
- SALAMO ROAD STREET & STORM IMPROVEMENTS PLAN & PROFILE
- 18' LEFT & RIGHT PROFILES
- GRADING & EROSION CONTROL PLAN
- DETAILS



LEGEND

(ALL ITEMS MAY NOT BE USED - EXISTING FEATURES ARE SHADED)

| | |
|--|------------------------------|
| • DENOTES FOUND MONUMENT AS NOTED | CO* PROPOSED CLEANOUT |
| ○ SEWER MANHOLE | SS SEWER LINE |
| □ STORM MANHOLE | ST STORM LINE |
| □ CATCH BASIN | ○ PROPOSED CATCH BASIN |
| □ IRRIGATION VALVE | □ PROPOSED MANHOLE |
| □ FIRE HYDRANT | □ PROPOSED FIRE HYDRANT |
| — W WATER LINE | — CURB |
| — WM WATER METER | — RETAINING WALL |
| — WV WATER VALVE | — EDGE OF PAVEMENT |
| — G GAS LINE | — BRUSH/TREE LINE |
| — GM GAS METER | — DITCH/CREEK |
| — GV GAS VALVE | — PROPERTY LINE |
| — UGT UNDERGROUND TELEPHONE LINE | — PROPOSED PROPERTY LINE |
| — TP TELEPHONE PEDESTAL | — GUARDRAIL |
| — TM TELEPHONE MANHOLE | — SIGN POST |
| — FLG FLASHING YELLOW GROUND LIGHT | — PROPOSED SIGN POST |
| — SCB SIGNAL CONTROL BOX | — CULVERT |
| — SP SIGNAL POLE - PEDESTRIAN CROSSING LIGHT | — MAILBOX |
| — UGP UNDERGROUND POWER LINE | — FENCE |
| — OHP OVERHEAD POWER LINE | — CONCRETE GARBAGE CONTAINER |
| — P POWER PEDESTAL | — DEODOROUS TREE |
| — UP UTILITY POLE | — EVERGREEN TREE |
| — QA GUY ANCHOR | — CONCRETE PAVEMENT |
| — R REMOVE | — F FILL TO CATCH POINT |
| — L RELOCATE | — C CUT TO CATCH POINT |

BENCHMARKS:
BENCH MARK: CITY OF WEST LINN BENCH MARK "B" IS 93.5' EAST AND 17.0' SOUTH OF EDGE OF PAVEMENT FROM 5-WAY INTERSECTION OF ROSEMONT/DAY/SANTA ANITA 3" CAP ON PIPE WITH YELLOW WATER WORKS LID. ELEV = 667.22

AS BUILT
THESE AS-BUILT PLANS ARE BASED ON PERIODIC FIELD OBSERVATIONS. TO THE BEST OF MY KNOWLEDGE, INFORMATION, AND BELIEF, THE REPRESENTATIONS SHOWN HEREON ARE TRUE AND ACCURATE.

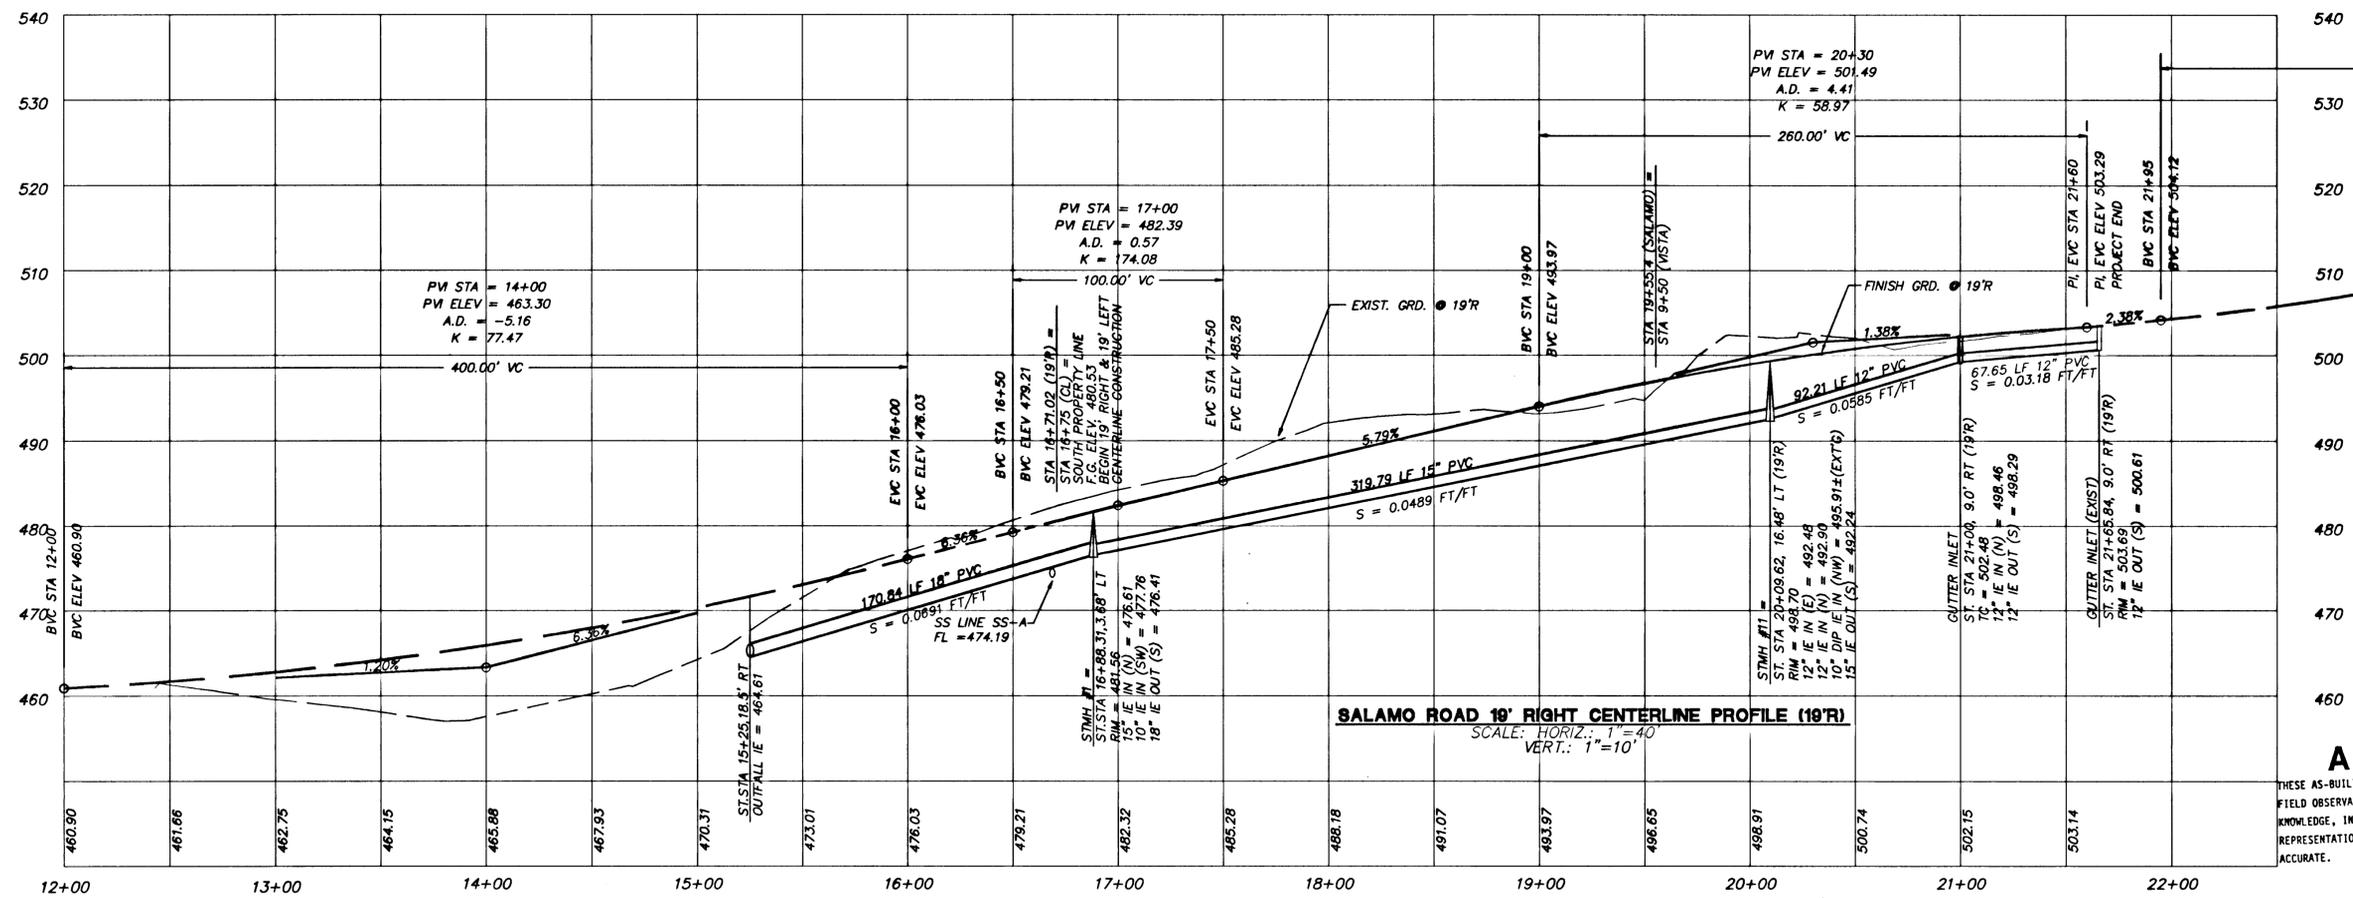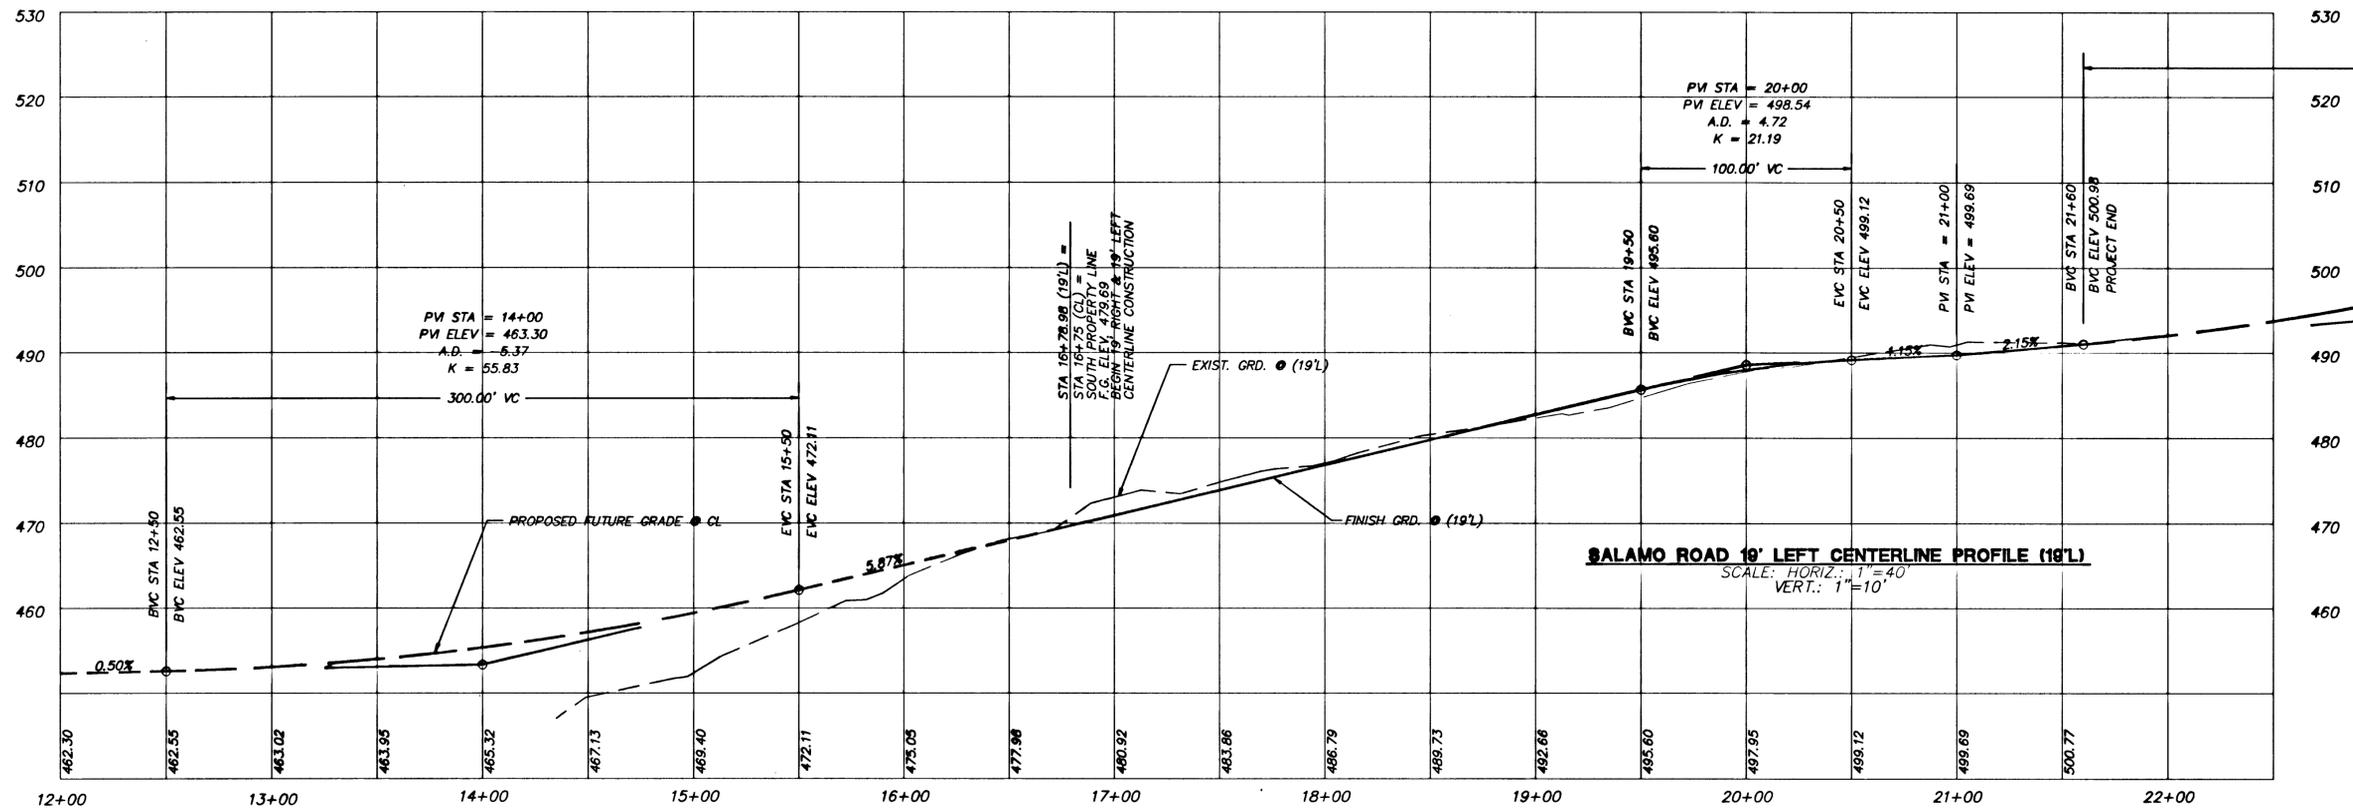

AS BUILT
 THESE AS-BUILT PLANS ARE BASED ON PERIODIC FIELD OBSERVATIONS. TO THE BEST OF MY KNOWLEDGE, INFORMATION, AND BELIEF, THE REPRESENTATIONS SHOWN HEREON ARE TRUE AND ACCURATE.


| NO. | BY | DATE | DESCRIPTION |
|-----|-----|---------|-------------|
| 1 | JMB | 5/26/94 | PER CITY |
| 2 | JMB | 6/7/94 | PER CITY |
| 3 | JMB | 8/30/94 | AS-BUILT |

Designed: SPT/JMB
 Drawn: JMB
 Checked: SPT
 Approved: [Signature]
 Date: 8/18/94
 Scale: 1"=40'

KAMPE ASSOCIATES
 CIVIL ENGINEERING
 LAND SURVEYING
 2895 S.E. COLLEGE WAY
 SUITE 100
 PORTLAND, OREGON 97202-3498
 (503) 835-1141 FAX (503) 835-3498

VISTA RIDGE DEVELOPMENT COMPANY
 18517 SW BRYANT ROAD
 LAKE OSWEGO, OREGON 97036


VISTA RIDGE ESTATES
 SUBDIVISION
 OFF-SITE IMPROVEMENTS
 STREET & STORM PROFILES
 19' LEFT & RIGHT PROFILES

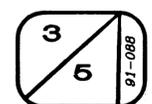

AS-BUILT

| LEGEND | |
|--------|-----------------------|
| | BIO FILTER BAG |
| | SEDIMENT FENCE |
| | SEED/MULCH AREA |
| | CONSTRUCTION ENTRANCE |
| | PROTECTED CATCH BASIN |

PRIOR TO CONSTRUCTION, RIGHT OF WAY AND EASEMENTS ARE TO BE ACQUIRED ON THE FOLLOWING PARCELS:
 TAX LOT NOS. 2100, 2200, 2400, & 3000
 OF MAP NO. 2 1E 35A


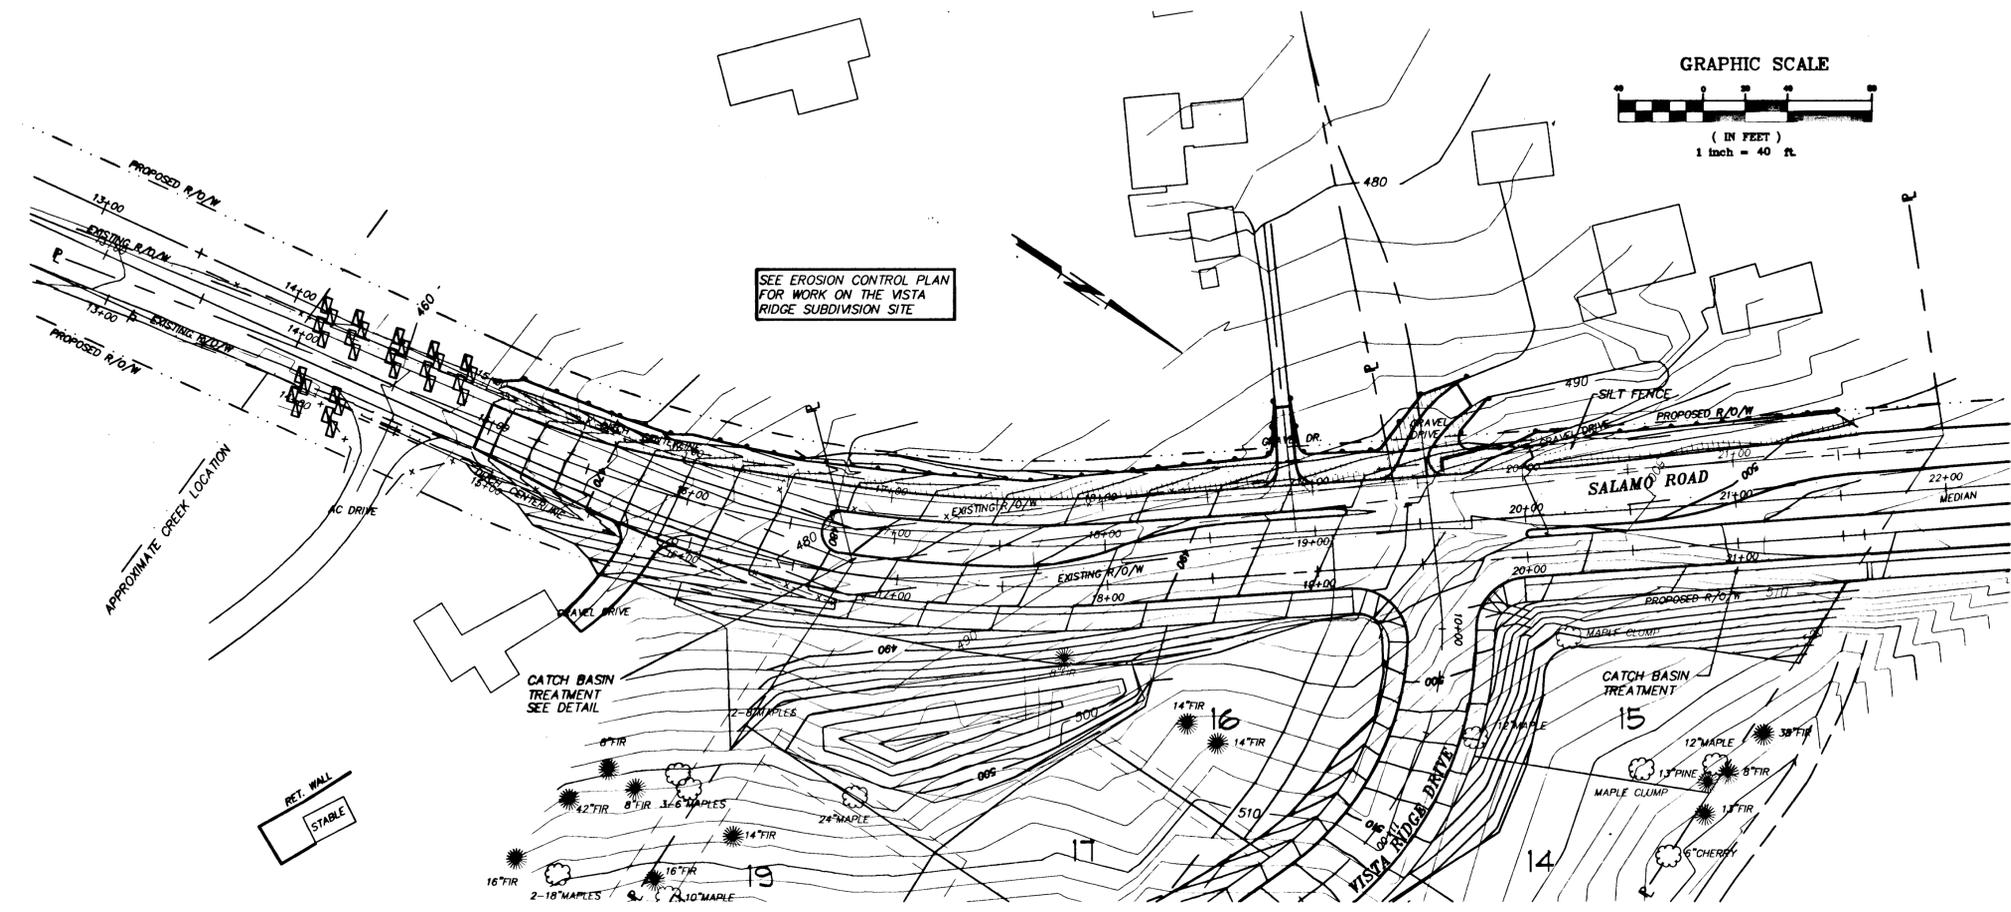


GENERAL EROSION CONTROL NOTES



- APPROVAL OF THIS EROSION/SEDIMENTATION CONTROL (ESC) PLAN DOES NOT CONSTITUTE AN APPROVAL OF PERMANENT ROAD OR DRAINAGE DESIGN (E.G., SIZE AND LOCATION OF ROADS, PIPES, RESTRICTORS, CHANNELS, RETENTION FACILITIES, UTILITIES, ETC.)
- THE IMPLEMENTATION OF THESE ESC PLANS AND THE CONSTRUCTION, MAINTENANCE, REPLACEMENT, AND UPGRADING OF THESE ESC FACILITIES IS THE RESPONSIBILITY OF THE APPLICANT/CONTRACTOR UNTIL ALL CONSTRUCTION IS COMPLETED AND APPROVED AND VEGETATION/LANDSCAPING IS ESTABLISHED.
- THE ESC FACILITIES SHOWN ON THIS PLAN MUST BE CONSTRUCTED IN CONJUNCTION WITH ALL CLEARING AND GRADING ACTIVITIES, AND IN SUCH A MANNER AS TO ENSURE THAT SEDIMENT-LADEN WATER DOES NOT ENTER THE DRAINAGE SYSTEM OR VIOLATE APPLICABLE WATER STANDARDS.
- THE ESC FACILITIES SHOWN ON THIS PLAN ARE THE MINIMUM REQUIREMENTS FOR ANTICIPATED SITE CONDITIONS. DURING THE CONSTRUCTION PERIOD, THESE ESC FACILITIES SHALL BE UPGRADED AS NEEDED FOR UNEXPECTED STORM EVENTS AND TO ENSURE THAT SEDIMENT-LADEN WATER DOES NOT LEAVE THE SITE.
- THE ESC FACILITIES SHALL BE INSPECTED DAILY BY THE APPLICANT/CONTRACTOR AND MAINTAINED AS NECESSARY TO ENSURE THEIR CONTINUED FUNCTIONING.
- THE ESC FACILITIES ON INACTIVE SITES SHALL BE INSPECTED AND MAINTAINED A MINIMUM OF ONCE A MONTH, OR WITHIN THE 48 HOURS FOLLOWING A STORM EVENT.
- AT NO TIME SHALL MORE THAN ONE FOOT OF SEDIMENT BE ALLOWED TO ACCUMULATE WITHIN A TRAPPED CATCH BASIN. ALL CATCH BASINS AND CONVEYANCE LINES SHALL BE CLEANED PRIOR TO PAVING. THE CLEANING OPERATION SHALL NOT FLUSH SEDIMENT-LADEN WATER INTO THE DOWNSTREAM SYSTEM.

SEDIMENT FENCE NOTES



- THE FILTER FABRIC SHALL BE PURCHASED IN A CONTINUOUS ROLL CUT TO THE LENGTH OF THE BARRIER TO AVOID USE OF JOINTS. WHEN JOINTS ARE NECESSARY, FILTER CLOTH SHALL BE SPLICED TOGETHER ONLY AT A SUPPORT POST, WITH A MINIMUM 6-INCH OVERLAP, AND BOTH ENDS SECURELY FASTENED TO THE POST.
- THE FILTER FABRIC FENCE SHALL BE INSTALLED TO FOLLOW THE CONTOURS, WHERE FEASIBLE. THE FENCE POSTS SHALL BE SPACED A MAXIMUM OF 6 FEET APART AND DRIVEN SECURELY INTO THE GROUND A MINIMUM OF 36 INCHES.
- A TRENCH SHALL BE EXCAVATED, ROUGHLY 8-INCHES WIDE BY 12-INCHES DEEP, UPSLOPE AND ADJACENT TO THE WOOD POST TO ALLOW THE FILTER FABRIC TO BE BURIED.
- WHEN STANDARD STRENGTH FILTER FABRIC IS USED, A WIRE SUPPORT FENCE SHALL BE FASTENED SECURELY TO THE UPSLOPE SIDE OF THE POSTS USING HEAVY-DUTY WIRE STAPLES AT LEAST 1 INCH LONG. THE WIRE OR HOG RINGS. THE WIRE SHALL EXTEND INTO THE TRENCH A MINIMUM OF 4 INCHES AND SHALL NOT EXTEND MORE THAN 36 INCHES ABOVE THE ORIGINAL GROUND SURFACE.
- THE STANDARD STRENGTH FILTER FABRIC SHALL BE STAPLED OR WIRED TO THE FENCE, AND 20 INCHES OF THE FABRIC SHALL BE EXTENDED INTO THE TRENCH. THE FABRIC SHALL NOT EXTEND MORE THAN 36 INCHES ABOVE THE ORIGINAL GROUND SURFACE. FILTER FABRIC SHALL NOT BE STAPLED TO EXISTING TREES.
- WHEN EXTRA-STRENGTH FILTER FABRIC AND CLOSER POST SPACING ARE USED, THE WIRE MESH SUPPORT FENCE MAY BE ELIMINATED. IN SUCH A CASE, THE FILTER FABRIC IS STAPLED OR WIRED DIRECTLY TO THE POSTS WITH ALL OTHER PROVISIONS OF THE ABOVE STANDARD NOTE FOR STANDARD STRENGTH FILTER FABRIC APPLYING.
- SEDIMENT FENCES SHALL BE REMOVED WHEN THEY HAVE SERVED THEIR USEFUL PURPOSE, BUT NOT BEFORE THE UPSLOPE AREA HAS BEEN PERMANENTLY STABILIZED.
- SEDIMENT FENCES SHALL BE INSPECTED BY APPLICANT/CONTRACTOR IMMEDIATELY AFTER EACH RAINFALL, AND AT LEAST DAILY DURING PROLONGED RAINFALL. ANY REQUIRED REPAIRS SHALL BE MADE IMMEDIATELY.

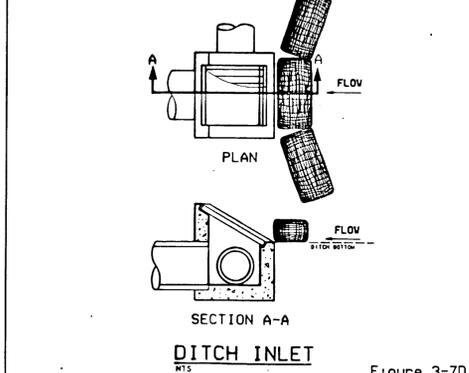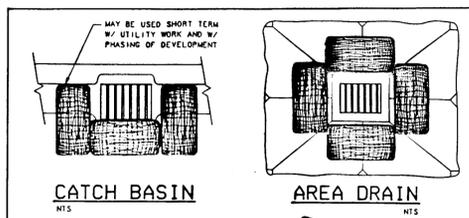

EROSION CONTROL PLANS
 TECHNICAL GUIDANCE HANDBOOK
 Biofilter Bags - Temporary Catch Basin Protection
 Figure 3-7D

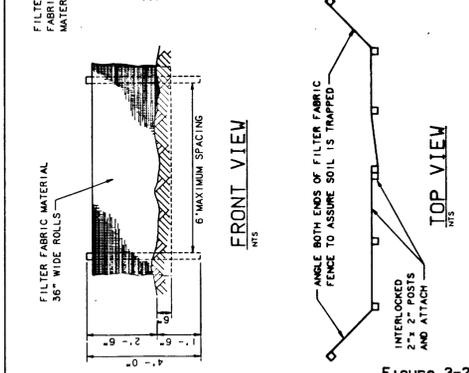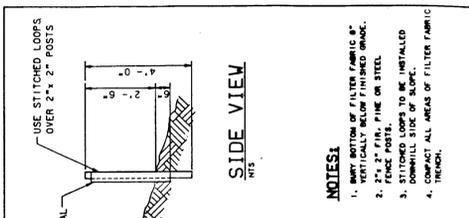

EROSION CONTROL PLANS
 TECHNICAL GUIDANCE HANDBOOK
 Sediment Fence
 Figure 3-2

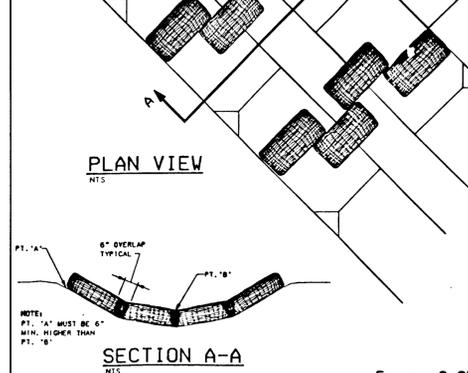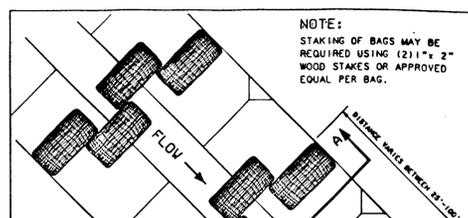

EROSION CONTROL PLANS
 TECHNICAL GUIDANCE HANDBOOK
 Biofilter Bags Ditches & Swales
 Figure 3-3D

AS BUILT

THESE AS-BUILT PLANS ARE BASED ON PERIODIC FIELD OBSERVATIONS. TO THE BEST OF MY KNOWLEDGE, INFORMATION, AND BELIEF, THE REPRESENTATIONS SHOWN HEREON ARE TRUE AND ACCURATE.

| NO. | DATE | DESCRIPTION |
|-----|---------|-------------|
| 1 | 5/24/94 | PER CITY |
| 2 | 6/7/94 | PER CITY |
| 3 | 8/30/94 | AS-BUILT |


| | |
|----------|---------|
| Designed | JAB |
| Drawn | JAB |
| Checked | SBT |
| Approved | |
| Date | 8/19/94 |
| Scale | 1"=40' |

KAMPE ASSOCIATES
 CIVIL ENGINEERING
 LAND SURVEYING
 200 W. 10TH ST. SUITE 200
 LAKE OSWEGO, OREGON 97035
 (503) 835-1100 (503) 835-5460


VISTA RIDGE DEVELOPMENT COMPANY
 18517 SW BRYANT ROAD
 LAKE OSWEGO, OREGON 97035

**VISTA RIDGE ESTATES
 SUBDIVISION
 OFF-SITE IMPROVEMENTS
 GRADING & EROSION CONTROL
 PLAN**

AS-BUILT

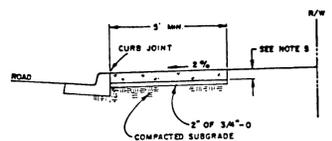

SIDEWALK ADJACENT TO CURB

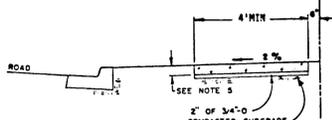


SIDEWALK AWAY FROM CURB

- Concrete shall be 3000 PSI at 28 days, 6 sack mix, slump range of 1 1/2" to 3".
- Panel lengths shall be equal to the sidewalk width, but may be adjusted with the City Engineer's approval.
- Contraction joints (1 1/2" deep) shall be placed every third panel, with a max. spacing of 18 feet.
- Contraction joints shall be placed at the side of driveway approaches, utility vaults, and wheelchairs ramps.
- A curing compound shall be used. White reflective sheeting shall be used in case of rain.
- For sidewalks adjacent to the curb placed at the same time as the curb, the joint between them shall be a troweled joint with a min. 3/2" radius.
- The sidewalk shall have a min. thickness of 4" if unworkable curb is used or if the sidewalk is intended as a portion of the driveway. Otherwise, the sidewalk shall have a min. thickness of 4".
- Drain inlets in the curb shall be extended to the back of the sidewalk with a 3" dia. plastic pipe at a 2% slope. A contraction joint shall be placed over the pipe.

CITY OF WEST LINN CONCRETE SIDEWALK

DRAWN BY DDP DATE 5-20-87
 CHECKED BY DLK DATE 5-27-87
 APPROVED BY Earl Reed DATE 5-27-87
 DWG. NO. CS - 270

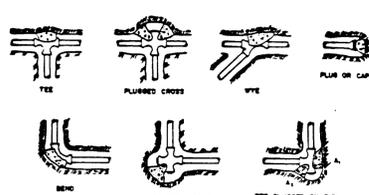

BEARING AREA OF THRUST BLOCK (in sq. ft.)


| FITTING SIZE (IN.) | TEE, WYE, PLUG ON CAP | 90° BEND, PLUGGED CROSS | TEE, PLUGGED ON RUN | 45° BEND | 180° BEND |
|--------------------|-----------------------|-------------------------|---------------------|----------|-----------|
| 1/2 | 1.0 | 1.4 | 3.1 | 1.0 | 1.0 |
| 3/4 | 2.1 | 3.0 | 4.1 | 2.0 | 2.0 |
| 1 | 3.8 | 5.2 | 7.6 | 3.0 | 3.0 |
| 1 1/4 | 5.9 | 8.4 | 11.8 | 4.0 | 4.0 |
| 1 1/2 | 8.0 | 12.0 | 17.0 | 5.0 | 5.0 |
| 2 | 13.0 | 18.0 | 27.0 | 8.0 | 8.0 |
| 2 1/2 | 18.0 | 25.0 | 38.0 | 11.0 | 11.0 |
| 3 | 23.0 | 32.0 | 49.0 | 14.0 | 14.0 |
| 3 1/2 | 28.0 | 39.0 | 60.0 | 17.0 | 17.0 |
| 4 | 33.0 | 46.0 | 71.0 | 20.0 | 20.0 |

NOTES

- Concrete shall be placed against unexcavated earth.
- Concrete shall be cast prior to joint and excavation.
- The required thrust blocking shall be placed in the concrete in the same manner as shown on this plan.
- For example, 1/2" concrete 18 1/2" bearing area required.
- If not shown on plan, required bearing area of fitting shall be as indicated above, adjusted if necessary to maintain the 100% bearing area of fitting and bearing strength stated in the bearing specifications.
- Bearing area and bearing strength details shown on this plan shall apply to all thrust blocking on this project.
- Some bearing areas are based on a test pressure of 180 P.S.I. and on concrete and bedding areas of 8000 LBS./SQ. FT. To compute bearing area for different test pressures and test bedding pressure, use the following equation: $Bearing Area = Table Value \times \frac{Test Pressure}{180} \times \frac{8000}{Bedding Pressure}$


CITY OF WEST LINN THRUST BLOCKING

DRAWN BY DDP DATE 5-20-87
 CHECKED BY DLK DATE 5-27-87
 APPROVED BY Earl Reed DATE 5-27-87
 DWG. NO. TB - 302

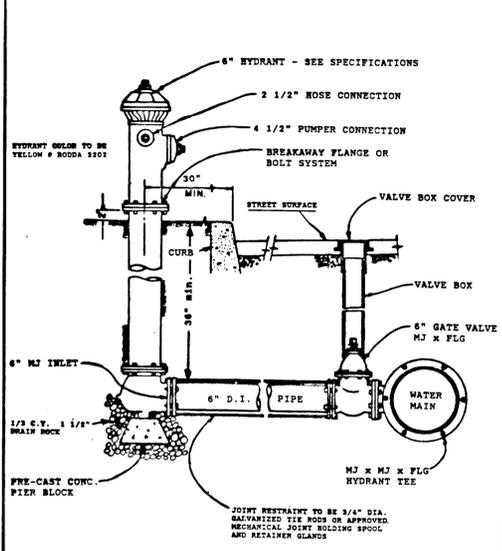


CITY OF WEST LINN FIRE HYDRANT

DRAWN BY DDP DATE 5-20-87
 CHECKED BY DLK DATE 5-27-87
 APPROVED BY Earl Reed DATE 5-27-87
 DWG. NO. FH - 300

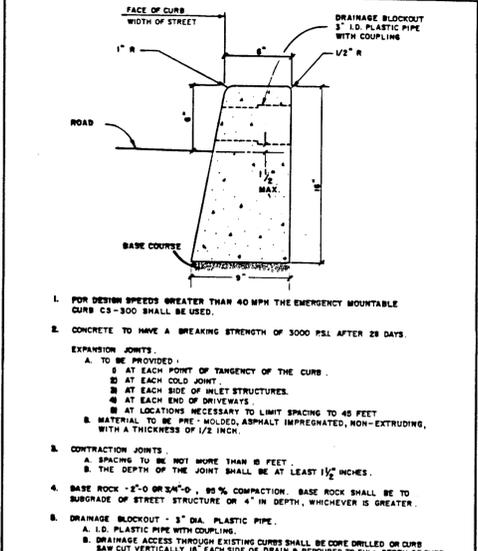


WASHINGTON COUNTY DEPARTMENT OF LAND USE AND TRANSPORTATION CURB NON-MOUNTABLE FOR USE ON MEDIANS

DRAWN BY DDP DATE 5-20-87
 CHECKED BY DLK DATE 5-27-87
 APPROVED BY Earl Reed DATE 5-27-87
 DWG. NO. CS - 301

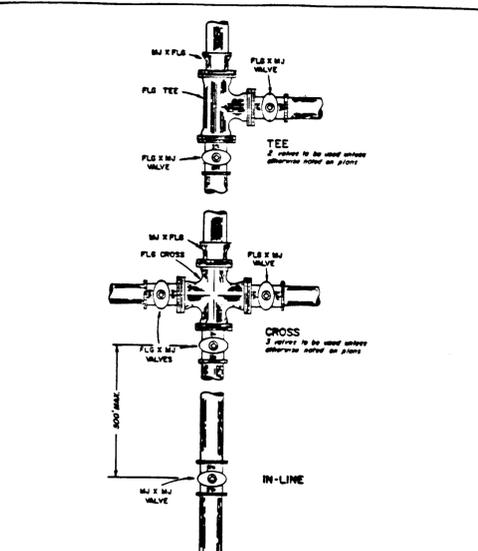


CITY OF WEST LINN VALVE LOCATION

DRAWN BY DDP DATE 5-20-87
 CHECKED BY DLK DATE 5-27-87
 APPROVED BY Earl Reed DATE 5-27-87
 DWG. NO. VL - 303

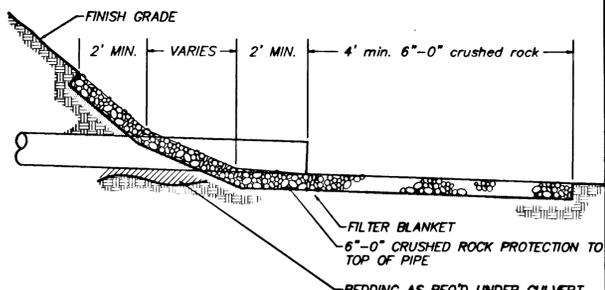


OUTFALL PROTECTION
N.T.S.

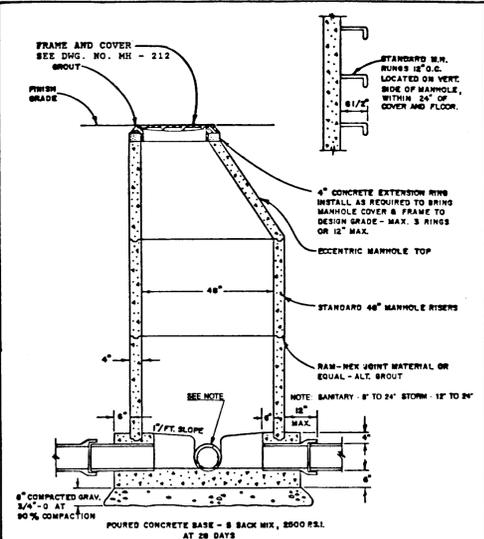


CITY OF WEST LINN STANDARD MANHOLE

DRAWN BY DDP DATE 5-20-87
 CHECKED BY DLK DATE 5-27-87
 APPROVED BY Earl Reed DATE 5-27-87
 DWG. NO. MH - 209

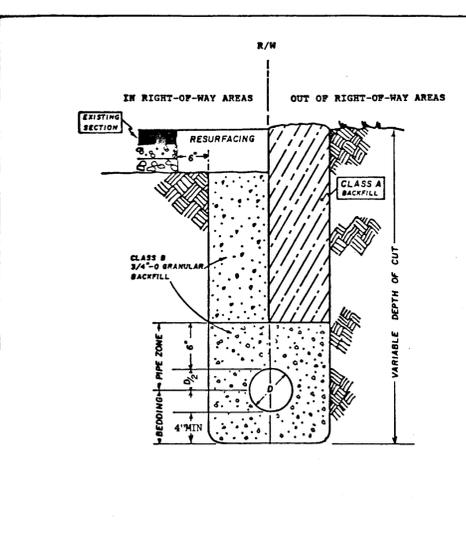


CITY OF WEST LINN PIPE BEDDING AND BACKFILL DETAILS

DRAWN BY DDP DATE 5-20-87
 CHECKED BY DLK DATE 5-27-87
 APPROVED BY Earl Reed DATE 5-27-87
 DWG. NO. PB - 280

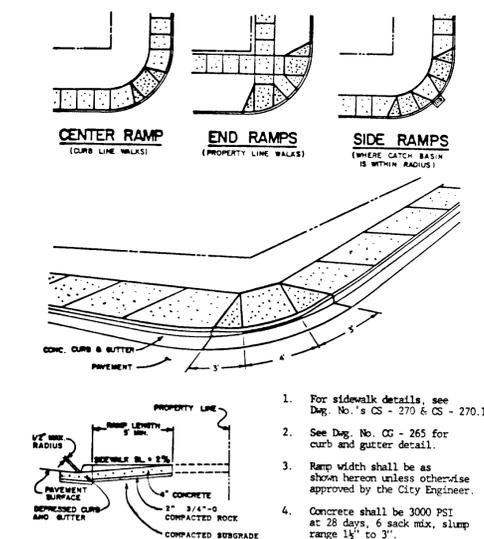


CITY OF WEST LINN SIDEWALK RAMP

DRAWN BY DDP DATE 5-20-87
 CHECKED BY DLK DATE 5-27-87
 APPROVED BY Earl Reed DATE 5-27-87
 DWG. NO. CS - 271

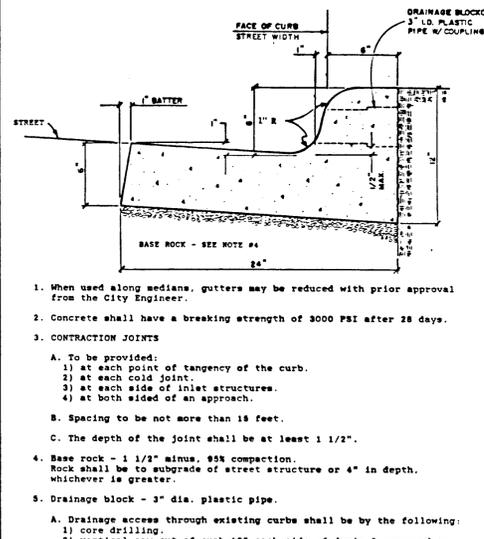


CITY OF WEST LINN CURB & GUTTER

DRAWN BY DDP DATE 5-20-87
 CHECKED BY DLK DATE 5-27-87
 APPROVED BY Earl Reed DATE 5-27-87
 DWG. NO. CG - 265

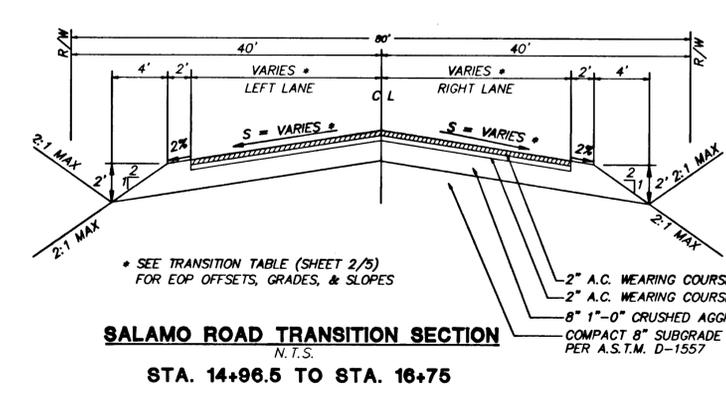

SALAMO ROAD TRANSITION SECTION
N.T.S.
STA. 14+96.5 TO STA. 16+75

- NOTES**
- LEFT LANE SLOPE VARIES FROM -3.0% TO -2.0% STA 21+25 TO STA 21+60 (19'L)
 - RIGHT LANE SLOPE VARIES FROM +3.0% TO -2.0% STA 19+55.4 TO STA 21+60 (19'R)

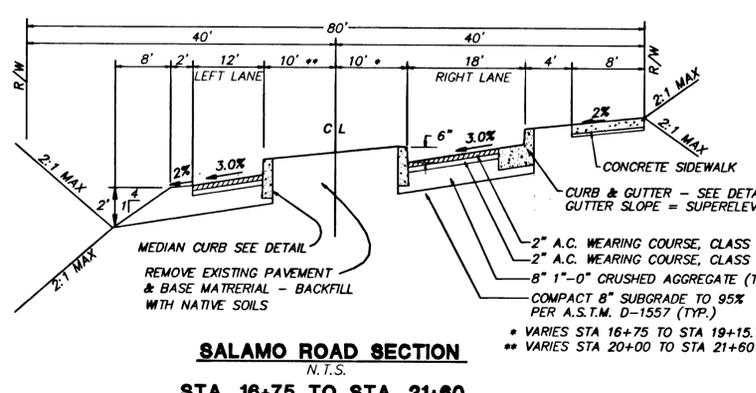

SALAMO ROAD SECTION
N.T.S.
STA. 16+75 TO STA. 21+60

AS BUILT
 THESE AS-BUILT PLANS ARE BASED ON PERIODIC FIELD OBSERVATIONS. TO THE BEST OF MY KNOWLEDGE, INFORMATION, AND BELIEF, THE REPRESENTATIONS SHOWN HEREON ARE TRUE AND ACCURATE.

DESIGNER: DDP
 DRAWN: DDP
 CHECKED: DLK
 APPROVED: Earl Reed
 DATE: 5/20/87
 DATE: 5/27/87
 DATE: 5/27/87
 SCALE: AS SHOWN

REVISIONS

| NO. | DATE | DESCRIPTION |
|-----|------------|-------------|
| 1 | 5/24/84 | PER CITY |
| 2 | 6/7/84 | PER CITY |
| 3 | 6/14/85/84 | AS-BUILT |

KAMPE ASSOCIATES
 200 WEST 10TH AVENUE
 LAKE OSWEGO, OREGON 97035
 (503) 261-7474 (503) 261-5360

VISTA RIDGE DEVELOPMENT COMPANY
 18617 SW BRYANT ROAD
 LAKE OSWEGO, OREGON 97035

VISTA RIDGE ESTATES
 SUBDIVISION
 OFF-SITE IMPROVEMENTS
 DETAILS

5
 5
 91-088

AS-BUILT