



REV	DATE	SUMMARY
2	8/30/11	Agency Comments

Project #: 9130 Drawn: CL

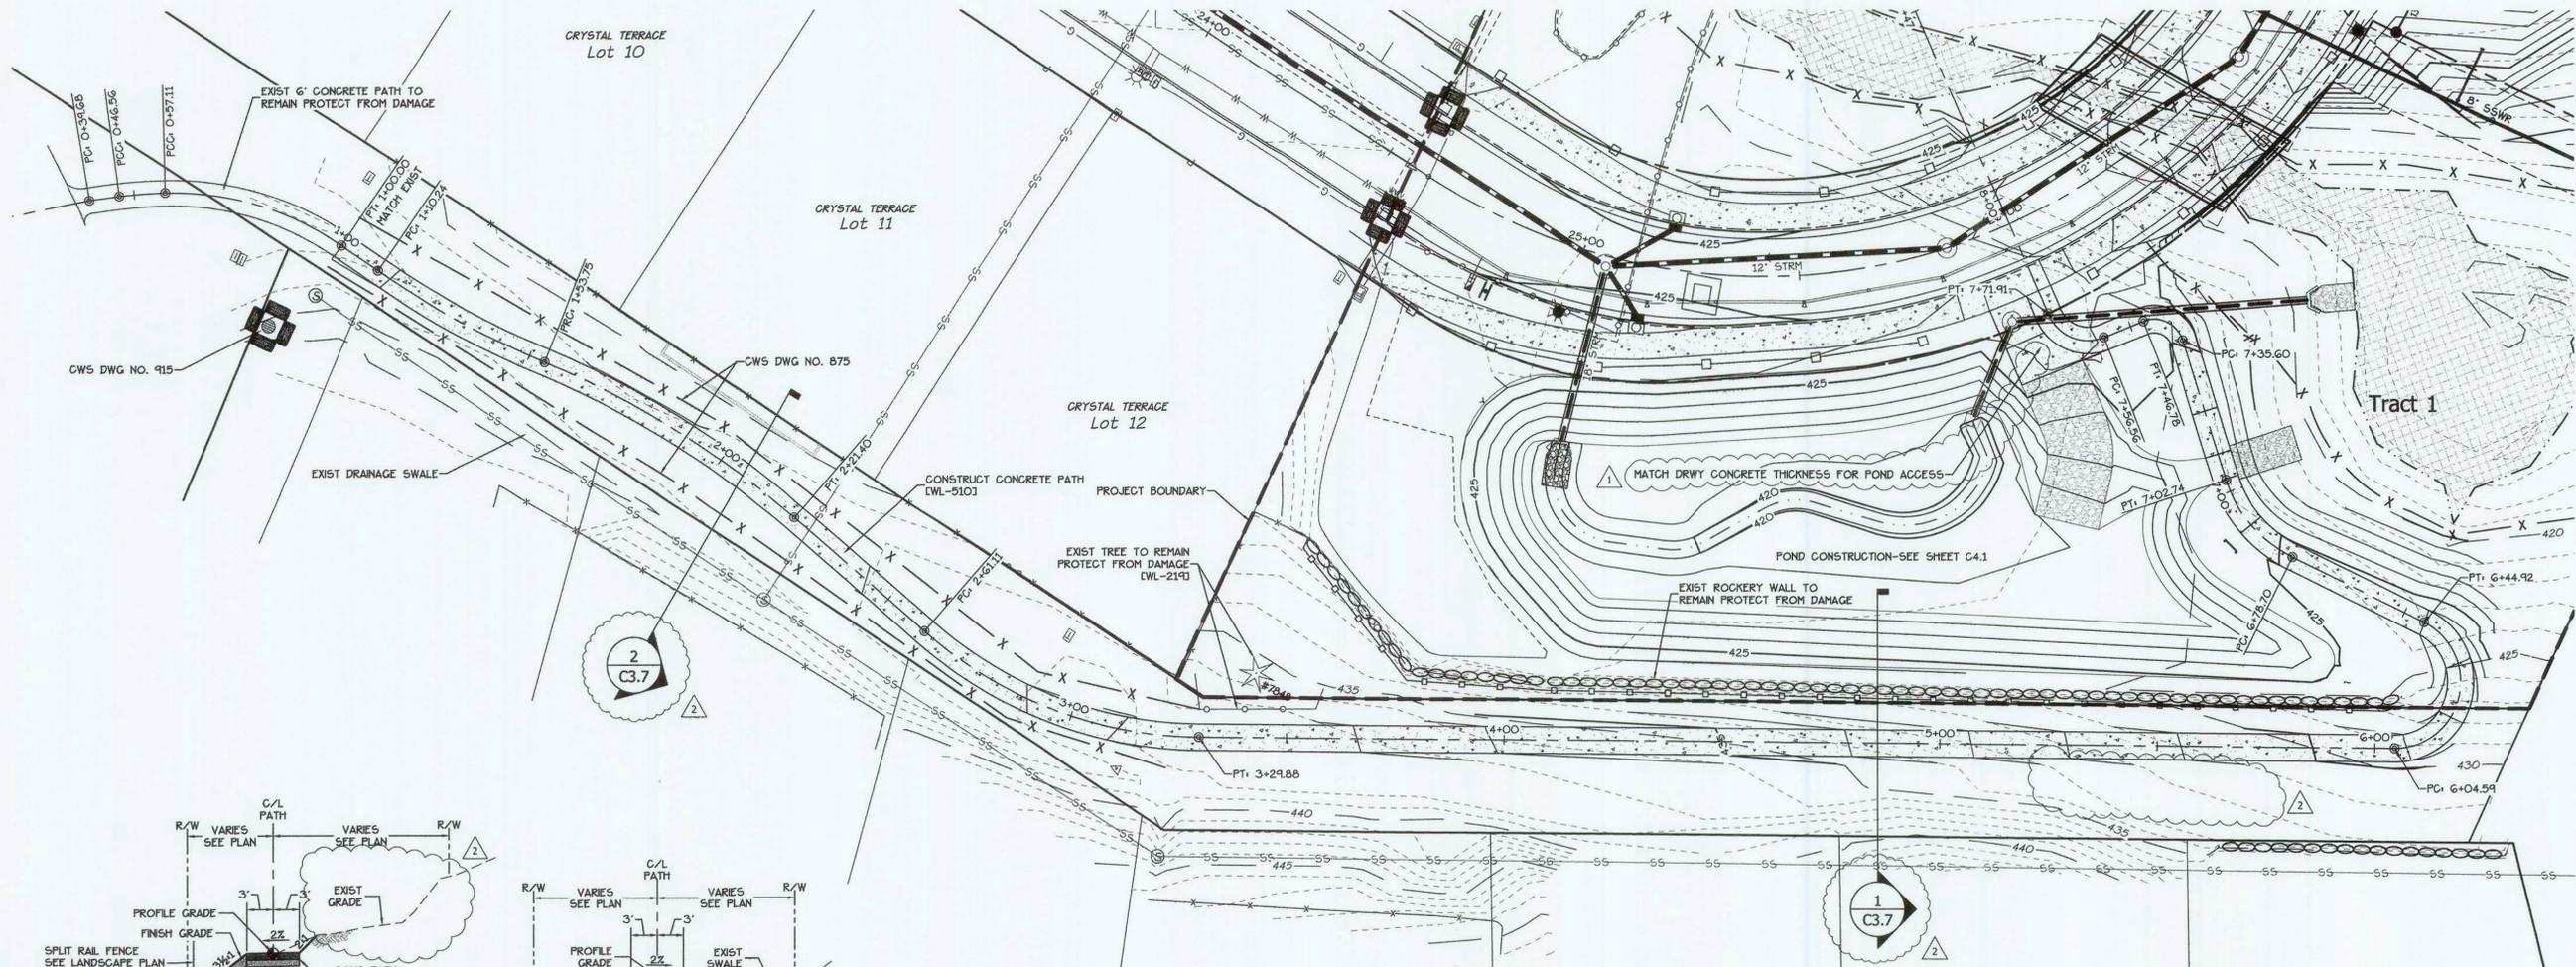

1 HASKINS LANE PEDESTRIAN PATH PLAN
 Scale: 1" = 20'

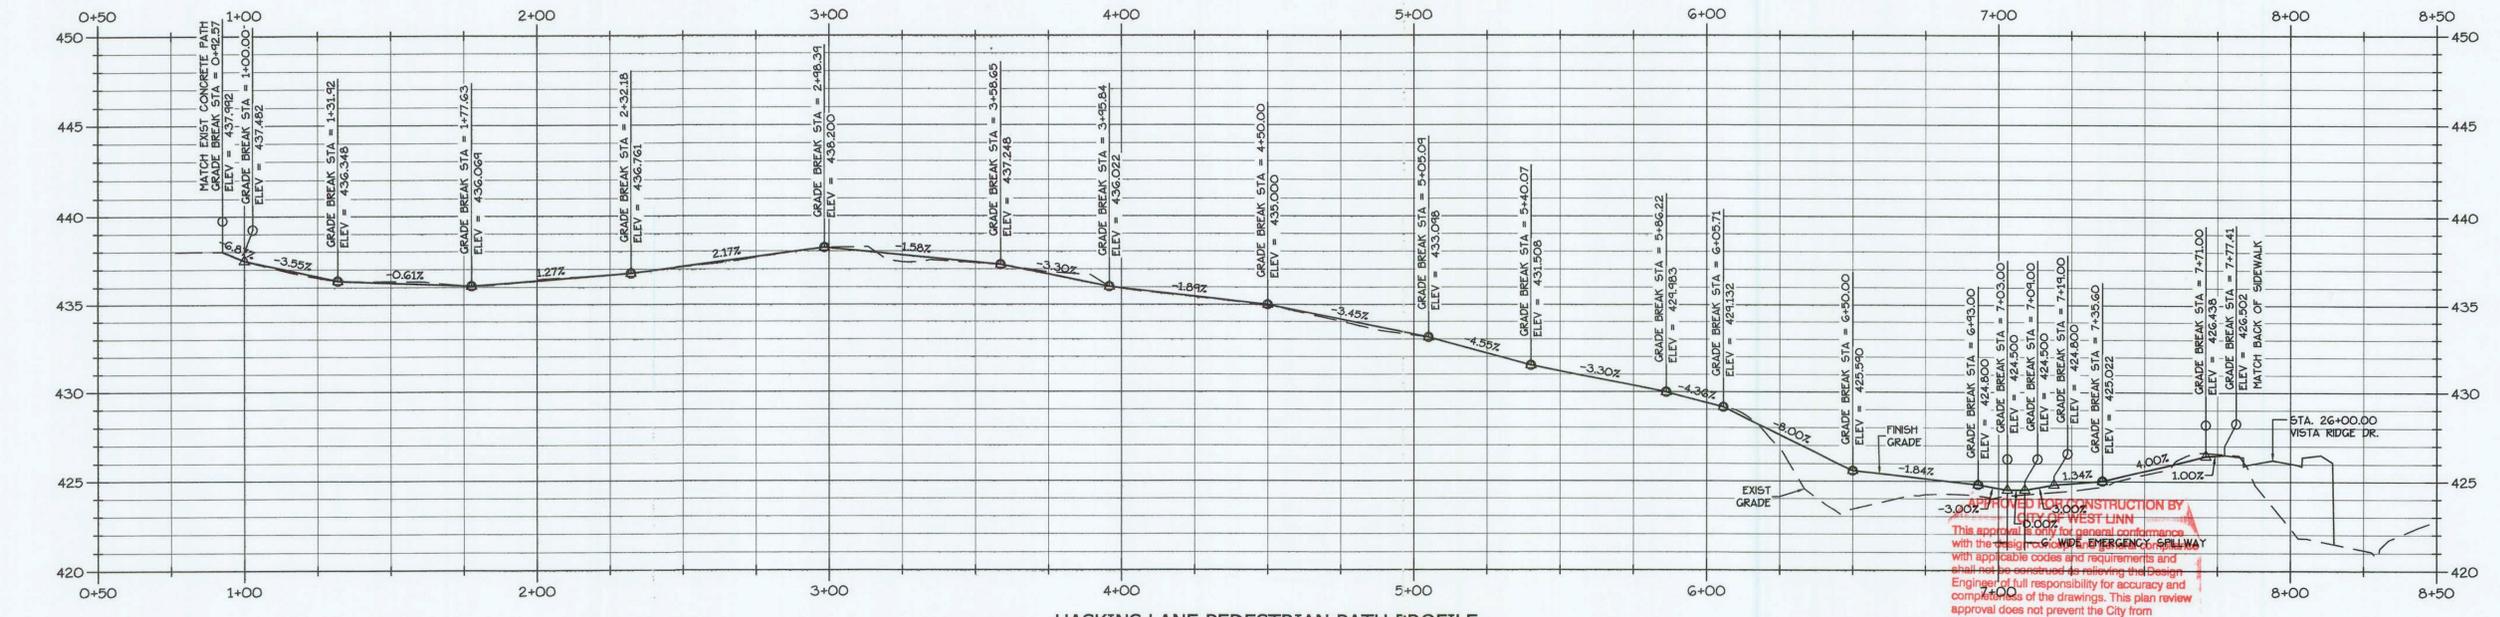

HASKINS LANE PEDESTRIAN PATH PROFILE
 STA 0+50 - 8+50
 Horiz: 1"=30' Vert: 1"=5'

 This approval is only for general conformance with the 6-1/2\"/>

