(#) CONSTRUCTION NOTES:

1. ADJUST STRUCTURE TO GRADE.
2. INSTALL MONUMENT BOX WL-513A. GRIND OR REMOVE FLANGE CROSS FROM BOTTOM SIDE OF LID.
3. SEE SECTION SHEET C4.3 FOR STREET RESTORATION DETAILS.
4. SAWCUT AND MATCH EXISTING PAVEMENT STA: 24+54.5
5. INSTALL 6' x 10' x 18" THICK RIP RAP OUTFALL PROTECTION.

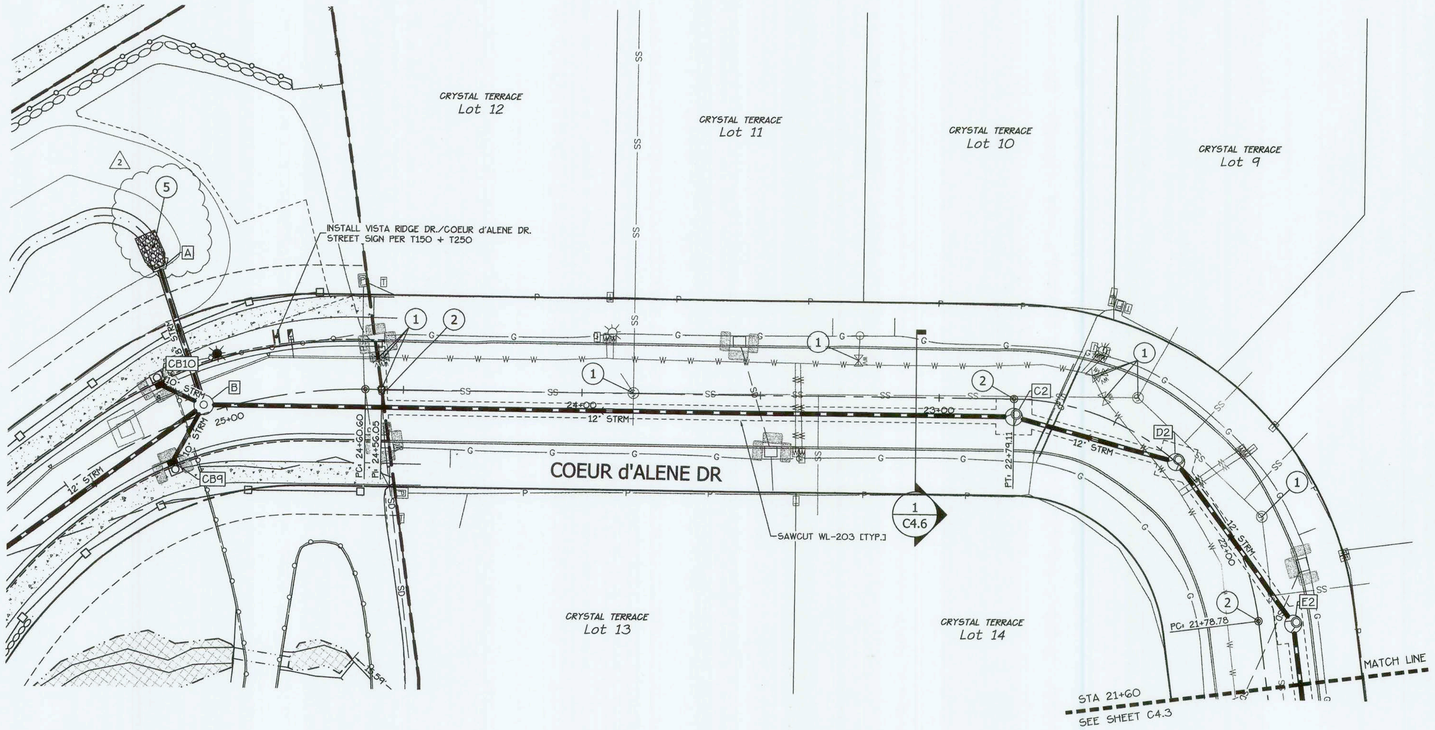

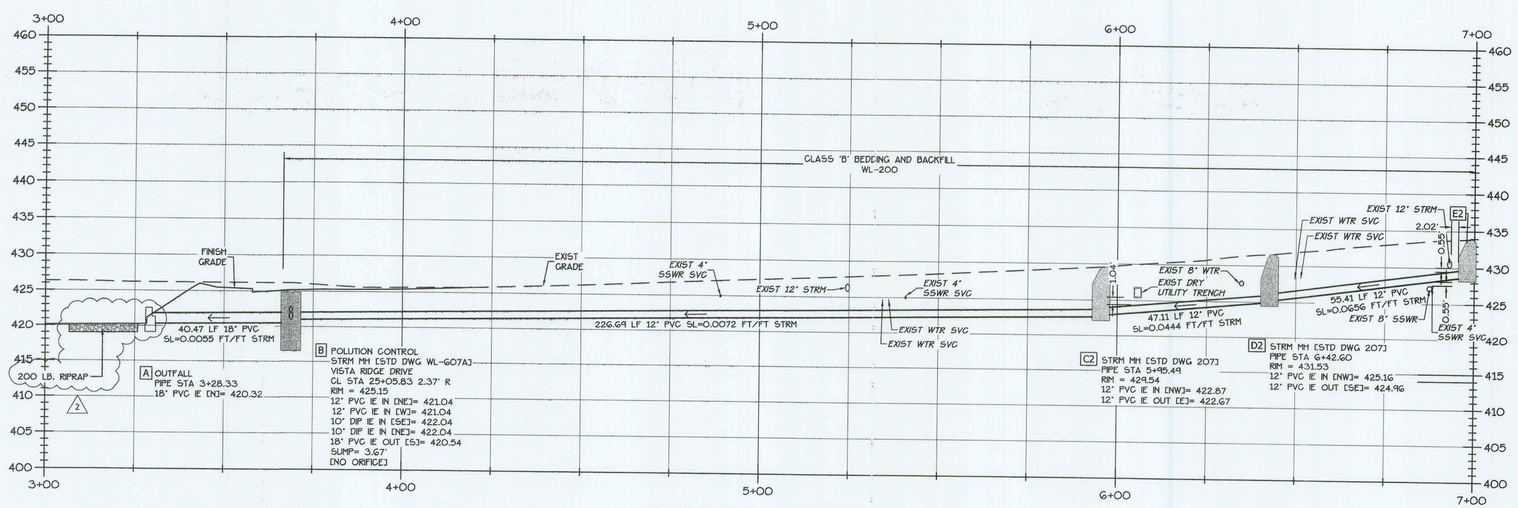

STORM BYPASS PROFILE
STA 3+00 - 7+00
Horiz: 1"=20' Vert: 1"=10'

NOTE:

1. ALL UTILITY CROSSINGS NOT DIMENSIONED. HAVE A MINIMUM OF 12" CLEARANCE UNLESS OTHERWISE NOTED.

APPROVED FOR CONSTRUCTION BY CITY OF WEST LINN
This approval is only for general conformance with the design concept and general compliance with applicable codes and requirements and shall not be construed as relieving the Design Engineer of full responsibility for accuracy and completeness of the drawings. This plan review approval does not prevent the City from requiring further code corrections.
DATE: 9-6-11 BY: Entry Q.6 ENGINEERING
DATE: 9-6-11 BY: [illegible] PLANNING

0 20' 40'

THE SAUNDERS COMPANY
DESIGN GROUP
901 N. Brutscher, Ste. 202
Newberg, Oregon 97132
Phone: 503-537-9347
www.thesaunderscompany.net

REGISTERED PROFESSIONAL ENGINEER 80644PE OREGON SEPT. 14, 1993 CHARLES EDWARD GREGORY
7/21/11
RENEWS: JUNE 30, 2013

J.T. SMITH companies

Teresa's Vineyard
Public Improvements
Sub-07-02/NDW-07-02/VAR-07-01
West Linn, Oregon

REV	DATE	SUMMARY
1	8/5/11	Client/Agency Comments
2	8/30/11	Agency Comments

Project #: 9130 Drawn: CL

STORM DRAINAGE BYPASS PLAN & PROFILE

Date: April 15, 2011

C4.2