



ARCHITECTURE + INTERIORS + PLANNING

DULL OLSON WEEKES
architects inc.

907 SW STARK STREET | PORTLAND, OR 97204
t: (503) 226-6950 f: (503) 273-9192 www.dovaw.com

TRILLIUM CREEK PRIMARY SCHOOL

West Linn Wilsonville School District

22210 SW STAFFORD ROAD - WEST LINN, OR 97068

t: (503) 673 7976
f: (503) 673 7044

WINZLER & KELLY

15575 SW SEQUOIA PARKWAY, SUITE 140
PORTLAND, OR 97224
PH (503) 226-3921 • FAX (503) 226-3926
WWW.W-AND-K.COM



EXPIRES 6/30/12

phase CONSTRUCTION

SET

date April 6, 2011


























revisions

ASI #8 06/29/2011

project # 09014

CROSS-SECTIONS

PI3.3

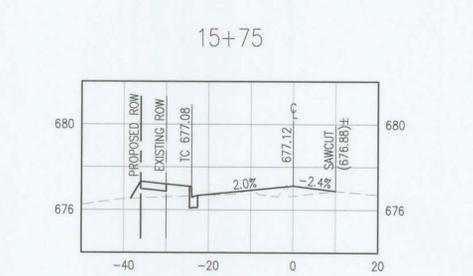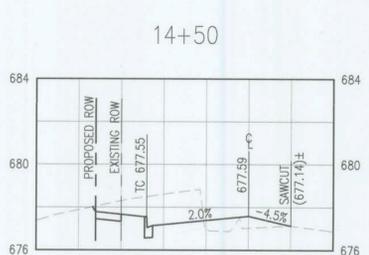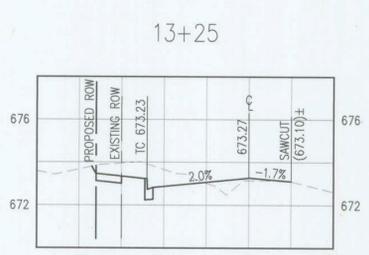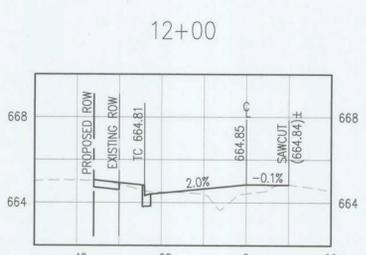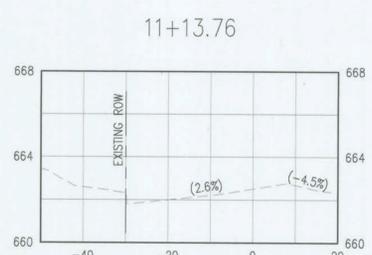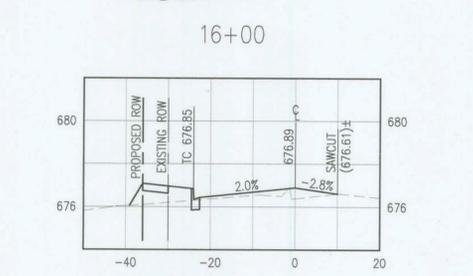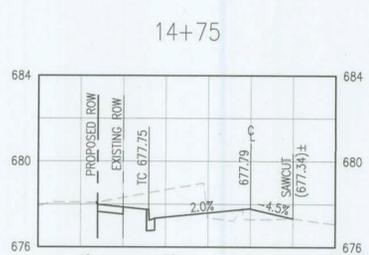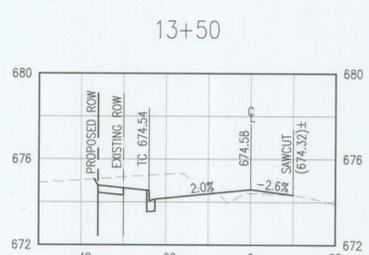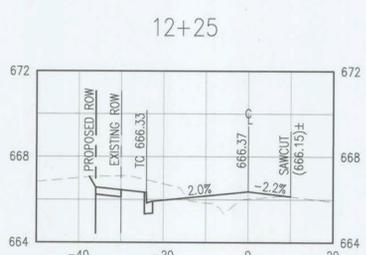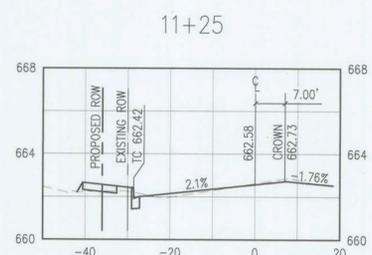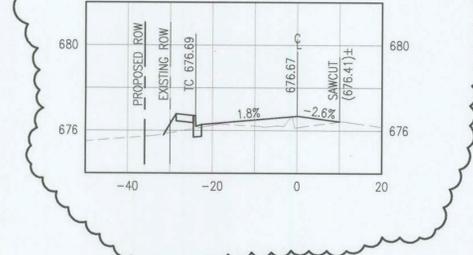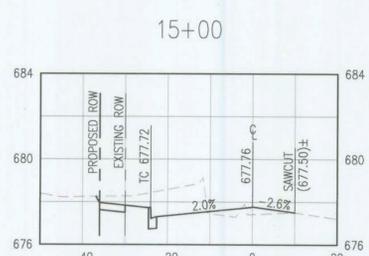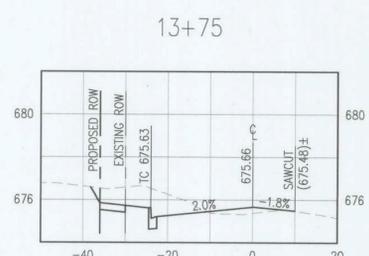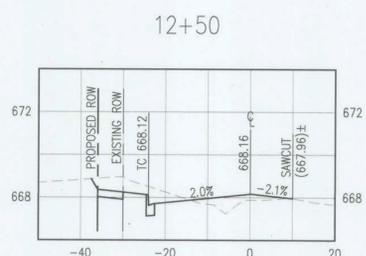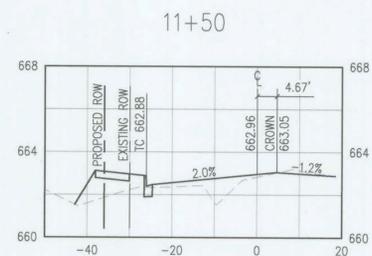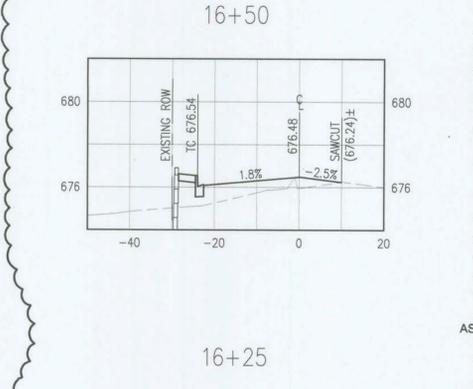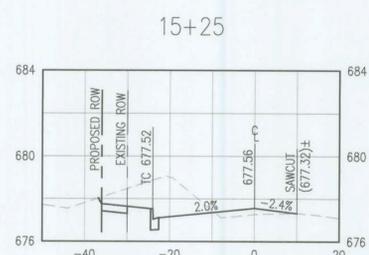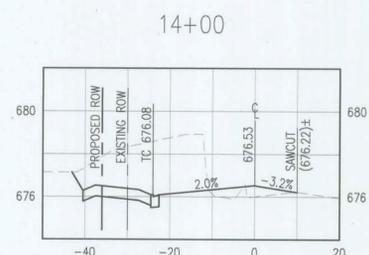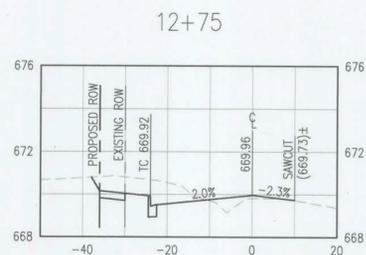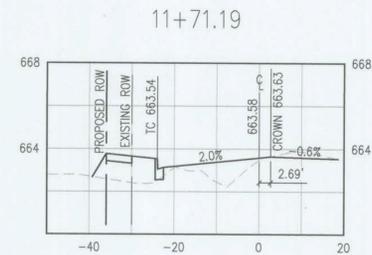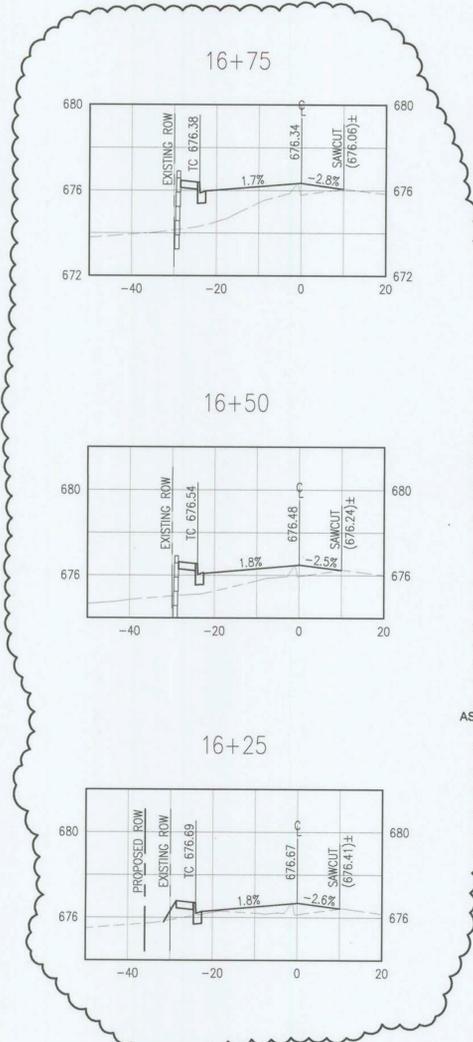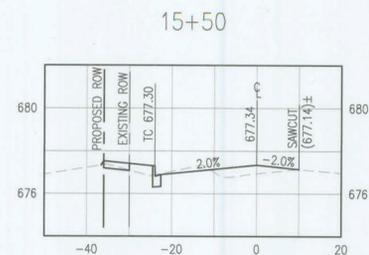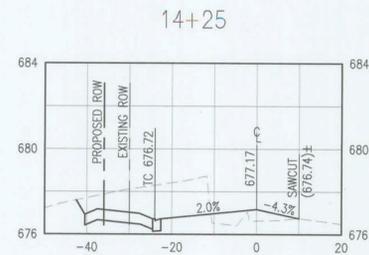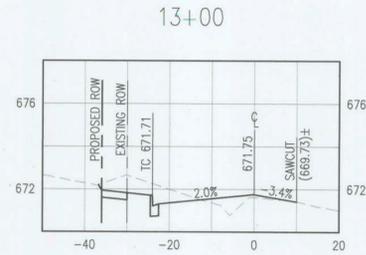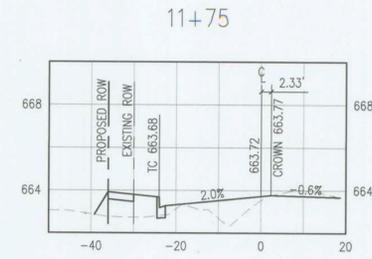

APPROVED FOR CONSTRUCTION BY
CITY OF WEST LINN
This approval is only for general conformance with the design concept and general compliance with applicable codes and requirements and shall not be construed as relieving the Design Engineer of full responsibility for accuracy and completeness of the drawings. This plan review approval does not prevent the City-Inspector from requiring further code corrections in the field.
DATE: 07/11/11 BY: *Kari & Le*

