10th St. /8th Ave. IMPROVEMENTS '84

PROFILE

SCALES: VERTICAL 1" = 4'
HORIZONTAL 1" = 40'

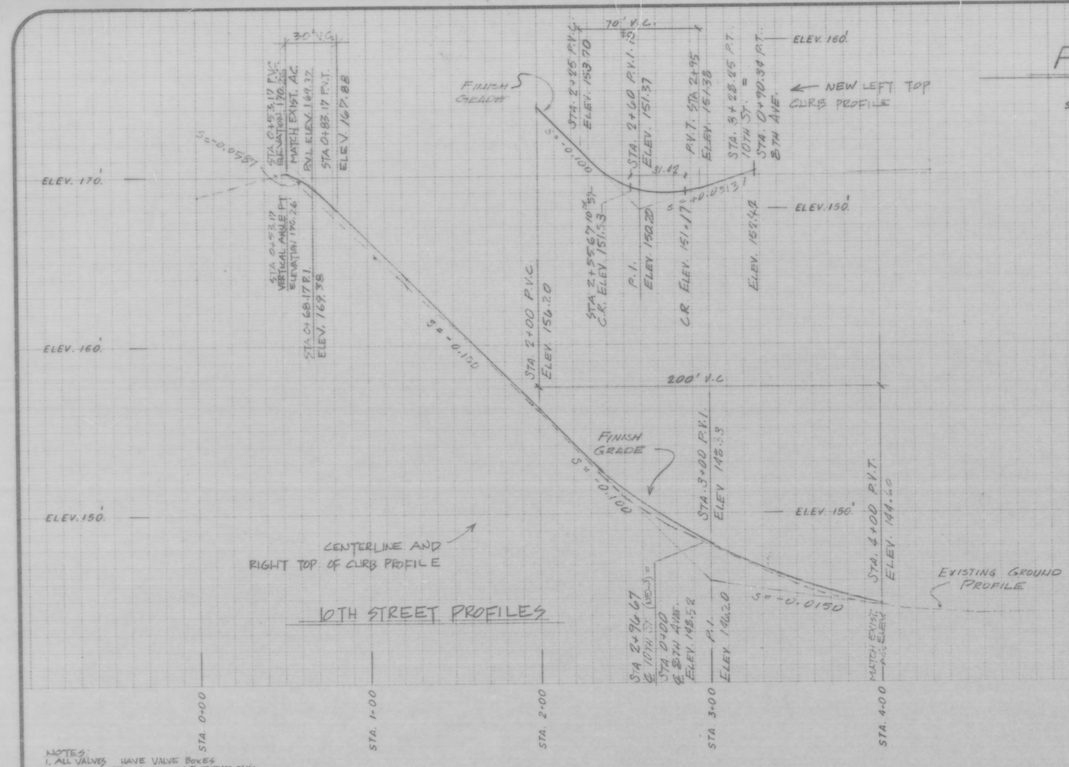

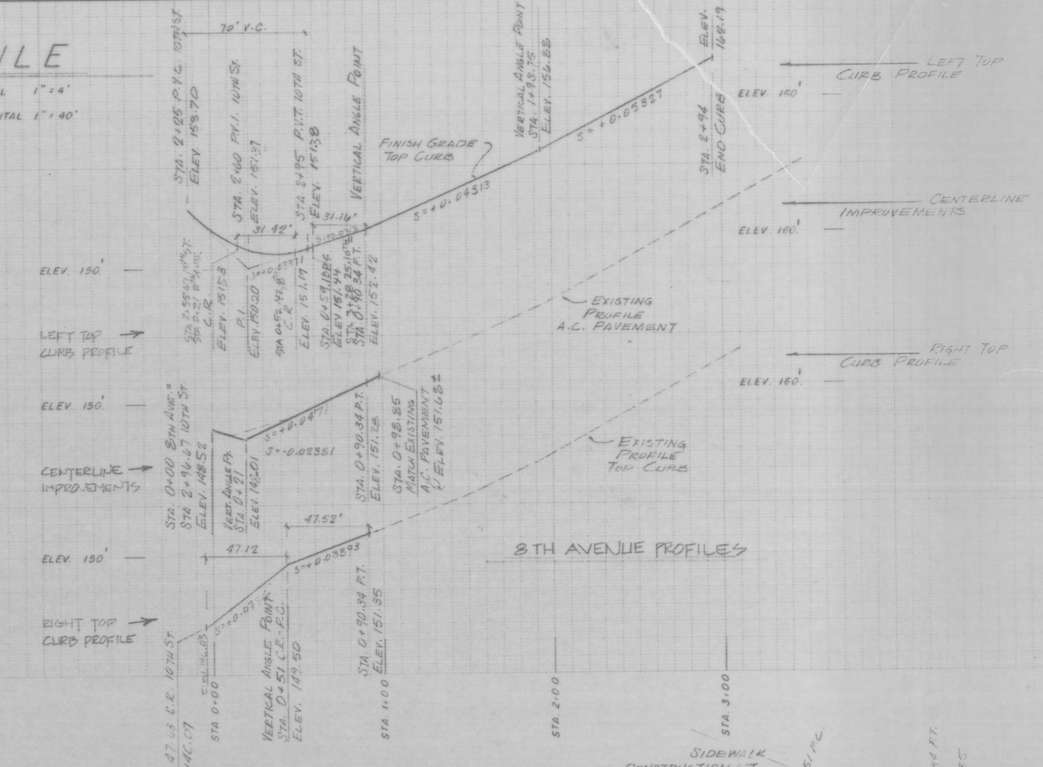

PLAN

SCALE: 1" = 40'

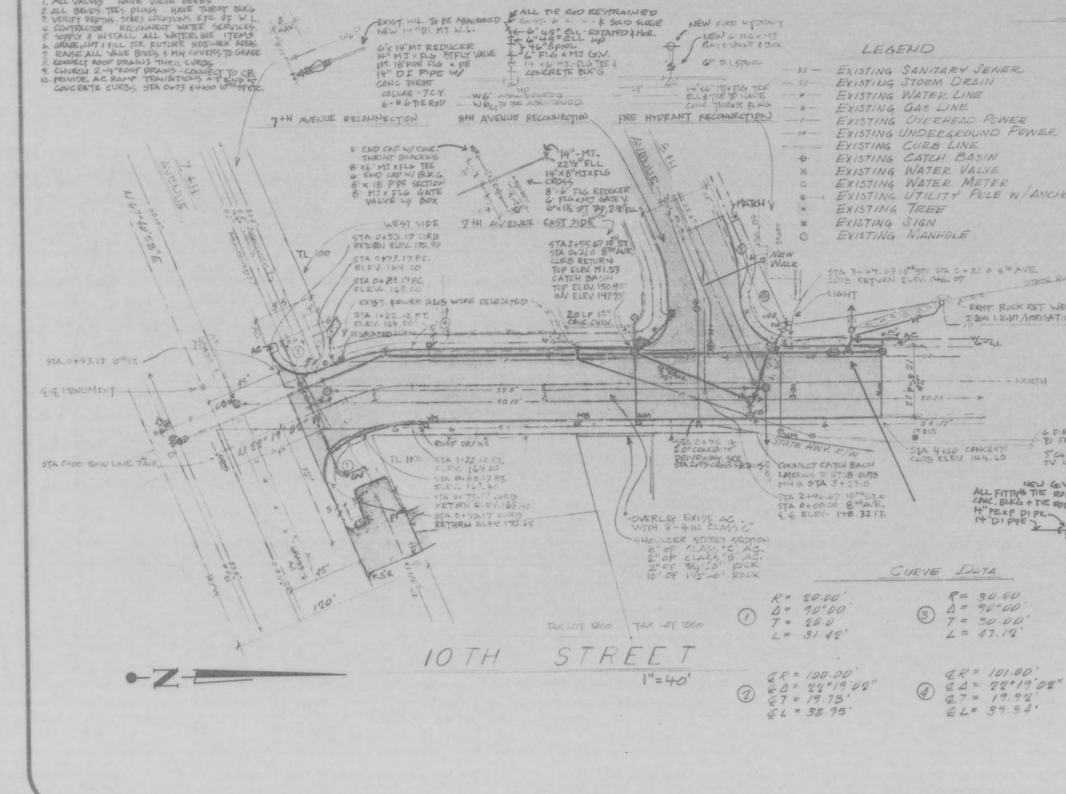

LEGEND

- EXISTING SANITARY SEWER
- EXISTING STORM DRAIN
- EXISTING WATER LINE
- EXISTING GAS LINE
- EXISTING OVERHEAD POWER
- EXISTING UNDERGROUND POWER
- EXISTING CURB LINE
- EXISTING CATCH BASIN
- EXISTING WATER VALVE
- EXISTING WATER METER
- EXISTING UTILITY POLE W/ANCHOR
- EXISTING TREE
- EXISTING SIGN
- EXISTING MANHOLE
- NEW CATCH BASIN
- NEW CATCH BASIN LATERAL
- NEW CURB
- NEW A.C. PAVEMENT
- NEW CONCRETE
- EXIST. MANHOLE
- WHEEL CHAIR RAMP

STA. 0+41 CONSTRUCTED CURB RETURN ELEV. 150.97

STA. 0+21.0 8TH AVE = STA. 2+55.67 10TH ST. CONSTRUCTED CURB RETURN ELEV. 151.53

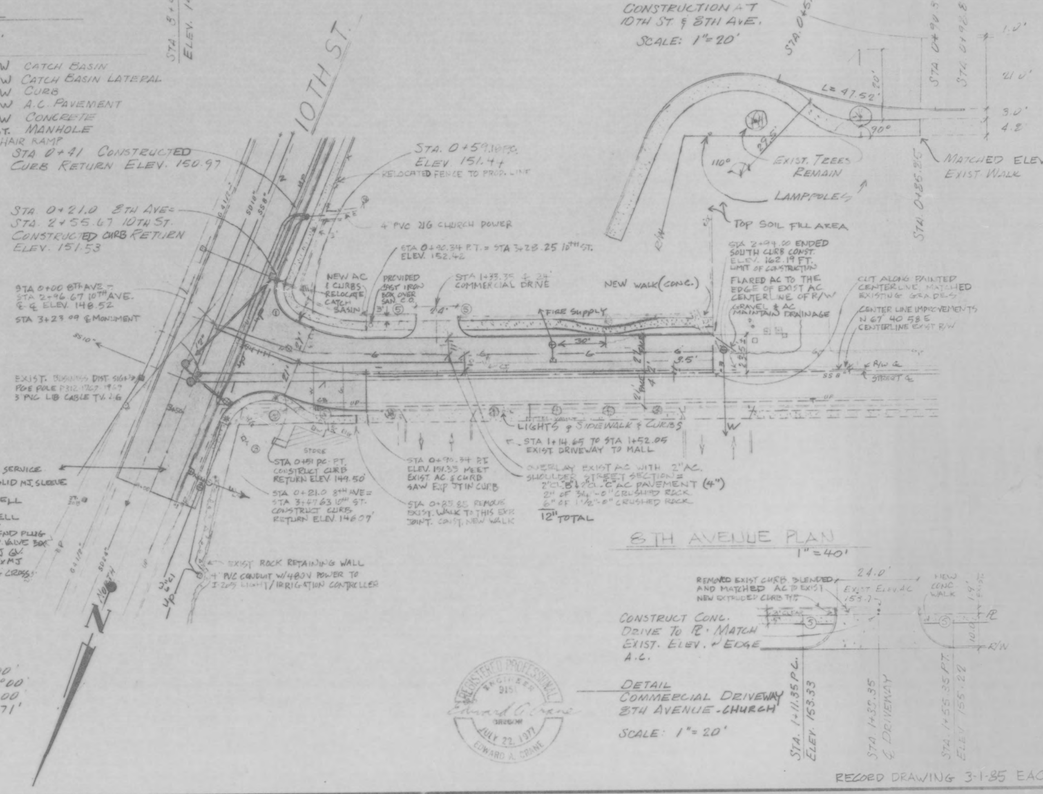

CURVE DATA

① R = 20.00' Δ = 90°00' T = 20.0 L = 31.42'	③ R = 30.00 Δ = 90°00' T = 30.00' L = 47.12'	R = 18.00' Δ = 90°00' T = 18.00 L = 18.71'
② ℄ R = 100.00' ℄ Δ = 22°19'02" ℄ T = 19.73' ℄ L = 38.95'	④ ℄ R = 101.00' ℄ Δ = 22°19'02" ℄ T = 19.92' ℄ L = 39.34'	

REDED DRAWING 3-1-85 EAC

ENGINEERS & PLANNERS
Coos Bay Oregon 5th and Highland 97420 (503) 269-1166
Portland Oregon 19 N.W. 5th Ave. 97209 (503) 226-6836

HGE INC

SHEET TITLE: PLAN & PROFILE

PROJECT: CITY OF WEST LINN
10TH ST. - 8TH AVE STREET IMPROVEMENTS
CLACKAMAS COUNTY, OREGON

PROJECT #
DATE

10 th St. / 8 th Ave. IMPROVEMENTS '84

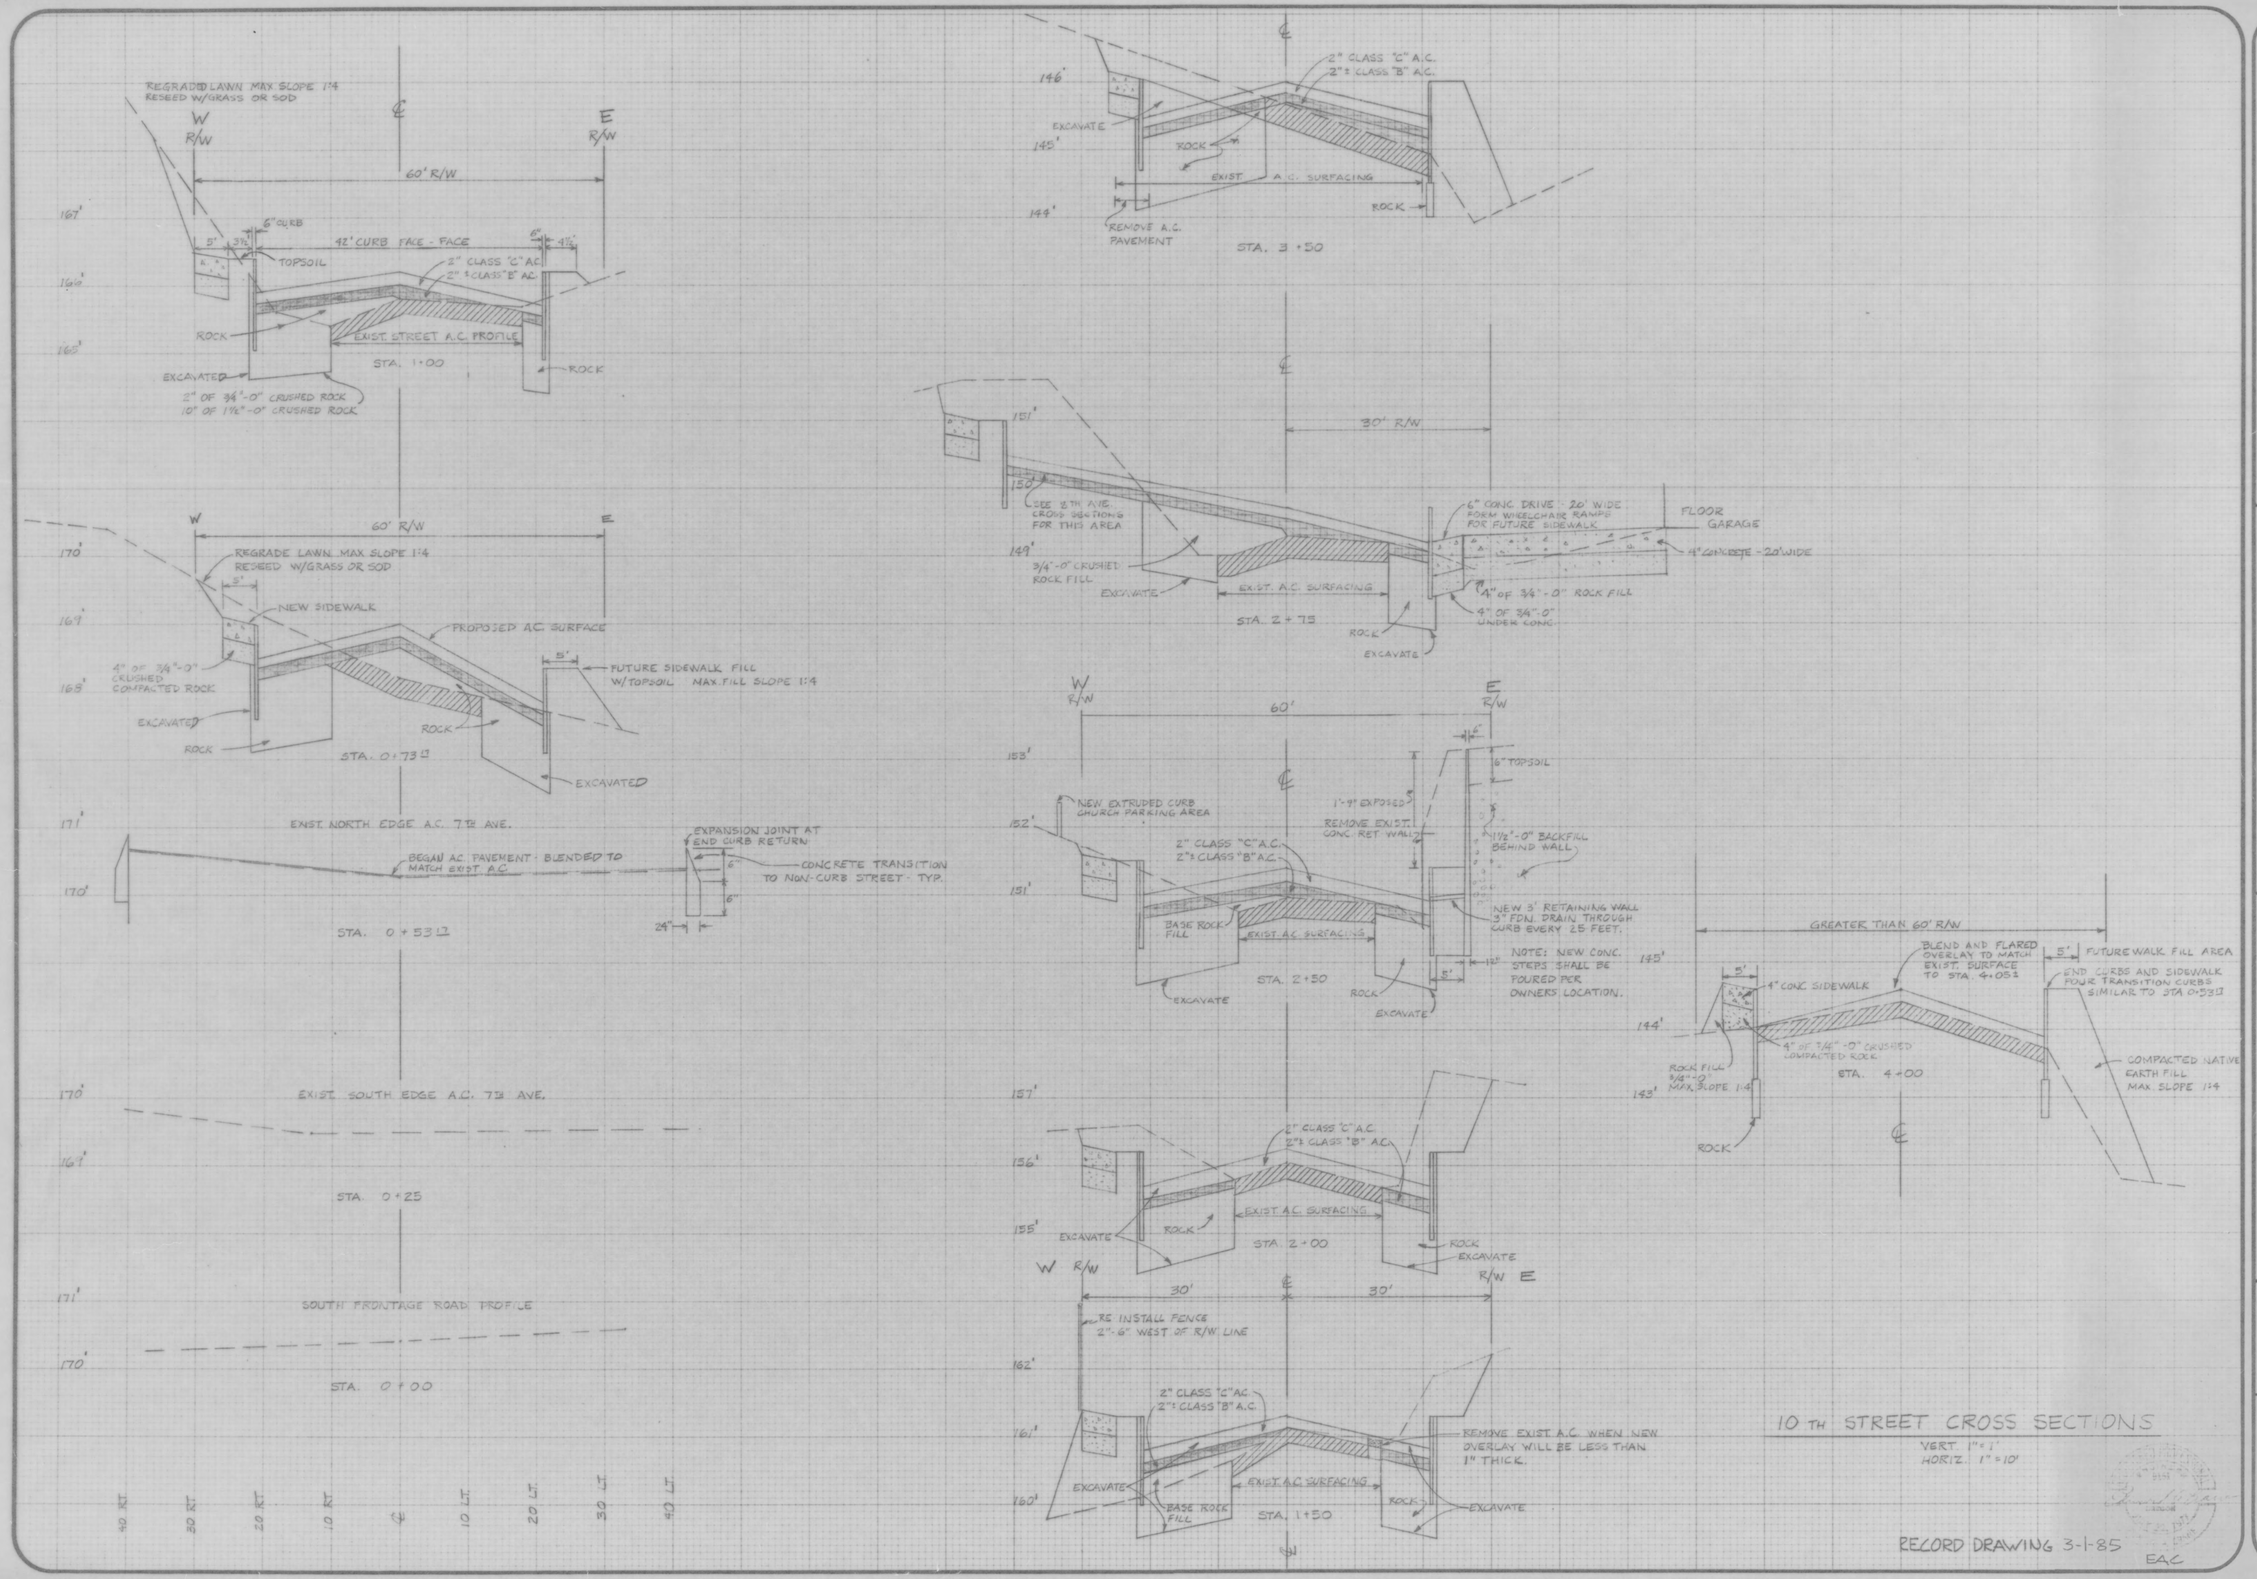

ENGINEERS & PLANNERS
Coos Bay, Oregon / 375 Park Ave. 97420 / (503) 269-1166
Portland, Oregon / 19 N. W. 5th Ave. 97209 / (503) 222-1687

HGE INC.

SHEET TITLE
10 TH STREET CROSS SECTIONS

PROJECT CITY OF WEST LINN
10 TH ST. AND 8TH AVE. STREET IMPROVEMENTS
CLACKAMAS COUNTY, OREGON

PROJECT # 3244
DATE OCT. 1984

SHEET NO. 2 OF 3

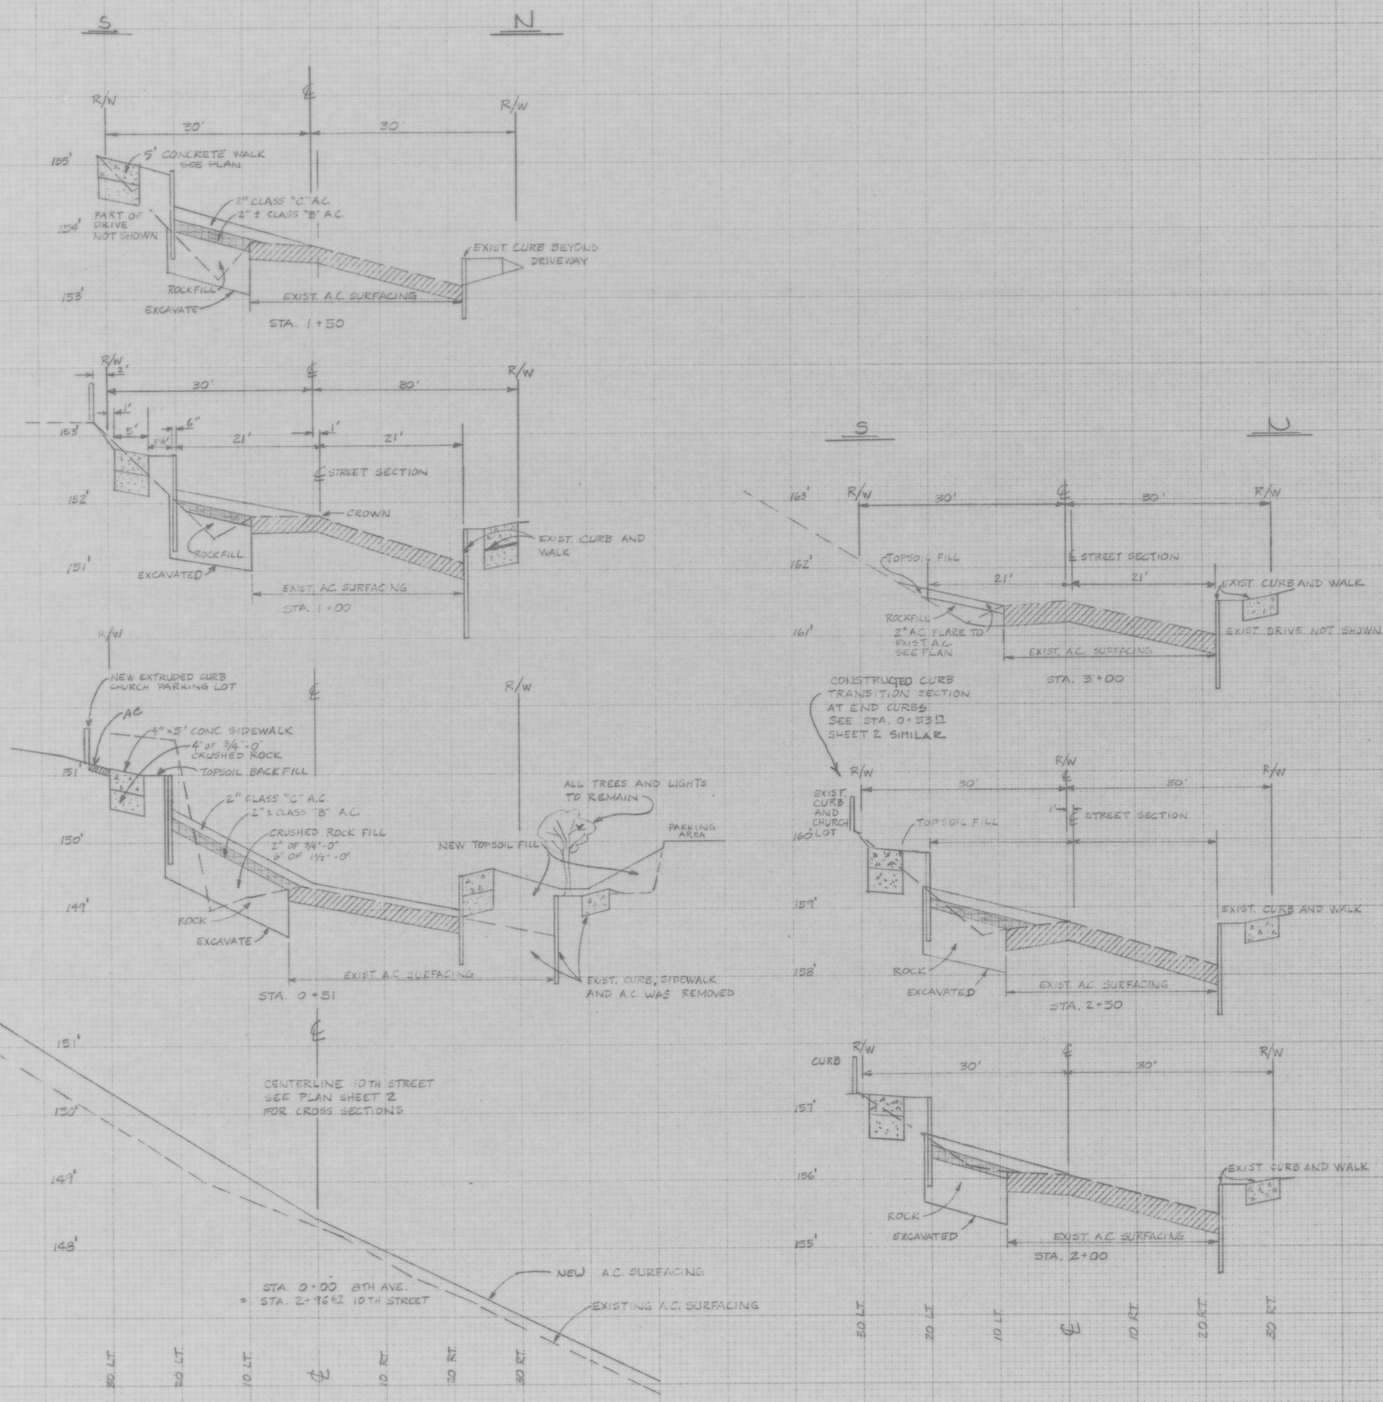

8TH. AVENUE CROSS SECTIONS

VERT. 1" = 1'
HORIZ. 1" = 10'

RECORD DRAWING 3-1-85 EAC

10th St. /8th Ave. Improvements, '84

ENGINEERS & PLANNERS
Coos Bay, Oregon / 375 Park Ave. 97420 / (503) 269-1166
Portland, Oregon / 19 N. W. 5th Ave. 97209 / (503) 222-1687
HGE INC.

SHEET TITLE
8TH AVENUE CROSS SECTIONS

PROJECT CITY OF WEST LINN
10TH ST. AND 8TH AVE. STREET IMPROVEMENTS
CLACKAMAS COUNTY, OREGON

PROJECT # 3244
DATE OCT. 1984

SHEET NO. 3 OF 3