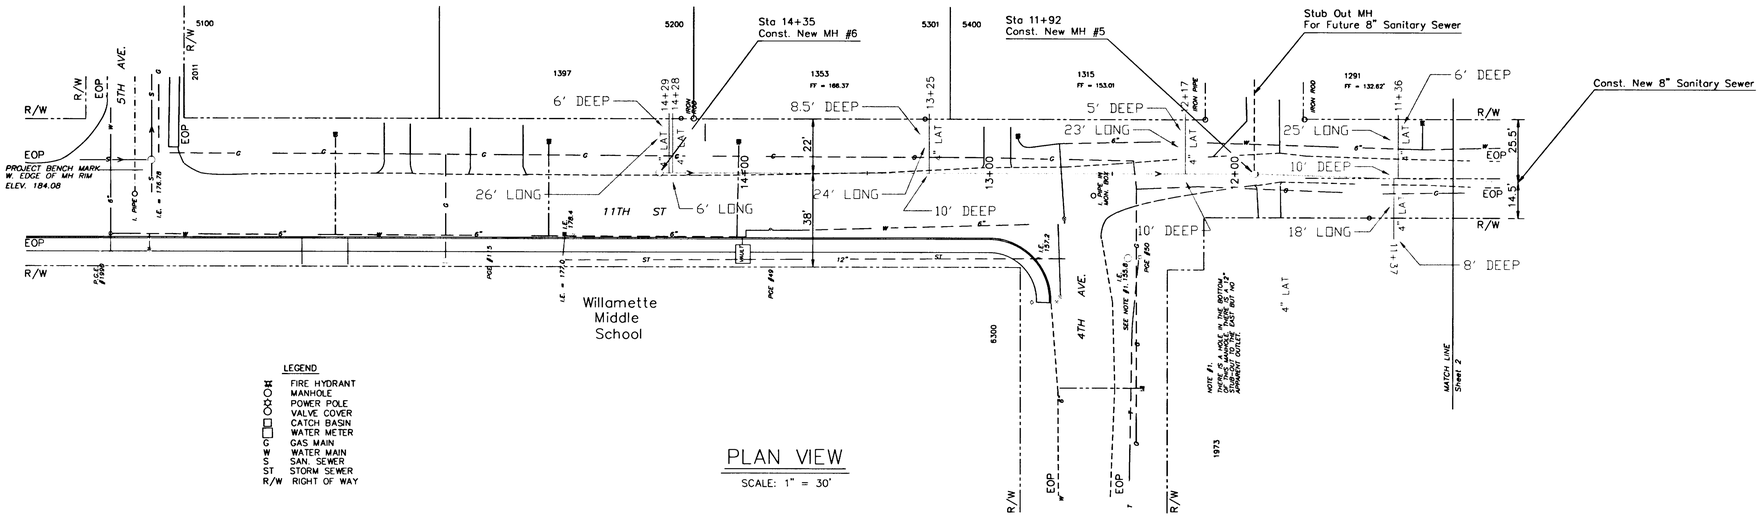

LEGEND

- FIRE HYDRANT
- MANHOLE
- POWER POLE
- VALVE COVER
- CATCH BASIN
- WATER METER
- G GAS MAIN
- W WATER MAIN
- S SAN. SEWER
- ST STORM SEWER
- R/W RIGHT OF WAY

PLAN VIEW

SCALE: 1" = 30'

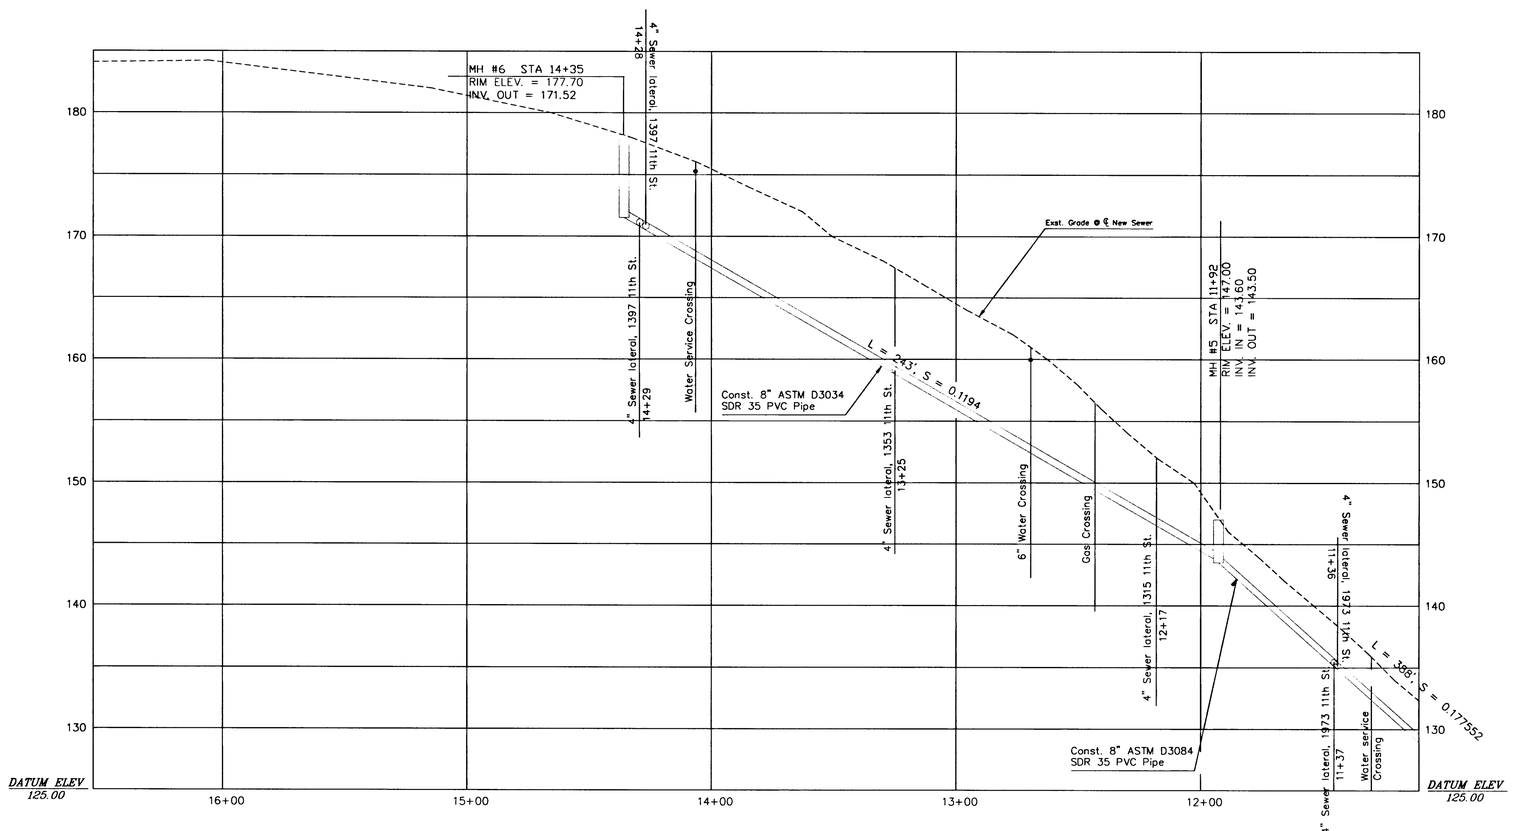

PROFILE VIEW

H: 1" = 30'
V: 1" = 6'

DATE	NO.	REVISION
1/8/98	1	Alignment change
7/28/99	1	AS BUILTS

DRAWN BY: REPPETO/K.KEMP/WOEBKE
SCALE: AS NOTED
DATE: 7-28-99

CITY OF WEST LINN
ENGINEERING DEPARTMENT

11th ST. SANITARY SEWER IMPROVEMENT

SURVEYED BY: JOHN REPPETO, P.L.S. #657
CHECKED BY: STAFF
DESIGNED BY: K.GARLINGHOUSE, P.E.

Project CI-92-05
DRAWING FILE: M:/Projects/CIP Projects/SS/Infill/10th and 11th/DWG

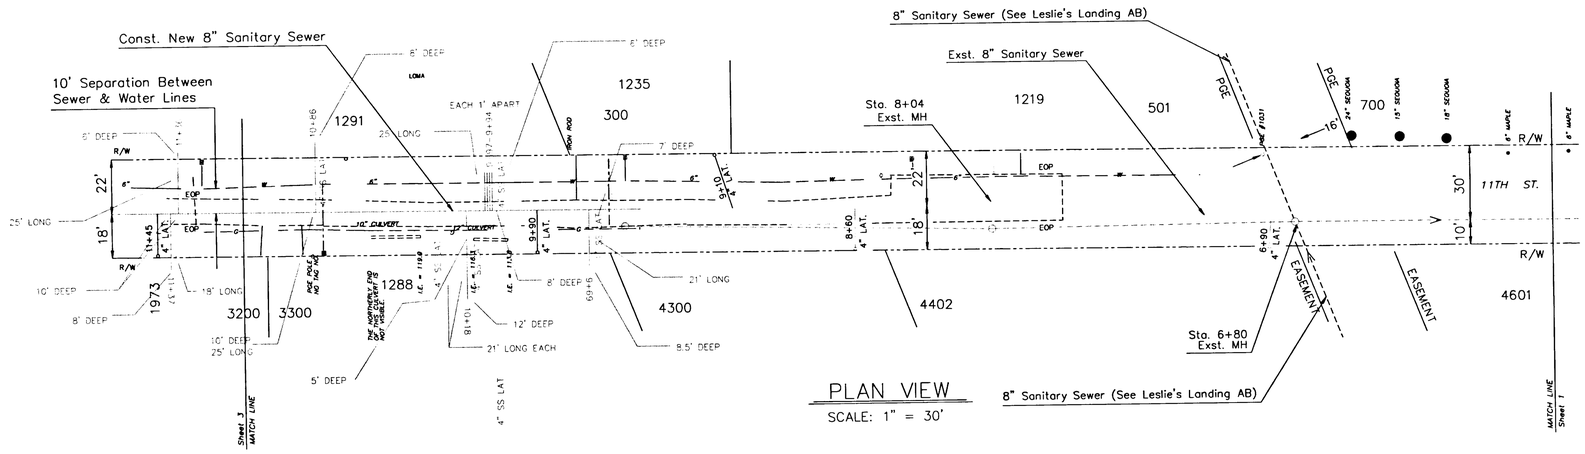

PLAN VIEW

SCALE: 1" = 30'

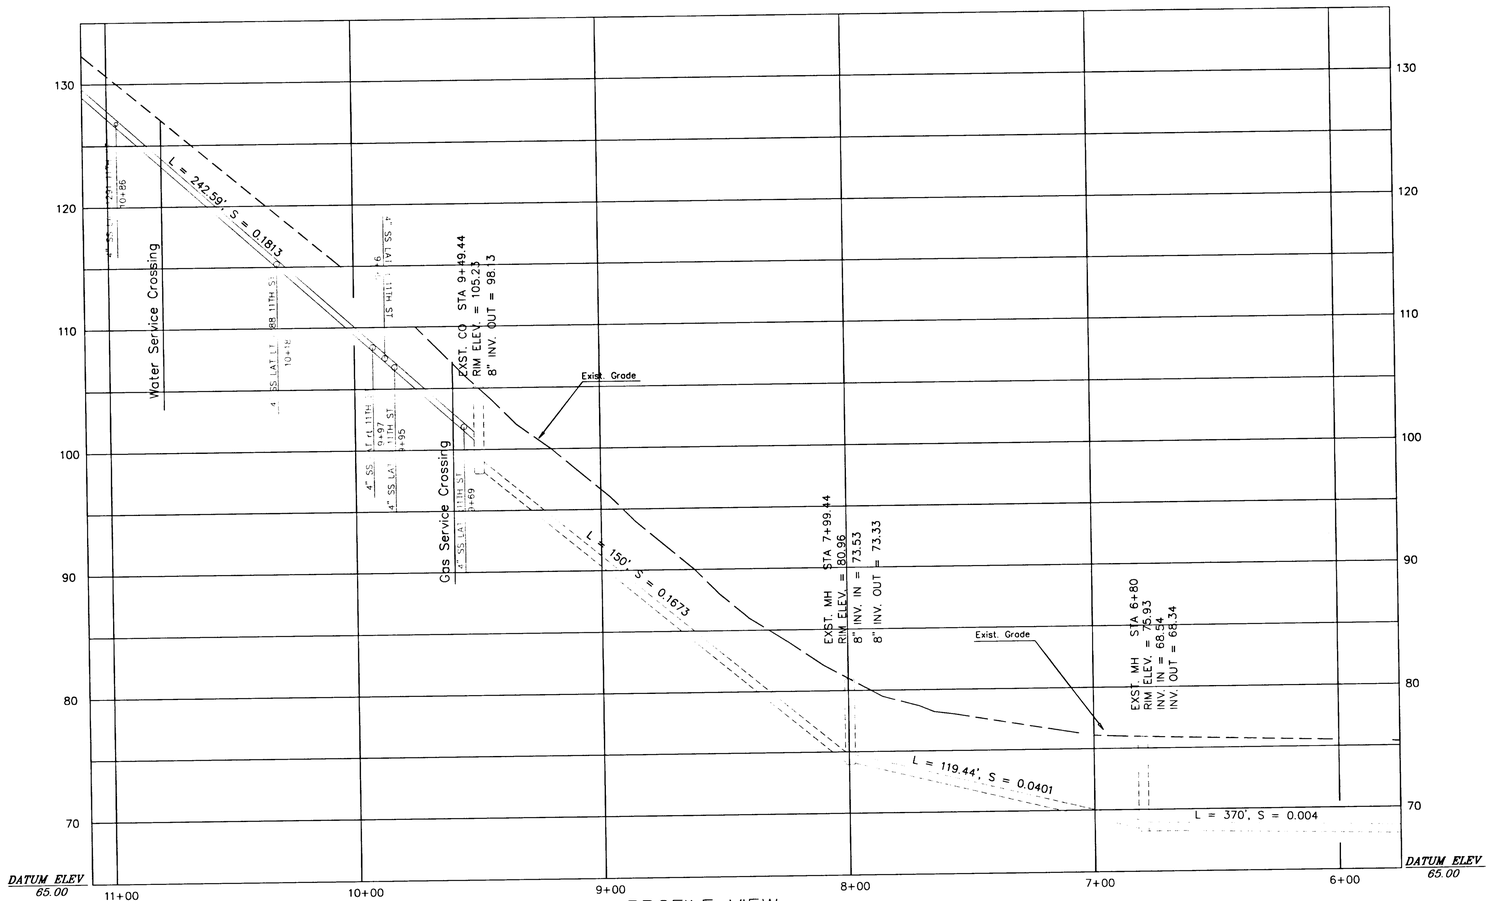

PROFILE VIEW

H: 1" = 30'
V: 1" = 6'

DATE	NO.	REVISION
12/1/97	1	As built

DRAWN BY: REPPETO/K.KEMP
FILE: CI-92-05 DATE: 4-1-93
SCALE: AS NOTED

CITY OF WEST LINN
ENGINEERING DEPARTMENT

WILLAMETTE PARK/11th ST. SANITARY SEWER IMPROVEMENT
STA. 5+75 to STA. 11+10

SURVEYED BY: JOHN REPPETO, P.L.S. # 657
CHECKED BY: STAFF
DESIGNED BY: K.GARLINGHOUSE, P.E.

PROJECT NO. CI-92-05
FILE: ...P\920511st\plan1.dwg