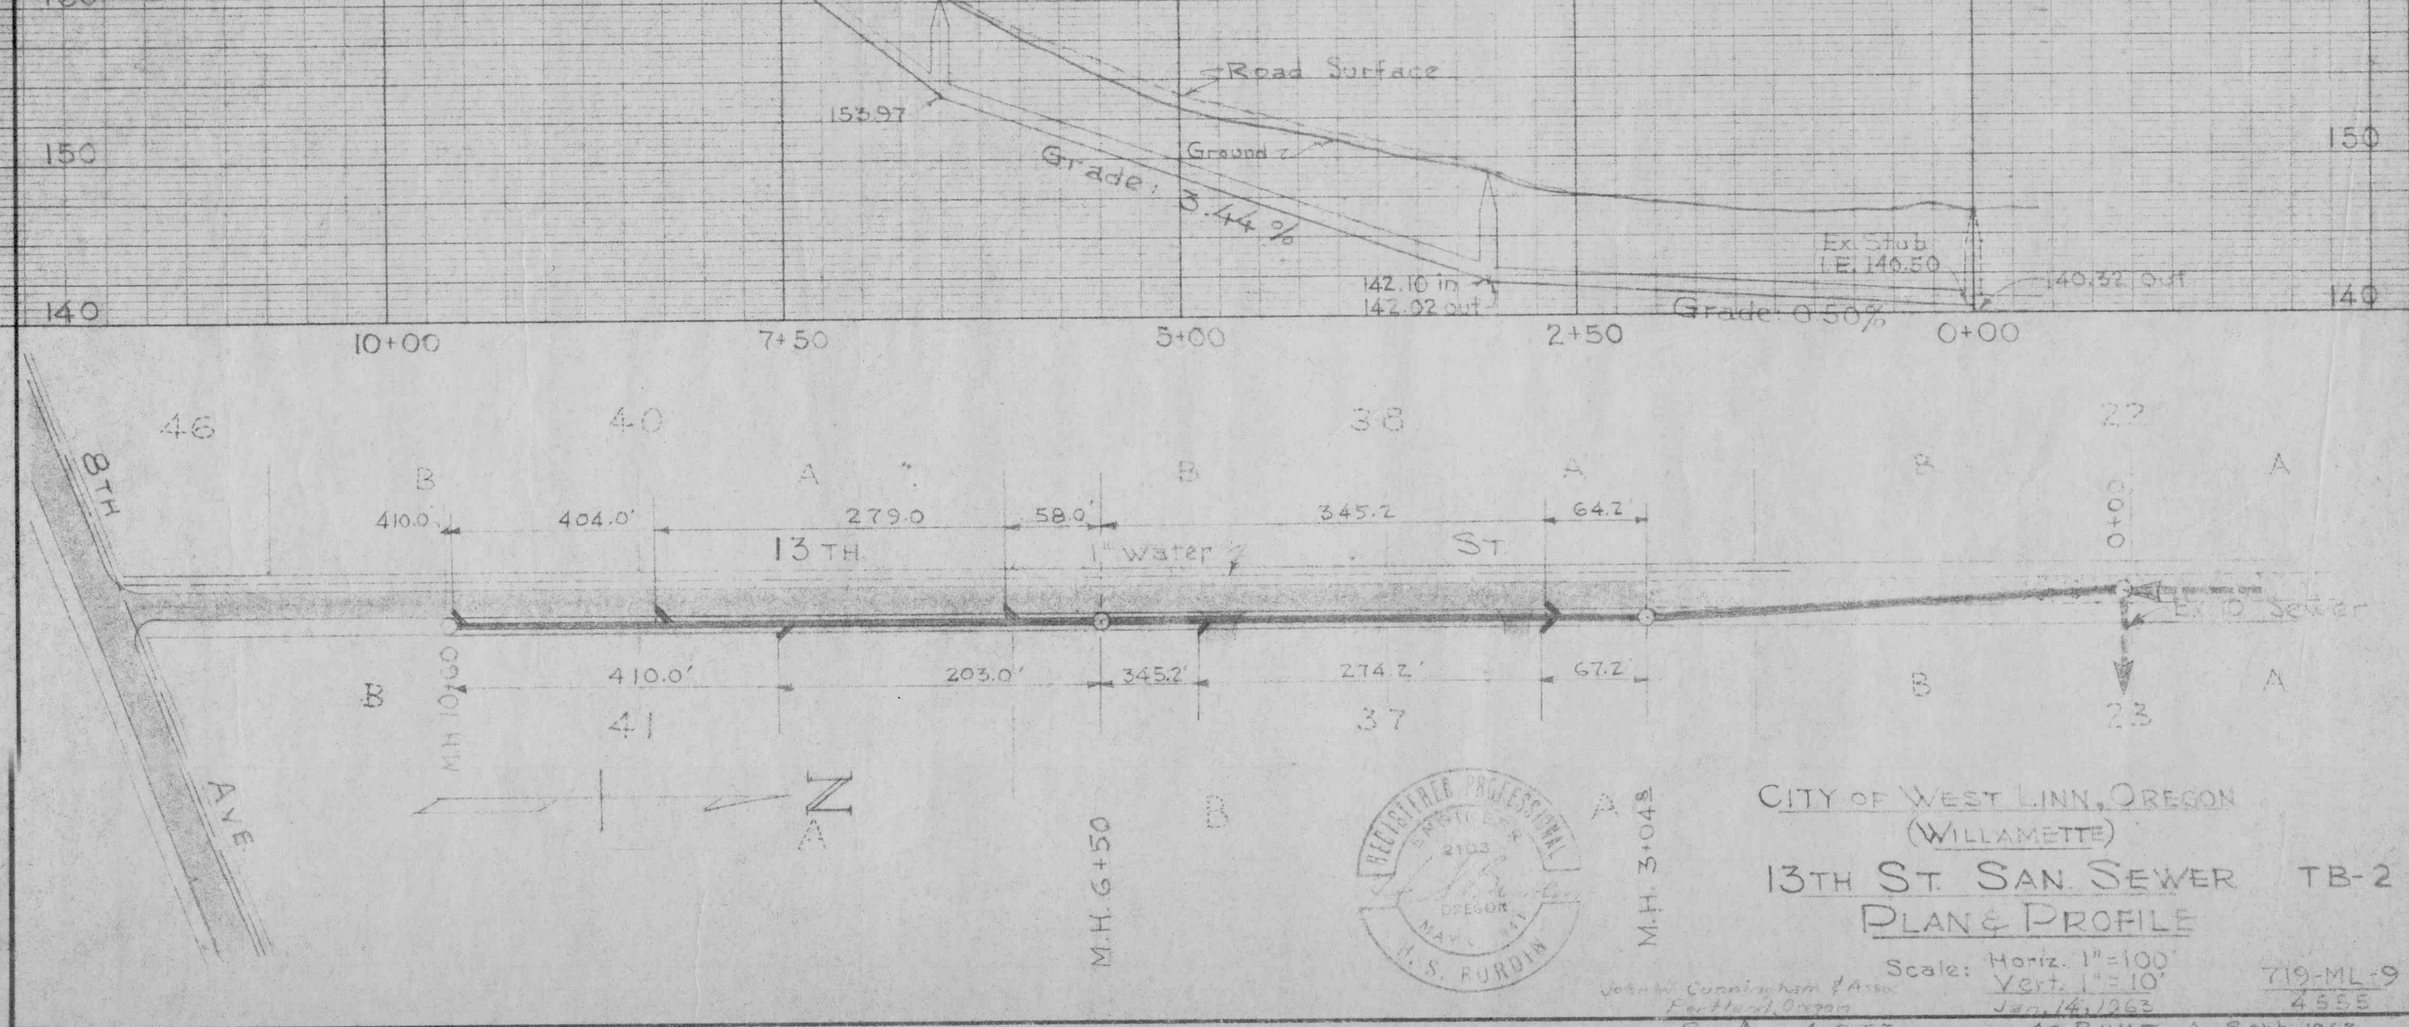

CITY OF WEST LINN, OREGON
(WILLAMETTE)

13TH ST. SAN. SEWER TB-2

PLAN & PROFILE

Scale: Horiz. 1" = 100'
Vert. 1" = 10'
Jan. 14, 1963

719-ML-9
4555

John W. Cunningham & Assoc.
Portland, Oregon

Rev. 1 4-8-63 AS BUILT 2 Sept. 1963

REGISTERED PROFESSIONAL ENGINEER 2103 OREGON MAY 1941 H. S. BURDIN