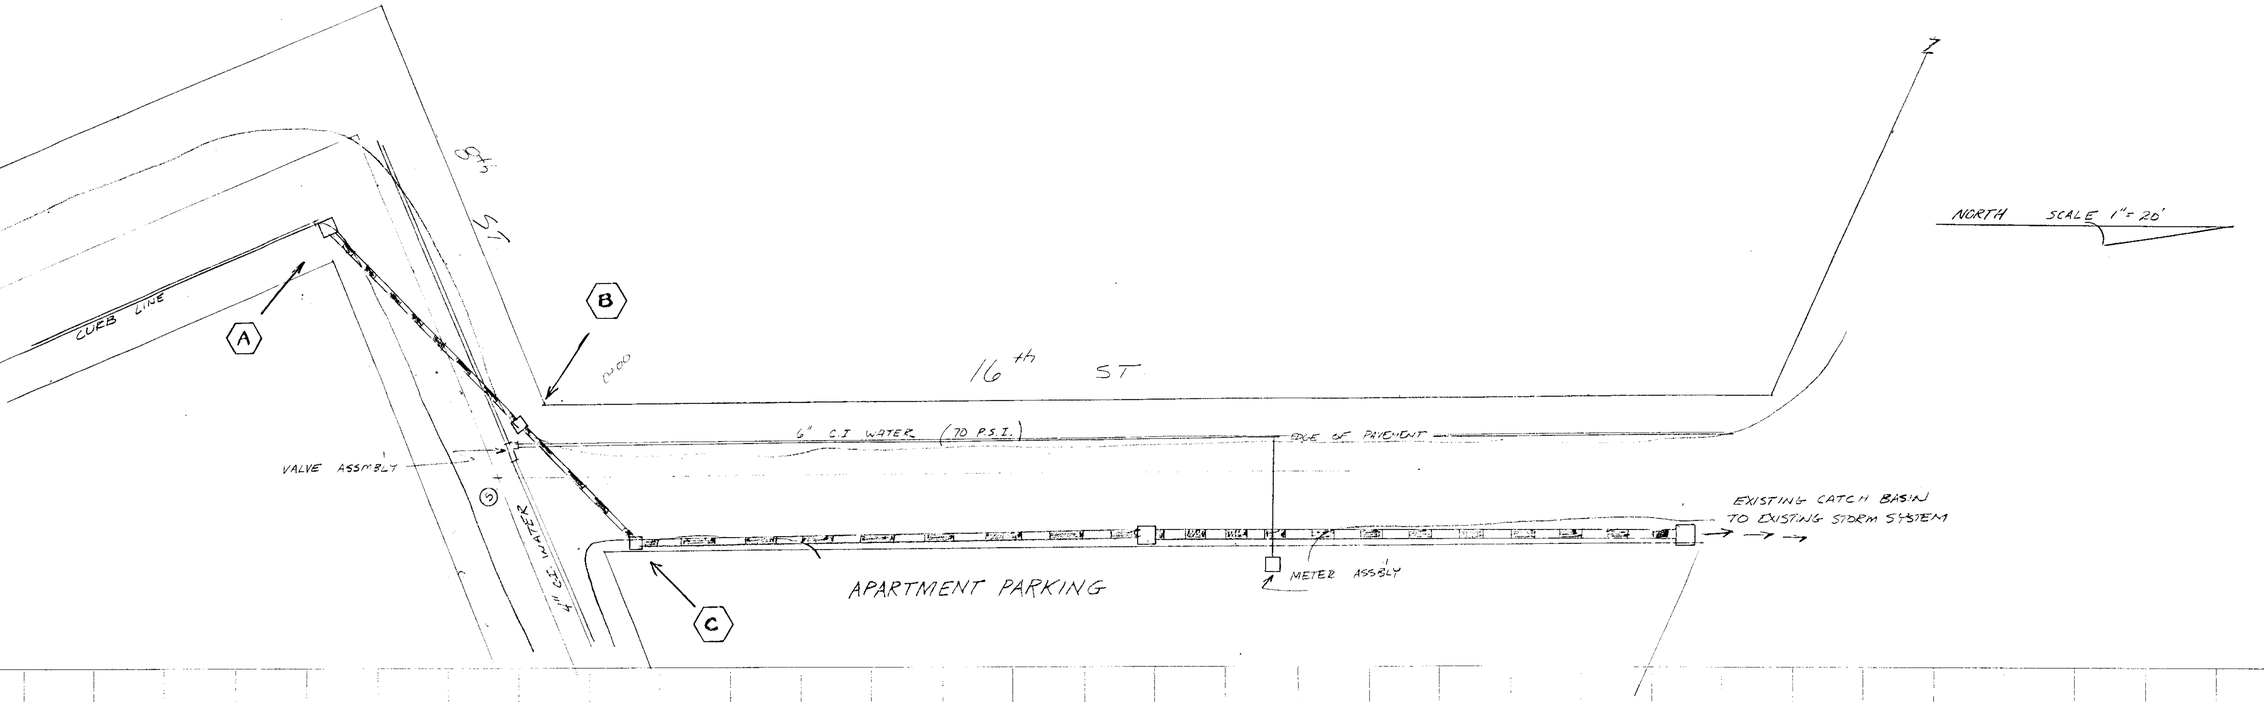

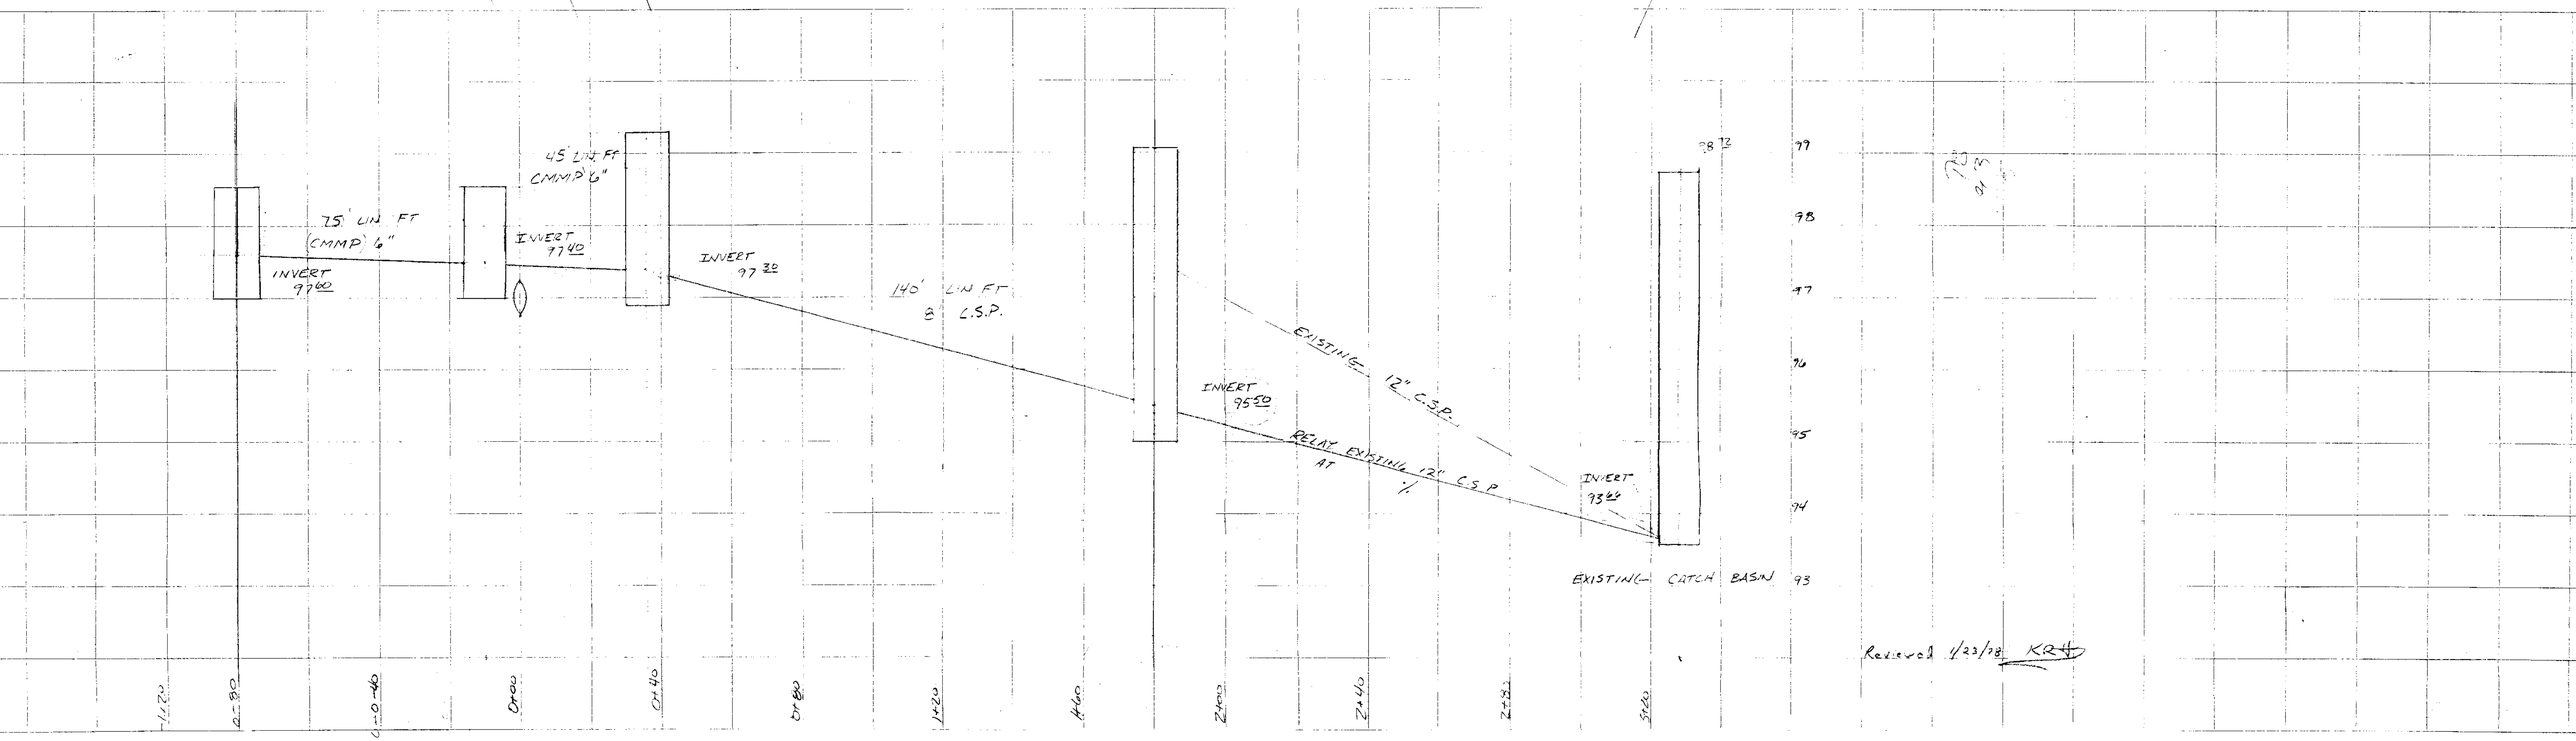

TRADE STANDARD MARK
100% RAG PAPER
CROSS SECTION 10 X 10
PRINTED IN U.S.A.
KEUFFEL & ESSER CO.
NEW YORK.