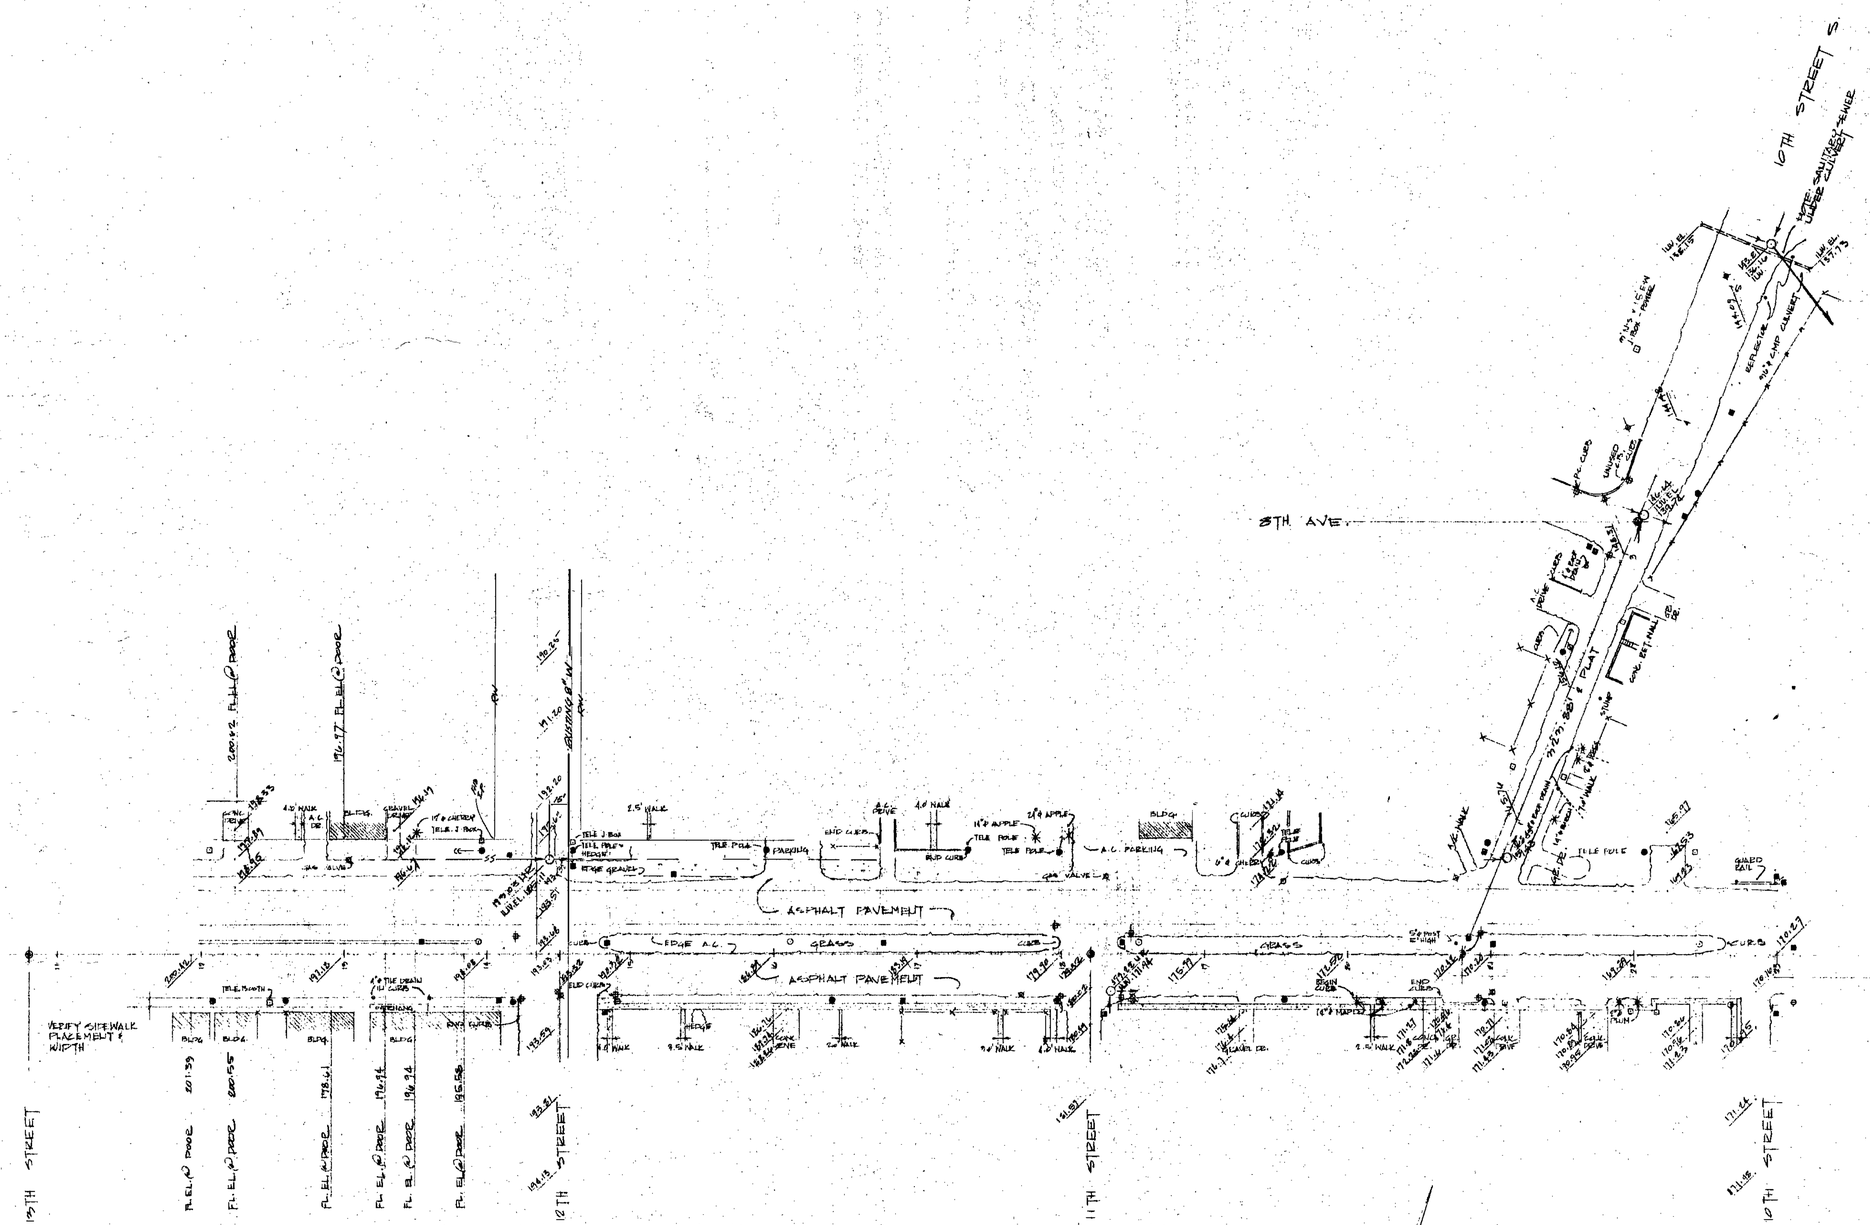

SCALE: 1" = 50'

DRAIN IMPROVEMENTS
PROJECT # 3146
WORK COPY

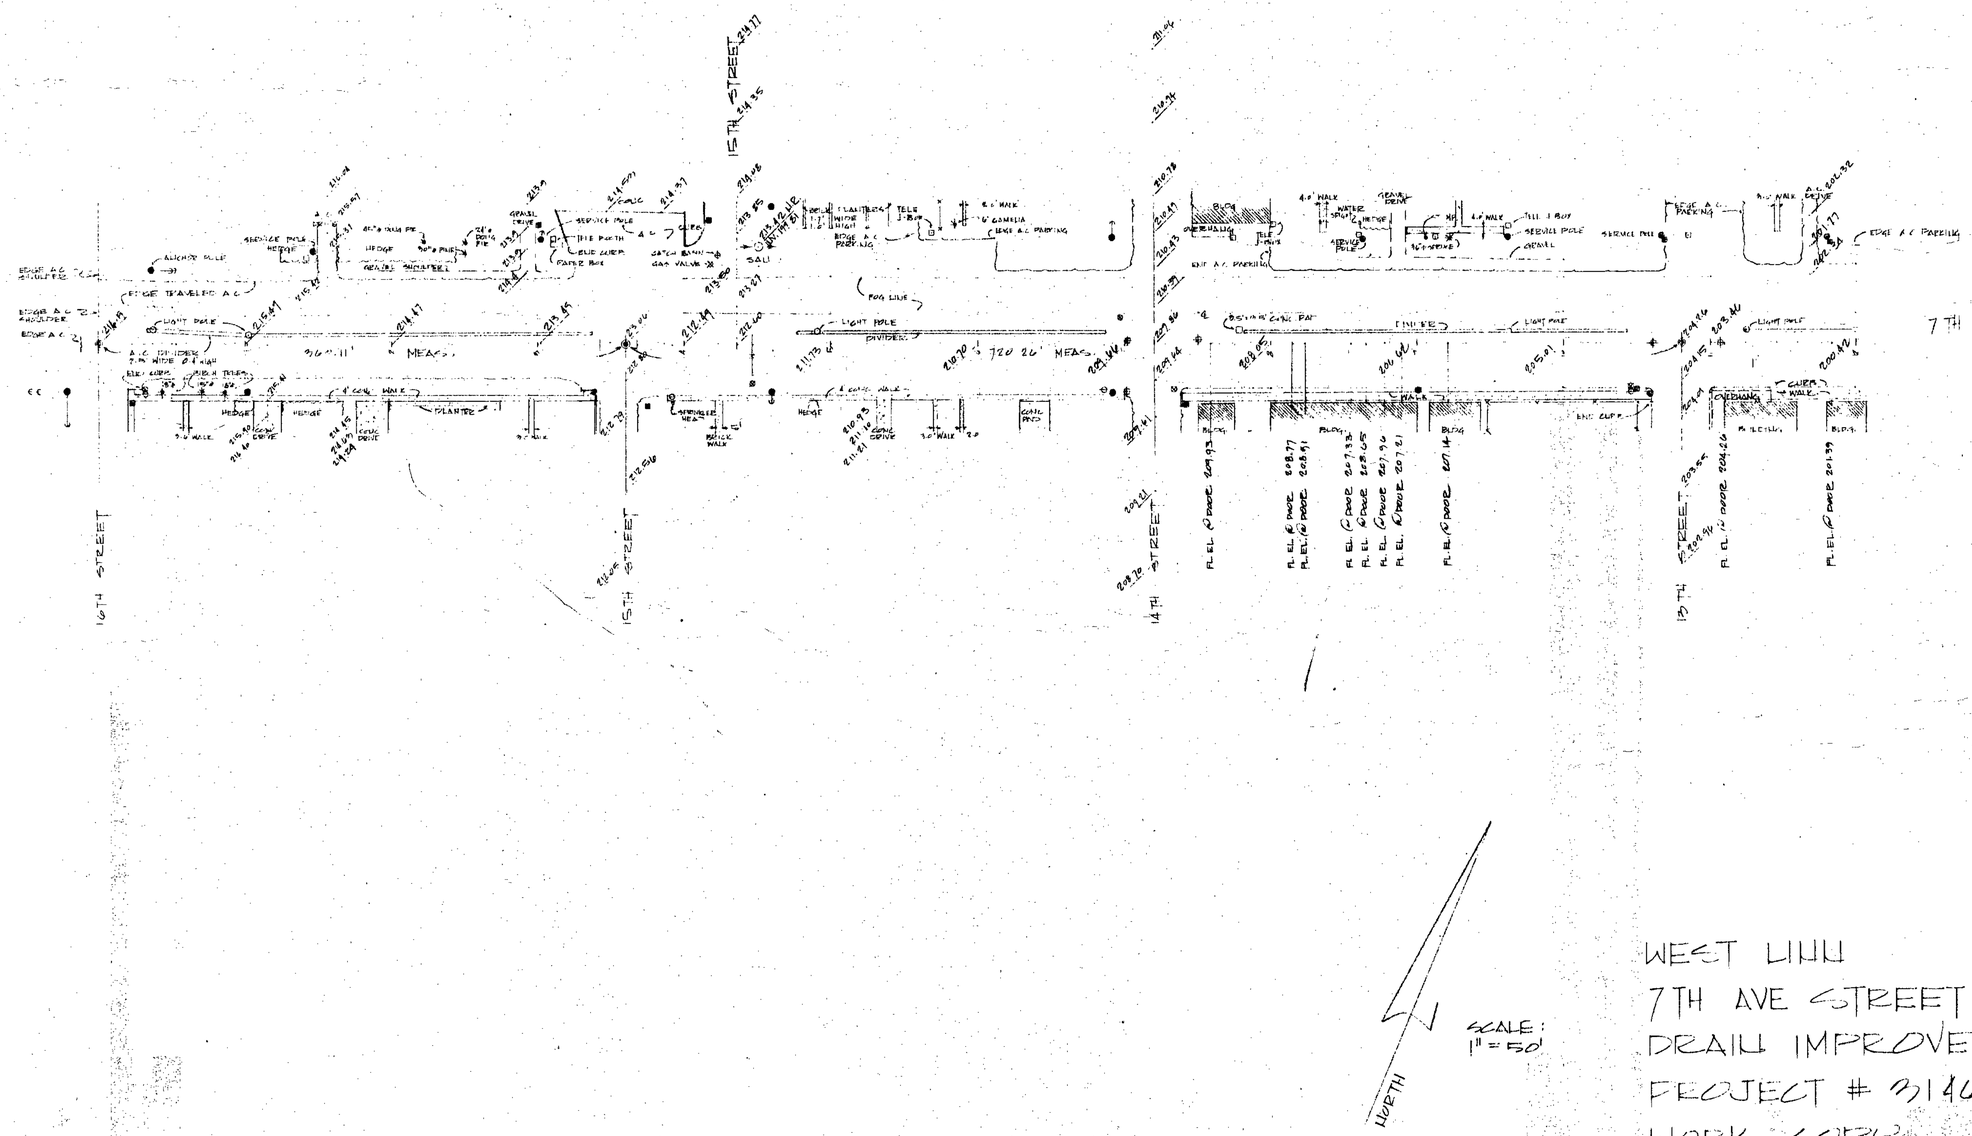

WEST LINN
7TH AVE STREET & STORM
DRAIN IMPROVEMENTS
PROJECT # 3146
WORK COPY