RECORD OF SURVEY
FOR
JACK McKINNON
LOTS 28, 29, 30, 31 & 32, ROBINWOOD SUBDIVISION
LOCATED IN SECTION 14, T-2S, R-1E, W.M.
CLACKAMAS COUNTY, OREGON
BASIS OF BEARING: ℄ ARBOR DRIVE, PLAT OF "ROBINWOOD".
SCALE: 1" = 50'
JOB NO: 77-30-8
DATE: 11-7-77

ARBOR DRIVE

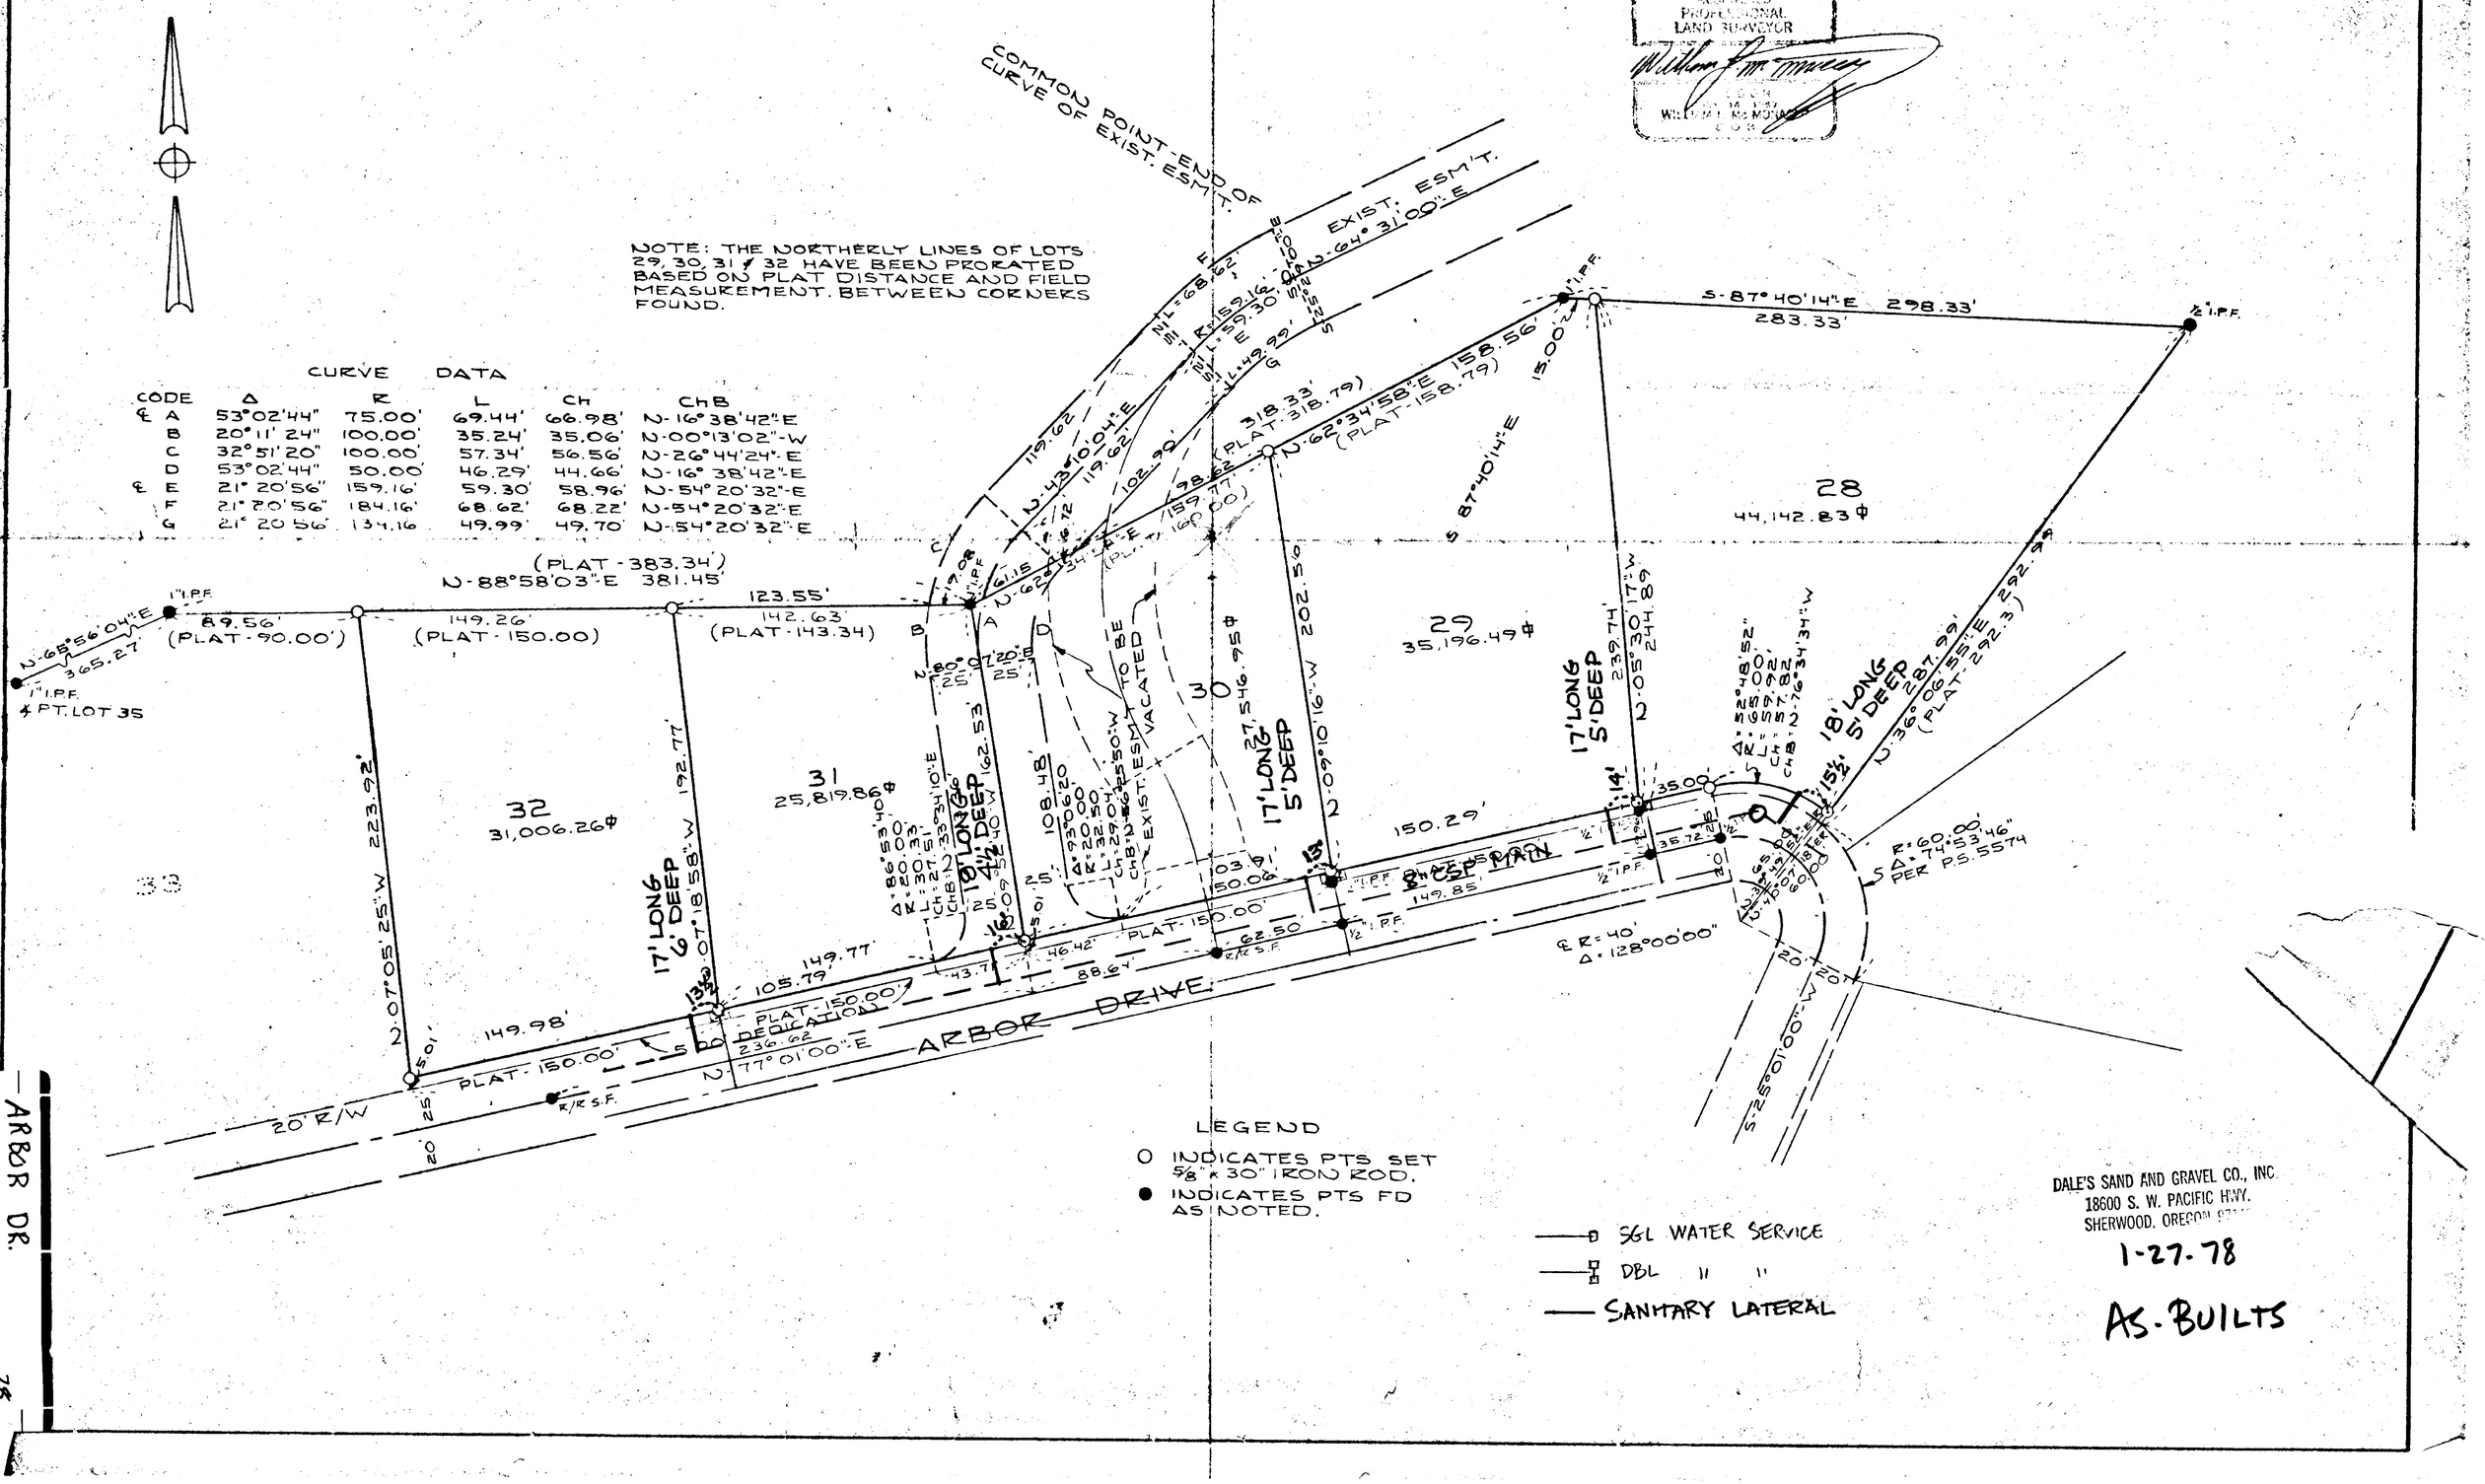

NOTE: THE NORTHERLY LINES OF LOTS 29, 30, 31 & 32 HAVE BEEN PRORATED BASED ON PLAT DISTANCE AND FIELD MEASUREMENT. BETWEEN CORNERS FOUND.

CURVE DATA

CODE	Δ	R	L	Ch	ChB
℄ A	53°02'44"	75.00'	69.44'	66.98'	N-16°38'42"-E
B	20°11'24"	100.00'	35.24'	35.06'	N-00°13'02"-W
C	32°51'20"	100.00'	57.34'	56.56'	N-26°44'24"-E
D	53°02'44"	50.00'	46.29'	44.66'	N-16°38'42"-E
℄ E	21°20'56"	159.16'	59.30'	58.96'	N-54°20'32"-E
F	21°20'56"	184.16'	68.62'	68.22'	N-54°20'32"-E
G	21°20'56"	134.16	49.99'	49.70'	N-54°20'32"-E

LEGEND

○ INDICATES PTS SET 5/8" x 30" IRON ROD.
● INDICATES PTS FD AS NOTED.

SGL WATER SERVICE
DBL " "
SANITARY LATERAL

DALE'S SAND AND GRAVEL CO., INC.
18600 S. W. PACIFIC HWY.
SHERWOOD, OREGON 97...

1-27-78

AS-BUILTS

ARBOR DR.