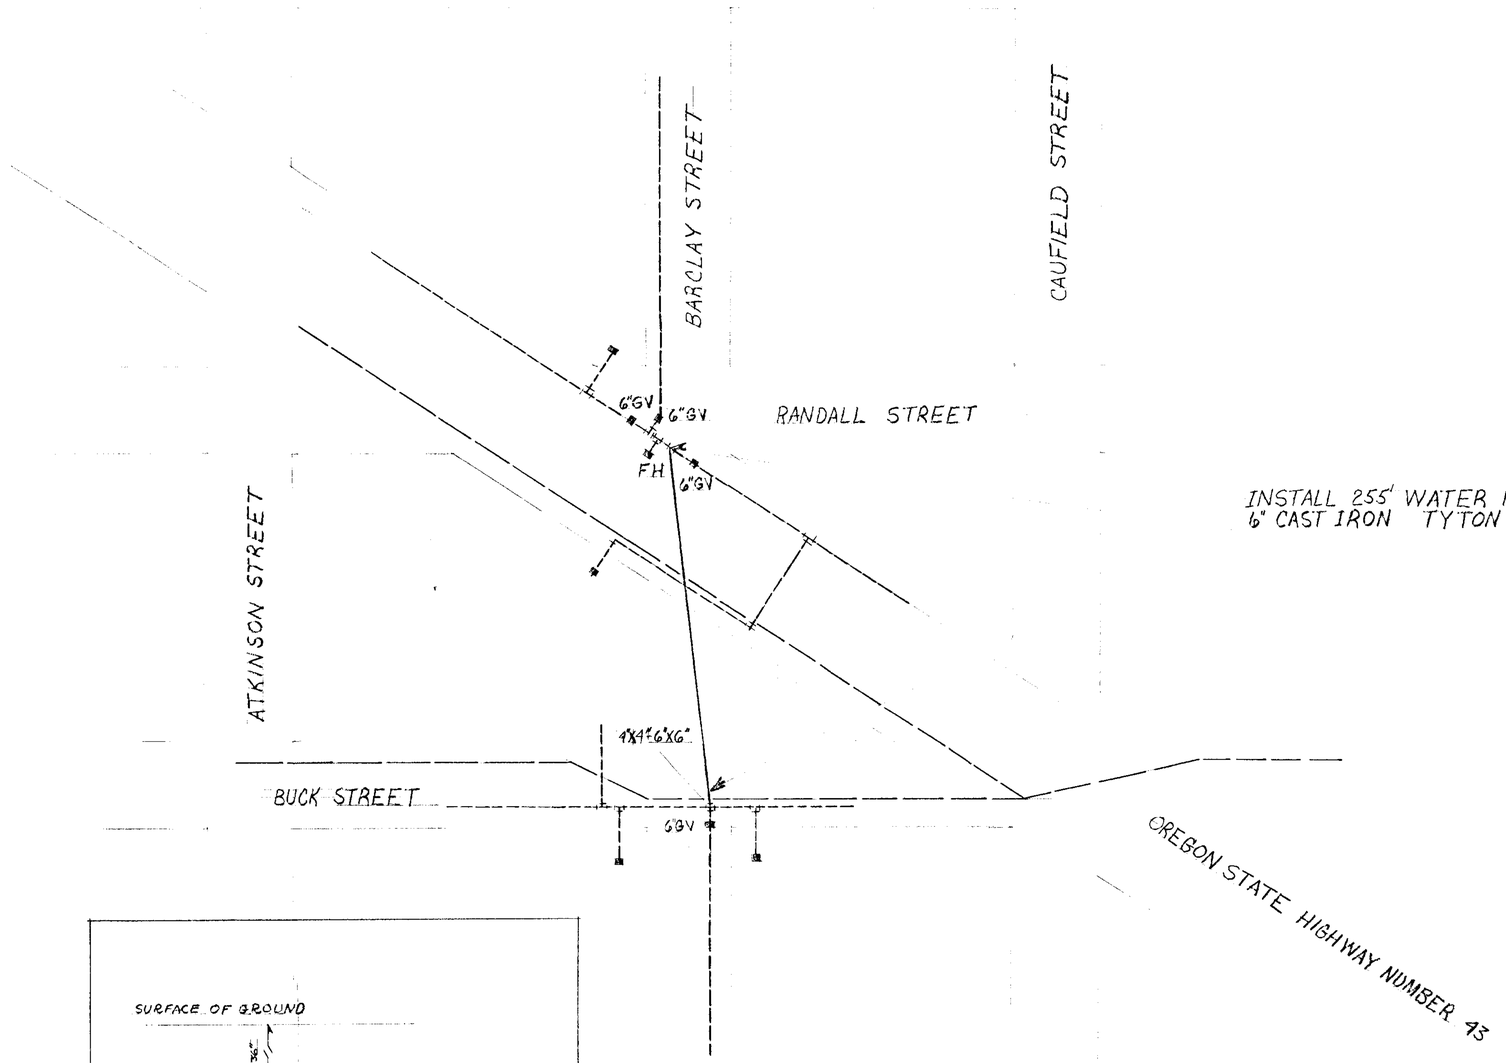

INSTALL 255' WATER MAIN
6" CAST IRON TYTON JOINT

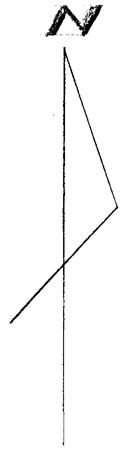

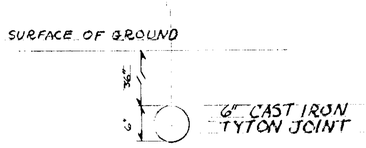

TYPICAL SECTION

SCALE 1" = 50'
EXISTING MAIN
EXISTING SEWER
NEW MAIN

CITY OF WEST LINN-ORE
BARCLAY STREET
WATER MAIN EXTENSION
APPROVED:
CITY ENGINEER
SCALE AS SHOWN DATE
DSGN:
CK:
SHEET 1 OF 1 FILE NO.