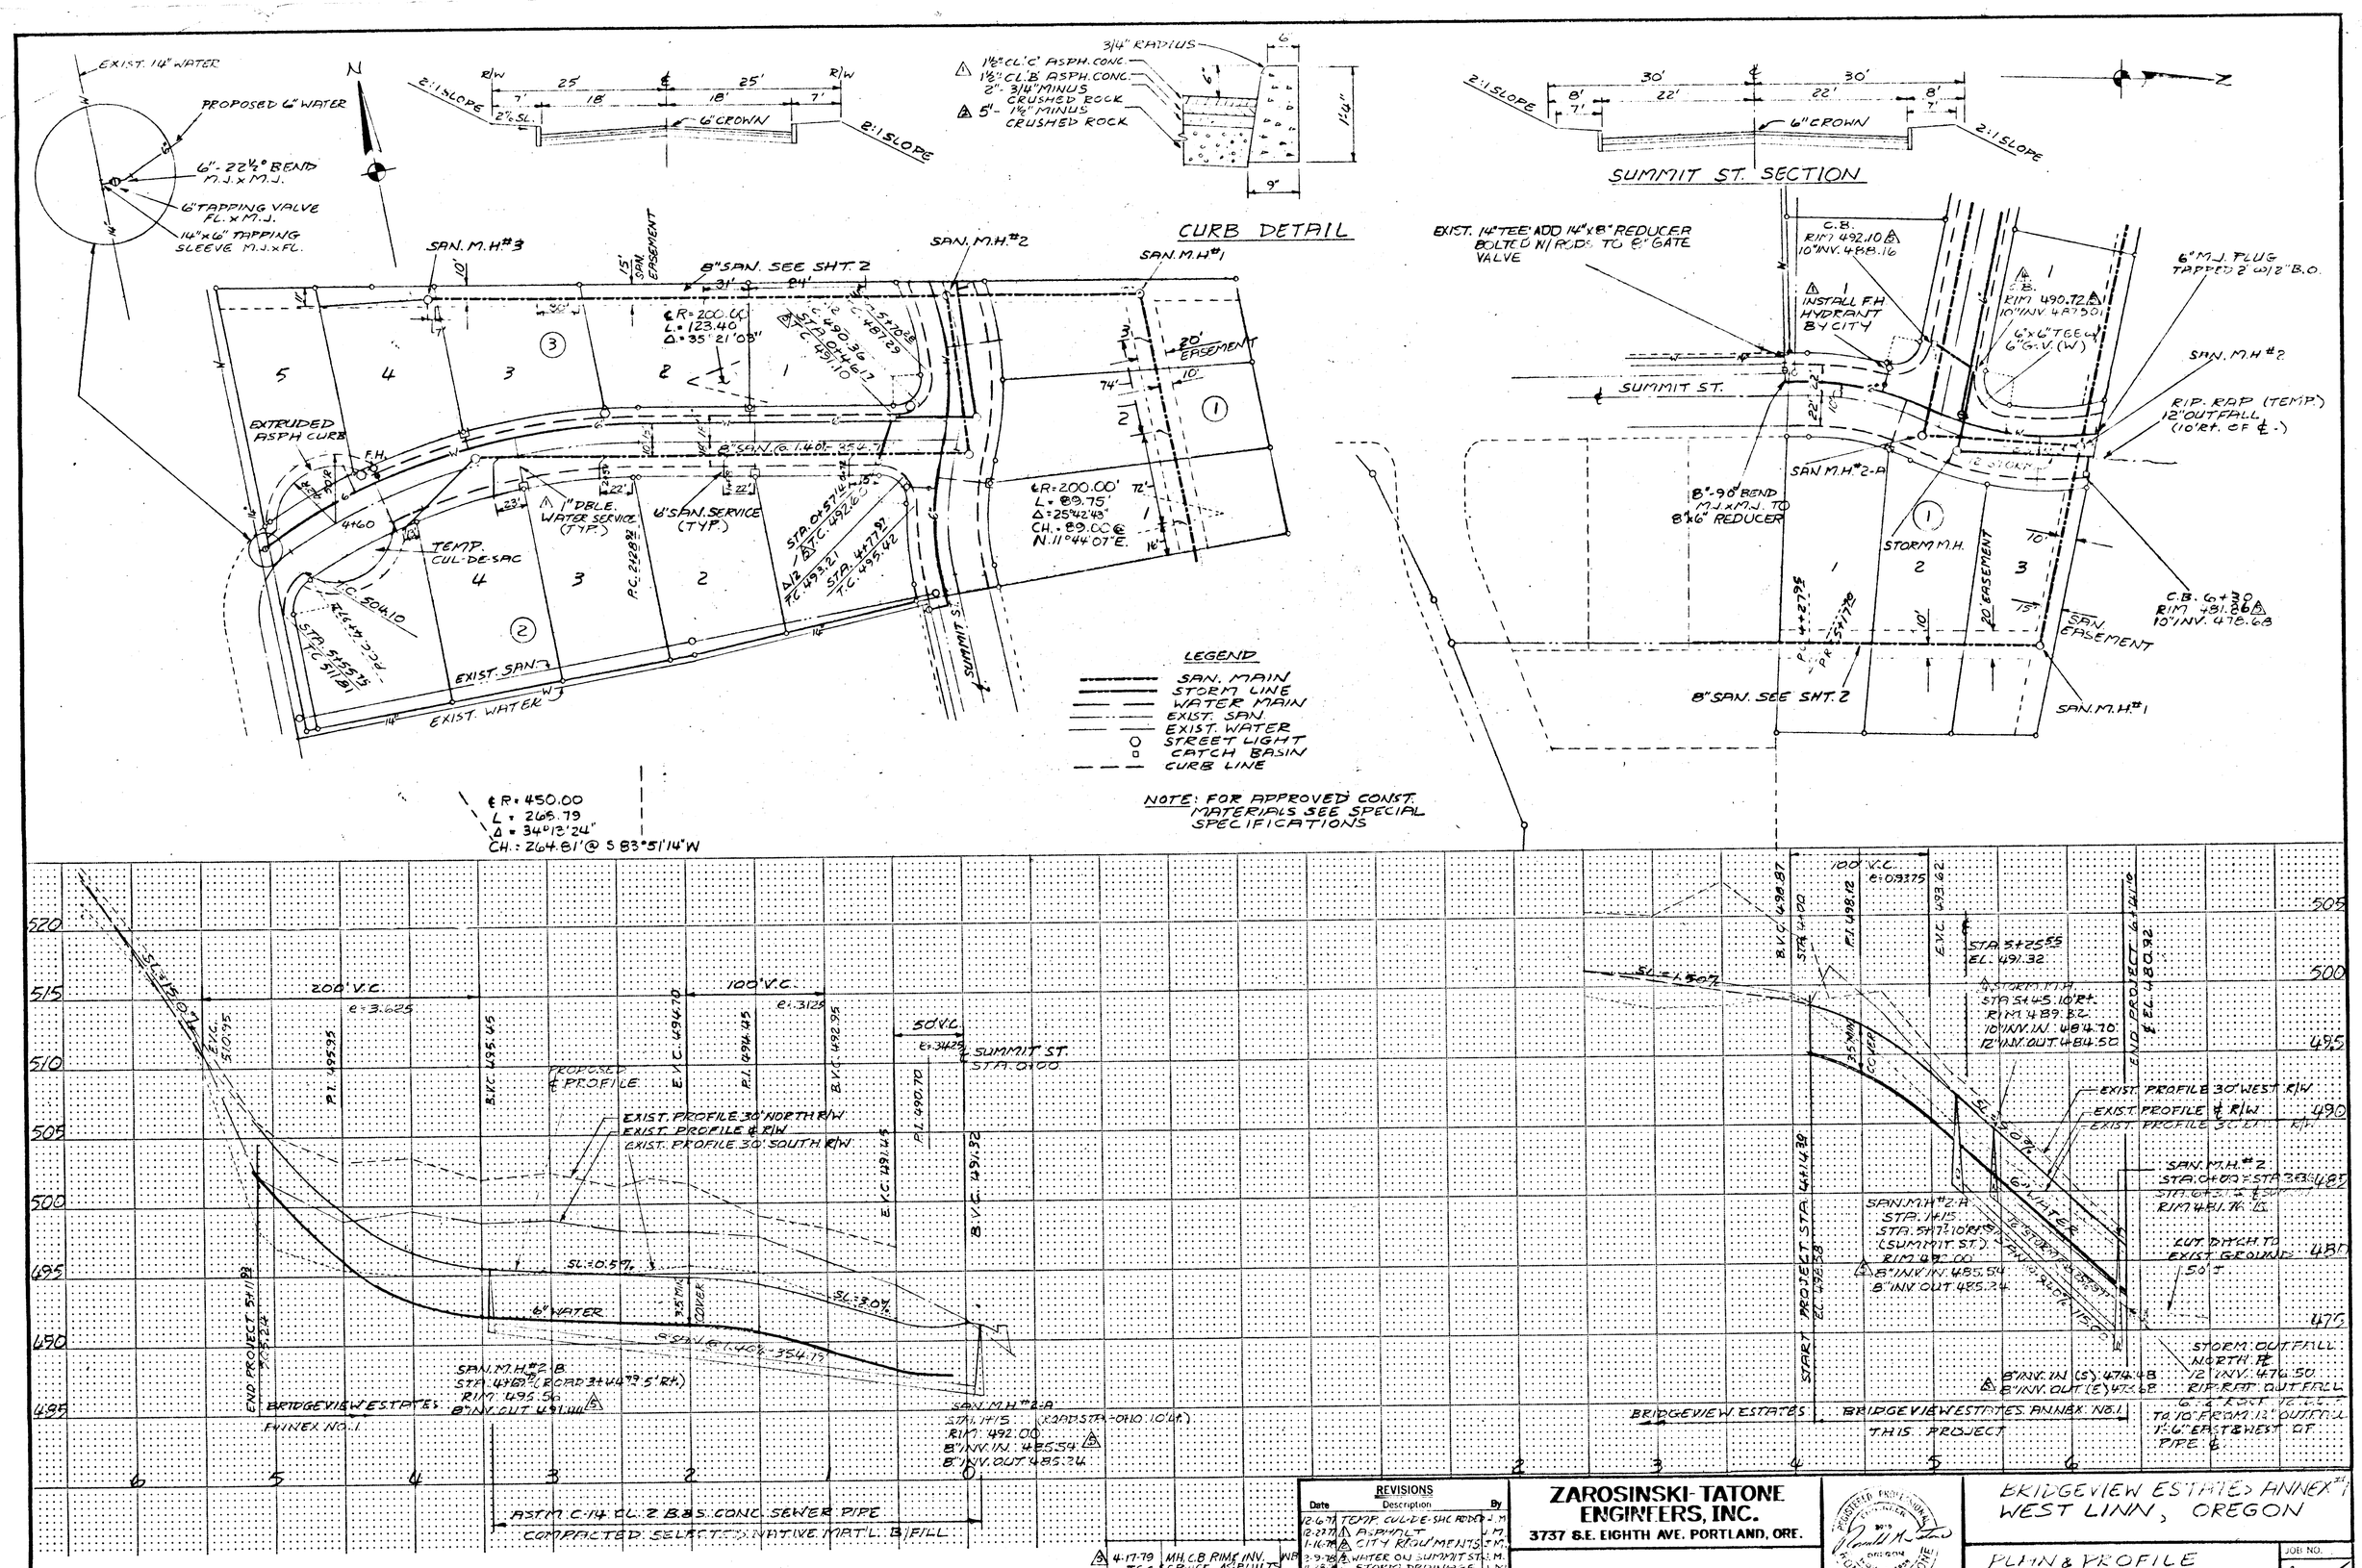

CASCADE ARCHITECTURAL AND ENGINEERING SUPPLIES CO. PORTLAND, OREGON

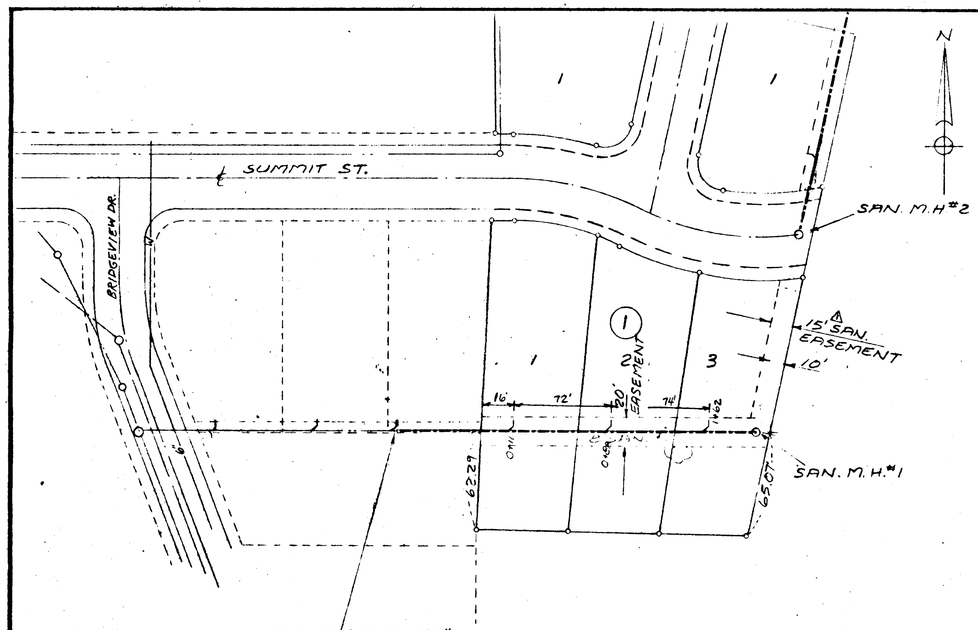

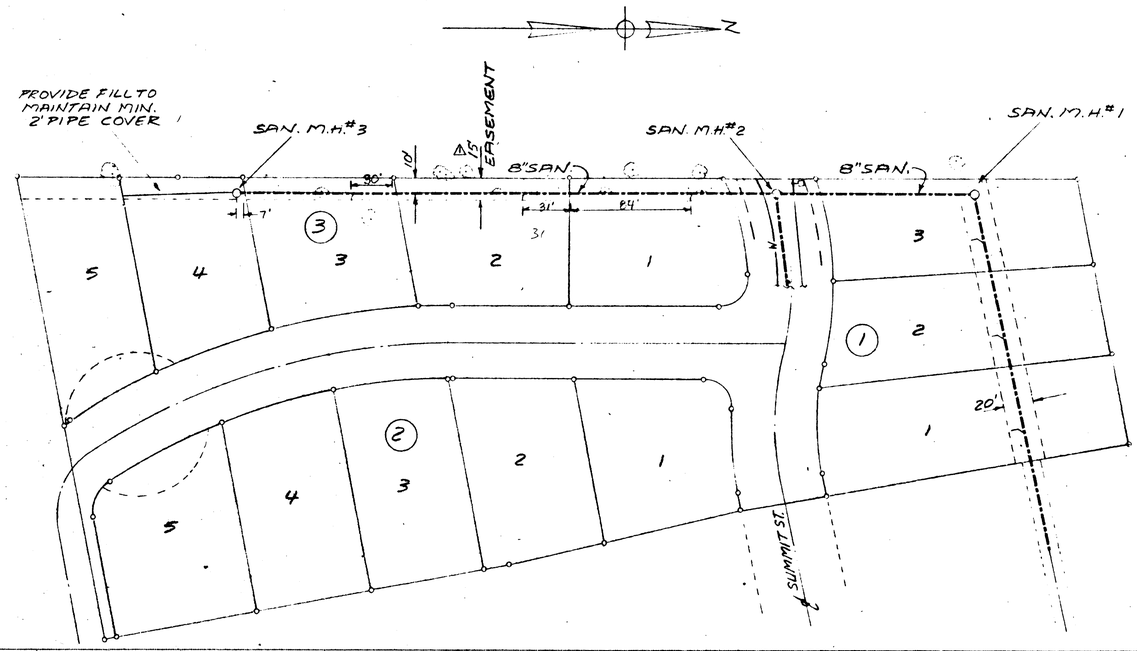

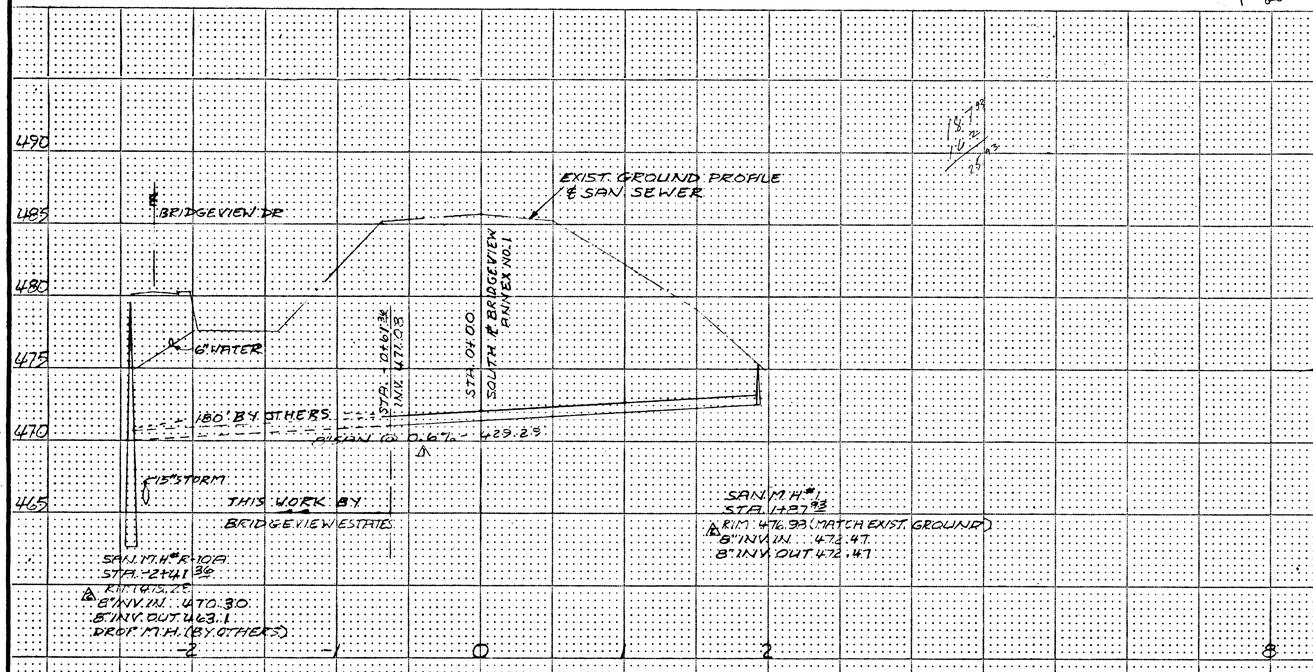

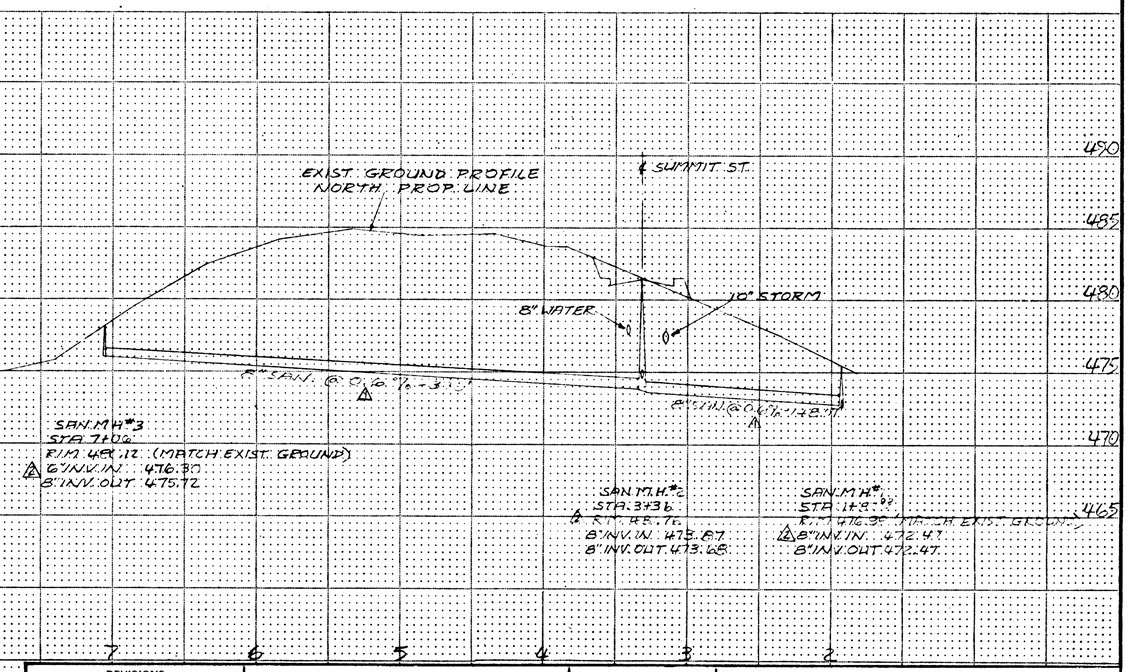

REVISIONS		
Date	Description	By
1-16-78	CITY REQUIREMENTS	JM
4-17-78	SAN MHS SERVICE AS BUILTS	WB

DRAWN: [illegible] CHECKED: [illegible]
SCALE: 1" = 50' DATE: 12/1/77

ZAROSINSKI-TATONE ENGINEERS, INC.
3737 S.E. EIGHTH AVE. PORTLAND, ORE.

REGISTERED PROFESSIONAL LAND SURVEYOR
OREGON
RONALD L. TATONE

BRIDGEVIEW ESTATES ANNEX #1
WEST LINN, OREGON.

PLAN AND PROFILE
SAN. SEWER OUTFALL

JOB NO. [illegible]
SHEET 2 OF 3

CASCADE ARCHITECTURAL AND ENGINEERING SUPPLIES CO. PORTLAND OREGON