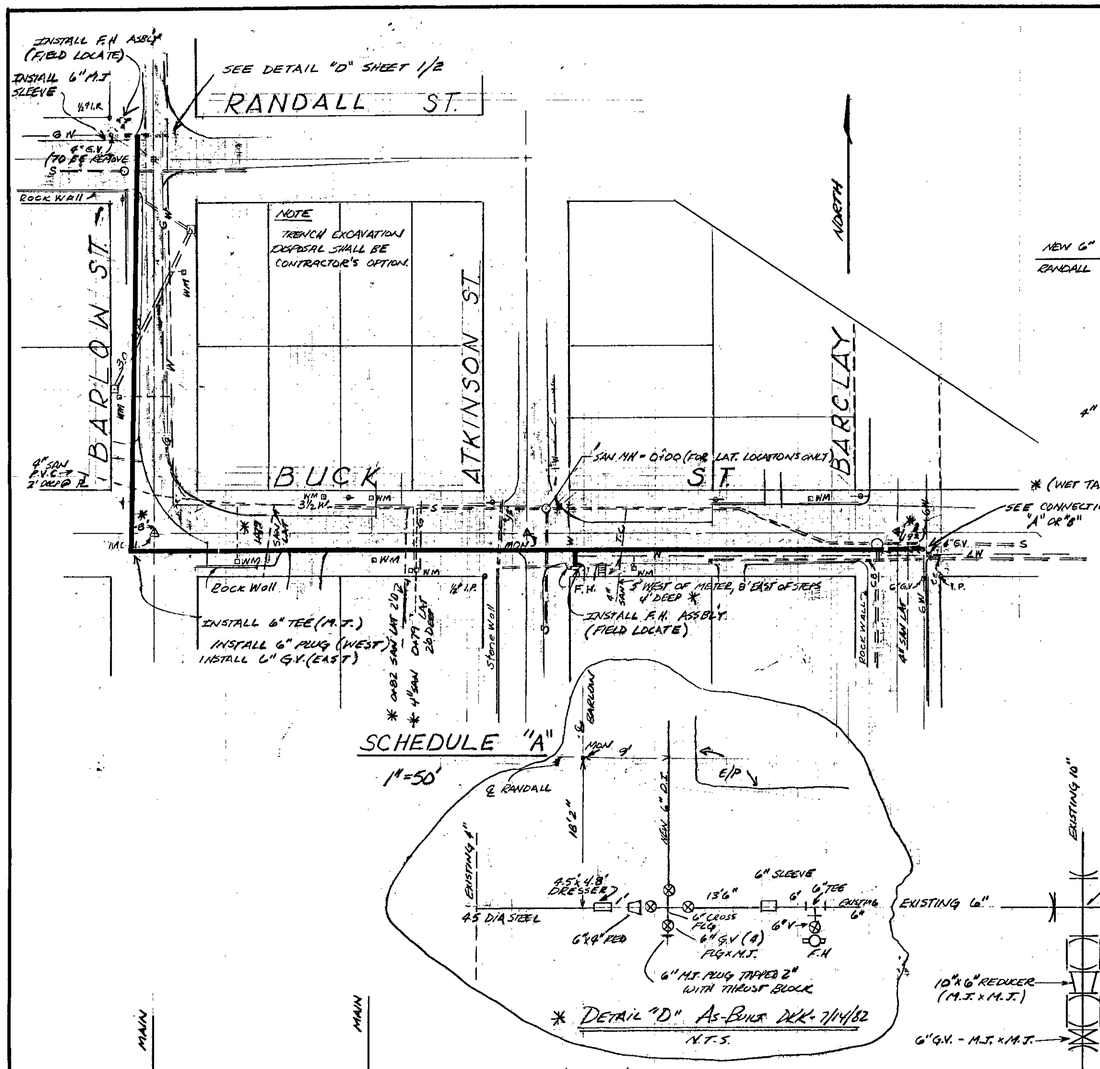

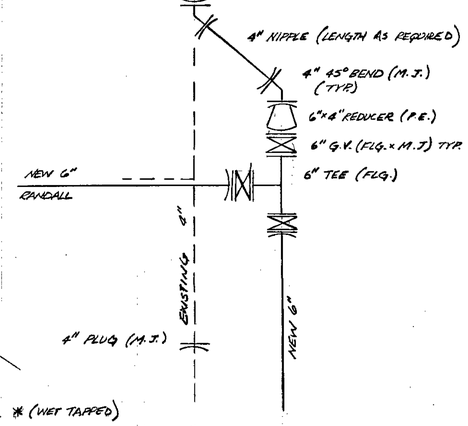

DETAIL "D" (SEE AS-BUILT)

N.T.S.

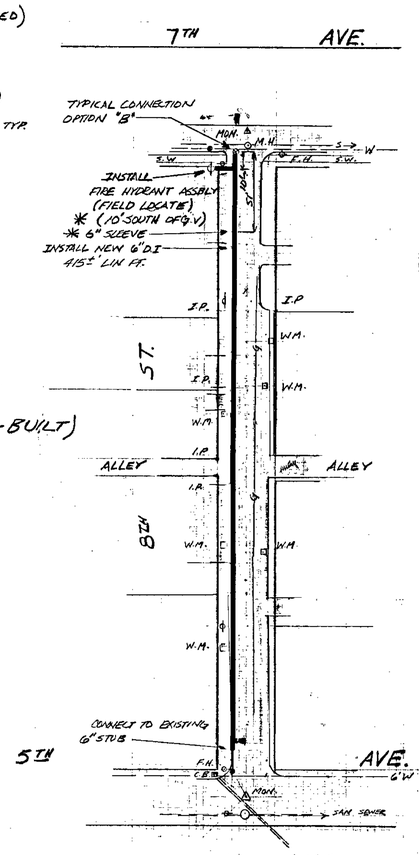

SCHEDULE "B"

1"=50'

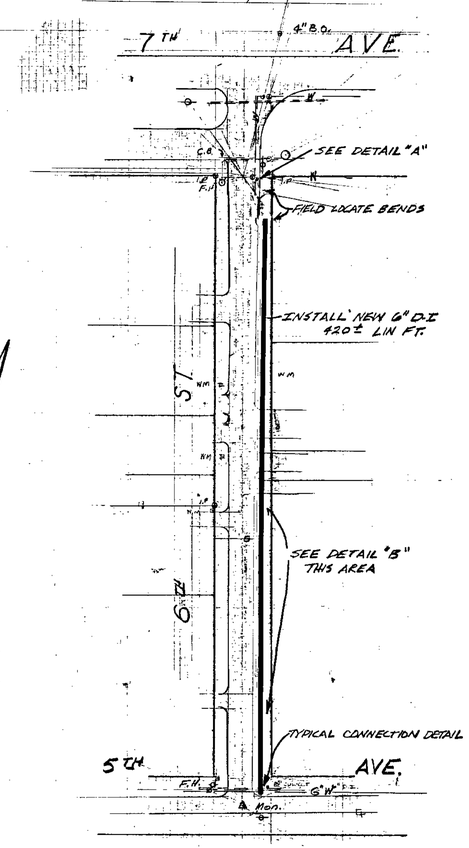

SCHEDULE "C"

1"=50'

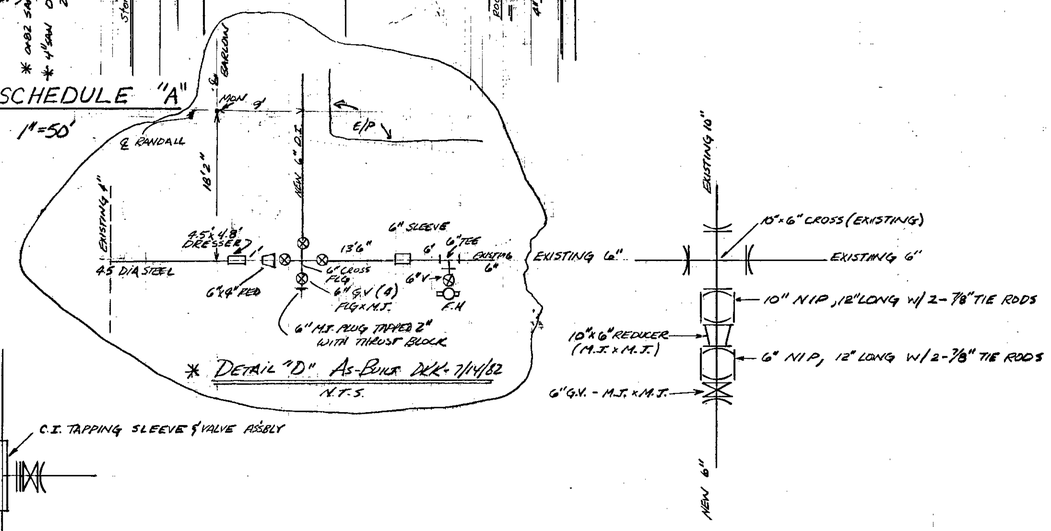

* DETAIL "D" AS-BUILT DKK 7/14/82

N.T.S.

DETAIL "A"

N.T.S.

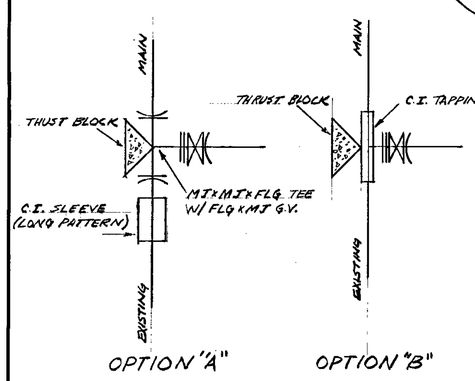

TYPICAL CONNECTION DETAILS

N.T.S.

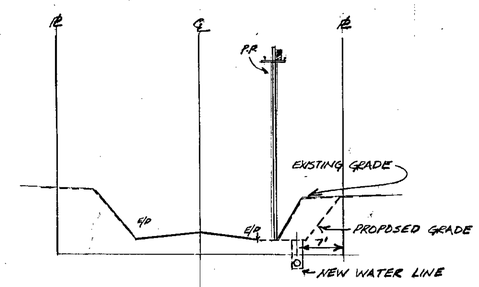

DETAIL "B"

N.T.S.

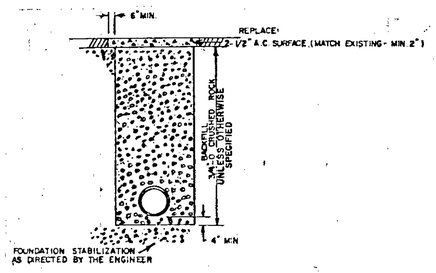

TYPICAL TRENCH DETAIL

N.T.S.

NOTES

1. HYDROSTATIC TESTING SHALL BE REQUIRED AND SUBJECT TO AWWA STANDARD #600 SECTION 13.
2. DISINFECTION SHALL BE SUBJECT TO AWWA STANDARD #601.
3. VERFIFICATION AND LOCATION OF EXISTING UTILITIES SHALL BE THE RESPONSIBILITY OF THE CONTRACTOR.

* ALL SERVICES REPLACED WITH TYPE "K" COPPER 7/82

"AS-BUILT" 1982 * DENOTES AS-BUILT REVISIONS

REGISTERED PROFESSIONAL ENGINEER 4477 OREGON OCT. 30, 1981 J. KAYNE DAVIS

DATE	NO.	REVISION		
			DRAWN DK, J.W.D.	
			FILE	DATE 4-82
			SCALE AS SHOWN	

CITY OF WEST LINN

PUBLIC WORKS DEPARTMENT

1982 WATER IMPROVEMENT PROGRAM

BUCK ST., 8TH ST. AND 6TH ST. IMPROVEMENTS

PLANS & DETAILS

1/2

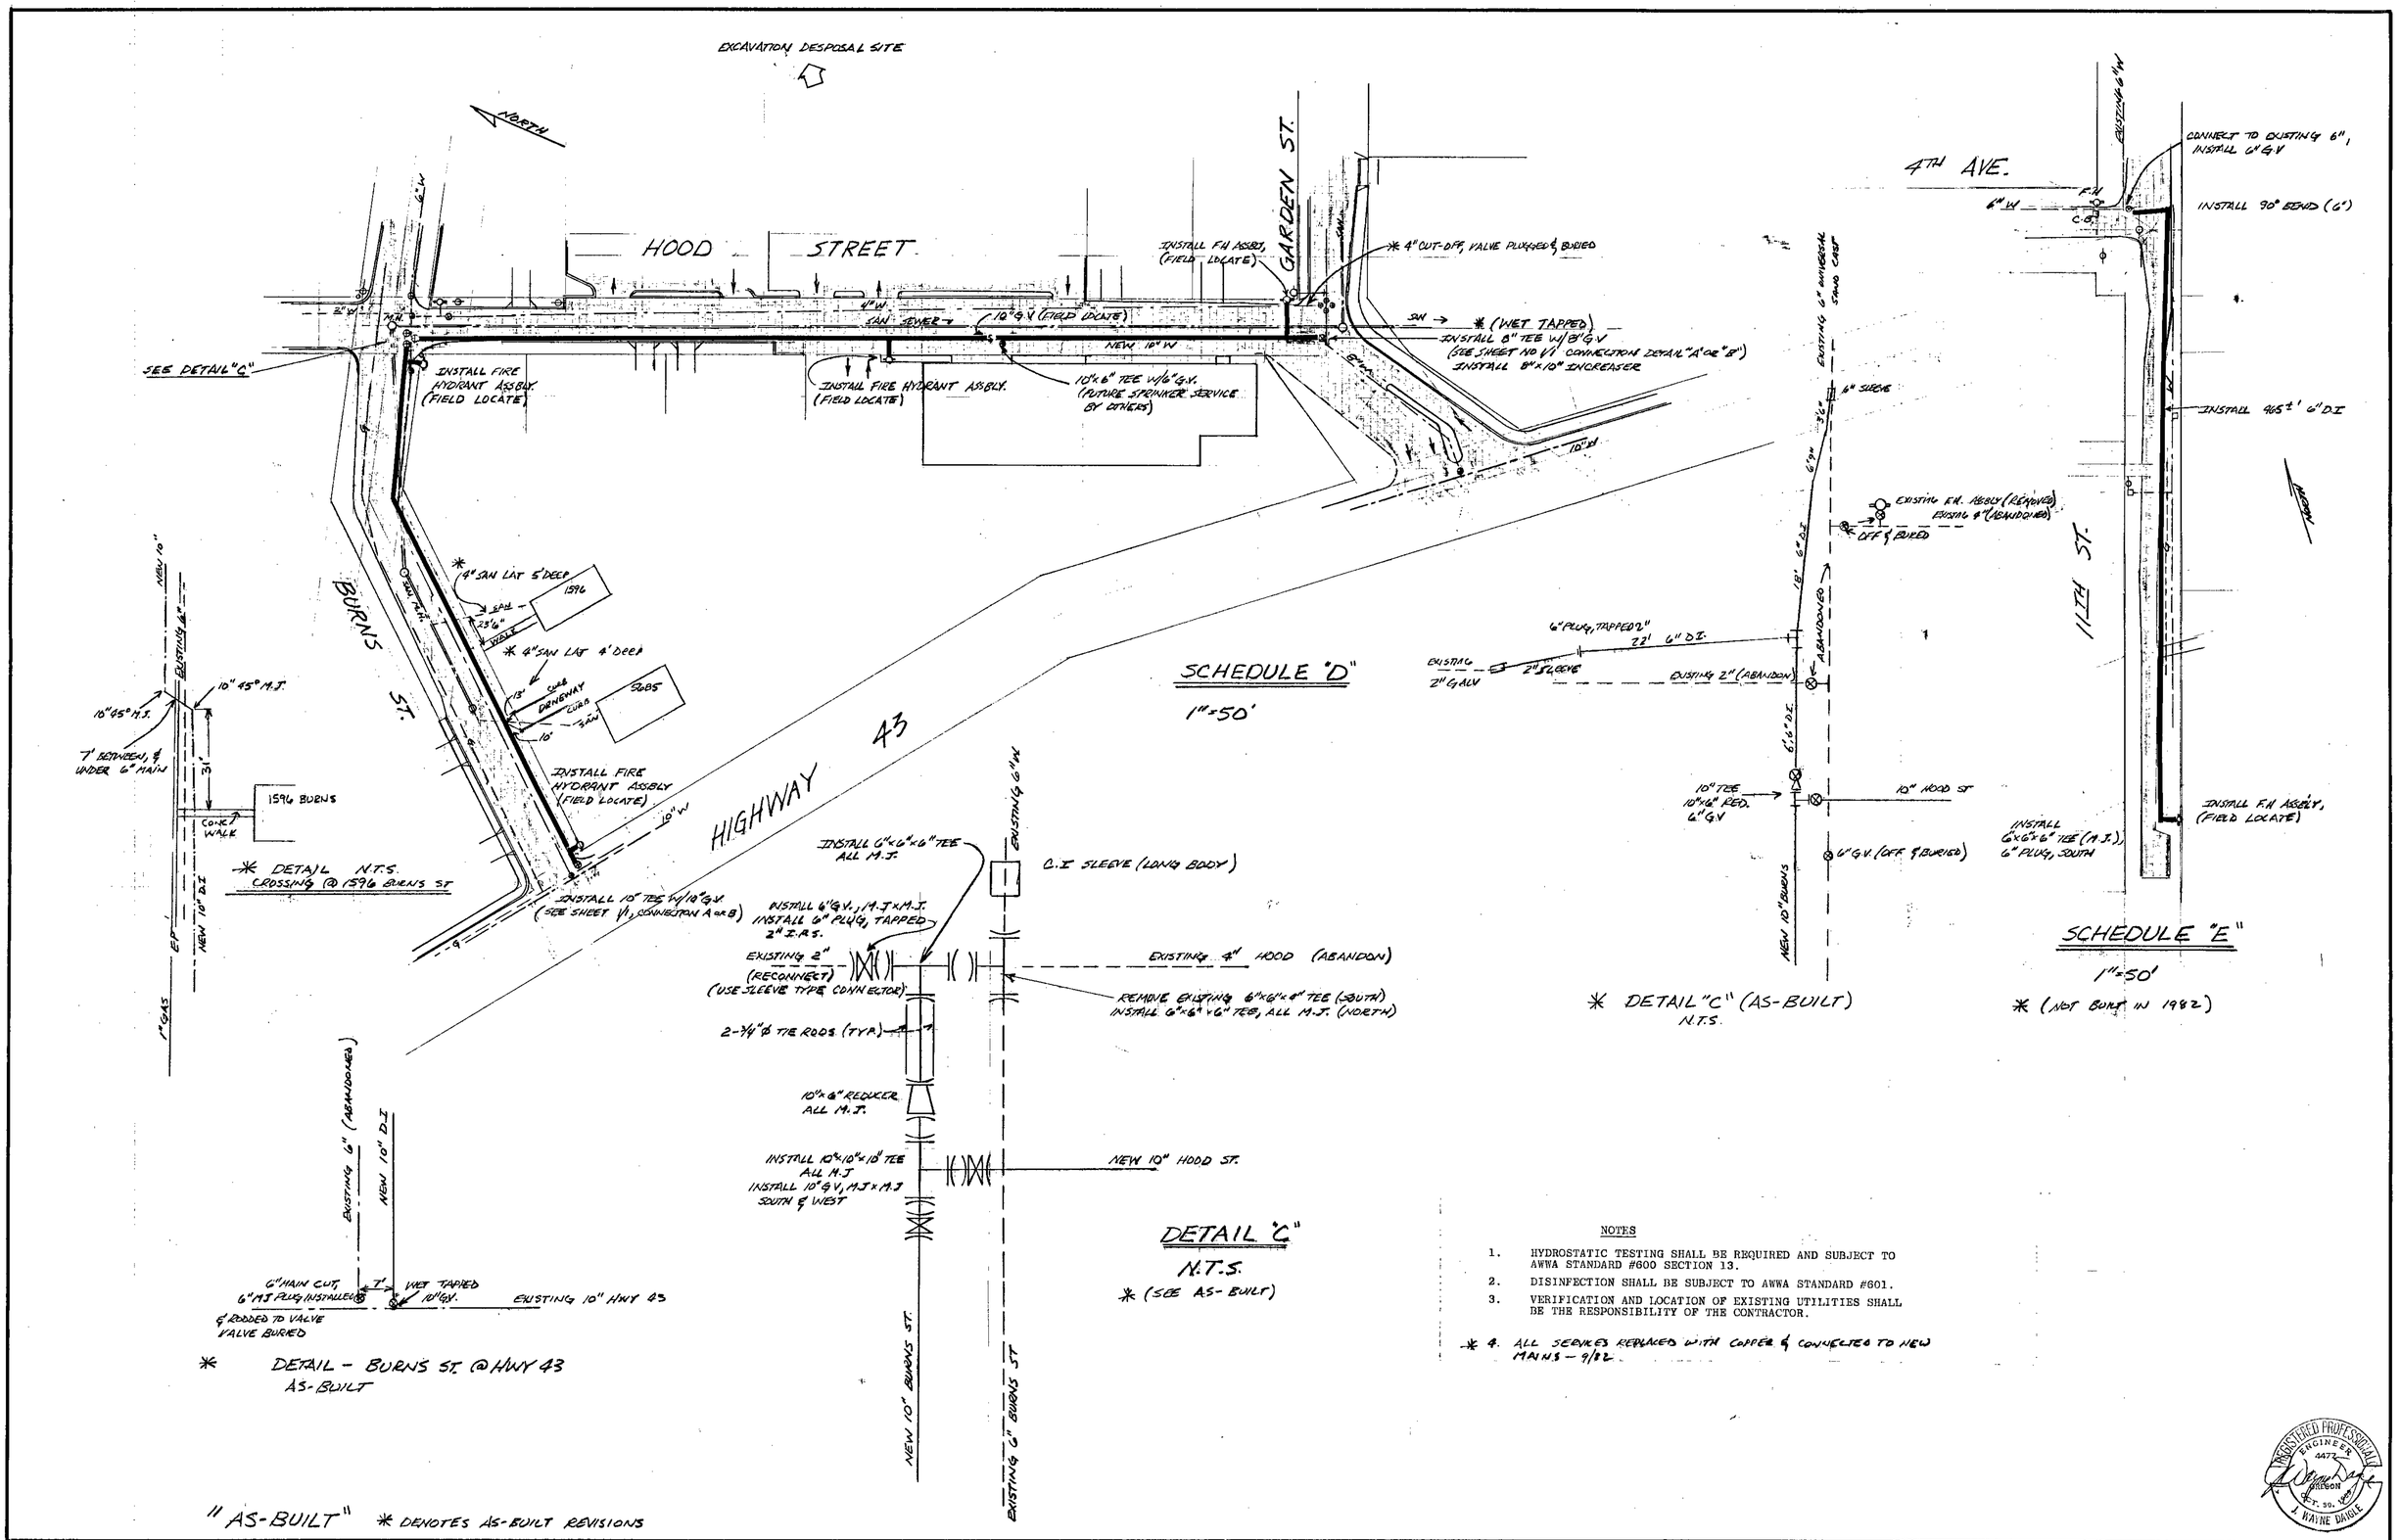

"AS-BUILT" * DENOTES AS-BUILT REVISIONS

DATE	NO.	REVISION		
			DRAWN	DKK
			FILE	DATE 4-82
			SCALE	AS SHOWN

CITY OF WEST LINN

PUBLIC WORKS DEPARTMENT

1982 WATER IMPROVEMENT PROGRAM

HOOD ST AND 11TH ST. IMPROVEMENTS
PLANS & DETAILS

2/2