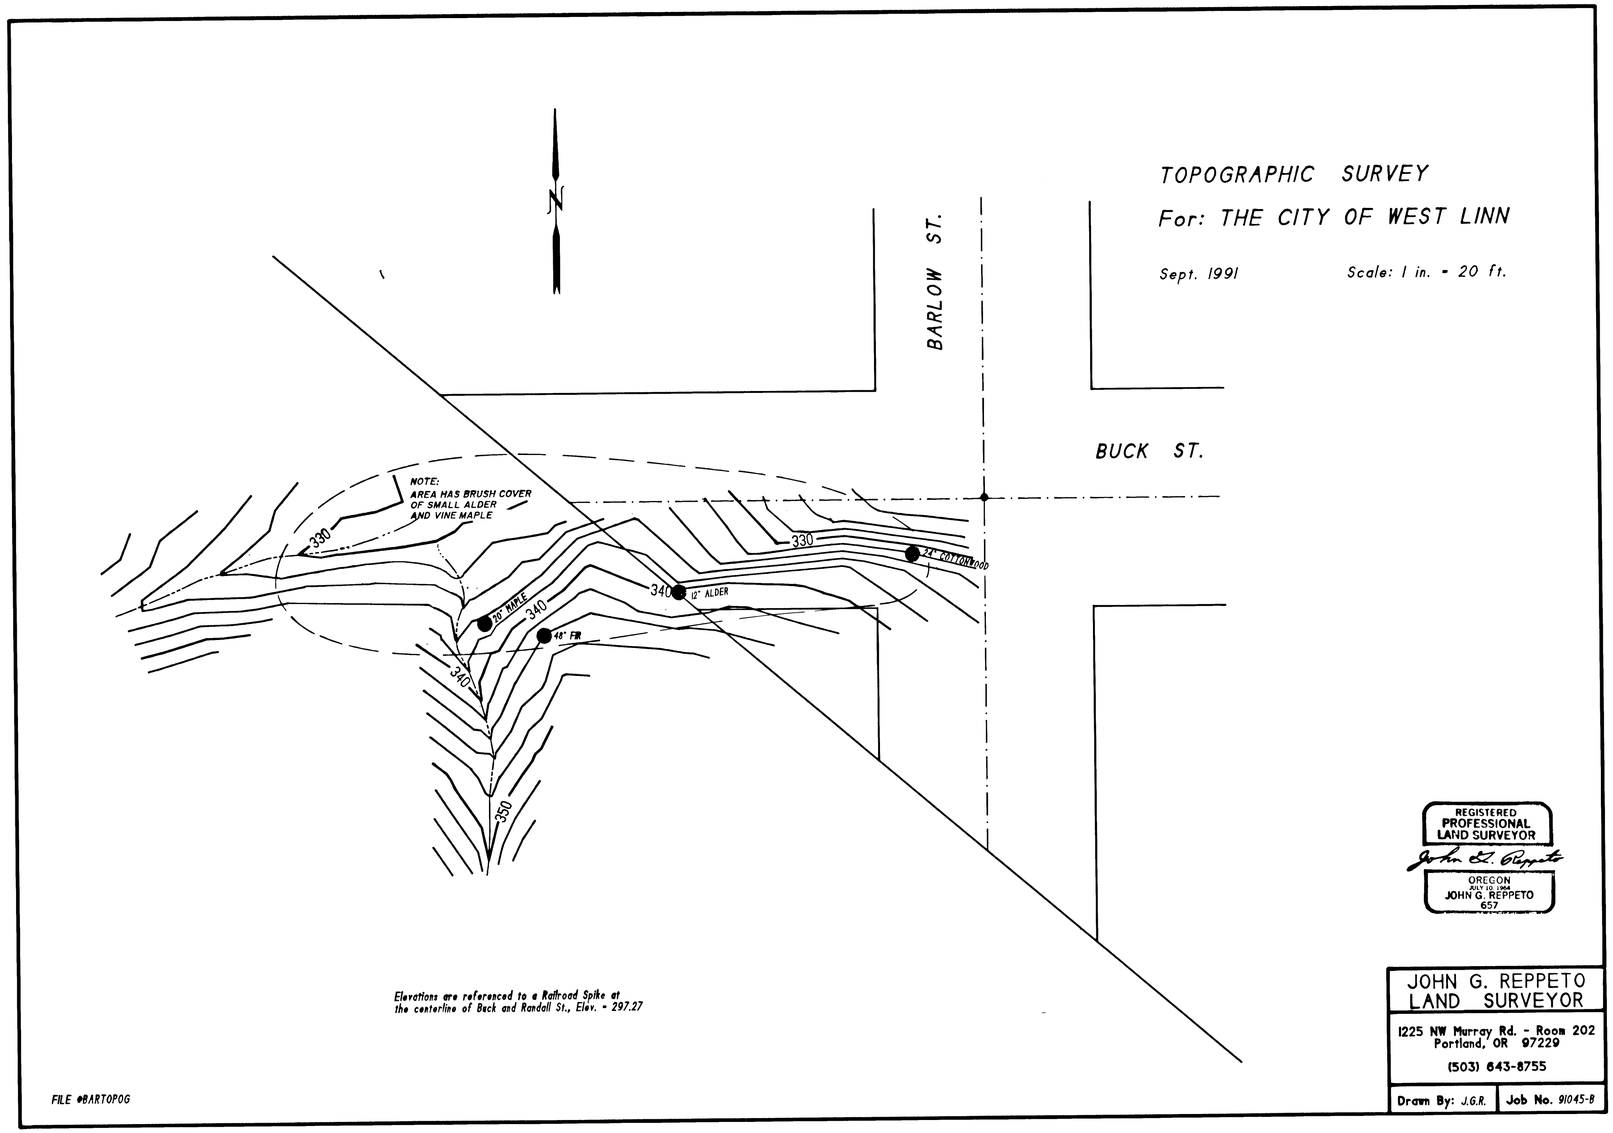
TOPOGRAPHIC SURVEY
For: THE CITY OF WEST LINN
Sept. 1991
Scale: 1 in. = 20 ft.
N
BARLOW ST.
BUCK ST.
NOTE:
AREA HAS BRUSH COVER
OF SMALL ALDER
AND VINE MAPLE
330
330
340
340
340
350
24" COTTONWOOD
12" ALDER
20" MAPLE
48" FIR
Elevations are referenced to a Railroad Spike at
the centerline of Buck and Randall St., Elev. = 297.27
FILE #BARTOPOG
REGISTERED
PROFESSIONAL
LAND SURVEYOR
OREGON
JULY 13, 1984
JOHN G. REPPETO
657
JOHN G. REPPETO
LAND SURVEYOR
1225 NW Murray Rd. - Room 202
Portland, OR 97229
(503) 643-8755
Drawn By: J.G.R.
Job No. 91045-B

-0-

1-11