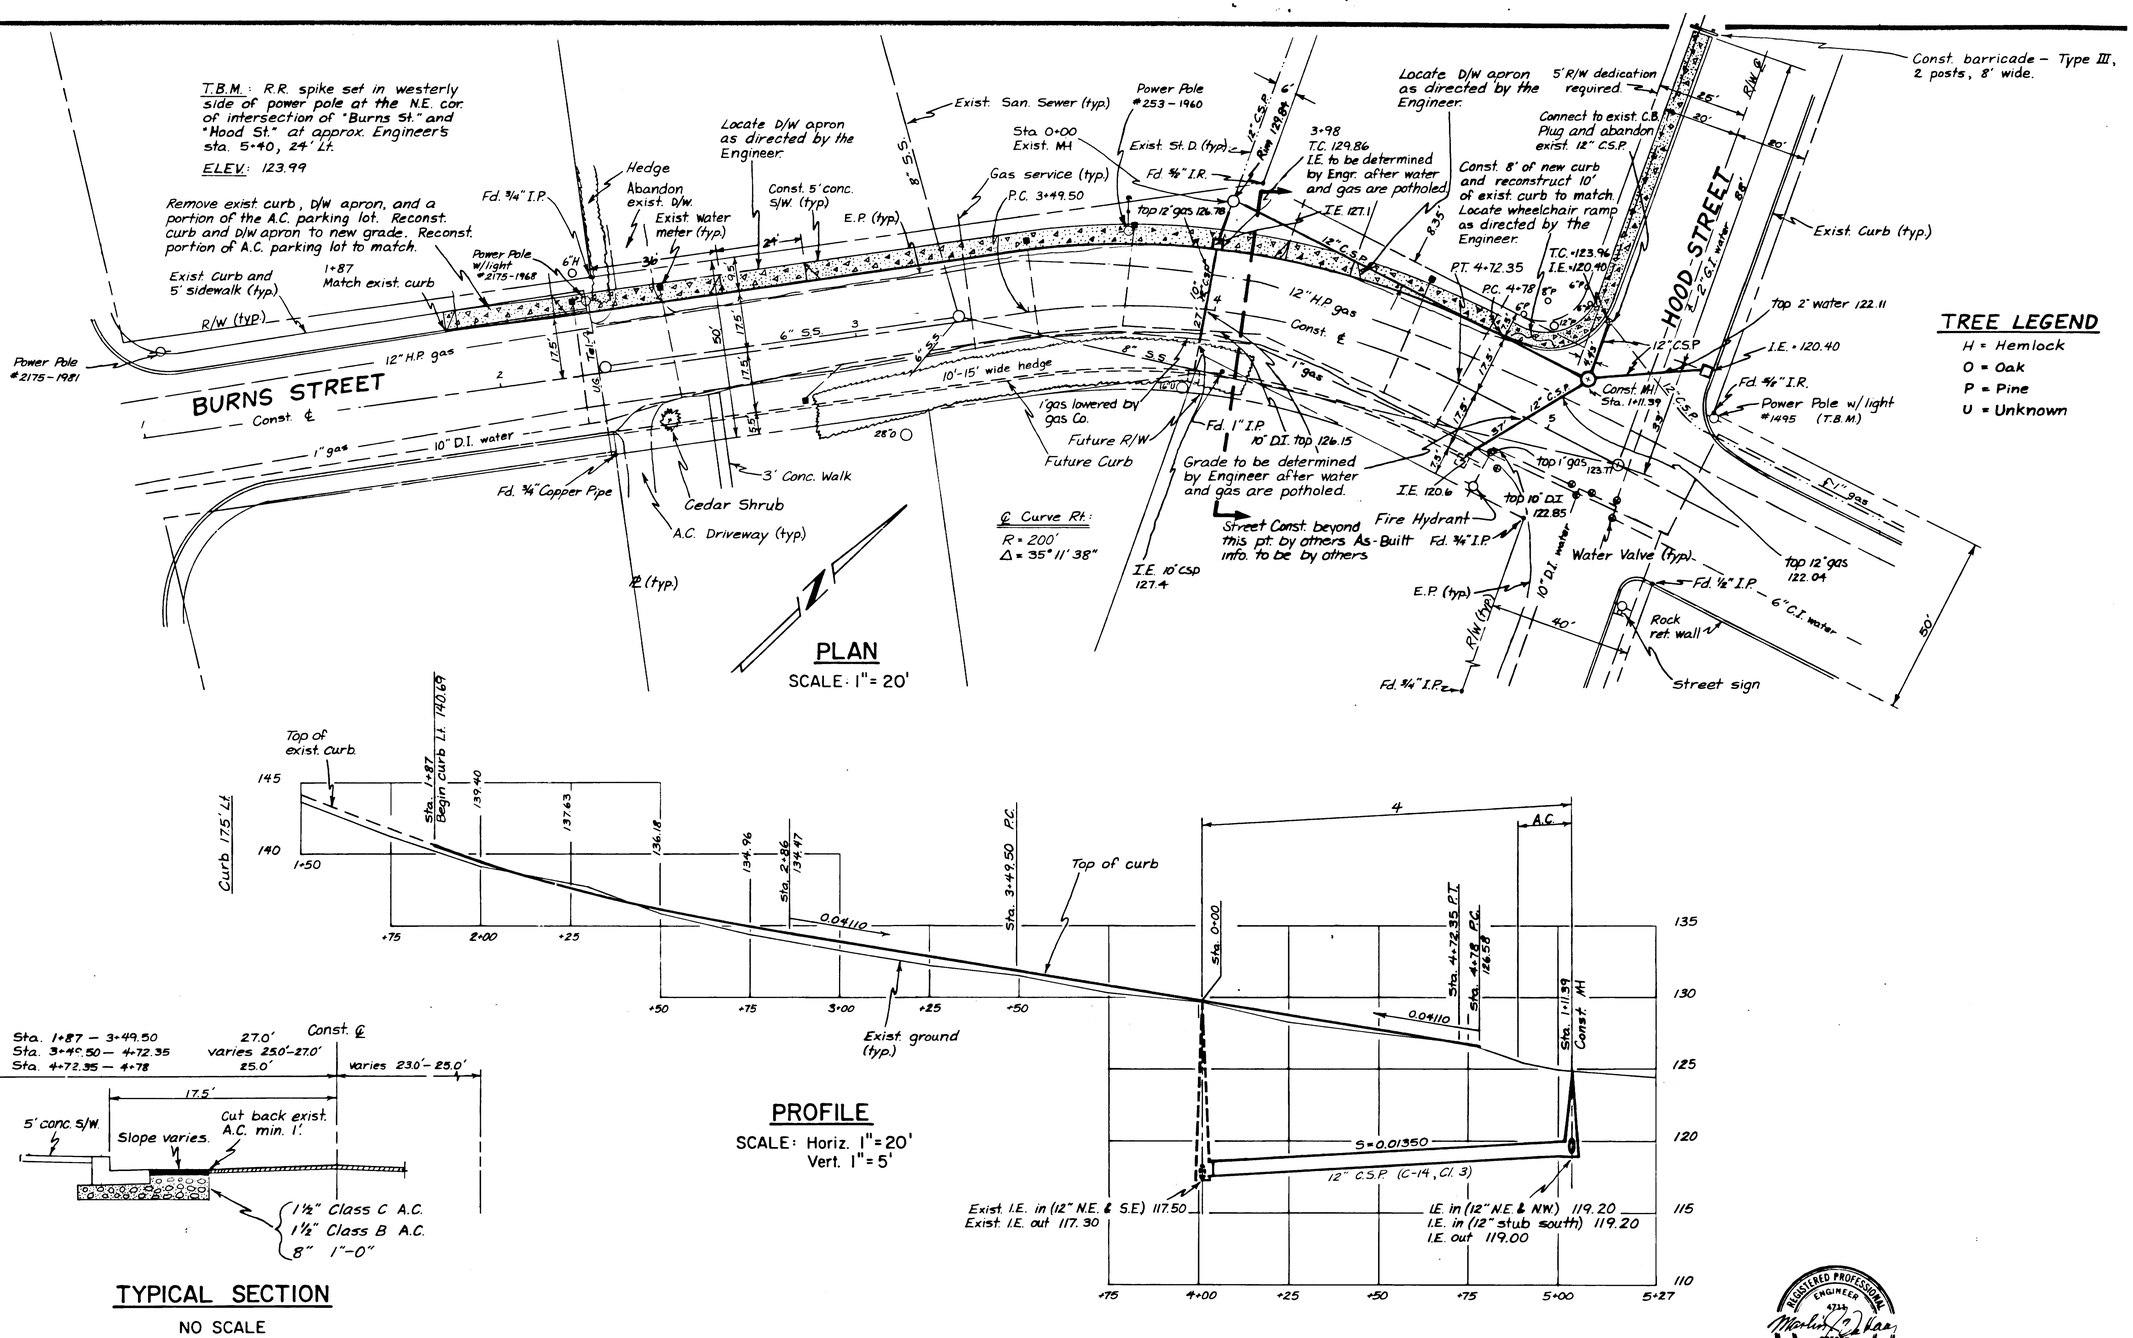

AS-BUILT OCTOBER, 1989

DATE	NO.	REVISIONS	BY
10/10/89	1	As-Builts	

T.D.K. DESIGNED
T.D.K. DRAWN
M.J.D. CHECKED
APPROVED
DATE 1/31/89

DE HAAS & Associates, Inc.
Consulting Engineers & Surveyors
Suite 300 - AGC Center
9450 S.W. Commerce Circle
Wilsonville, Oregon 97070
(503) 682-2450
Res. 636-6195

CITY OF WEST LINN
DEPARTMENT OF PUBLIC WORKS
EARL R. REED, DIRECTOR

BURNS STREET
STREET & STORM DRAIN IMPROVEMENTS
(RELATED TO LIBRARY IMPROVEMENTS)

SCALE AS SHOWN | DATE JAN., 1989 | FILE 88.838.250

SHEET 1/2