PROFILE OF PART OF BURNS STREET
FROM ℄ OF RIVER STREET TO EASTERLY
SIDE OF HOOD STREET, WEST LINN Or.

Elevations refer to BM. at Wly end of Oregon City-West Linn Bridge Ele. 107.74'

D. T. Meldrum, City Engr.

Hor. Scale 1 inch = 50 ft. Ver. Scale 1 inch = 10 ft.

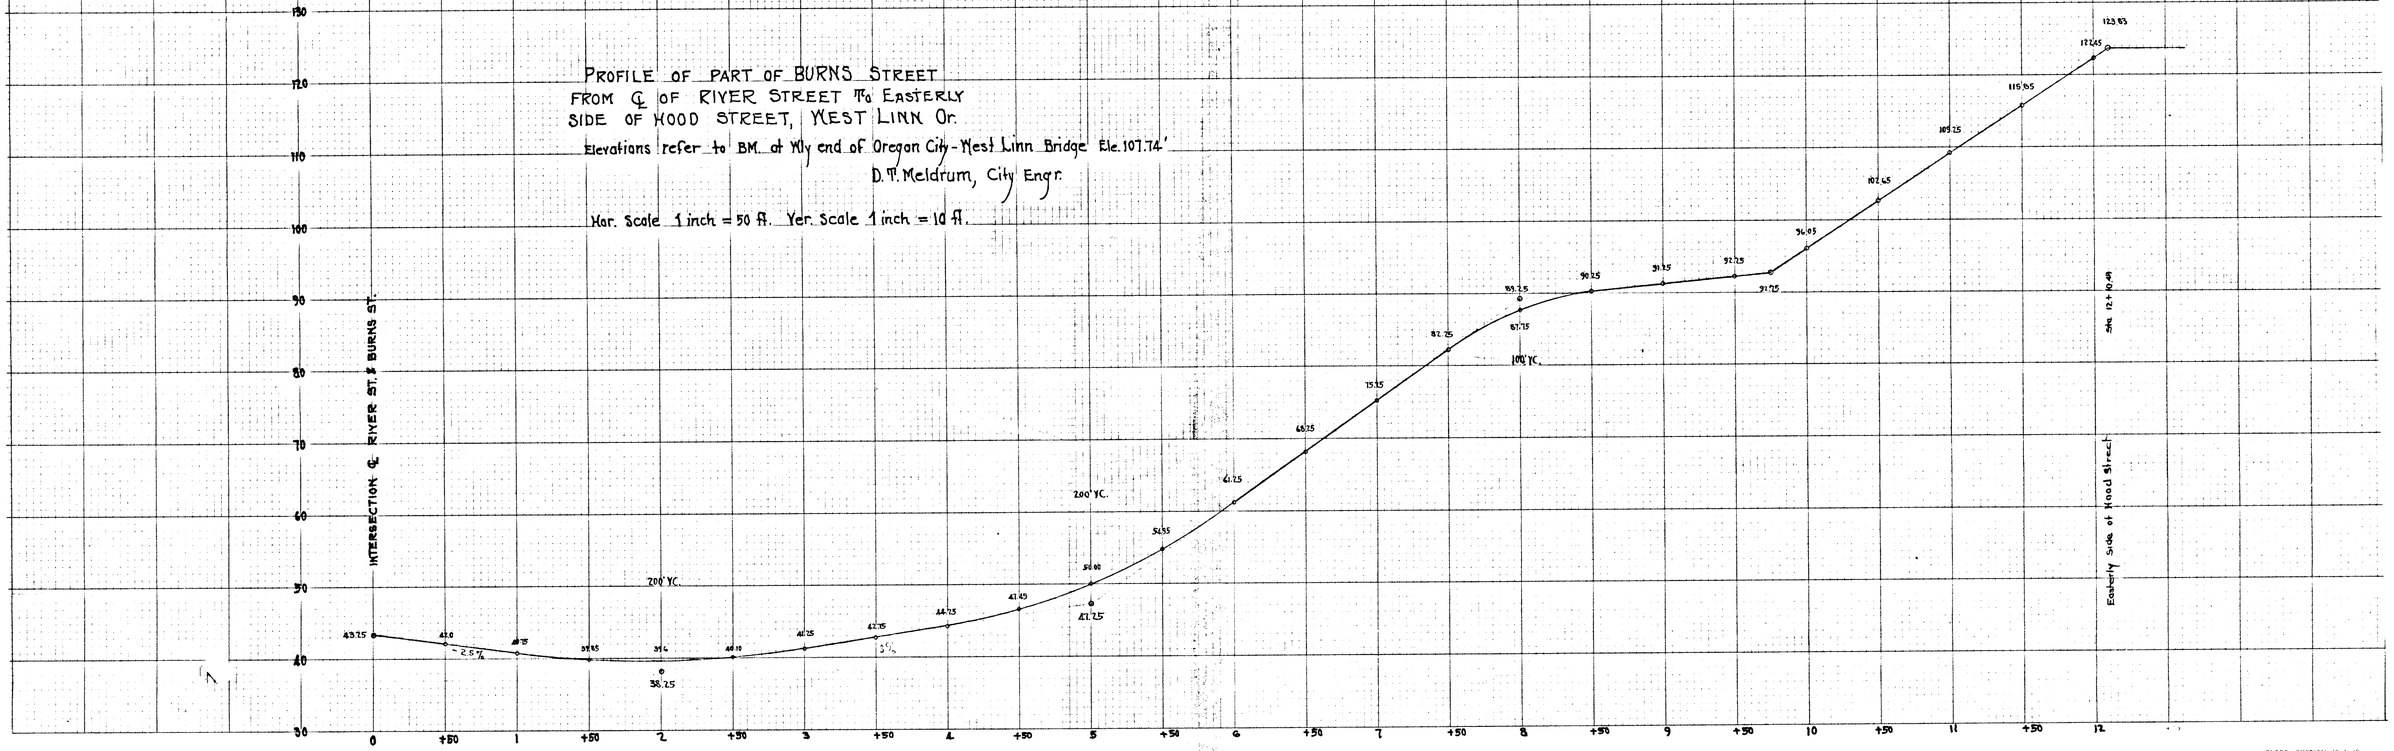

CROSS SECTION 10 X 10.
TRACING MARK

CROSS SECTION 10 X 10.
TRACING MARK