


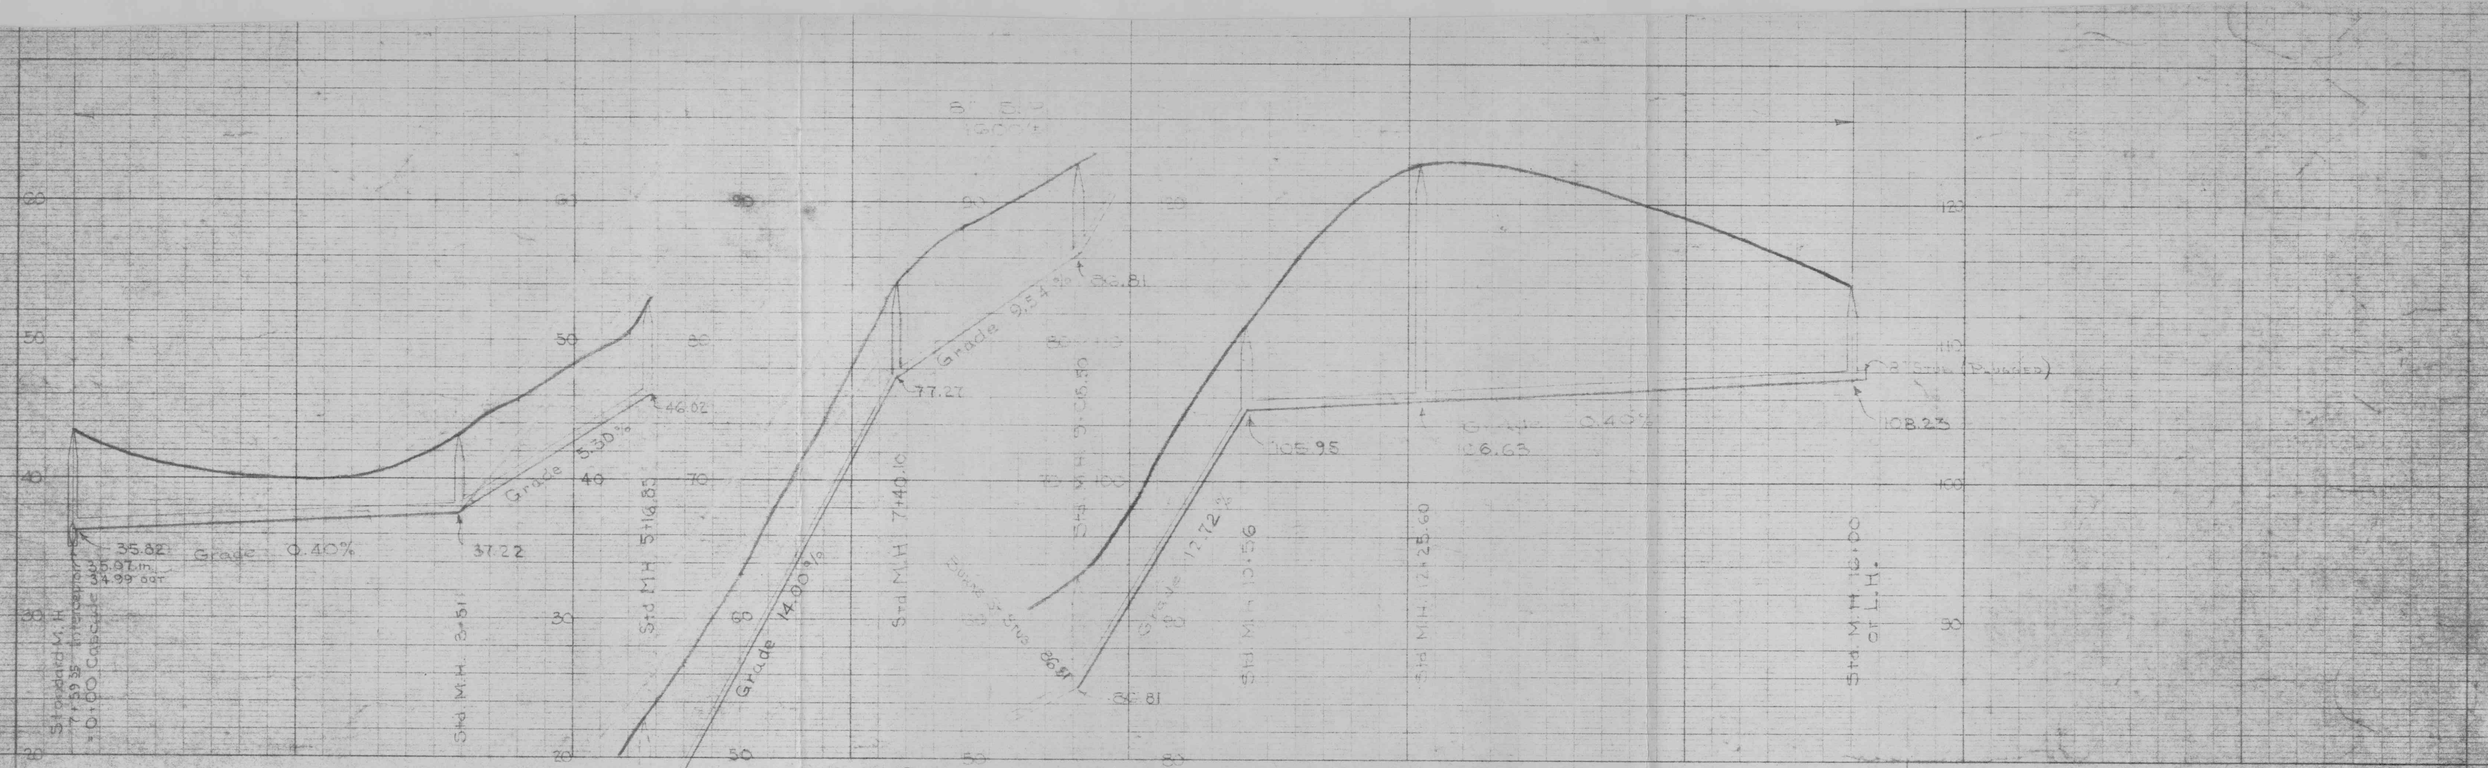





JOHN W. CUNNINGHAM & ASSOCIATES
CONSULTING ENGINEERS
SPALDING BLDG. PORTLAND, OREGON

# CITY OF WEST LINN, ORE.

## MAP & PROFILE OF
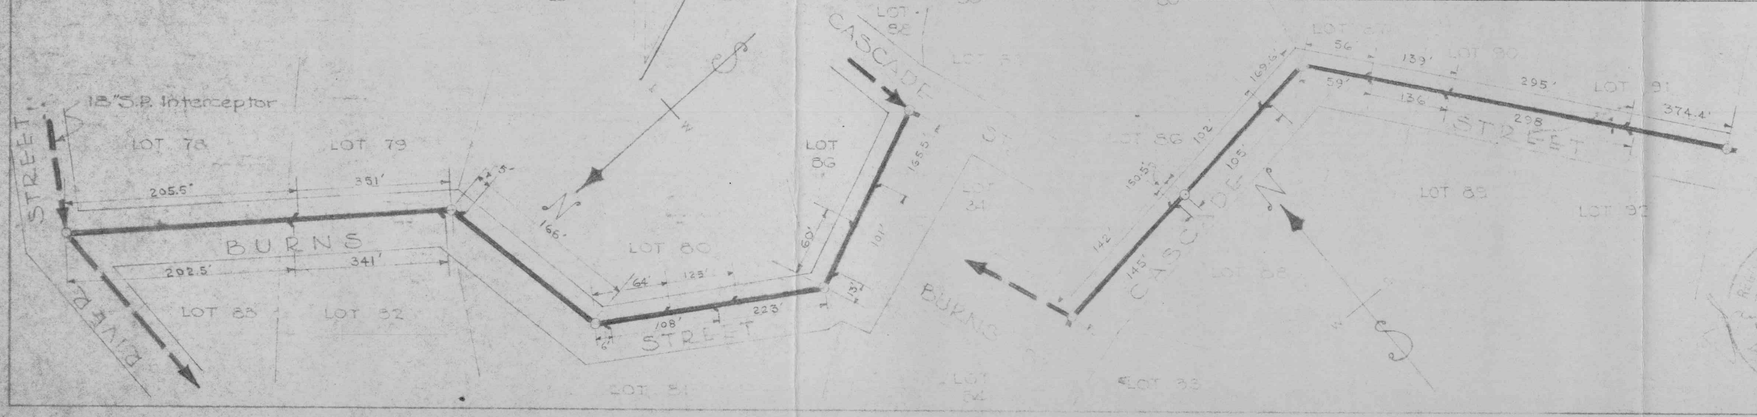
# CASCADE ST. SEWER

SCALES: VERT. 1" = 8'
HORIZ. 1" = 100'

| | | | |
|---|---|---|---|
| DESIGN | L.K.M.-J.D.C. | REVISIONS | DATE OCT. 1950 |
| DRAWN | J.D.C. | As Built & W.O. Dec 1951 | NO. 4 OF 6 |
| TRACED | | | 549 - P - 3 |
| CHECKED | | | 3076 |