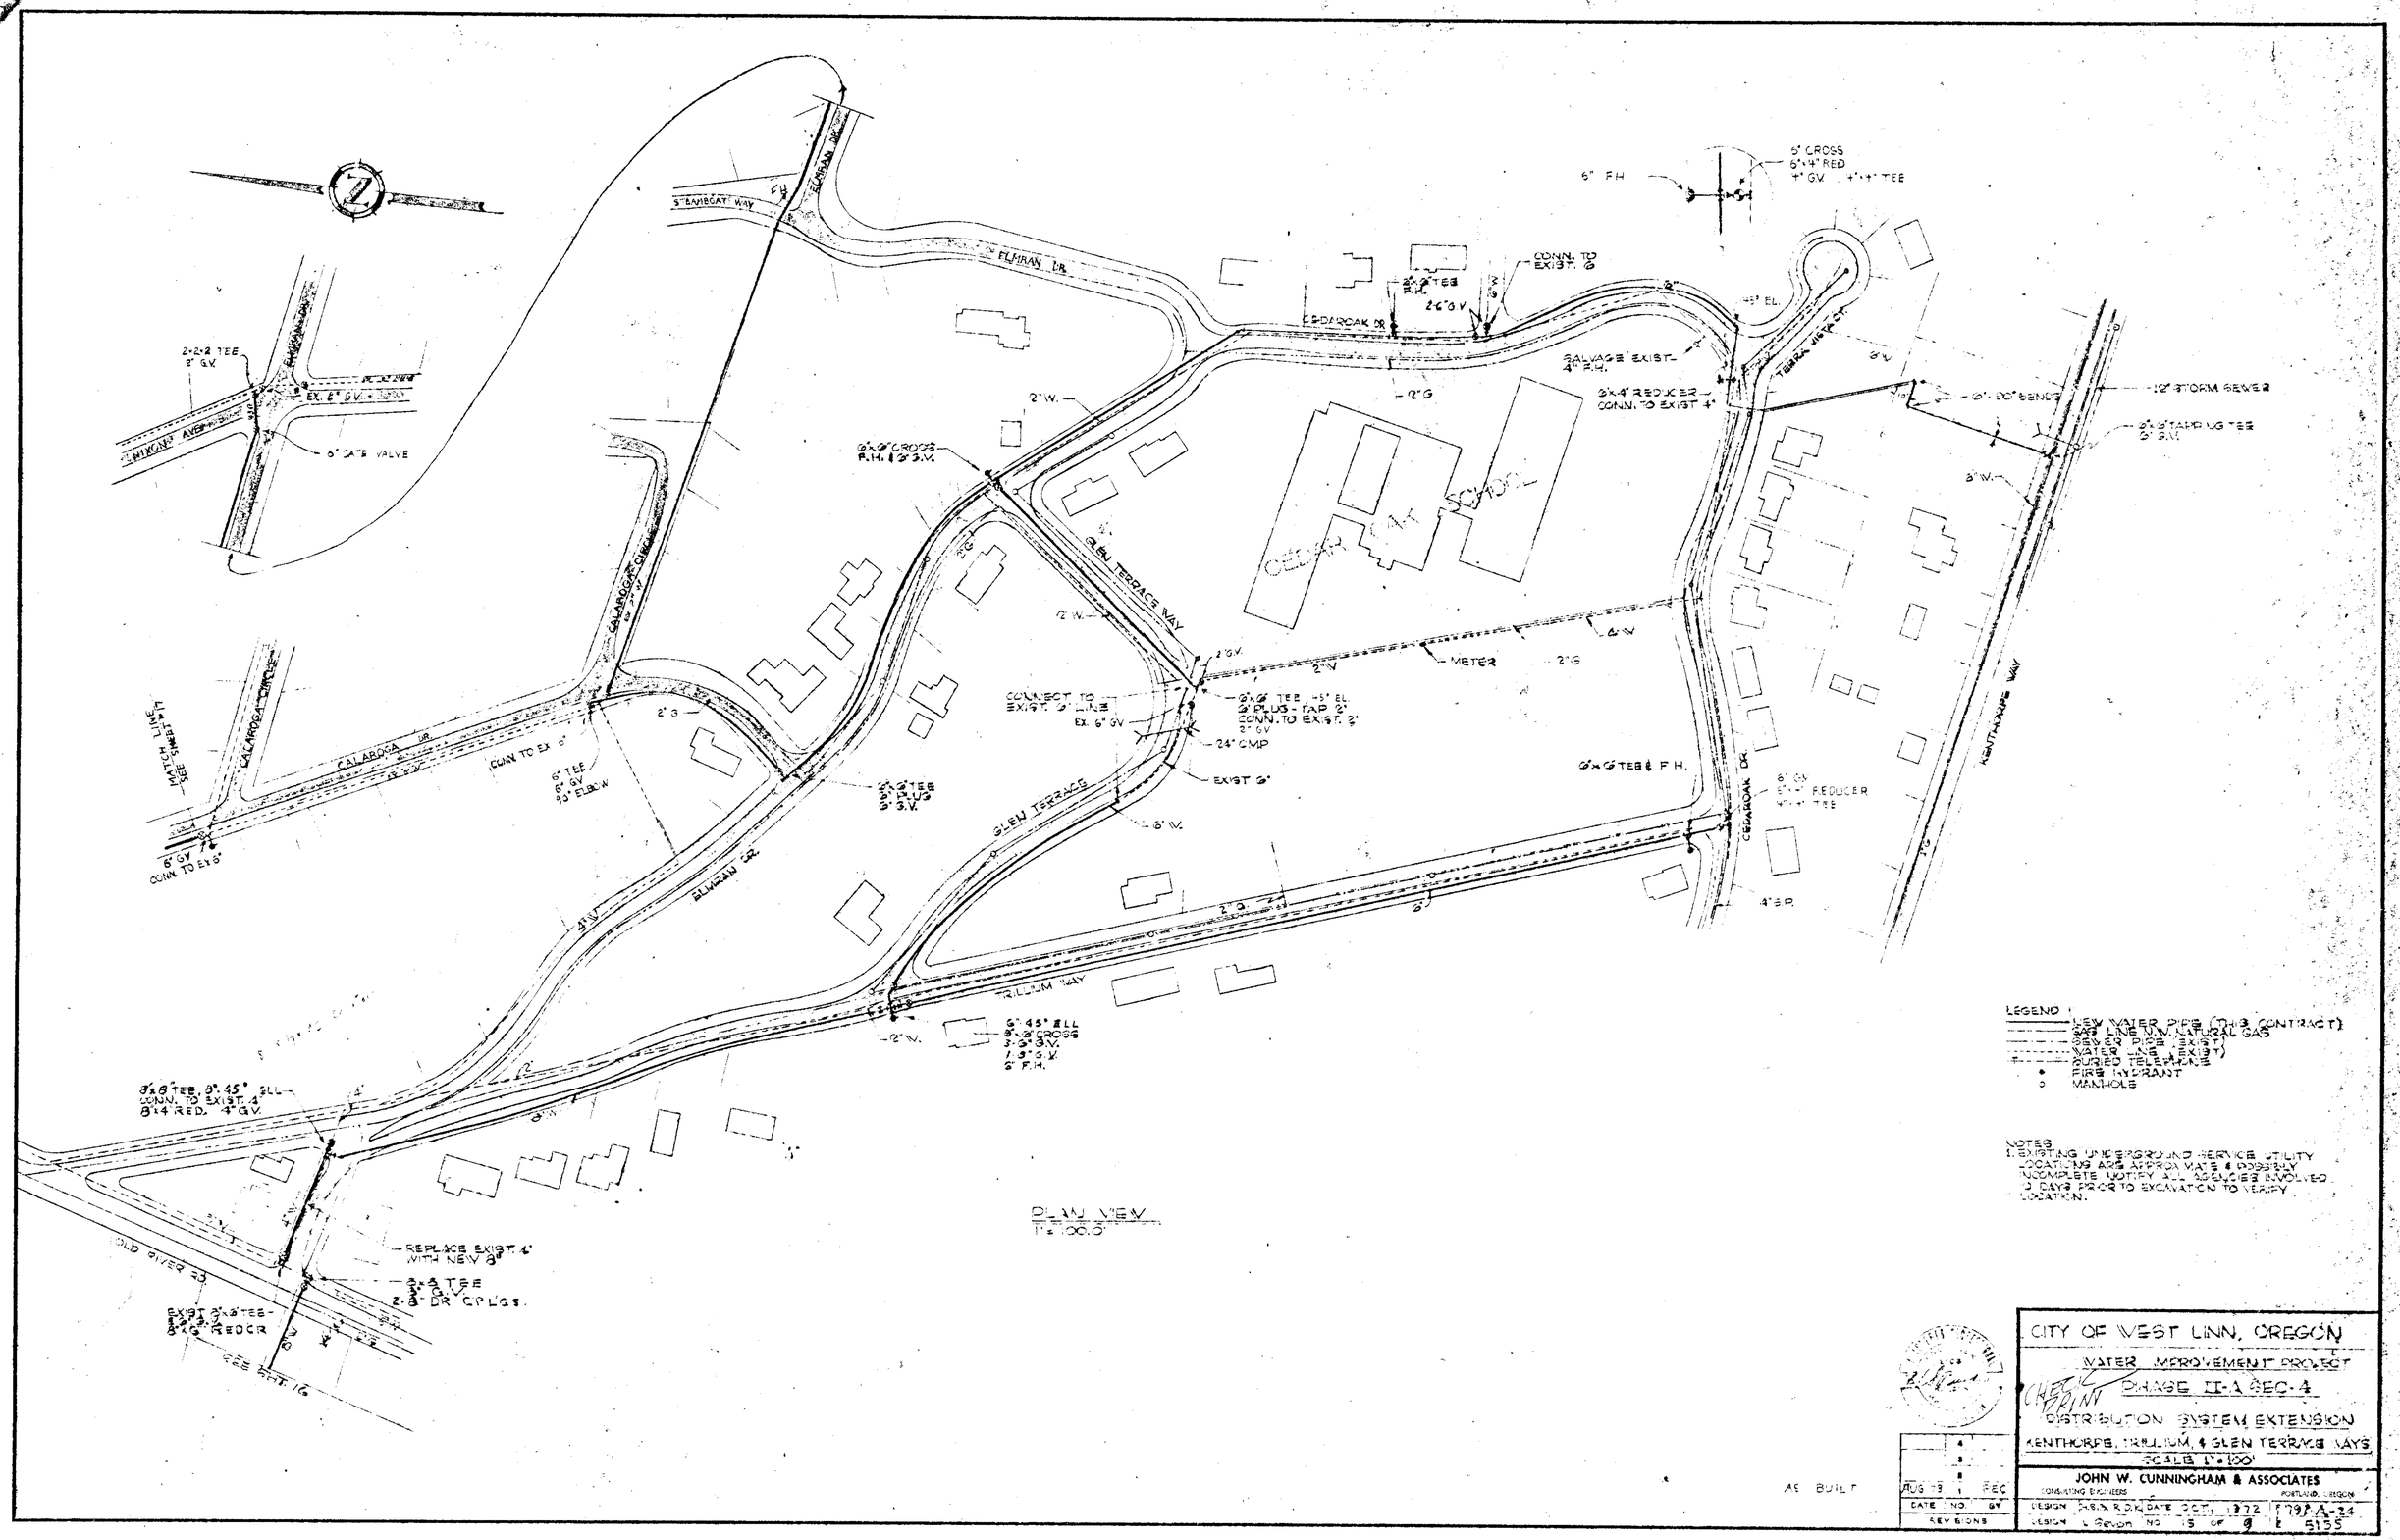
N
ELMRAN DR.
BAMBGAT WAY
2-2-2 TEE 2" G.V.
EX. 6" G.V.
6" GATE VALVE
CALAROGA CIRCLE
CALAROGA DR.
CONN. TO EX. 6"
6" TEE 6" G.V. 90° ELBOW
6" G.V. CONN. TO EXIST.
MATCH LINE SEE SHEET 17
6"x6" CROSS P.H. & 2" S.V.
GLEN TERRACE WAY
GLEN TERRACE
2" W.
CONNECT TO EXIST. 2" LINE
EX. 6" G.V.
24" CMP
EXIST. 6"
METER
6"x6" TEE, 45° EL. 2" PLUG - TAP 2" CONN. TO EXIST. 2" G.V.
6"x6" TEE 2" PLUG 2" S.V.
6" W.
6"x6" TEE & F.H.
6" G.V. 6"x4" REDUCER W/4" TEE
CEDAR OAK DR.
4" S.P.
6" F.H.
5" CROSS 6"x4" RED 4" G.V. 4"x4" TEE
CONN. TO EXIST. 6"
6"x6" TEE F.H. 2"x6" G.V.
EDAROAK DR.
SALVAGE EXIST. 4" F.H.
6"x4" REDUCER CONN. TO EXIST. 4"
45° EL.
TERRA VISTA CT.
6" W.
6" DOG FENCE
12" STORM SEWER
6"x6" TAPPING TEE 2" S.V.
8" W.
SCHOOL
KENTHORPE WAY
TRILLIUM WAY
6" 45° ELL 6"x6" CROSS 3-2" S.V. 1-2" S.V. 2" F.H.
6"x6" TEE, 6" 45° ELL CONN. TO EXIST. 4" 8"x4" RED. 4" G.V.
OLD RIVER RD.
REPLACE EXIST. 4" WITH NEW 8"
6"x6" TEE 6" G.V. 2-8" DR. CP LGS.
EXIST. 6"x6" TEE 6"x4" REDCR
SEE SHT. 16
PLAN VIEW
1" = 100.0'
LEGEND :
NEW WATER PIPE (THIS CONTRACT)
GAS LINE N.W. NATURAL GAS
SEWER PIPE (EXIST.)
WATER LINE (EXIST.)
BURIED TELEPHONE
FIRE HYDRANT
MANHOLE
NOTES
1. EXISTING UNDERGROUND SERVICE UTILITY LOCATIONS ARE APPROXIMATE & POSSIBLY INCOMPLETE. NOTIFY ALL AGENCIES INVOLVED 10 DAYS PRIOR TO EXCAVATION TO VERIFY LOCATION.
AS BUILT
CITY OF WEST LINN, OREGON
WATER IMPROVEMENT PROJECT
CHECK PRINT
PHASE II-A SEC. 4
DISTRIBUTION SYSTEM EXTENSION
KENTHORPE, TRILLIUM, & GLEN TERRACE WAYS
SCALE 1" = 100'
JOHN W. CUNNINGHAM & ASSOCIATES
CONSULTING ENGINEERS
PORTLAND, OREGON
DESIGN
DATE OCT. 1972
DESIGN
NO. 15 OF 9
AUG 73 1 REC
DATE NO. BY
REVISIONS
A-24
5135