PLAN VIEW

Scale: 1"=30'

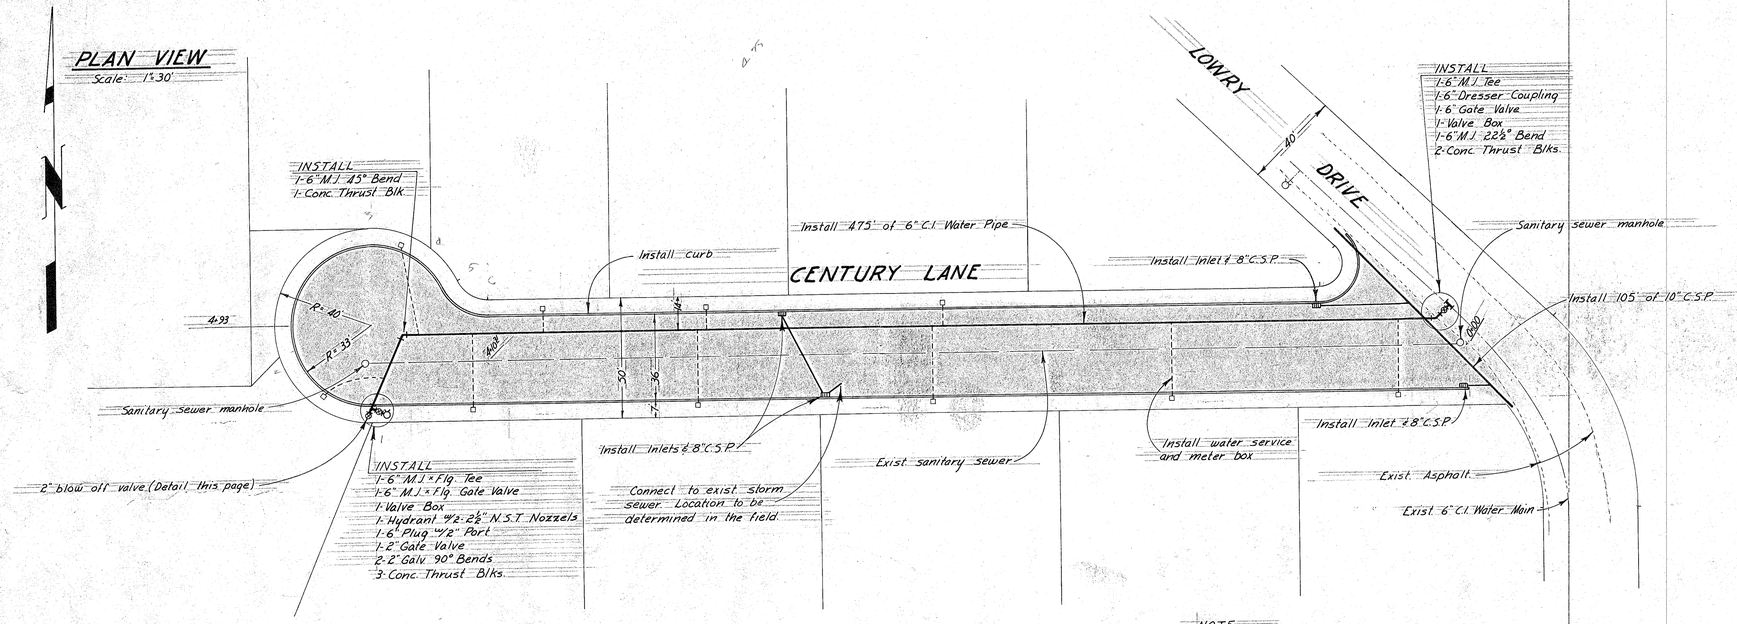

NOTE
On all up hill lots, the contractor shall install a 4" weep hole in curb at lower portion of each lot.

TYPICAL STREET SECTION

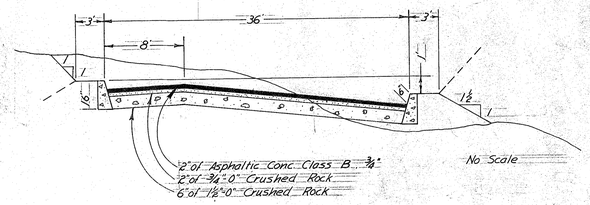

No Scale

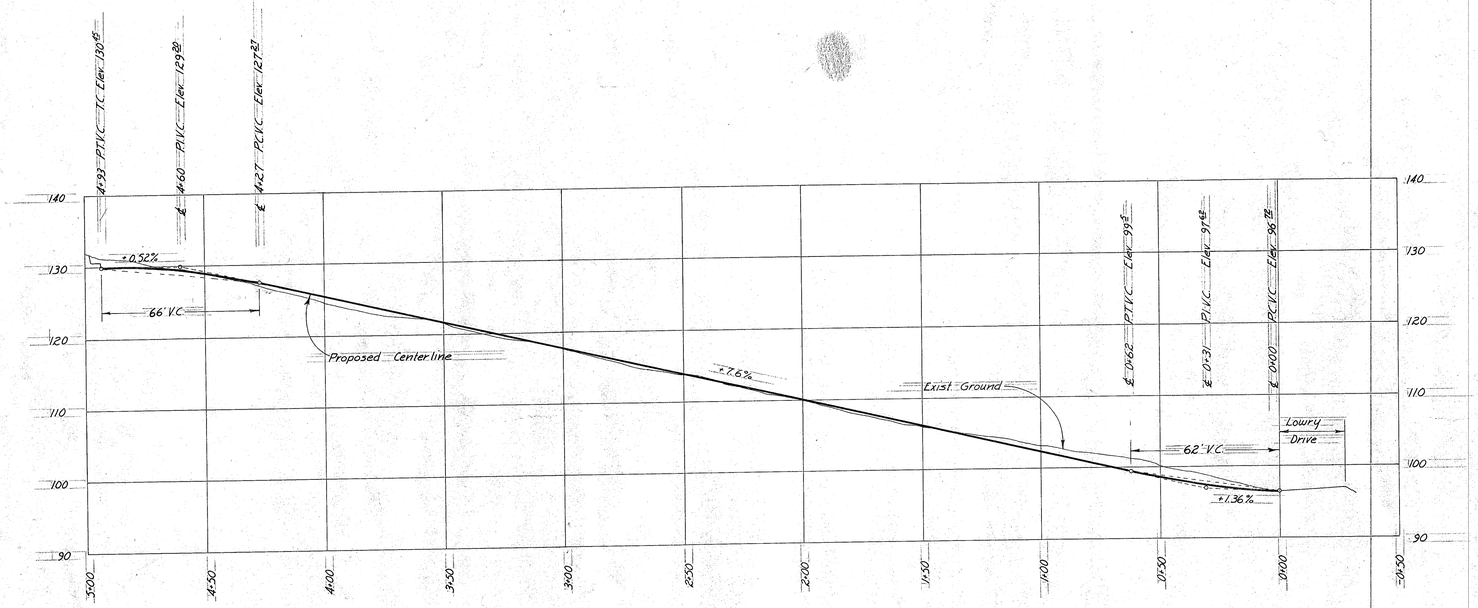

CENTURY LANE PROFILE

Scale: Horz. 1"=30'
Vert. 1"=10'

2" BLOW OFF VALVE DETAIL

No Scale

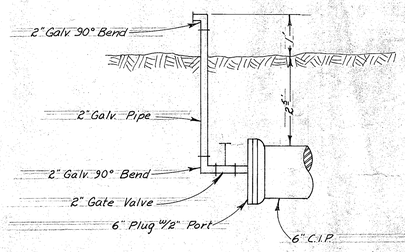

CITY OF WEST LINN	
CENTURY LANE	
STREET & WATER IMPROVEMENT	
Approved By:	Merle L. Irvine, Public Works Director
Scale: As Shown	Date: March 1970
Dsn By: M.L.I. / Ck By:	Sheet 1 of 1