SECTION A - A
SCALE 1" = 2'

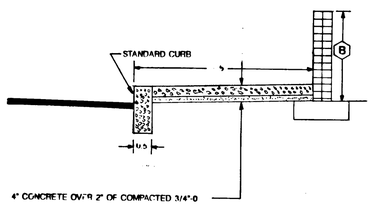

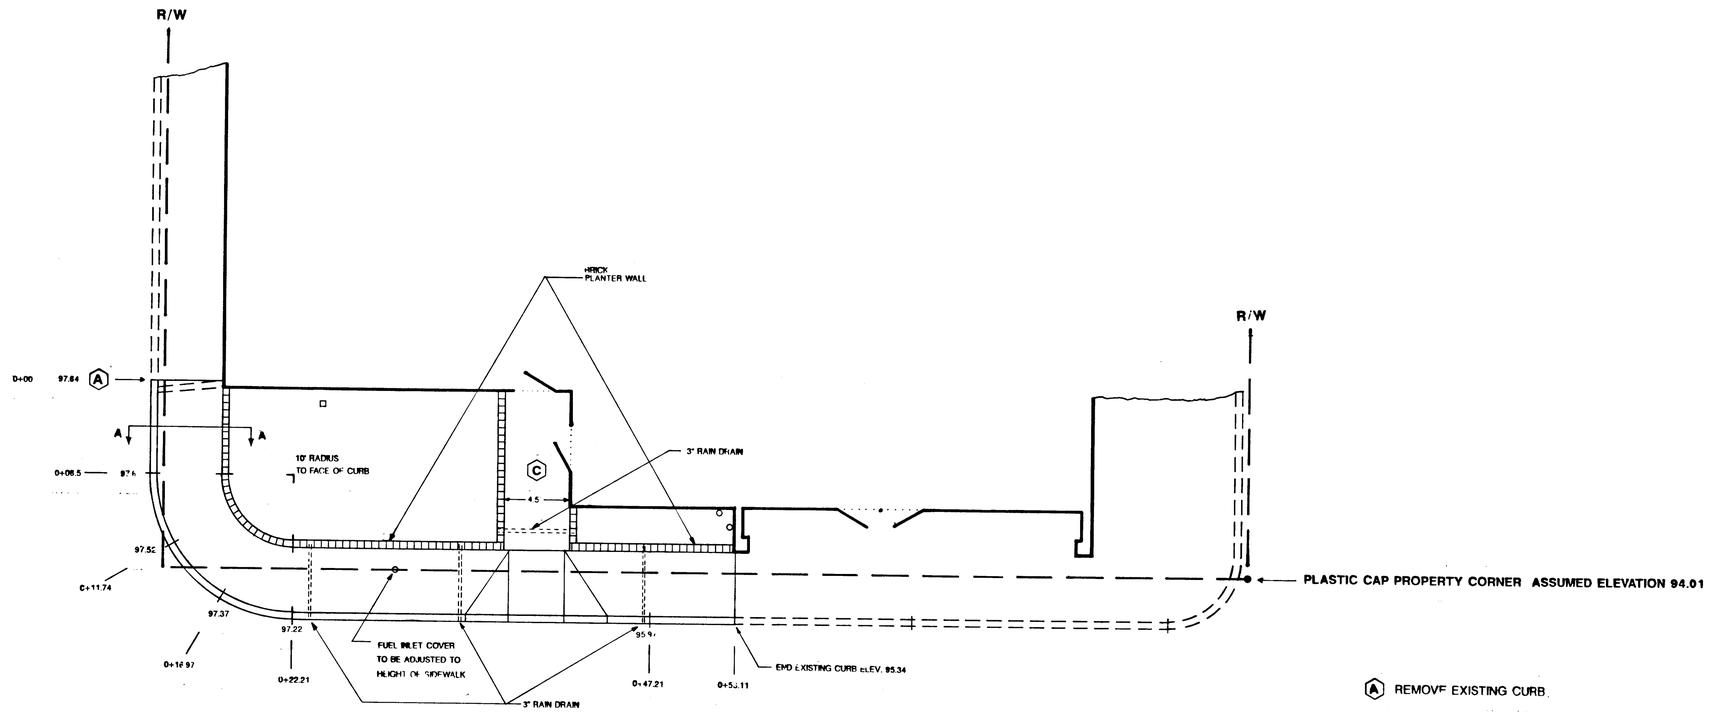

A REMOVE EXISTING CURB

B HEIGHT VARIES, SEE WALL ELEVATIONS

C 4.5' SIDEWALK - 4"CONCRETE, 2" COMPACTED 3/4"-0

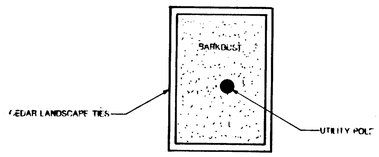

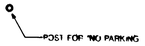

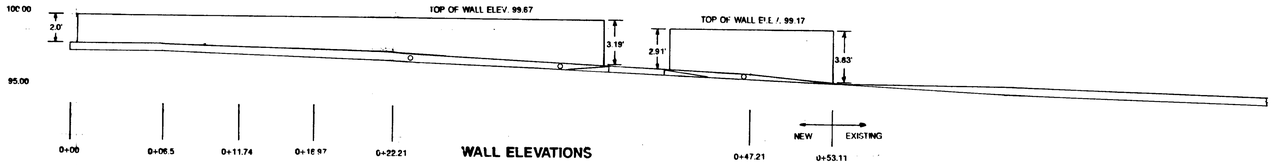

WALL ELEVATIONS

DATE	NO.	REVISION

DRAWN DDP

FILE

DATE 2-25-1988

SCALE 1" = 5'

CITY OF WEST LINN

PUBLIC WORKS DEPARTMENT

CITY HALL - SIDEWALK & PLANTER