AS BUILT

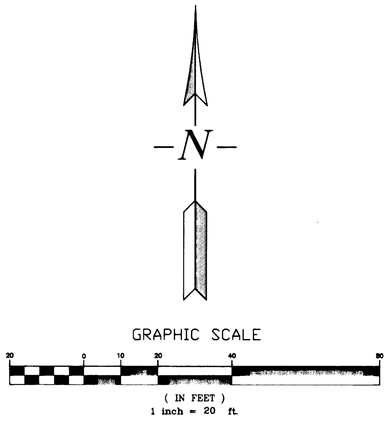

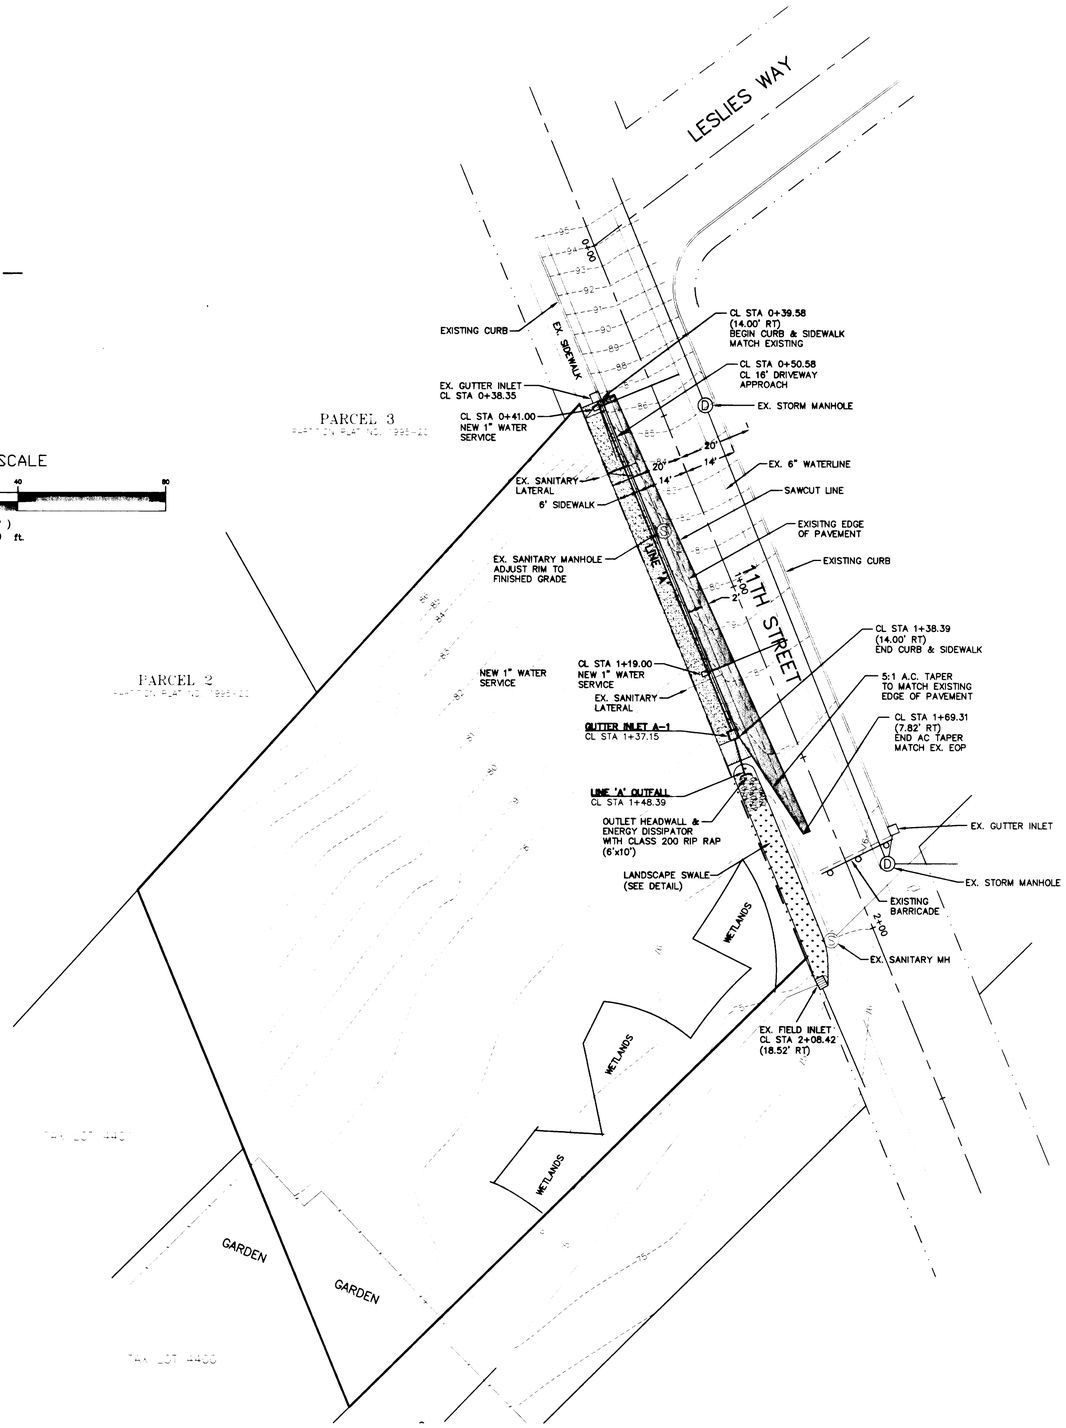

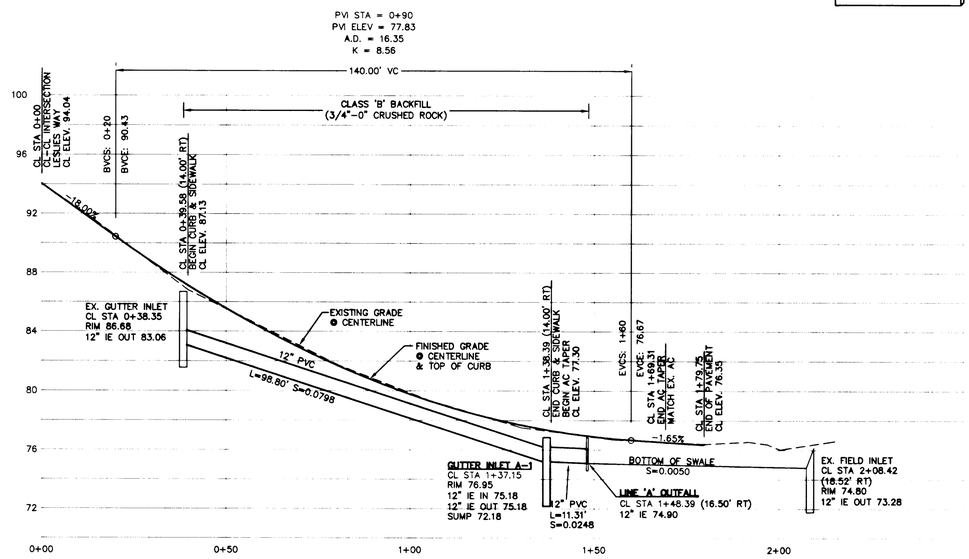

11TH STREET

SCALE: H: 1"=20'
V: 1"=5'

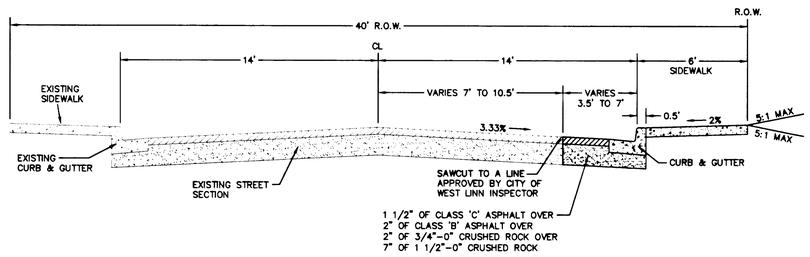

TYPICAL SECTION – 11TH STREET

N.T.S.

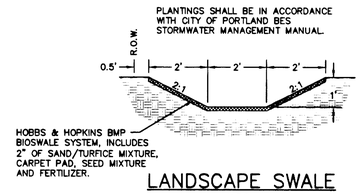

LANDSCAPE SWALE

N.T.S.

REGISTERED PROFESSIONAL ENGINEER #16,551 Patrick A. Sisul EXP 6/30/04 OREGON MAY 18, 1993 PATRICK A. SISUL

1-27-03

REVISIONS	BY
REVISED PER CITY COMMENTS 8/21/02	DJ
AS-BUILT 1-27-2003	LD

11TH STREET IMPROVEMENTS

JEFF FRANCIS

Street & Storm Drain Plan

SISUL ENGINEERING
375 PORTLAND AVENUE
GLADSTONE, OREGON 97027
(503) 657-0188

DATE	MAY 2002
SCALE	1"=20'
DRAWN	DJ
JOB	SGL 02-035
SHEET	1
OF	3 SHEETS

ELEVENTH ST.