TYP. ALL PLANS

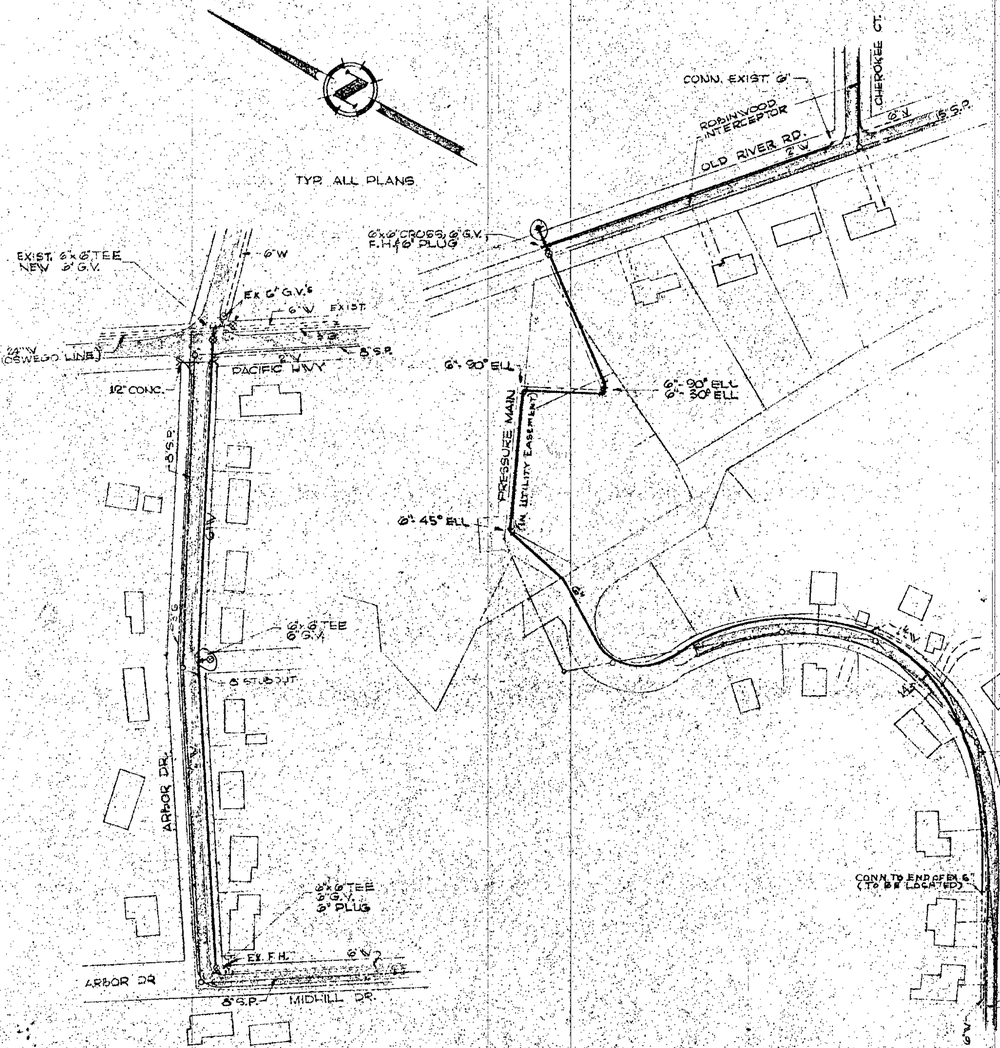

PLAN VIEW
1" = 10.0'

PLAN VIEW
1" = 100'

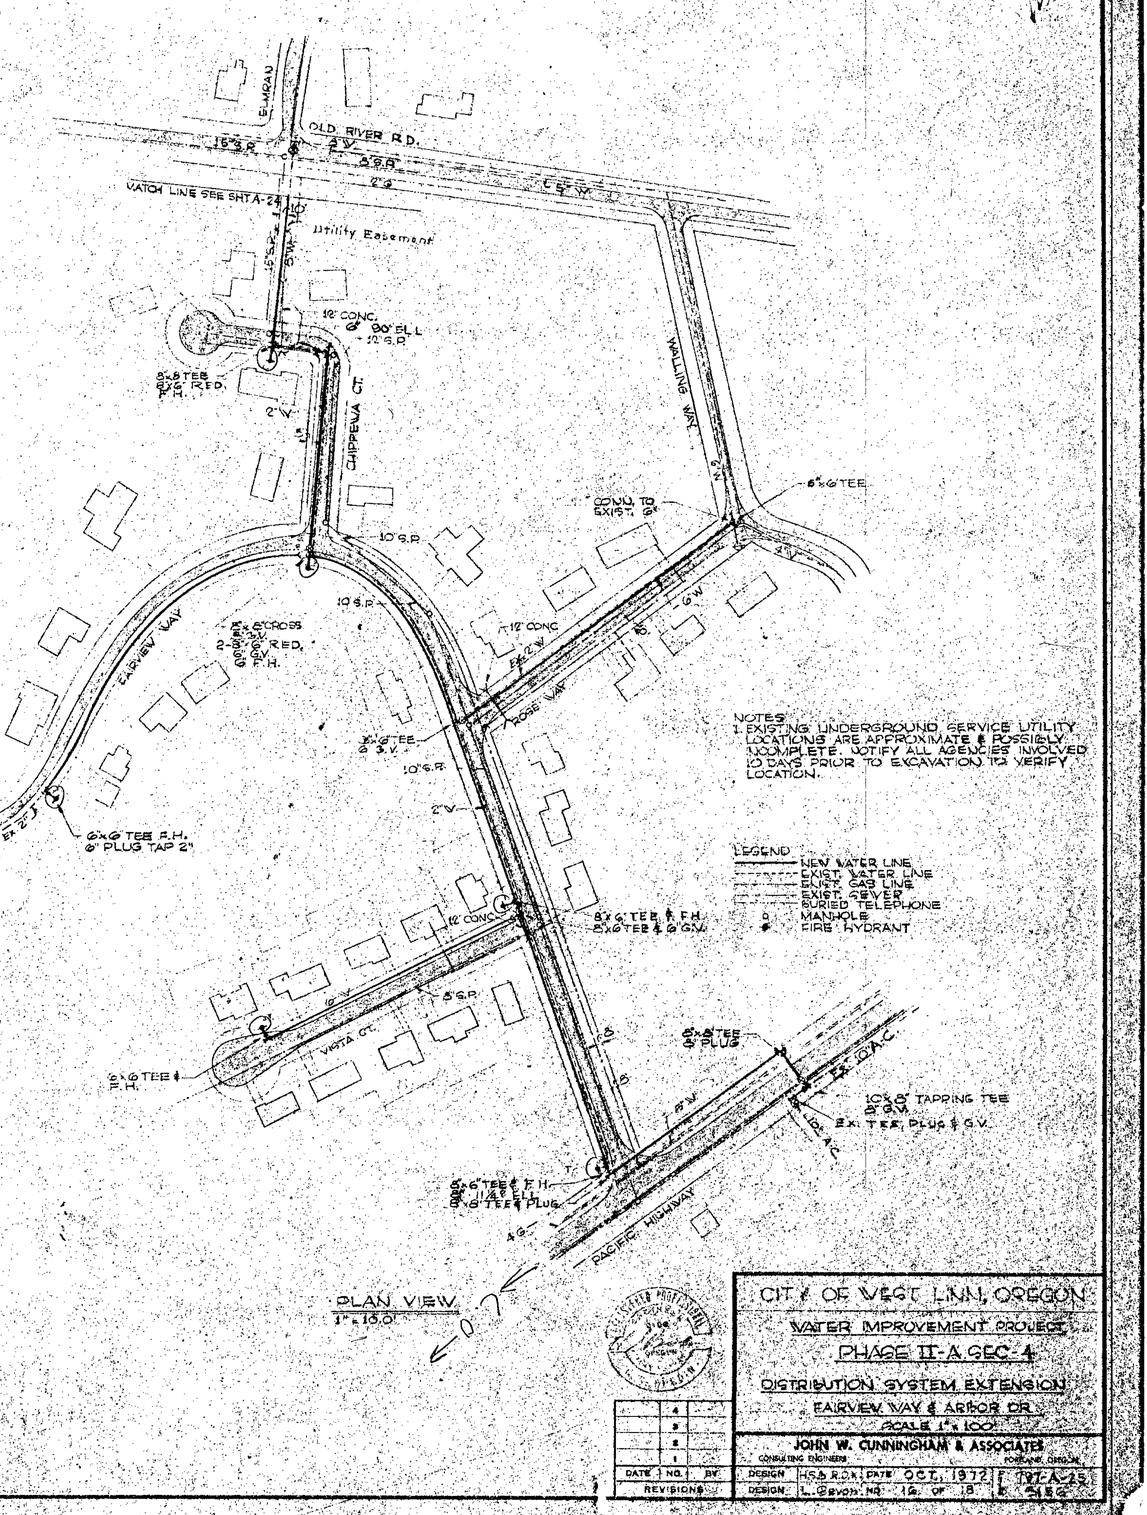

PLAN VIEW
1" = 10.0'

NOTES:
1. EXISTING UNDERGROUND SERVICE UTILITY LOCATIONS ARE APPROXIMATE & POSSIBLY INCOMPLETE. NOTIFY ALL AGENCIES INVOLVED 10 DAYS PRIOR TO EXCAVATION TO VERIFY LOCATION.

LEGEND
- NEW WATER LINE
- EXIST. WATER LINE
- EXIST. GAS LINE
- EXIST. SEWER
- BURIED TELEPHONE
- MANHOLE
- FIRE HYDRANT

	NO.	BY
	4	
	3	
	2	
	1	
DATE	NO.	BY
REVISIONS		

CITY OF WEST LINN, OREGON
WATER IMPROVEMENT PROJECT
DISTRIBUTION SYSTEM EXTENSION
FAIRVIEW WAY & ARBOR DR.
SCALE 1" = 100'

JOHN W. CUNNINGHAM & ASSOCIATES
CONSULTING ENGINEERS PORTLAND, OREGON

DESIGN	L. Gevedon	SHEET NO. 16 OF 18 SHEETS	

TYP. ALL PLANS

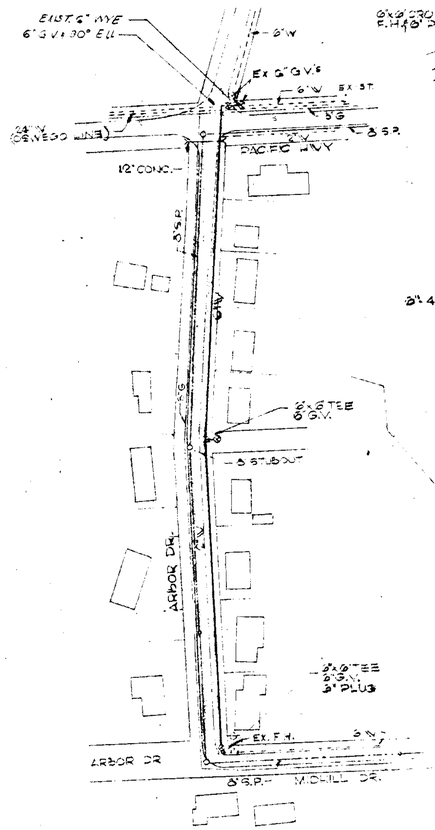

PLAN VIEW
1" = 10.0'

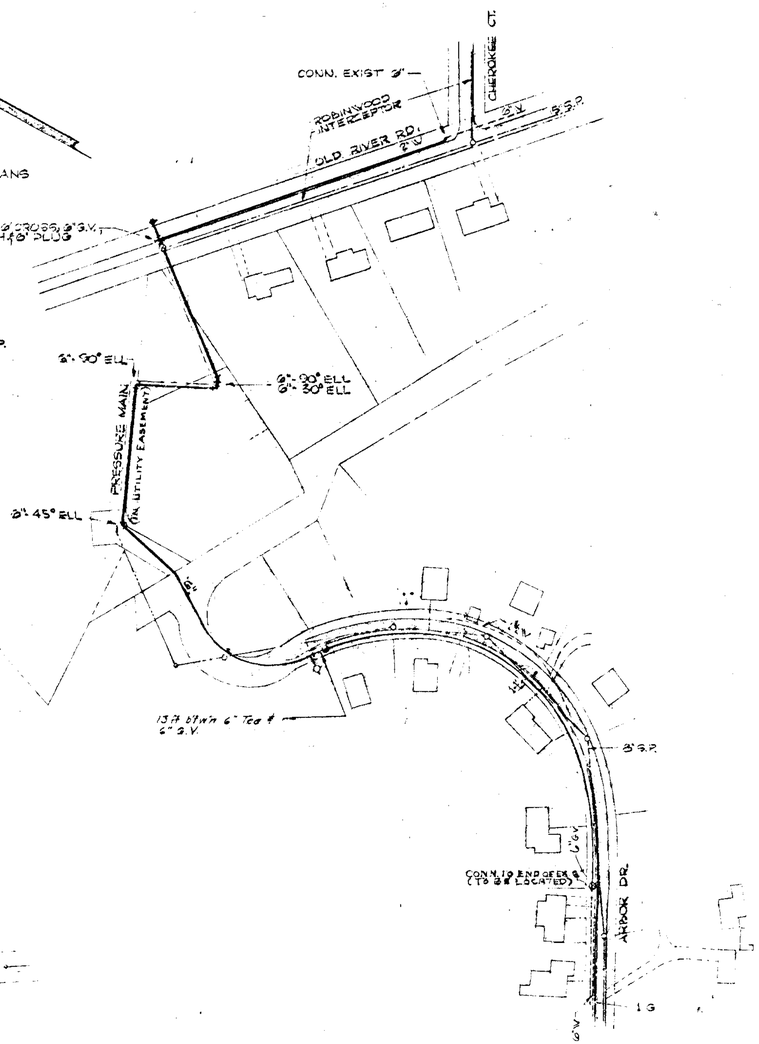

PLAN VIEW
1" = 100'

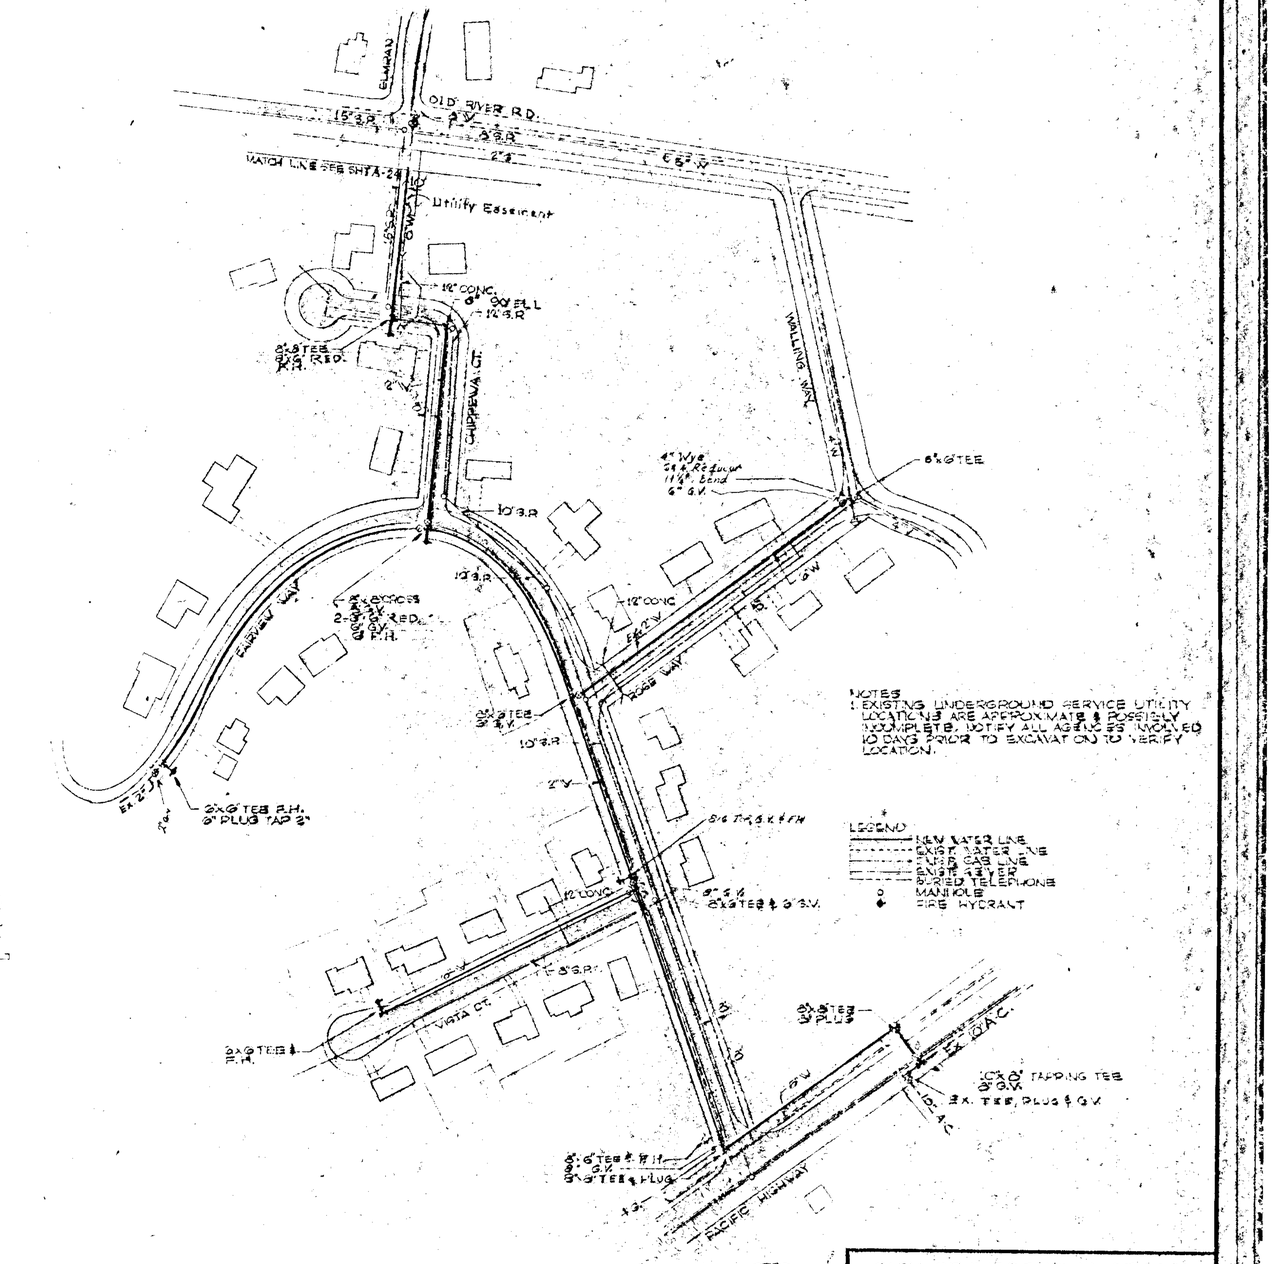

PLAN VIEW
1" = 10.0'

NOTES
1. EXISTING UNDERGROUND SERVICE UTILITY LOCATIONS ARE APPROXIMATE & POSSIBLY INCOMPLETE. NOTIFY ALL AGENCIES INVOLVED 10 DAYS PRIOR TO EXCAVATION TO VERIFY LOCATION.

As Built

NO.	BY	DATE
4		
3		
2		
1		

REVISIONS

CITY OF WEST LINN, OREGON
WATER IMPROVEMENT PROJECT
PHASE II-A SEC-4
DISTRIBUTION SYSTEM EXTENSION
FAIRVIEW WAY & ARBOR DR
SCALE 1" = 100'

JOHN W. CUNNINGHAM & ASSOCIATES
CONSULTING ENGINEERS PORTLAND, OREGON

DESIGN [illegible] DATE OCT. 1972 FILE 797-A-25
DESIGN [illegible] SHEET 9 OF [illegible] SHEETS