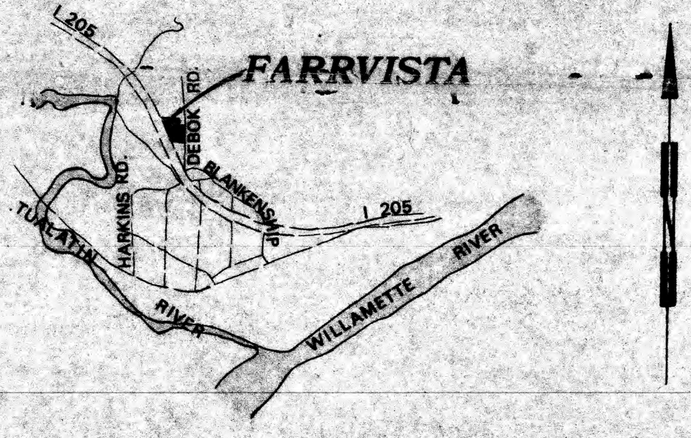

VICINITY MAP

NO SCALE

FOR:

DAVID E. FARR

PORTLAND, OREGON

W&H WILSEY & HAM

Suite 4, Portland Center, 222 S.W. Harrison
Portland, Oregon 97201 503 227-0455

CONSTRUCTION DRAWINGS

FARRVISTA

WEST LINN, OREGON

APPROVED AS REVISED 12-19-72

C. L. Sanders
City of West Linn
12-26-72

CONSTRUCTION NOTES
1. ALL WORK TO BE DONE IN CONFORMANCE WITH THE STANDARDS OF THE CITY OF WEST LINN.
2. TREES TO BE REMOVED IN CONSTRUCTION AREA UNLESS OTHERWISE NOTED.

SCALE 1"=40'

NOTE! CONTR. TO VERIFY EXACT LOCATION OF EXIST. 6" WATER LINE BEFORE CONST.

DE BOK ROAD

MARGERY STREET

FARRVISTA DRIVE

I-205 FREEWAY

EXISTING DE BOK 20.00 RADIUS CURB

EXIST. 6" WATER LINE

DISTRIBUTE EXCESS IN THIS AREA

EXCAVATION MATERIAL

20 HOT CHECK BARB FENCE ALONG FREEWAY

END 18" CMP CULVERT

CATCH BASIN #4 (TYPE 'A' 48" DIA.)

CATCH BASIN #3 (TYPE 'A' 48" DIA.)

CATCH BASIN #2 (TYPE 'A' 48" DIA.)

CATCH BASIN #1 (TYPE 'A' 48" DIA.)

STANDARD CATCH BASIN

DE BOK RD STREET SECTION

TYPICAL STREET SECTION

REV. 12-19-72 PER CITY OF WEST LINN ENG.

SHEET NO. 1 OF 4
DESIGN NOV. 1972 BY DNG
DRAWN NOV. 1972 BY DNG
CHECKED NOV. 1972 BY DEF
FILE NO. 4-1938-0701-20

FARRVISTA

DAVID E. FARR

WEST LINN, OREGON

STREET & STORM SEWER PLAN

W&H WILSEY & HAM
Suite 4, Portland Center, 222 S.W. Harrison
Portland, Oregon 97201 503 227-0455

SHEET NO. 2 OF 4
DESIGN NOV. 1972 BY DAG
DRAWN NOV. 1972 BY DAG
CHECKED NOV. 1972 BY [illegible]
FILE NO. 4-1828-0701-20

FARRVISTA
DAVID E. FARR
WEST LINN, OREGON

WATER & SAN SEWER PLAN

W&H WILSEY & HAM
Suite 4, Portland Center, 222 S.W. Harrison
Portland, Oregon 97201 503 227-0455

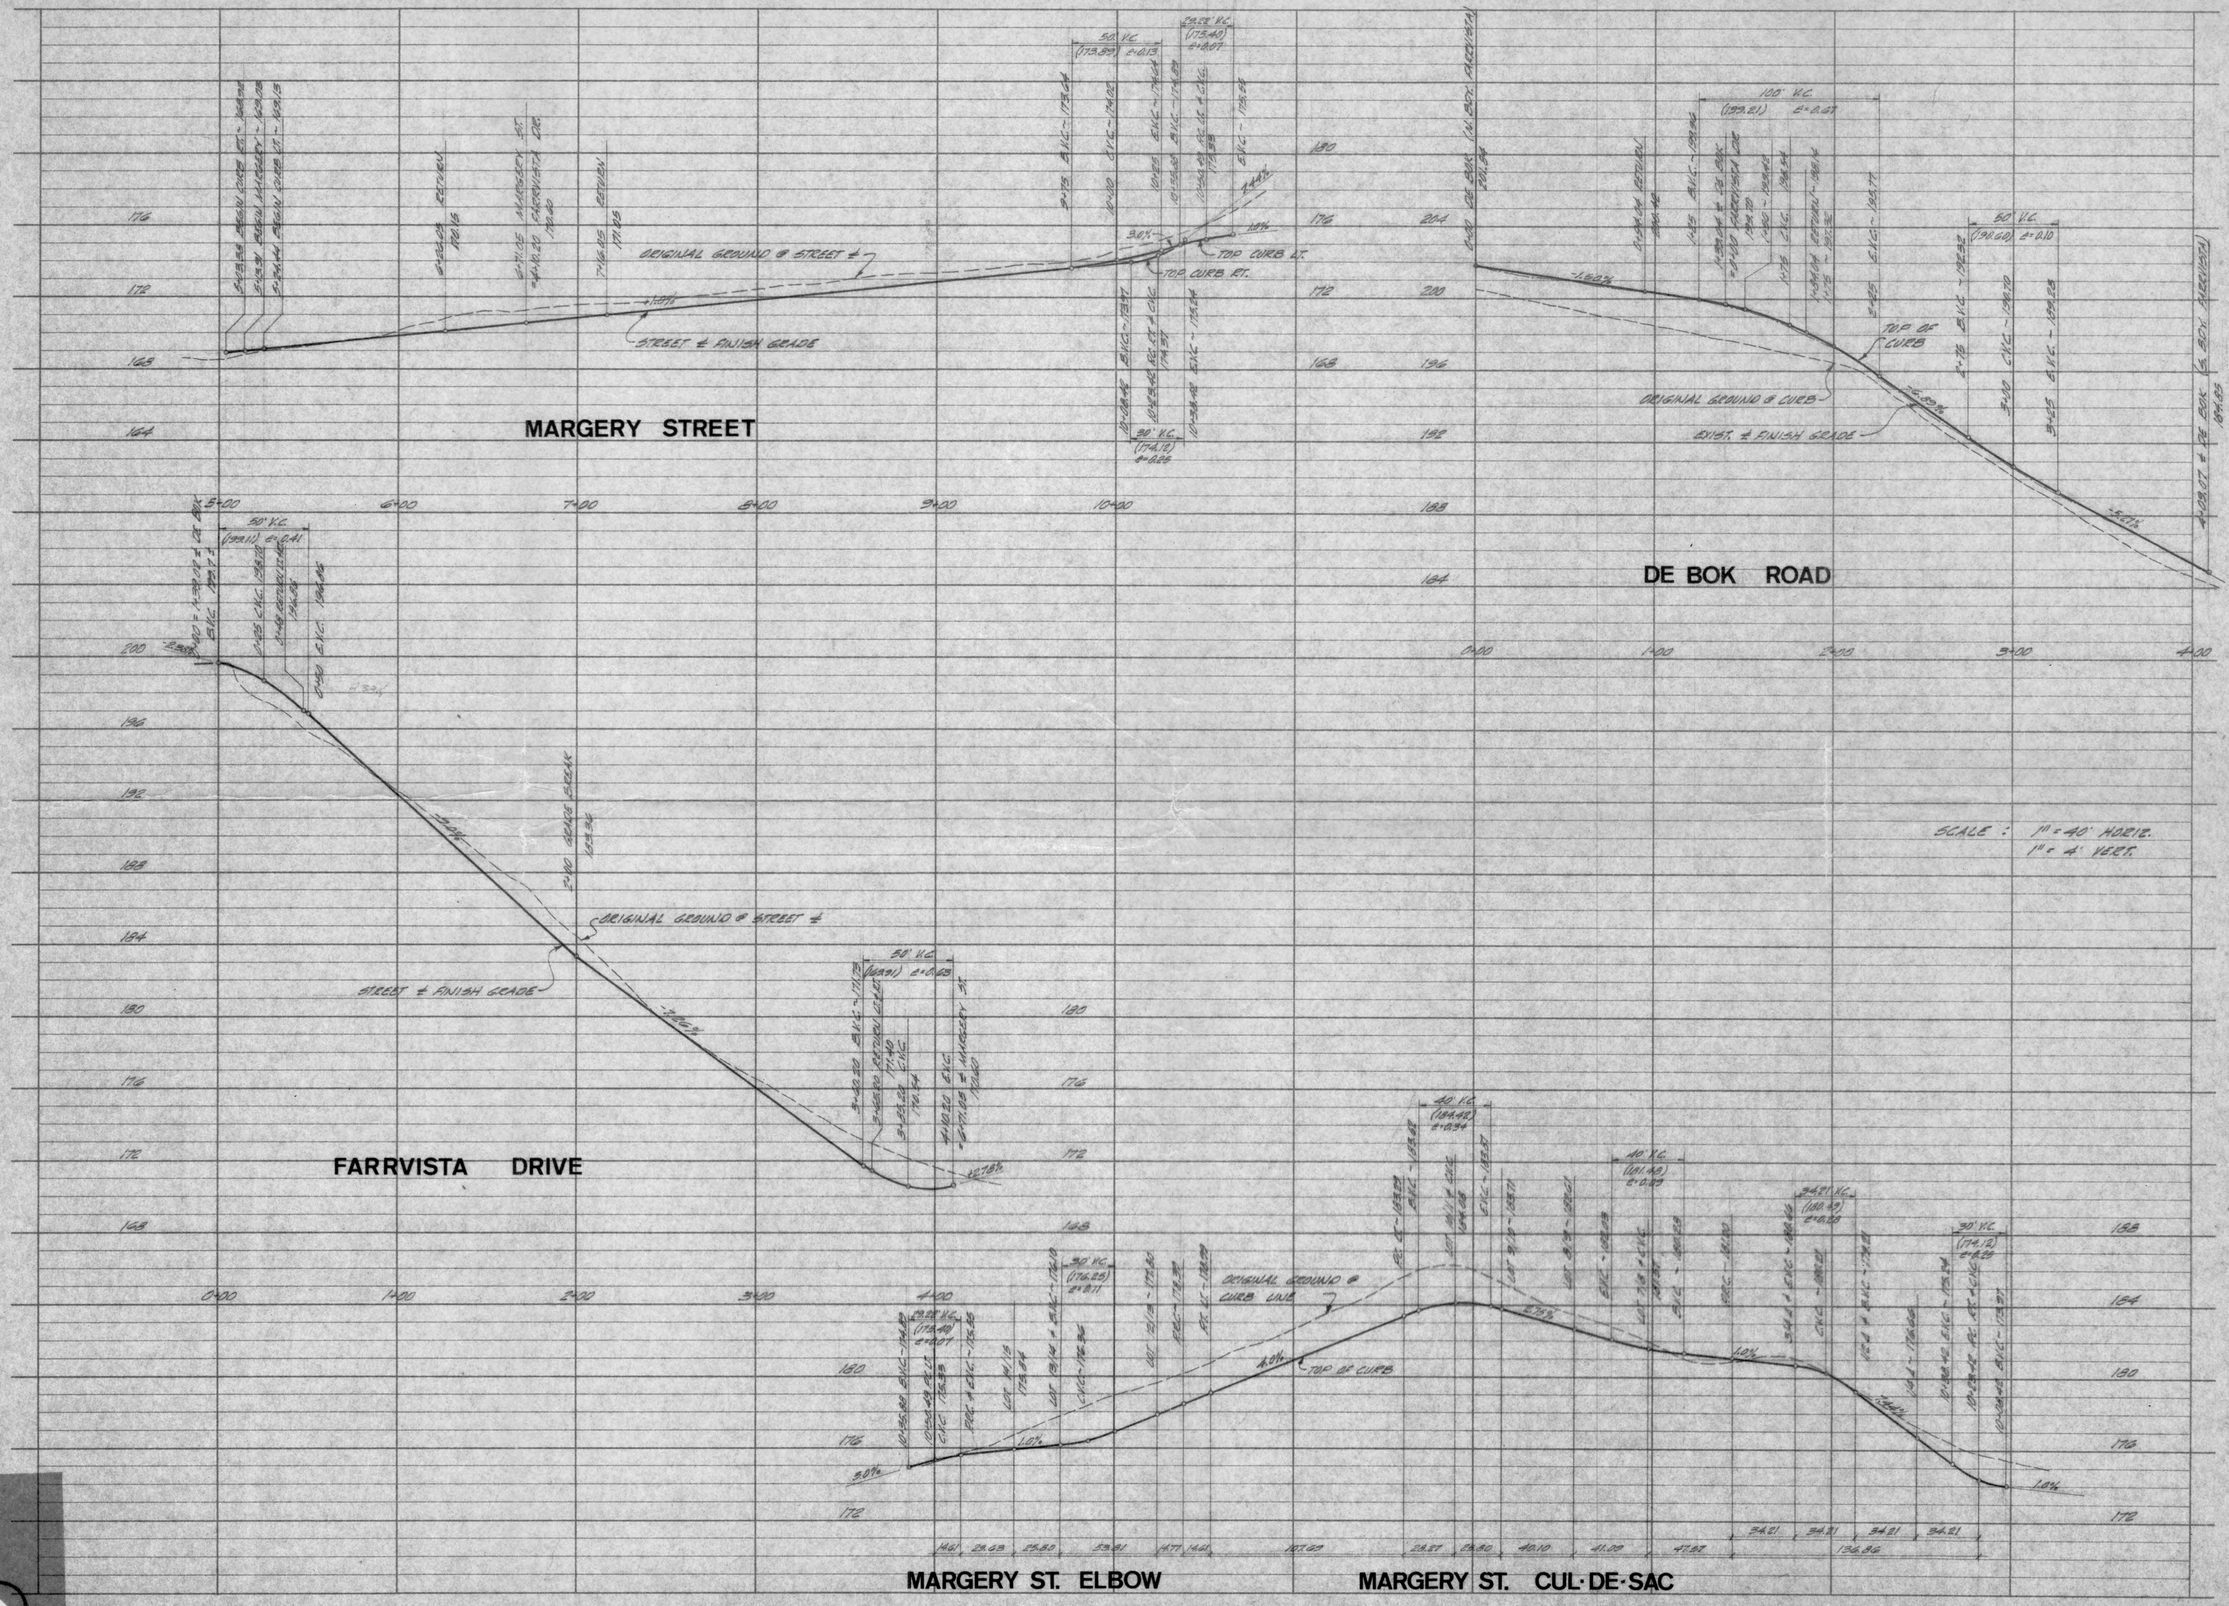

W&H WILSEY & HAM

Suite 4, Portland Center, 222 S.W. Harrison
Portland, Oregon 97201 503 227-0455

STREET PROFILES

FARRVISTA

DAVID E. FARR

WEST LINN, OREGON

SHEET NO. 3 OF 4

DESIGN NOV. 1971 BY DEF

DRAWN NOV. 1971 BY DEF

CHECKED NOV. 1971 BY DEF

FILE NO. F-1968-0170-00

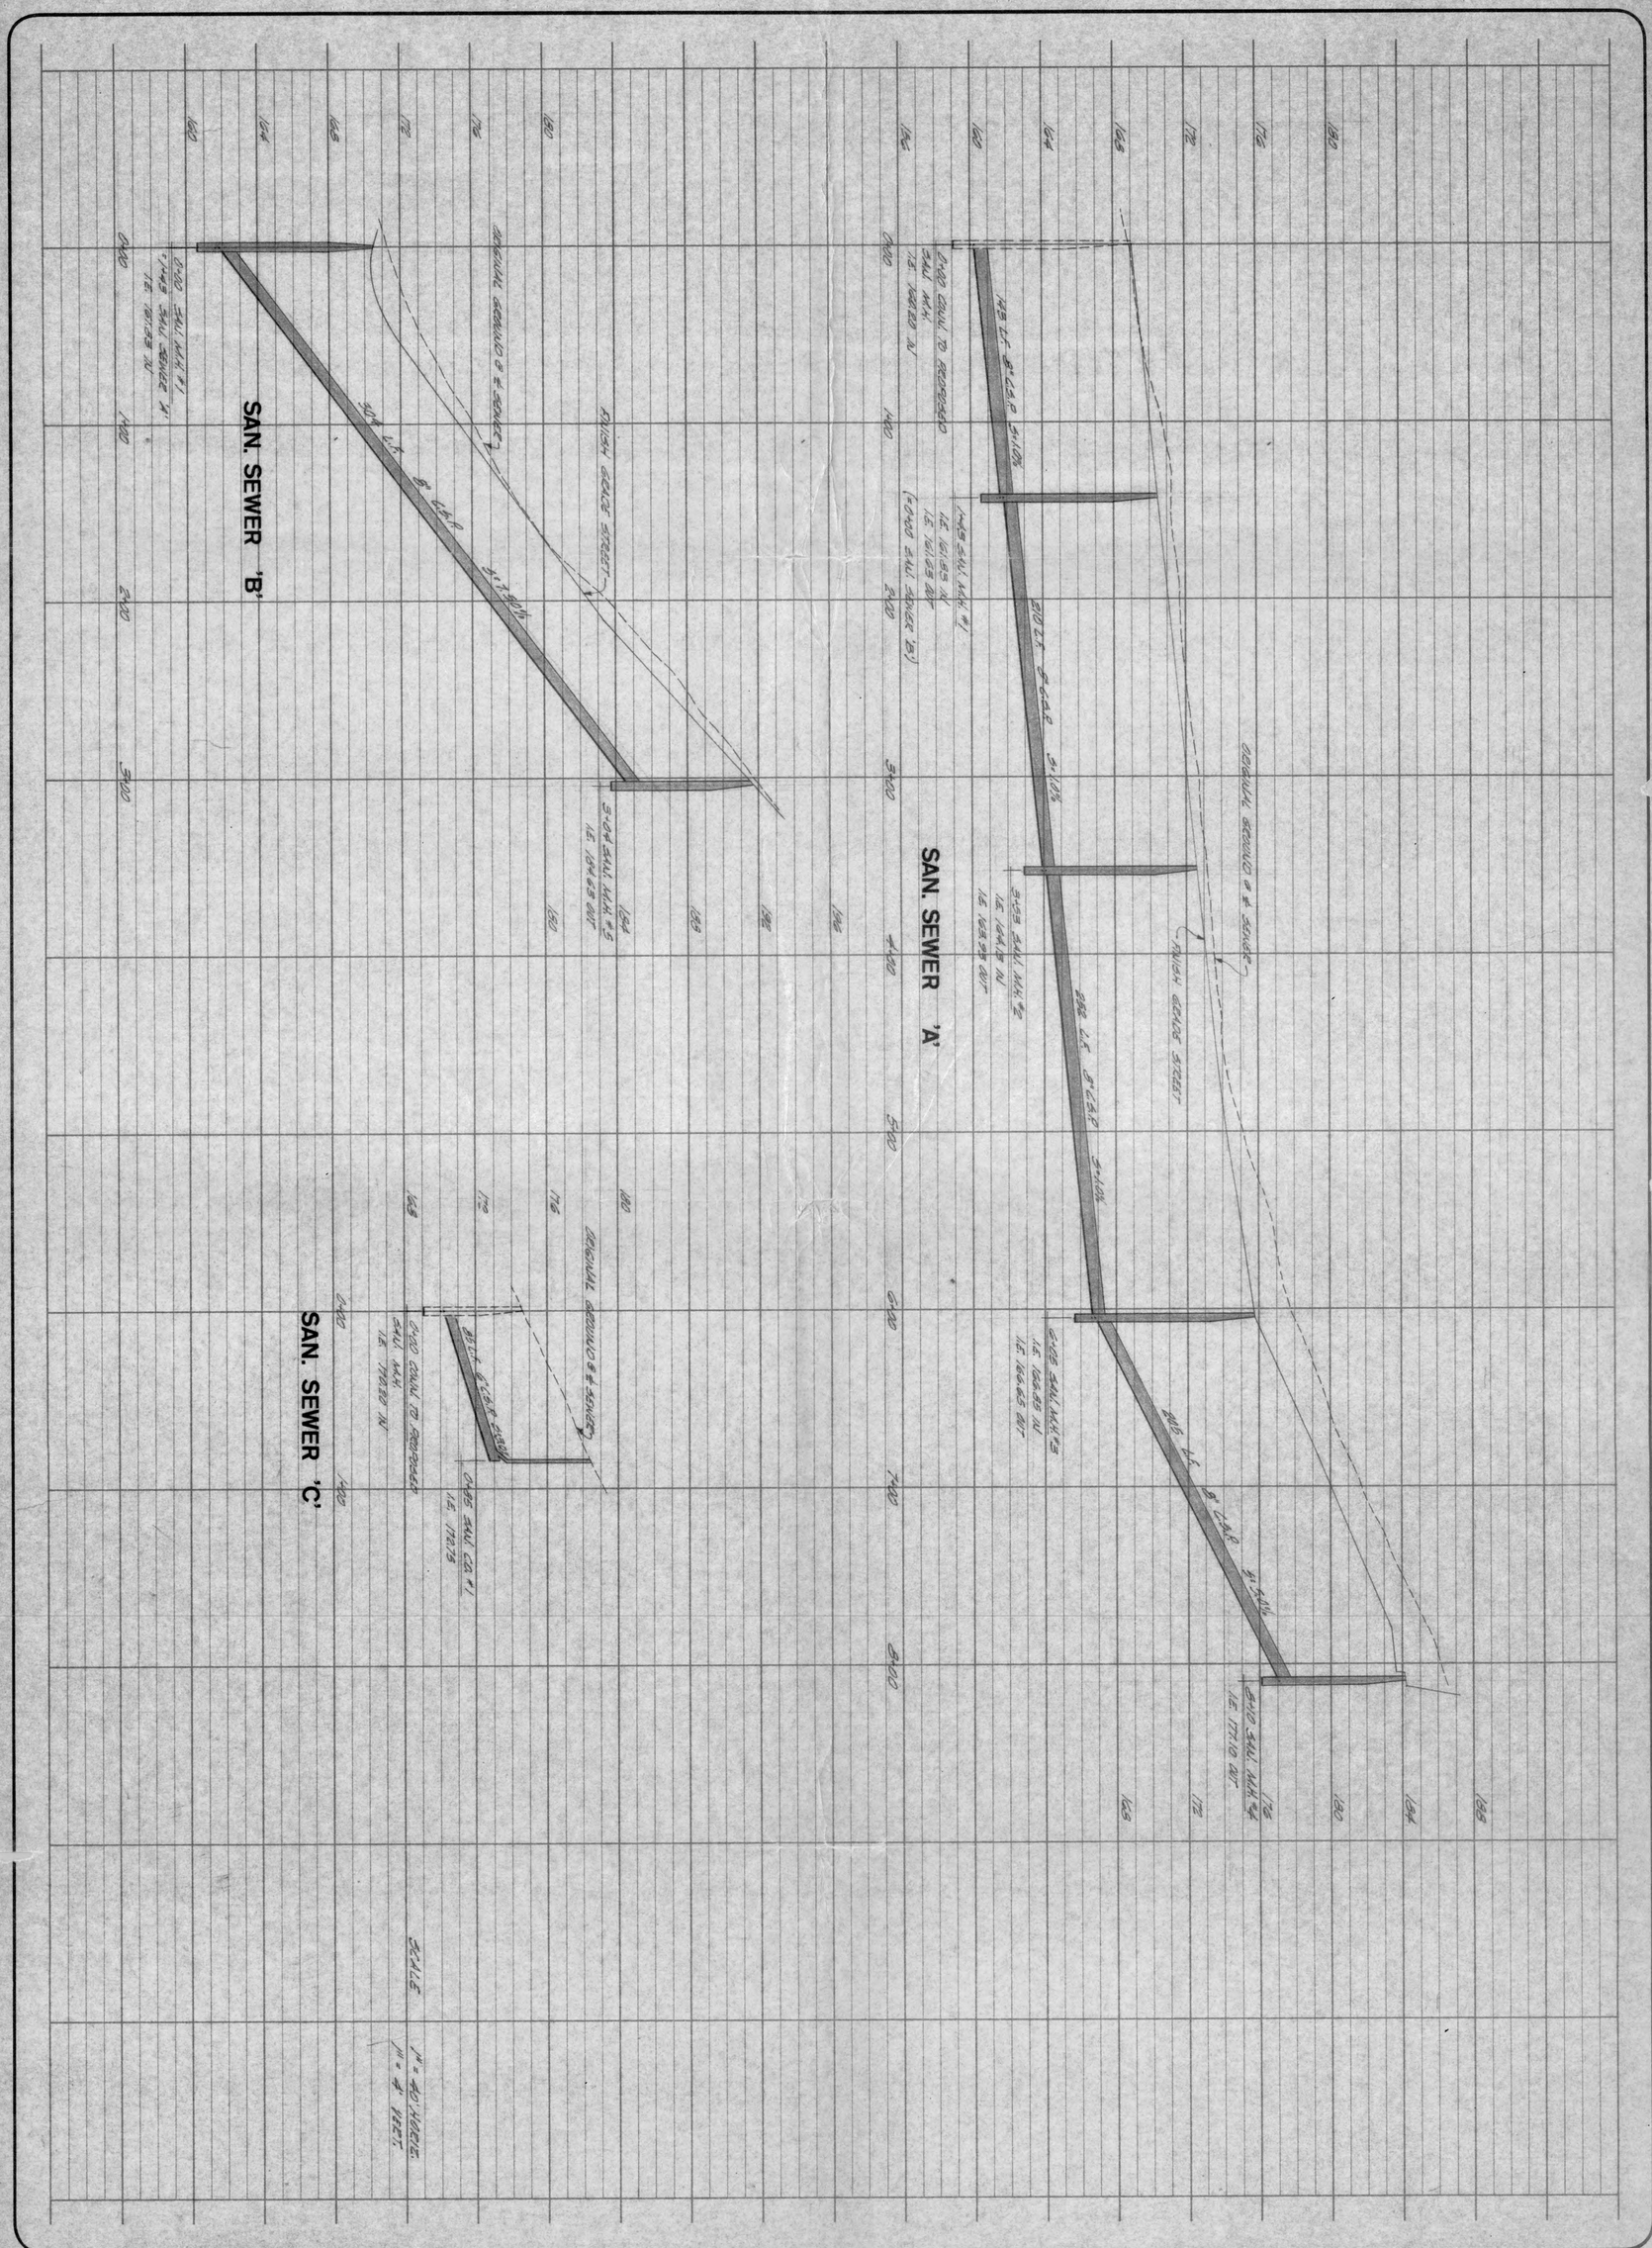

SHEET NO. 4 OF 4

DESIGN NOV. 1972 BY DAG

DRAWN NOV. 1972 BY DAG

CHECKED NOV. 1972 BY DE

FILE NO. 4-1928-0701-20

FARRVISTA

DAVID E. FARR

WEST LINN OREGON

SANITARY SEWER PROFILES

W&H WILSEY & HAM

Suite 4, Portland Center, 222 S.W. Harrison

Portland, Oregon 97201 503 227-0455