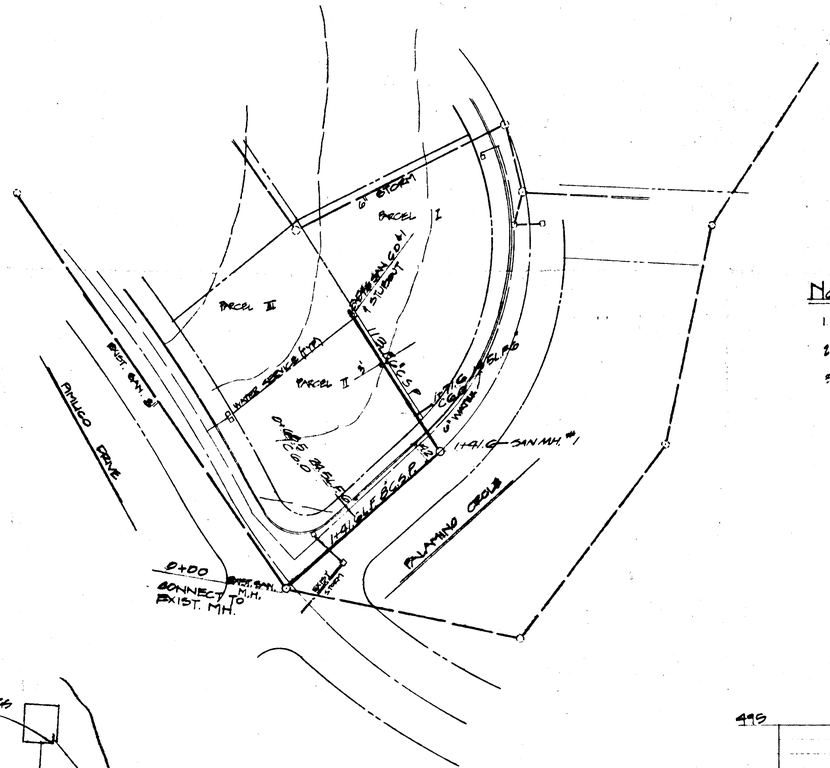

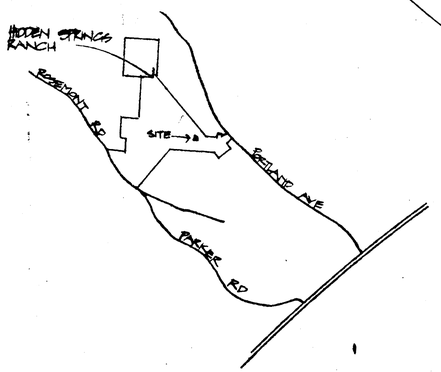

NOTES

1. ALL CONSTRUCTION SHALL CONFORM TO THE APPLICABLE REQUIREMENTS OFF THE CITY OF WEST LINN, OREGON.
2. EXIST UTILITIES SHOWN ARE FROM RECORD ONLY AND THE CONTRACTOR SHALL EXPOSE AND VERIFY THESE WHERE APPLICABLE BEFORE STARTING CONSTRUCTION.
3. SANITARY SEWER PIPE SHALL BE SHALL BE CONCRETE PIPE, ASTM C-14 EXTRA STRENGTH WITH RUBBER GASKETS.

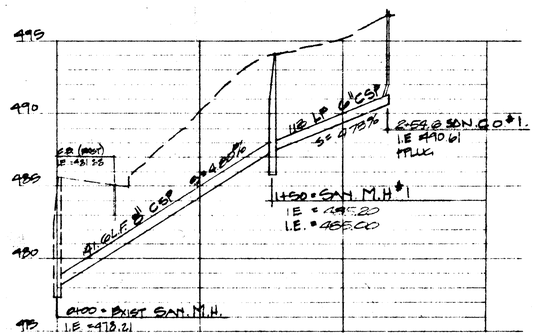

AS-BUILT 22 JUNE 77

W&H WILSEY & HAM
Suite 4, Portland Center, 222 S.W. Harrison
Portland, Oregon 97201 503 227-0455

MINOR PARTITION - LOT 6 BLOCK 8,
HIDDEN SPRINGS RANCH NO. 2
SANITARY & WATER
WEST LINN, OREGON

SHEET NO. 1 of 1
DESIGN BY
DRAWN MAY 77 BY GL
CHECKED MAY 77 BY JMP
FILE NO. 4-1100-5601

Jerry M. Palmer

-HIDDEN SPRINGS RANCH 2
Lot 6 Block 8