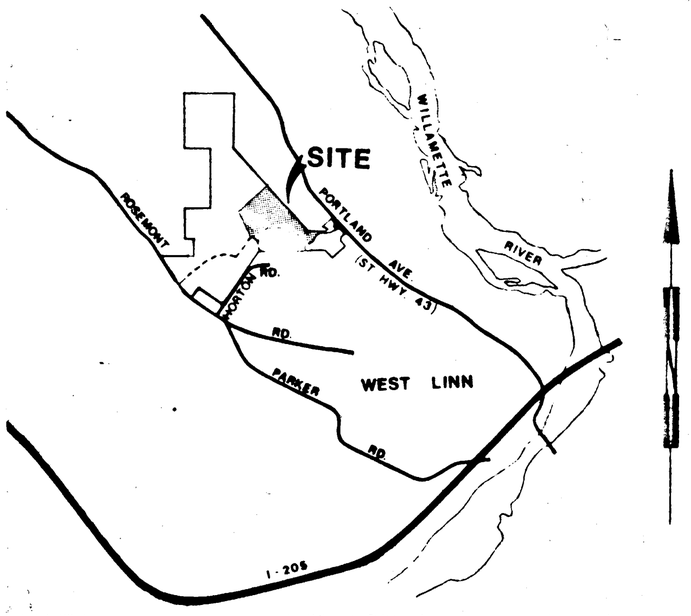

VICINITY MAP

NO SCALE

FOR:

EDWARDS INDUSTRIES, INC.
Beaverton, Oregon

W&H WILSEY & HAM

Suite 4, Portland Center, 222 S.W. Harrison
Portland, Oregon 97201 503 227-0455

AS BUILT 3-2-76

CONSTRUCTION DRAWINGS

HIDDEN SPRINGS RANCH NO.2

West Linn, Oregon

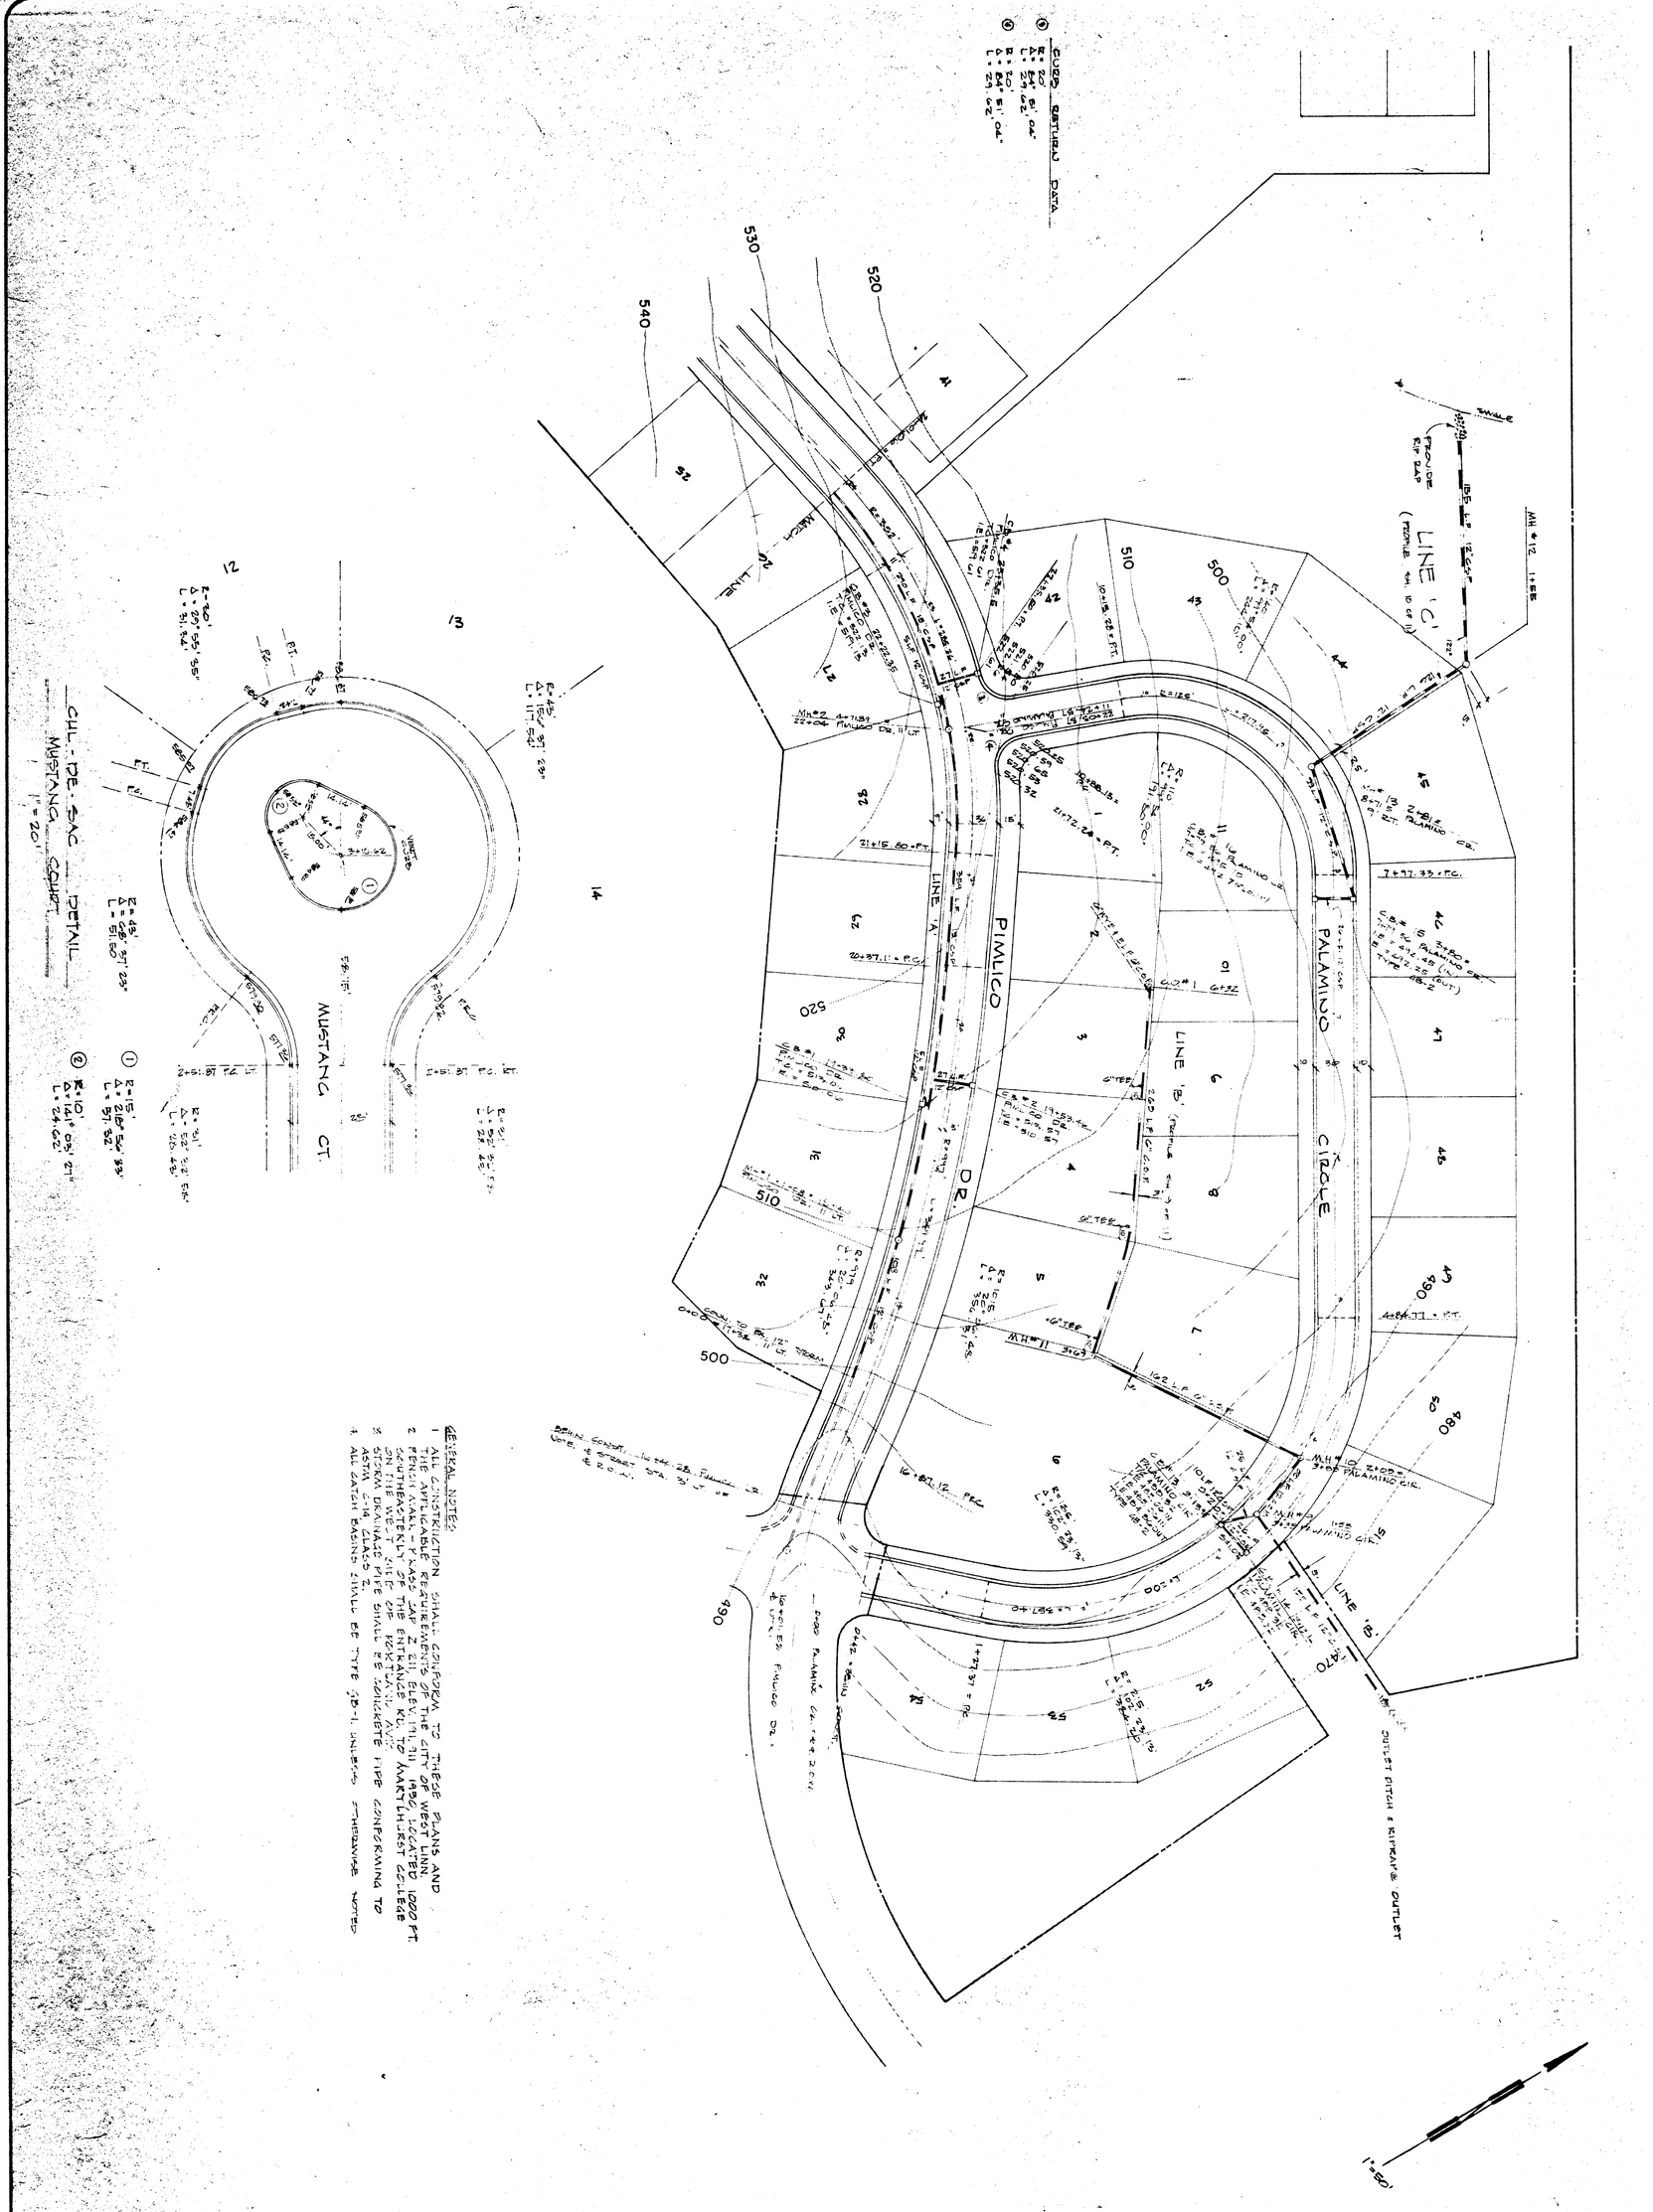

GENERAL NOTES:

1. ALL CONSTRUCTION SHALL CONFORM TO THESE PLANS AND THE CURRENT APPLICABLE REQUIREMENTS OF THE CITY OF WEST LINN.
2. PENINSULAR - PLASS CAP Z 611 ELEV. 171.711 1956 LOCATED 1000 FT. SOUTHEASTERLY OF THE ENTRANCE RD. TO MARYLHURST COLLEGE
3. SEE INDIVIDUAL SHEETS FOR HORIZONTAL CONTROL.
4. ALL CATCH BASINS SHALL BE TYPE CB-1 UNLESS OTHERWISE NOTED

AS BUILT 3-2-76

SHEET NO. 1 of 11
DESIGN OCT. 1974 BY RFG
DRAWN OCT. 1974 BY JLM
CHECKED OCT. 1974 BY DPS
FILE NO. 4-1100-2261

REGISTERED PROFESSIONAL ENGINEER OREGON 6407 JULY 11, 1972 ERROL T. DAHL

HIDDEN SPRINGS RANCH NO. 2

west linn, oregon

Street & Storm Sewer Plan

EDWARDS INDUSTRIES, INC. beaverton, oregon

W&H WILSEY & HAM
Suite 4, Portland Center, 222 S.W. Harrison
Portland, Oregon 97201 503 227-0455

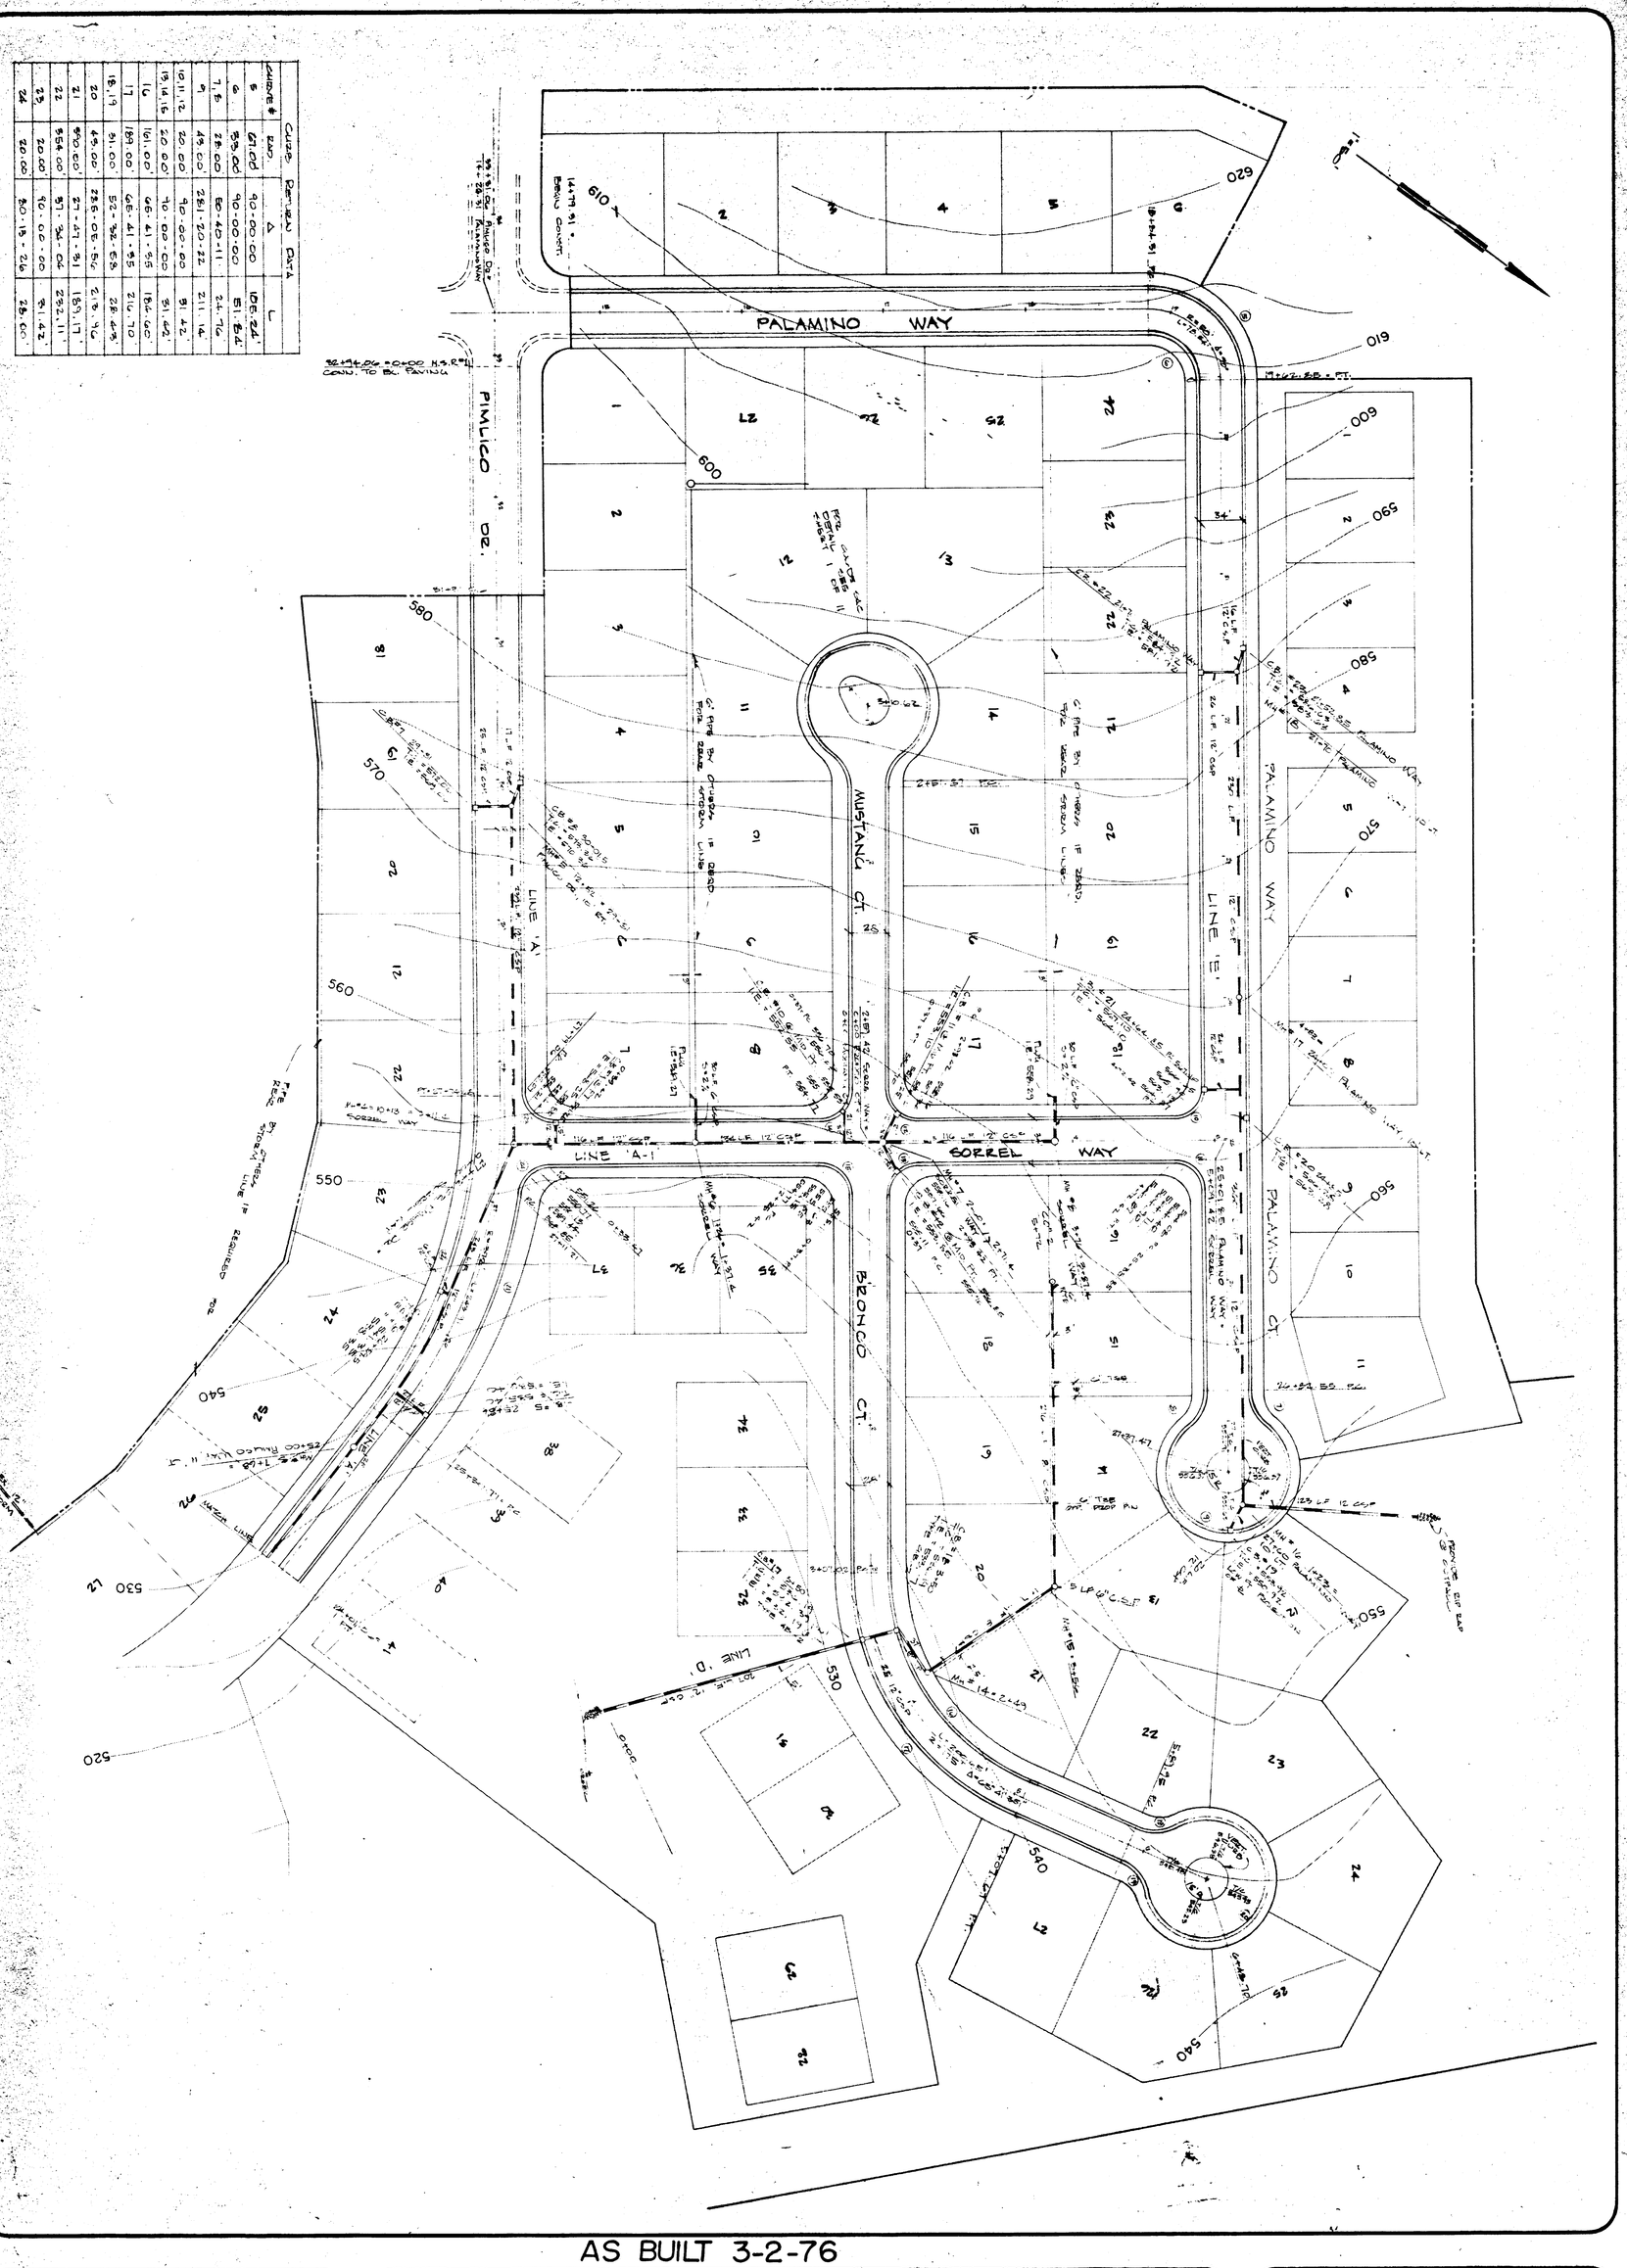

AS BUILT 3-2-76

SHEET NO. 2 of 11

DESIGN OCT. 1974 BY EPG
DRAWN OCT. 1974 BY JLM
CHECKED OCT. 1974 BY DPB
FILE NO. 4-1100-3201

REGISTERED PROFESSIONAL ENGINEER
OREGON
JULY 1, 1975
ERROL F. DAPP

HIDDEN SPRINGS RANCH NO. 2

west linn, oregon

Street & Storm Sewer Plan

EDWARDS INDUSTRIES, INC. beaverton, oregon

W&H WILSEY & HAM
Suite 4, Portland Center, 222 S.W. Harrison
Portland, Oregon 97201 503 227-0455

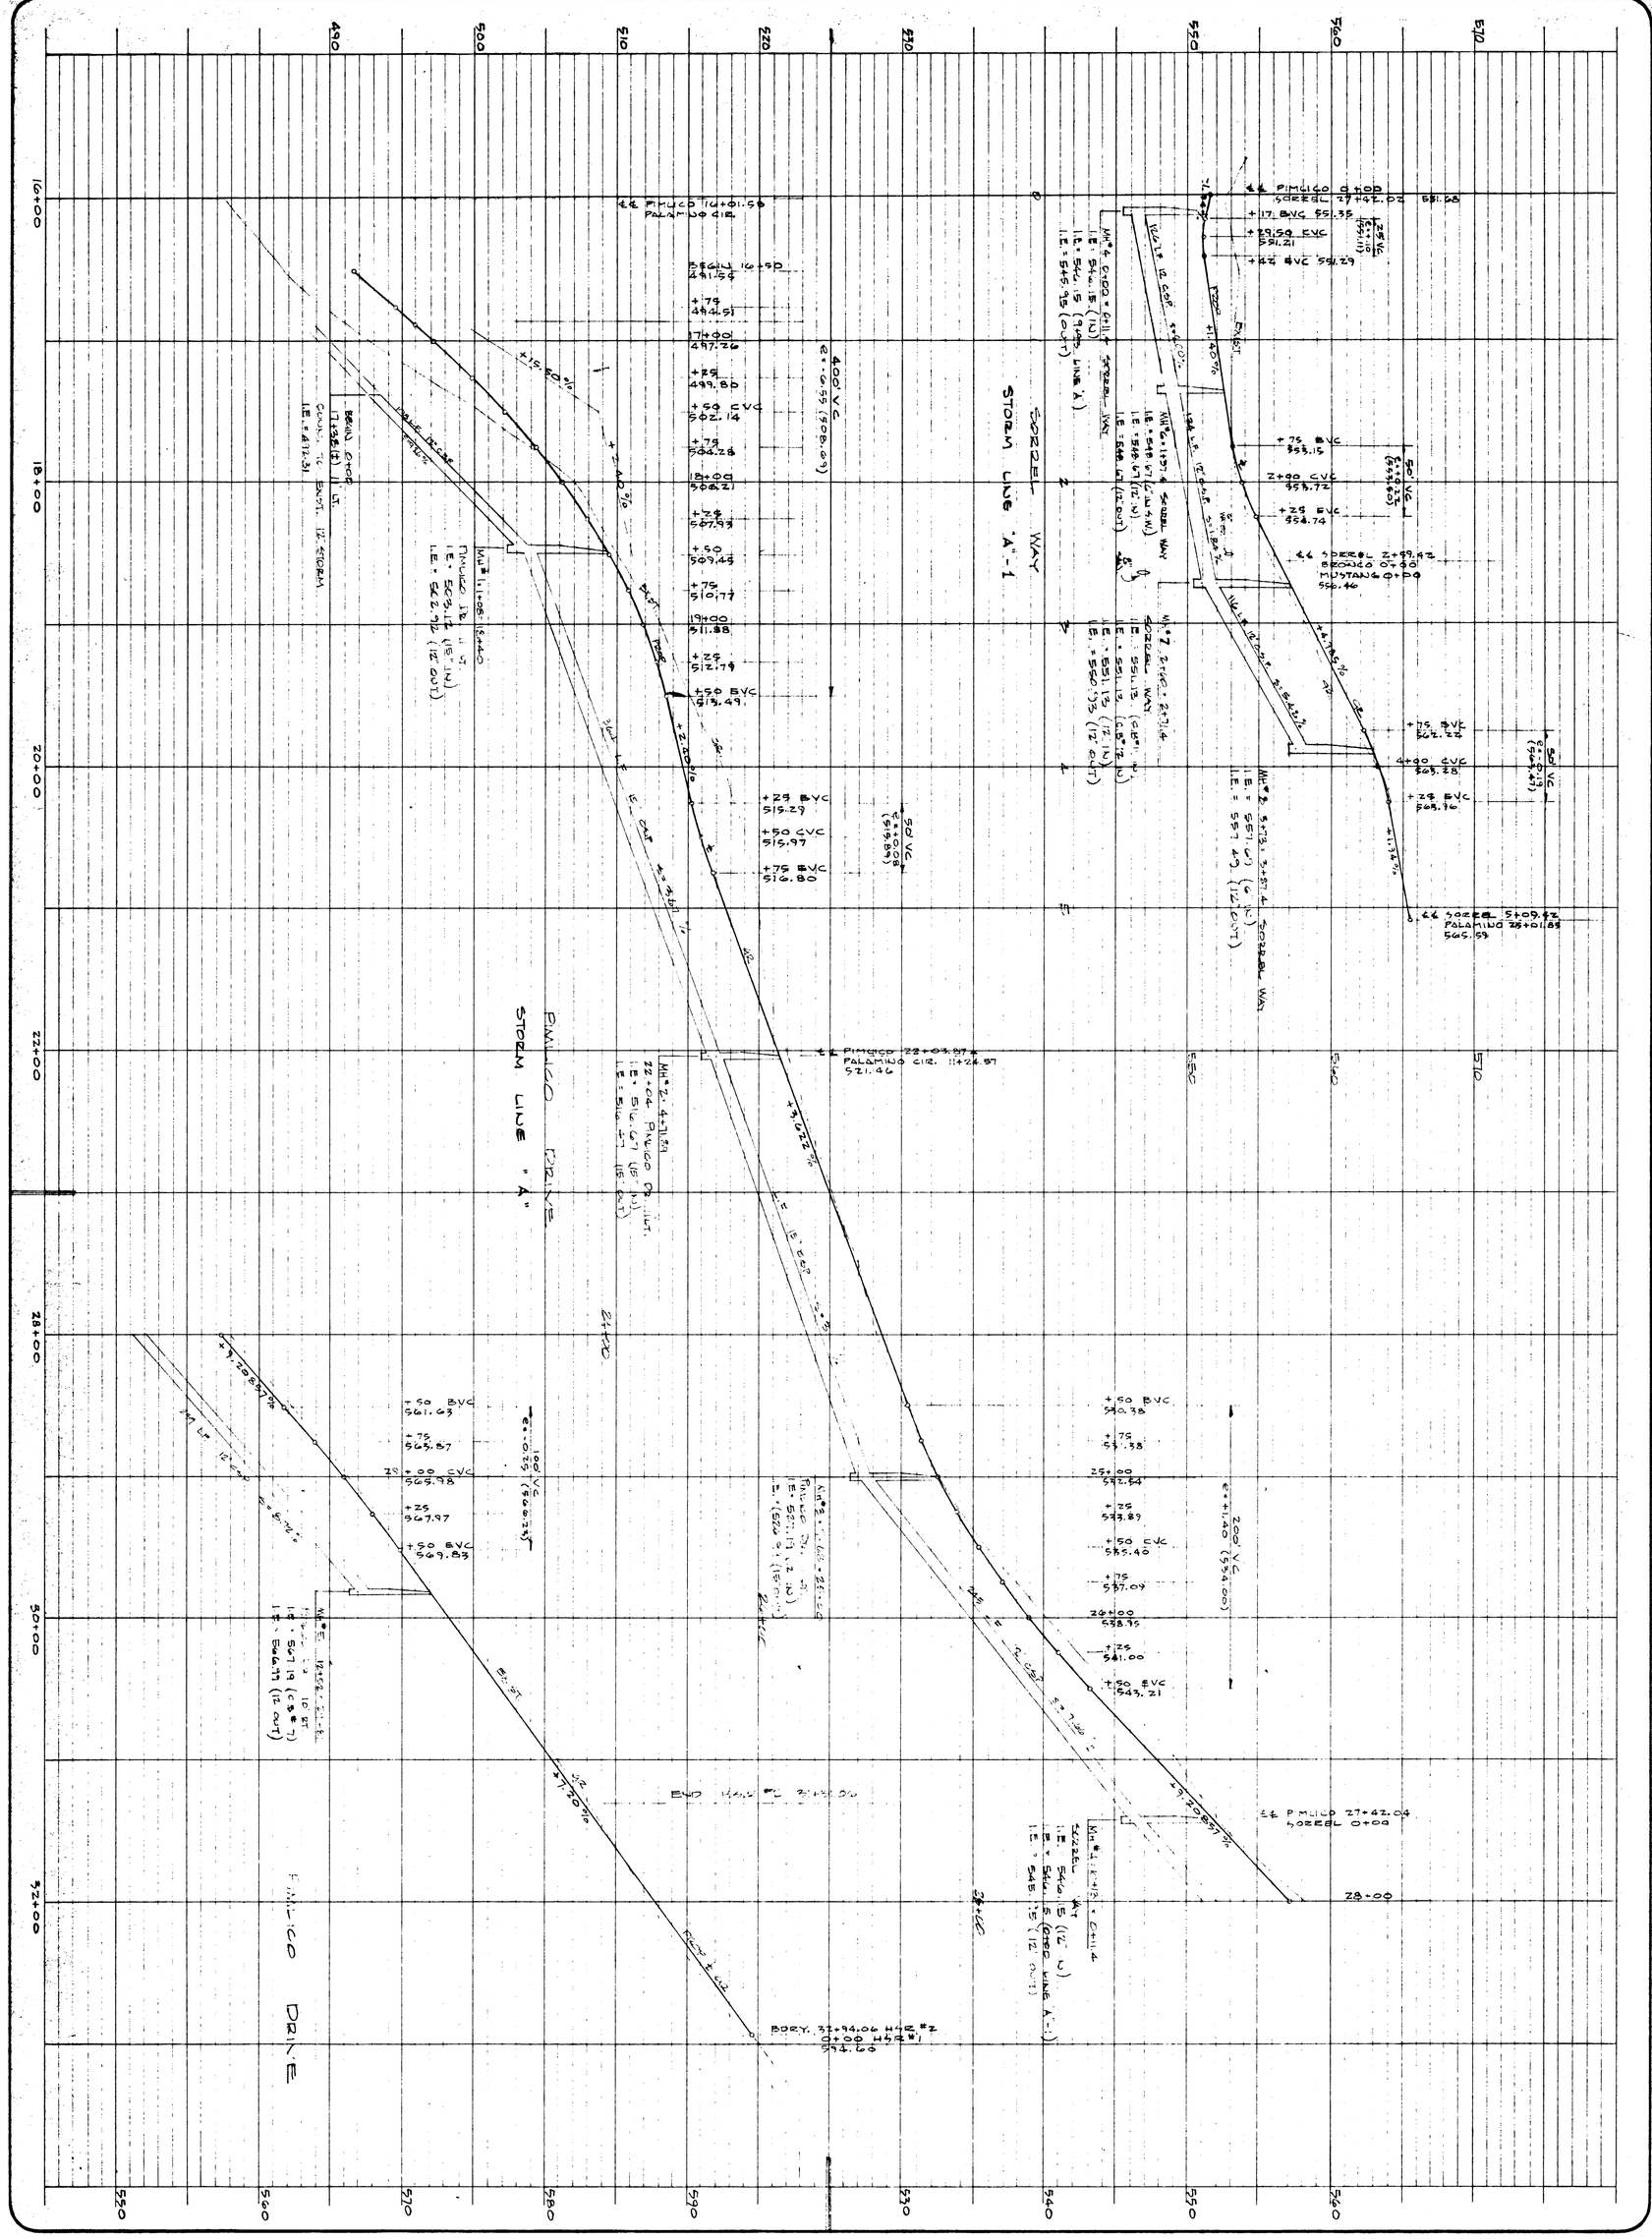
STORM LINE 'A-1
SOREEL WAY
STORM LINE "A"
PIMLICO DRIVE
PIMLICO DRIVE
EDGE OF PAVE
EDGE OF PAVE
EDGE OF PA

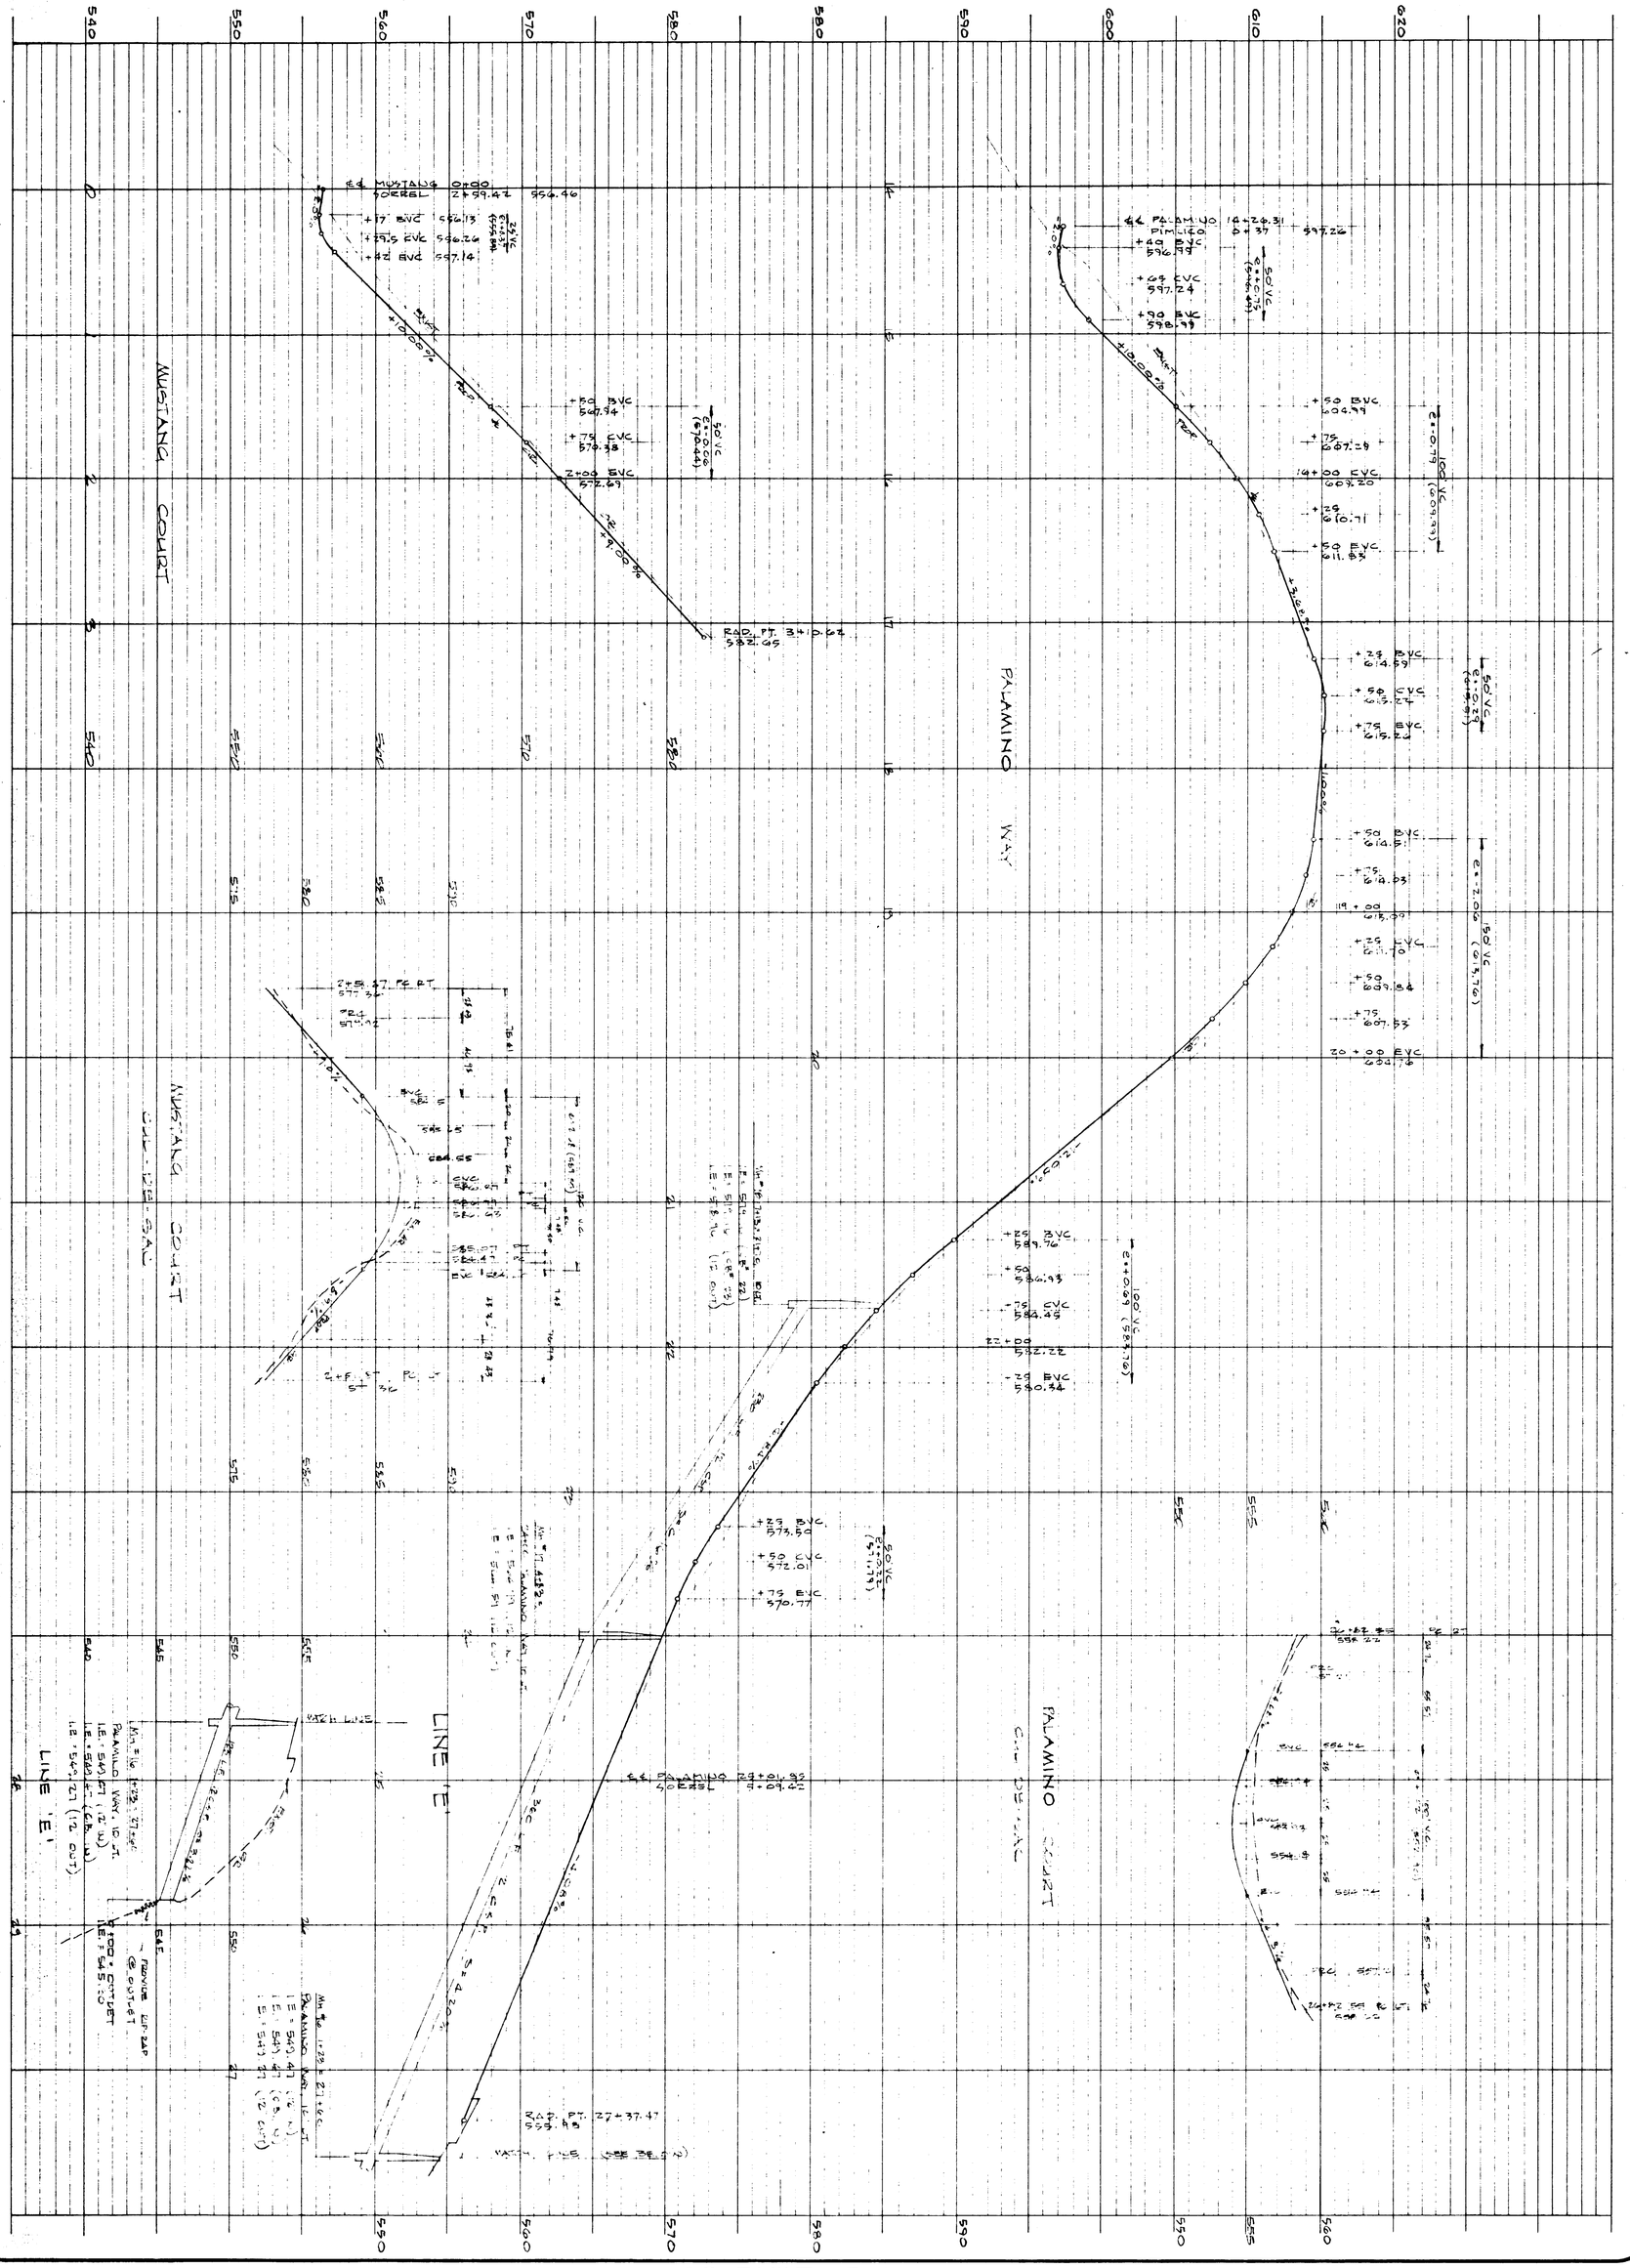
PALAMINO WAY
MUSTANG COURT
LINE 'E'
PALAMINO COURT
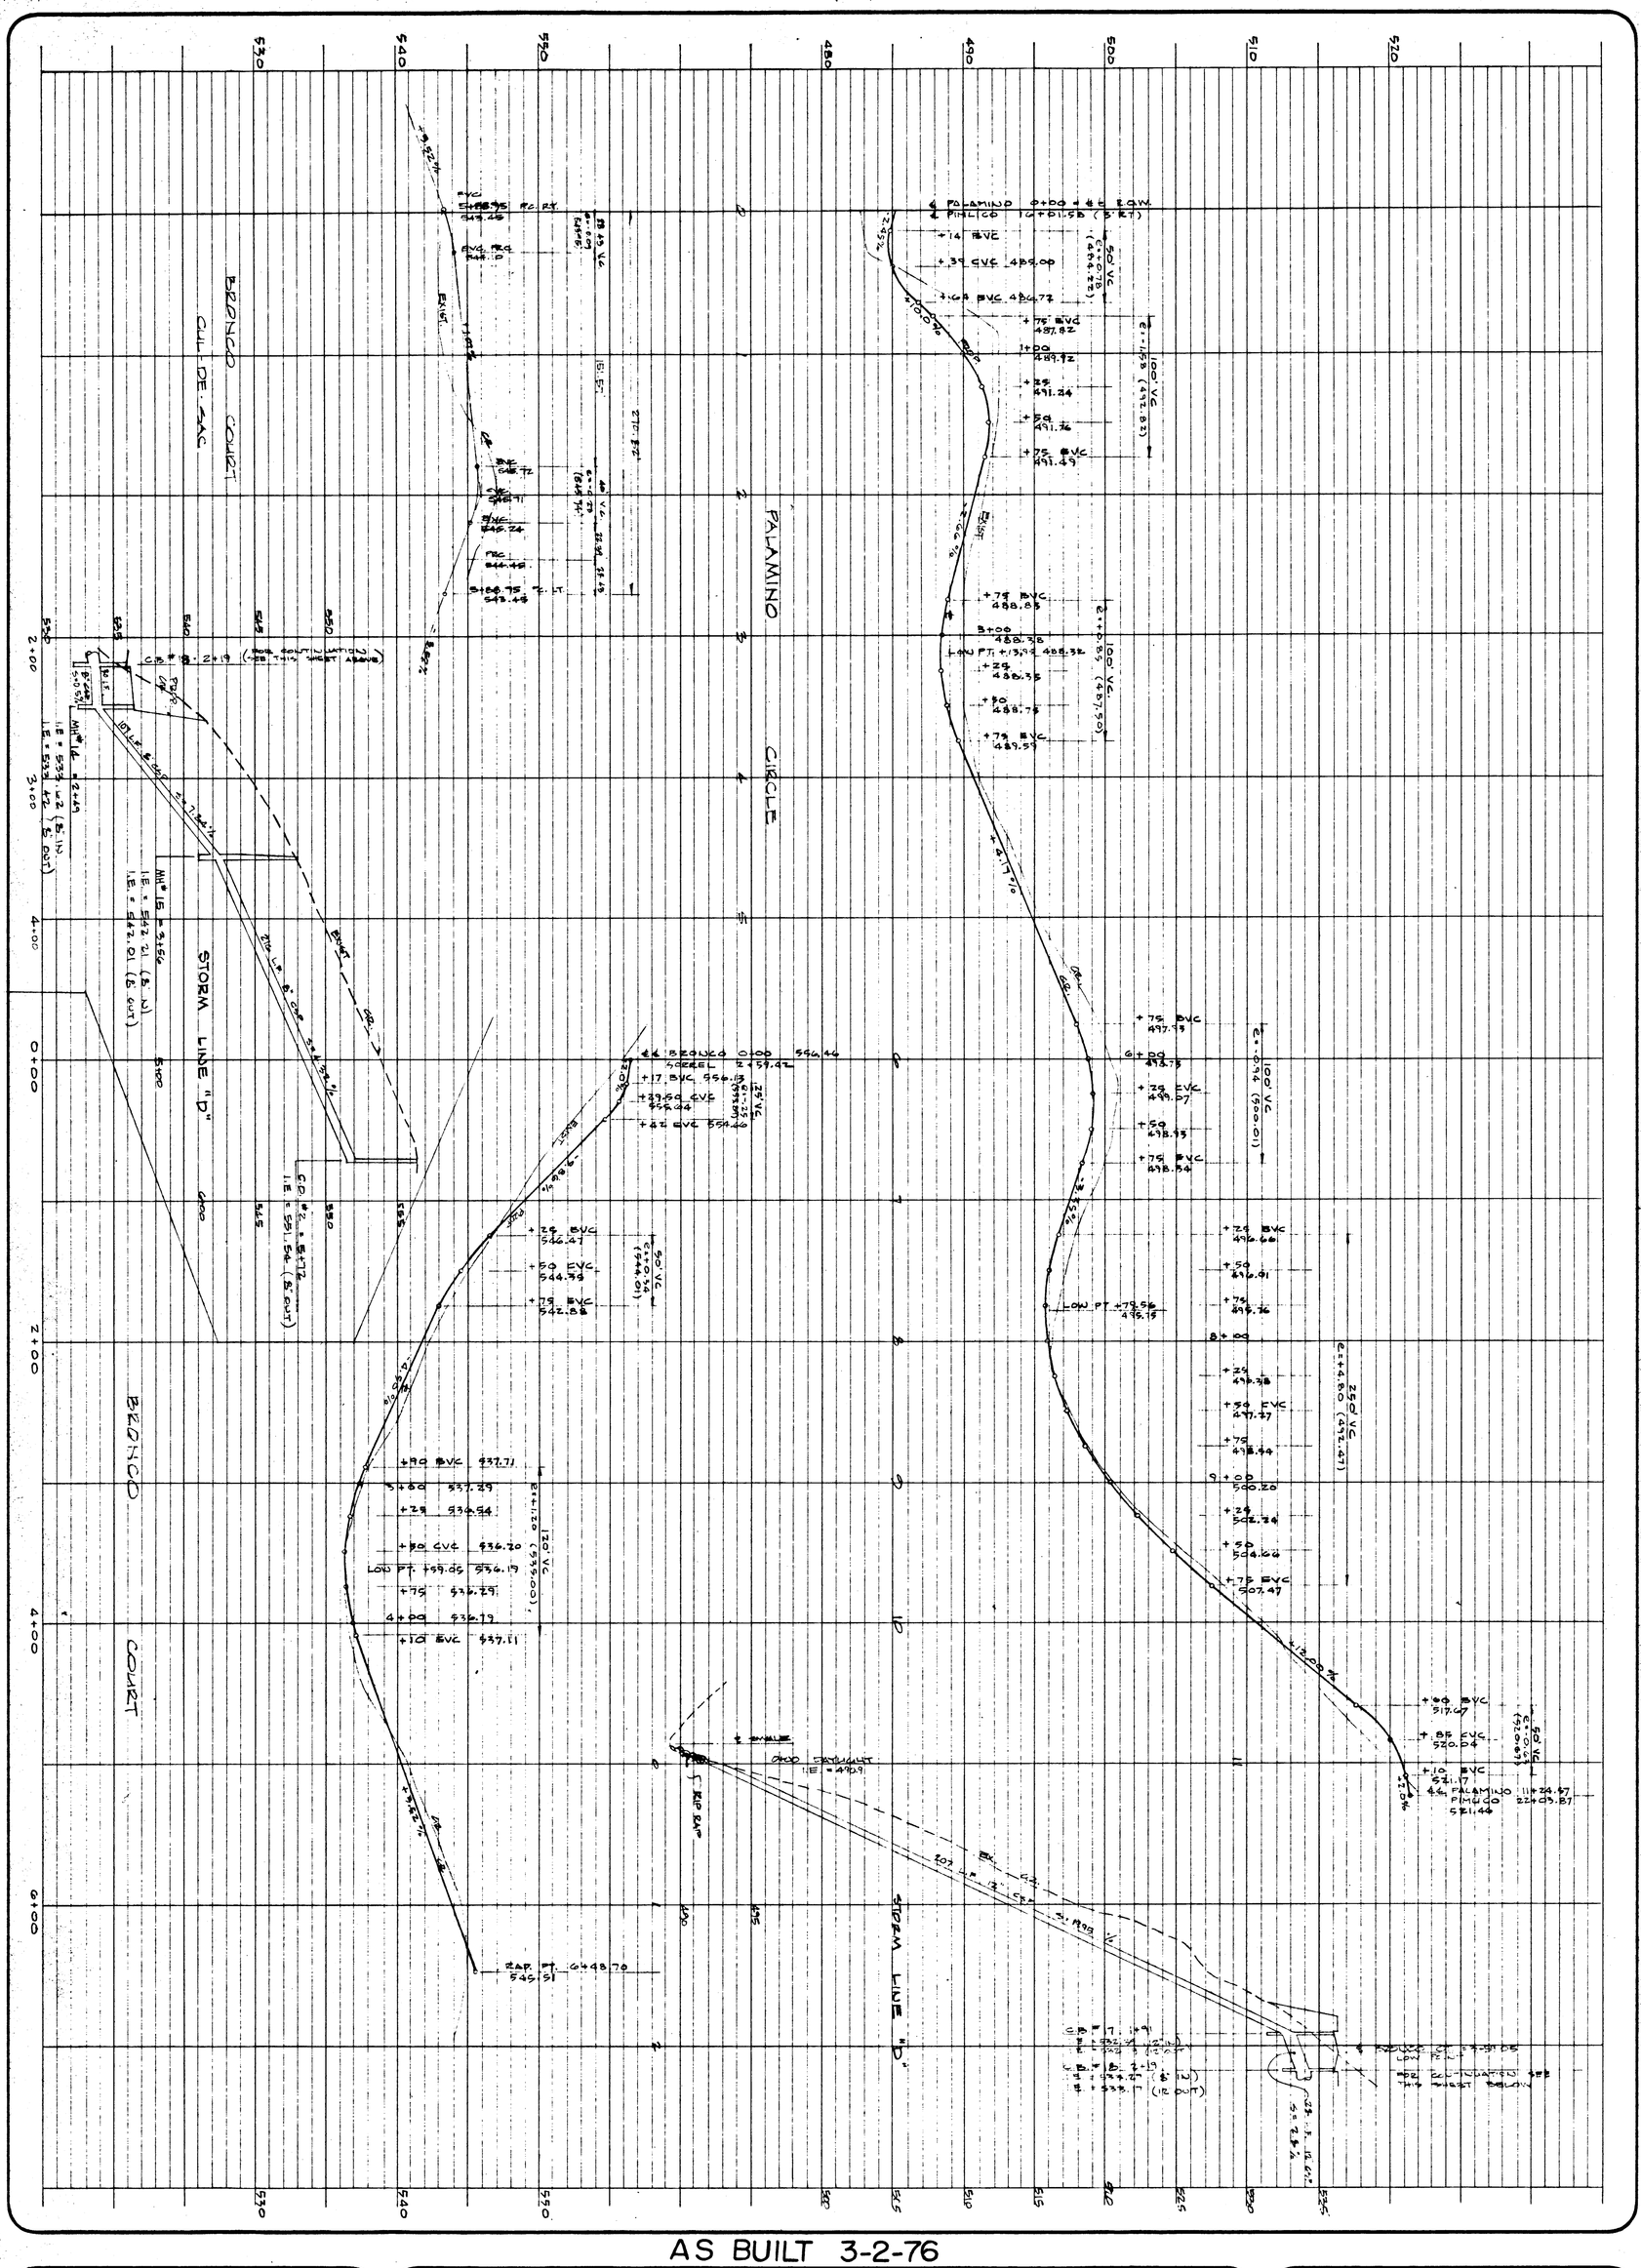
PALAMINO CIRCLE
BRONCO COURT
CUL-DE-SAC
STORM LINE "D"
BRONCO COURT
STORM LINE "D"
PALAMINO 0+00 = 6+61.56 EQU
PI=L.CO 14+61.56 (5' RT)
LOW PT +75.56 496.19
LOW PT +59.05 536.19
LOW PT +13.96 488.32
LOW PT +59.47 554.13
EAP. PT. 0+48.70 545.91
EAP. PT. 0+48.70 545.91
100' V.C. (497.82)
100' V.C. (496.01)
100' V.C. (496.01)
100' V.C. (496.01)
100' V.C. (496.01)
250' V.C. (497.67)
250' V.C. (497.67)
50' V.C.
50' V.C.
50' V.C.

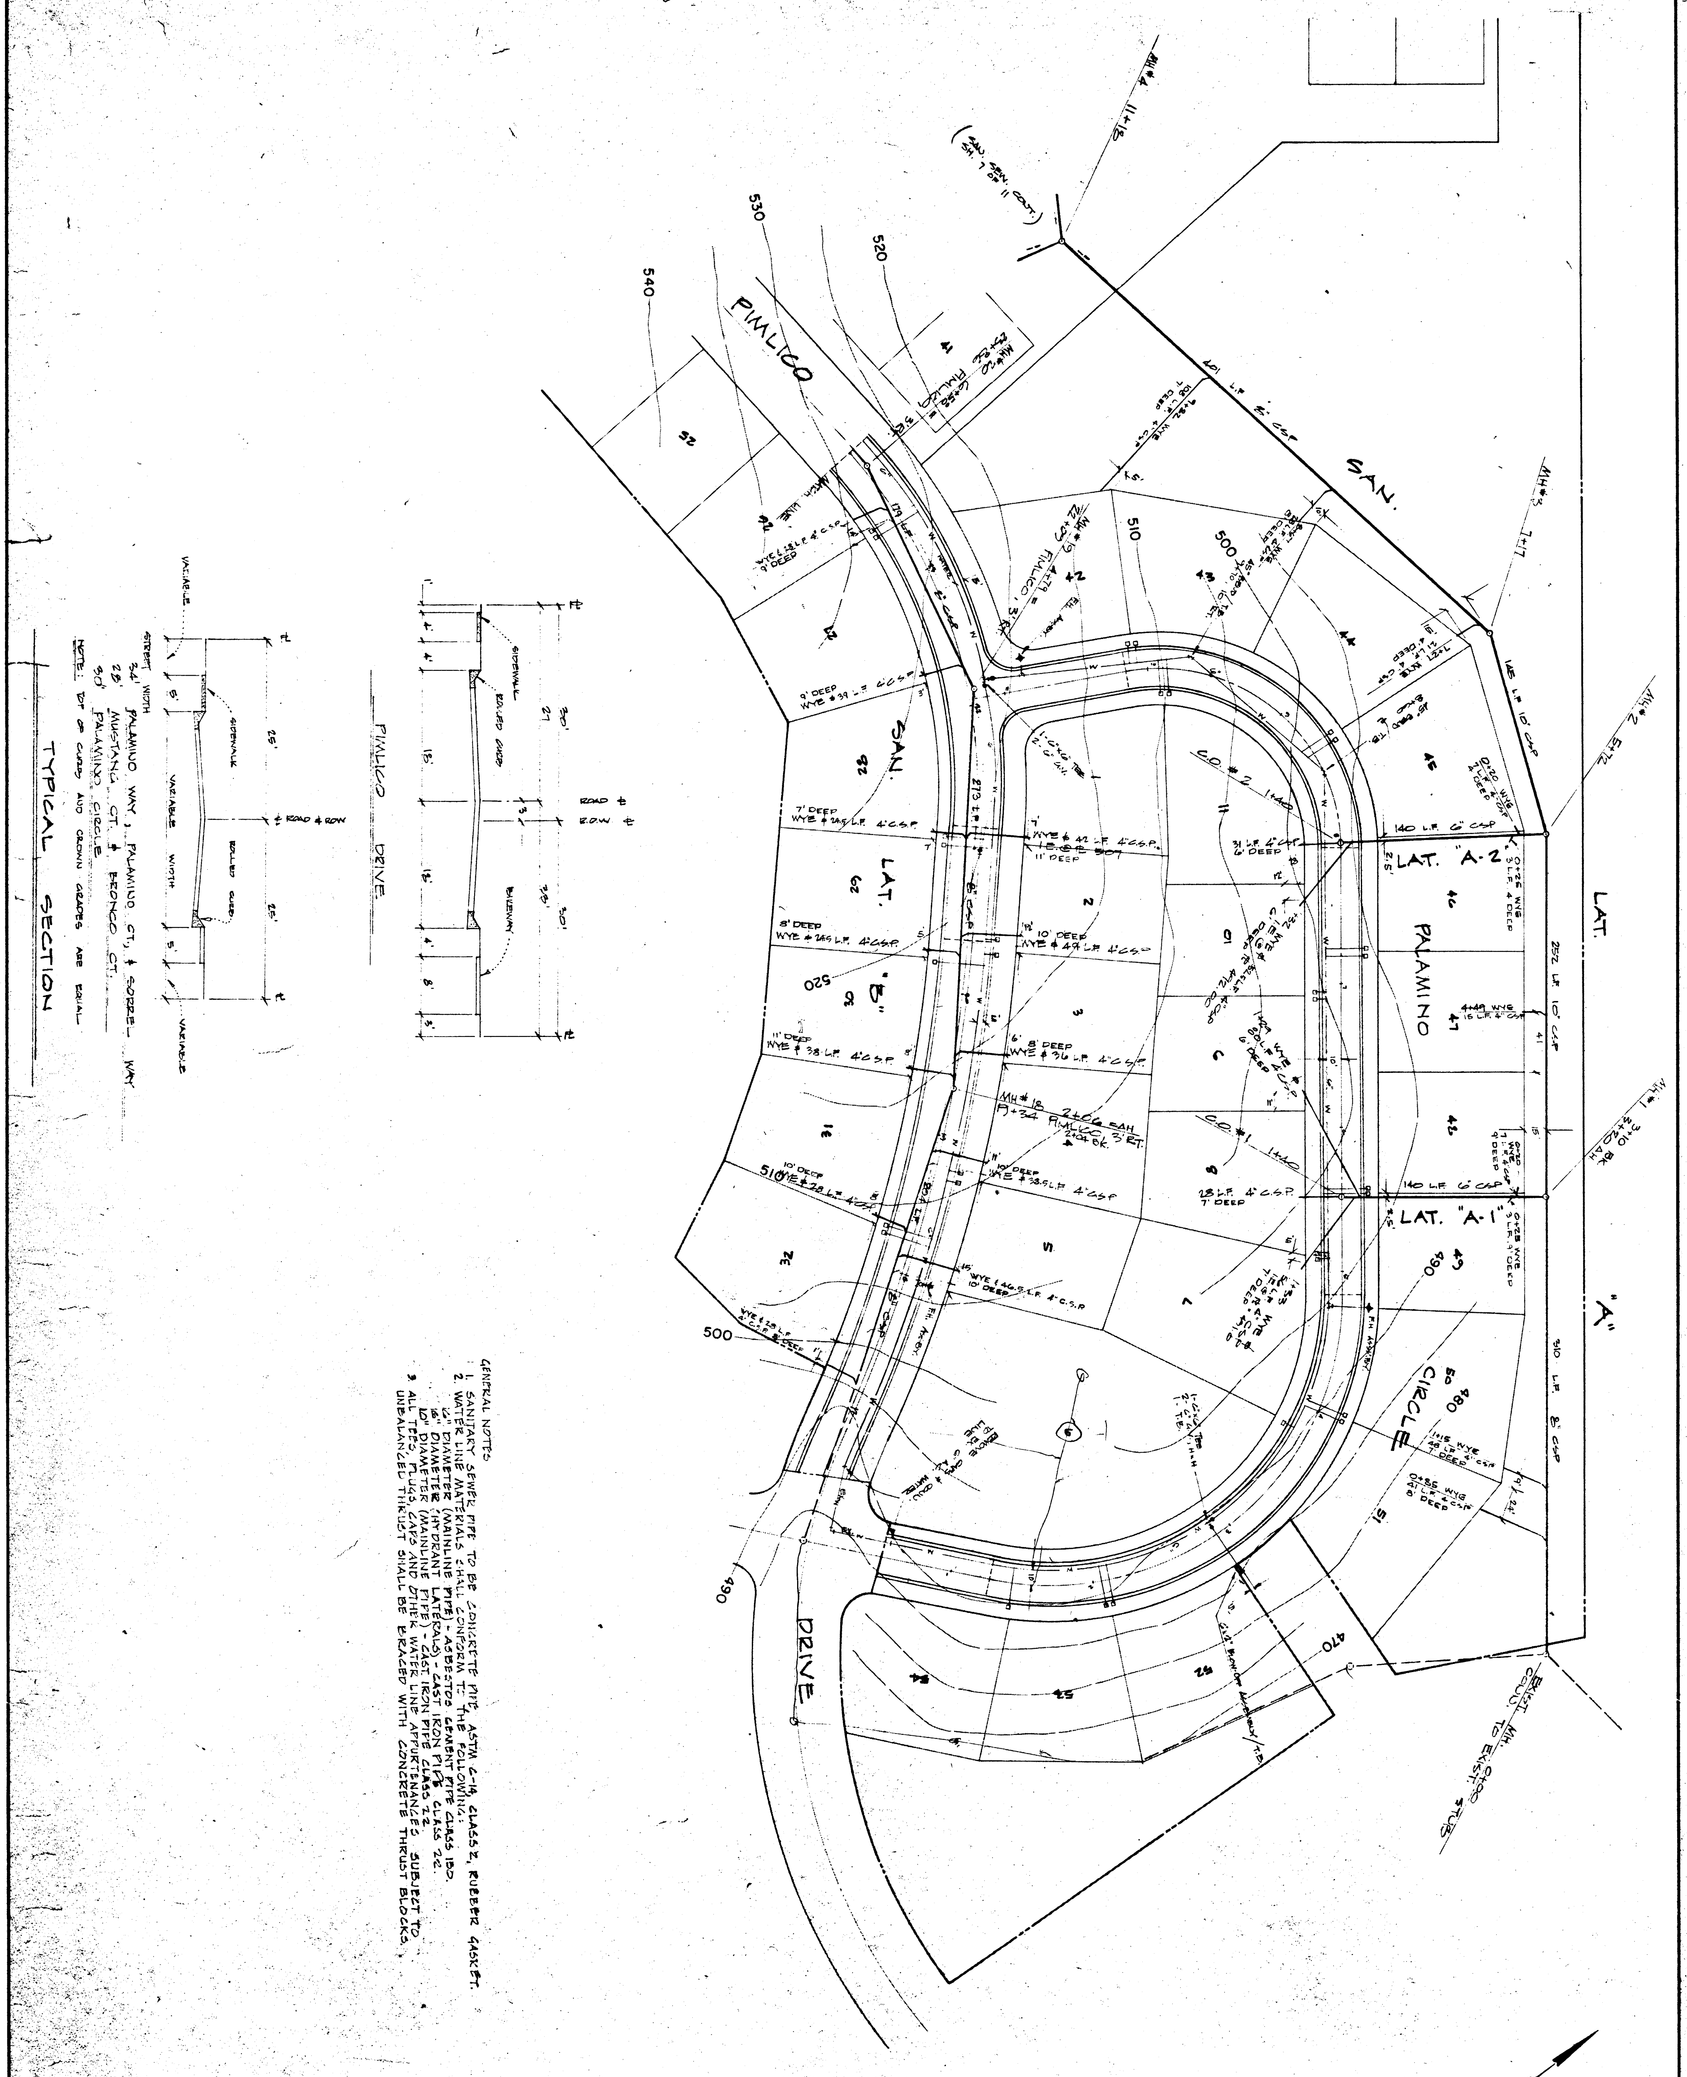

AS BUILT 3-2-76

SHEET NO. 6 of 11
DESIGN OCT 1974 BY EPG
DRAWN OCT 1974 BY JLM
CHECKED OCT 1974 BY DFB
FILE NO. 4-1100-5201

REGISTERED PROFESSIONAL ENGINEER OREGON JULY 17, 1979 ERROL F. GANN

HIDDEN SPRINGS RANCH NO. 2

west linn, oregon

Water & Sanitary Sewer Plan

EDWARDS INDUSTRIES, INC. beaverton, oregon

W&H WILSEY & HAM
Suite 4, Portland Center, 222 S.W. Harrison
Portland, Oregon 97201 503 227-0455

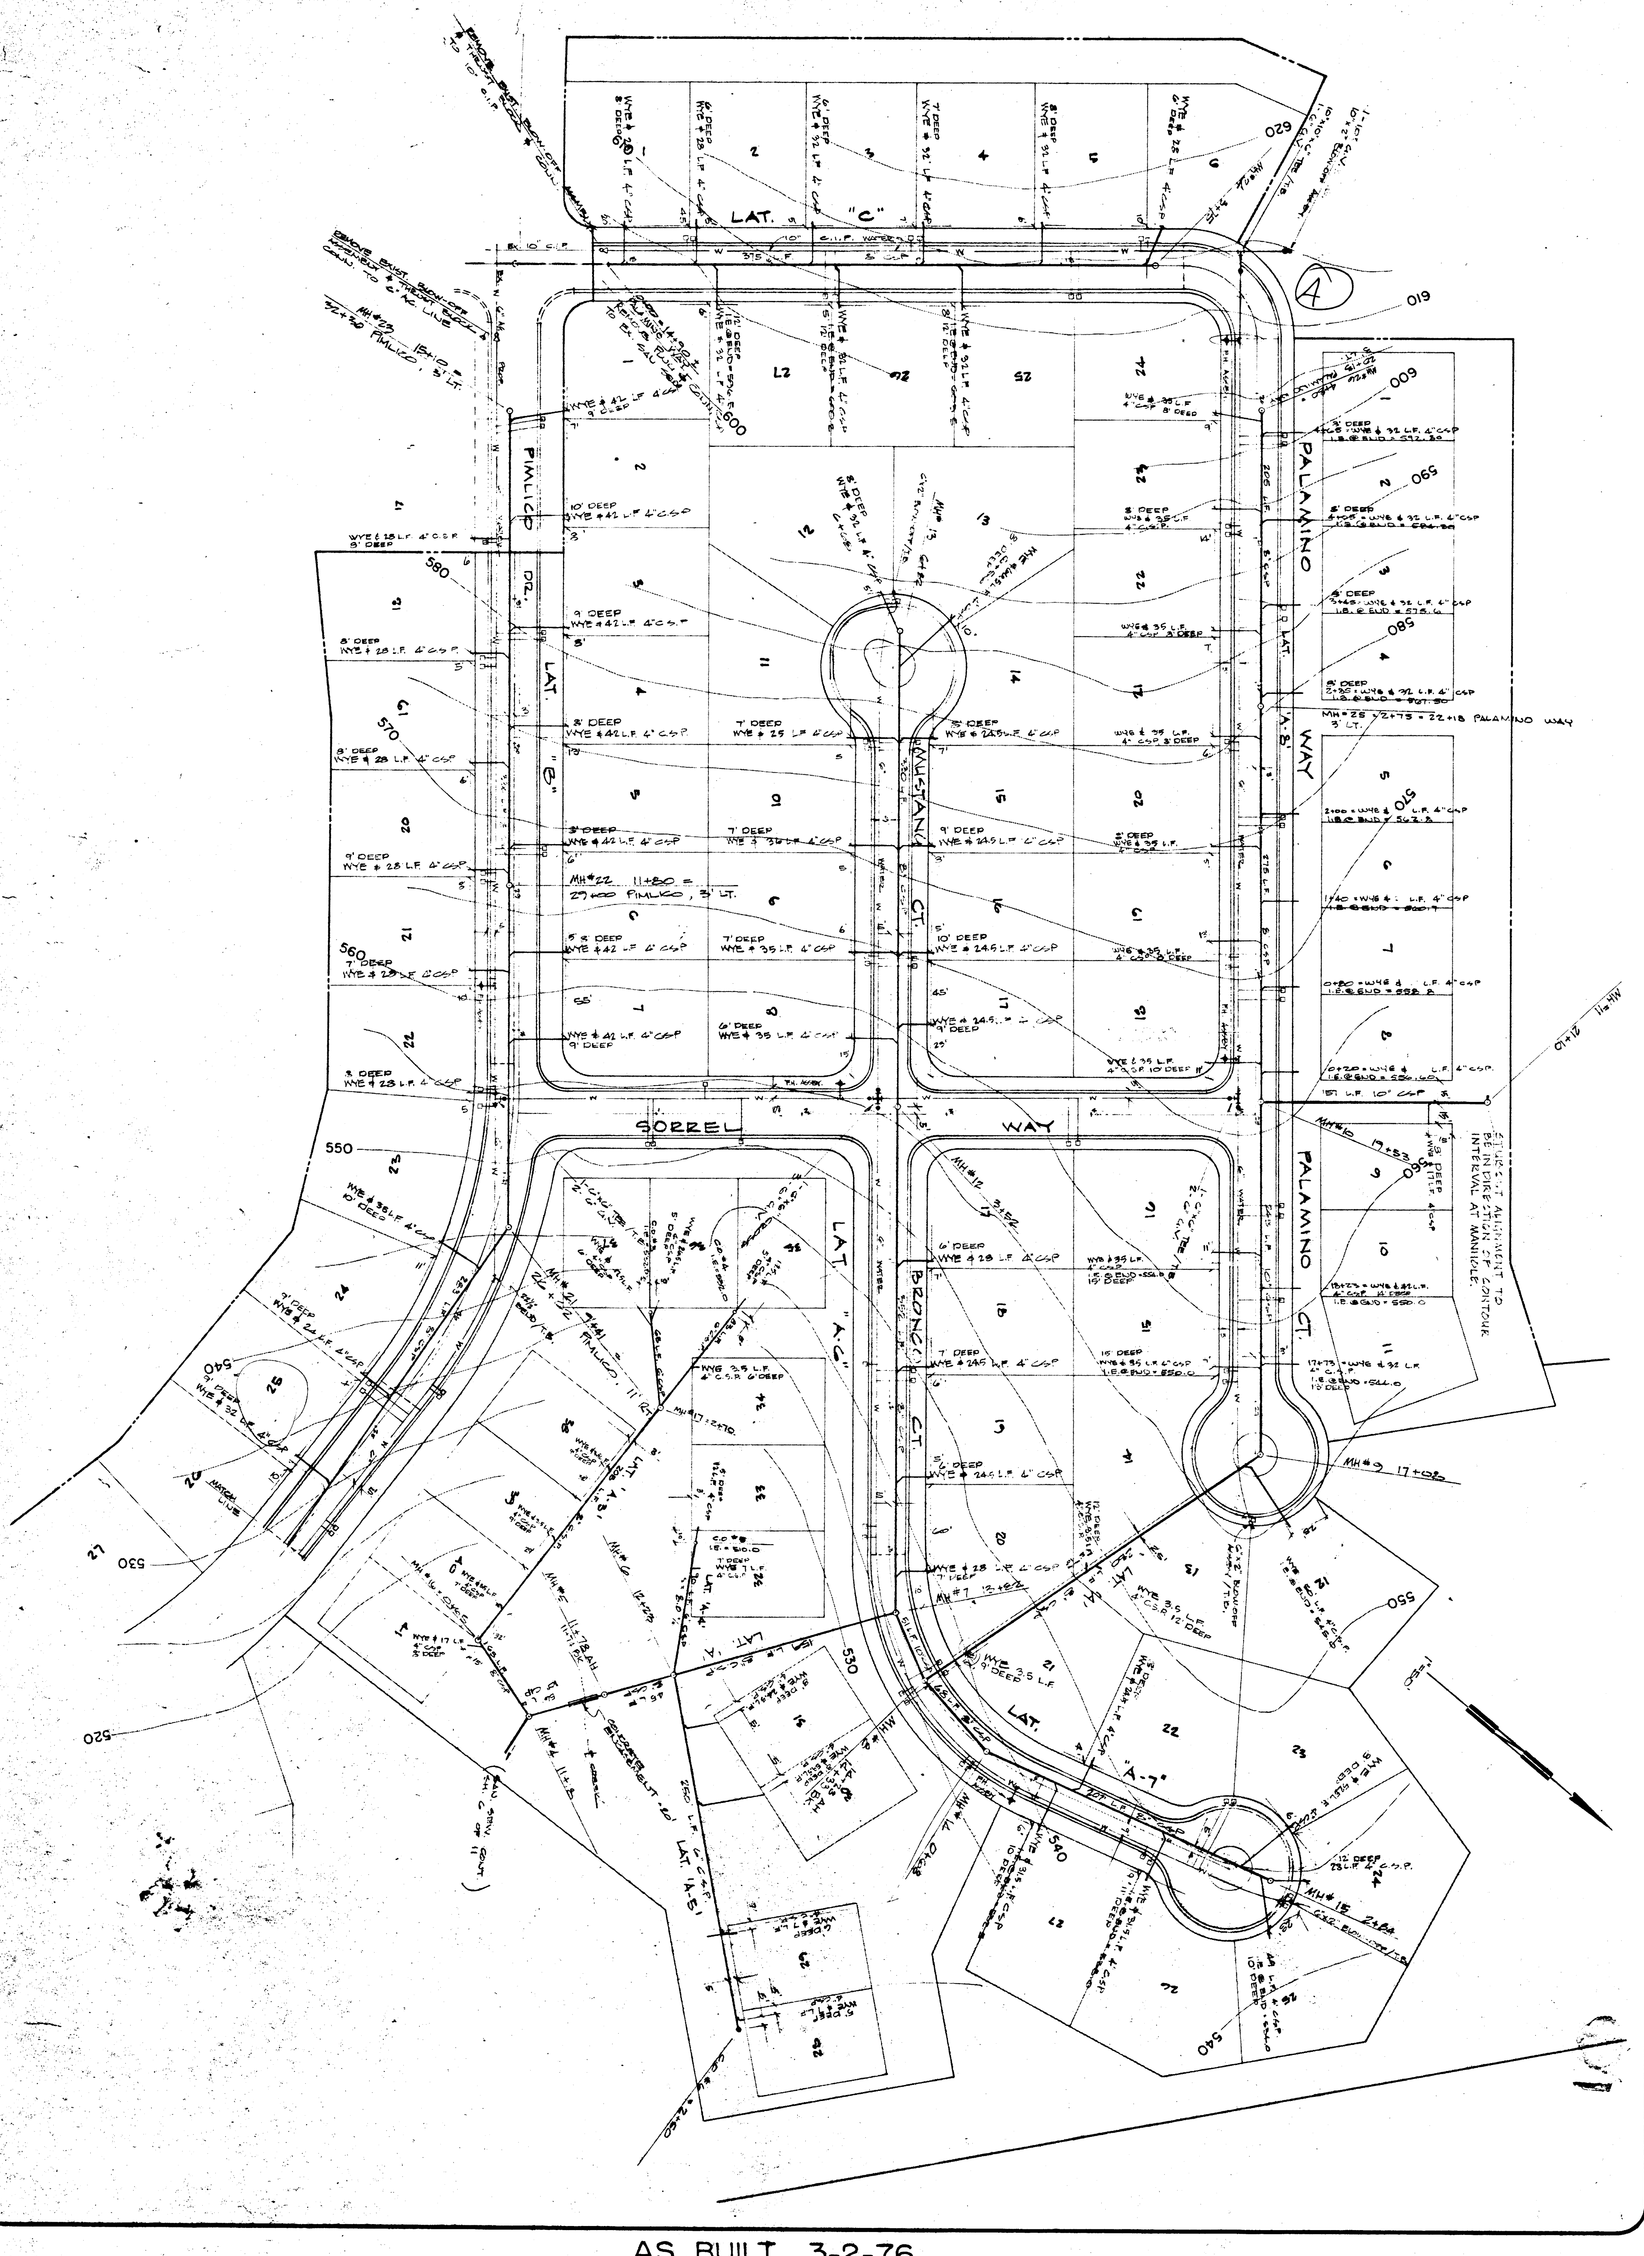
LAT. "C"
PIMLICO DR.
PALAMINO WAY
PALAMINO CT.
SORREL WAY
LAT. "A-5"
LAT. "A-6"
LAT. "A-7"
MUSTANG CT.
BRONCO CT.
MH #22 11+80 = 27.00 PIMLICO, 5' LT.
MH #21 22+00 = 37.41 PIMLICO, 11' LT.
MH #20 17+75 = 22.18 PALAMINO WAY 5' LT.
MH #19 17+82 = 27.00 PALAMINO WAY 5' LT.
MH #15 21+82
MH #9 17+08
MH #7 12+62
MH #6 12+29
MH #5 11+78
MH #4 11+58
MH #3 11+38
MH #2 11+18
MH #1 10+98
MH #12 13+52
MH #10 13+22
MH #11 17+75
MH #15 21+82
EXISTING SANITARY SEWER TO BE CONNECTED TO & NE LINE

LAT. A-3

MH#4 = 0+00 = 11+18
LAT. 'A'
I.E. = 485.18 (8" IN)
I.E. = 484.98 (10" IN)
I.E. = 484.78 (8" OUT)

MH#4 0+65
I.E. = 500.20 (8" IN)
I.E. = 500.00 (8 OUT)

MH#3 2+70
I.E. = 515.06 (6" IN)
I.E. = 515.06 (6" IN)
I.E. = 514.86 (8" OUT)

LAT. A-1

MH#1 = 0+00 LAT. A-1 =
0+00 LAT. A
I.E. = 468.50 (6" LAT. A-1 IN)
I.E. = 468.50 (10" IN)
I.E. = 468.01 (8" OUT)

C.O. #1 = 1+40 =
I.E. = 483.95 (6" OUT)

LAT. A-2

MH#2 = 0+00 LAT. A-2 =
5+72 LAT. A
I.E. = 471.22 (10" IN)
I.E. = 471.52 (6" LAT. A-2 IN)
I.E. = 471.02 (10" OUT)

C.O. #2 = 1+40 =
I.E. = 480.00 (6" OUT)

LAT. A

MH#1 = 3+20 AH
0+00 LAT. A-1
I.E. = 468.50 (6" LAT. A-1 IN)
I.E. = 468.50 (10" IN)
I.E. = 468.01 (8" OUT)

MH#2 = 5+72 =
0+00 LAT. A-2
I.E. = 471.52 (6" LAT. A-2 IN)
I.E. = 471.22 (10" IN)
I.E. = 471.02 (10" OUT)

MH#3 = 7+17
I.E. = 474.03 (8" IN)
I.E. = 473.83 (10" OUT)

MH#4 = 11+18
I.E. = 485.16 (8" IN - LAT. 'A-3')
I.E. = 484.98 (10" IN)
I.E. = 484.78 (8" OUT)

MH#5 = 11+78 AH
INSIDE DROP MH
I.E. = 481.53 (8" IN) AH
I.E. = 485.53 (10" OUT) PK

MH#6 = 12+23 = 0+00 LAT. 'A-4' & A-5'
I.E. = 500.2 OUT SIDE DROP LAT. 'A' 8"
I.E. = 496.8 (6" IN LAT. 'A-4') 4510
I.E. = 496.6 (6" IN LAT. A-5)
I.E. = 496.4 (8" OUT)

MH#7 = 13+82 =
0+00 LAT. A-6
I.E. = 530.65 (8" LAT. 'A'-6 IN)
I.E. = 530.69 (10" IN)
I.E. = 530.49 (8" OUT)

MH#8 = 14+28 AH
MH#8 = 14+32 PK
I.E. = 531.35 (8" IN)
I.E. = 531.35 (8" IN LAT. 'A'-1)
I.E. = 531.15 (10" OUT)

MH#9 = 17+08
I.E. = 540.17 (10" IN)
I.E. = 539.97 (8" OUT)

MH#10 = 19+82 = 0+00
LAT. A-B
I.E. = 554.50 (8" IN - OUTSIDE DROP)
I.E. = 542.04 (OUTSIDE DROP)
I.E. = 541.84 (10" IN)
I.E. = 541.64 (10" OUT)

MH#11 = 21+10
I.E. = 542.78 (10" STUB IN)
I.E. = 542.78 (10" OUT)

EX. M.H. = 0+00
I.E. = 434.13 (8" IN)
(VERIFY)

EXIST.
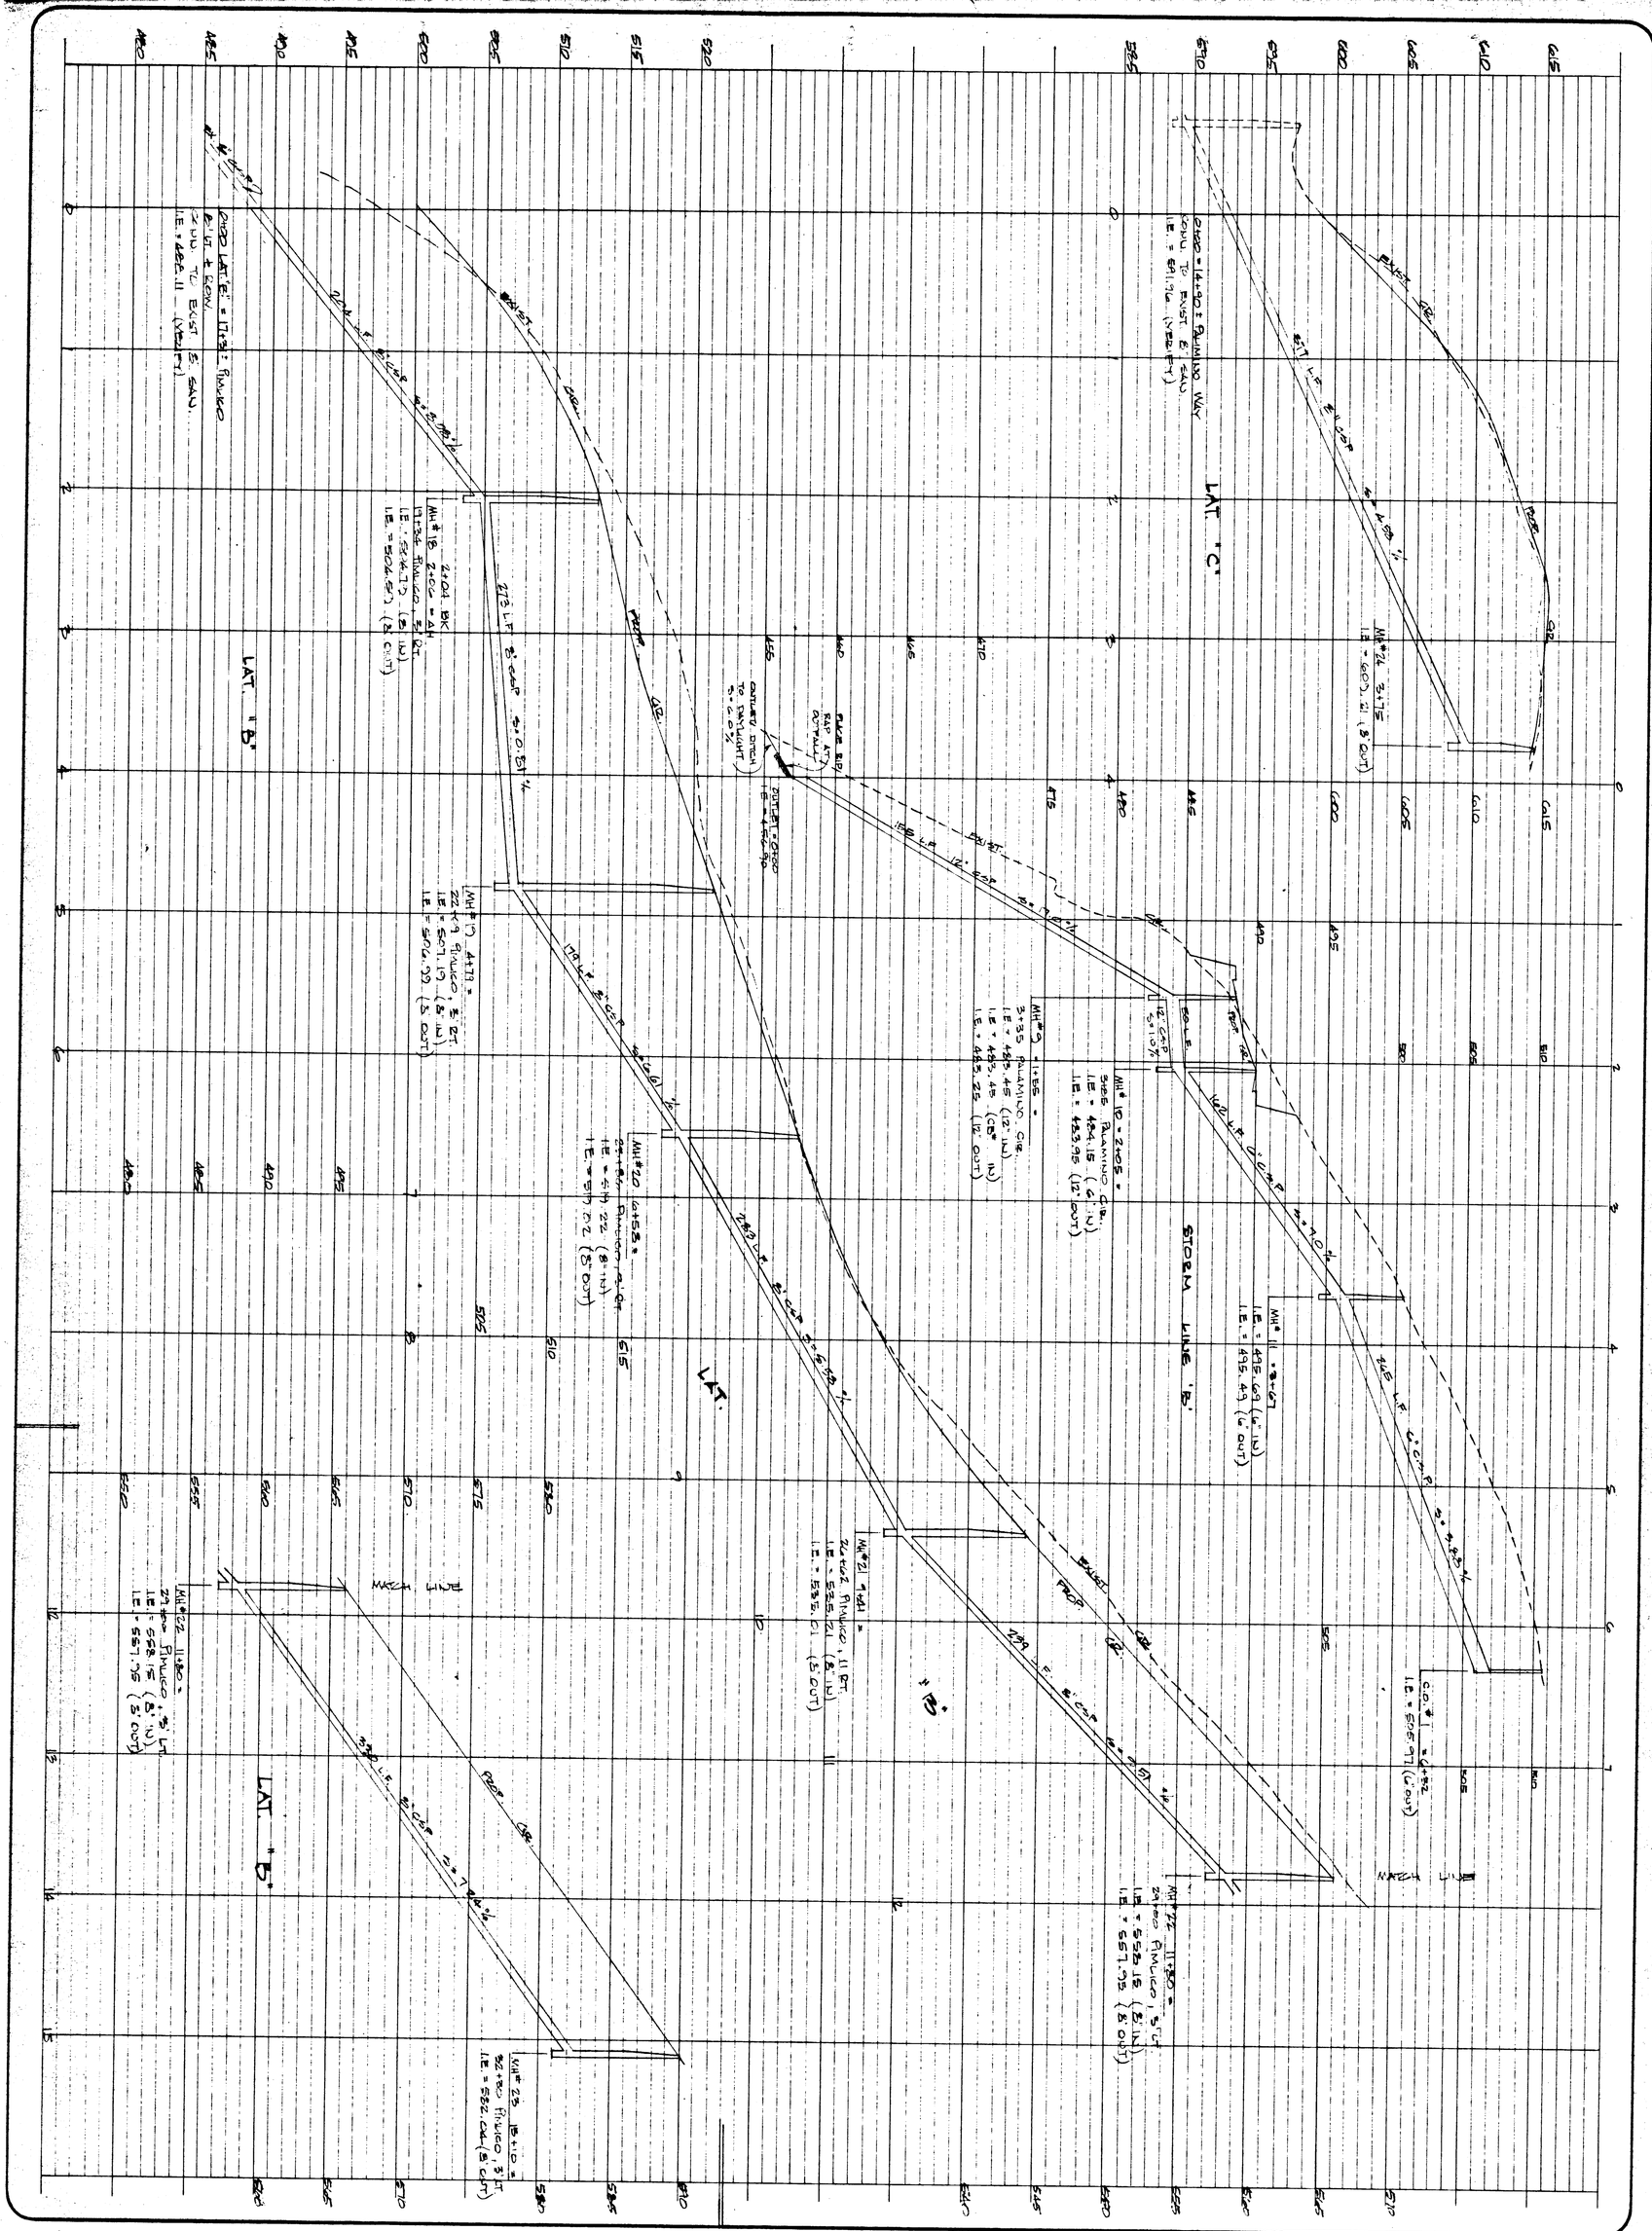

AS BUILT 3-2-76

SHEET NO. **9 of 11**

DESIGN OCT 1974 BY BPG
DRAWN OCT 1974 BY JLM
CHECKED OCT 1974 BY DPB
FILE NO. 4-1100-3201

REGISTERED PROFESSIONAL ENGINEER OREGON JULY 13, 1960 ERROL F. GANN

HIDDEN SPRINGS RANCH NO. 2

west linn, oregon

Storm & Sanitary Sewer Profile

EDWARDS INDUSTRIES, INC. beaverton, oregon

W&H WILSEY & HAM

Suite 4, Portland Center, 222 S.W. Harrison
Portland, Oregon 97201 503 227-0455

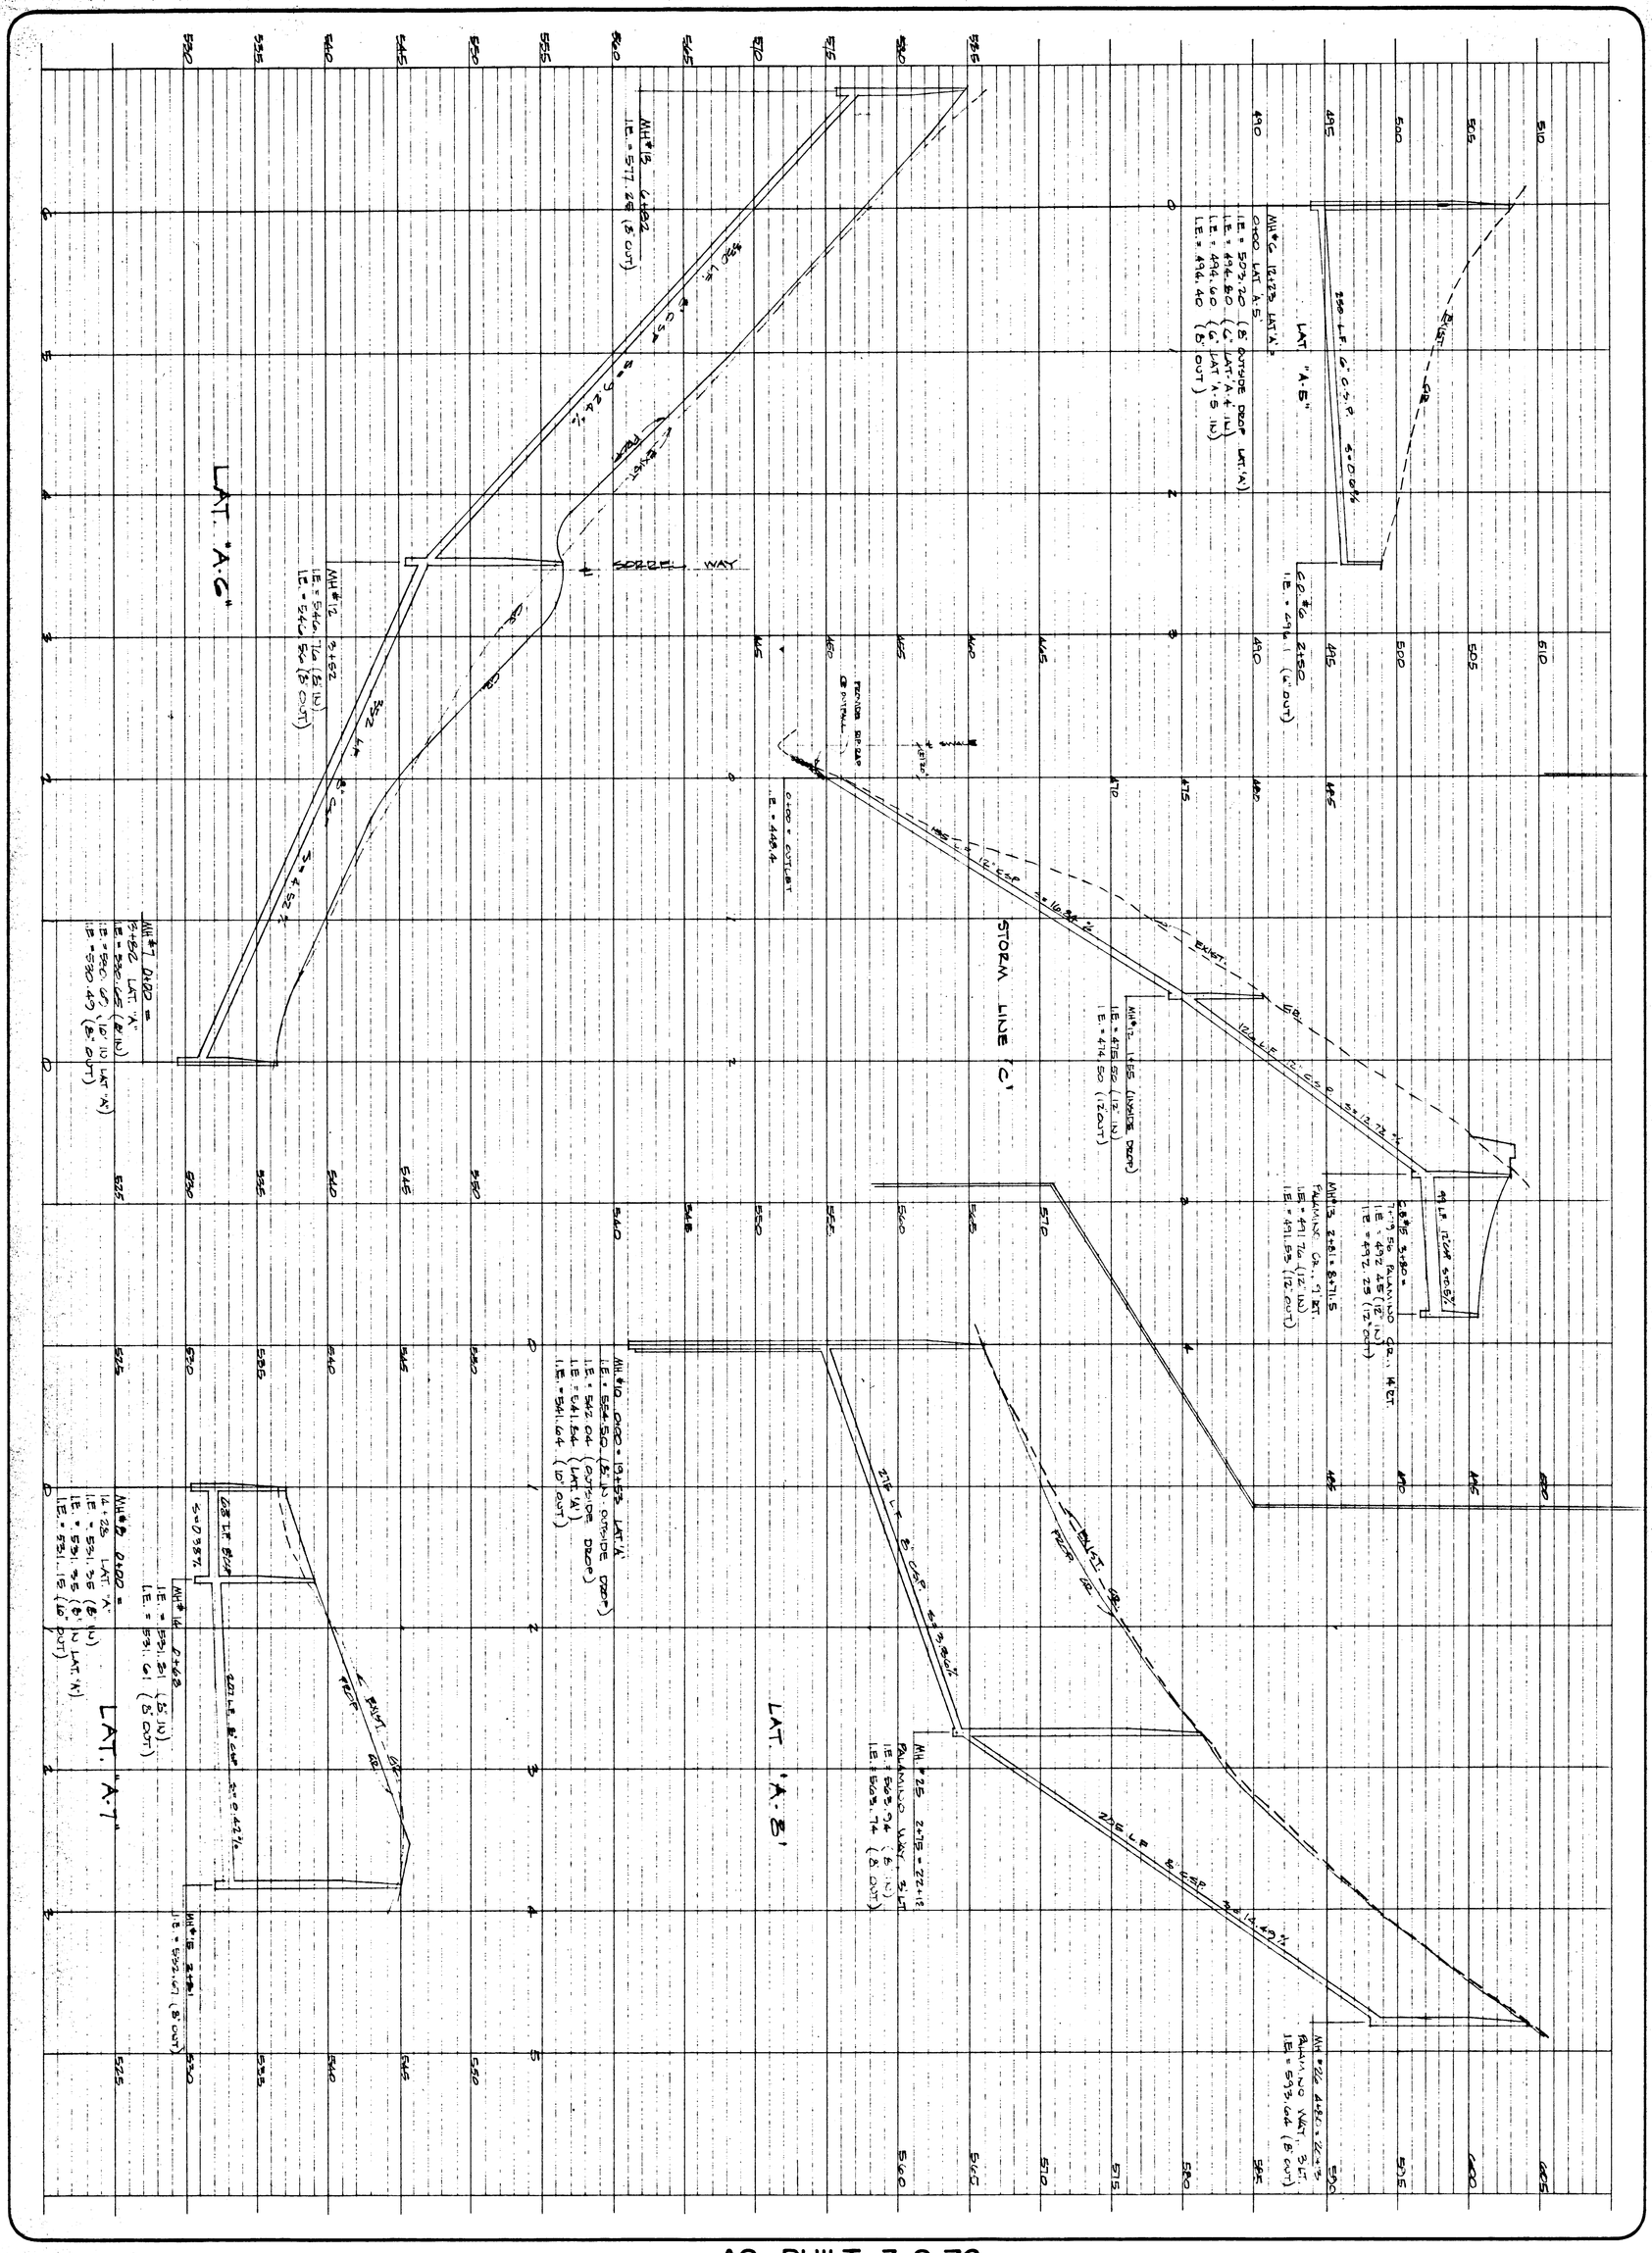

AS BUILT 3-2-76

SHEET NO **10 of 11**

DESIGN OCT 1974 BY FPG
DRAWN OCT 1974 BY JLM
CHECKED OCT 1974 BY DPB
FILE NO. #1100-320

REGISTERED PROFESSIONAL ENGINEER — OREGON — JULY 11, 1969 — ERROL F. GANN

HIDDEN SPRINGS RANCH NO. 2

west linn, oregon

Storm & Sanitary Sewer Profile

EDWARDS INDUSTRIES, INC. beaverton, oregon

WILSEY & HAM

Suite 4, Portland Center, 222 S.W. Harrison
Portland, Oregon 97201 503 227-0455

GENERAL PURPOSE CURB

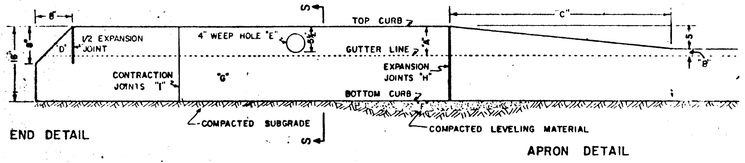

END DETAIL

APRON DETAIL

PLAN

SCALE: 1/16" = 1'

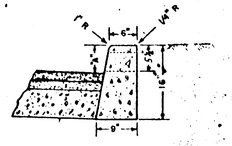

SECTION S-S

NOTES:
- "A" CURB EXPOSER, STANDARD 6", VARY AS SHOWN ON TYPICAL SECTIONS, OR AS DIRECTED.
- "B" CURB EXPOSER AT DRIVEWAY, STANDARD 1", OR AS DIRECTED.
- "C" DRIVEWAY APRON, STANDARD RESIDENTIAL 4', COMMERCIAL 8', OR AS DIRECTED.
- "D" END CURB SECTION, TO BE REMOVED UPON EXTENSION OF CURB.
- "E" WEEP HOLE, 4" PLASTIC DRAIN PIPE OR APPROVED EQUIVILANT, LOCATED AS INDICATED ON THE PLANS OR AS DIRECTED
- "F" LEVELING COURSE, 3/4" X 0" OR 1/2"X 0" CRUSHED ROCK.
- "G" PORTLAND CEMENT CONCRETE, "CLASS "A" 3300 PSI.
- "H" EXPANSION JOINTS, MAX 45' AND LOCATIONS AS DIRECTED
- "I" CONTRACTION JOINTS, MAX. 15' AND LOCATIONS AS DIRECTED.

SPECIFICATIONS FOR CONCRETE AND MISC. MATERIALS USED IN CURB CONSTRUCTION, SHALL CONFORM TO THE CURRENT O.S.H.D. "STANDARD SPECIFICATIONS FOR HIGHWAY CONSTRUCTION".

CLACKAMAS COUNTY
DEPARTMENT OF PUBLIC WORK
STANDARD
GENERAL PURPOSE CUR
TYPE "C"
JOHN C McINTYRE
DIRECTOR OF PUBLIC WORKS

DRG. S 200

TYPES G, G-1, G-2

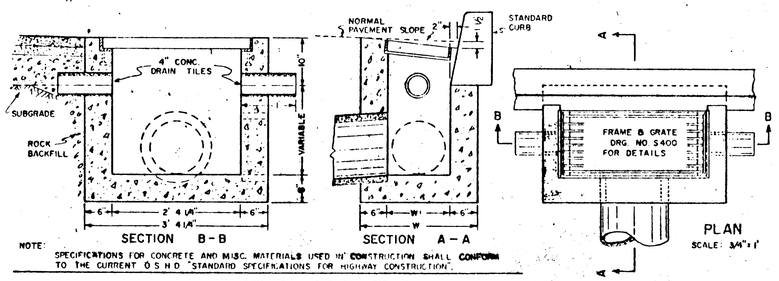

NOTE: SPECIFICATIONS FOR CONCRETE AND MISC. MATERIALS USED IN CONSTRUCTION SHALL CONFORM TO THE CURRENT O.S.H.D. "STANDARD SPECIFICATIONS FOR HIGHWAY CONSTRUCTION".

TYPES GB, GB-1, GB-2

(FOR DETAILS NOT SHOWN SEE ABOVE)

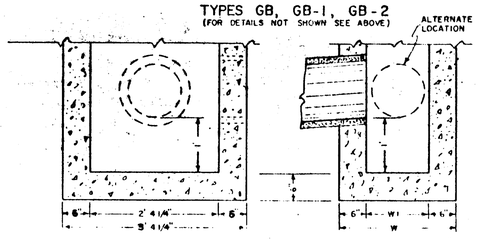

INLET TYPE	W	W1
GB-1	2' 8 7/8"	1' 8 7/8"
GB-2	3' 5 3/8"	2' 3 3/8"

NOTE: A MAXIMUM DEVIATION FROM PLAN DIMENSIONS OF ONE INCH, AT THE INLET FLOOR, SHALL BE ALLOWED FOR TAPERING OF FORMS USED IN CONSTRUCTION OF CONCRETE INLETS.

CLACKAMAS COUNTY
DEPARTMENT OF PUBLIC WORKS
STANDARD
CONCRETE INLET
DETAILS
JOHN C McINTYRE
DIRECTOR OF PUBLIC WORKS

DRG. S 410

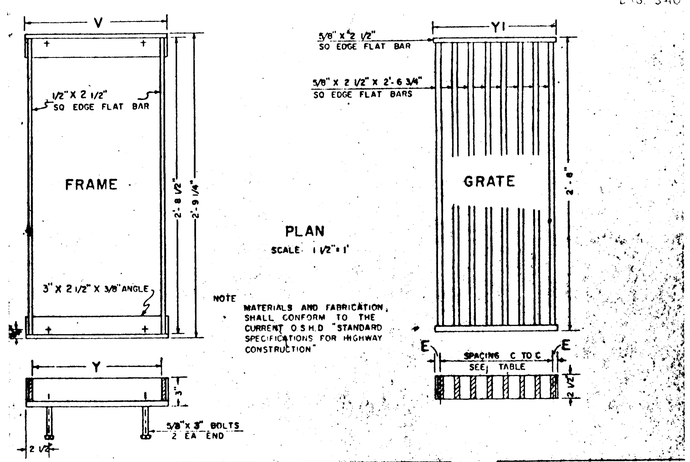

NOTE
MATERIALS AND FABRICATION, SHALL CONFORM TO THE CURRENT O.S.H.D. "STANDARD SPECIFICATIONS FOR HIGHWAY CONSTRUCTION"

INLET TYPE	V	Y	Y1	E	SPACING C TO C	NO OF BARS	REMARKS
G, GB, CG	1'-3 1/4"	1'-1 7/8"	1'-1 1/2"	5/8"	1 3/4"	8	
G-1, GB-1, CG-1	1'-10 1/4"	1'-8 7/8"	1'-8 1/2"	5/8"	1 3/4"	12	
G-2, GB-2, CG-2	2'-4 3/4"	2'-3 3/8"	2'-3"	#8"	1 3/4"	8	2 RATES
G-2M, D	2'-4 3/4"	2'-3 3/8"	2'-3"	1 1/2"	3"	9	

CLACKAMAS COUNTY
DEPARTMENT OF PUBLIC WORK
STANDARD
FRAME & GRATE
DETAILS
JOHN C McINTYRE
DIRECTOR OF PUBLIC WORKS

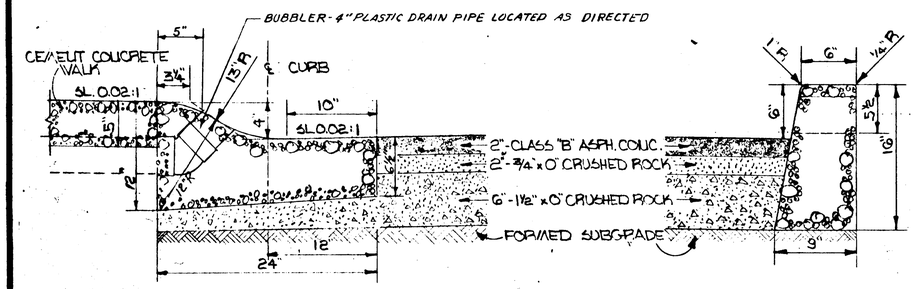

ROLLED CURB

PAVEMENT SECTION

VERTICAL CURB

NOTE: SPECIFICATIONS FOR CONCRETE CURBS, ASPHALTIC CONCRETE, CRUSHED ROCK, AND SUBGRADE CONSTRUCTION SHALL CONFORM TO THE CURRENT O.S.H.D. "STANDARD SPECIFICATION FOR HIGHWAY CONSTRUCTION."

NOTE: WHERE PARKWAY EXISTS BETWEEN SIDEWALK & CURB, PLACE HYDRANT 2 FEET BACK OF CURB.

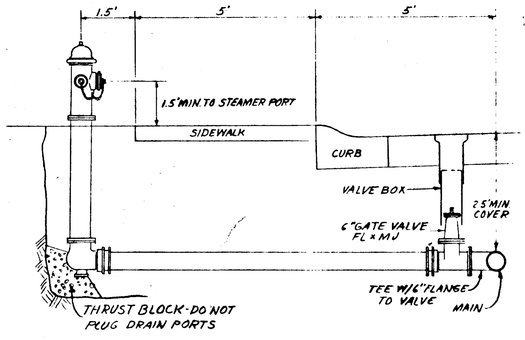

STANDARD FIRE HYDRANT

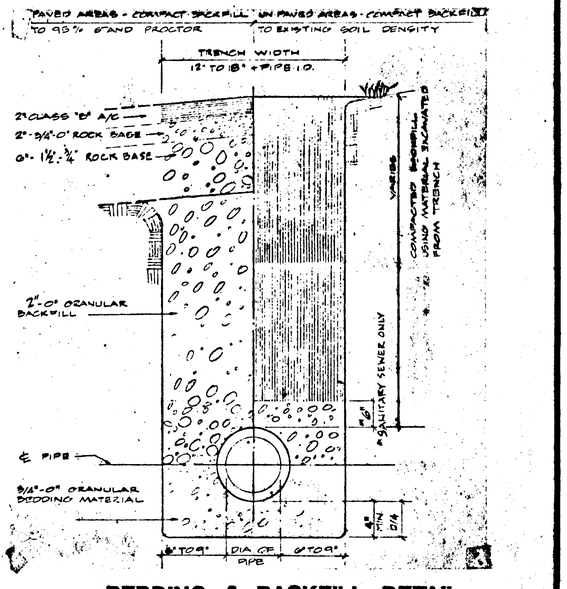

BEDDING & BACKFILL DETAIL
STORM & SANITARY SEWERS

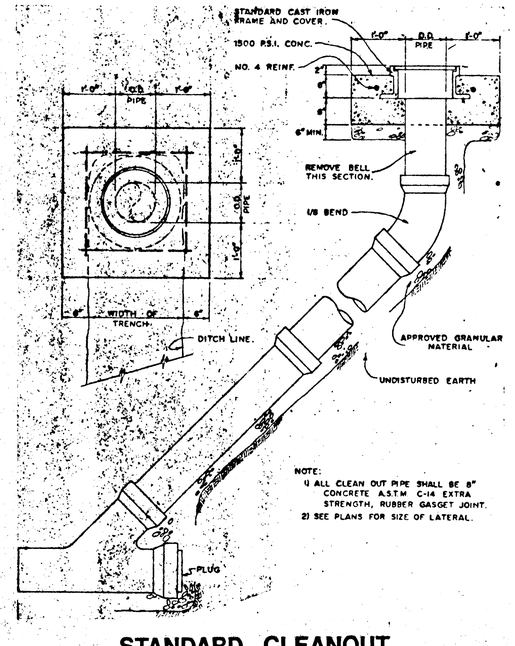

NOTE:
1) ALL CLEAN OUT PIPE SHALL BE 8" CONCRETE A.S.T.M C-14 EXTRA STRENGTH, RUBBER GASGET JOINT.
2) SEE PLANS FOR SIZE OF LATERAL.

STANDARD CLEANOUT

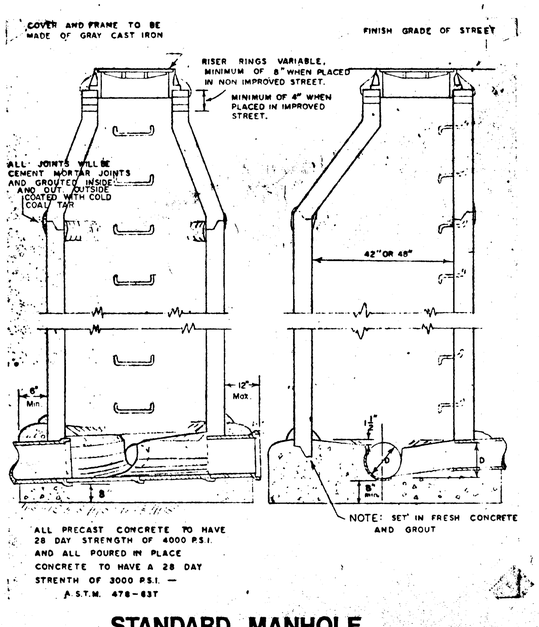

ALL PRECAST CONCRETE TO HAVE 28 DAY STRENGTH OF 4000 P.S.I. AND ALL POURED IN PLACE CONCRETE TO HAVE A 28 DAY STRENTH OF 3000 P.S.I. — A.S.T.M. 478-63T

STANDARD MANHOLE

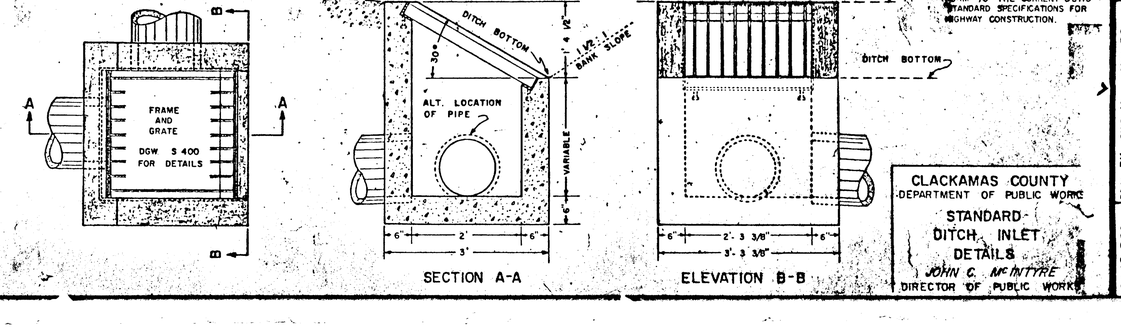

NOTE
SPECIFICATIONS FOR CONCRETE AND MISC MATERIALS USED IN CONSTRUCTION SHALL CONFORM TO THE CURRENT O.S.H.D. STANDARD SPECIFICATIONS FOR HIGHWAY CONSTRUCTION.

CLACKAMAS COUNTY
DEPARTMENT OF PUBLIC WORKS
STANDARD
DITCH INLET
DETAILS
JOHN C. McINTYRE
DIRECTOR OF PUBLIC WORKS

W&H WILSEY & HAM
Suite 4, Portland Center, 222 S.W. Harrison
Portland, Oregon 97201 503 227-0455

REGISTERED PROFESSIONAL ENGINEER OREGON FRANK E. GU

STANDARD DETAILS
HIDDEN SPRINGS RANCH DIVISION NO. 2
WEST LINN OREGON

JOB NO 083	DRN PK CHD JL	APP'D EG		
DATE 2-76	REVISIONS		BY	DATE
SHEET 11				