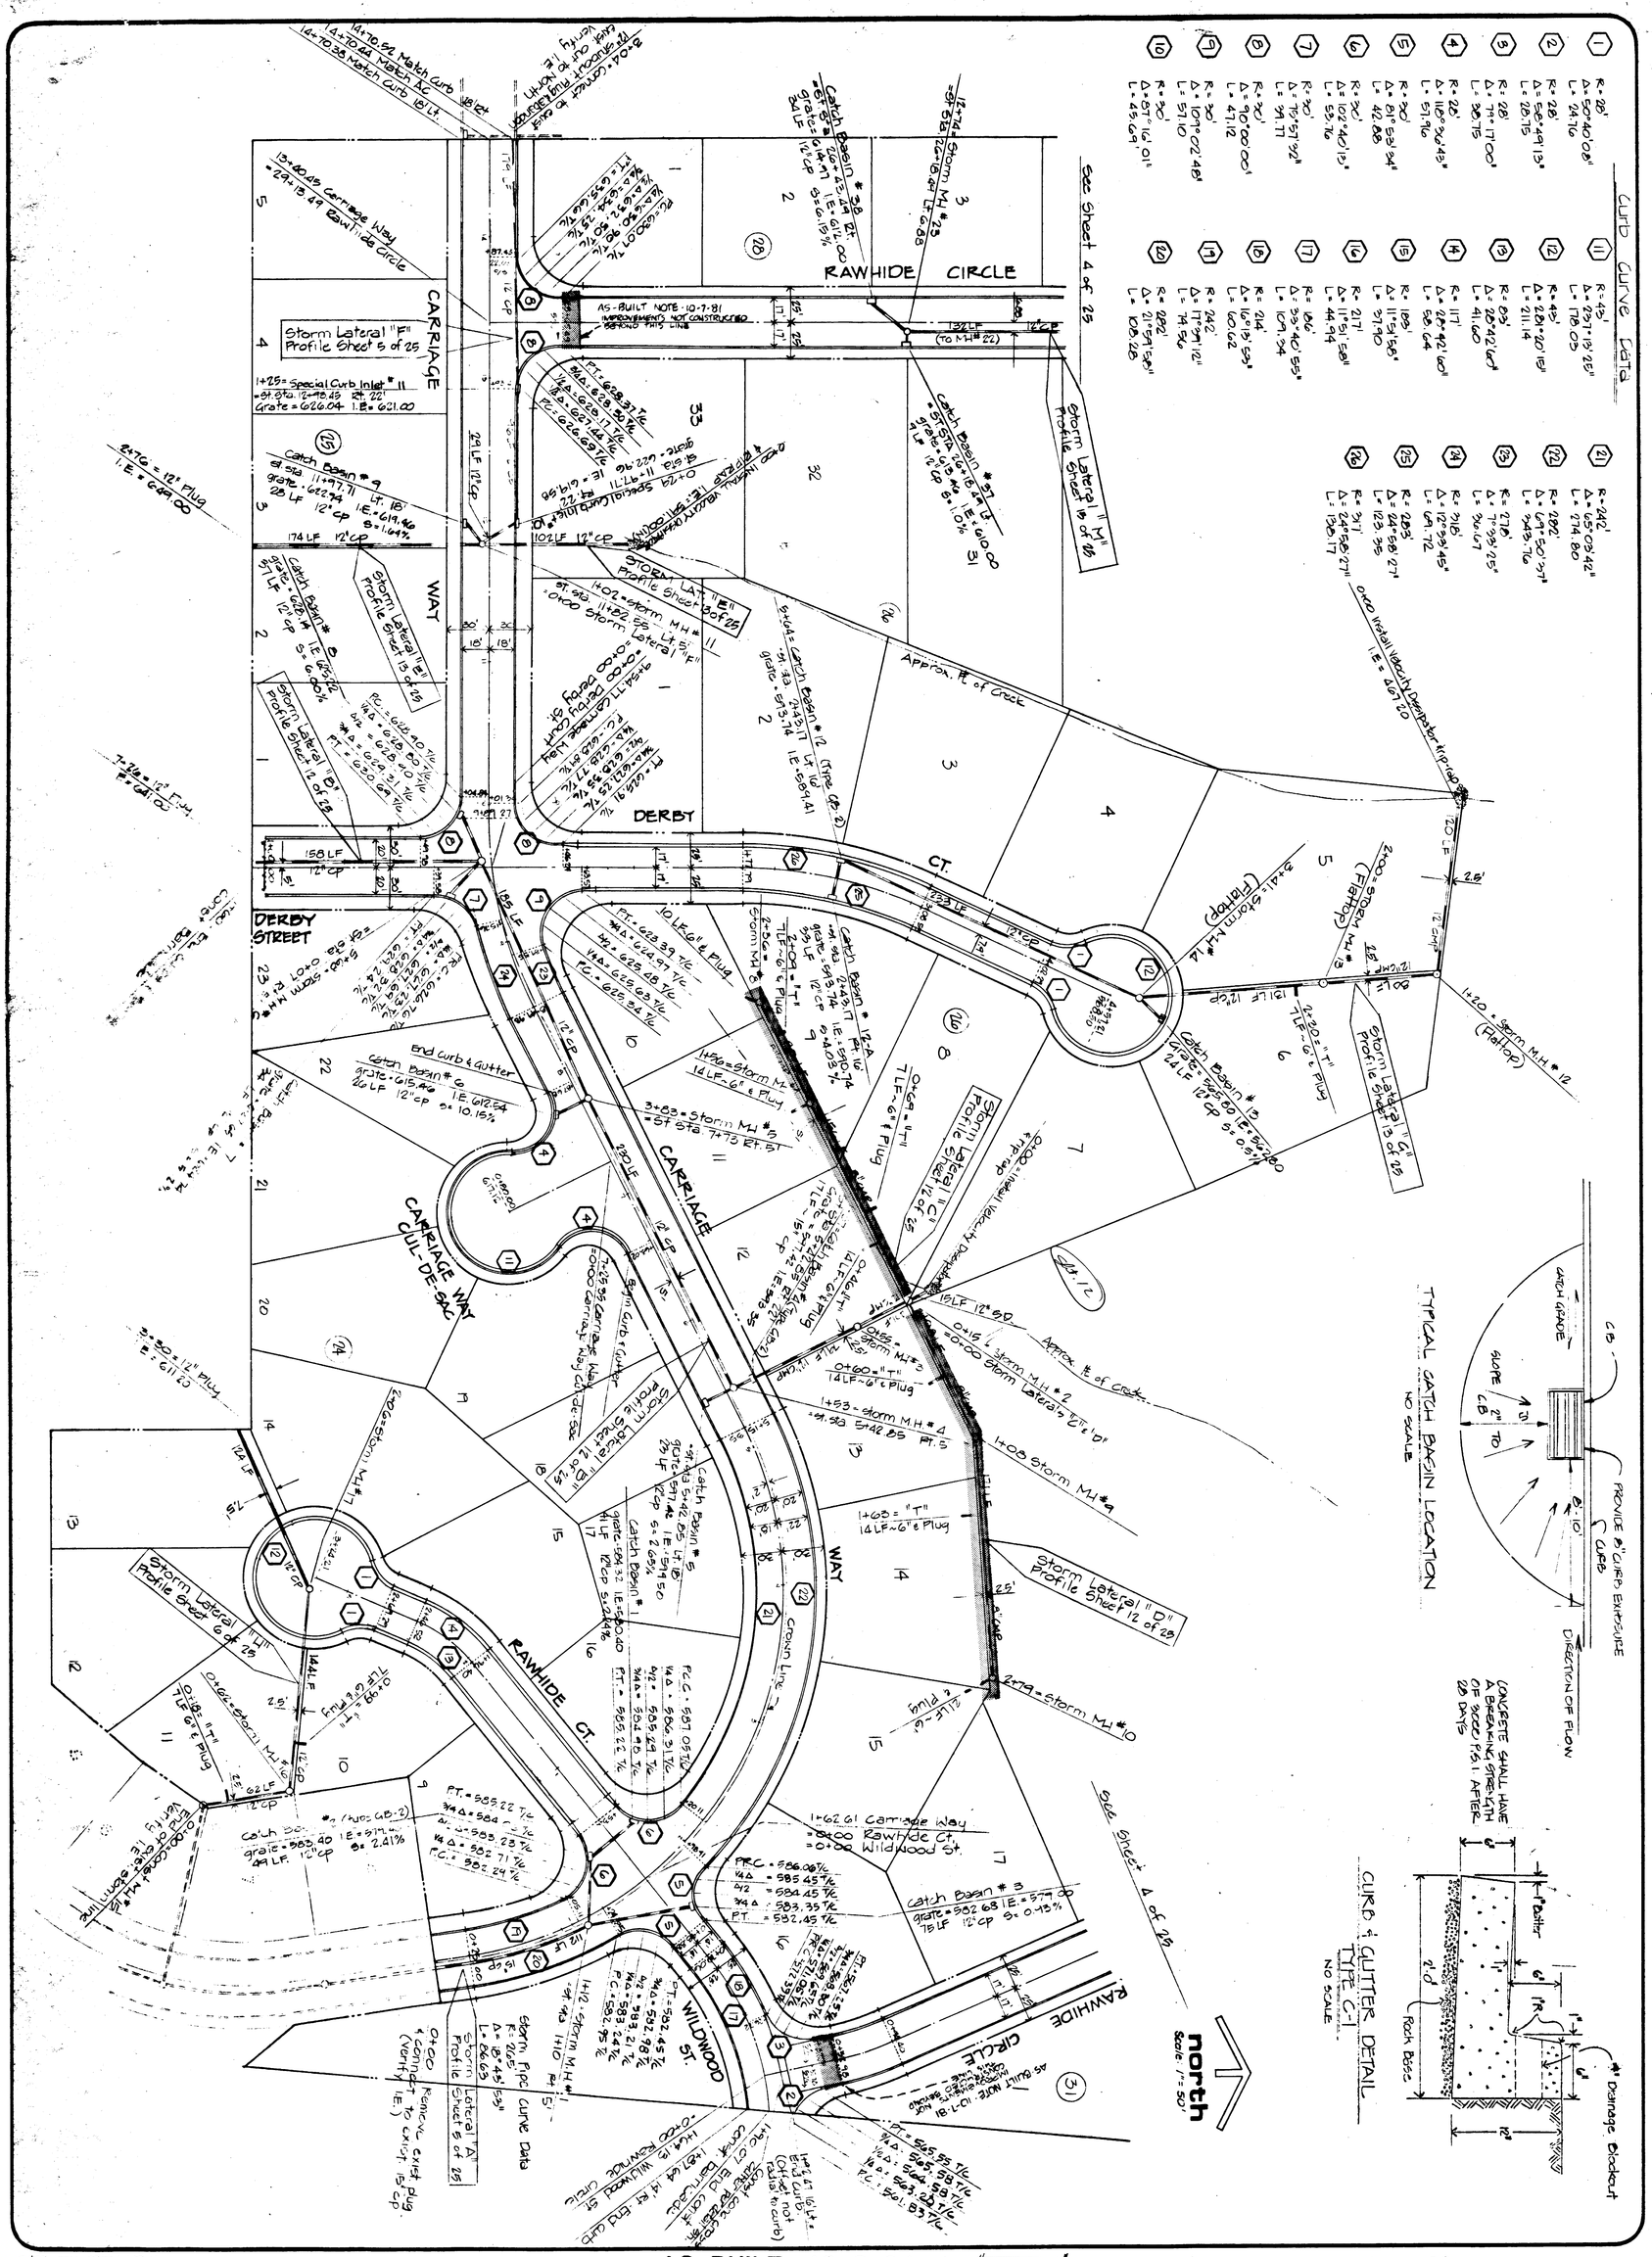

9/80 REV STORM LAT. H
10/79 REV. PER CITY OF WEST LINN RJP/EH
REV. CURB GRADES RJP/JC

AS-BUILT 10-8-81 (NOTE: "[redacted]" INDICATES AREA/UTILITY NOT CONST. AS OF 10-8-81)

SHEET NO. 3/25
DESIGN JUNE 1979 BY RJP
DRAWN JUNE 1979 BY EH
CHECKED _____ BY _____
FILE NO. 4-1100-7401

HIDDEN SPRINGS RANCH NO. 6

WEST LINN, OREGON

STREET & STORM PLAN

EDWARDS INDUSTRIES, INC. BEAVERTON, OREGON

W&H WILSEY & HAM
Suite 4, Portland Center, 222 S.W. Harrison
Portland, Oregon 97201 503 227-0455

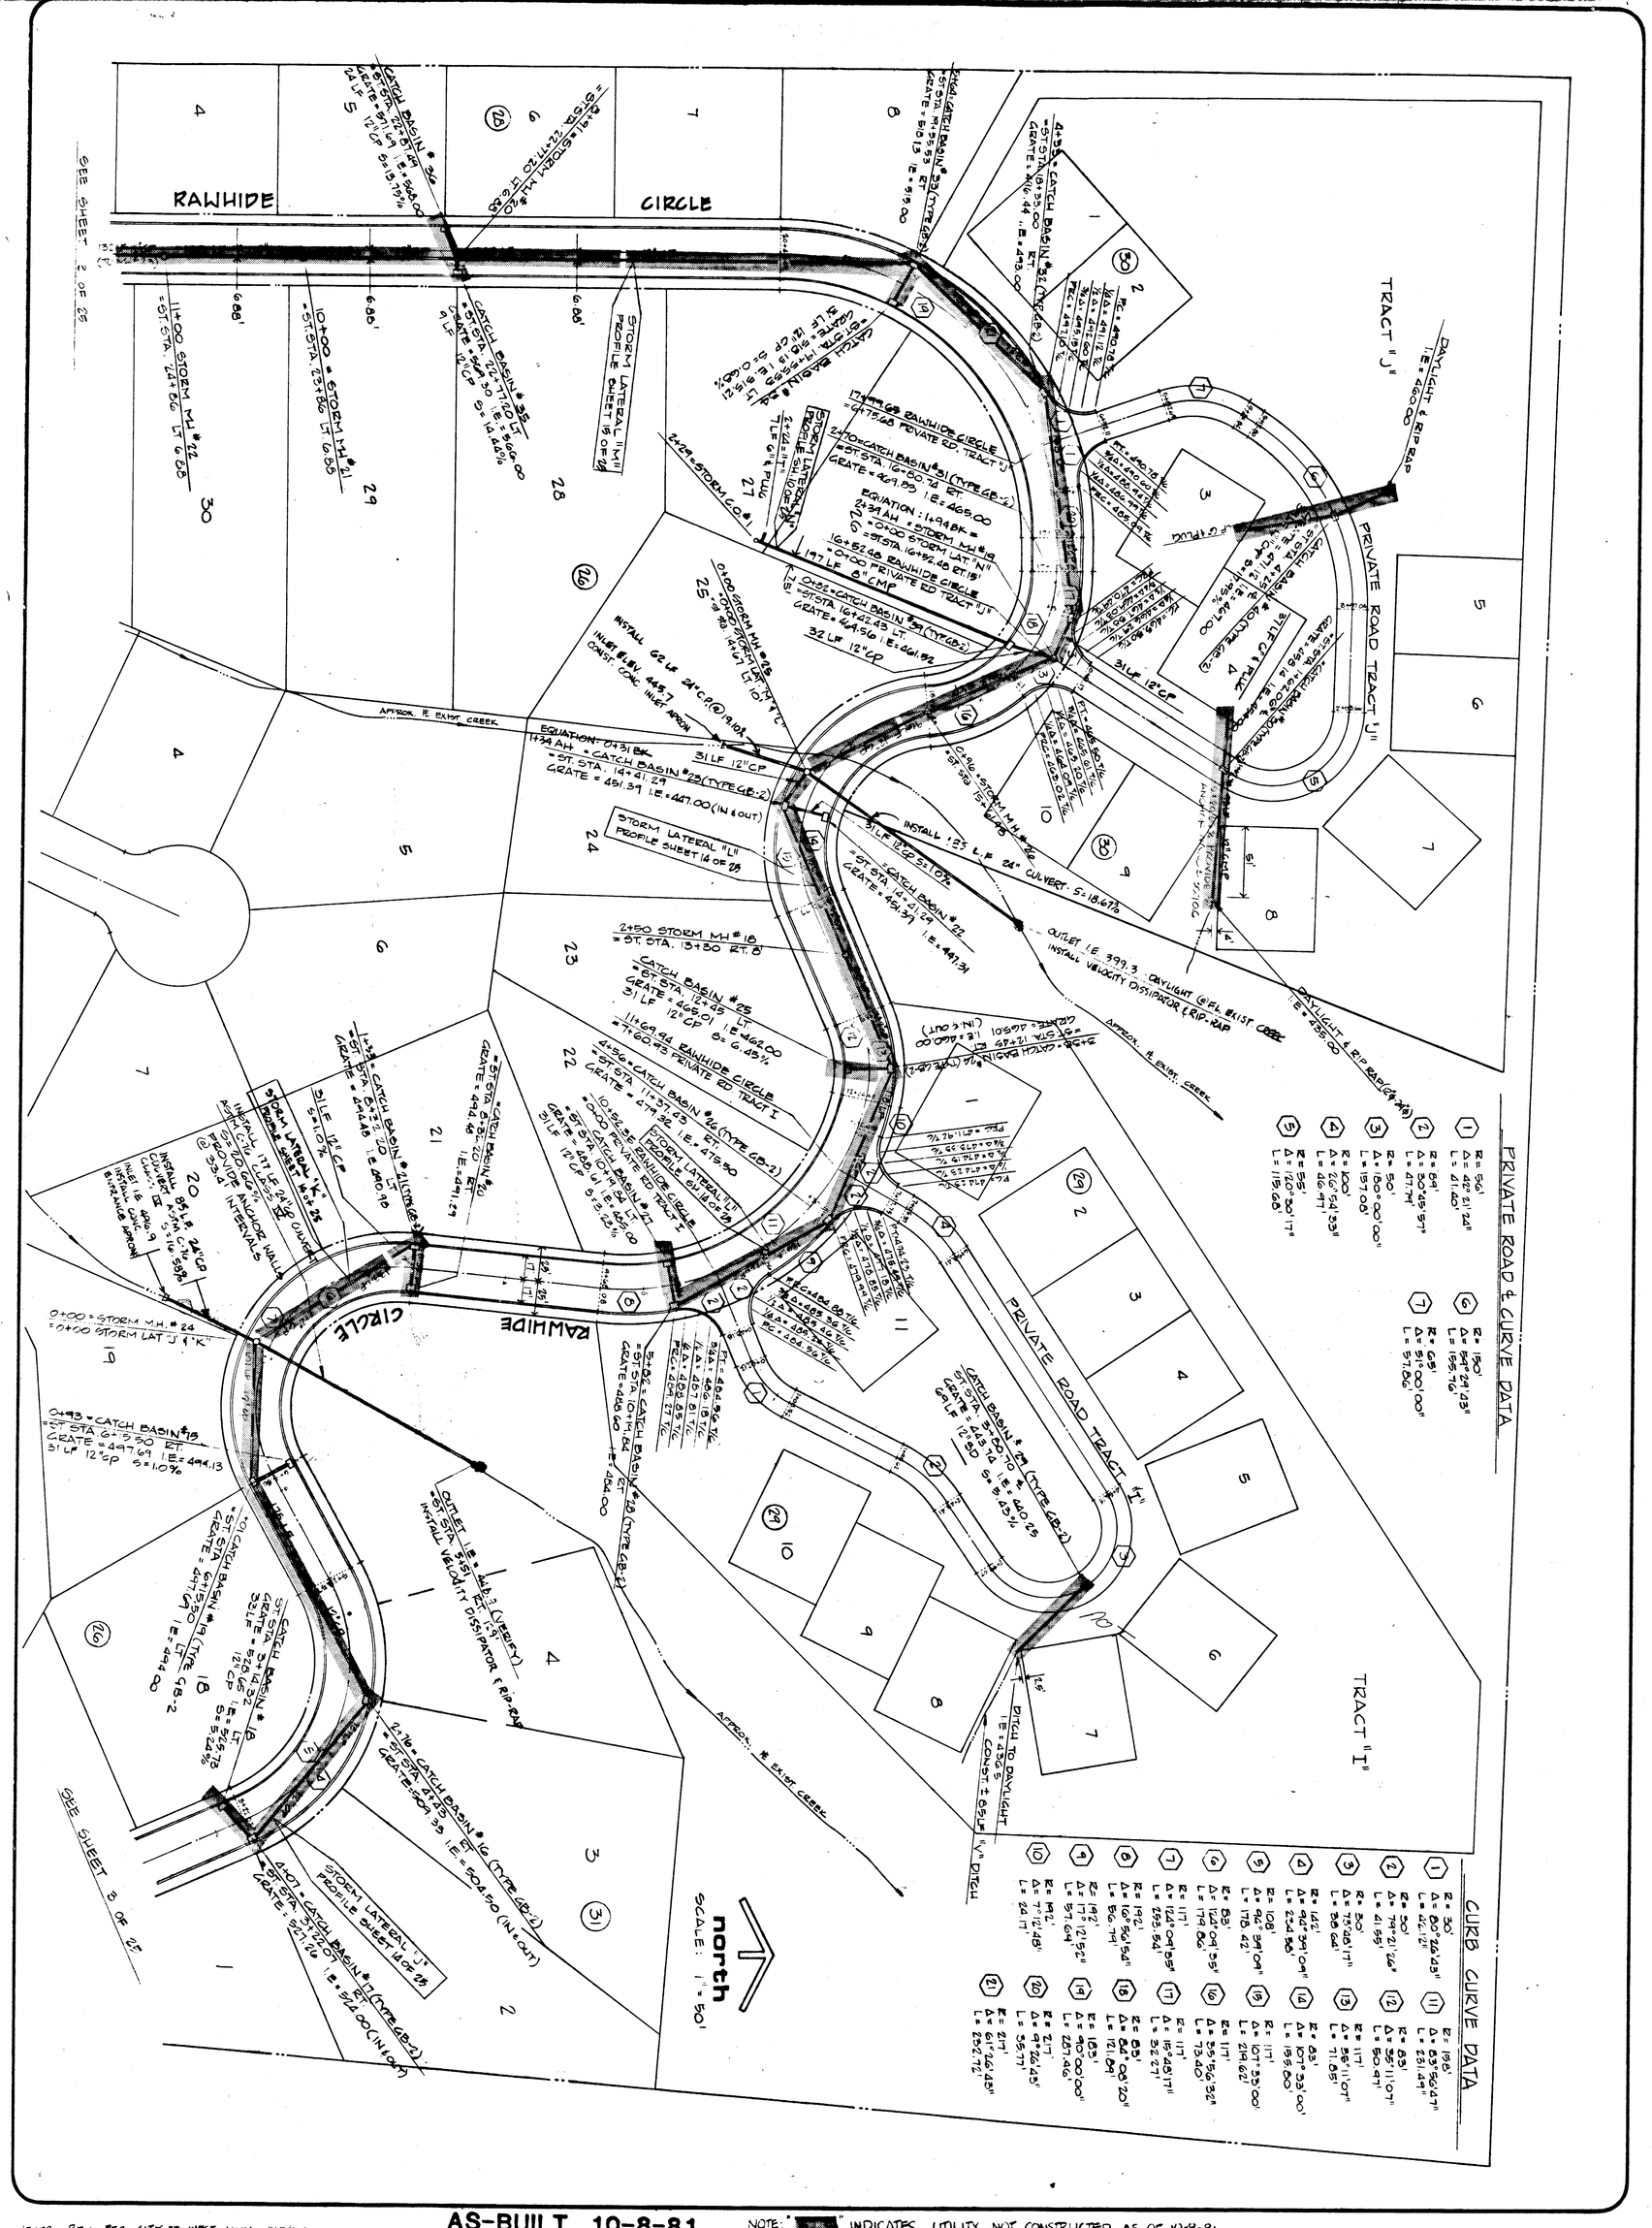

10/79 REV. PER CITY OF WEST LINN RJP/RH

AS-BUILT 10-8-81

NOTE: "[redacted]" INDICATES UTILITY NOT CONSTRUCTED AS OF 10-3-81

SHEET NO. 4/25

DESIGN JUNE 1979 BY RJP

DRAWN JUNE 1979 BY CB

CHECKED _____ BY _____

FILE NO. 4-1100-7401

REGISTERED PROFESSIONAL ENGINEER 8970 OREGON JUN 30, 1978 JERRY M. PALMER

HIDDEN SPRINGS RANCH NO. 6

WEST LINN, OREGON

STREET & STORM SEWER PLAN

EDWARDS INDUSTRIES, INC. BEAVERTON, OREGON

W&H WILSEY & HAM

Suite 4, Portland Center, 222 S.W. Harrison
Portland, Oregon 97201 503 227-0455

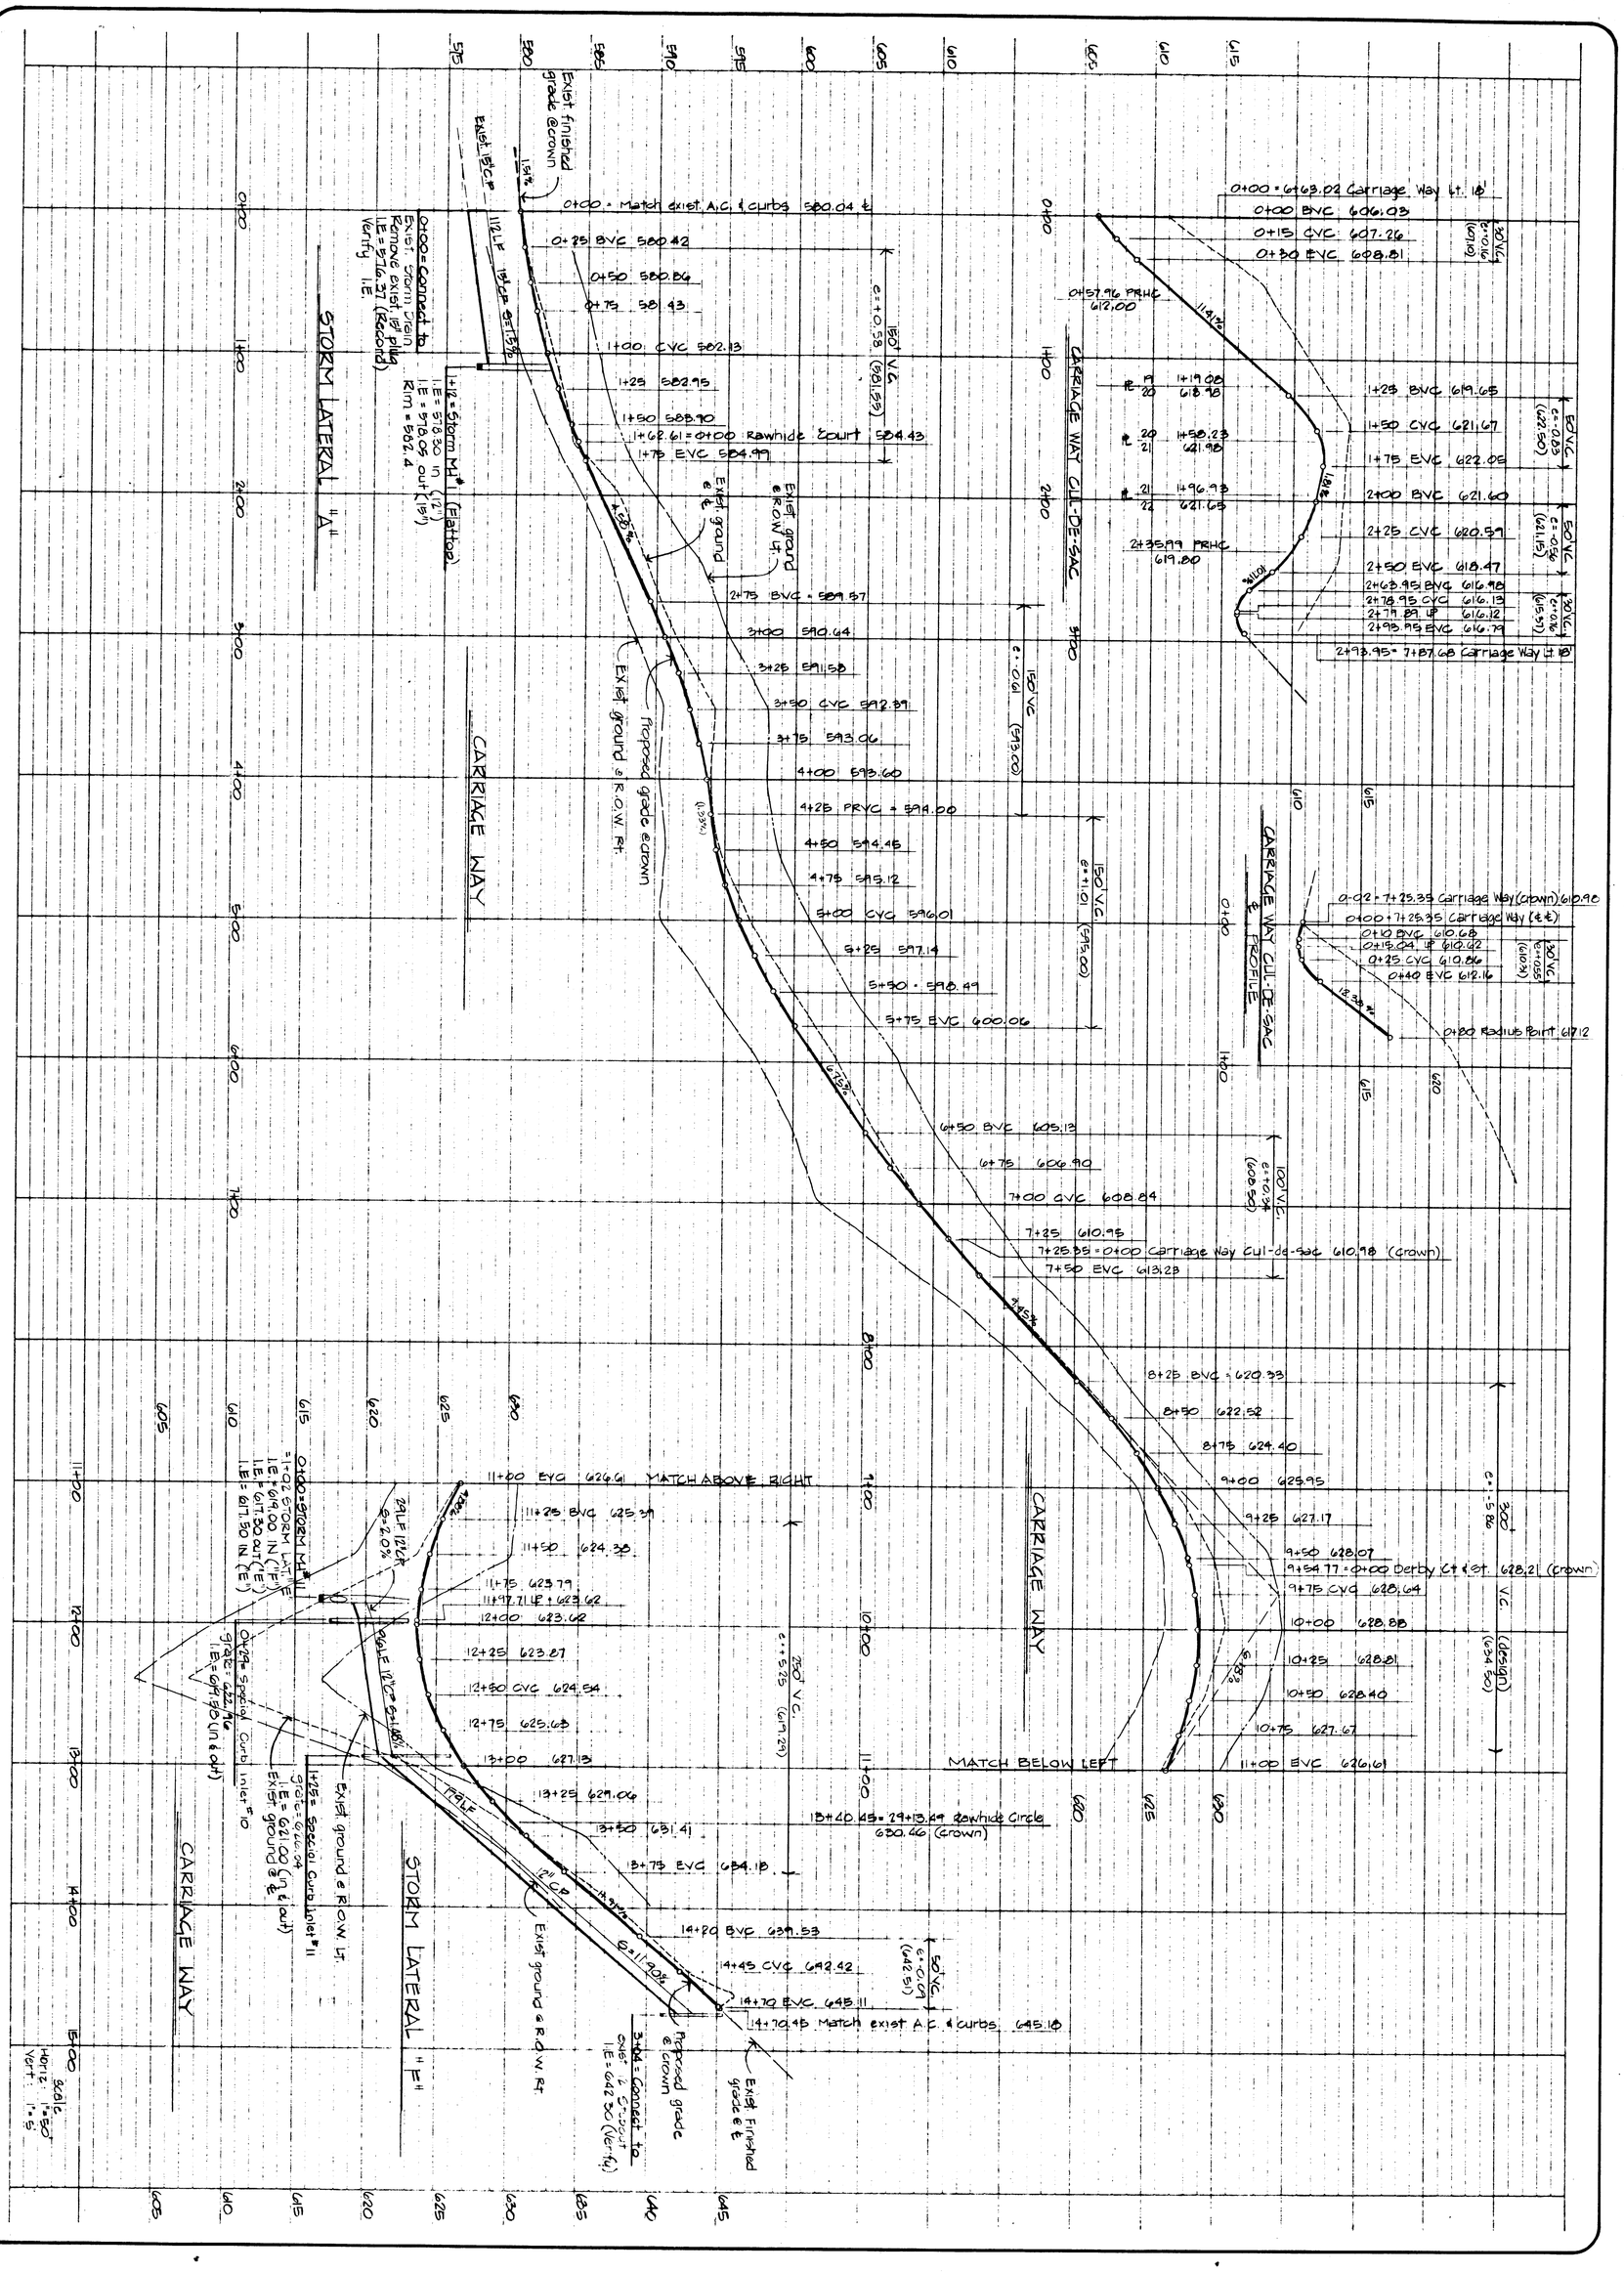

SHEET NO. 5/25

DESIGN JUNE 1979 BY RJP
DRAWN JUNE 1979 BY RH
CHECKED _____ BY _____
FILE NO. 4-1100-7401

REGISTERED PROFESSIONAL ENGINEER — JERRY M. PALMER — July 26, 1979

HIDDEN SPRINGS RANCH NO.6

WEST LINN, OREGON

STREET & STORM SEWER PROFILES

EDWARDS INDUSTRIES, INC. BEAVERTON, OREGON

W&H WILSEY & HAM

Suite 4, Portland Center, 222 S.W. Harrison
Portland, Oregon 97201 503 227-0455

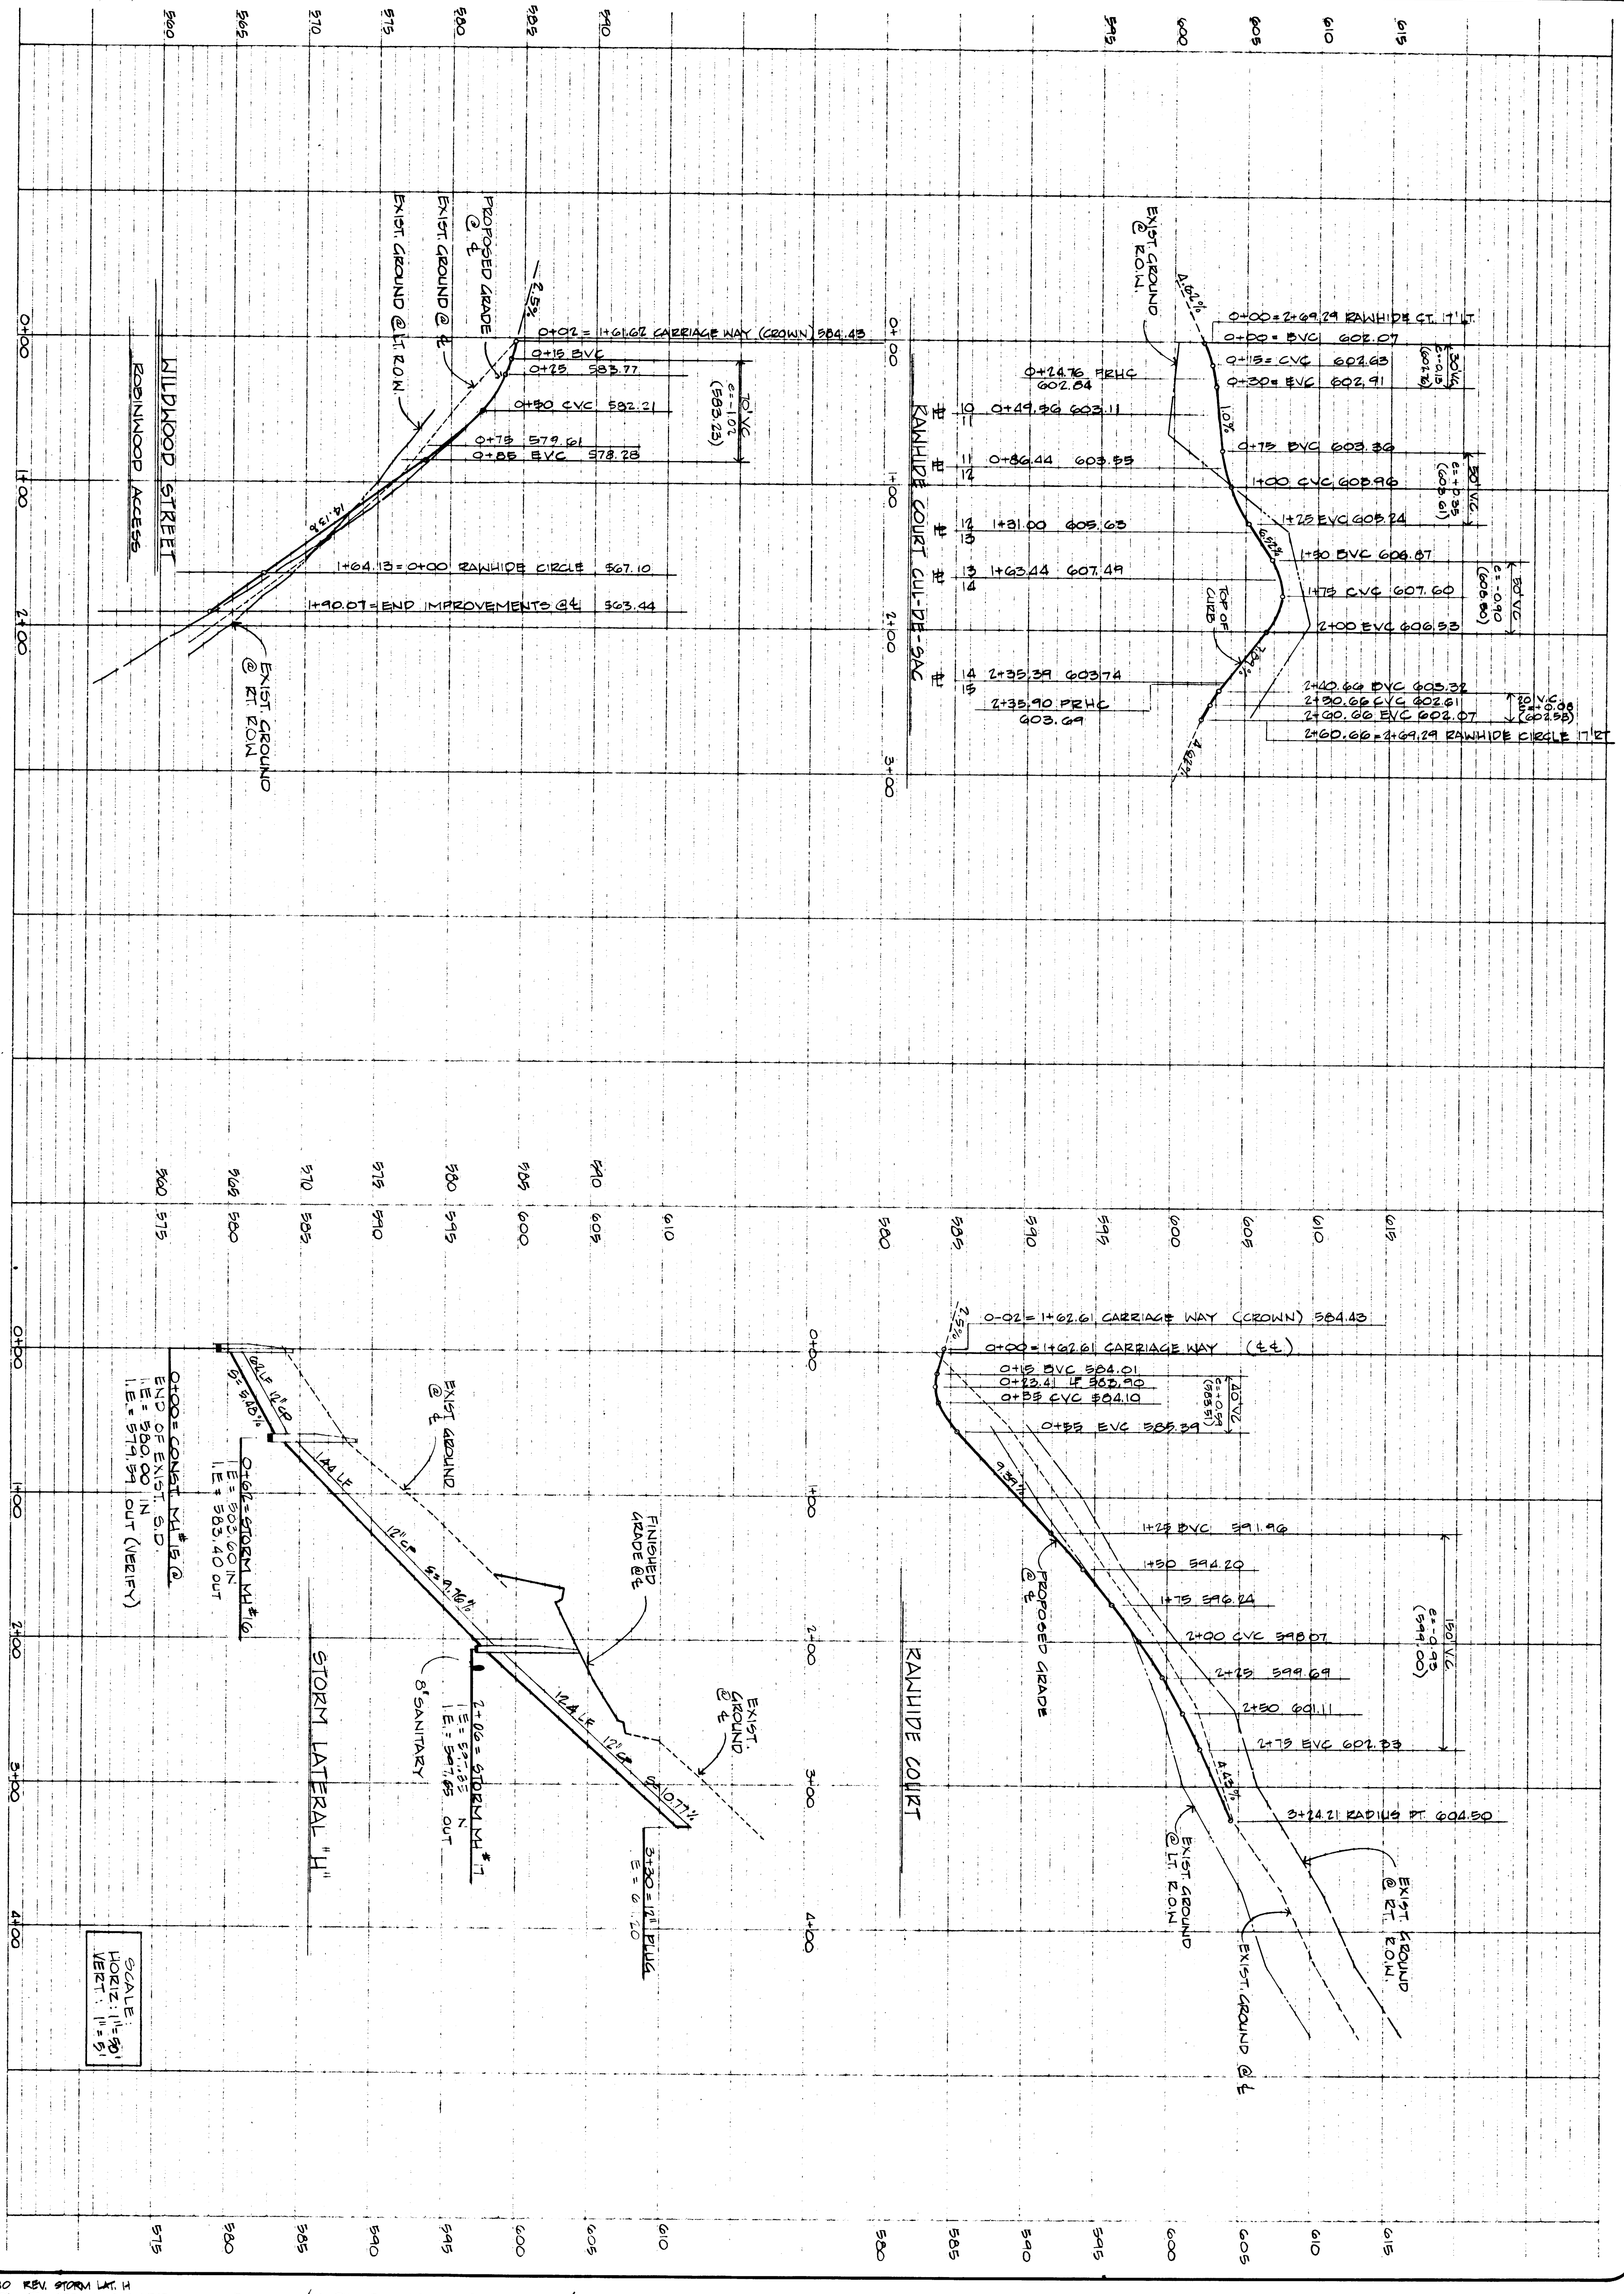

9/80 REV. STORM LAT. H
6/79 REV. PER CITY OF WEST LINN RJP 6/81 REVISE GRADES - WILDWOOD ST. RJP/JC

SHEET NO. 6/25
DESIGN JUNE 1979 BY RJP
DRAWN JUNE 1979 BY CB
CHECKED _____ BY _____
FILE NO. 4-1100-7401

REGISTERED PROFESSIONAL ENGINEER JERRY M. PALMER

HIDDEN SPRINGS RANCH NO. 6

WEST LINN, OREGON

STREET & STORM SEWER PROFILES

EDWARDS INDUSTRIES, INC. BEAVERTON, OREGON

W&H WILSEY & HAM
Suite 4, Portland Center, 222 S.W. Harrison
Portland, Oregon 97201 503 227-0455

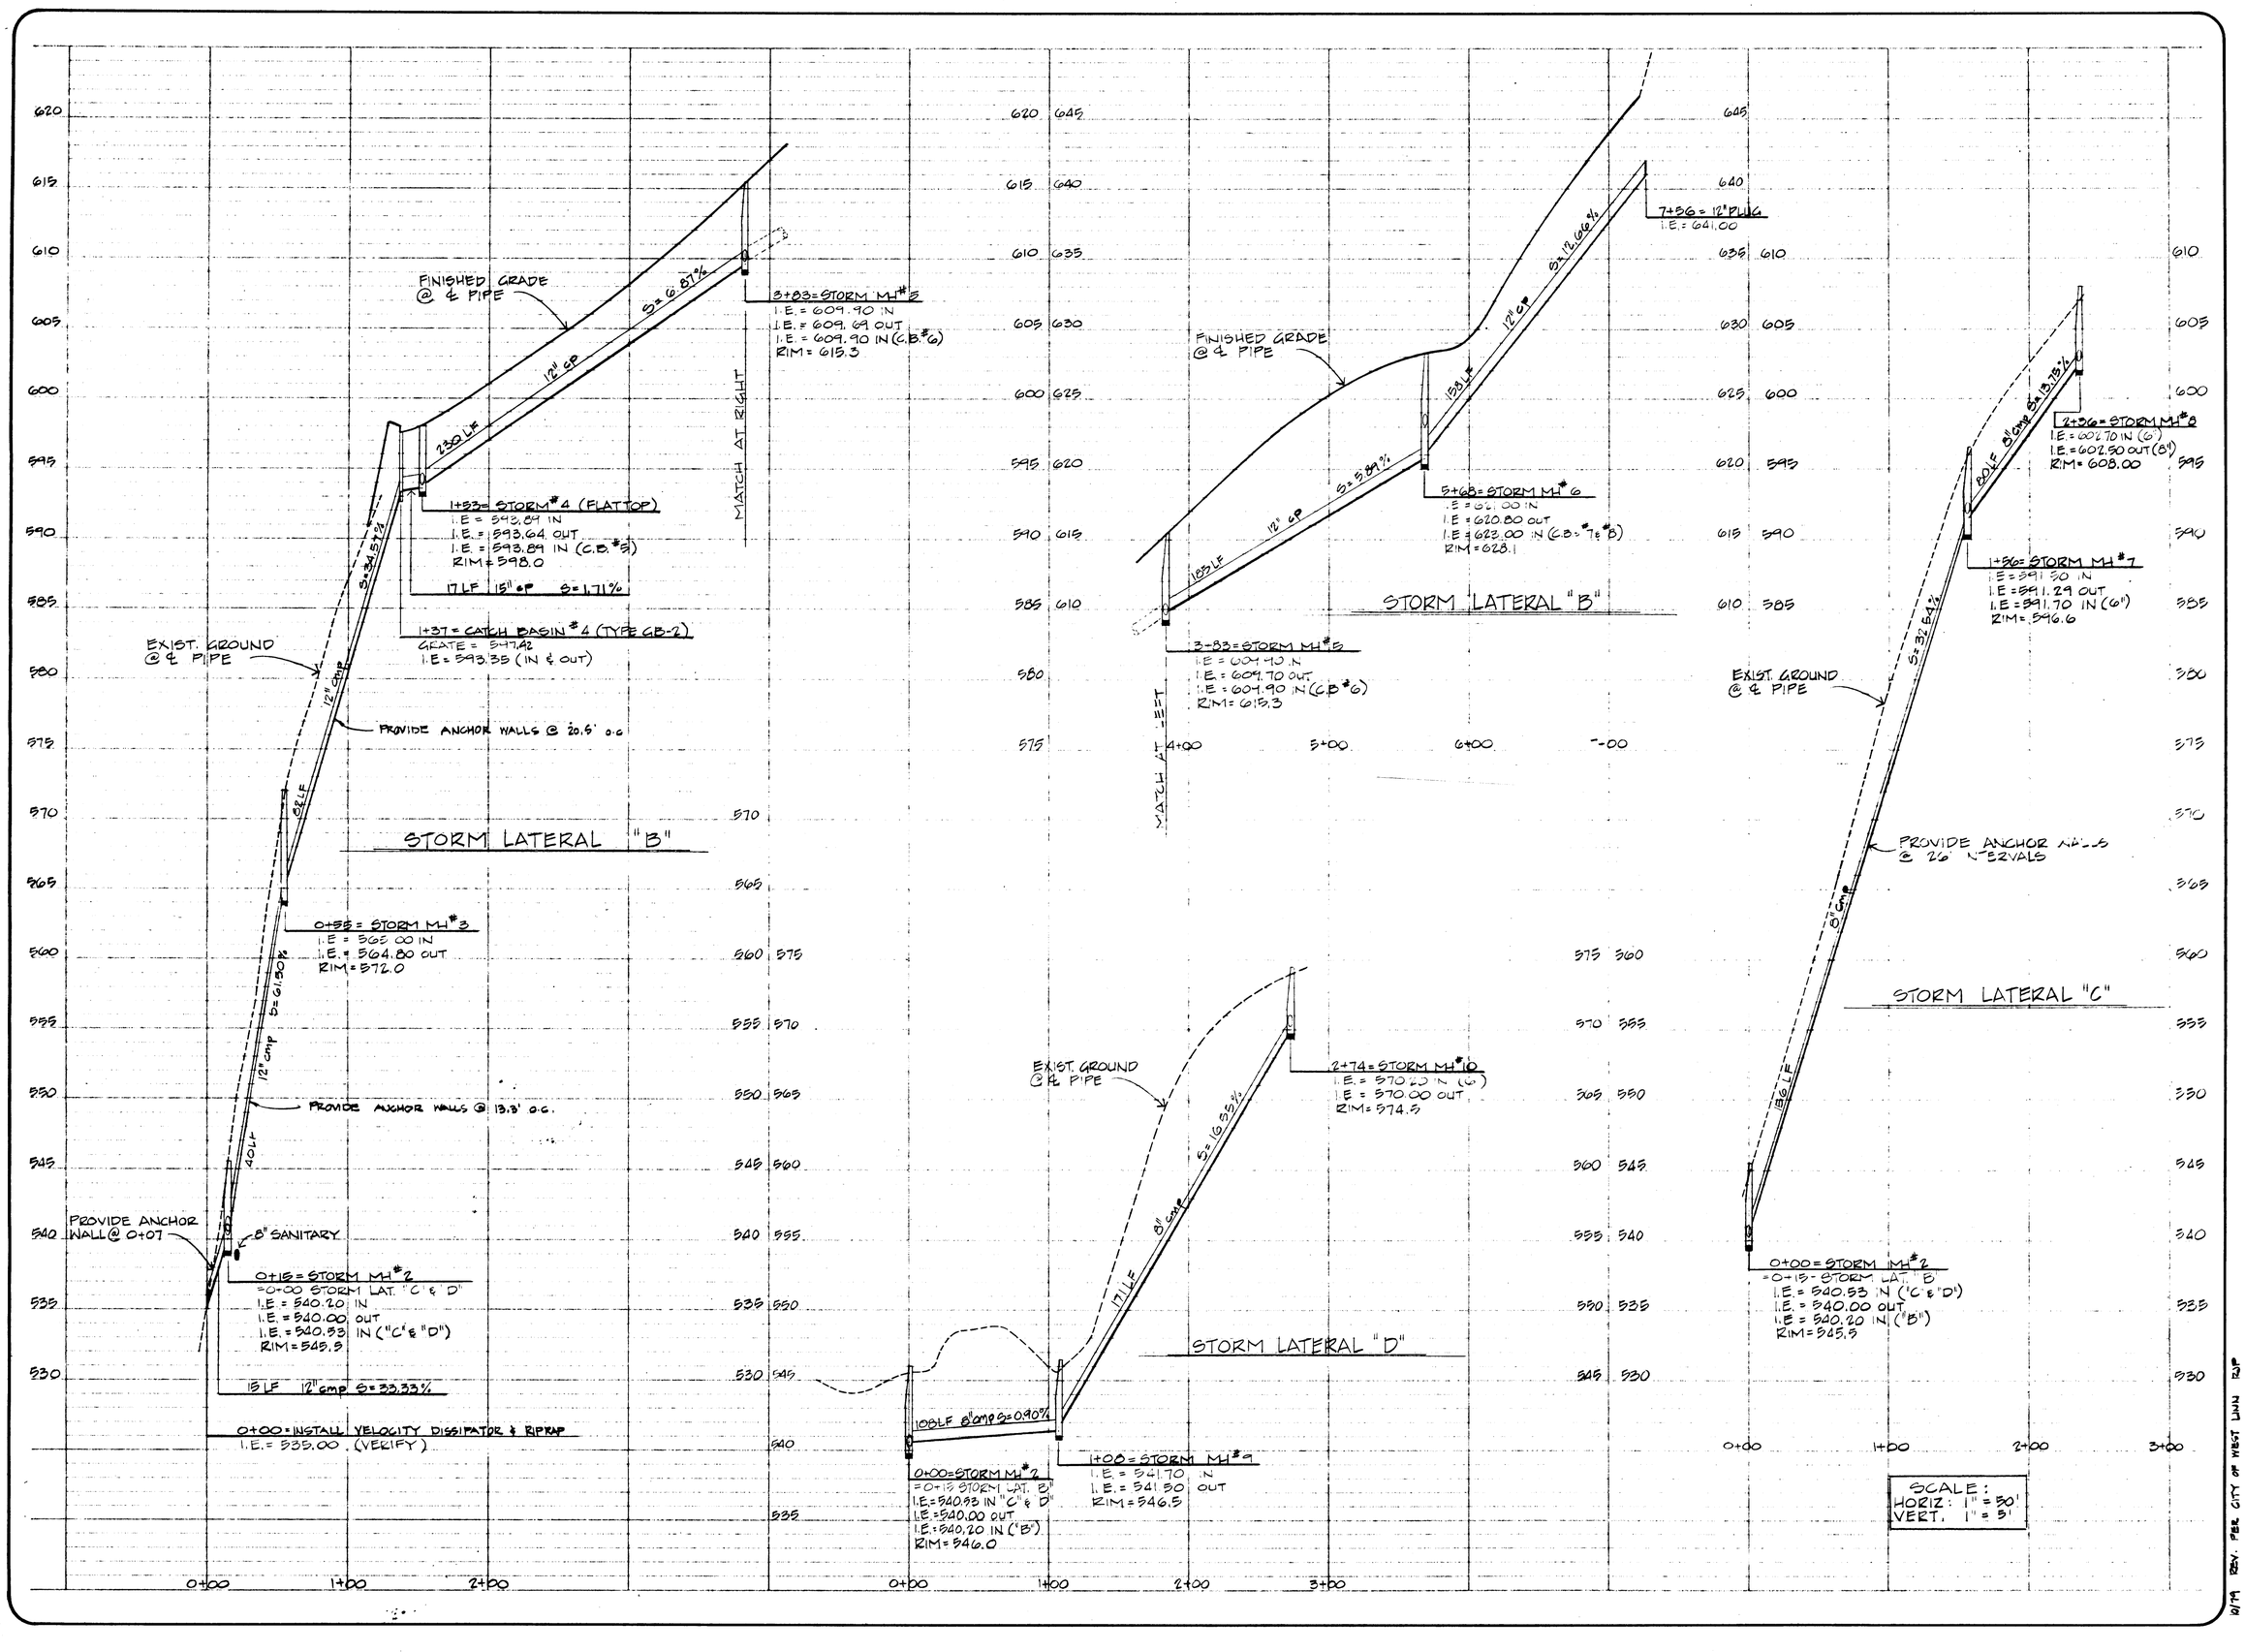

W&H WILSEY & HAM
Suite 4, Portland Center, 222 S.W. Harrison
Portland, Oregon 97201 503 227-0455

HIDDEN SPRINGS RANCH NO. 6
OREGON
WEST LINN,
STORM SEWER PROFILES
BEAVERTON, OREGON
EDWARDS INDUSTRIES, INC.

REGISTERED PROFESSIONAL ENGINEER
PALMER
RODNEY M. ALLEN
OREGON

SHEET NO. 12/25
DESIGN JUNE 1979 BY RJP
DRAWN JUNE 1974 BY CB
CHECKED ____ BY ____
FILE NO. 4-1100-7401

10/79 REV. PER CITY OF WEST LINN RJP

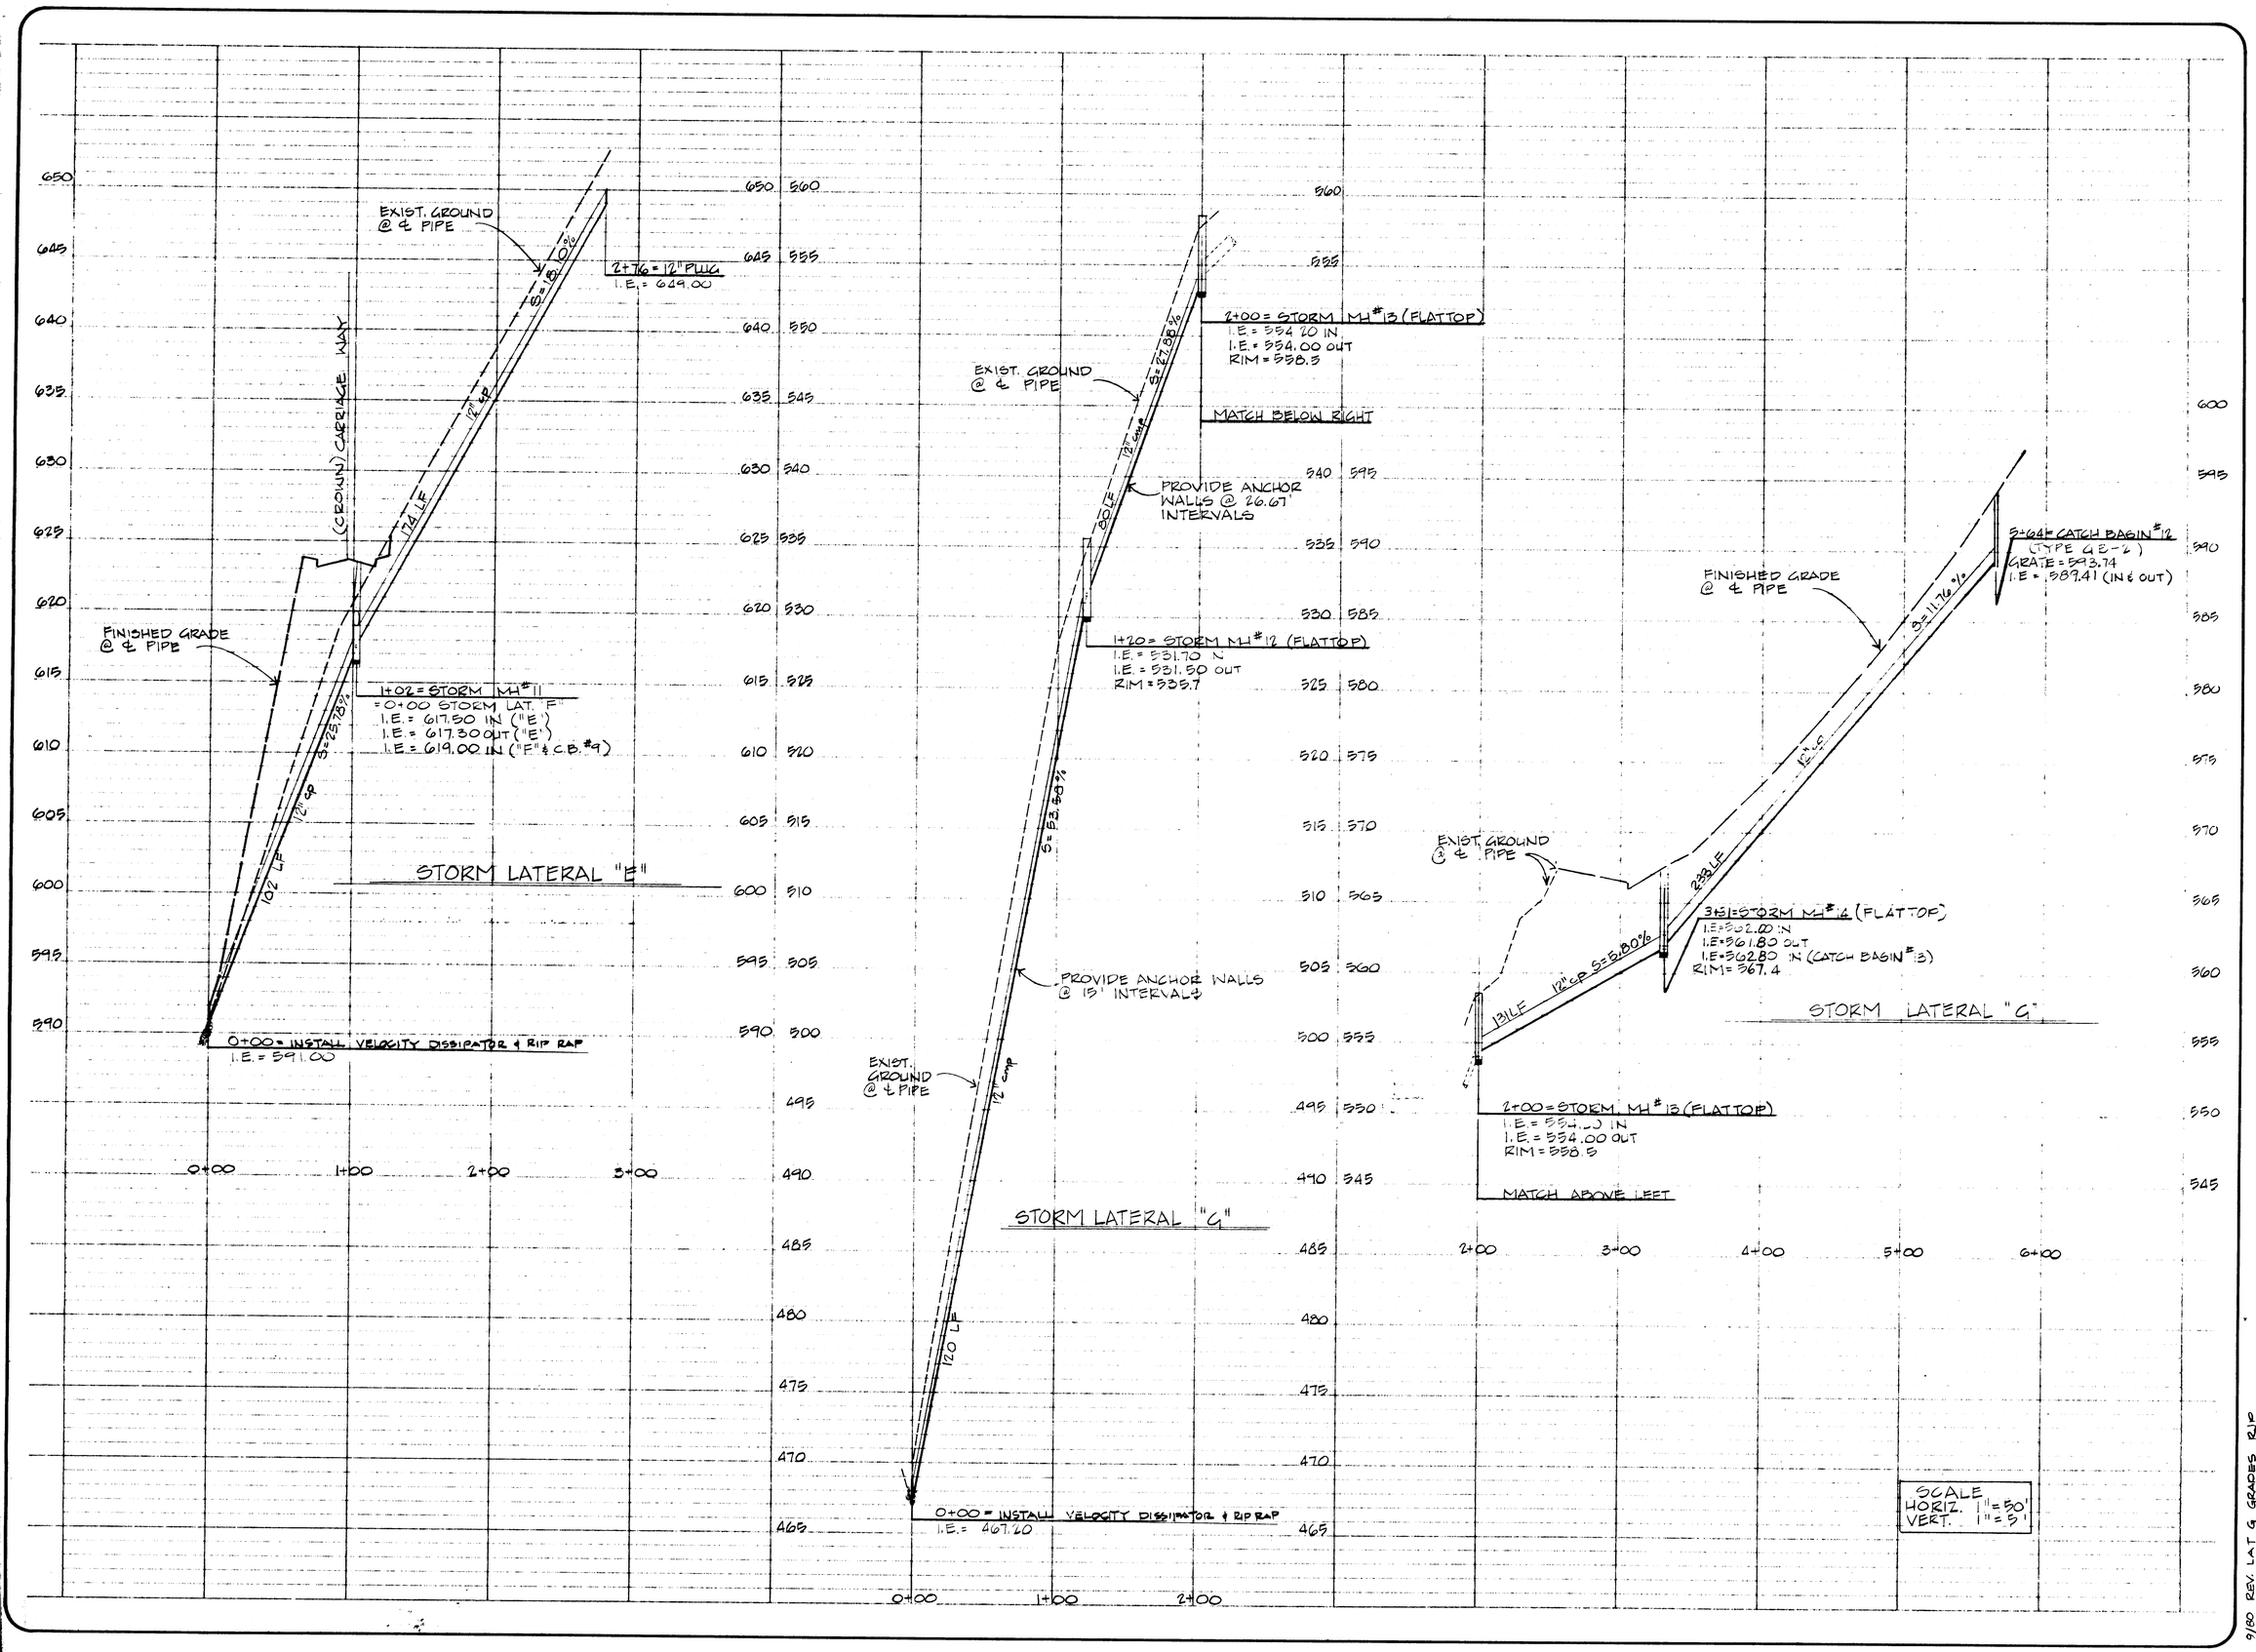

9/80 REV. LAT G GRADES RIP
10/79 REV. PER CITY OF WEST LINN RIP

SHEET NO. 13/25
DESIGN JUNE 1979 BY RIP
DRAWN JUNE 1979 BY CD
CHECKED BY
FILE NO. 4-1100-740

REGISTERED PROFESSIONAL ENGINEER
OREGON

W&H WILSEY & HAM
Suite 4, Portland Center, 222 S.W. Harrison
Portland, Oregon 97201 503 227-0455

HIDDEN SPRINGS RANCH NO. 6
WEST LINN, OREGON

STORM SEWER PROFILES

BEAVERTON, OREGON

EDWARDS INDUSTRIES, INC.

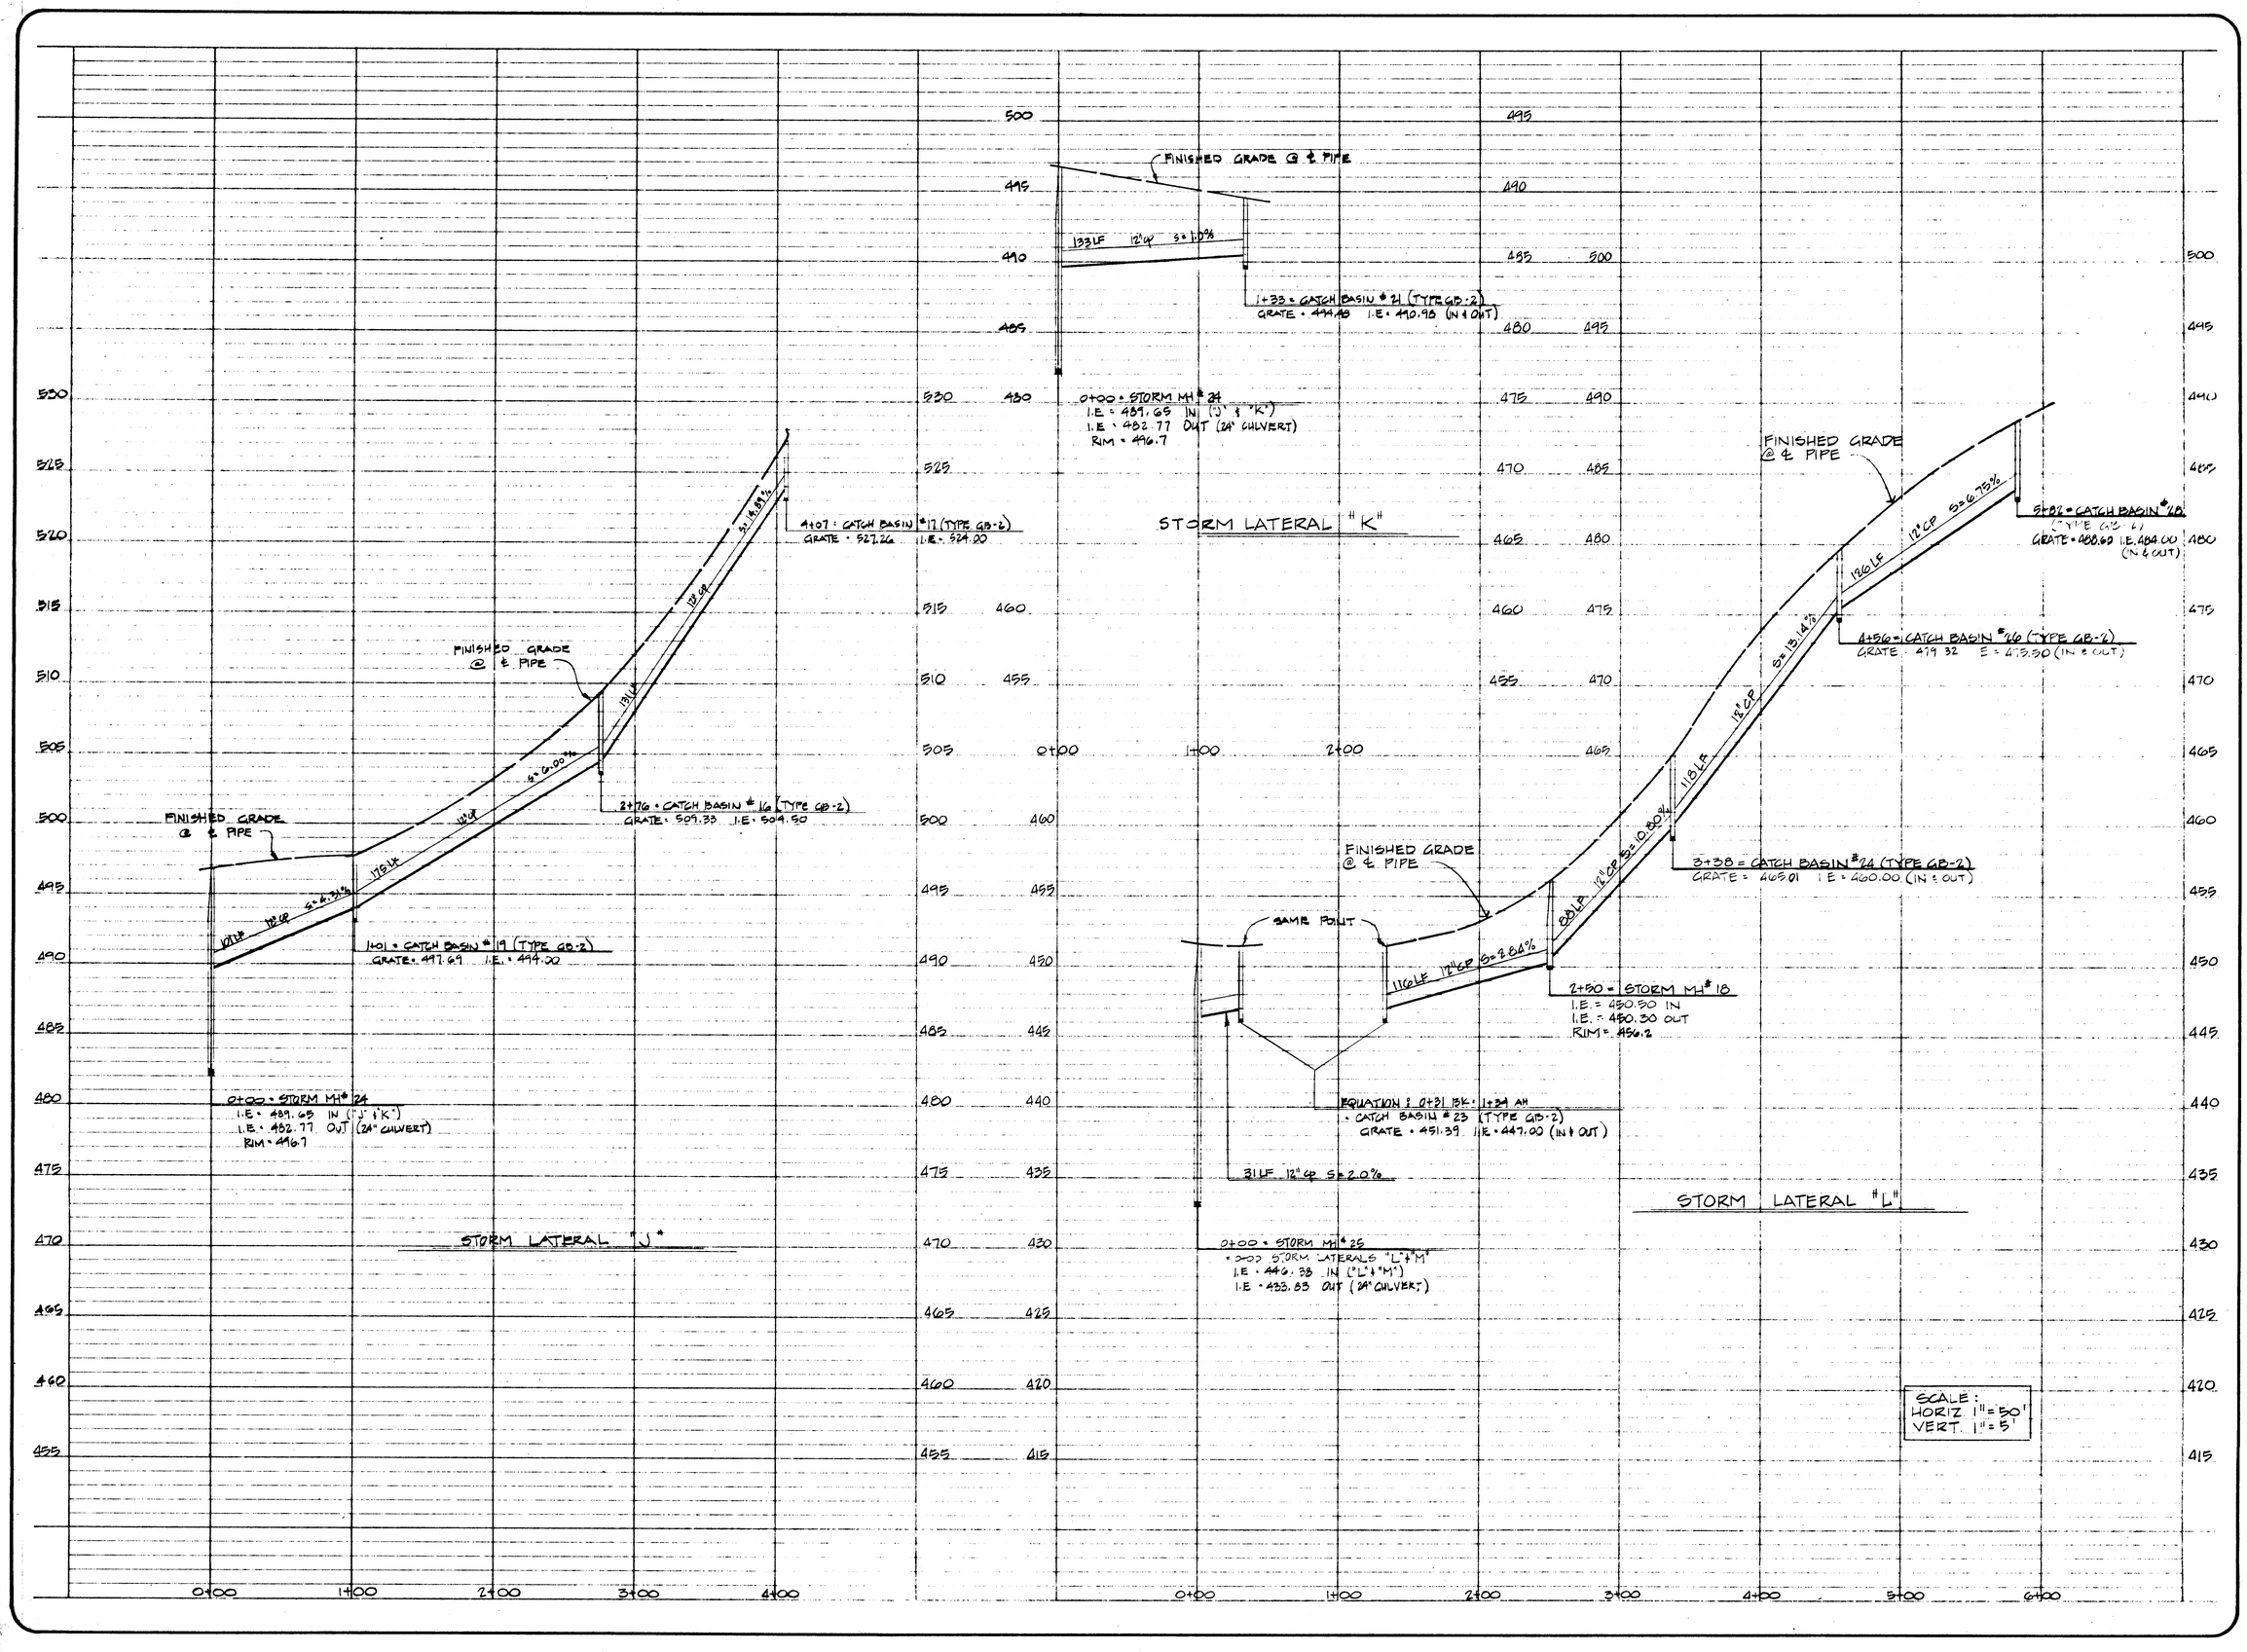

W&H WILSEY & HAM
Suite 4, Portland Center, 222 S.W. Harrison
Portland, Oregon 97201 503 227-0455

HIDDEN SPRINGS RANCH NO. 6
WEST LINN, OREGON
STORM SEWER PROFILES
EDWARDS INDUSTRIES, INC. BEAVERTON, OREGON

REGISTERED PROFESSIONAL ENGINEER 8979 OREGON J. A. ZEC, JR. JERRY M. PALMER

10/79 REV. PER CITY OF WEST LINN RJP

SHEET NO. 14/25
DESIGN JUNE 1979 BY RJP
DRAWN JUNE 1979 BY CB
CHECKED BY
FILE NO. 4-1100-7401

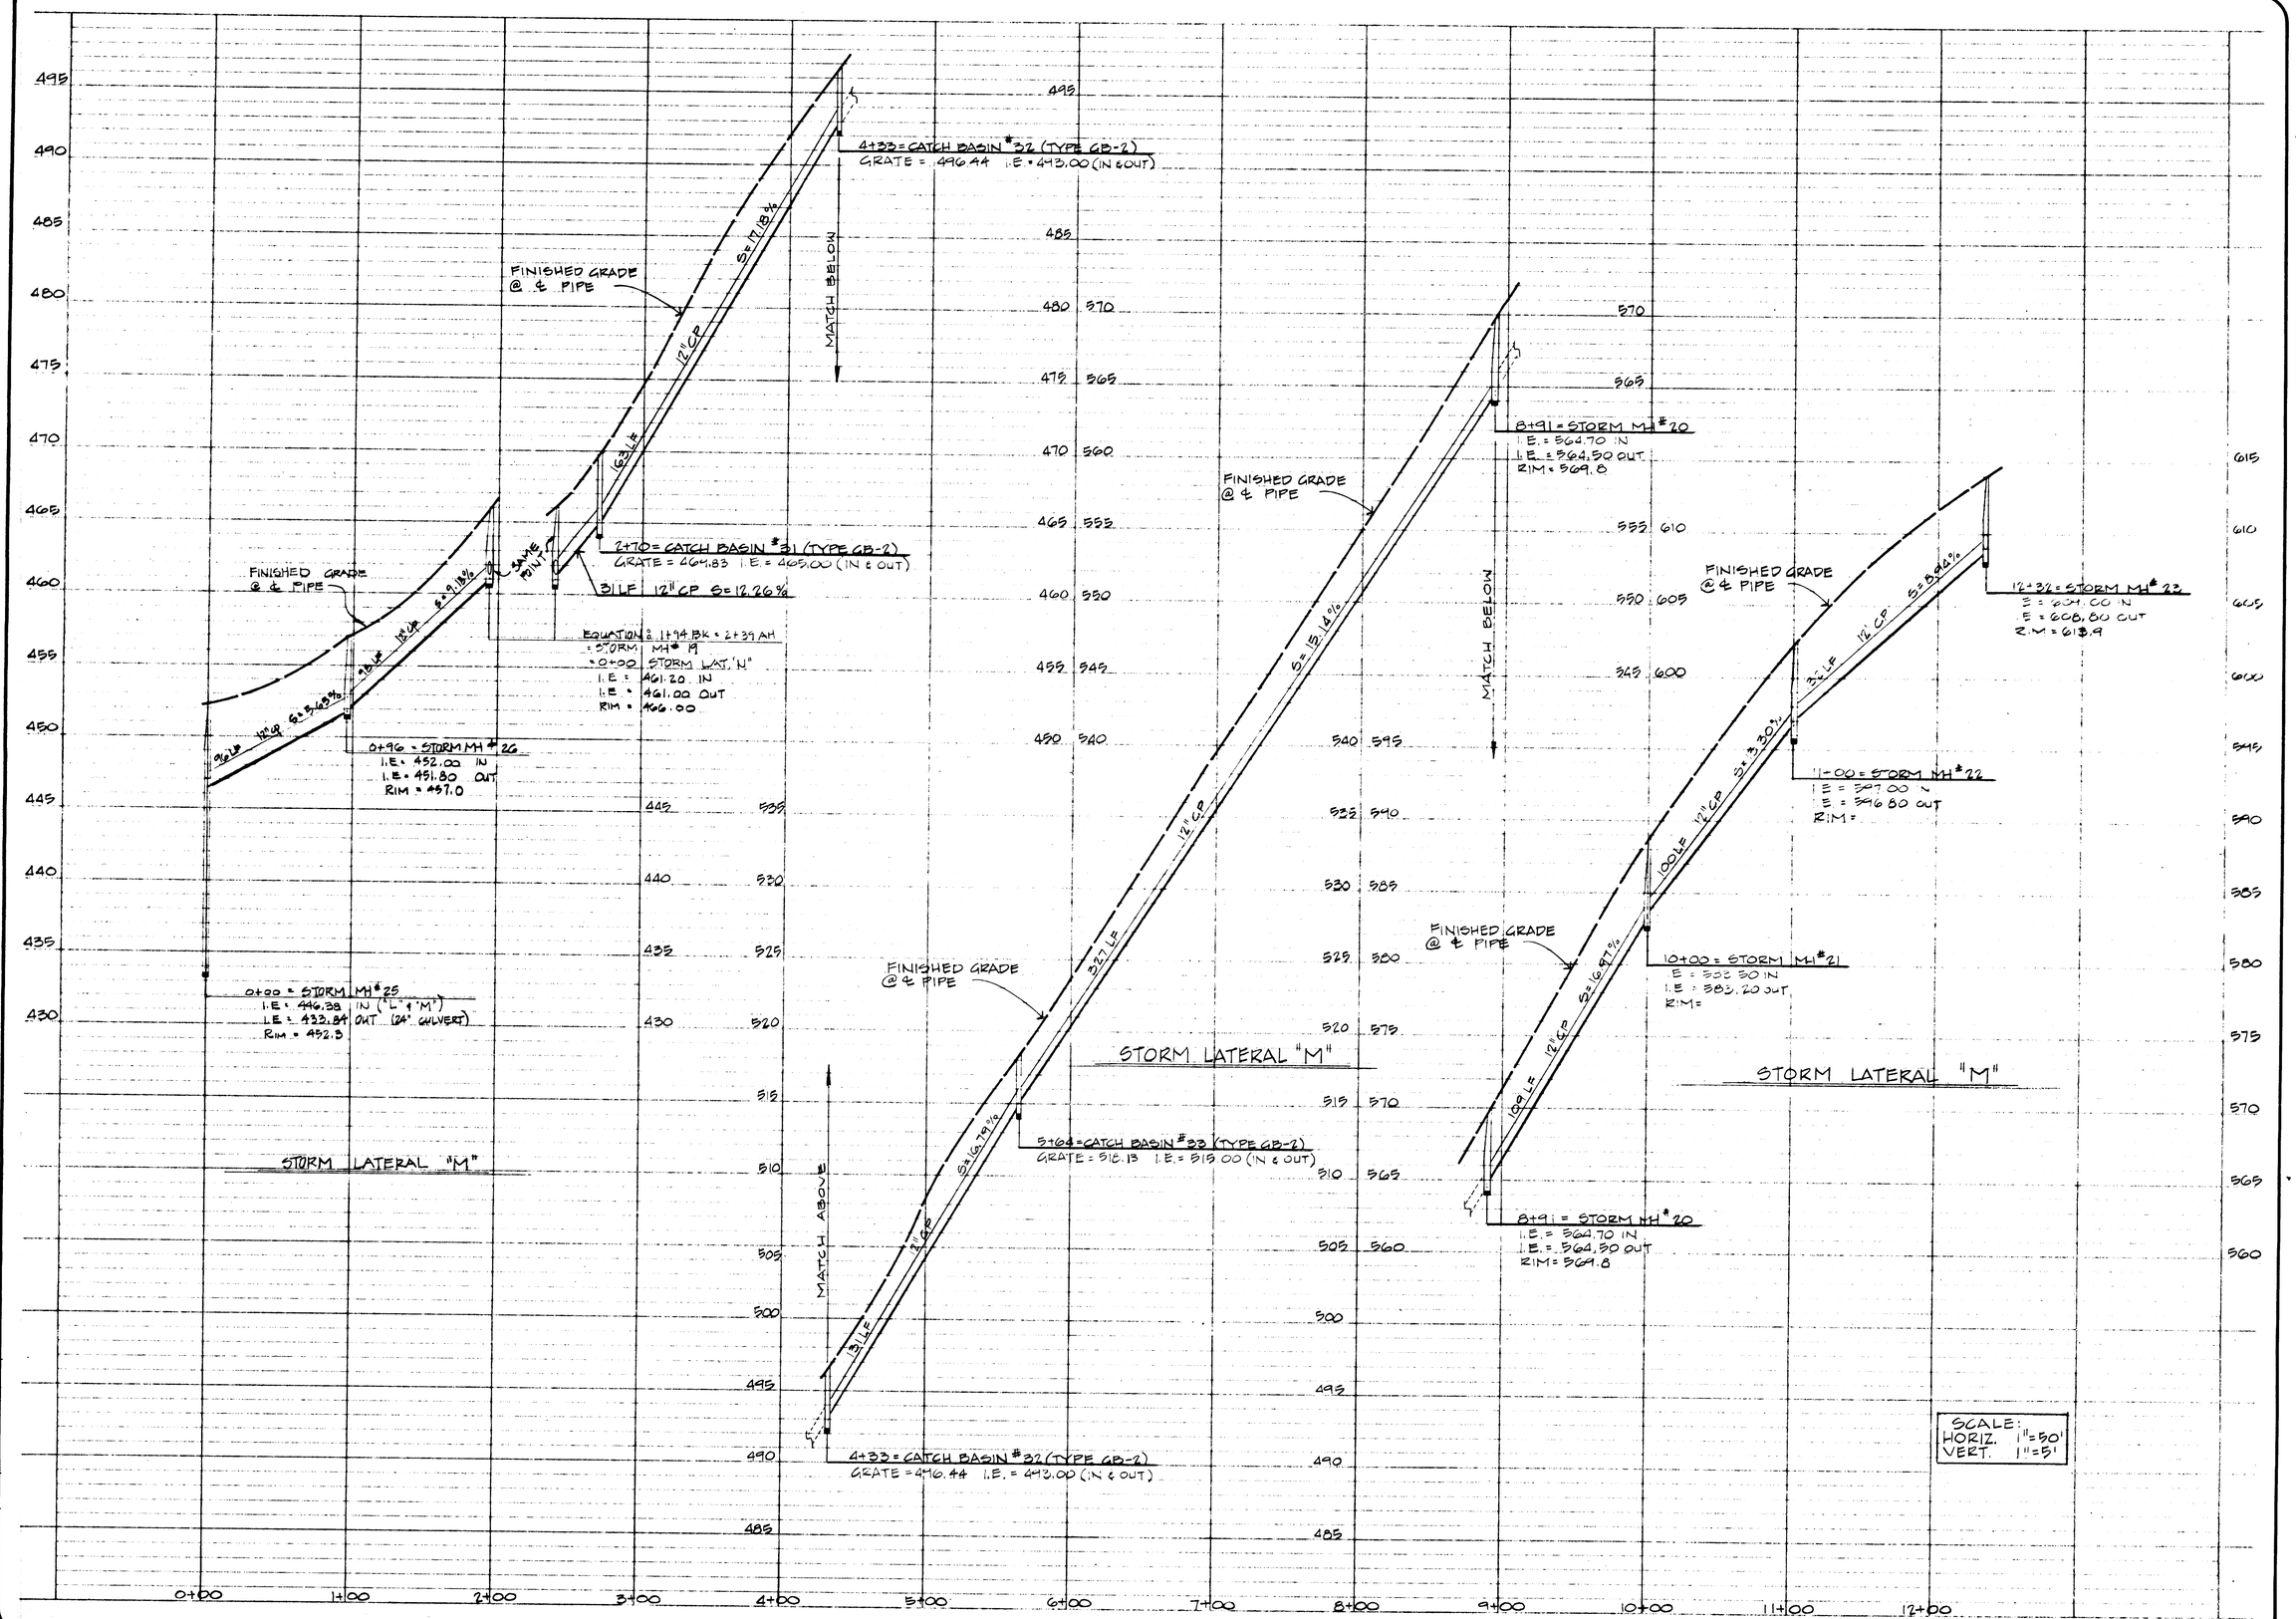

W&H WILSEY & HAM
Suite 4, Portland Center, 222 S.W. Harrison
Portland, Oregon 97201
503 227-0455

HIDDEN SPRINGS RANCH NO. 6
WEST LINN, OREGON

STORM SEWER PROFILES

BEAVERTON, OREGON

EDWARDS INDUSTRIES, INC.

10-79 REV PER CITY OF WEST LINN RJP

SHEET NO. 15/25
DESIGN JUNE 1979 BY RJP
DRAWN JUNE 1979 BY CD
CHECKED ____ BY ____
FILE NO. 4-1100-7401

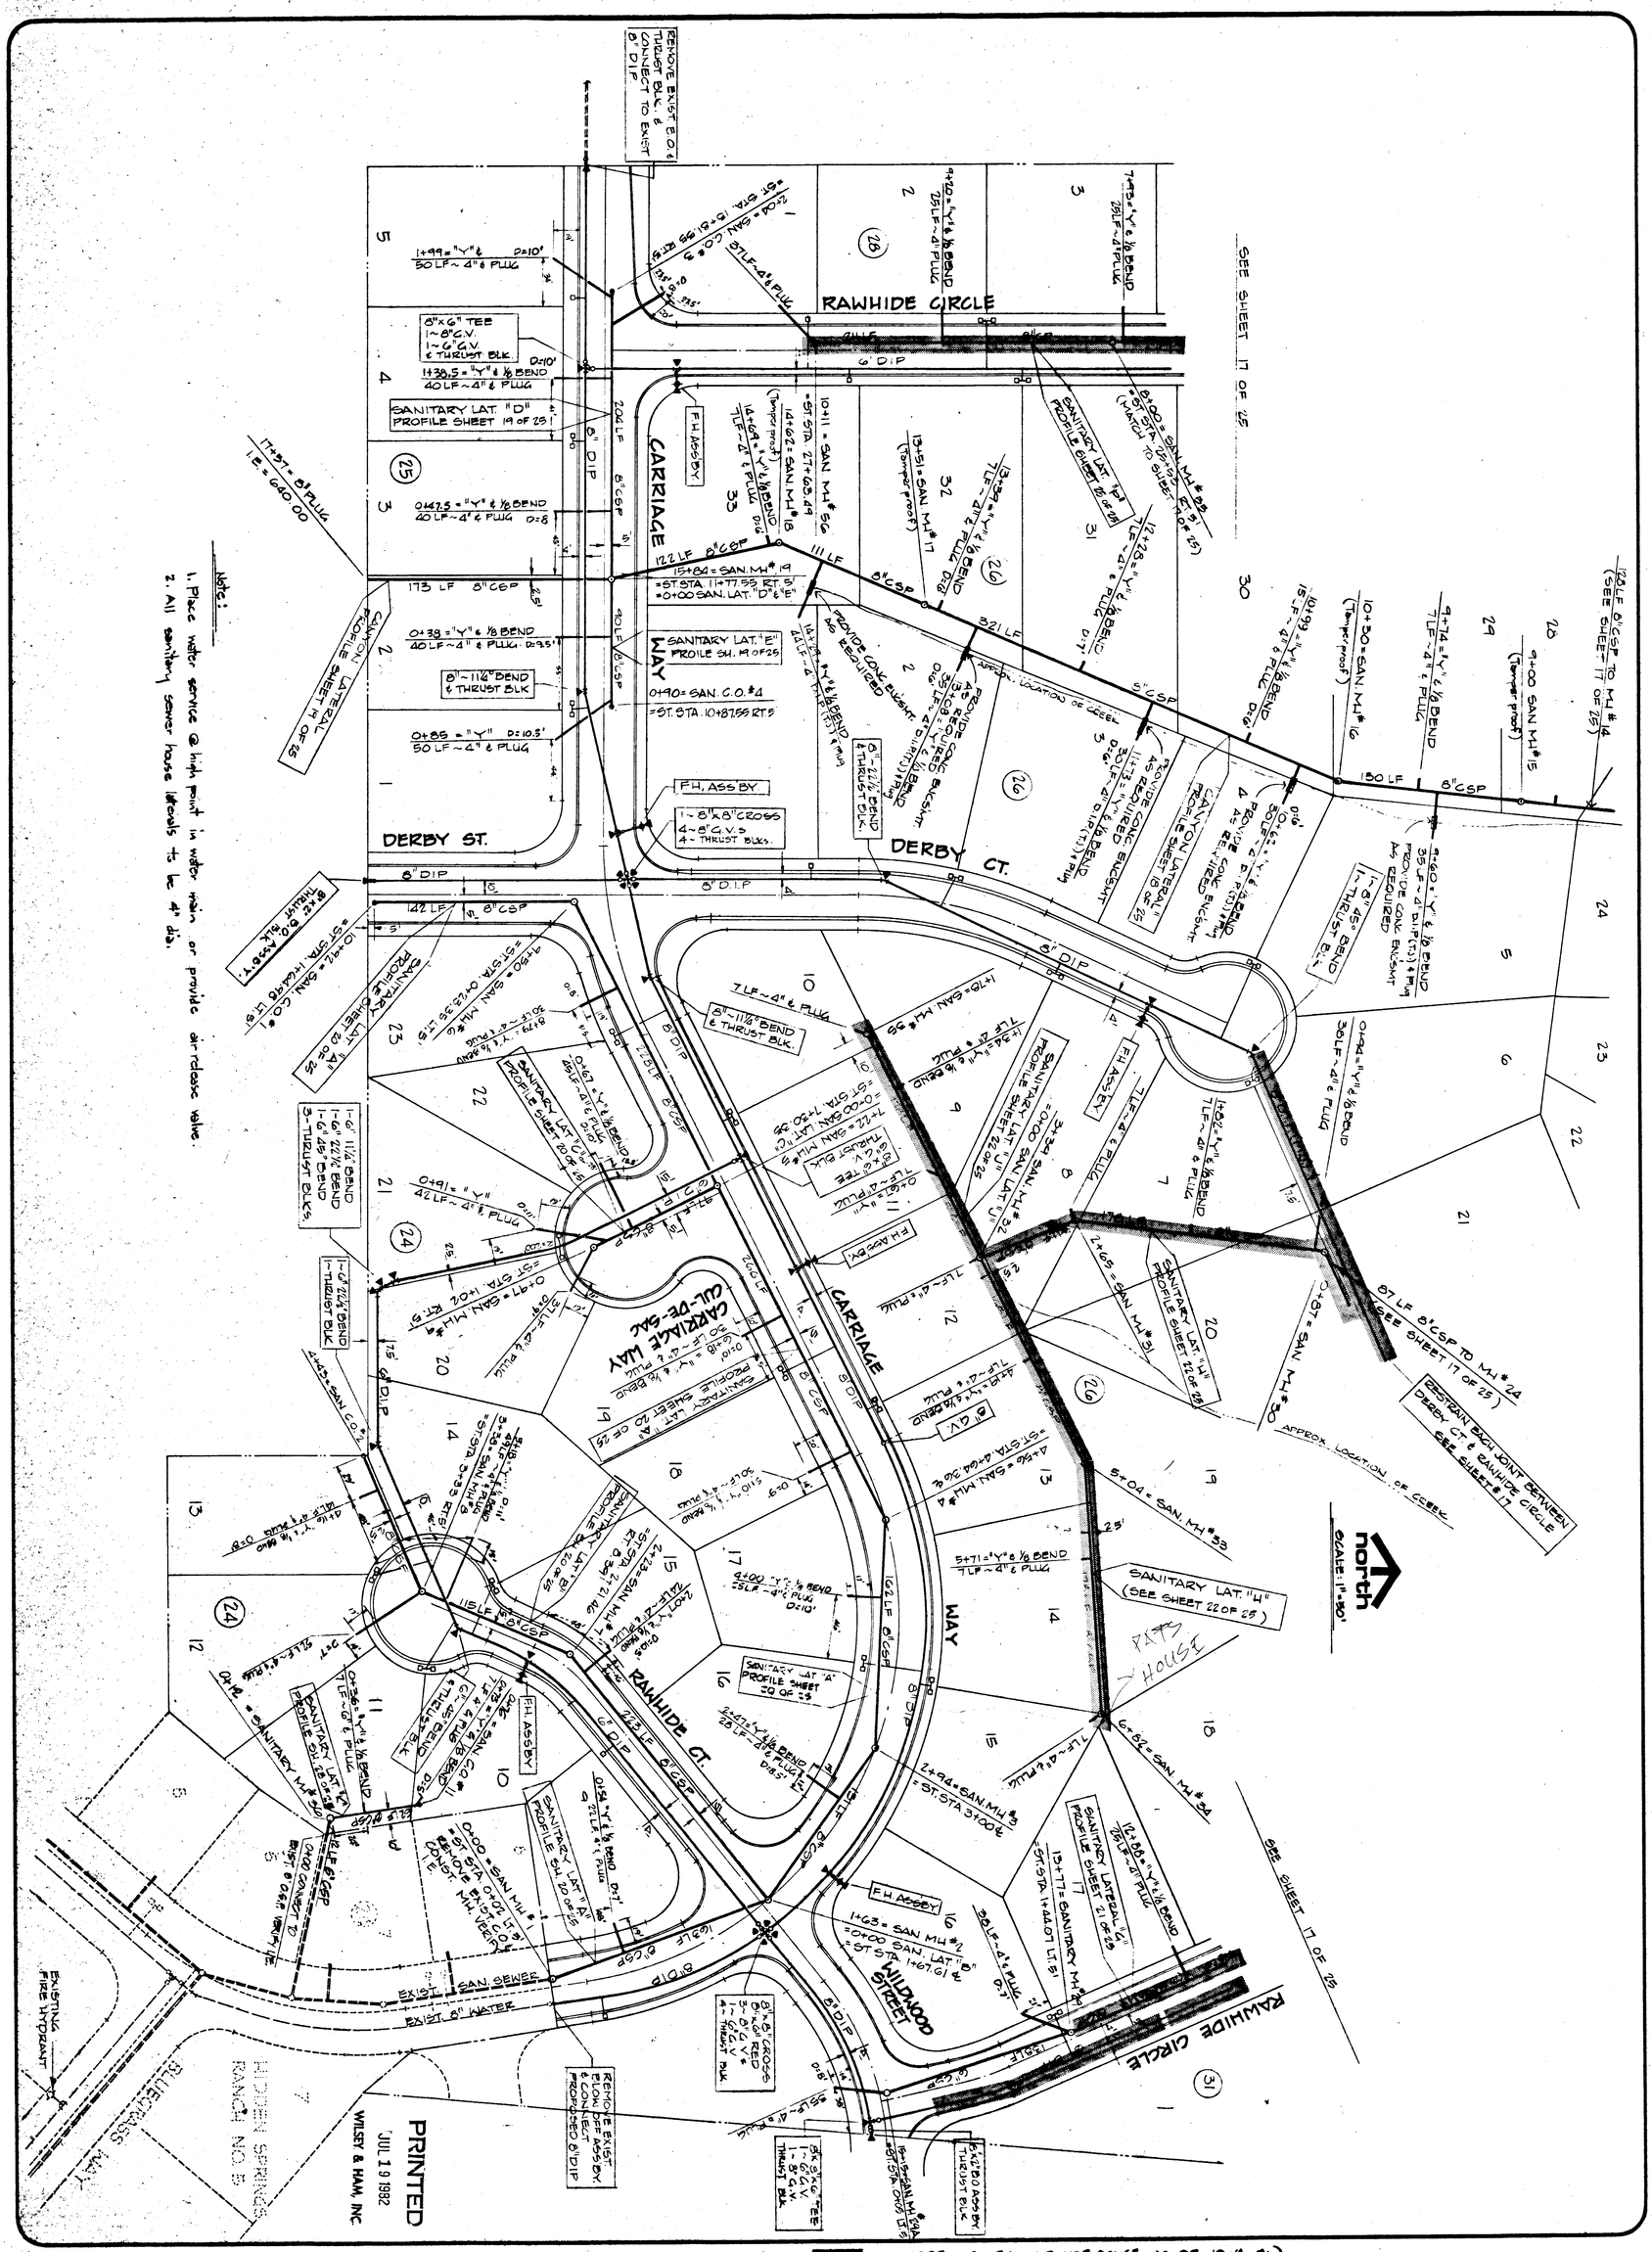

Note:
1. Place water service @ high point in water main or provide air release valve.
2. All sanitary sewer house laterals to be 4" dia.

PRINTED JUL 19 1982
WILSEY & HAM, INC.

9/80 RDA SAN. LAT. K
6/79 REV. PER CITY OF WEST LINN RJP

AS-BUILT 10-8-81 (NOTE: ▬ INDICATES UTILITY LINE NOT CONST. AS OF 10-8-81)

SHEET NO. 16/25
DESIGN JUNE 1979 BY RJP
DRAWN JUNE 1979 BY CB
CHECKED ____ BY ____
FILE NO. 4-1100-7401

HIDDEN SPRINGS RANCH NO. 6

WEST LINN, OREGON

SANITARY & WATER PLAN

EDWARDS INDUSTRIES, INC. BEAVERTON, OREGON

W&H WILSEY & HAM
Suite 4, Portland Center, 222 S.W. Harrison
Portland, Oregon 97201 503 227-0455

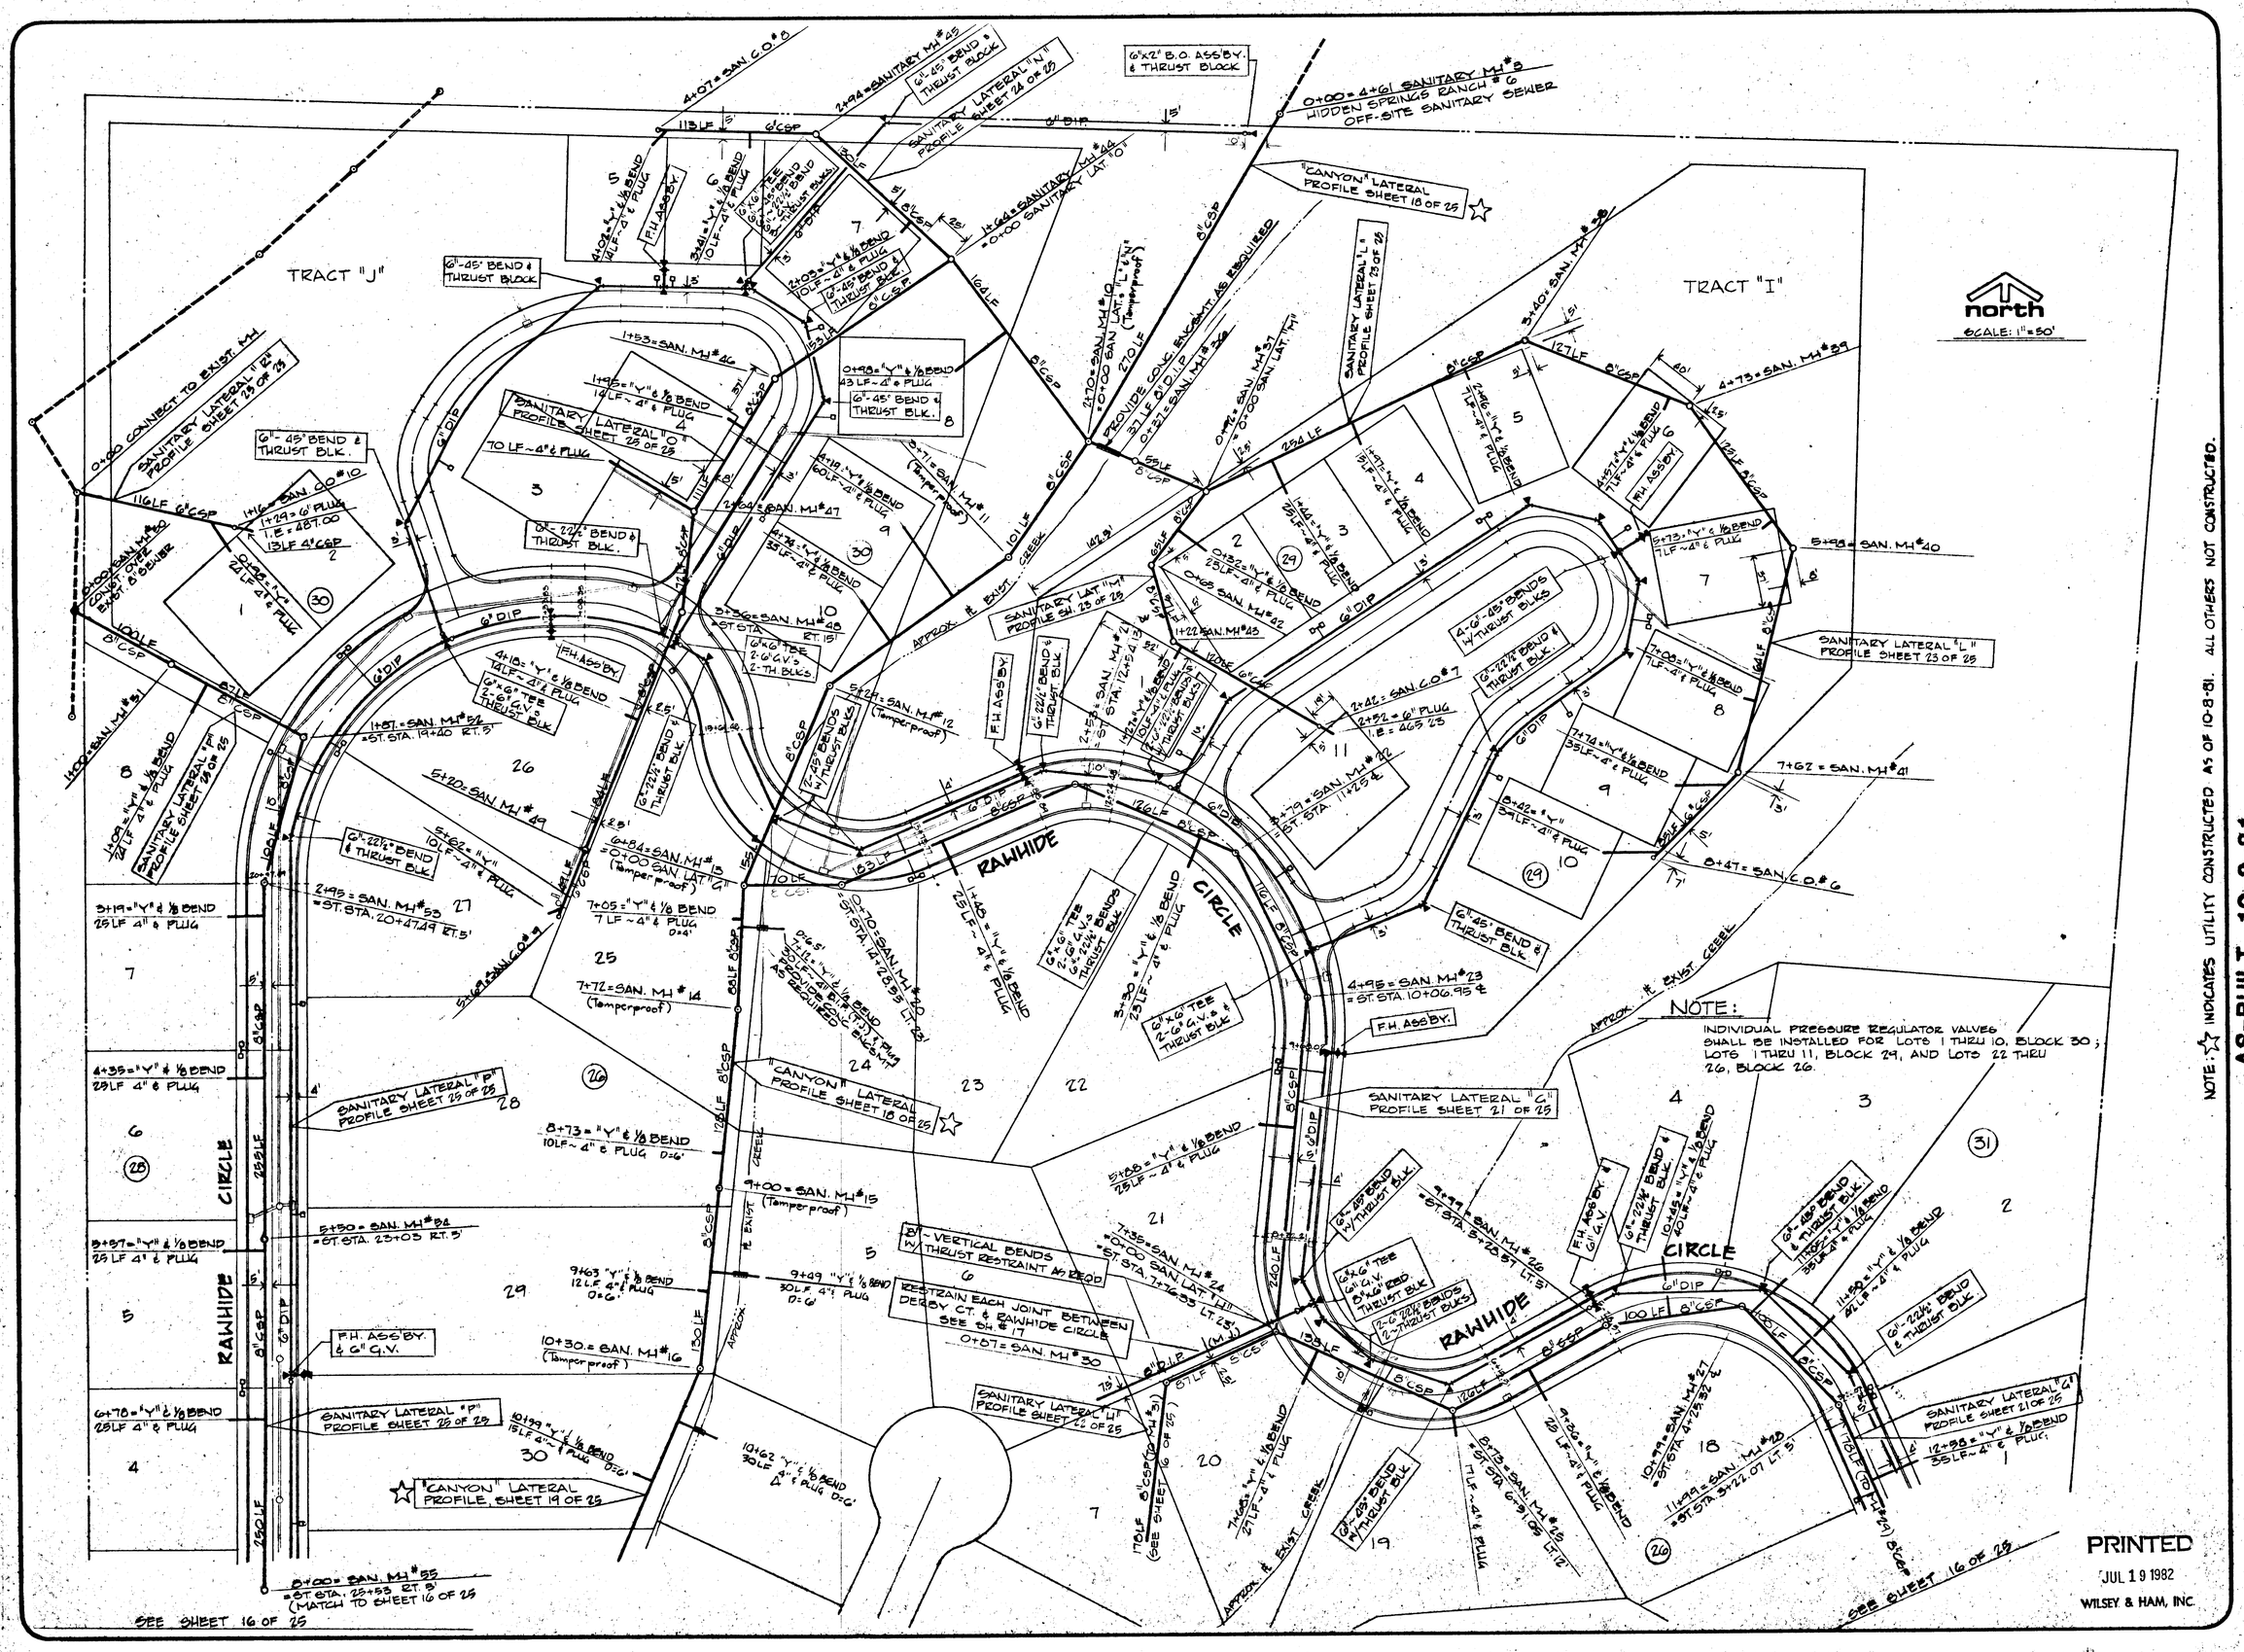

NOTE: ☆ INDICATES UTILITY CONSTRUCTED AS OF 10-8-81. ALL OTHERS NOT CONSTRUCTED.

AS-BUILT 10-8-81

HIDDEN SPRINGS RANCH NO. 6

WEST LINN, OREGON

SANITARY & WATER PLAN

EDWARDS INDUSTRIES, INC. BEAVERTON, OREGON

W&H WILSEY & HAM
Suite 4, Portland Center, 222 S.W. Harrison
Portland, Oregon 97201 503 227-0455

SHEET NO. 17/25

DESIGN JUNE 1979 BY RLP
DRAWN JUNE 1979 BY RLP
CHECKED BY
FILE NO. 4100-1461

8/7/79 REV. PER CITY OF WEST LINN RLP

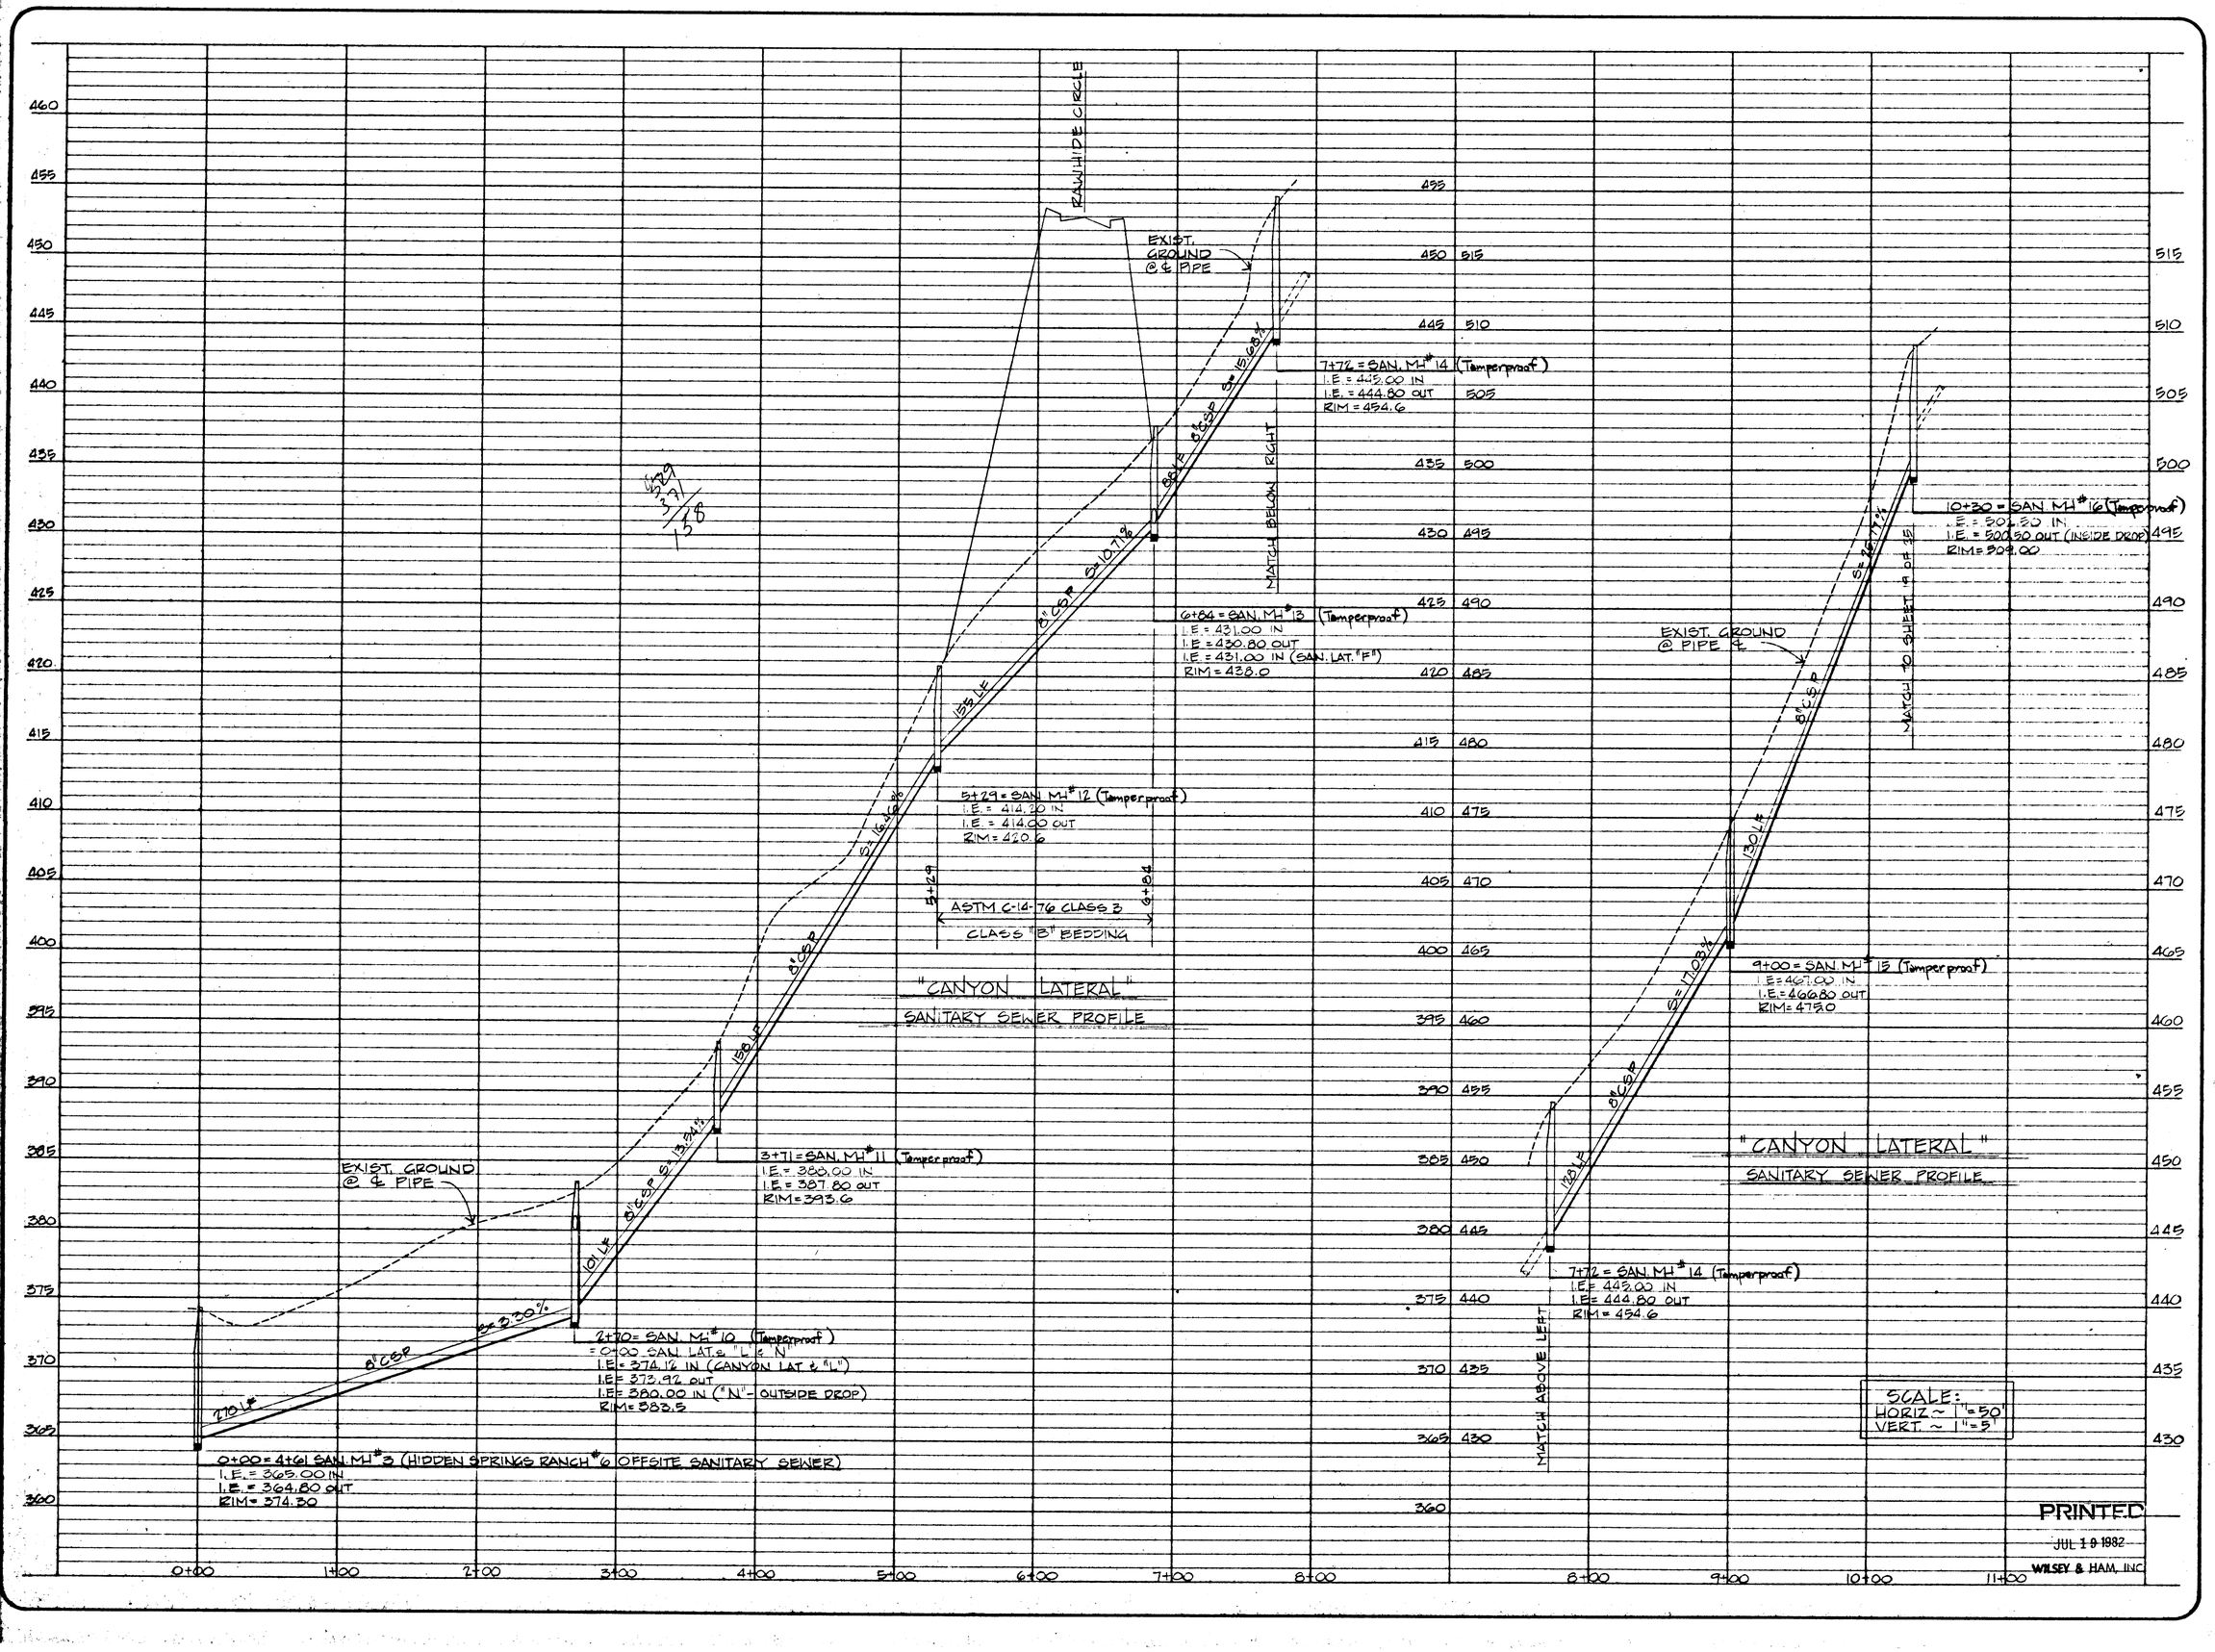

W&H WILSEY & HAM
Suite 4, Portland Center, 222 S.W. Harrison
Portland, Oregon 97201 503 227-0455

HIDDEN SPRINGS RANCH NO. 6
OREGON
WEST LINN,
SANITARY SEWER PROFILE
BEAVERTON, OREGON
EDWARDS INDUSTRIES, INC.

REGISTERED PROFESSIONAL ENGINEER
JERRY M. PAYNE
OREGON

1974 Rev. Per City of West Linn BJP

SHEET NO. 18/25
DESIGN JUNE 1979 BY BJP
DRAWN JUNE 1974 BY GB
CHECKED ____ BY ____
FILE NO. 4-1100-7401

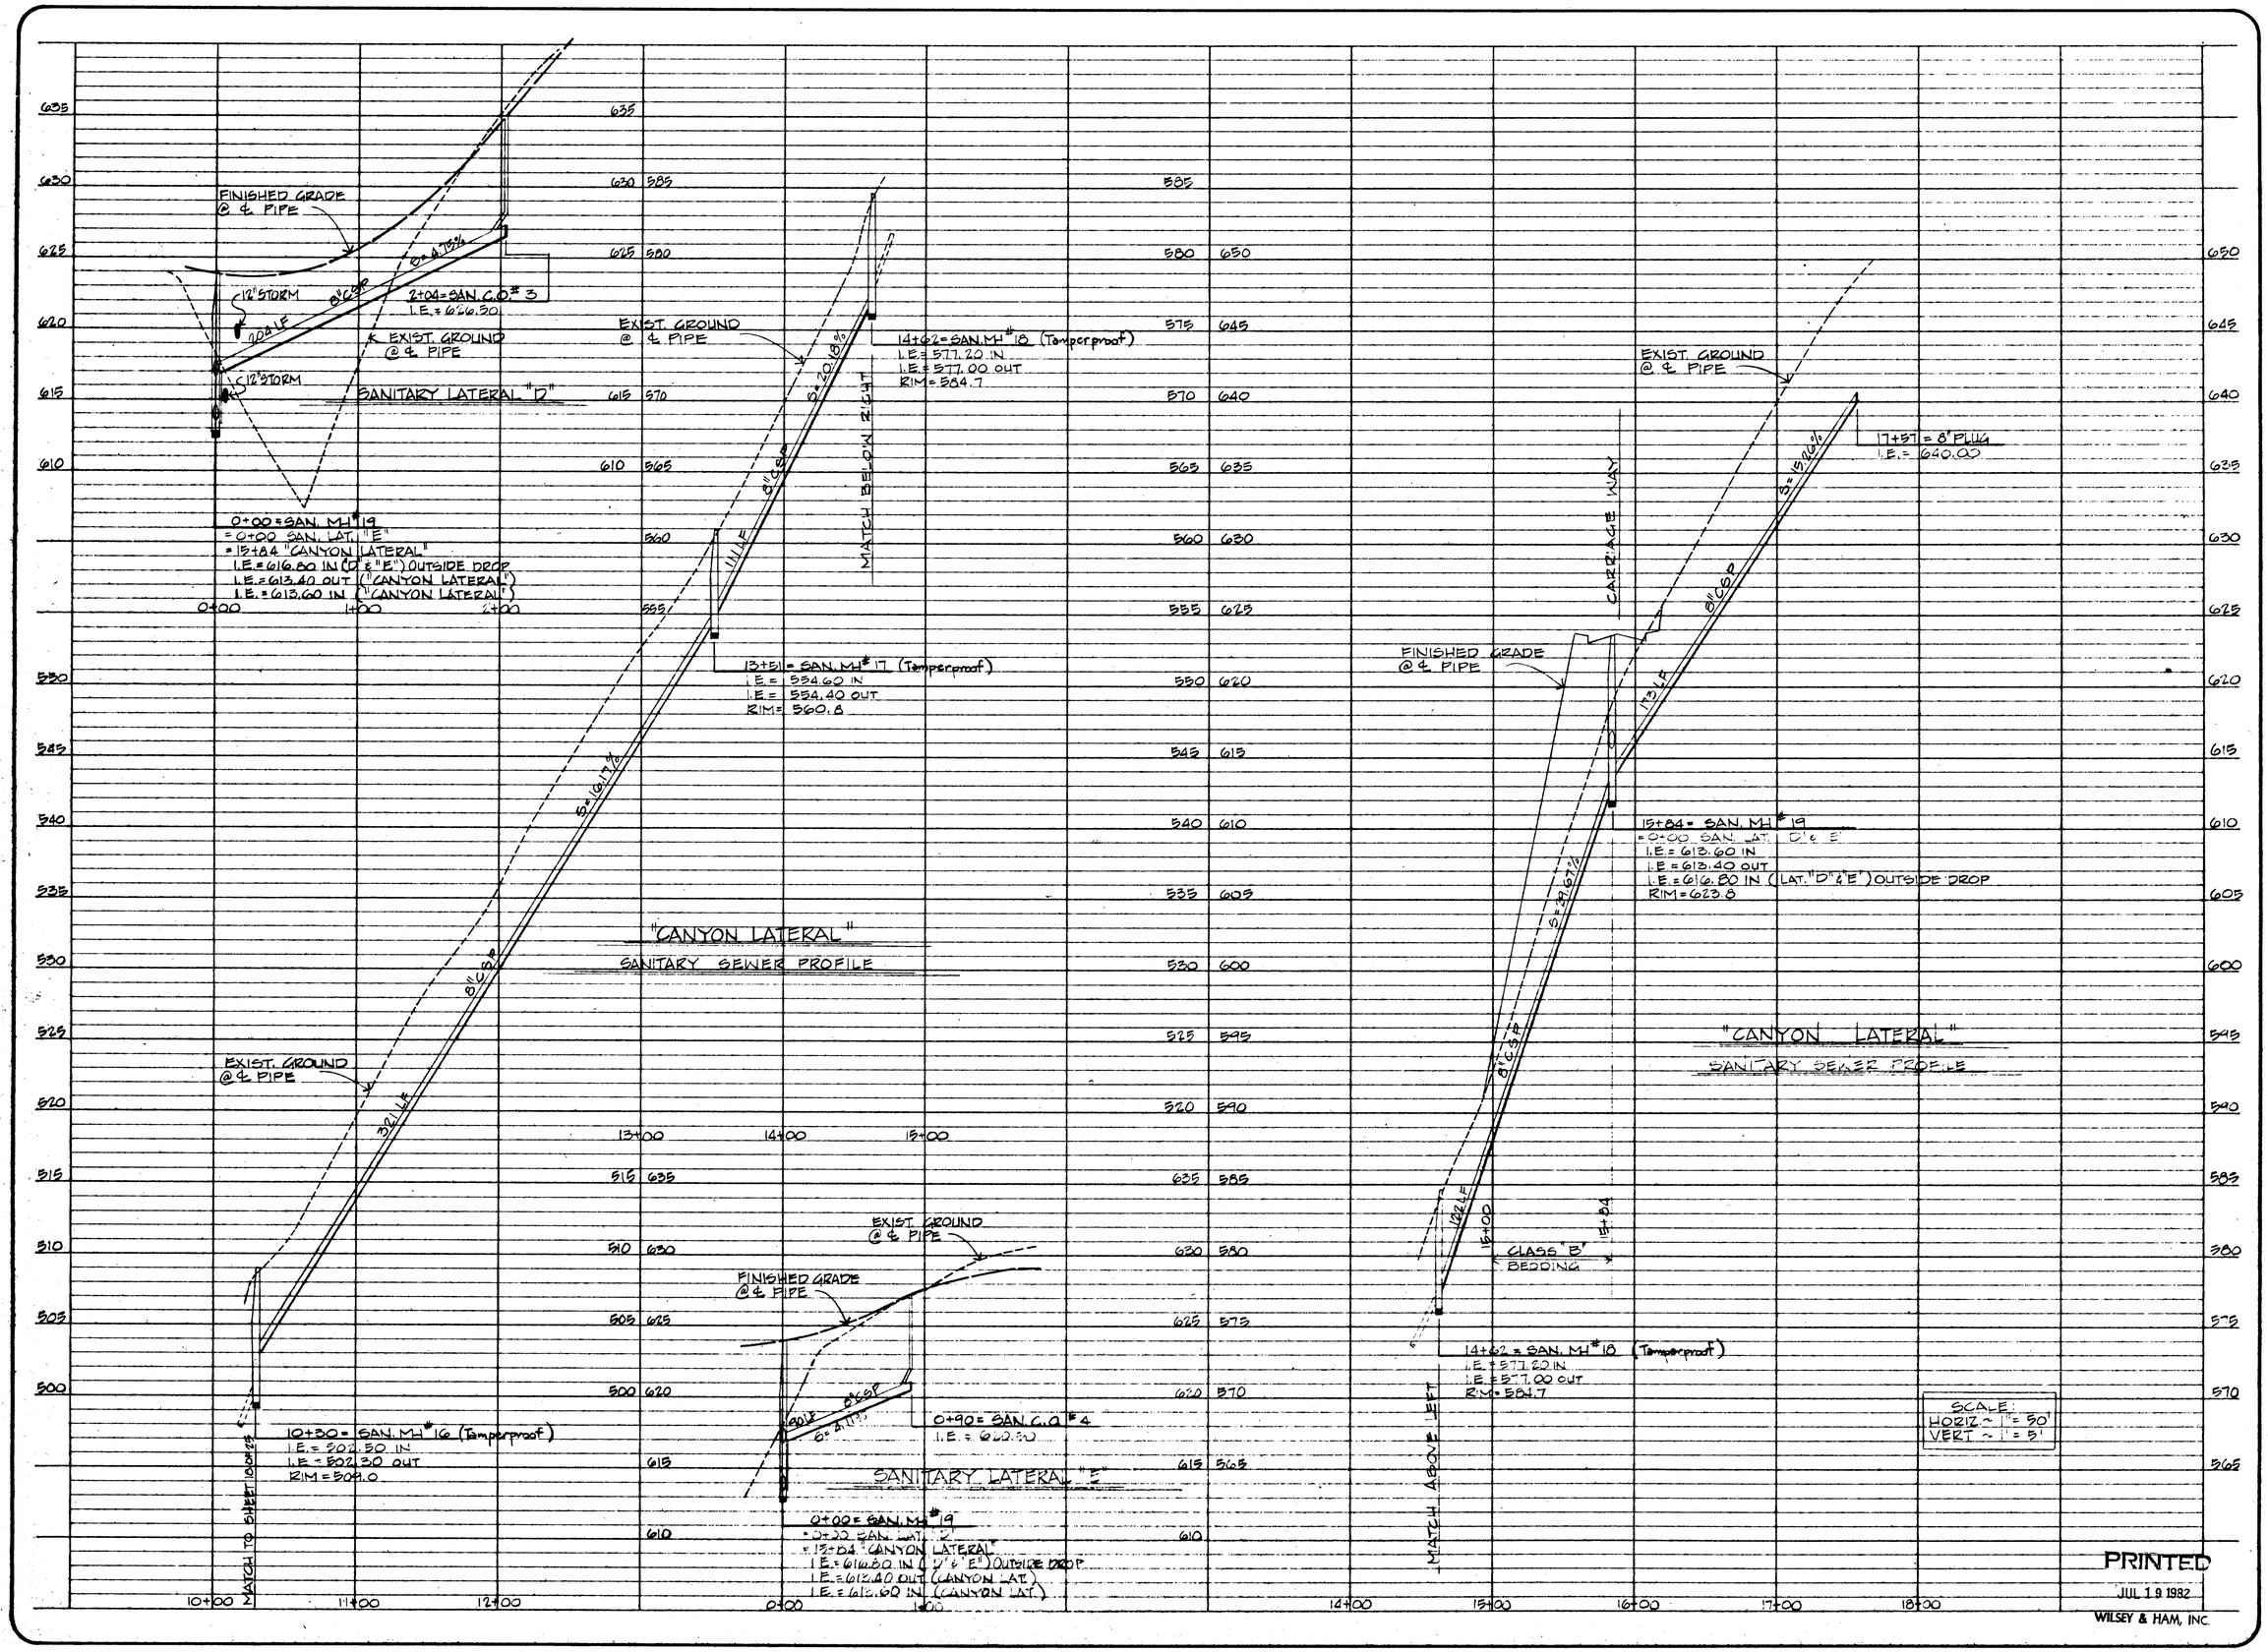

W&H WILSEY & HAM
Suite 4, Portland Center, 222 S.W. Harrison
Portland, Oregon 97201 503 227-0455

HIDDEN SPRINGS RANCH NO. 6
WEST LINN, OREGON
SANITARY SEWER PROFILES
EDWARDS INDUSTRIES, INC. BEAVERTON, OREGON

REGISTERED PROFESSIONAL ENGINEER 5949 OREGON JUL 30, 1979 JERRY M. PALMER

10/79 REV. PER CITY OF WEST LINN RJP

SHEET NO. 19/25
DESIGN JUNE 1979 BY RJP
DRAWN JUNE 1979 BY CB
CHECKED BY
FILE NO. 41100-7401

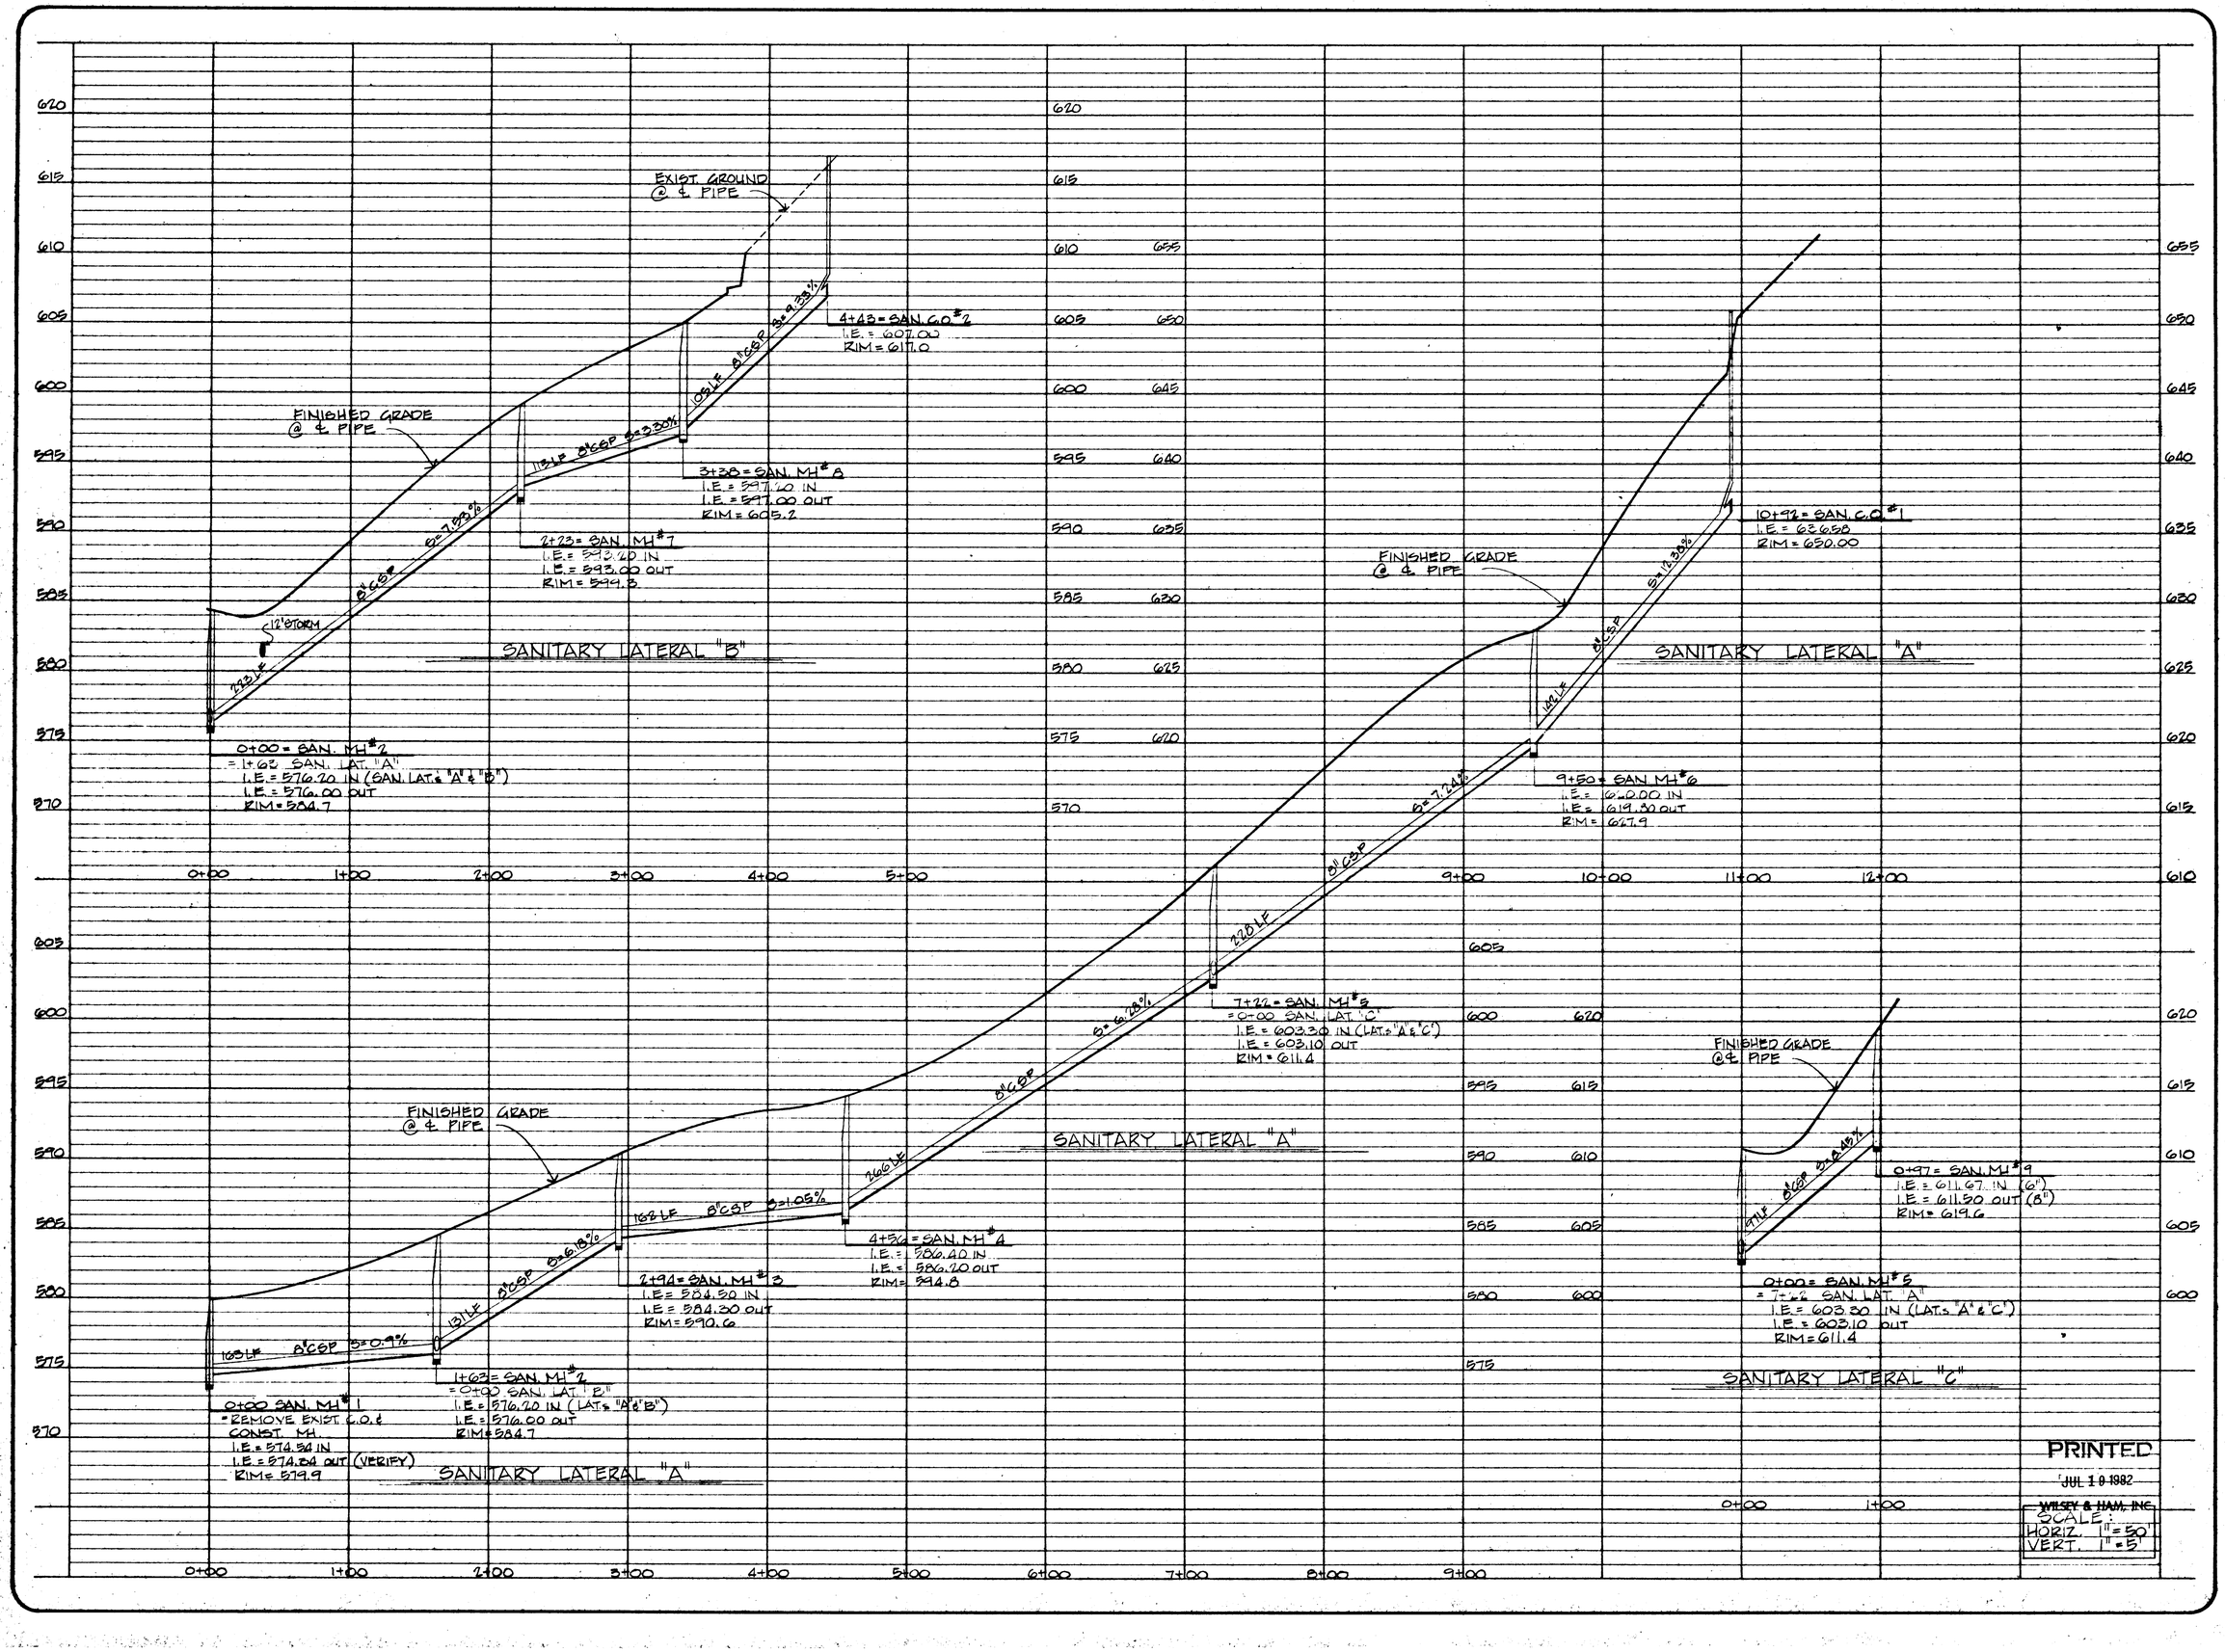

W&H WILSEY & HAM
Suite 4, Portland Center, 222 S.W. Harrison
Portland, Oregon 97201 503 227-0455

HIDDEN SPRINGS RANCH NO. 6
WEST LINN, OREGON
SANITARY SEWER PROFILES
BEAVERTON, OREGON
EDWARDS INDUSTRIES, INC.

REGISTERED PROFESSIONAL ENGINEER 8628 JERRY M. HAM OREGON JULY 20, 1982

SHEET NO. 20/25
DESIGN JUNE 1979 BY RJP
DRAWN JUNE 1979 BY GB
CHECKED BY
FILE NO. 4-1100-7401

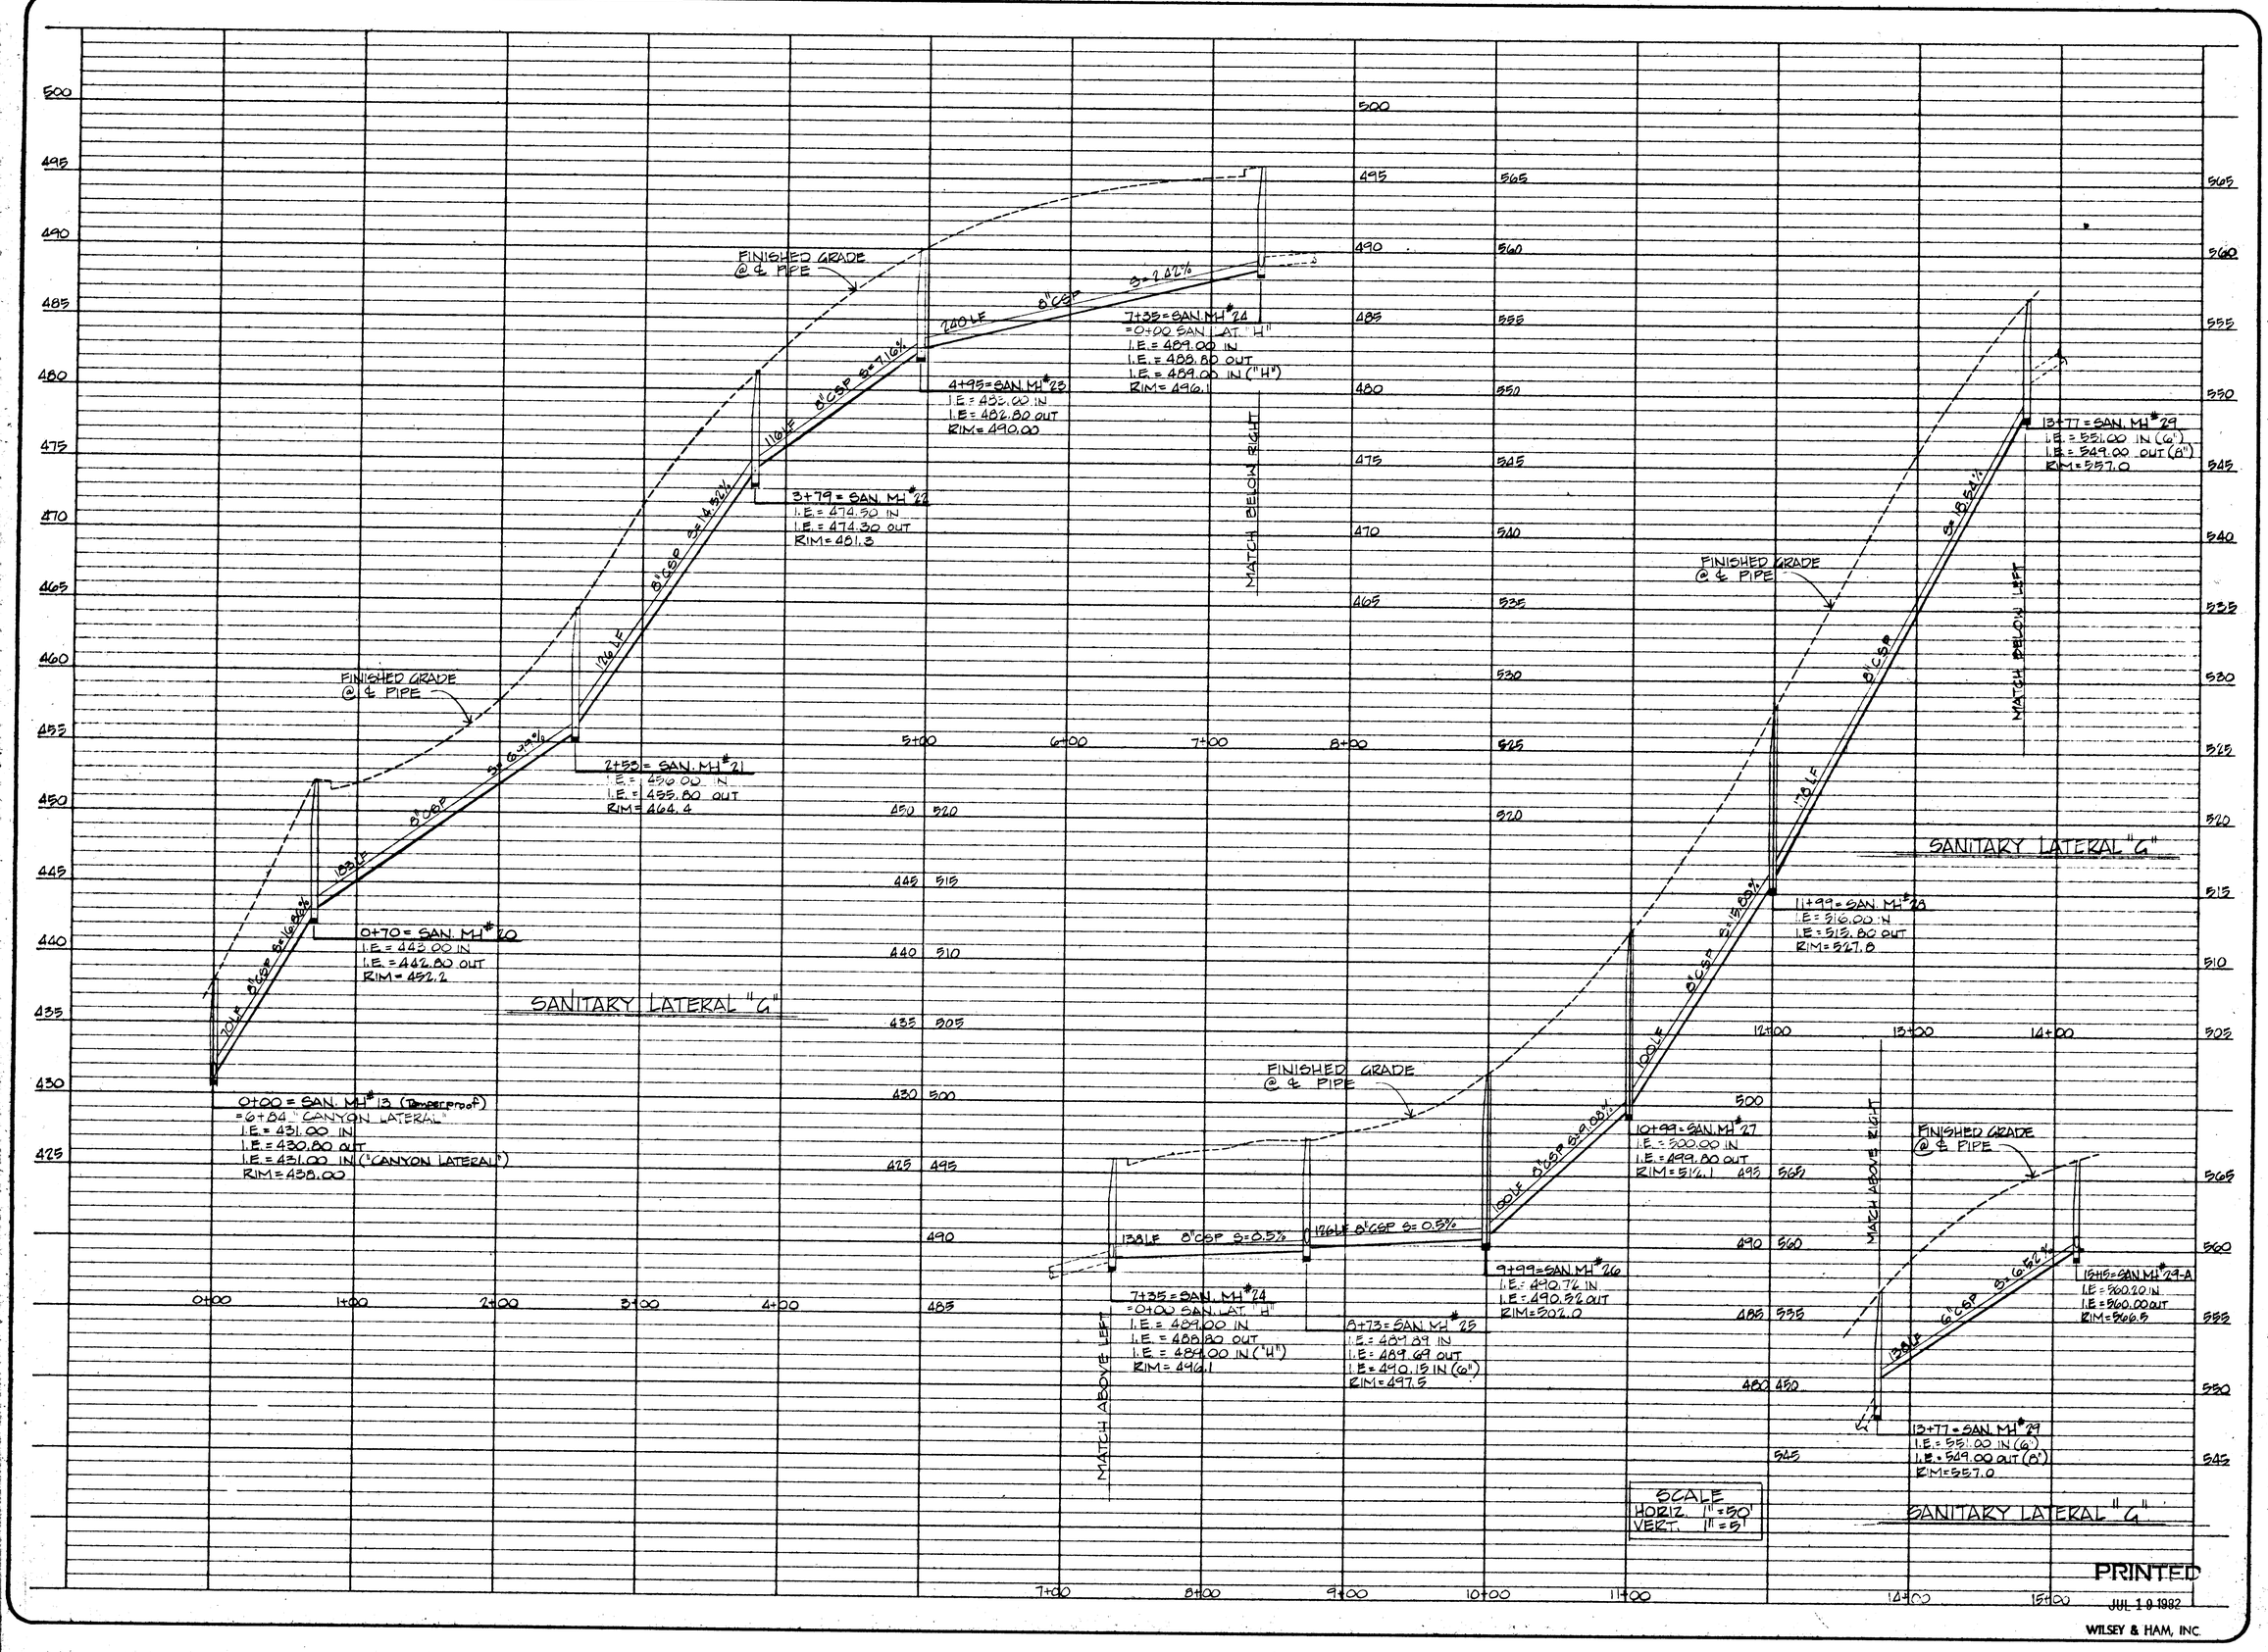

W&H WILSEY & HAM
Suite 4, Portland Center, 222 S.W. Harrison
Portland, Oregon 97201 503 227-0455

HIDDEN SPRINGS RANCH NO. 6
WEST LINN, OREGON
SANITARY SEWER PROFILE
EDWARDS INDUSTRIES, INC.
BEAVERTON, OREGON

REGISTERED PROFESSIONAL ENGINEER 8979 OREGON JERRY M. PALMER

10/79 REV. PER CITY OF WEST LINN RJP

SHEET NO. 21/25
DESIGN JUNE 1979 BY RJP
DRAWN JUNE 1979 BY CB
CHECKED BY
FILE NO. 4-1100-7401

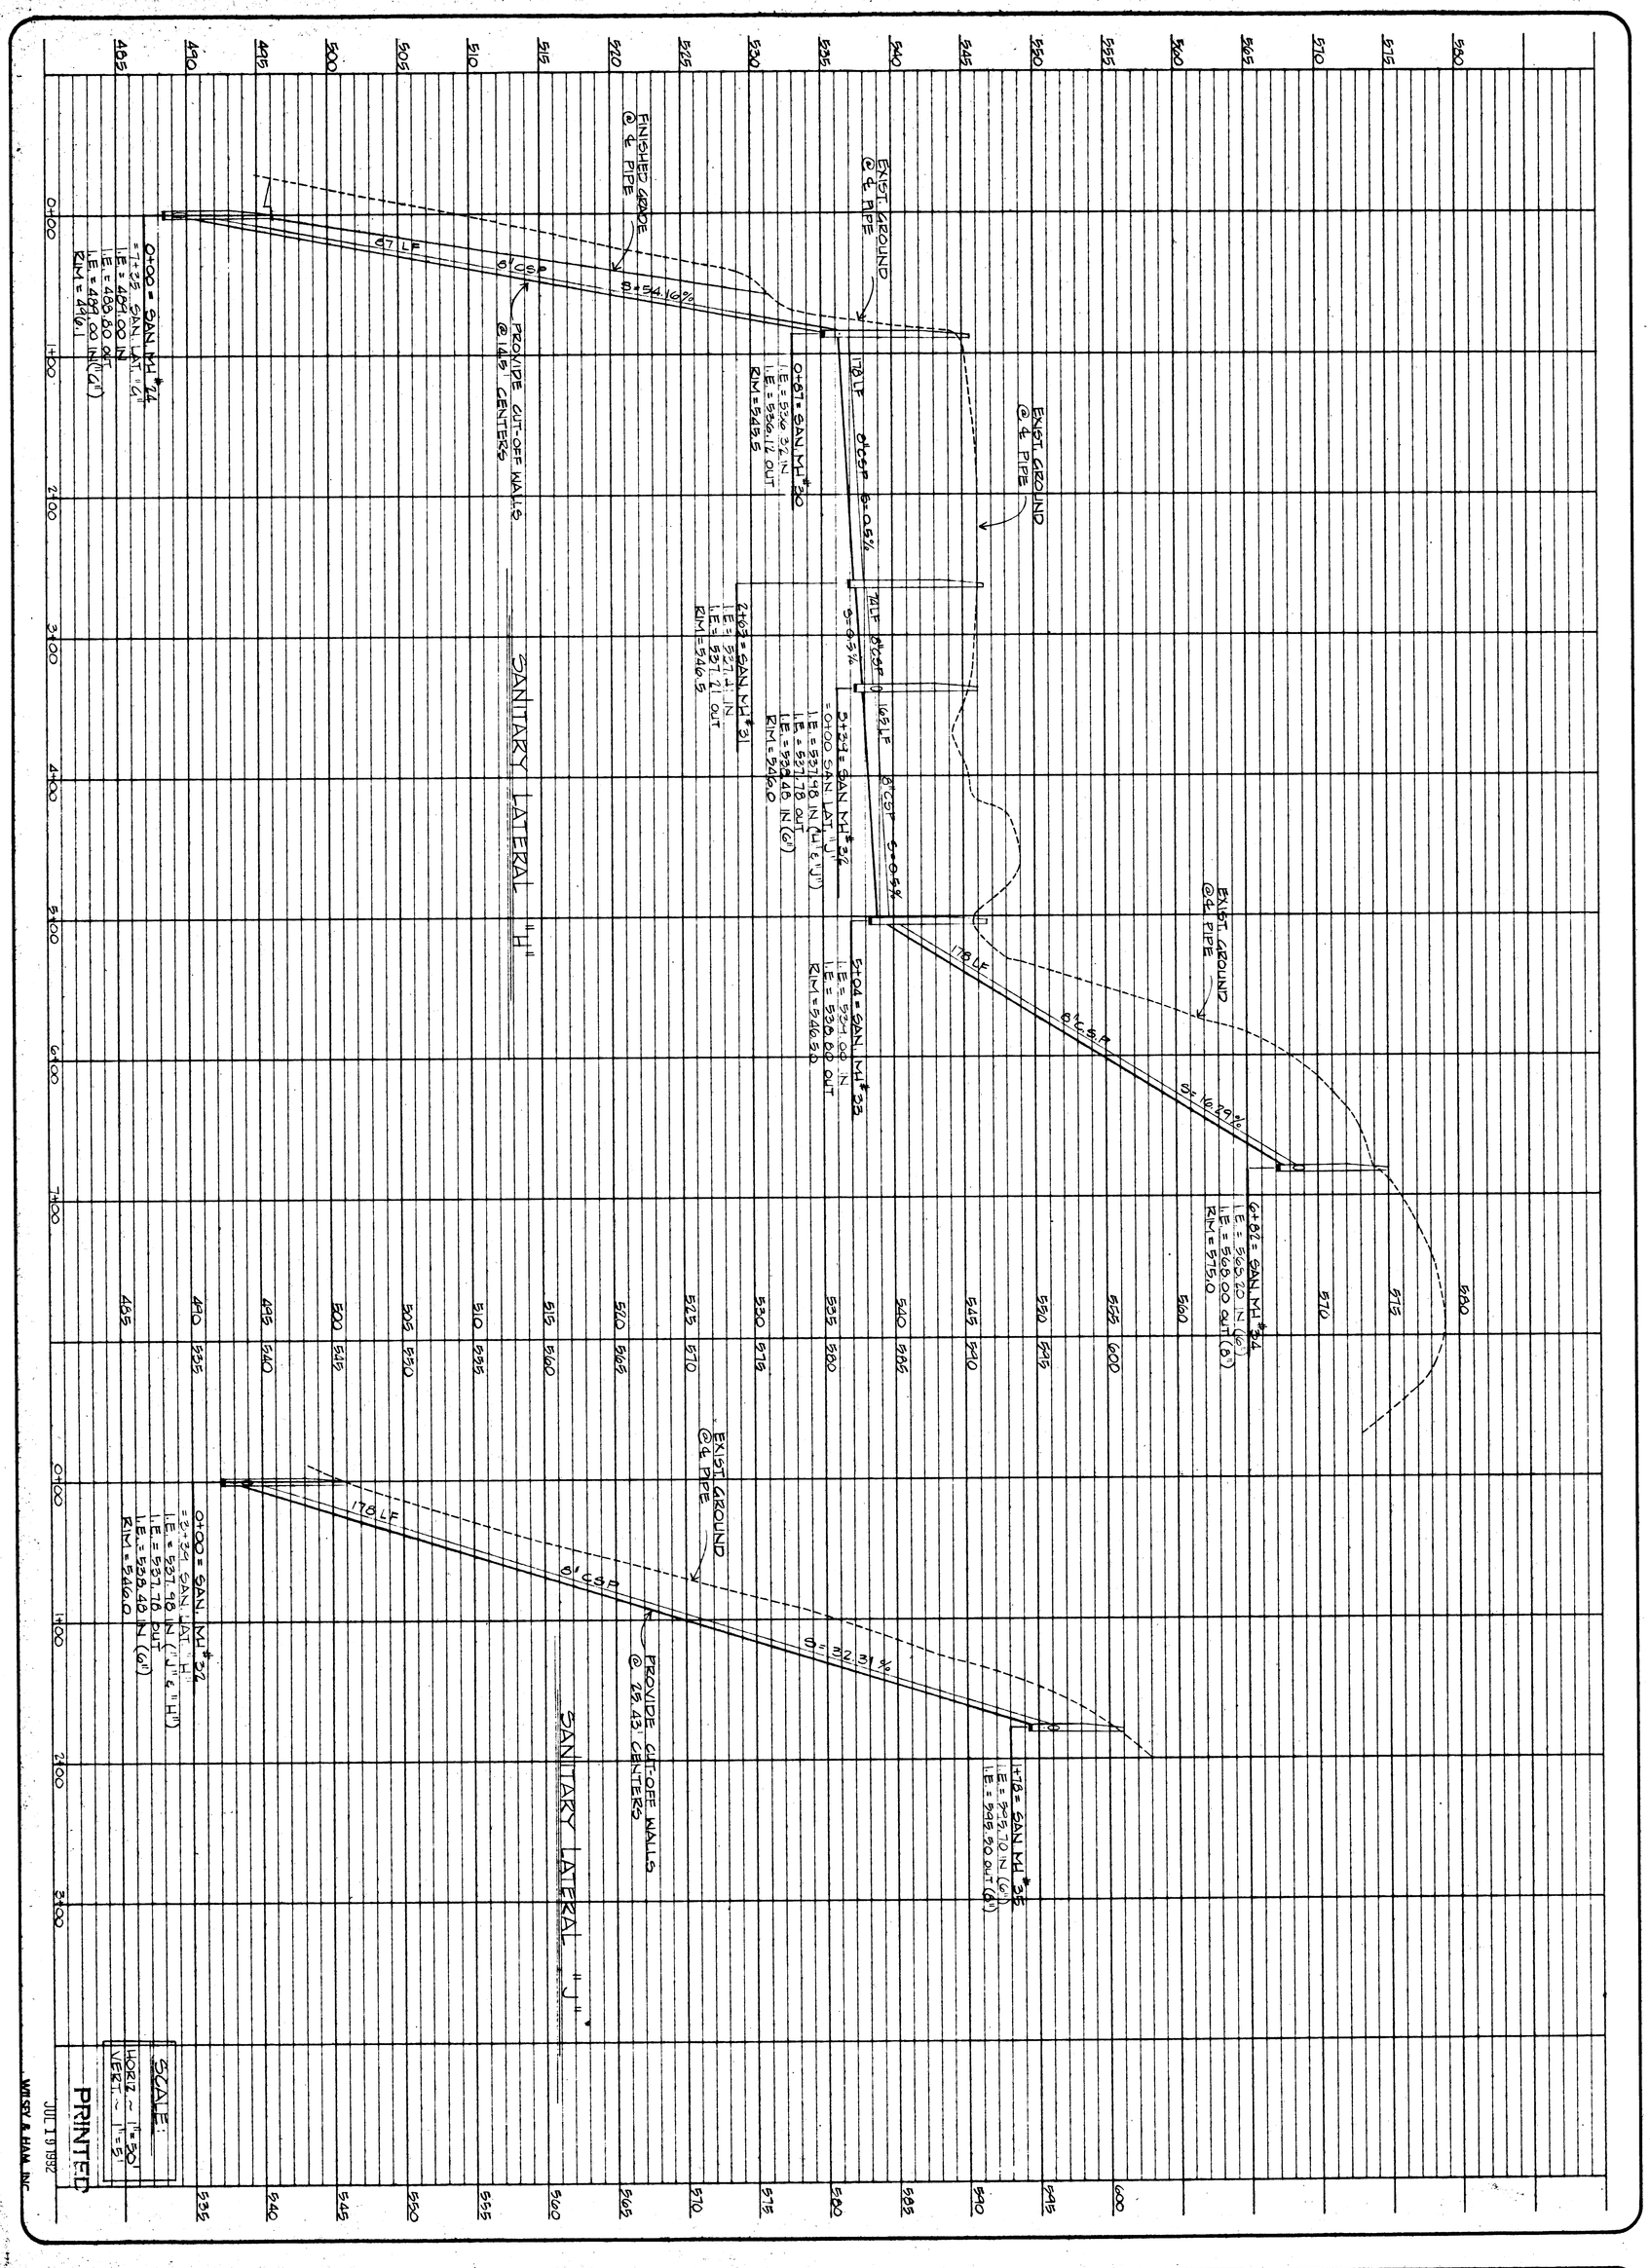

SHEET NO. 22/25

DESIGN JUNE 1979 BY RJP
DRAWN JUNE 1979 BY CB
CHECKED _____ BY _____
FILE NO. 4-1100-7401

REGISTERED PROFESSIONAL ENGINEER 8979 OREGON JAN 30, 1976 JERRY M. PALMER

HIDDEN SPRINGS RANCH NO. 6

WEST LINN, OREGON

SANITARY SEWER PROFILE

EDWARDS INDUSTRIES, INC. BEAVERTON, OREGON

W&H WILSEY & HAM

Suite 4, Portland Center, 222 S.W. Harrison
Portland, Oregon 97201 503 227-0455

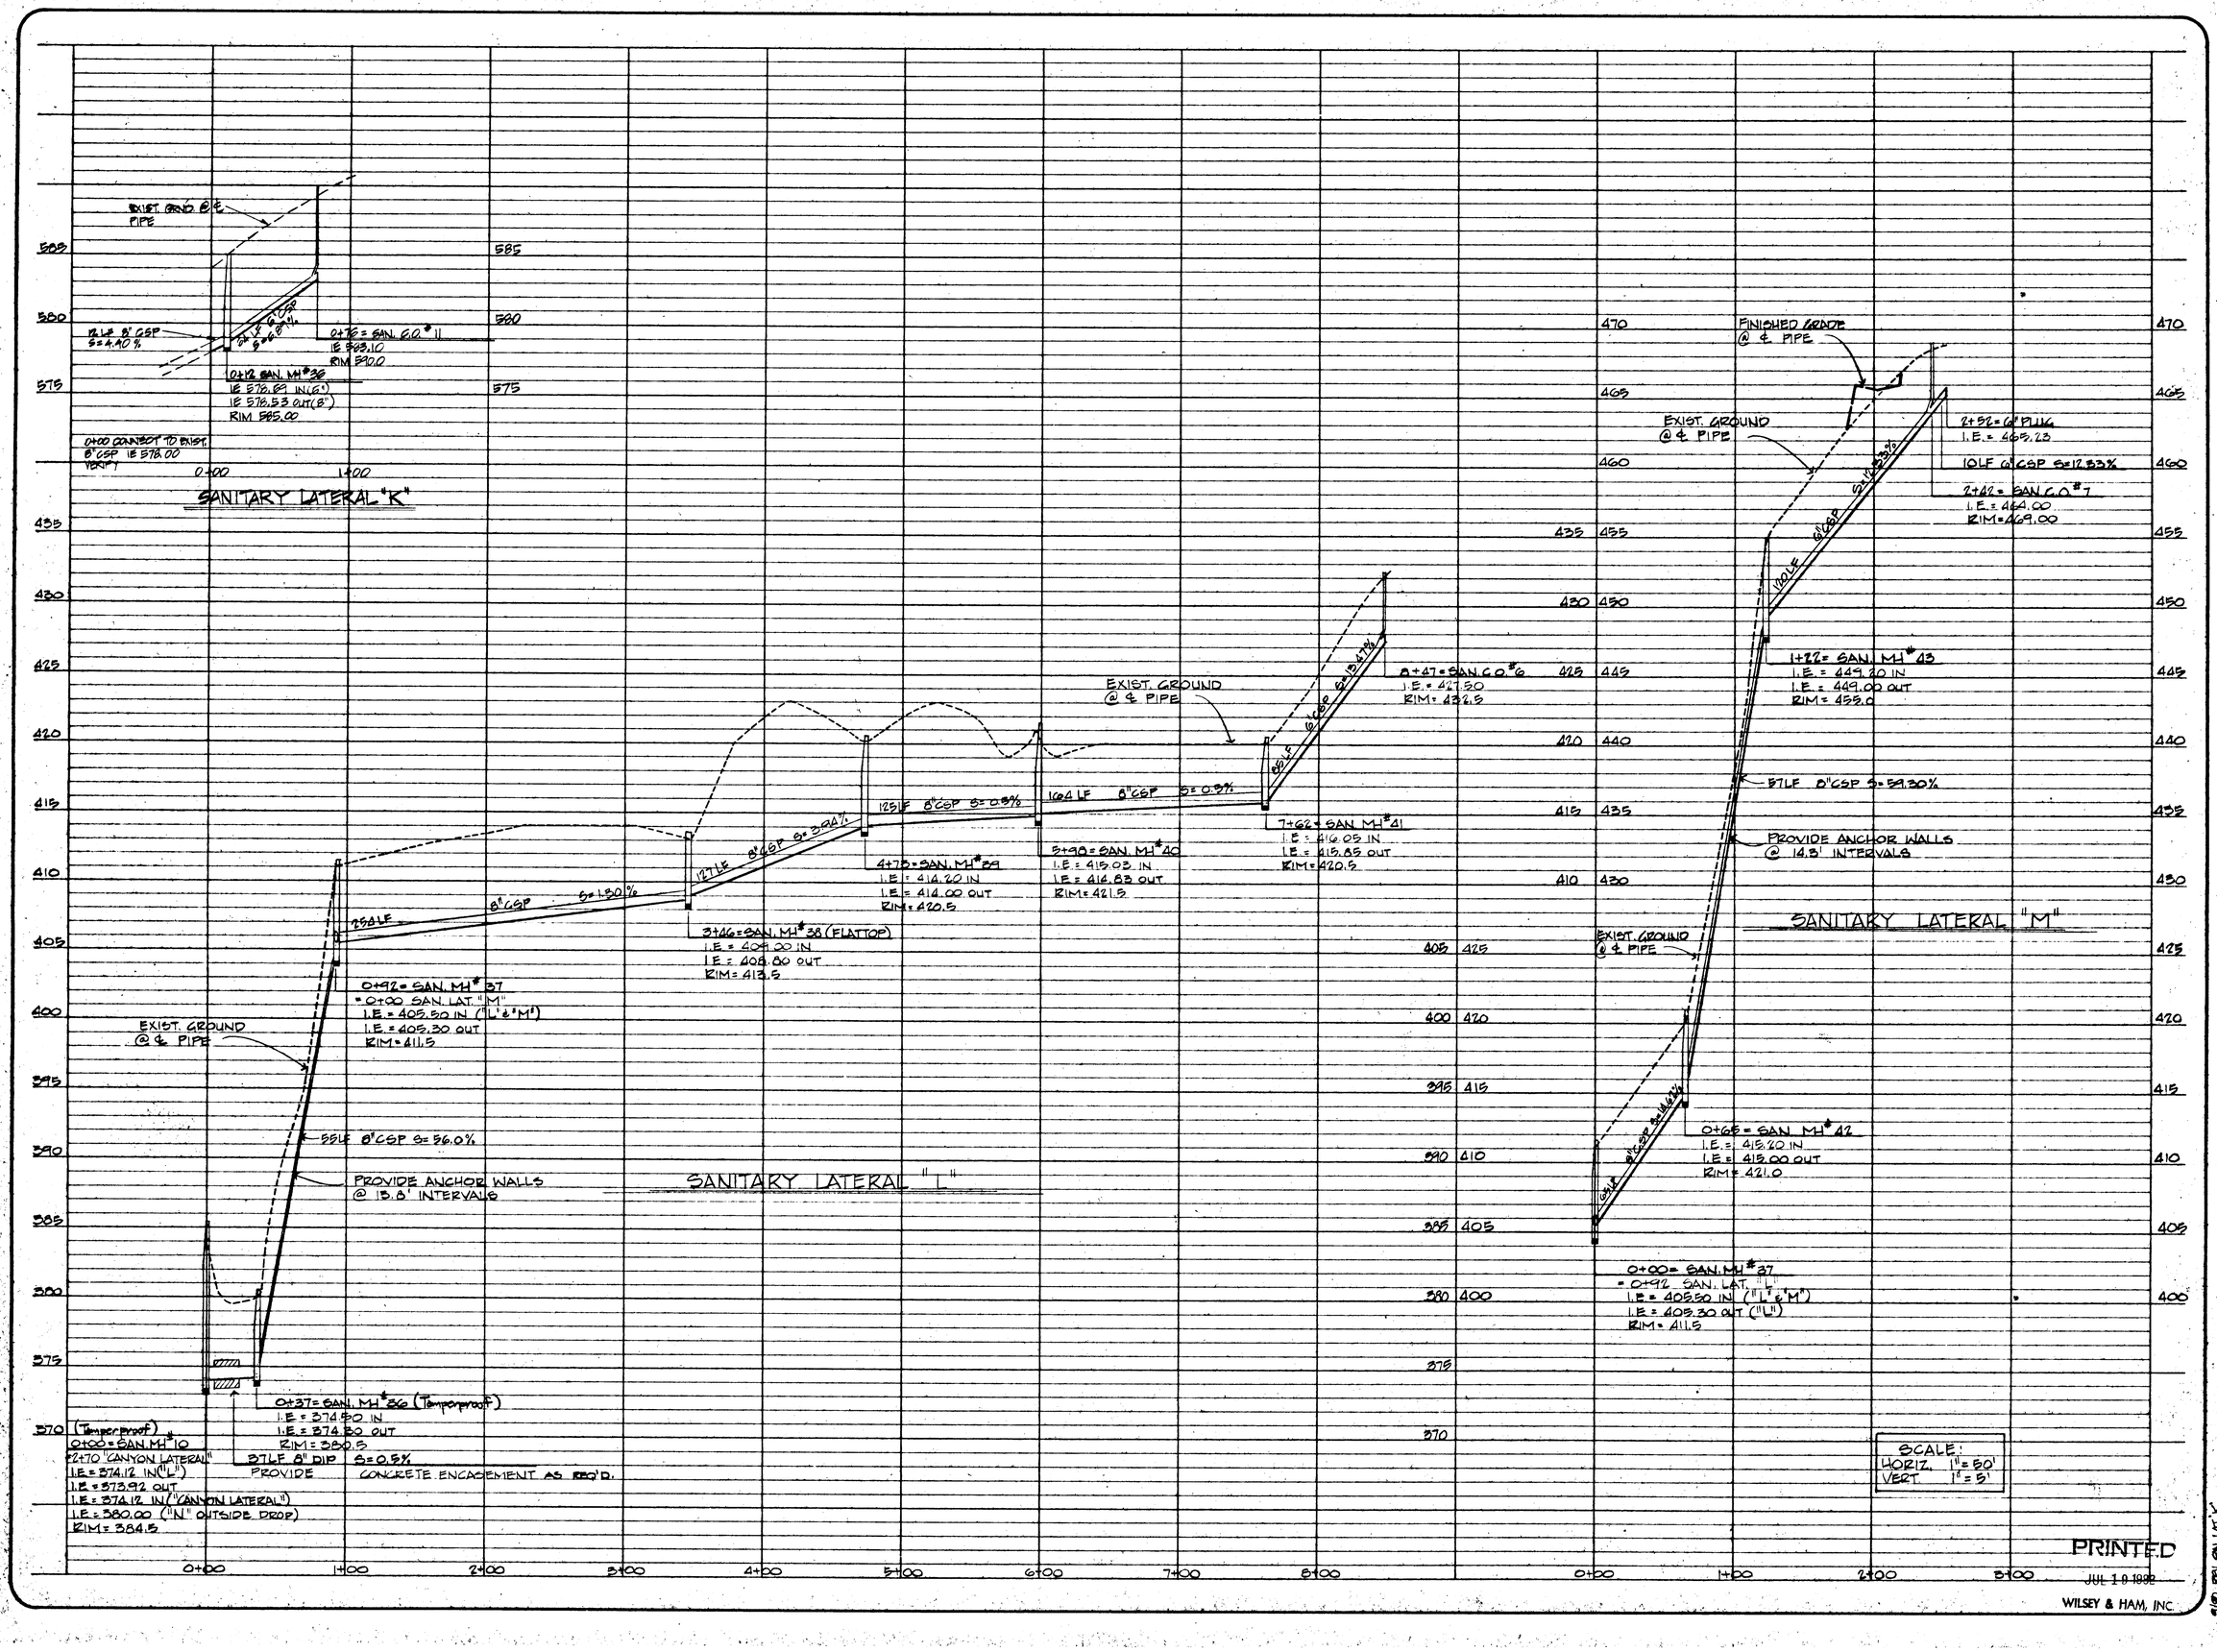

PRINTED
JUL 1 8 1992

WILSEY & HAM, INC.

9/80 REV. SAN. LAT. "K"
12/91 REV. PER CITY OF WEST LINN

W&H WILSEY & HAM
Suite 4, Portland Center, 222 S.W. Harrison
Portland, Oregon 97201 503 227-0455

HIDDEN SPRINGS RANCH NO. 6
WEST LINN, OREGON

SANITARY SEWER PROFILES

EDWARDS INDUSTRIES, INC.

BEAVERTON, OREGON

REGISTERED PROFESSIONAL ENGINEER
STATE OF OREGON
8573
JAMES M. HAM

SHEET NO. 23 / 25
DESIGN JUNE 1992 BY RJP
DRAWN JUNE 1992 BY CB
CHECKED ____ BY ____
FILE NO. 42100-740

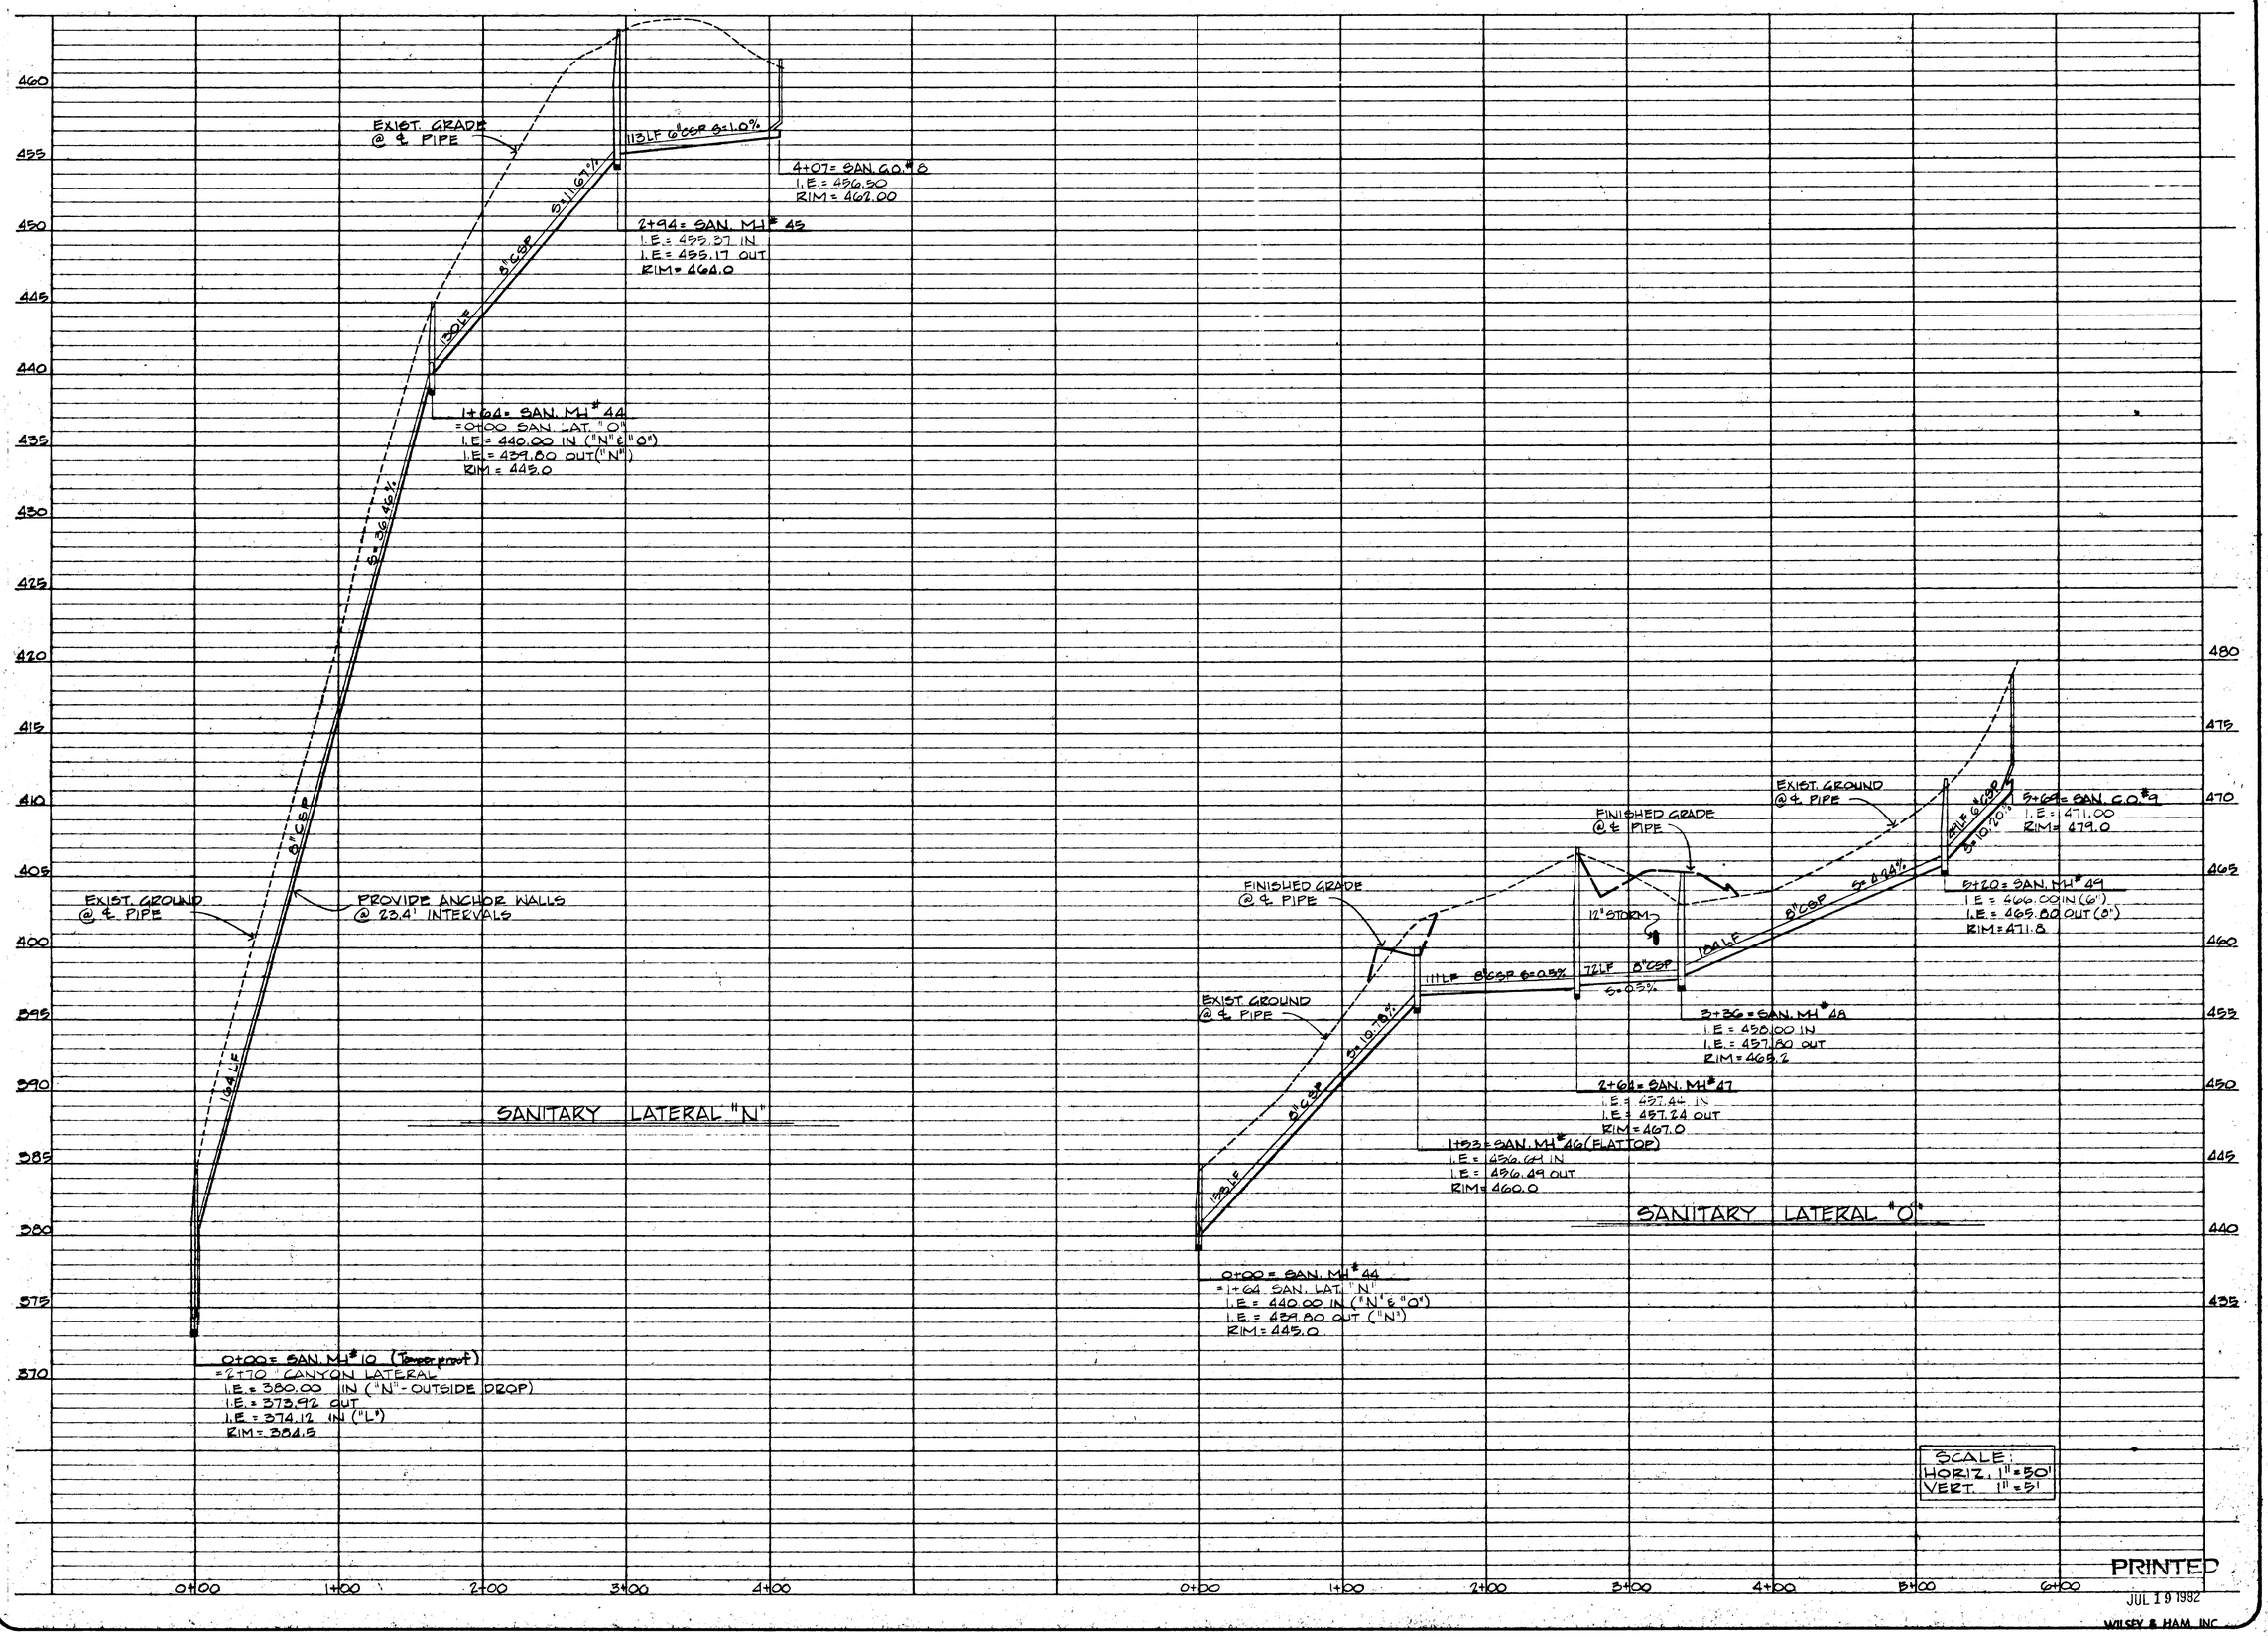

W&H WILSEY & HAM
Suite 4, Portland Center, 222 S.W. Harrison
Portland, Oregon 97201 503 227-0455

HIDDEN SPRINGS RANCH NO. 6
WEST LINN, OREGON

SANITARY SEWER PROFILES

EDWARDS INDUSTRIES, INC. BEAVERTON, OREGON

REGISTERED PROFESSIONAL ENGINEER
OREGON
JERRY M. WILSEY

SHEET NO. 24/25

DESIGN JUNE 1973 BY RJF
DRAWN JUNE 1973 BY CB
CHECKED ____ BY ____
FILE NO. 4-1100-740

1973 REV. PER CITY OF WEST LINN REP

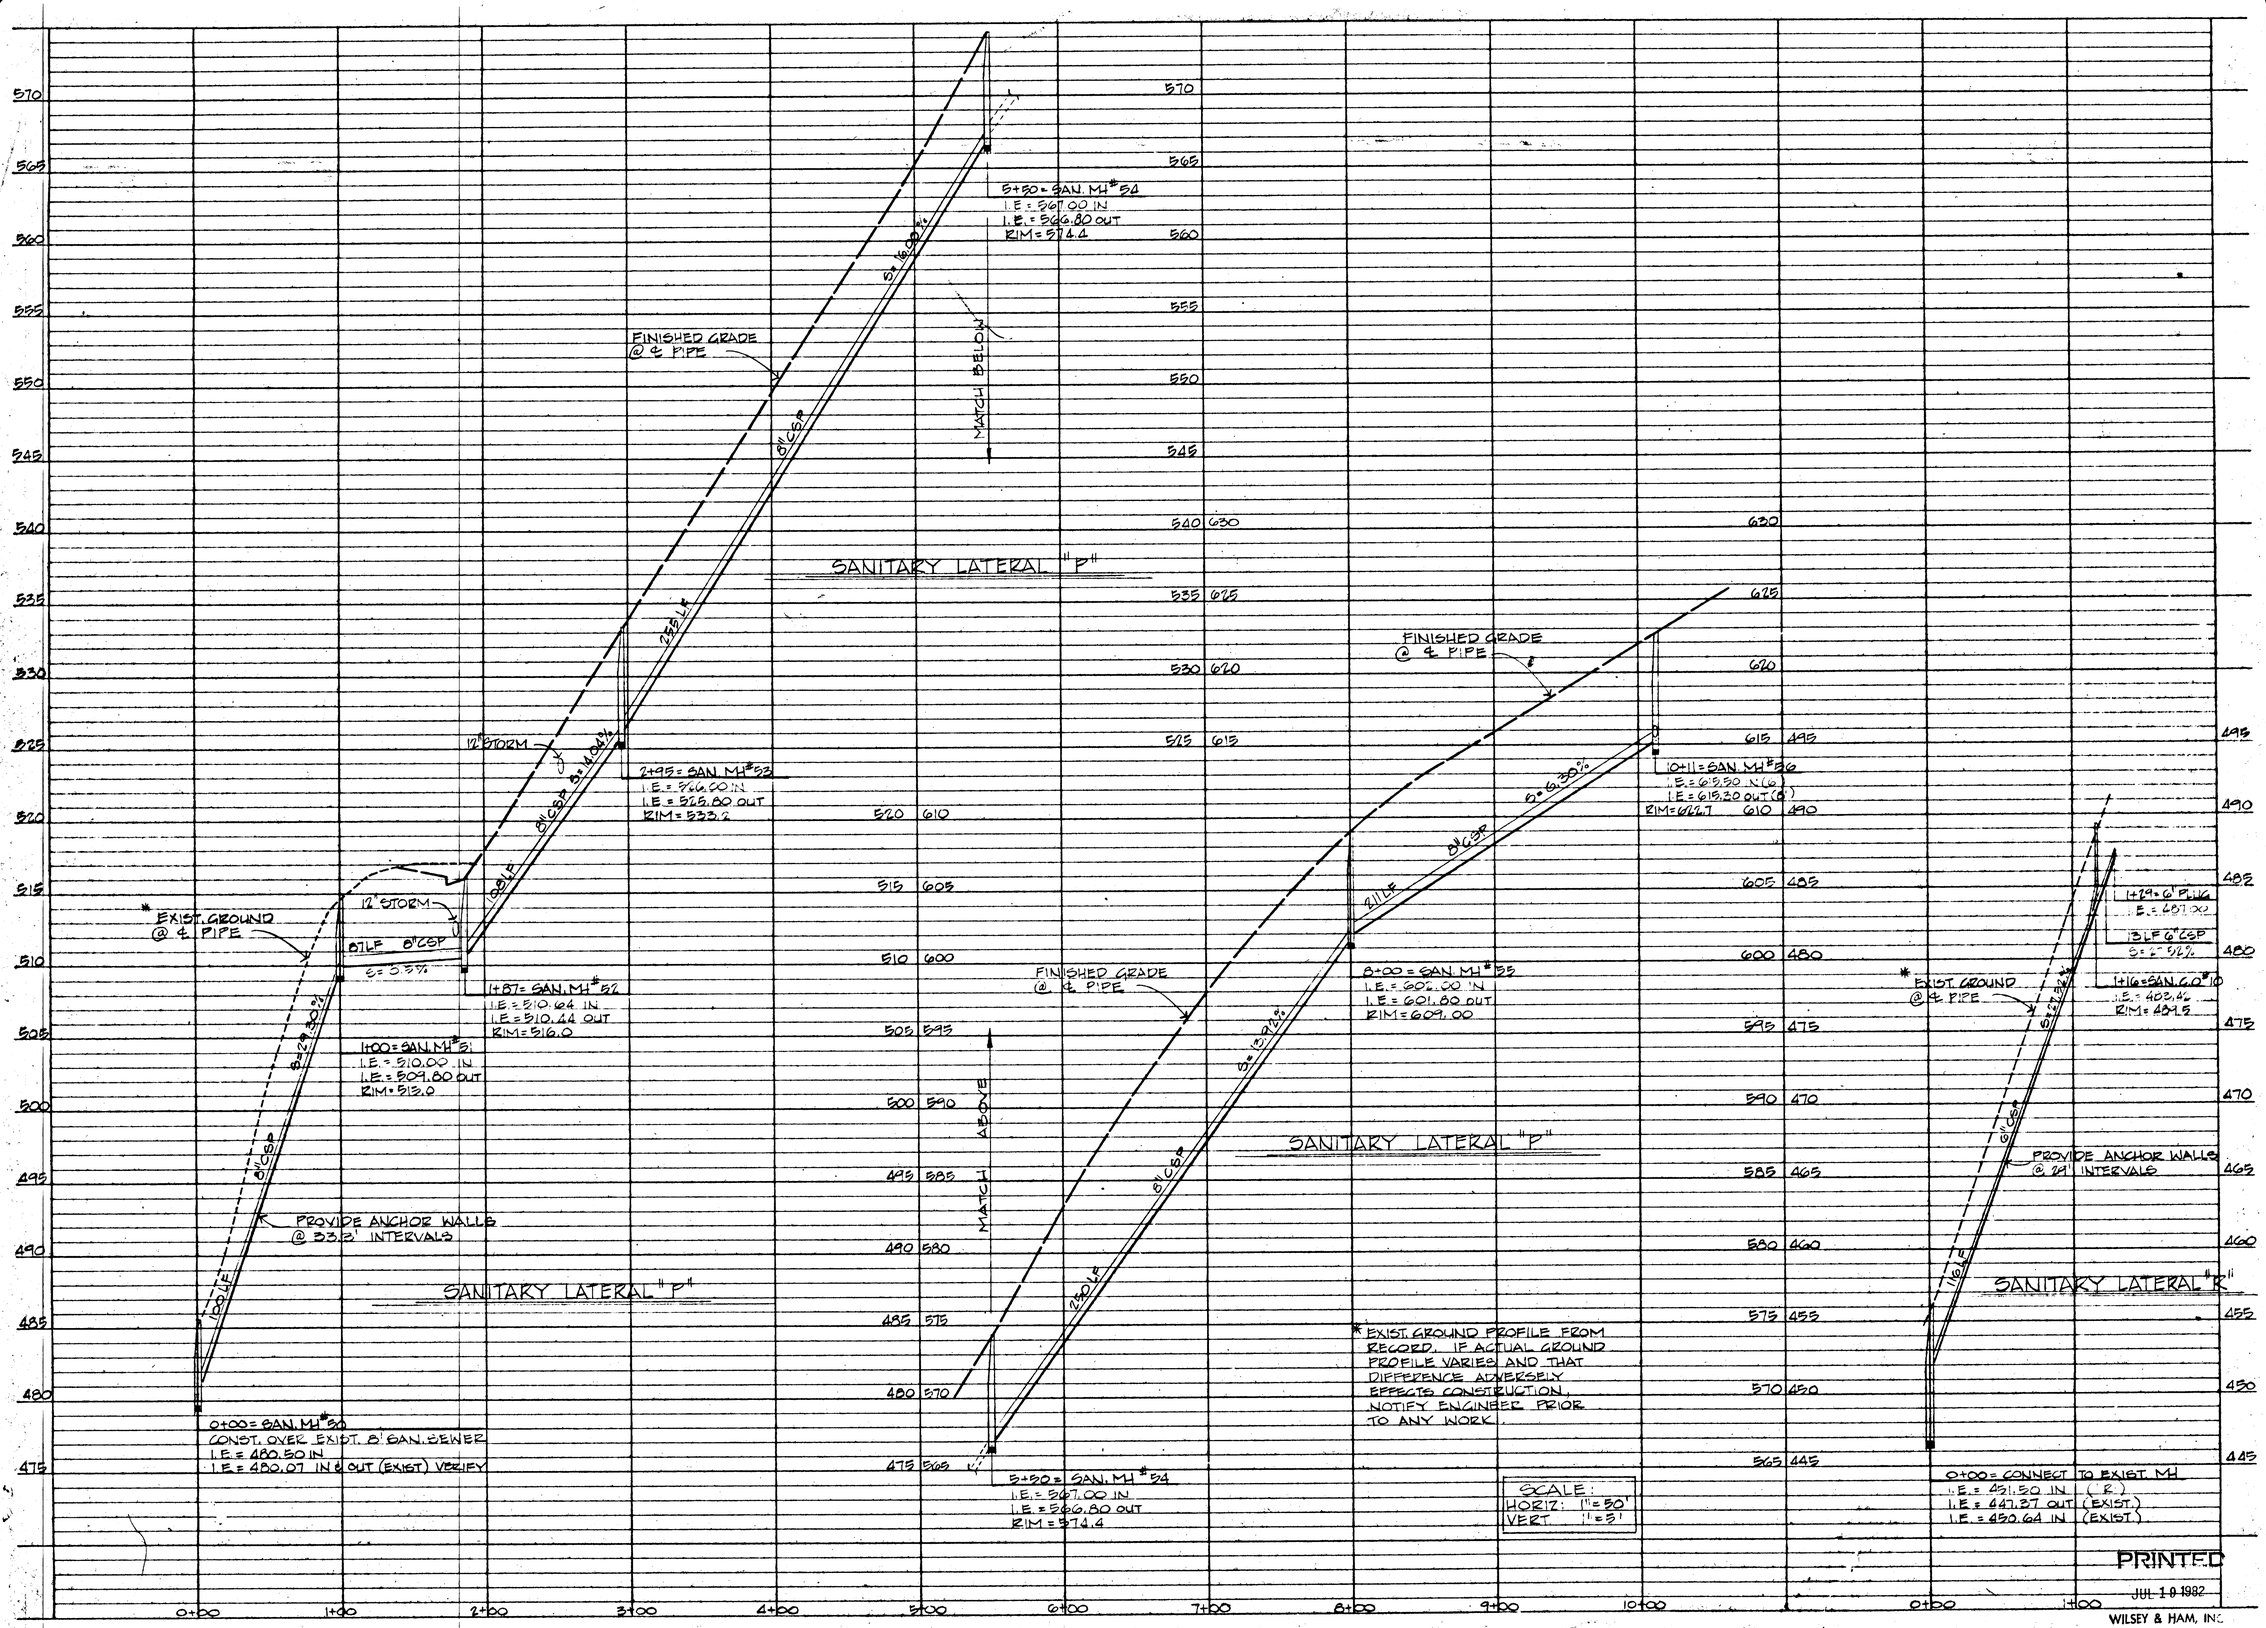

W&H WILSEY & HAM
Suite 4, Portland Center, 222 S.W. Harrison
Portland, Oregon 97201 503 227-0455

HIDDEN SPRINGS RANCH NO. 6
WEST LINN, OREGON
SANITARY SEWER PROFILES
EDWARDS INDUSTRIES, INC.
BEAVERTON, OREGON

REGISTERED PROFESSIONAL ENGINEER 8979 OREGON JUN 30, 1978 JERRY M. PALMER

SHEET NO. 25/25
DESIGN JUNE 1979 BY ZJP
DRAWN JUNE 1979 BY CB
CHECKED BY
FILE NO. A-1100-7401