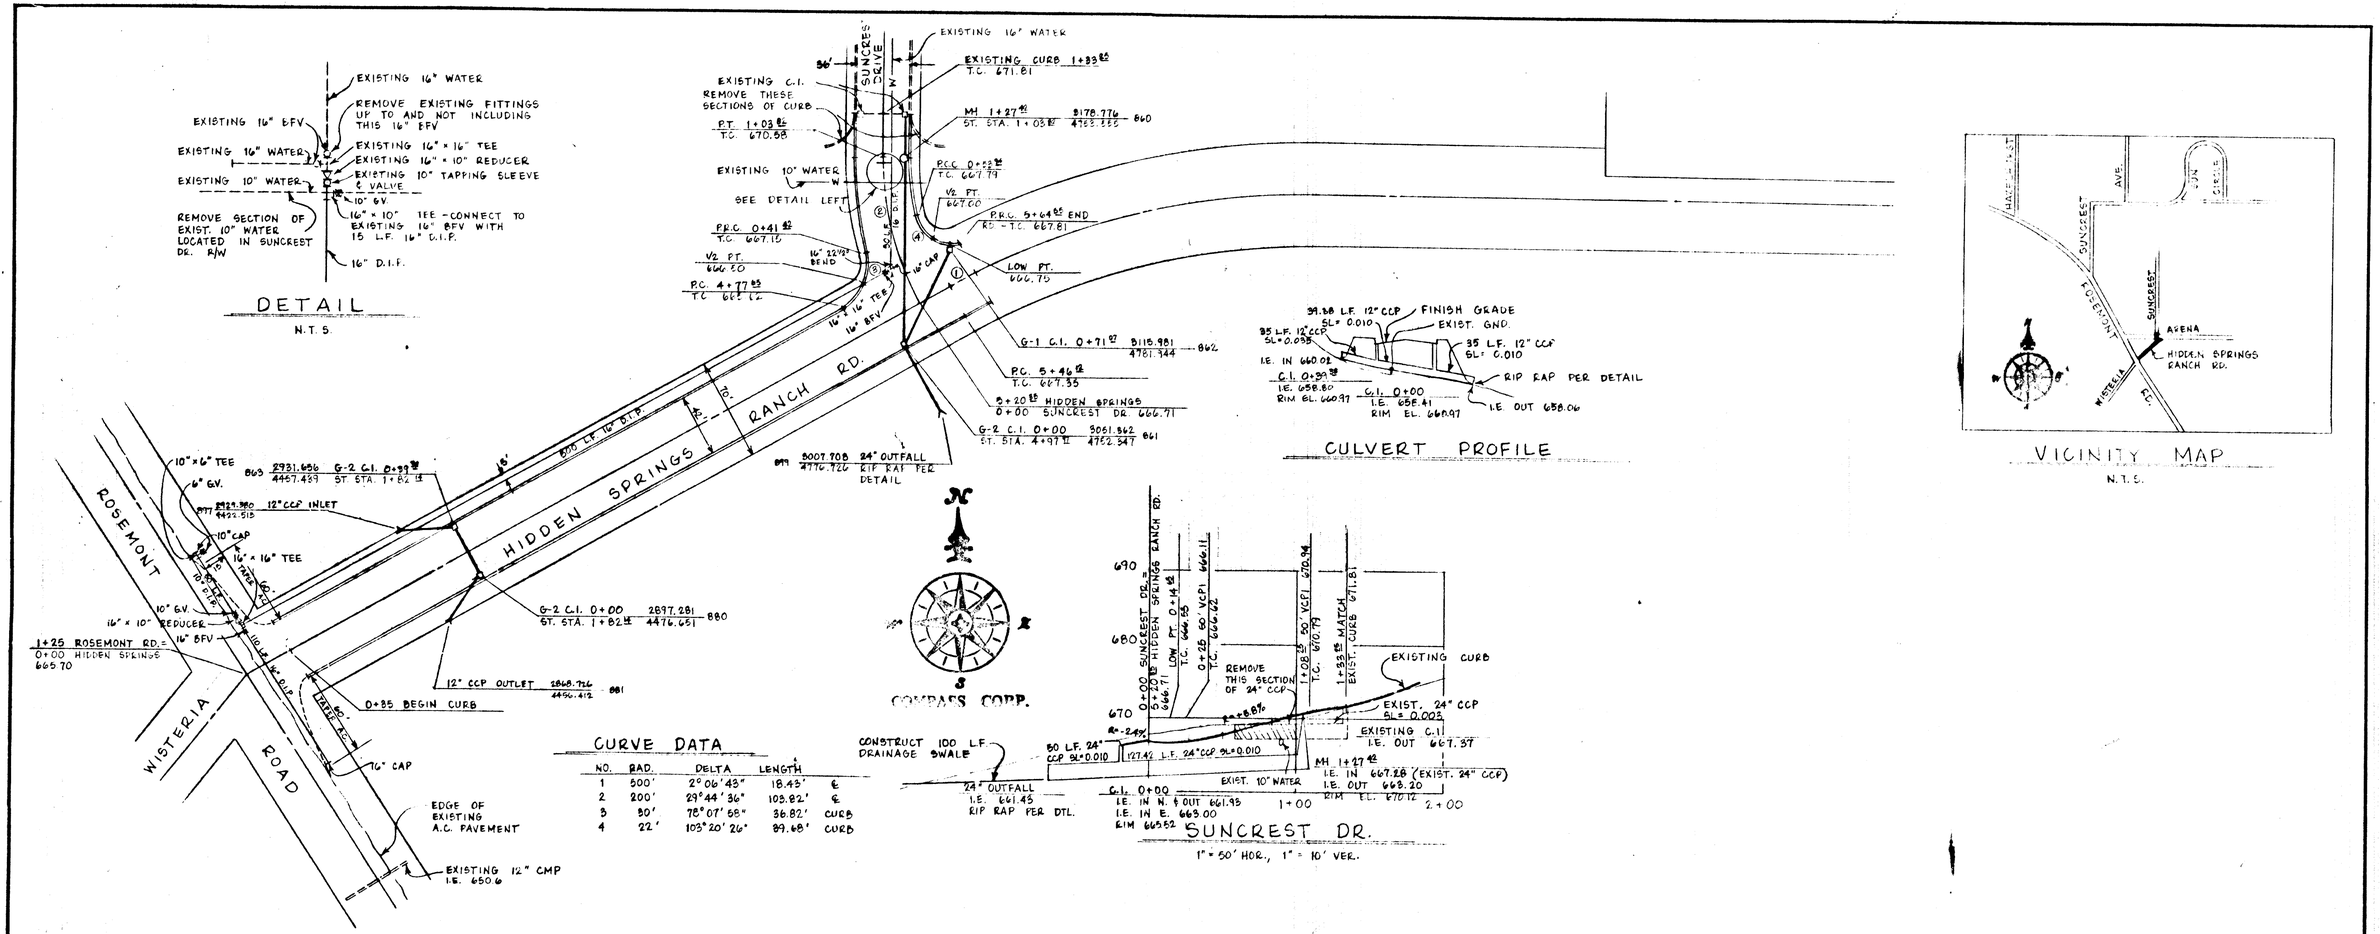

REGISTERED PROFESSIONAL ENGINEER 10,433 OREGON EXP. 12-31-83 MICHAEL R. WITTINA

DATE	NO.	REVISION
6/23/83	3	REVISED CURVE DATA
6/9/83	2	REVISED WATER PER CITY
5/31/83	1	REVISED STORM SEWER

DRAWN M M M | DESIGNED M R W | CHECKED
SCALE AS SHOWN | DATE MAY, 1983
FILE 76-1019-918

COMPASS CORPORATION
ENGINEERING - SURVEYING - PLANNING
9564 S.E. LAKE ROAD
MILWAUKIE, OREGON 97222
(503) 222-4652
(503) 653-9093

K & F DEVELOPMENT, INC.
15790 S.E. PIAZZA AVE.
CLACKAMAS, OREGON 97015

HIDDEN SPRINGS RANCH ROAD
ROAD AND STORM SEWER IMPROVEMENTS

Willamette Print & Blueprint Company N21783