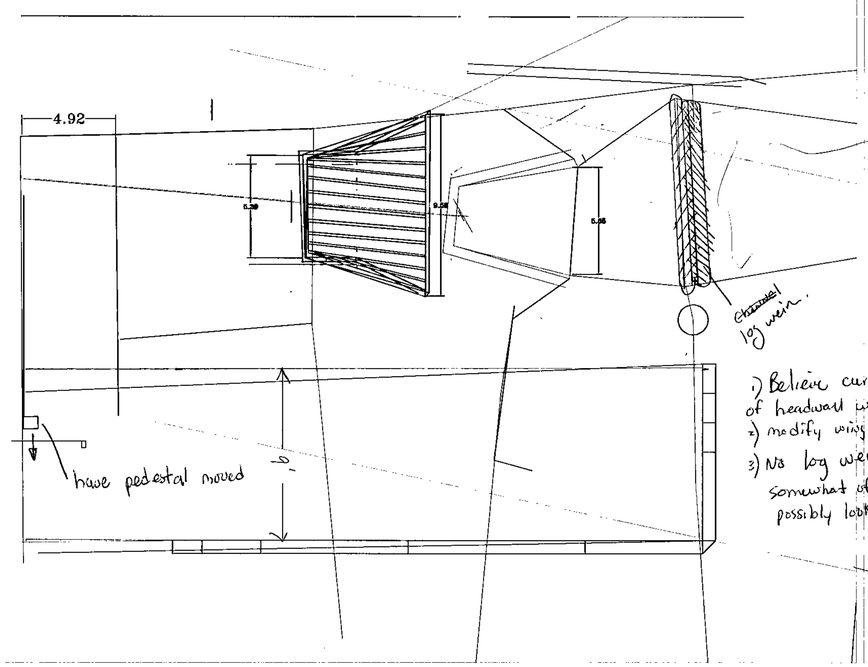

1) Believe current location of headwall will work
2) modify wing walls (widen out)
3) No log weir, there is somewhat of a natural one in place possibly look at putting something up the creek

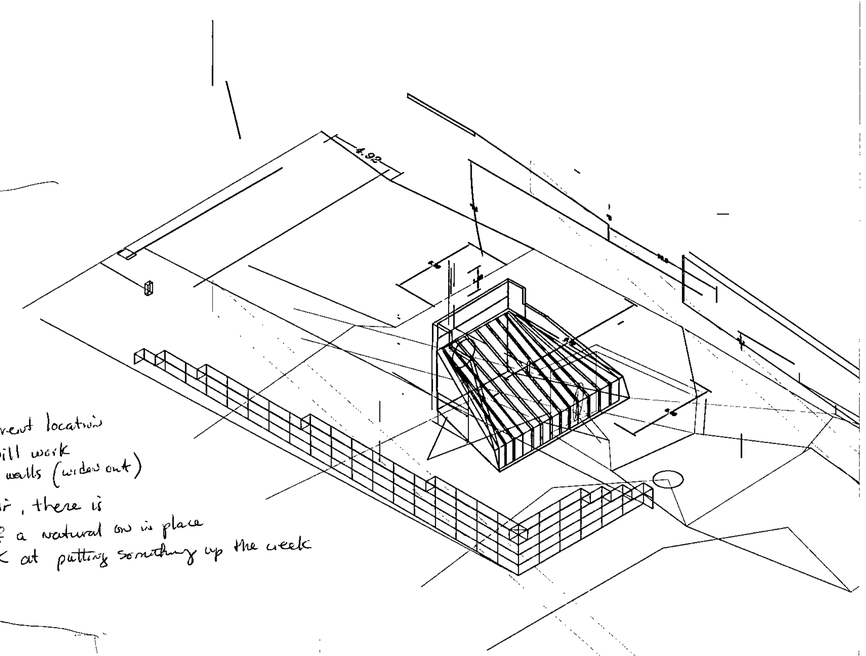

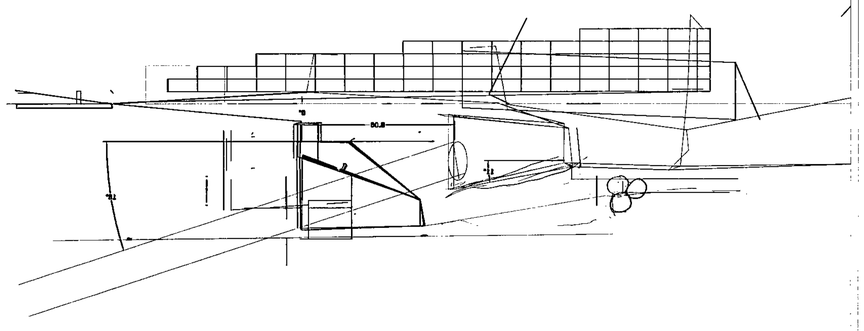

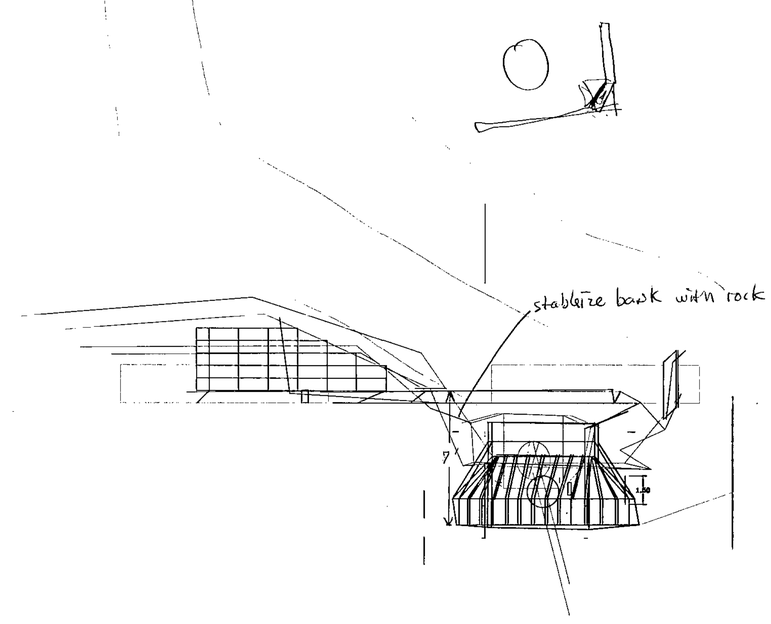

REVISIONS				
ZONE	REV	DESCRIPTION	DATE	APPROVED

project #
PW0032

Hillside Court Headwall

SIZE	FSCM NO.	DWG NO.	REV
		DRAFT	
SCALE 1"=4'		SHEET	